




Section B-B

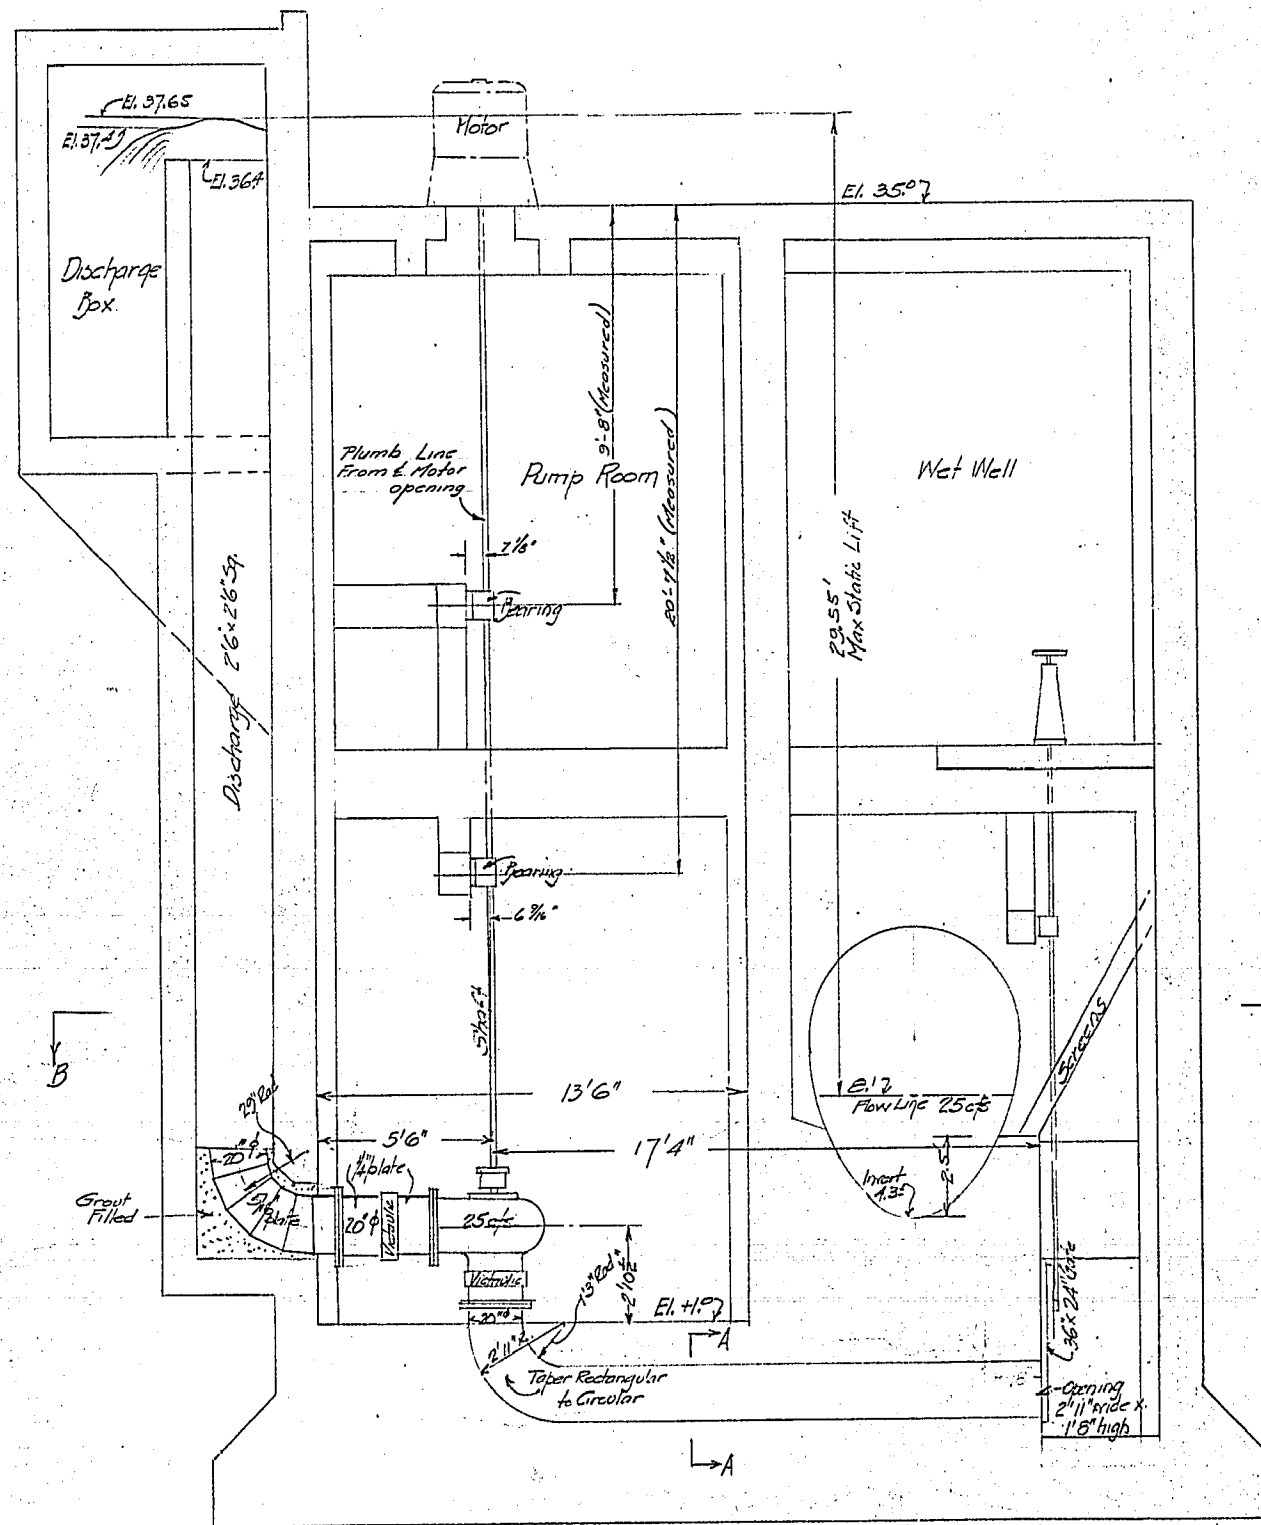

City Datum 0.00 = Can Geodetic 727.54  
Elevations shown are City Datum.

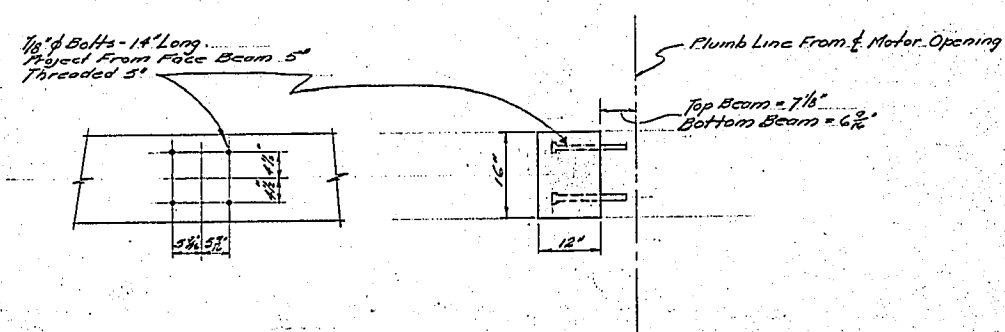

Detail of Anchor Bolts For Bracket  
To Carry Steady Bearing  
Scale = 1/4" = 1'-0"

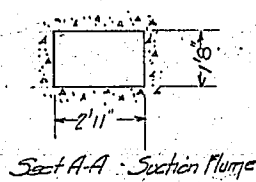

Section A-A: Suction Pipe

REVISIONS				
NO	BY	DATE	REF.	
1	M.B.	June 13/55	Location of Bearing Beams & Anchor Bolts as Constructed.	

COCKBURN STREET FLOOD PUMPING STATION  
20" Pump Installation

CITY OF WINNIPEG  
ENGINEERING DEPARTMENT  
W. D. HURST, CITY ENGINEER  
A. J. S. TAUNTON, DEPUTY CITY ENGINEER

DRAWN BY... DATE Oct 20, 1954  
CHECKED BY...  
APPROVED...

R-145  
SCALE  
1/4" = 1' foot  
DRAWING NO.  
682-9