


MECA:

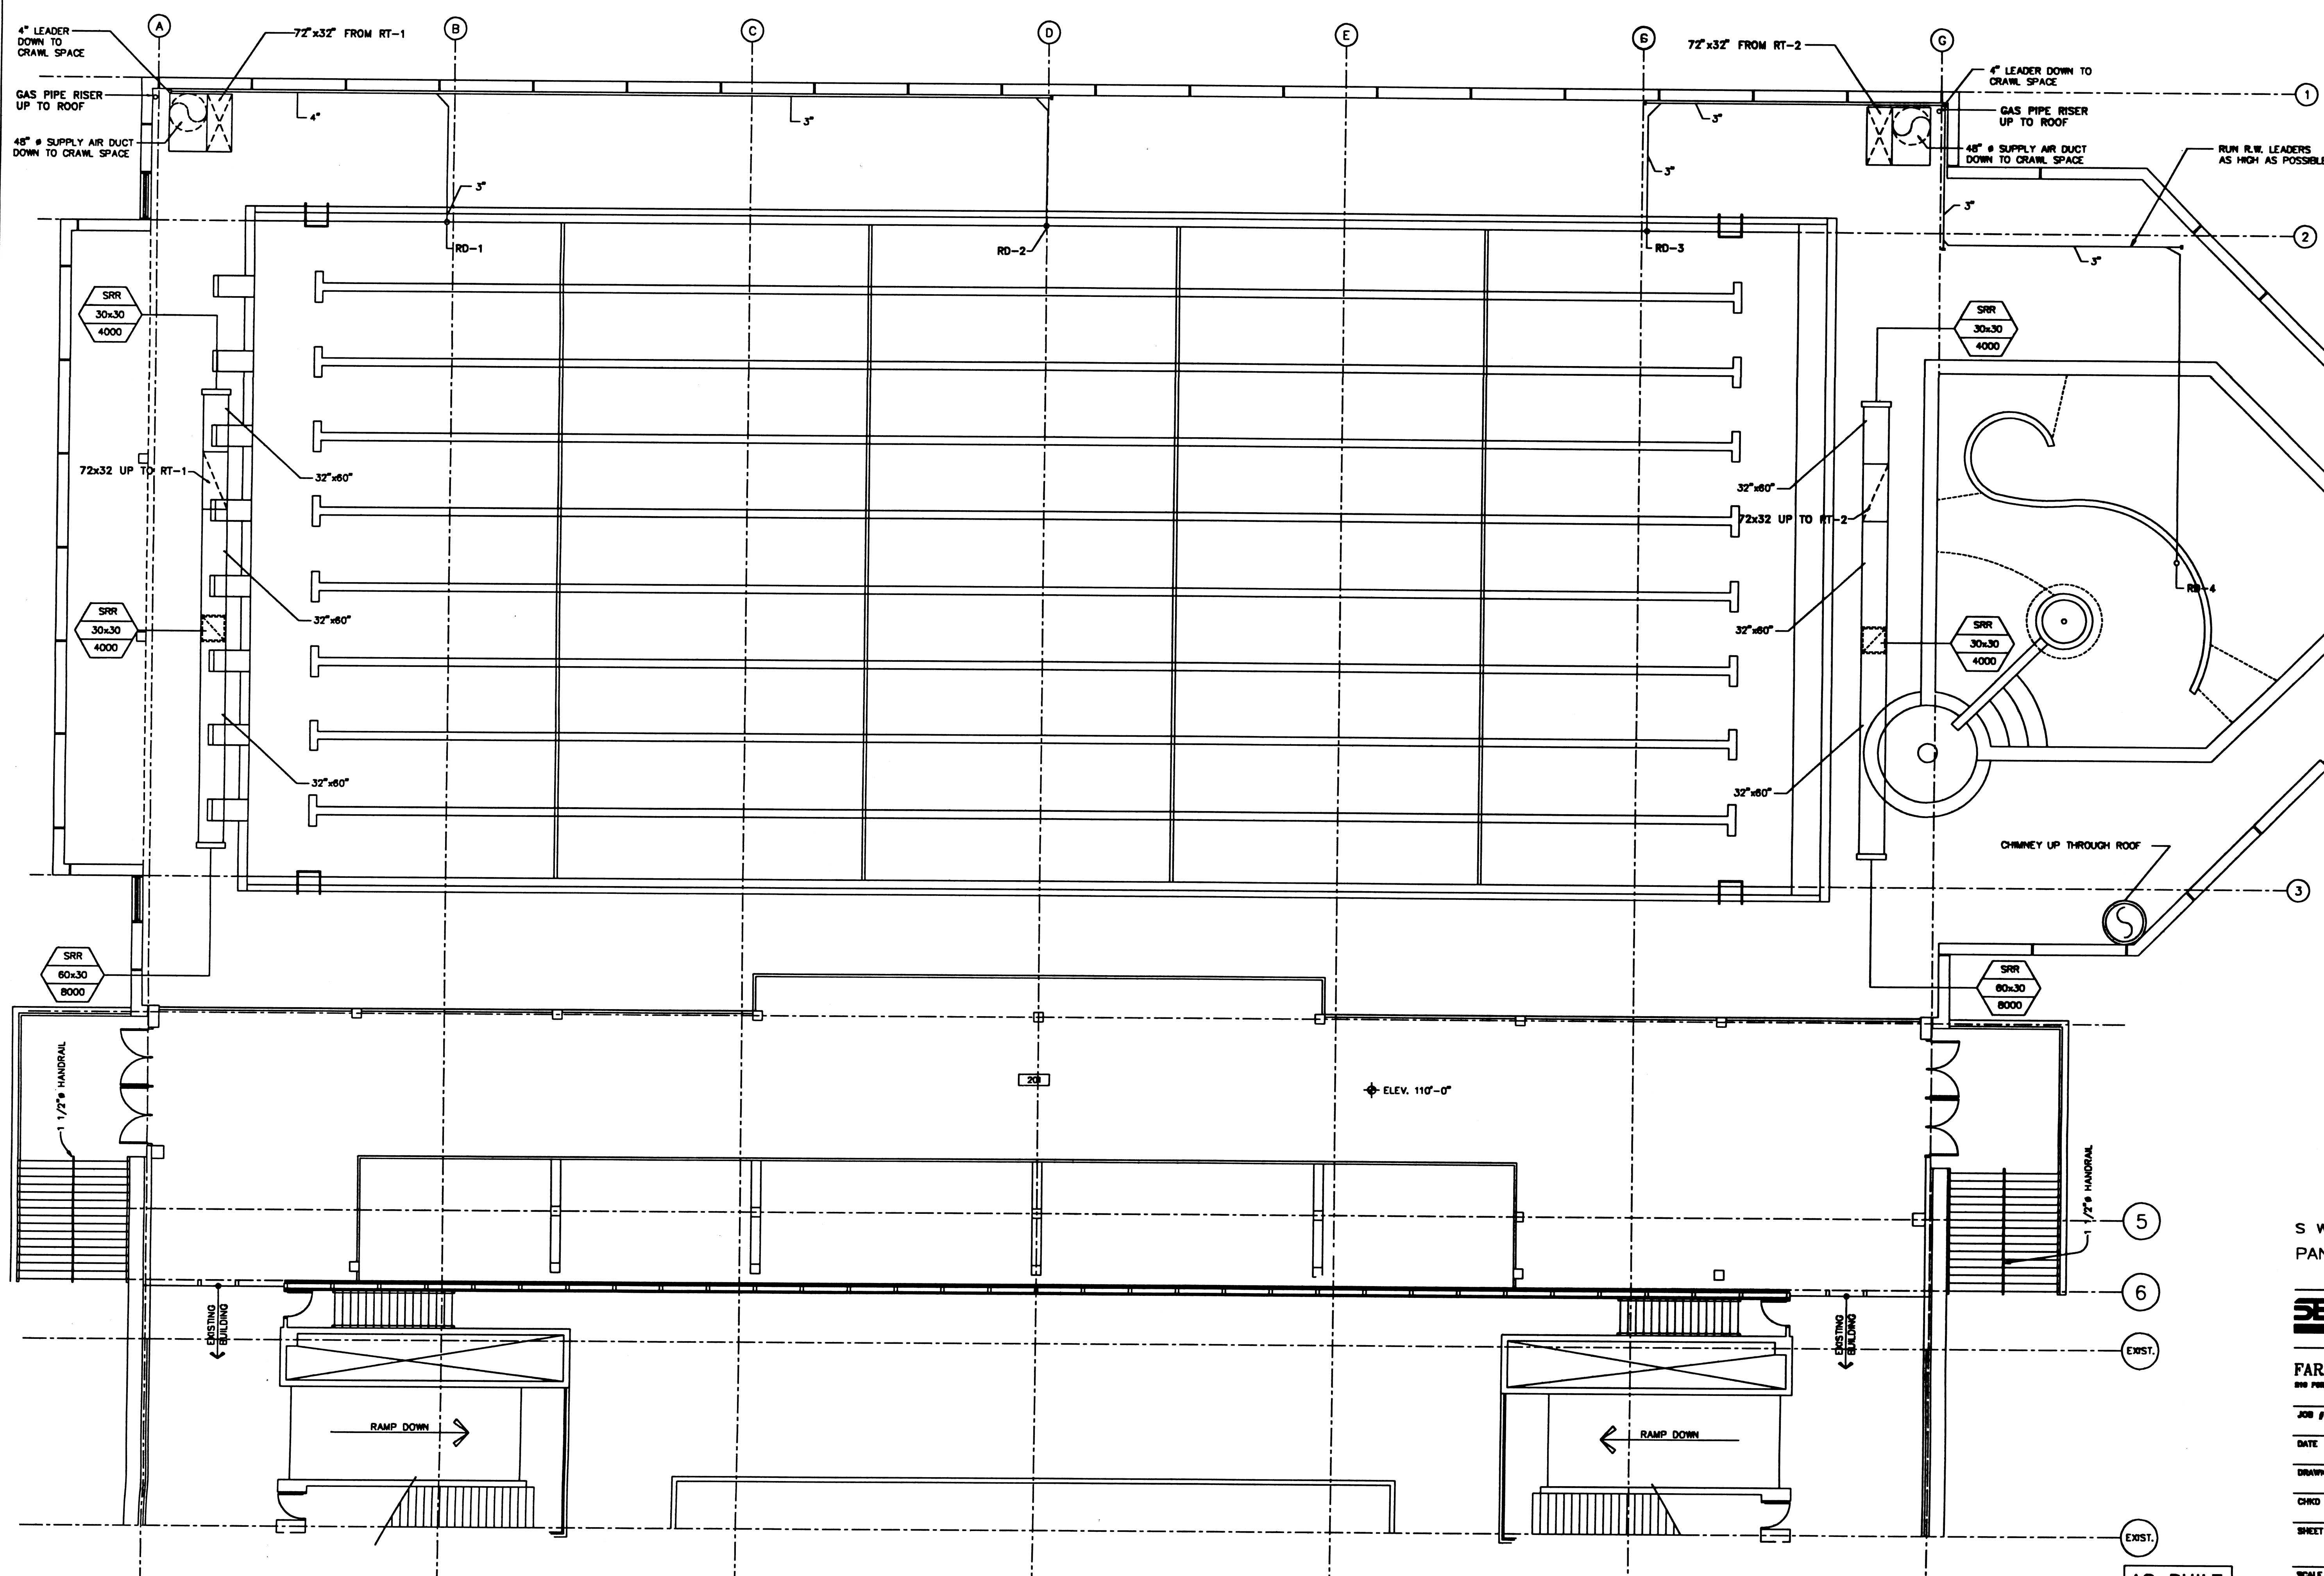

SWIM MANITOBA
PAN AM POOL ADDITION

SEG SEG ENGINEERING INC.
200 FINE STREET TORONTO, ONTARIO, CANADA M5G 1B1

FARACI ENGINEERING LTD.
200 FINE STREET TORONTO, ONTARIO, CANADA M5G 1B1

JOB #	8301
DATE	MAY 10 1983
DRAWN BY	M.L.
CHKD BY	E.A.F.

SHEET TITLE
MEZZANINE PLAN
MECHANICAL

SCALE 1/8" = 1'-0" SHEET No. M-3.1
CAD FILE ABL763

AS BUILT