


PAN AM POOL
CONCOURSE PLUMBING LAYOUT

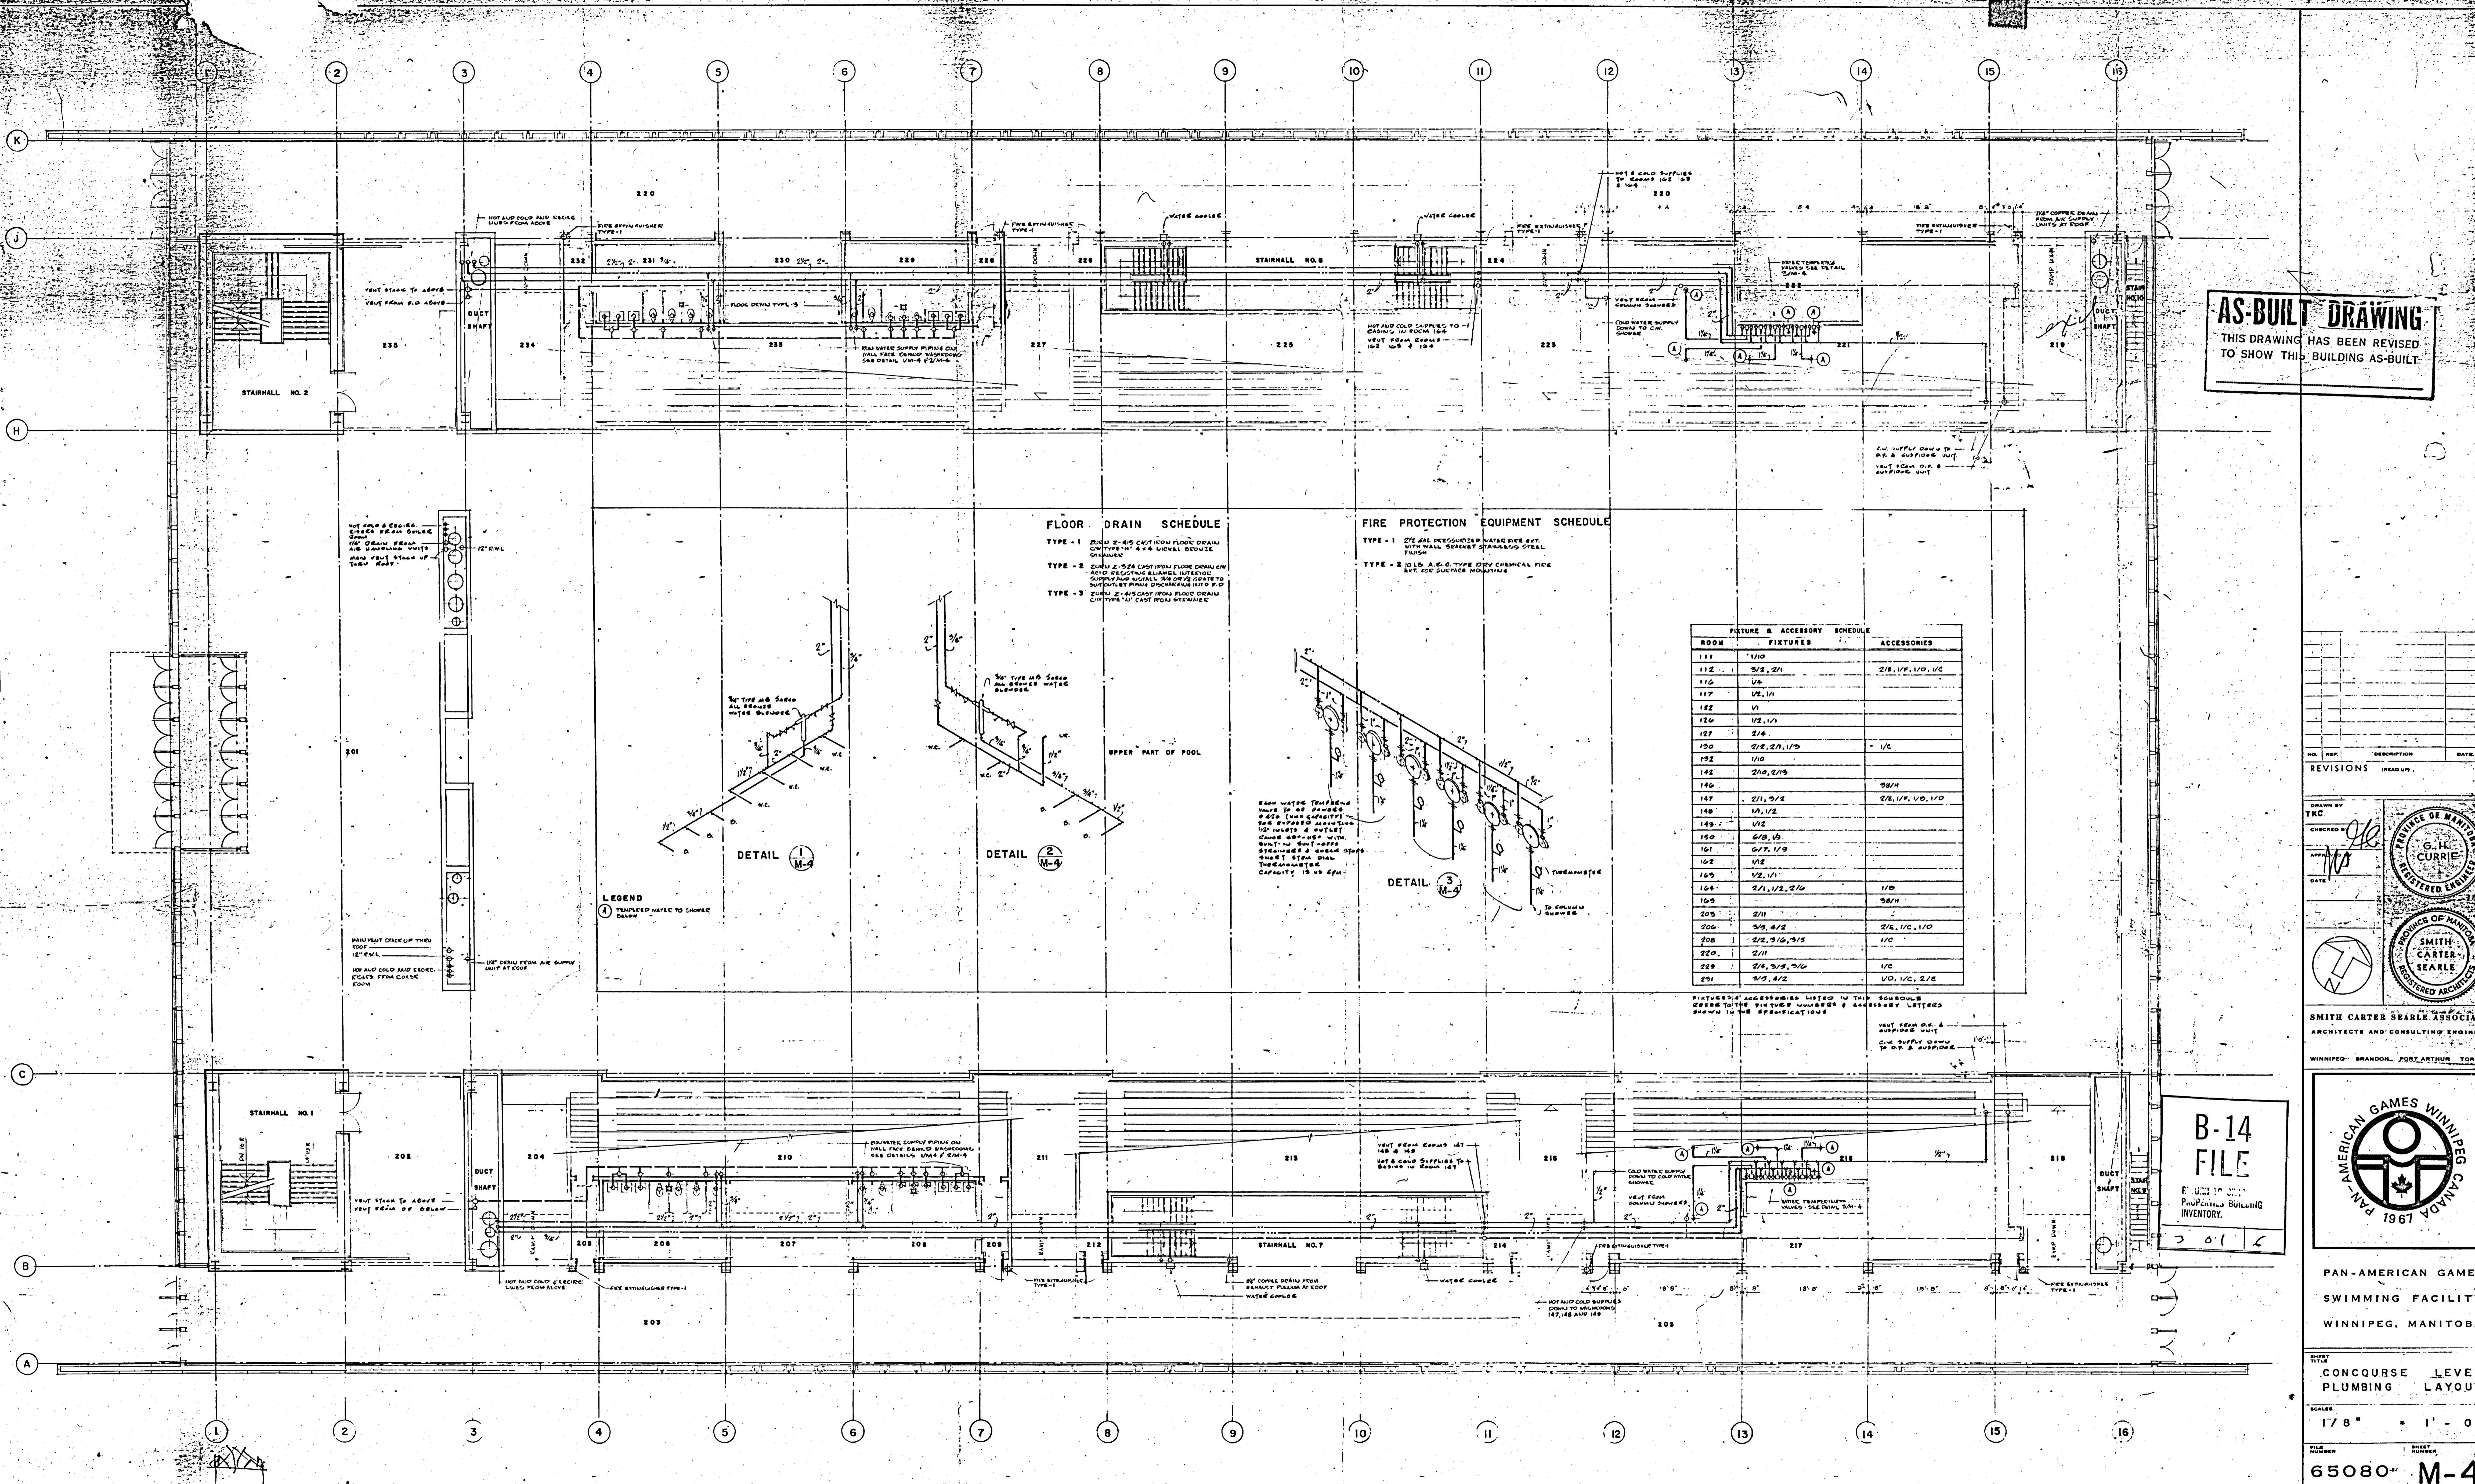




AS-BUILT DRAWING
THIS DRAWING HAS BEEN REVISED
TO SHOW THIS BUILDING AS-BUILT.

FLOOR DRAIN SCHEDULE
TYPE - 1 2" DIA. 2-45 CAST IRON FLOOR DRAIN
ON TYPE "A" & "B" LUGGED BRONZE
STAINLESS
TYPE - 2 2" DIA. 2-524 CAST IRON FLOOR DRAIN
ON 1/2" THICK BRASS INLET
SUPPORT AND SUPPLY 1/2" DIA. COUPLER TO
SUPPORT BY FLOOR DISCONNECT AND 1/2" ID
TYPE "A" CAST IRON FLOOR DRAIN
ON TYPE "A" CAST IRON STAINLESS

FIRE PROTECTION EQUIPMENT SCHEDULE
TYPE - 1 2 1/2" GAL. RECOGNIZED WATER PIPE
WITH WALL SOCKET STAINLESS STEEL
FLUSH
TYPE - 2 10 LB. A. S. C. TYPE DRY CHEMICAL PICE
EXT. FOR SURFACE MOUNTING


FIXTURE & ACCESSORY SCHEDULE

ROOM	FIXTURES	ACCESSORIES
111	1/10	
112	3/2, 2/1	2/R, V/F, V/D, V/C
116	1/6	
117	1/2, 1/1	
122	1/1	
126	1/2, 1/1	
127	2/4	
130	2/2, 2/1, 1/3	1/C
132	1/10	
142	2/2, 2/3	
146		38/N
147	2/1, 2/2	2/R, 1/C, V/D, V/C
148	1/2, 1/2	
149	1/2	
150	6/8, 1/3	
161	0/7, 1/3	
162	1/2	
165	1/2, 1/1	
164	2/1, 1/2, 2/6	1/0
165		38/N
205	2/11	
206	2/2, 4/2	2/R, 1/C, 1/0
208	2/2, 3/6, 3/3	1/C
220	2/11	
229	2/4, 3/3, 3/6	1/C
231	1/3, 4/2	V/D, 1/C, 2/E

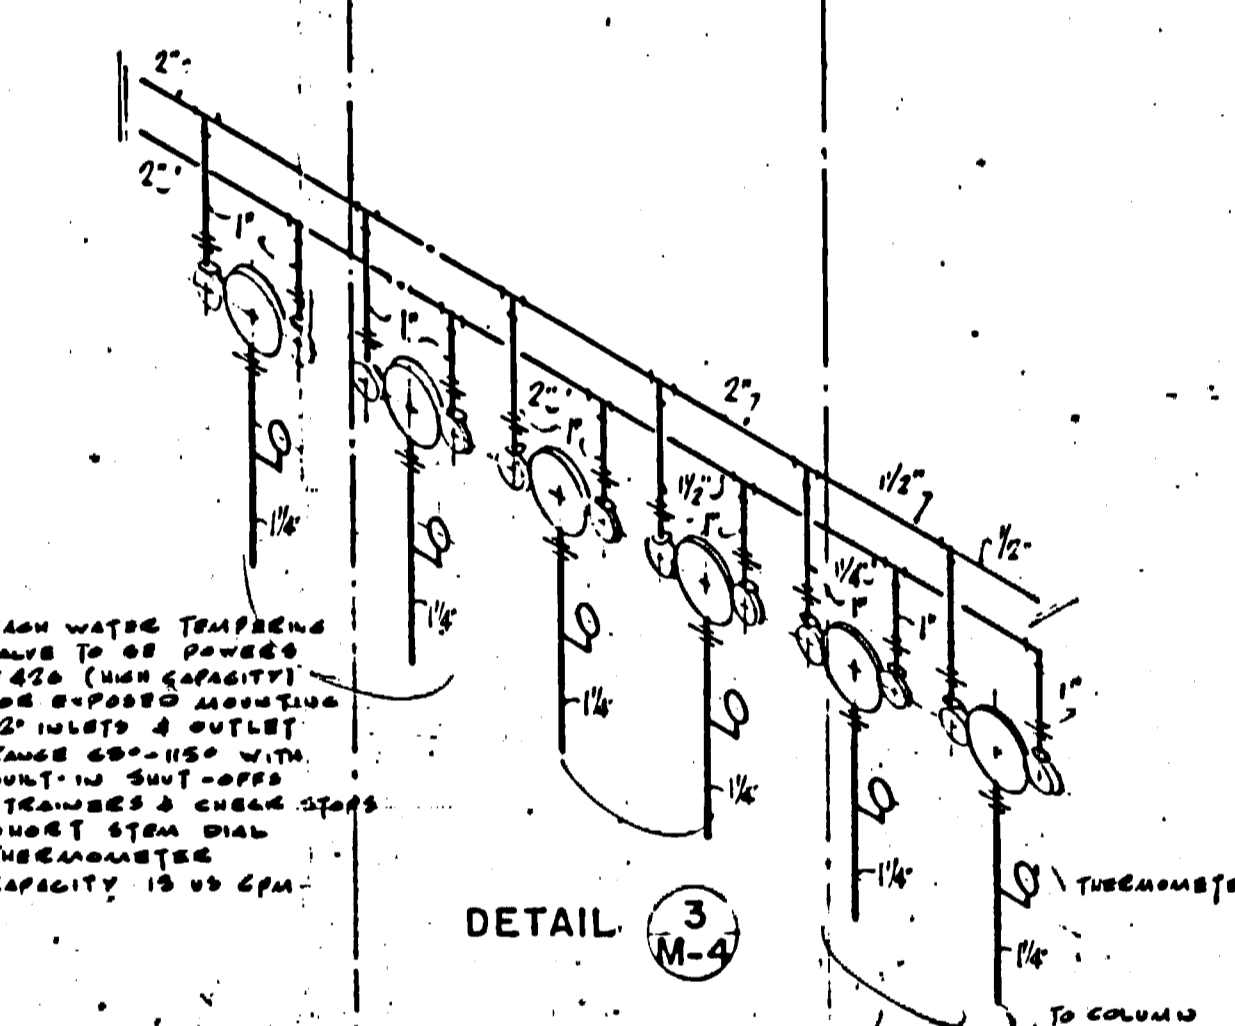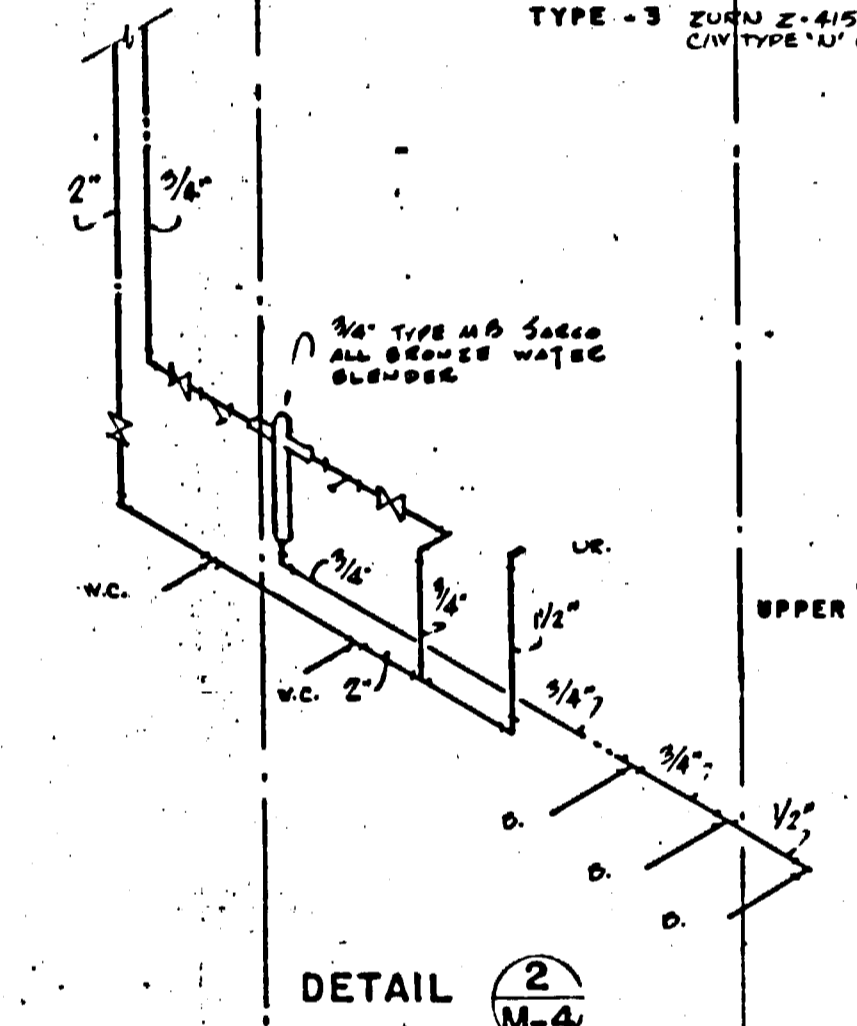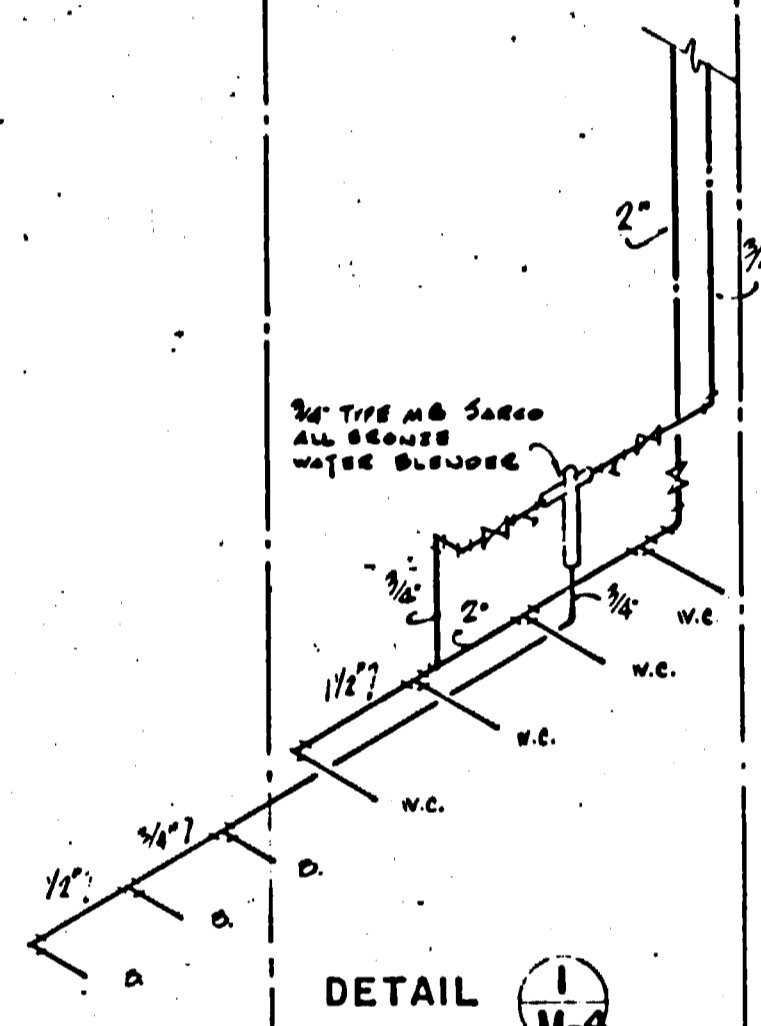

LEGEND
① TRAPPED WATER TO SHOWER
DRAIN

B-14 FILE
PROPERTY BUILDING
INVENTORY
2016

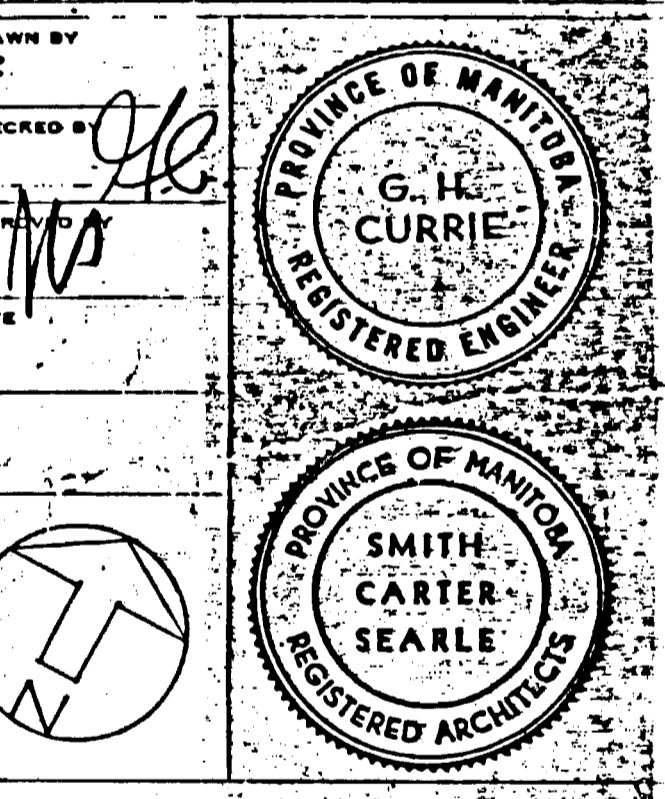

SMITH CARTER SEALE ASSOCIATES
ARCHITECTS AND CONSULTING ENGINEERS
WINNIPEG - BRANDON - FORT ARTHUR - TORONTO



PAN-AMERICAN GAMES
SWIMMING FACILITY
WINNIPEG, MANITOBA

CONCOURSE LEVEL
PLUMBING LAYOUT

SCALE
1 7/8" = 1' - 0"

FILE NUMBER
65080 M-4