
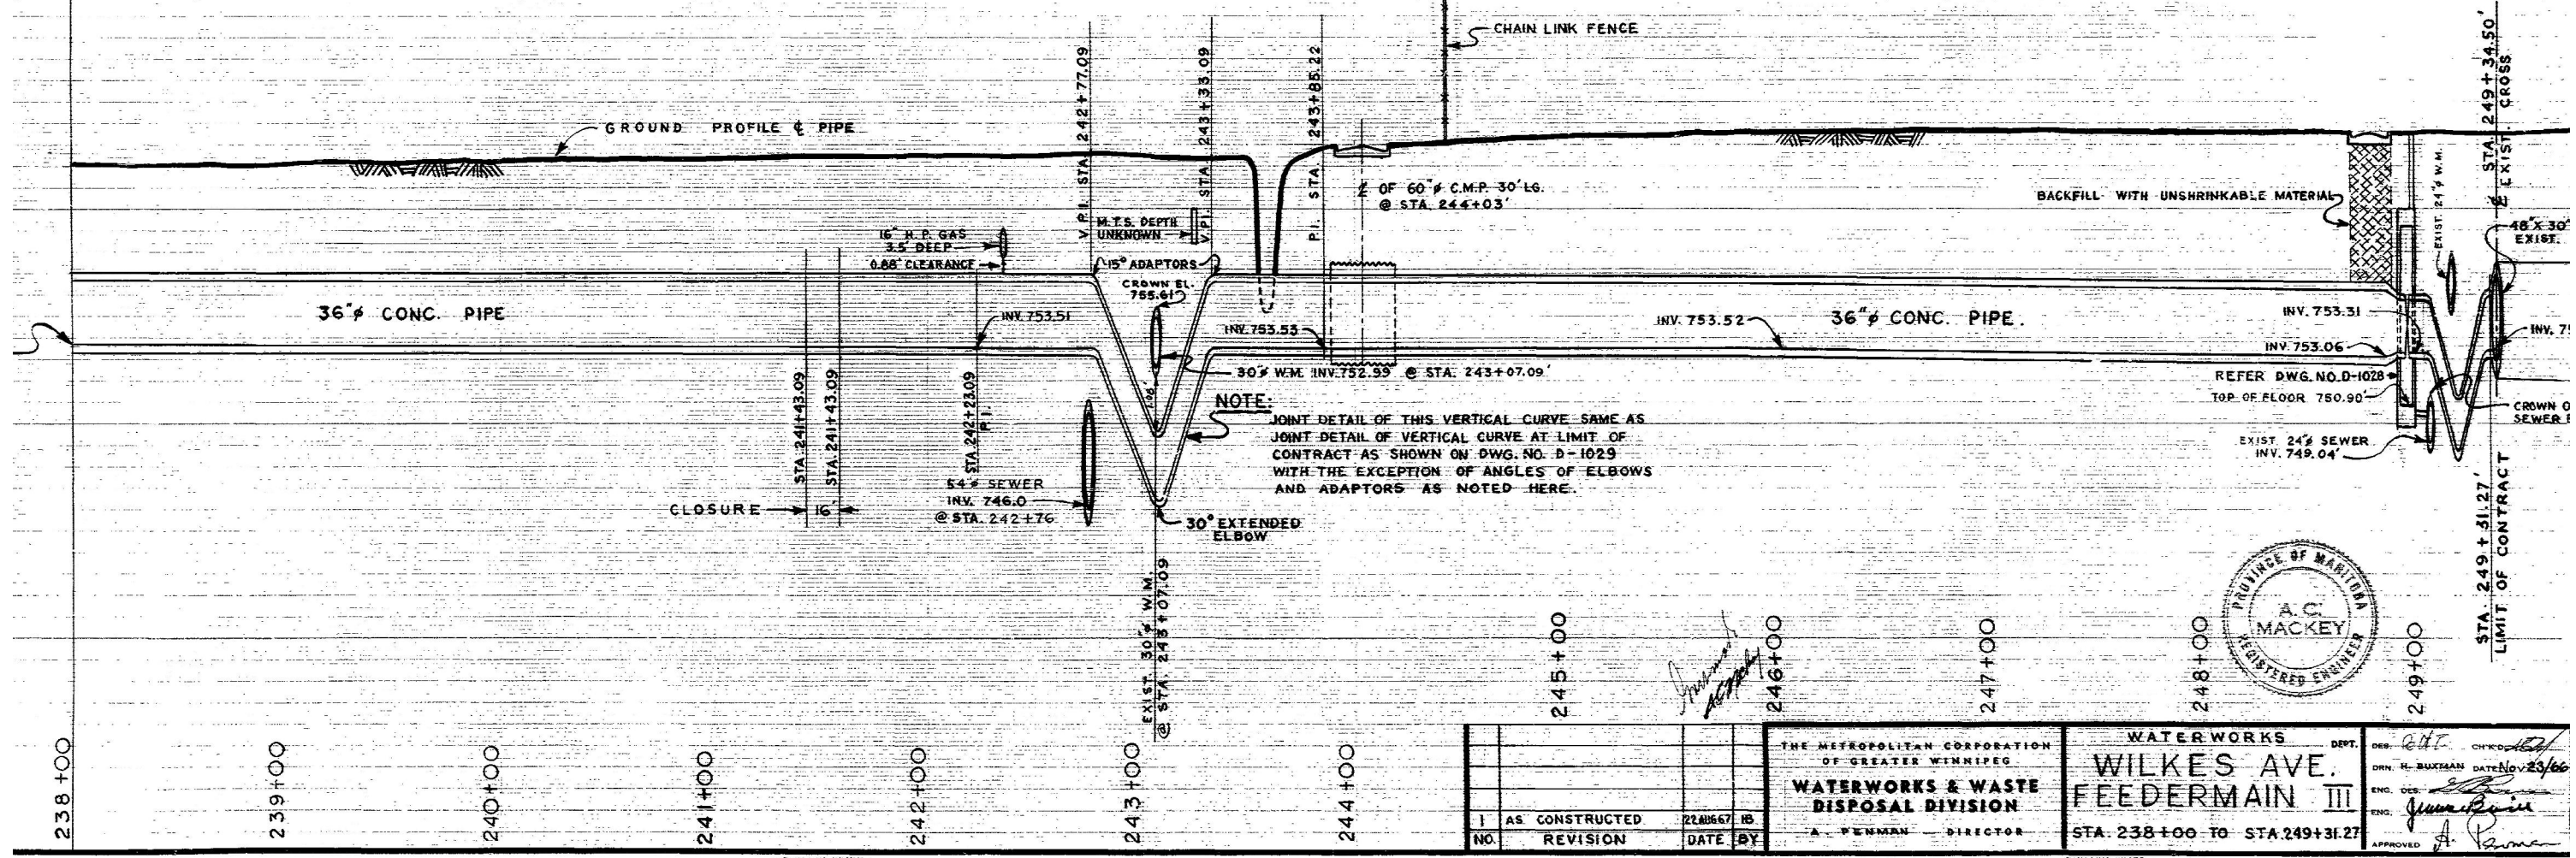


APPENDIX 'C'

REFERENCE DRAWINGS

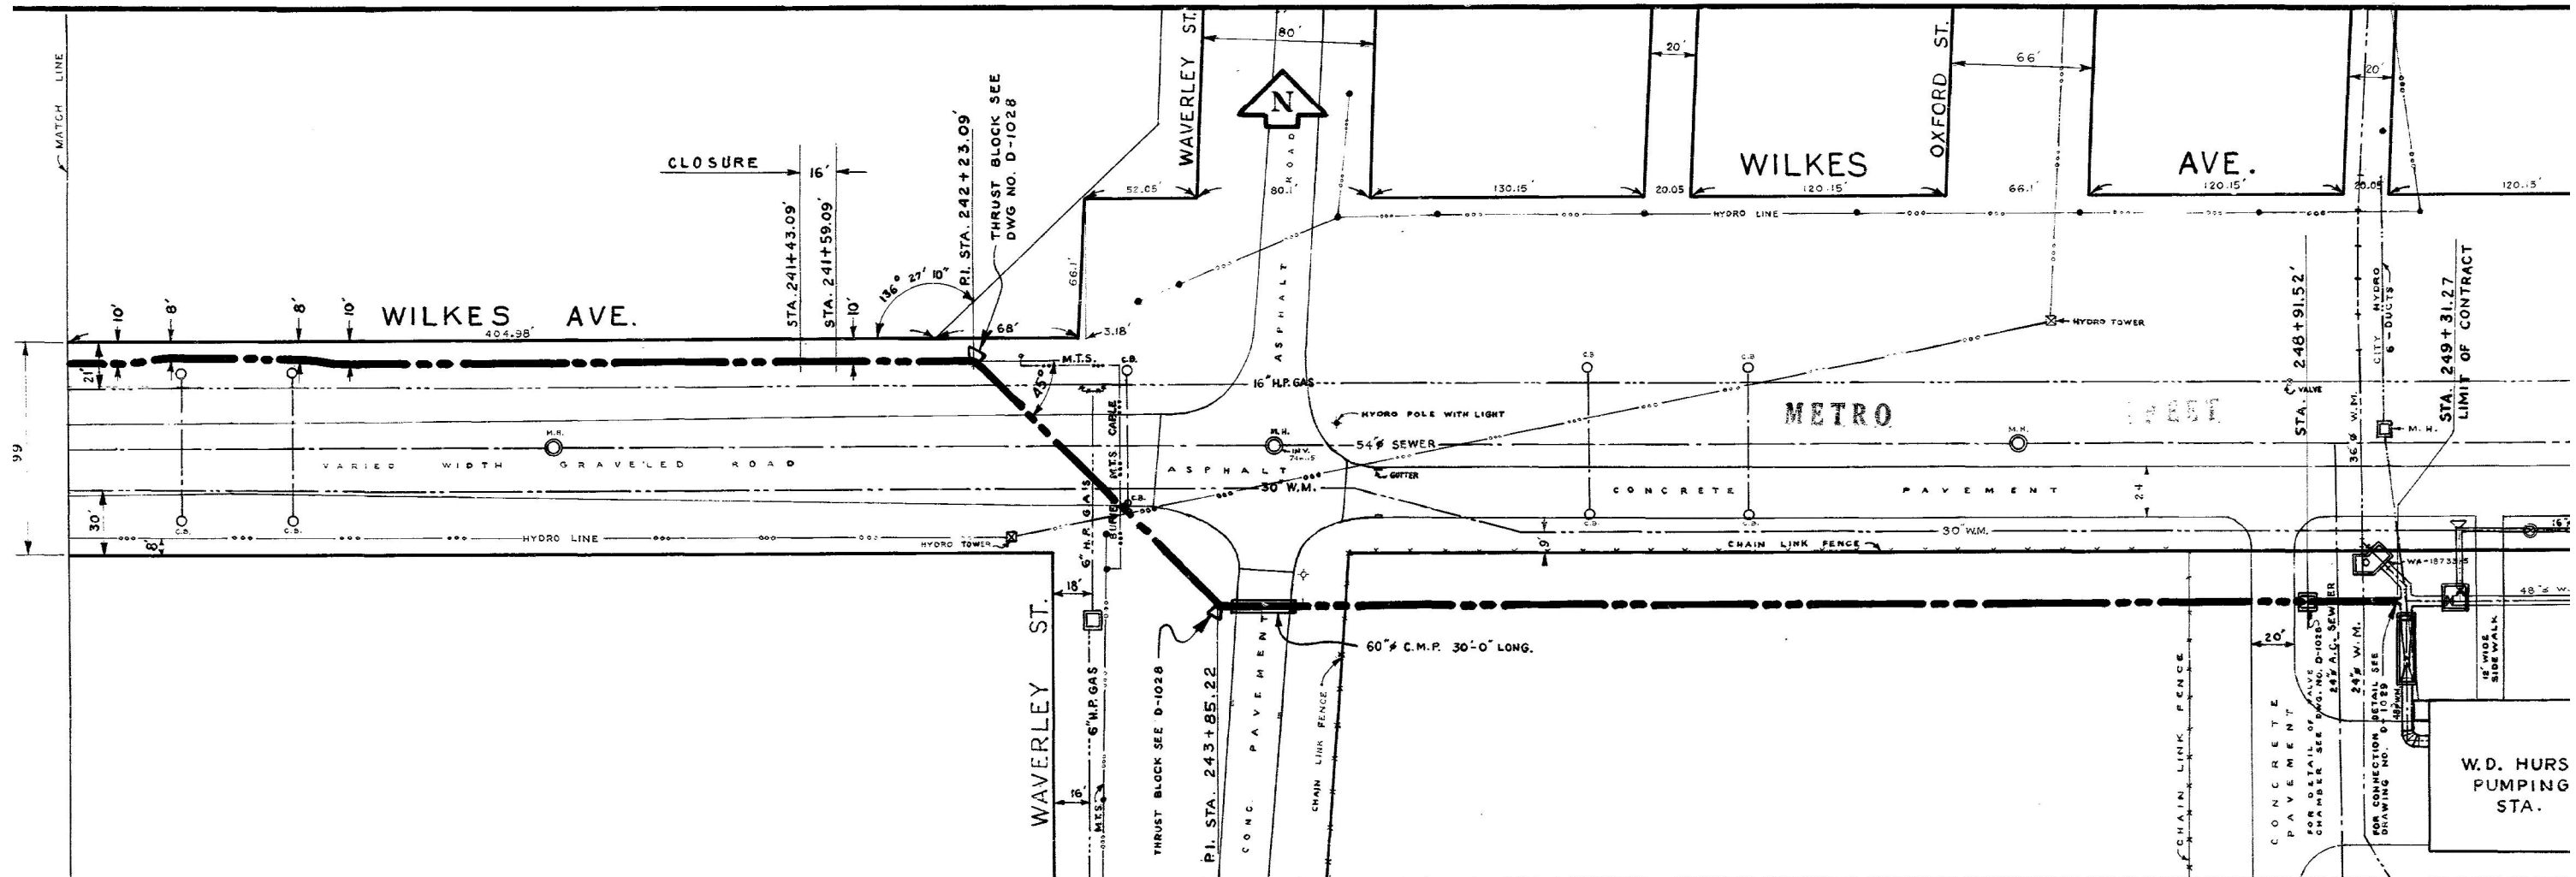

238+00	239+00	240+00	241+00	242+00	243+00	244+00	245+00	246+00	247+00	248+00	249+00
--------	--------	--------	--------	--------	--------	--------	--------	--------	--------	--------	--------


NO.	REVISION	DATE	BY
1	AS CONSTRUCTED	22/06/75	HS

THE METROPOLITAN CORPORATION OF GREATER WINNIPEG
WATERWORKS & WASTE DISPOSAL DIVISION
 A. PENNAN DIRECTOR

PROVINCE OF MANITOBA
A.C. MACKEY
 REGISTERED ENGINEER

WILKES AVE. FEEDERMAN III
 STA. 238+00 TO STA. 249+31.27

DES. DATE: 11/23/66
 DRN. H. BUXEBAUM
 ENG. DATE: 11/23/66
 ENG. J. B. BROWN
 APPROVED: A. Penman

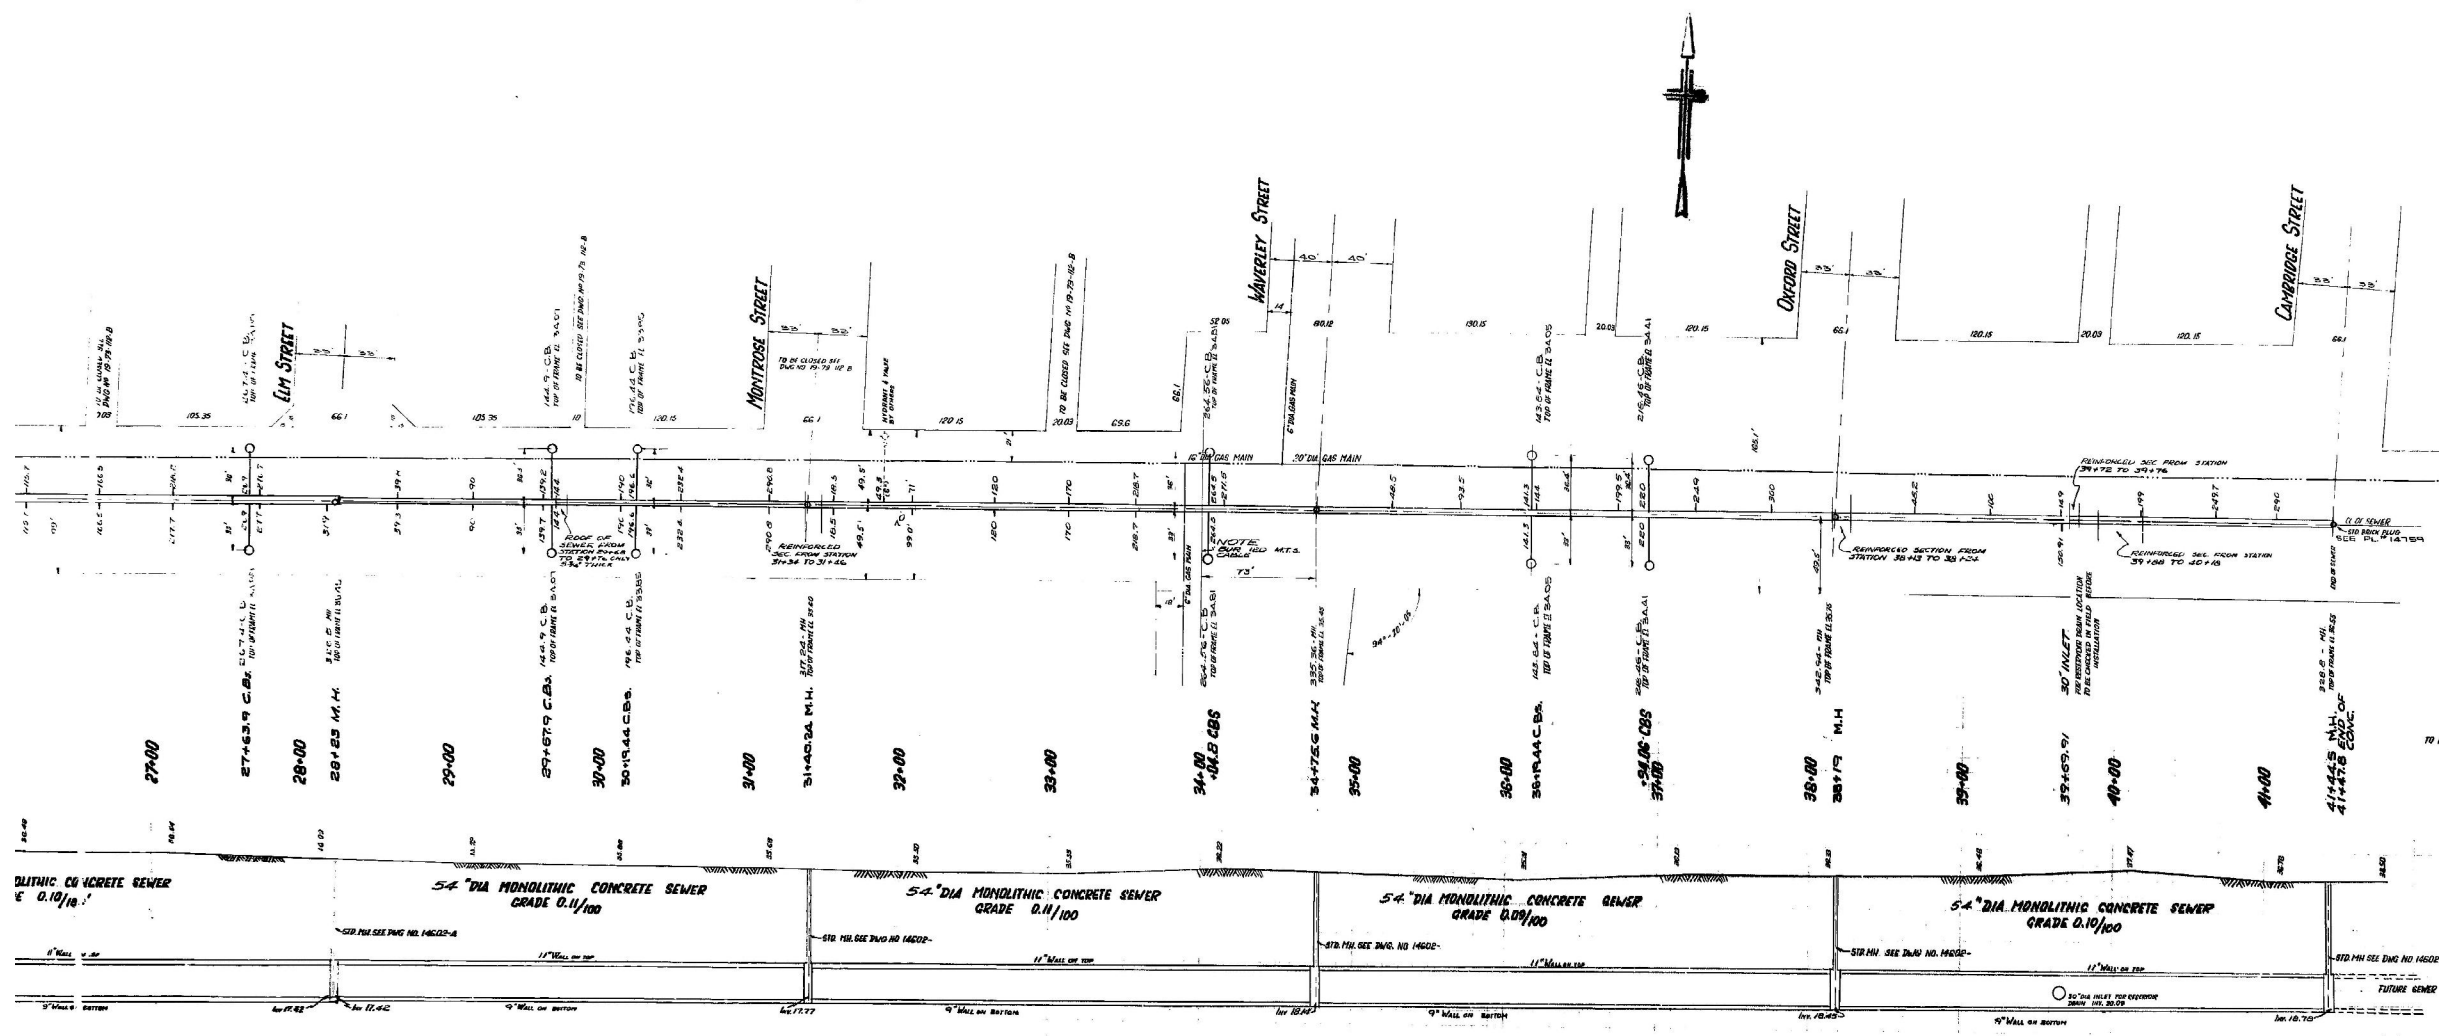

1. F.L.S. 10.00' CHANGE ON PLAN NUMBER 447
2. F.L.S. 10.00' AUGMENT ON PLAN NUMBER 447
3. F.L.S. 10.00' COR. TOP OF MANHOLE CHANGING 447

NOTE
ALL SERVICE CONNECTIONS
TO BE AS SHOWN UNLESS OTHERWISE SPECIFIED




NO.	DATE	BY	FOR
1	10-1-59	S. COLEMAN	
2	10-1-59	J. PHILLIPS	
3	10-1-59	H. BENOIT	
4	10-1-59	C. BENOIT	
5	10-1-59	J. ALLAN	
6	10-1-59	E. HOUGHTON	
7	10-1-59	E. FRENK	

W.O. #17269

MATERIAL LIST	
ITEM NO.	DESCRIPTION
1	54" DIA. MONOLITHIC CONCRETE SEWER
2	12" CONNECTIONS
3	12" CONNECTIONS
CITY OF WINNIPEG
ENGINEERING DEPARTMENT
W.O. #17269
54" DIA. MONOLITHIC CONCRETE SEWER
FROM LIN STREET TO CAMBRIDGE STREET
DRAWN BY: G.E. DATE: JANUARY 7, 1959
CHECKED BY: J.E. DATE: JANUARY 7, 1959
DESIGNED BY: J.E. DATE: JANUARY 7, 1959
SCALE: PLAN 1"=40'
PROPOSED: 1"=40'
VERT: 1"=10'
SC12046

29x

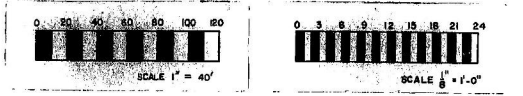

OF

