
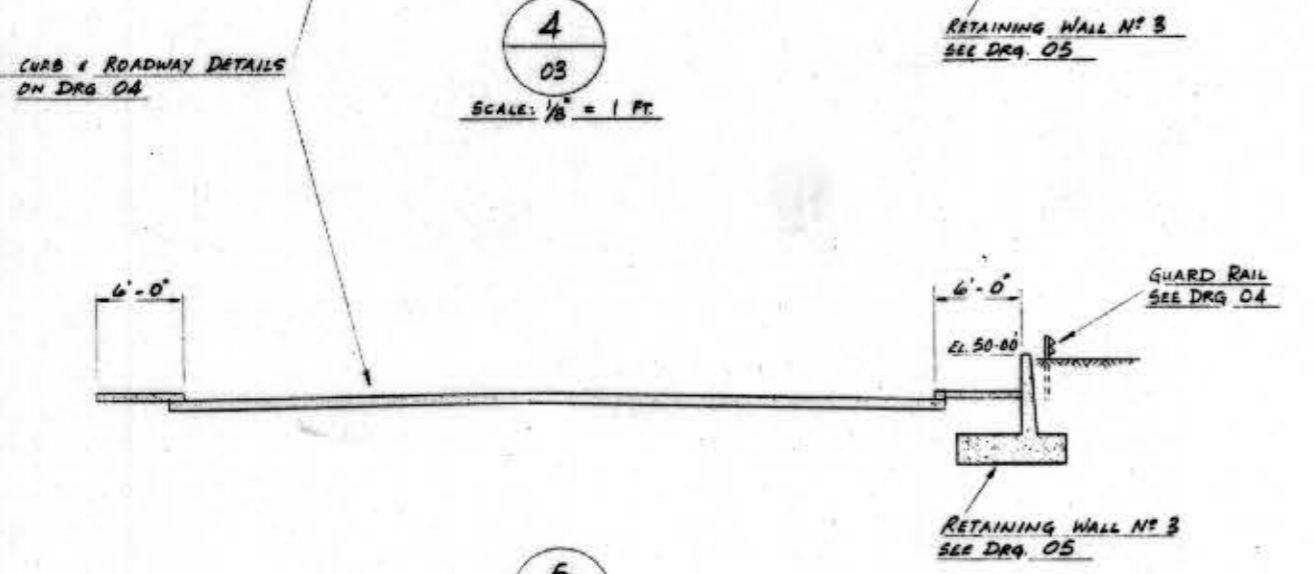


— PLAN —
SCALE: 1" = 20'

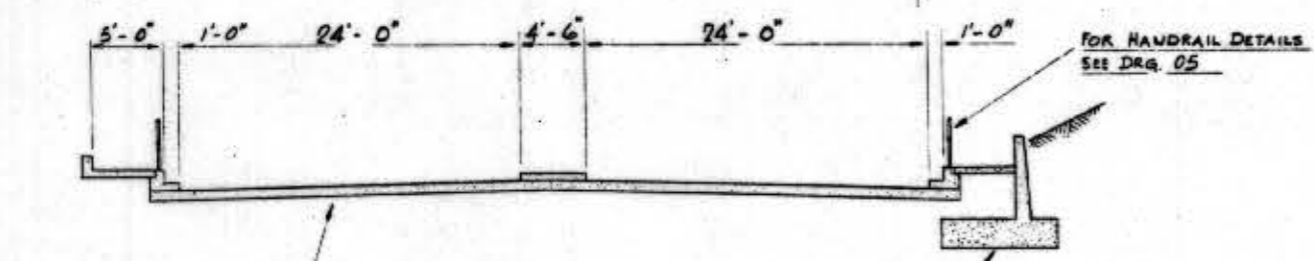

 DETAIL NUMBER REFERENCE DRG. NO.		HADDIN, DAVIS & BROWN (MANITOBA) LIMITED CONSULTING ENGINEERS WINNIPEG MANITOBA
 N.L. REID REGISTERED ENGINEER		GENERAL LAYOUT NORTH OF RAILWAY STRUCTURE
	L.S.K. AS CONSTRUCTED 28 142 M.G. W36 BULL. NO. 2 5 276 BY APP. REVISIONS DATE	SCALE AS SHOWN DATE AUG. 1928 DES. BY W. J. S. CHK. BY W. S.