



PLAN
SCALE: 1/8" = 1 FT.

NOTE: DESIGN LOAD PER PILE - 60 TONS

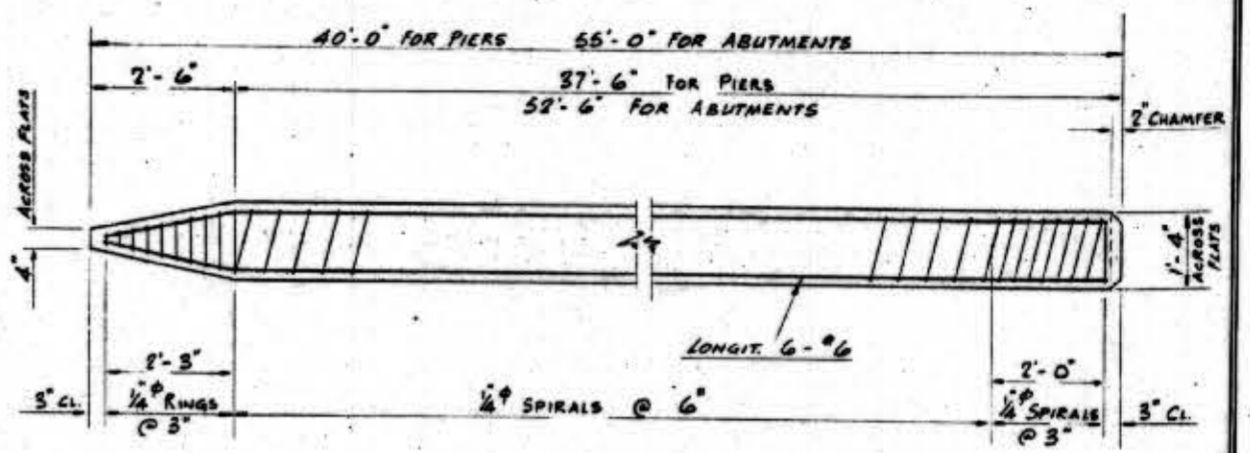


TYPICAL PILE DETAIL
SCALE: 1/2" = 1 FT.

TYPICAL SECTION
SCALE: 1" = 1 FT.

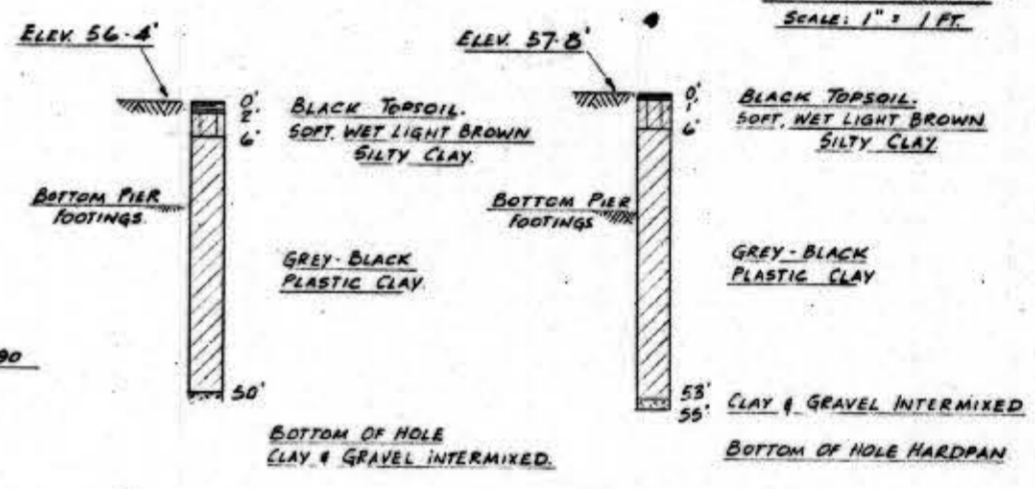


BORING NO. 1

BORING NO. 2

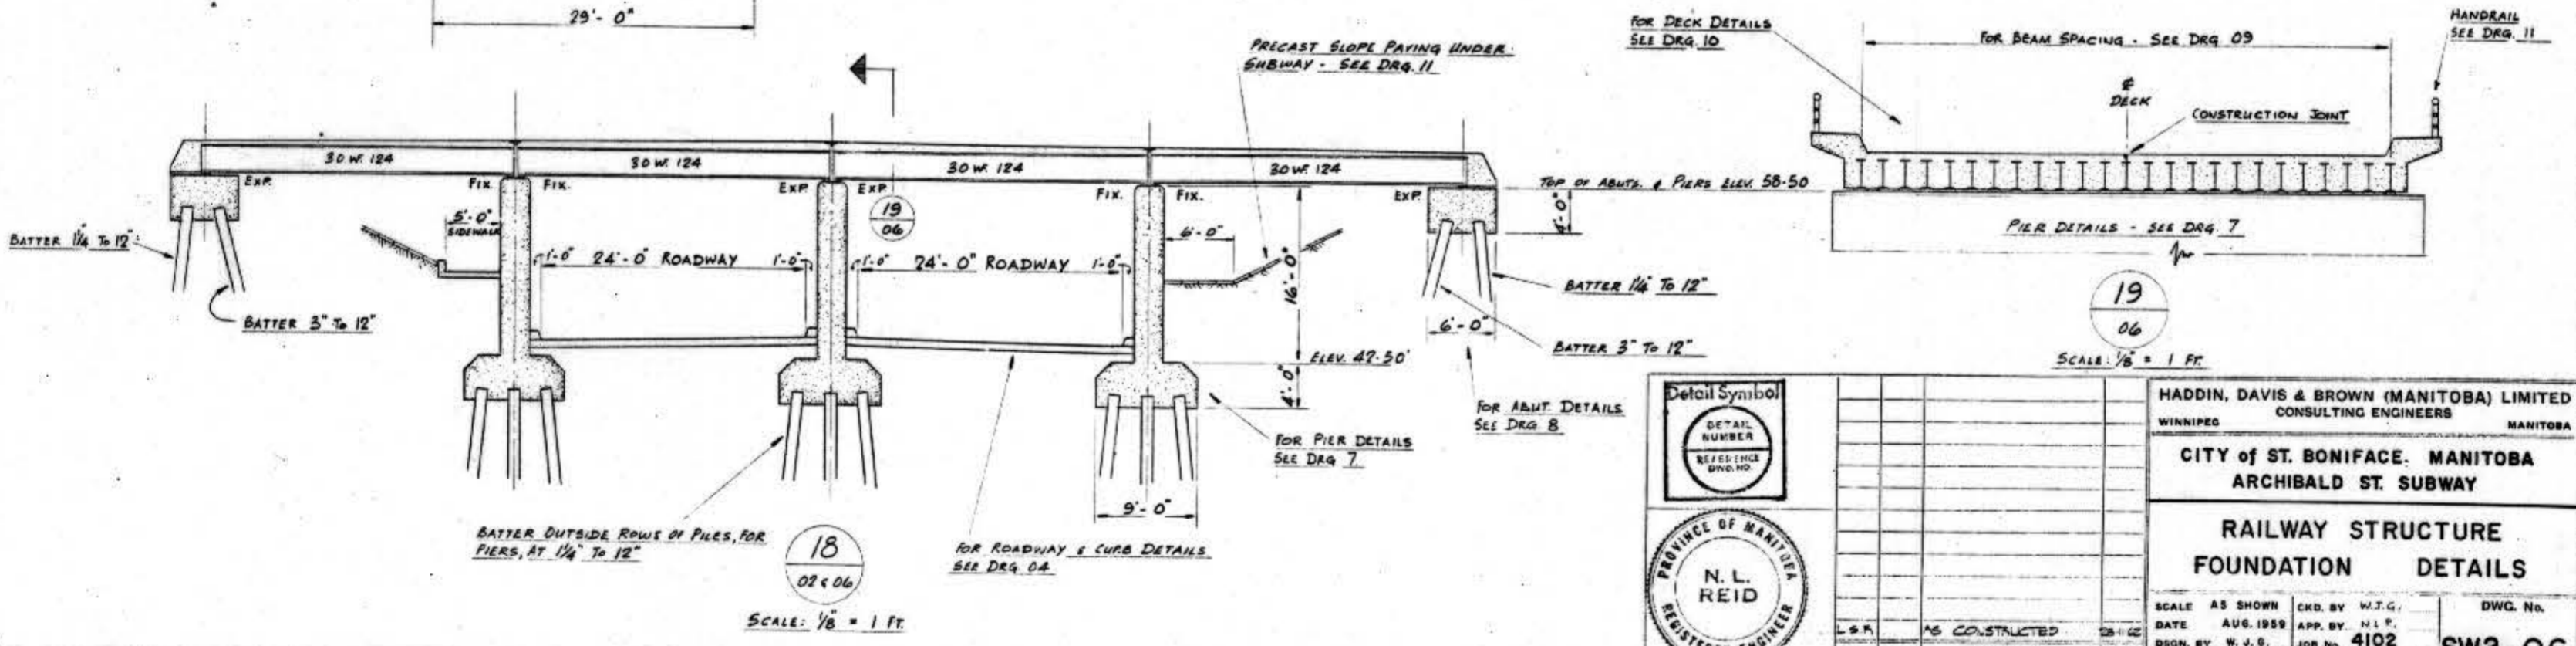

18
03 & 06
SCALE: 1/8" = 1 FT.

19
06
SCALE: 1/8" = 1 FT.

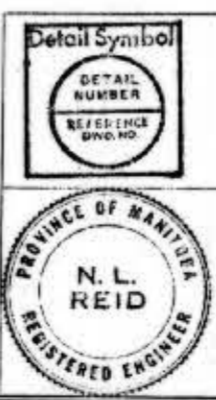

HADDIN, DAVIS & BROWN (MANITOBA) LIMITED CONSULTING ENGINEERS WINNIPEG MANITOBA	
CITY OF ST. BONIFACE, MANITOBA ARCHIBALD ST. SUBWAY	
RAILWAY STRUCTURE FOUNDATION DETAILS	
SCALE AS SHOWN DATE AUG 1958 DES. BY W. J. G. DRN. BY W. G.	CKD. BY W. J. G. APP. BY H. P. P. JOB No. 4102 SHEET No. 6 OF 22
AS CONSTRUCTED REVISIONS DATE	DWG. No. SW2-06

