


1
2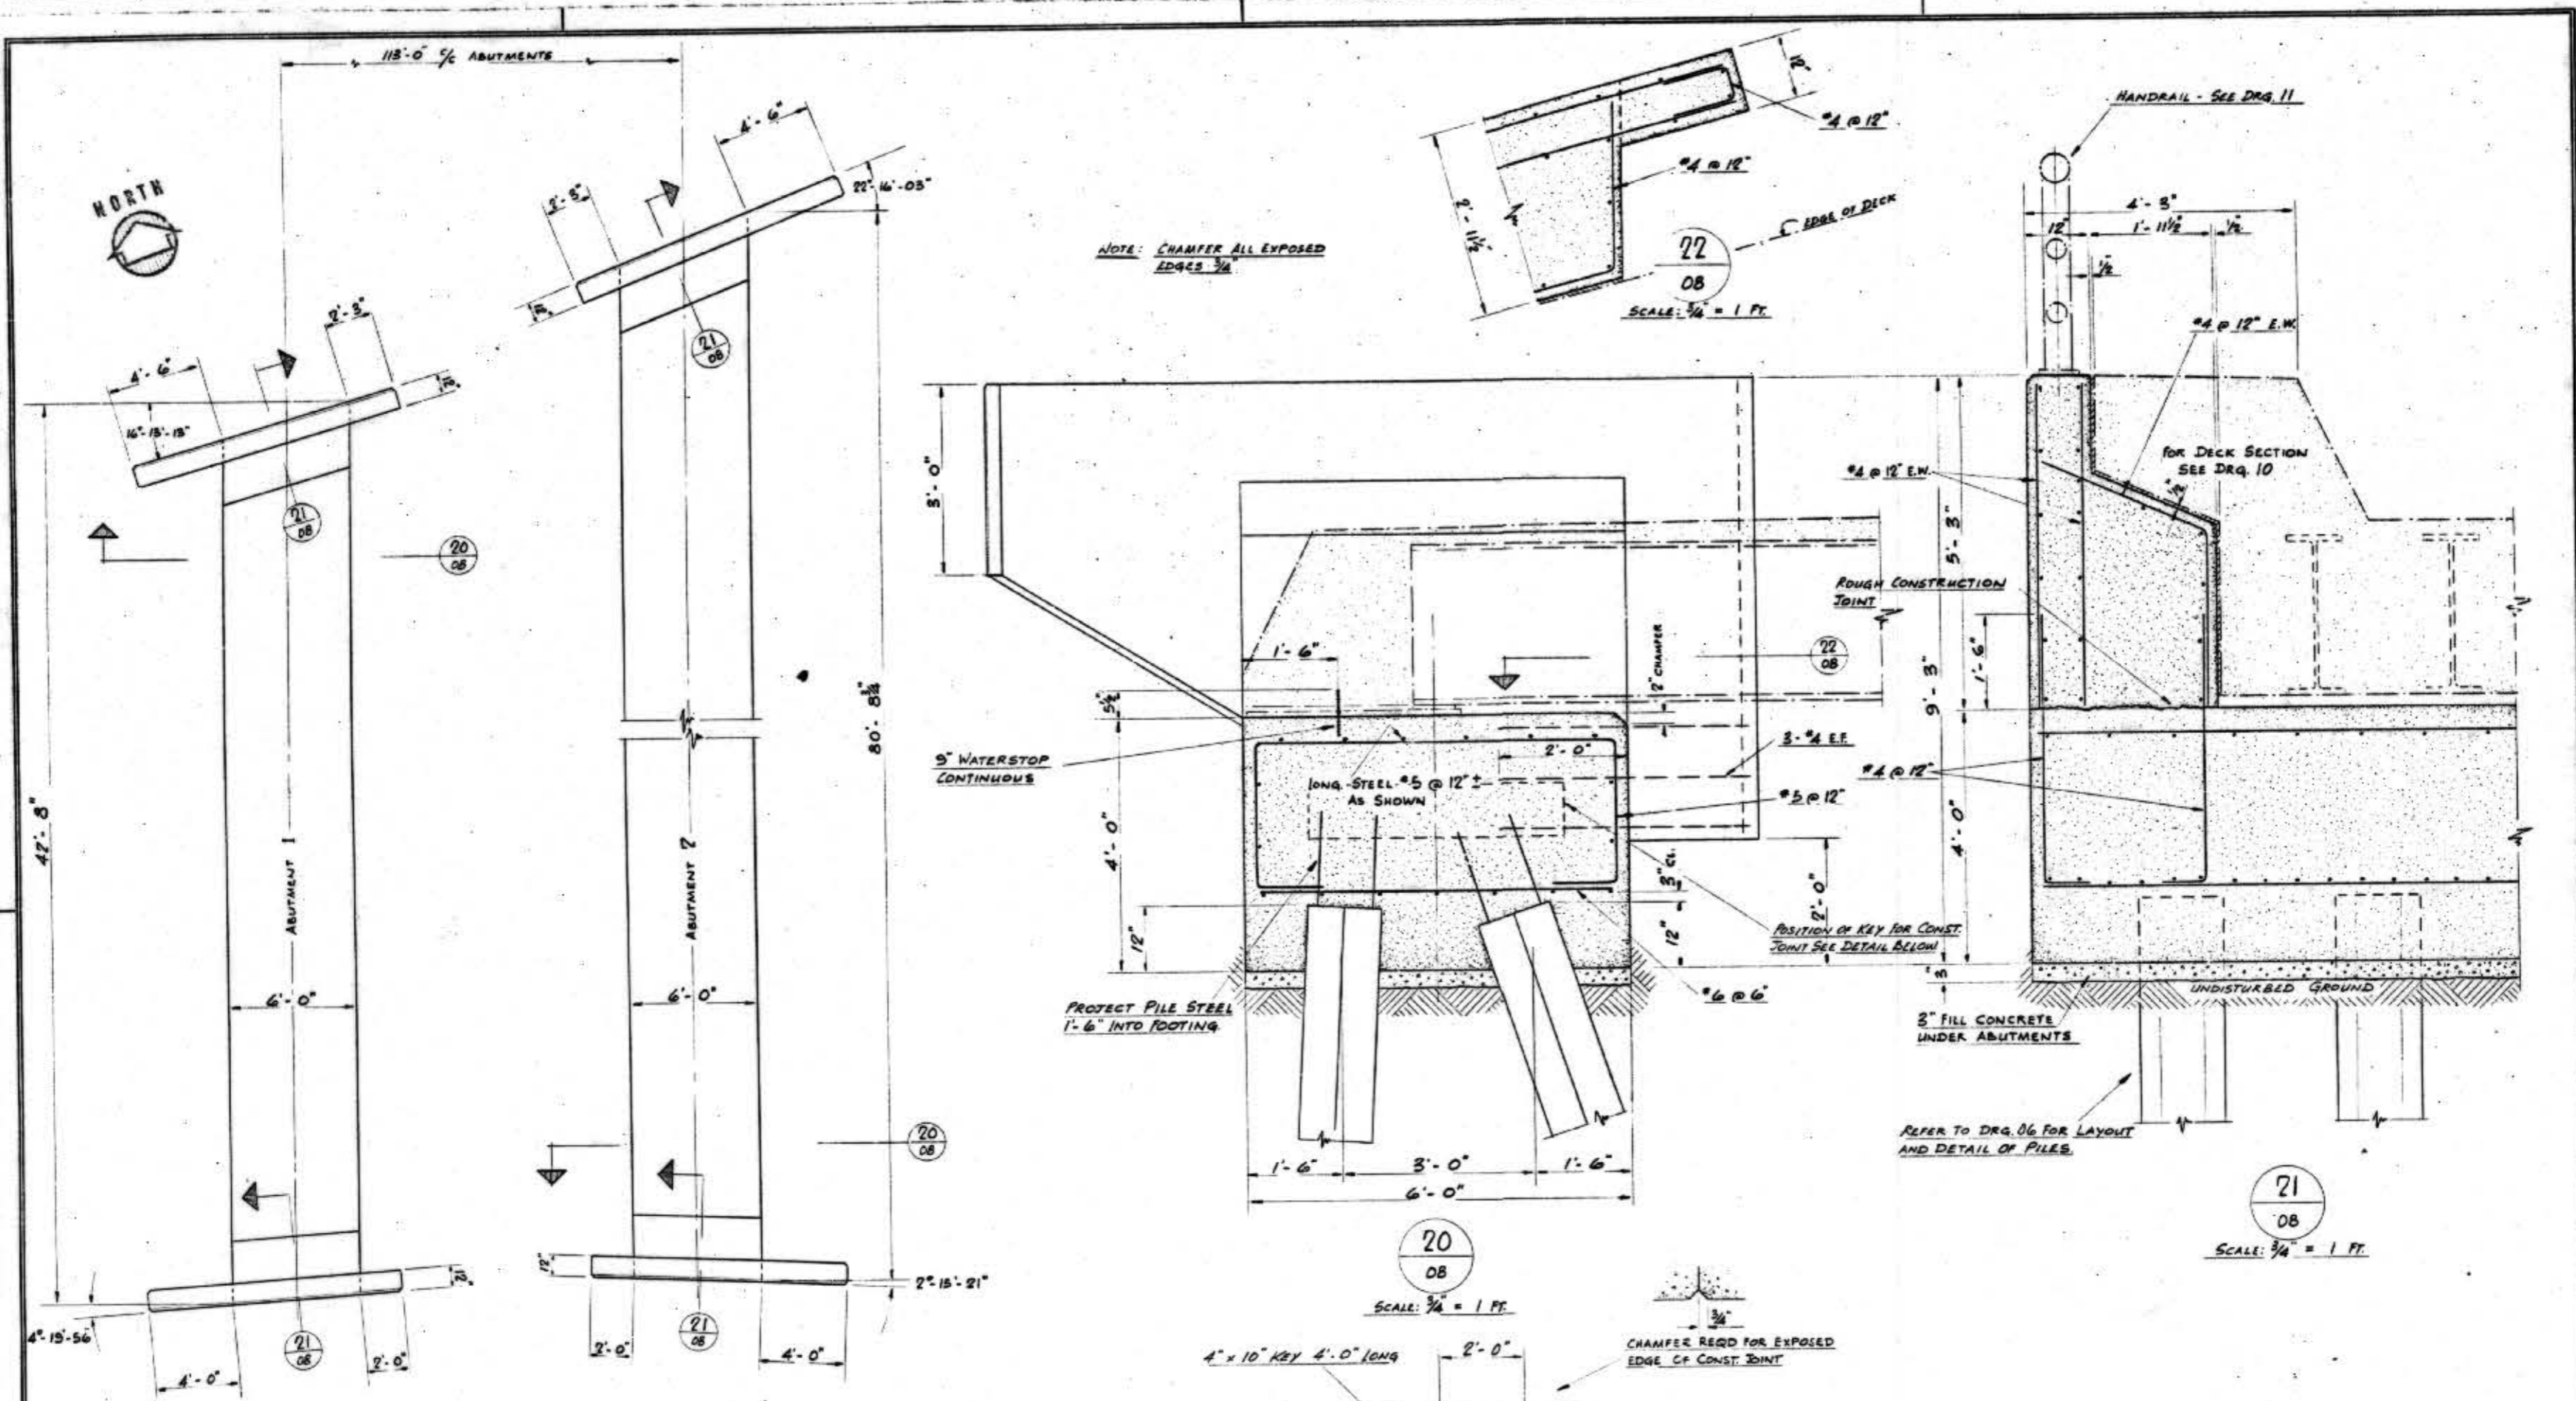
— PLAN OF ABUTMENTS —
SCALE: 1/4" = 1 FT.
LAYOUT OF PILES FOR ABUTMENTS SHOWN ON DRG. 06

NOTE: CHAMFER ALL EXPOSED EDGES 3/8"

20
OB
SCALE: 3/4" = 1 FT.

21
OB
SCALE: 3/4" = 1 FT.

NOTE: CONSTRUCTION JOINT TO BE PLACED TO CLEAR ANCHOR BOLTS (6" MIN CLEAR)

— CONSTRUCTION JOINT —
SCALE: 1/2" = 1 FT.

Detail Symbol DETAIL NUMBER REFERENCE DIV. NO.									
HADDIN, DAVIS & BROWN (MANITOBA) LIMITED CONSULTING ENGINEERS WINNIPEG MANITOBA									
CITY OF ST BONIFACE, MANITOBA ARCHIBALD ST. SUBWAY									
RAILWAY STRUCTURE ABUTMENT DETAILS									
SCALE AS SHOWN DATE AUG. 1959		CRD. BY W. J. G. APP. BY W. J. G.		DWG. No. 4102		SHEET No. 8 OF 22 SW2-08			
L.S.R. BY	AS CONSTRUCTED	REVISIONS	DATE	DRN. BY W. S.	DESIGNED BY W. J. G.	CHECKED BY W. J. G.	APPROVED BY W. J. G.	DATE	SHEET No. 8 OF 22

