




- PLAN -
SCALE: 1" = 100'

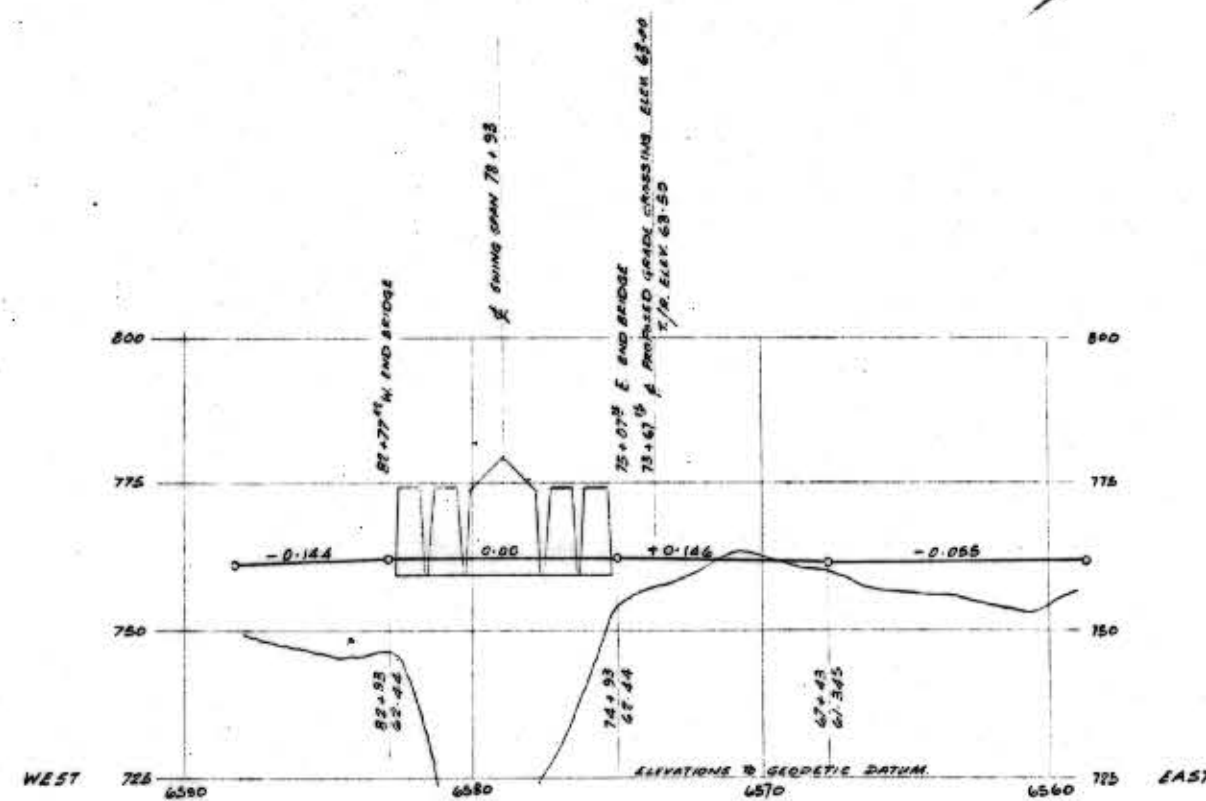

PROFILE OF RAILWAY
KEEWATIN SUBDIVISION
MILE 124.24 TO MILE
SCALE: 1" = 400' HORIZ
1" = 20' VERT

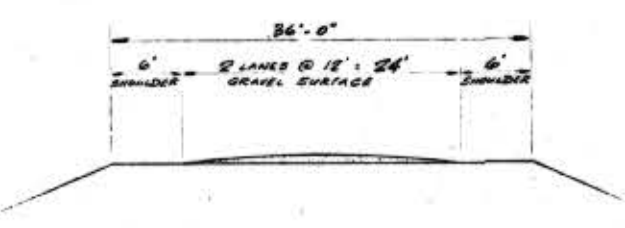

TYPICAL CROSS SECTION
OF
PROPOSED TEMPORARY GRADE CROSSING
SCALE: 1" = 10'

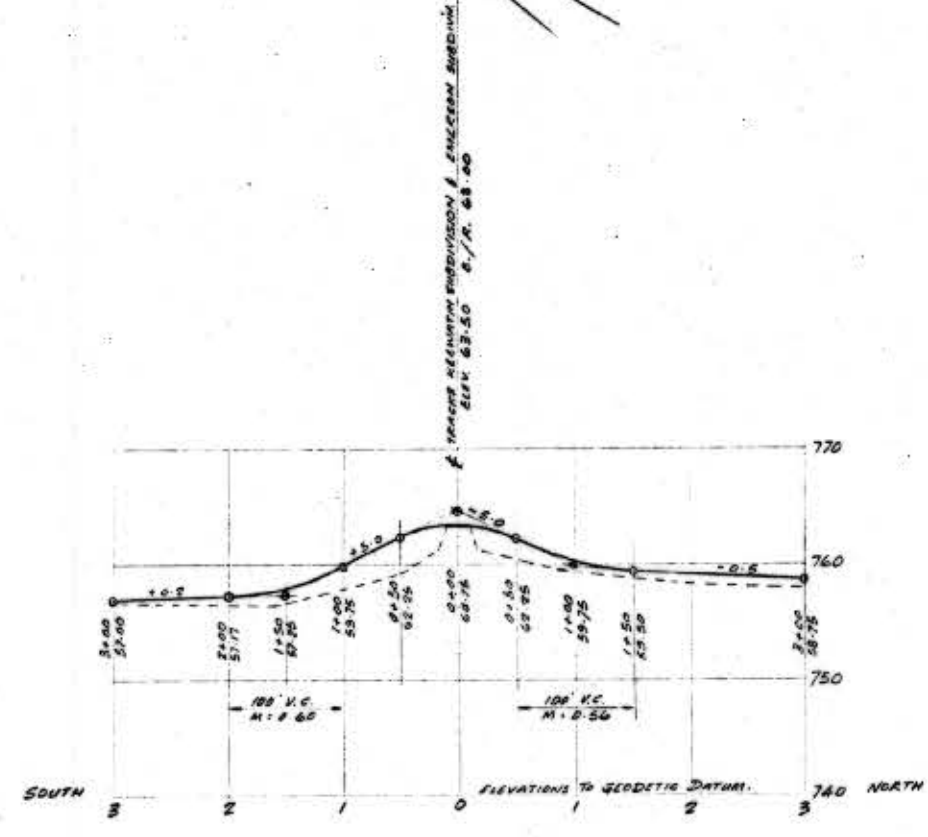

PROFILE OF PROPOSED GRADE CROSSING
SCALE: 1" = 100' HORIZ
1" = 10' VERT

| | | | |
|--|----------------|----------------------|----------------------|
| HADDIN, DAVIS & BROWN (MANITOBA) LIMITED CONSULTING ENGINEERS WINNIPEG MANITOBA | | | |
| CITY OF ST. BONIFACE, MANITOBA ARCHIBALD ST. SUBWAY | | | |
| PLAN PROFILE & SIGHT LINES OF PROPOSED TEMPORARY GRADE CROSSING C.P.R. MILE 124.54 KEEWATIN SUBDIVISION | | | |
| SCALE: AS SHOWN | CHKD. BY: | DATE: MAR 1950 | DWG. No. SW 2-23 |
| BY: APP | AS CONSTRUCTED | DATE: 25-1-50 | APP. BY: [Signature] |
| REVISIONS | DATE | DRN. BY: [Signature] | SHEET No. OF |

