

GENERAL LAYOUT PLAN

PROPOSED WORKS	REFERENCE DRAWING NUMBER
1. REMOVED CURB AND SIDEWALK. INSTALLED TEMPORARY 75 MM ASPHALT CONCRETE PAVEMENT AND SIDEWALK USED DURING STAGE 1 TRAFFIC DIVERSION.	U205-85-02
2. REMOVED EXISTING CONCRETE BOULEVARD AND MEDIAN SLAB.	U205-85-03, 04 & 05
3. REMOVED EXISTING PAVEMENT AND CONSTRUCTED NEW 230 MM CONCRETE PAVEMENT.	U205-85-03, 04 & 05
4. REMOVED EXISTING CONCRETE SIDEWALK AND CONSTRUCTED NEW UNDERPASS SIDEWALK SLAB C/W SIDEWALK RETAINING WALL, PARAPET AND ALUMINUM PEDESTRIAN HANDRAIL.	U205-85-06
5. REMOVED EXISTING ASPHALT OVERLAY AND RESURFACED WITH NEW ASPHALT OVERLAY.	U205-85-03 & 05
6. INSTALLED ALUMINUM PEDESTRIAN HANDRAIL.	U205-85-06, 07 & 08
7. INSTALLED BALANCED ALUMINUM TRAFFIC SHOULDER BARRIER (FOUR LOCATIONS).	U205-85-10 & 11
8. CONSTRUCTED CONCRETE MEDIAN TRAFFIC BARRIER.	U205-85-09
9. INSTALLED NEW GUARDRAIL ENERGY-ABSORBING TERMINAL (G.R.E.A.T.) BARRIER (TWO LOCATIONS).	U205-85-14 & 15
10. MODIFICATIONS TO DECK DRAINS, DRAINAGE CHANNEL AND SLOPE PROTECTION.	U205-85-12 & 13
11. RELOCATED EXISTING FLEX-BEAM GUARDRAIL.	U205-85-03 & 04
12. CONCRETE JOINT AND SLAB RENEWAL.	U205-85-03 & 05
13. NEW CURB AND SIDEWALK OR CURB AND SIDEWALK RENEWAL.	U205-85-03 & 05
14. REGRADED EMBANKMENT TO SUIT.	U205-85-03, 04 & 05
15. REMOVED EXISTING RETAINING WALL.	U205-85-04, 05 & 16
16. (A) WATERMAIN RENEWAL (SECTION A OF SCHEDULE OF PRICES) (B) WATERMAIN RENEWAL (SECTION B OF SCHEDULE OF PRICES)	U205-85-03, 04 & 05
17. INSTALLED PERFORATED PLASTIC SUB-BASE DRAIN C/W POLYESTER FILTER SOCK.	U205-85-03, 04 & 05


DRAWING LIST

U205-85-C1	COVER SHEET
U205-85-01	LOCATION OF PROPOSED WORKS AND DRAWING LIST
U205-85-02	GEOMETRIC LAYOUT AND CONSTRUCTION STAGING
U205-85-03	RUE ARCHIBALD STA. 0+00 TO STA. 1+40
U205-85-04	RUE ARCHIBALD/WATT STREET STA. 1+40 TO STA. 2+70
U205-85-05	WATT STREET STA. 2+70 TO STA. 4+00
U205-85-06	UNDERPASS SIDEWALK - LAYOUT AND DETAILS
U205-85-07	ALUMINUM PEDESTRIAN HANDRAIL - LAYOUT
U205-85-08	ALUMINUM PEDESTRIAN HANDRAIL - DETAILS
U205-85-09	CONCRETE MEDIAN TRAFFIC BARRIER - LAYOUT AND DETAILS
U205-85-10	BALANCED ALUMINUM SHOULDER BARRIERS - LAYOUT
U205-85-11	BALANCED ALUMINUM SHOULDER BARRIER - STANDARD DETAILS
U205-85-12	SLOPE PROTECTION AND DRAINAGE WORKS
U205-85-13	DRAINAGE DETAILS
U205-85-14	GUARDRAIL ENERGY ABSORBING TERMINAL (G.R.E.A.T.) BARRIER FOR USE WITH CONCRETE MEDIAN TRAFFIC BARRIER SHEET 1 OF 2
U205-85-15	GUARDRAIL ENERGY ABSORBING TERMINAL (G.R.E.A.T.) BARRIER FOR USE WITH CONCRETE MEDIAN TRAFFIC BARRIER SHEET 2 OF 2
U205-85-16	PAVEMENT DETAILS
U205-85-17	REINFORCING STEEL SCHEDULE

B-5539-1

REID, CROWTHER & PARTNERS LIMITED  
WINNIPEG  
**AS CONSTRUCTED**  
SIG: *[Signature]* DATE: 85-12-18

NO.	REVISIONS	DATE	APP.
1.	AS CONSTRUCTED	OCT 85	<i>[Signature]</i>

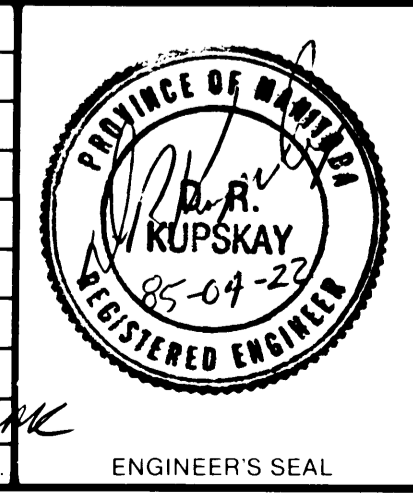

**Reid Crowther**  
Reid Crowther & Partners Ltd.  
Engineers-Planners-Scientists

DESIGNED BY: D.R.K. \ P.A.L.  
DRAWN BY: P.A.L.  
CHECKED BY: *[Signature]* DATE: 85 04 12  
JOB NO. 60709-02  
APPROVED BY: *[Signature]* DATE: 85/04/22

**THE CITY OF WINNIPEG**  
WORKS & OPERATIONS DIVISION  
STREETS & TRANSPORTATION DEPARTMENT

**RUE ARCHIBALD UNDERPASS**  
C.P.R. KEEWATIN SUBDIVISION  
PAVEMENT RECONSTRUCTION AND RELATED WORKS  
LOCATION OF PROPOSED WORKS AND DRAWING LIST

AUTHORIZED BY: *[Signature]* P. Eng. 1985-04-30  
ACCEPTED BY: *[Signature]* M.S. 04-30  
SCALE: 1:500  
DRAWING NO. U205-85-01