


CURVE DATA								
NO.	STATION	BC	EC	Δ	Dc	R	T	Lc
1.	0+22.473	0+53.488	7°06' 44.3"	6°59' 22.98"	249.850	15.527	31.015	
2.	0+86.967	1+30.432	7°06' 44.3"	4°59' 15.0"	350.150	21.761	43.465	
3.	2+37.300	3+00.697	7°08' 53.5"	3°26' 12.2"	508.150	31.739	63.397	
4.	3+00.697	3+77.945	7°08' 53.5"	2°49' 13.8"	619.173	38.674	77.248	
5.	0+26.585	0+66.383	7°06' 44.3"	5°26' 49.4"	320.609	19.925	39.798	
6.	0+87.978	1+30.432	7°06' 44.3"	5°06' 22.9"	342.000	21.254	42.454	
7.	2+37.300	2+99.680	7°08' 53.5"	3°29' 33.9"	500.000	31.230	62.380	
8.	2+99.680	3+62.060	7°08' 53.5"	3°29' 33.9"	500.000	31.230	62.380	
9.	0+42.550	0+67.395	7°06' 44.3"	8°43' 31.2"	200.150	12.439	24.845	
10.	0+88.990	1+30.432	7°06' 44.3"	5°13' 51.7"	333.850	20.748	41.442	
11.	2+37.300	2+98.663	7°08' 53.5"	3°33' 02.3"	491.850	30.721	61.363	
12.	2+98.663	3+39.897	6°08' 53.5"	4°32' 41.1"	384.262	20.637	41.234	
13.	3+46.377	3+57.622	10°02' 23.0"	27°06' 39.3"	644.16	5.660	11.245	

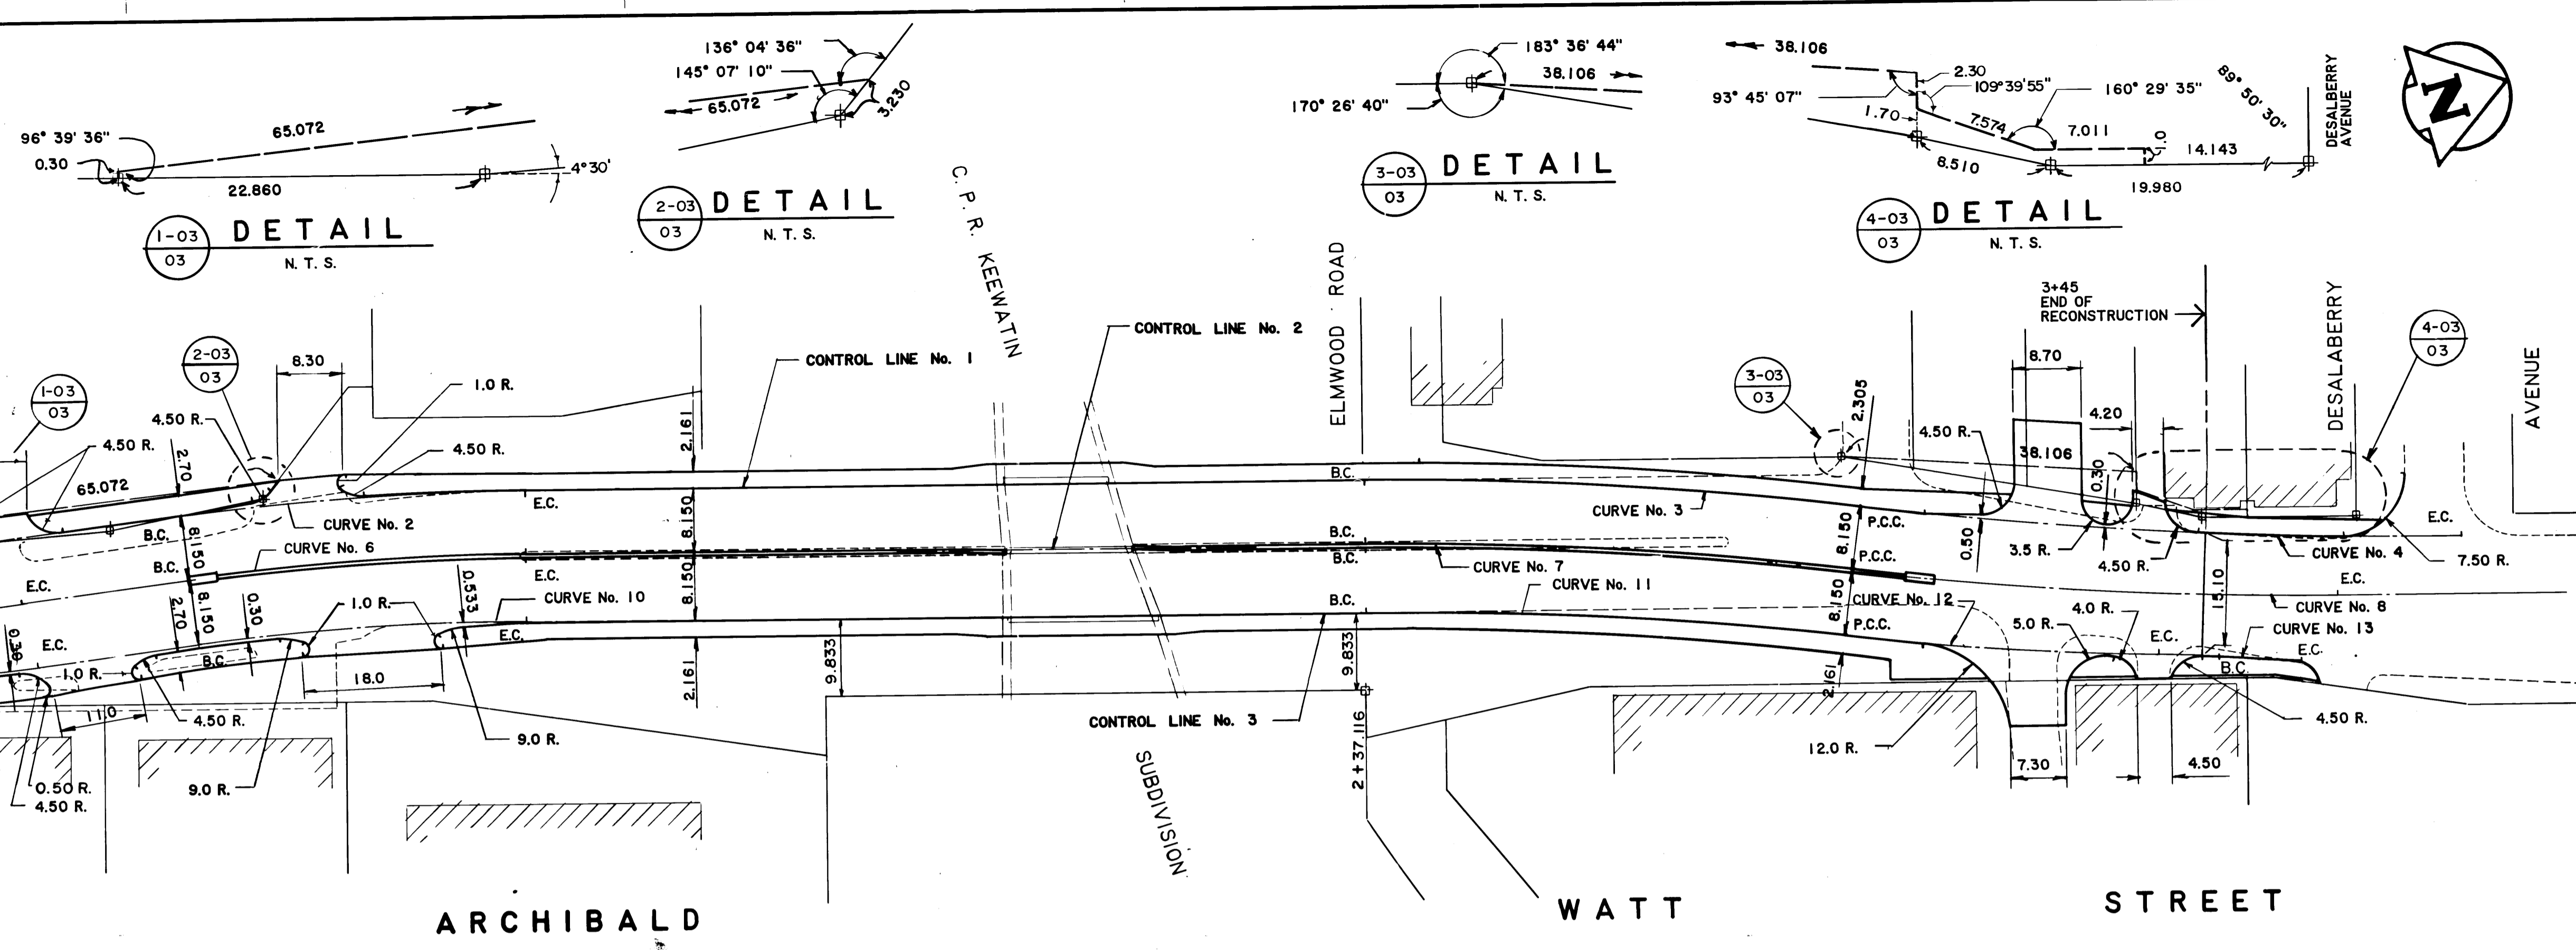

NOTE: STATIONS SHOWN REFER TO RESPECTIVE CONTROL LINES
 CONTROL LINE NO. 1 - BACK OF WEST CURB
 CONTROL LINE NO. 2 - CENTRE LINE
 CONTROL LINE NO. 3 - BACK OF EAST CURB



GENERAL LAYOUT PLAN - GEOMETRICS -

REID, CROWTHER & PARTNERS LIMITED
 WINNIPEG
AS CONSTRUCTED
 DATE 85-12-18


A-B C
 A. DETAIL NO.
 B. DRAWING WHERE DETAIL SHOWN
 C. DRAWING WHERE DETAIL TAKEN

STAGING SEQUENCE

- STAGE 1: RECONSTRUCTION OF EAST SIDE, AFTER TEMPORARY LANE WIDENING AS PER SECTION A-A, AND MEDIAN SLAB REMOVAL. TRAFFIC DIVERTED TO WEST SIDE, ONE LANE EACH DIRECTION.
- STAGE 2: RECONSTRUCTION OF WEST SIDE. TRAFFIC DIVERTED TO EAST SIDE, ONE LANE EACH DIRECTION.
- STAGE 3: CONSTRUCTION OF CONCRETE BARRIERS. MEDIAN LANES CLOSED ON EACH SIDE, ONE LANE OF TRAFFIC EACH DIRECTION USING RESPECTIVE CURB LANES.

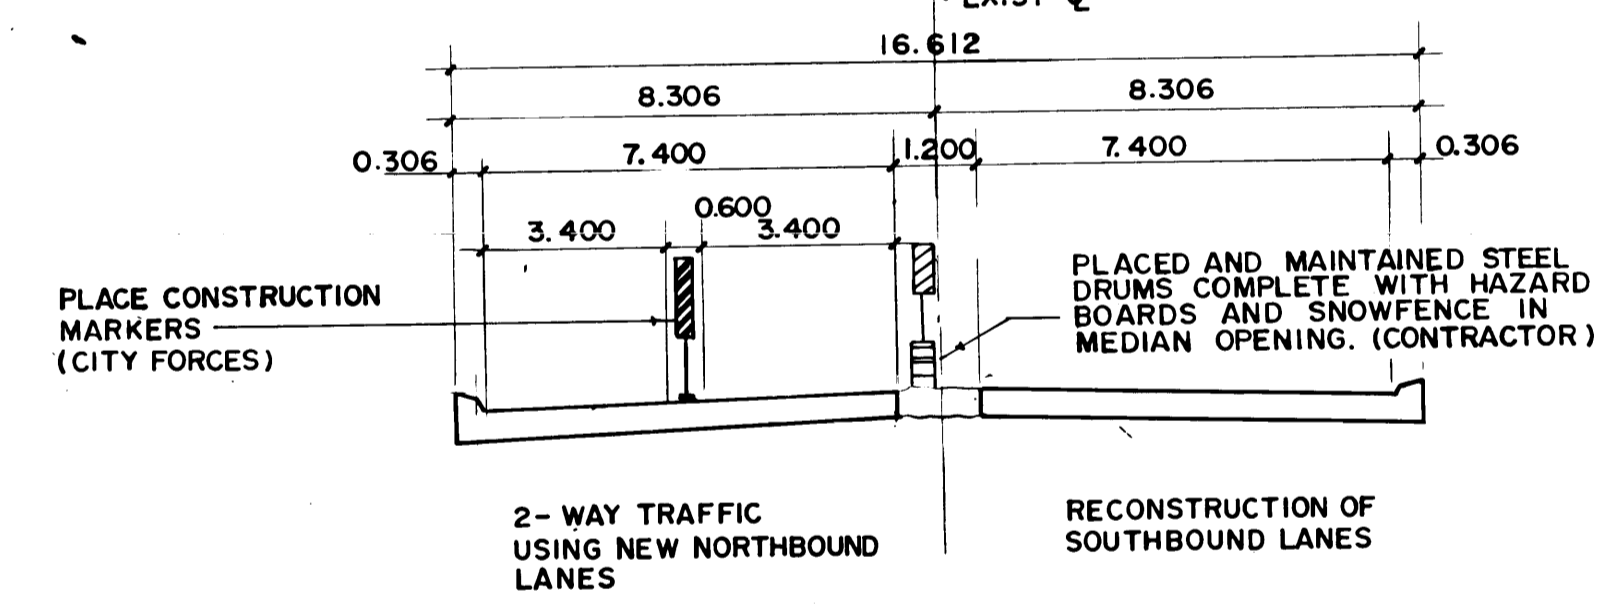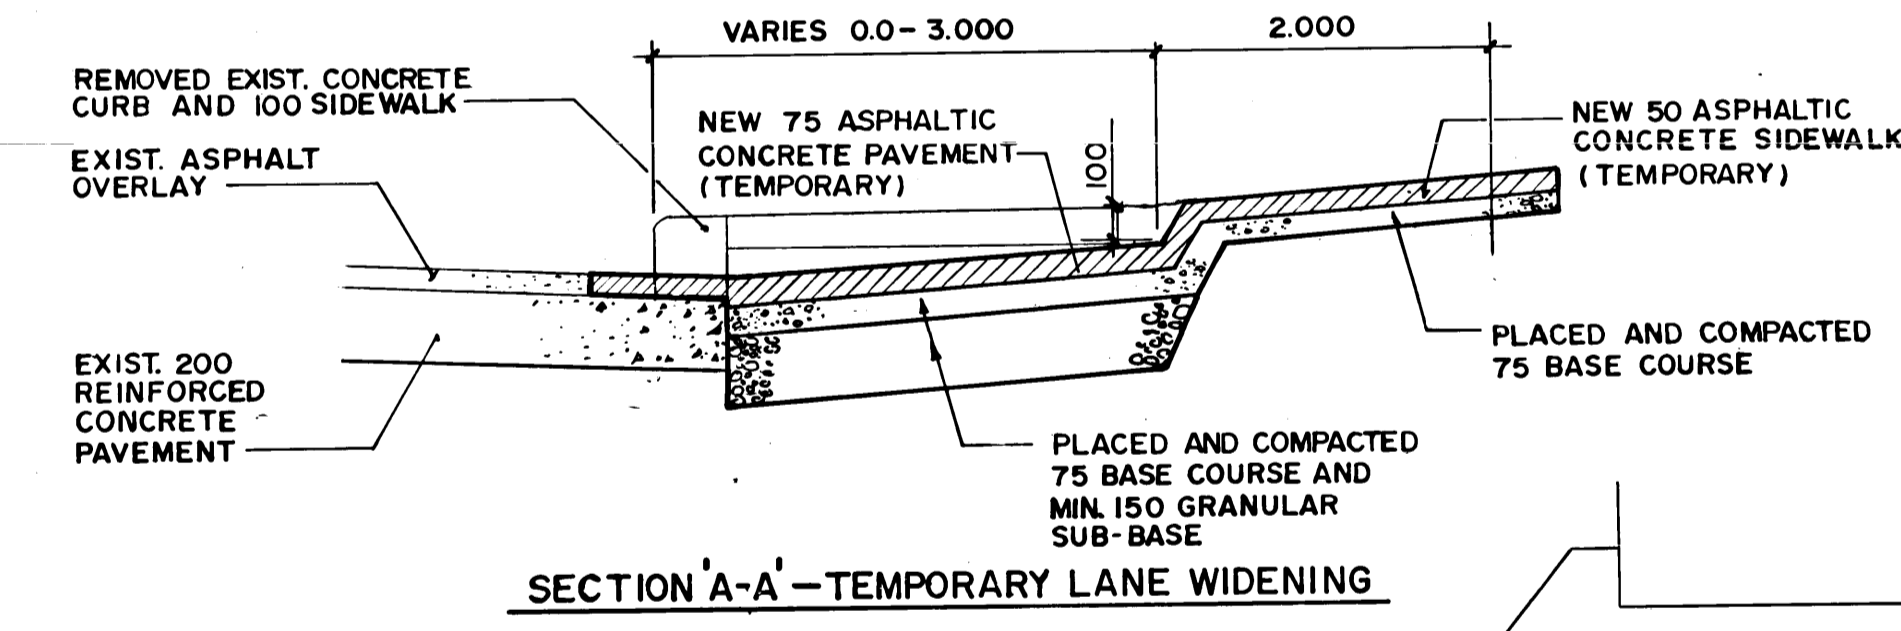

STAGING PLAN

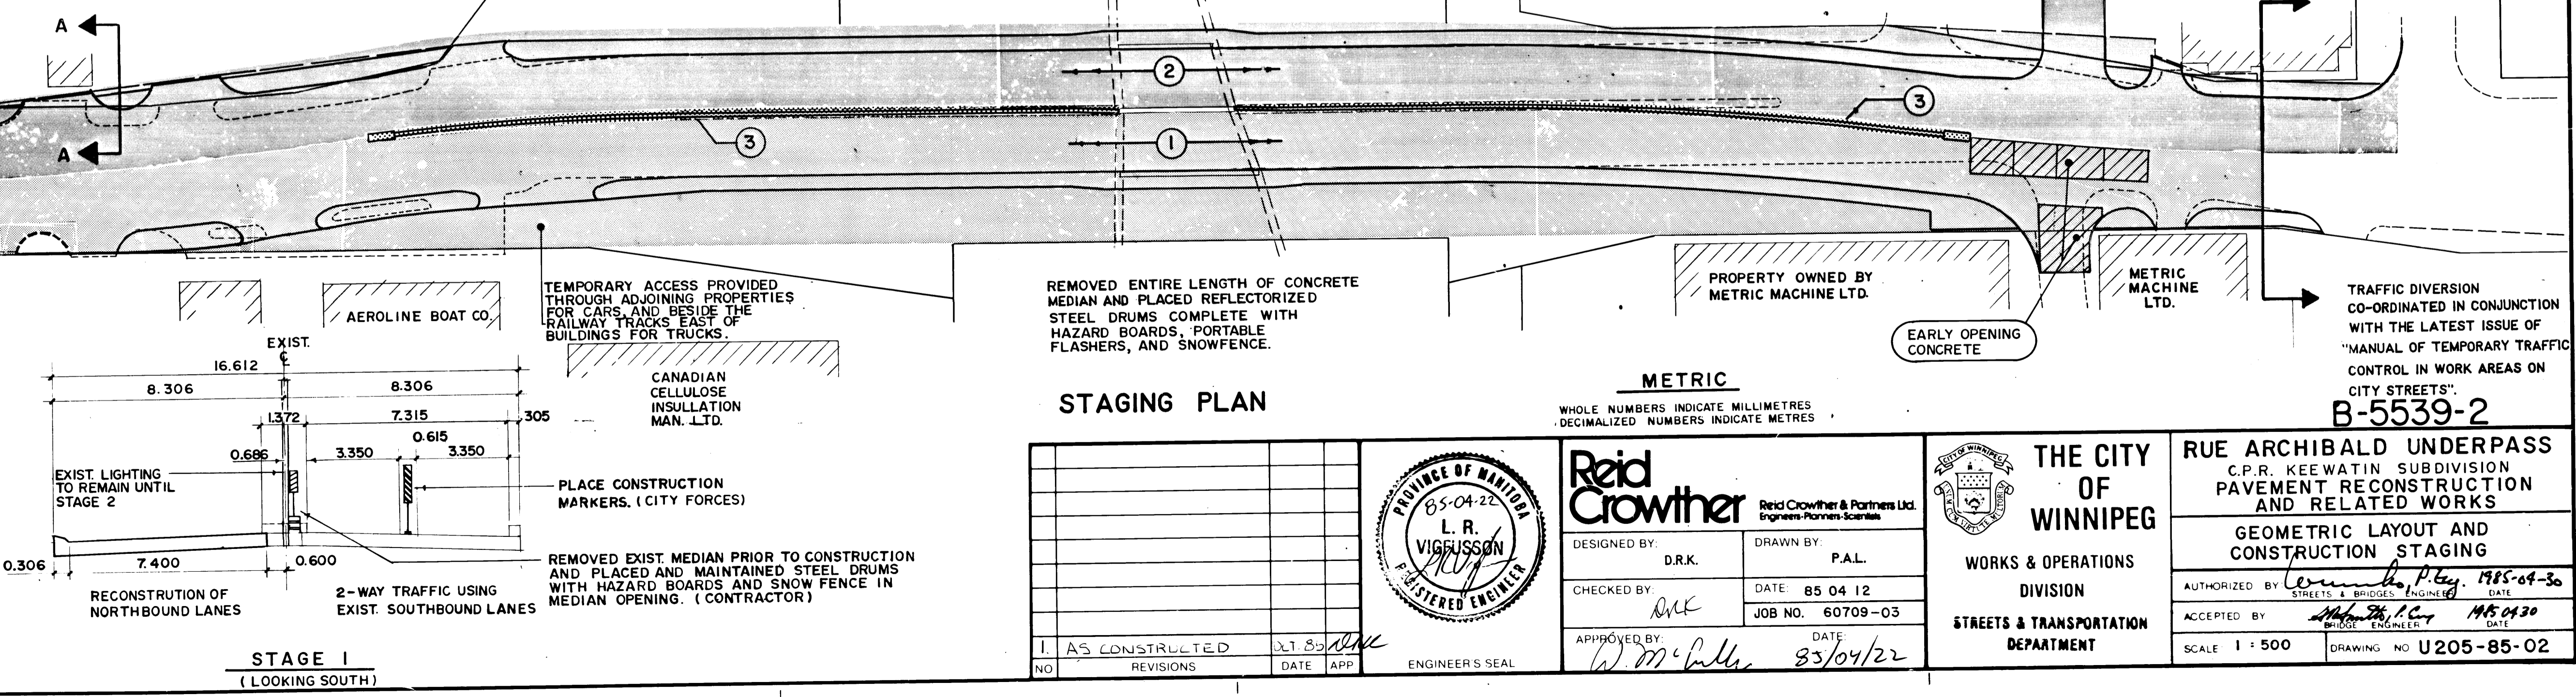

NO.	REVISIONS	DATE	APP.
1.	AS CONSTRUCTED	31.85	W.C.



Reid Crowther
 Reid Crowther & Partners Ltd.
 Engineers-Planners-Scientists

DESIGNED BY: D.R.K. DRAWN BY: P.A.L.
 CHECKED BY: [Signature] DATE: 85 04 12
 JOB NO. 60709-03

APPROVED BY: [Signature] DATE: 85/04/22

THE CITY OF WINNIPEG
 WORKS & OPERATIONS DIVISION
 STREETS & TRANSPORTATION DEPARTMENT

RUE ARCHIBALD UNDERPASS
 C.P.R. KEEWATIN SUBDIVISION
 PAVEMENT RECONSTRUCTION AND RELATED WORKS

GEOMETRIC LAYOUT AND CONSTRUCTION STAGING

AUTHORIZED BY: [Signature] P. Eng. 1985-04-30
 DATE: 1985-04-30

ACCEPTED BY: [Signature] P. Eng. 1985-04-30
 DATE: 1985-04-30

SCALE 1:500 DRAWING NO U 205-85-02