



THE CITY OF WINNIPEG

WORKS AND OPERATIONS DIVISION


STREETS AND TRANSPORTATION DEPARTMENT

P.D. NO. 85 - 98

RUE ARCHIBALD UNDERPASS

C.P.R. KEEWATIN SUBDIVISION

PAVEMENT RECONSTRUCTION
AND RELATED WORKS

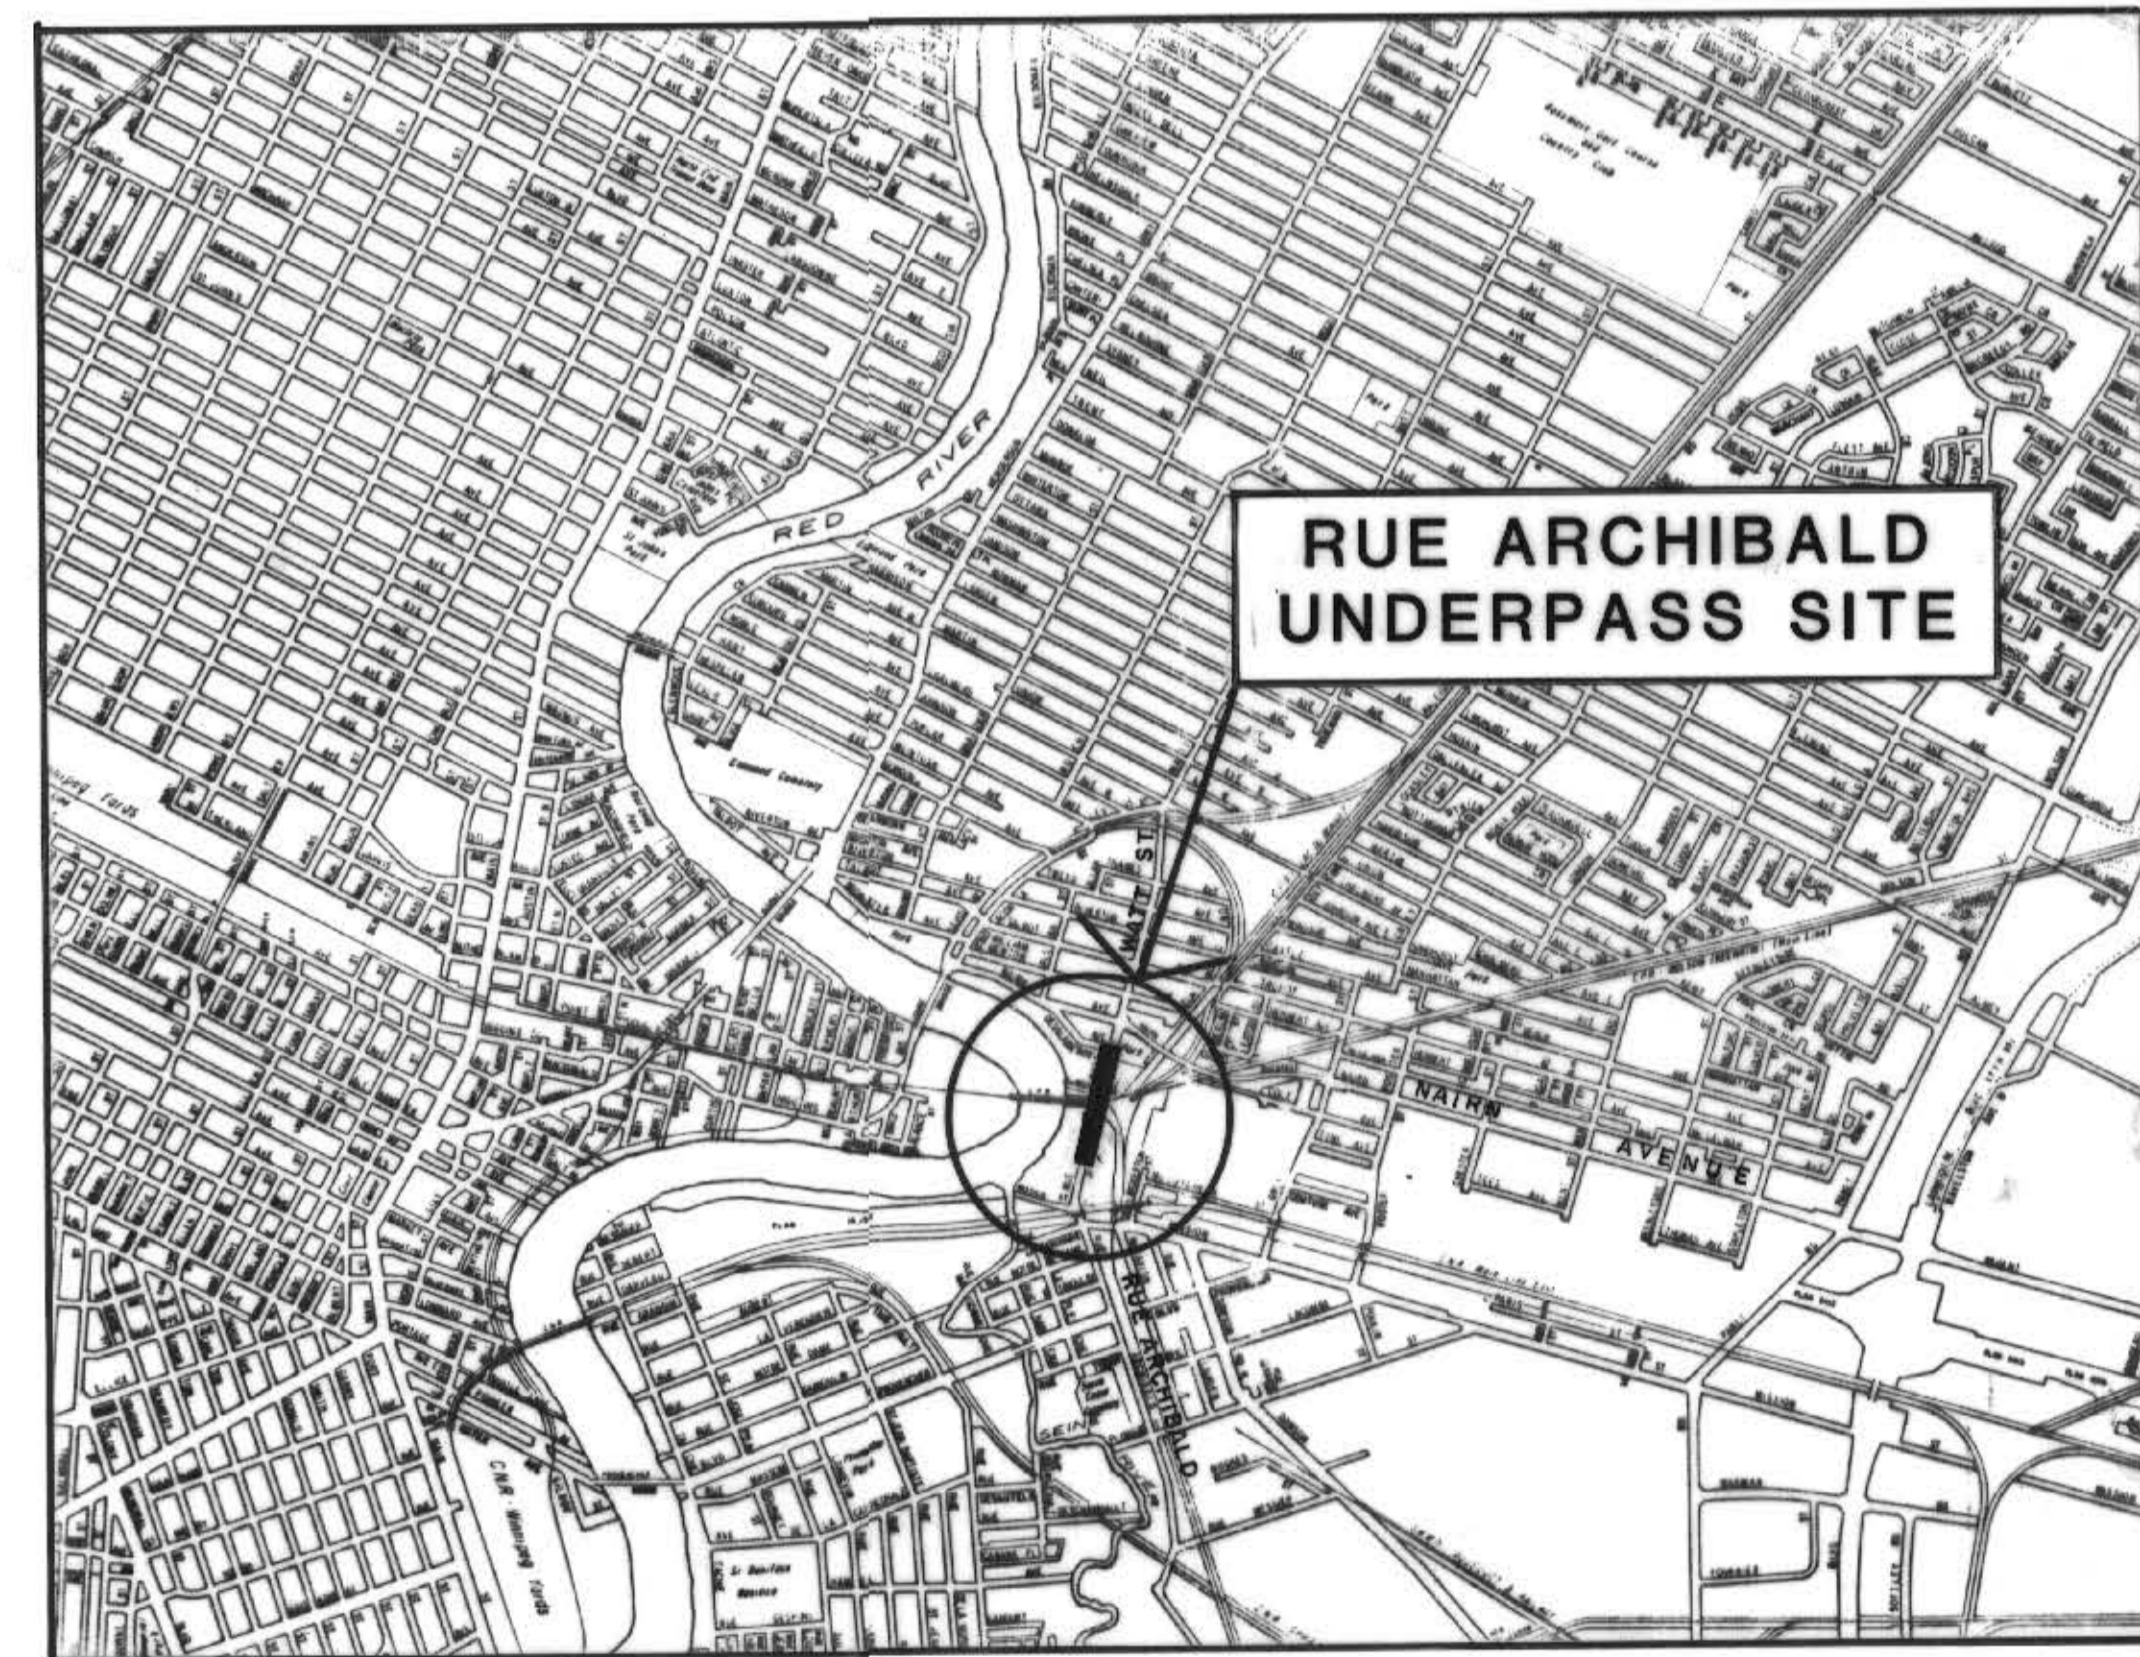

RUE ARCHIBALD
UNDERPASS SITE

Reid Crowther

Reid Crowther & Partners Ltd.
Engineers • Planners • Scientists
Winnipeg, Manitoba

LOCATION PLAN

RELEASED FOR CONSTRUCTION BY:

Small R. Campbell
MANAGER OF STREETS AND TRAFFIC

85.04.30
DATE

SET NO.

REID, CROWTHER & PARTNERS LIMITED
WINNIPEG
AS CONSTRUCTED
SIG. *[Signature]* DATE 85-12-18

B-5539-0

COVER SHEET
U205-85-C1