
ASBESTOS INVENTORY CONTROL



Planning, Property and Development Department Municipal Accommodations Division 4th Floor - 185 King Street • Winnipeg, MB • R3B 1J1

Building Name:	Eric Coy Indoor Arena	Inspection Date: Inspected By: Construction Date:		November 27, 2014				
Building Code:	AR-04			J Neufeld & R. Matthews				
Building Address:	535 Oakdale Avenue			1971				
Material Location	Material Description	Drawing Label	Material Condition	Testing Status	Date M/Y	Test %	Est. %	
Exterior Block Walls of Dressing	Randomly Inspected & Appear To Be Empty (Do Not Contain							
Room Lobby Area	Vermiculite Insulation)							
Hallway/ Lobby	Asphalt Plank Flooring	APF	Good	TESTED	Oct/'12	3		
Canteen	24x48 Ceiling Tile	C48		TESTED	Oct/'09	0		
Men's Washroom	Asphalt Plank Flooring	APF	Good				3	
	Pipe Fitting Insulation	PF	Good				30	
Women's Washroom	Asphalt Plank Flooring	APF	Good				3	
Dressing Room #4	Pipe Fitting Insulation	PF	Good	TESTED	Oct/'12	30		
	Pipe Insulation	PI	Good				0	
	Asphalt Plank Flooring	APF	Good					
Shower Room #3 & #4	Pipe Fitting Insulation	PF	Good					
	Pipe Insulation	PI		-			0	
	Asphalt Plank Flooring	APF		TESTED	Oct/'12		0	
Dressing Room #3	Pipe Fitting Insulation	PF	Good	TESTED	Oct/'12	30		
	Pipe Insulation	PI		TESTED	Oct/'12	0		
	Asphalt Plank Flooring	APF						
Dressing Room #1	Asphalt Plank Flooring	APF						
	Pipe Fitting Insulation	PF		-				
Dressing Room # 2	Asphalt Plank Flooring	APF		TESTED	Nov/'12	0		
Dressing Room #1 & #2	Pipe Fitting Insulation	PF	Good				30	
Shower/Washroom	Pipe Insulation	PI					0	
	Asphalt Plank Flooring	APF					0	
Mechanical Room	Pipe Fitting Insulation	PF	Good	1			30	
	Pipe Insulation	PI	Good	1				
	Tank Insulation	TI	Good	1				
	Duct Insulation	DI	Good	TESTED	Oct/'12	0		

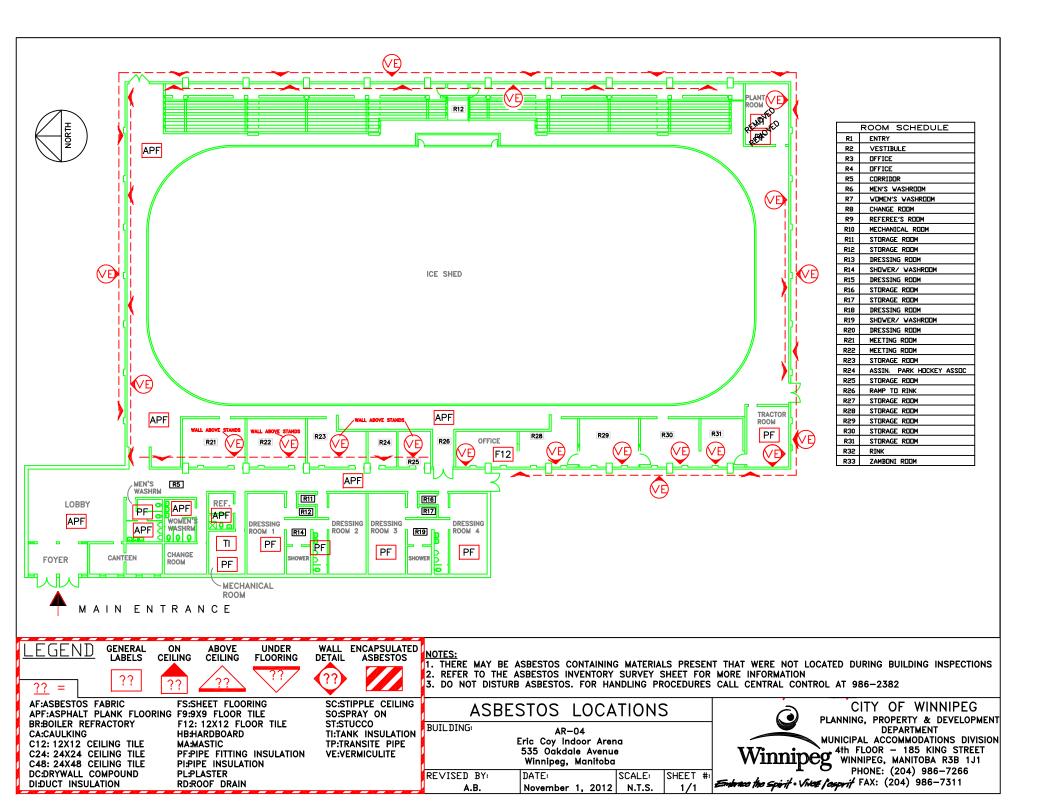

		Drawing	Material	Testing	Date	Test	Est.
Material Location	Material Description	Label	Condition	Status	M/Y	%	%
Ice Shed							
Office	12x12 Floor Tile (under bleachers)	F12	Good				
Plant Room	Pipe Fitting Insulation	PF	Removed				
	Tank Insulation	TI	Removed				
Tractor Room	Pipe Fitting Insulation	PF	Good				30
Corridors	Asphalt Plank Flooring	APF	Good	TESTED	Oct/'12	2	
Exterior Block Walls of Ice Shed	Contain Vermiculite Insulation (Which May Contain Asbestos)	VE	Good	N/A			

AR-04

NOTES:

1. Asbestos inspections and inventory updates are conducted annually.

2. There may be asbestos containing materials present that were not located during asbestos inspections.

3. Floor tile and sheet flooring installed before 1990 may contain asbestos and must be treated as an asbestos containing material.

4. Vermiculite insulation may contain pockets of asbestos. All vermiculite insulation must be treated as an asbestos containing material.

5. For asbestos related inquiries, call Central Control at 986-2382