

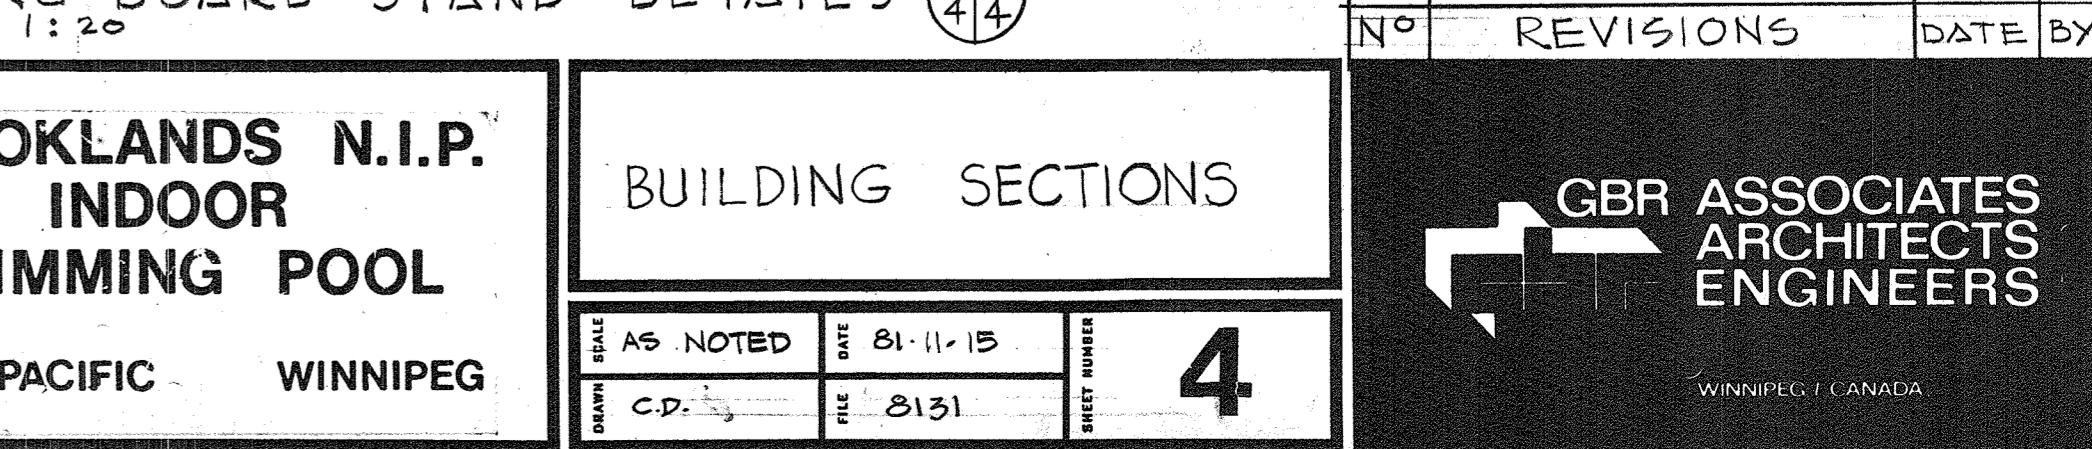
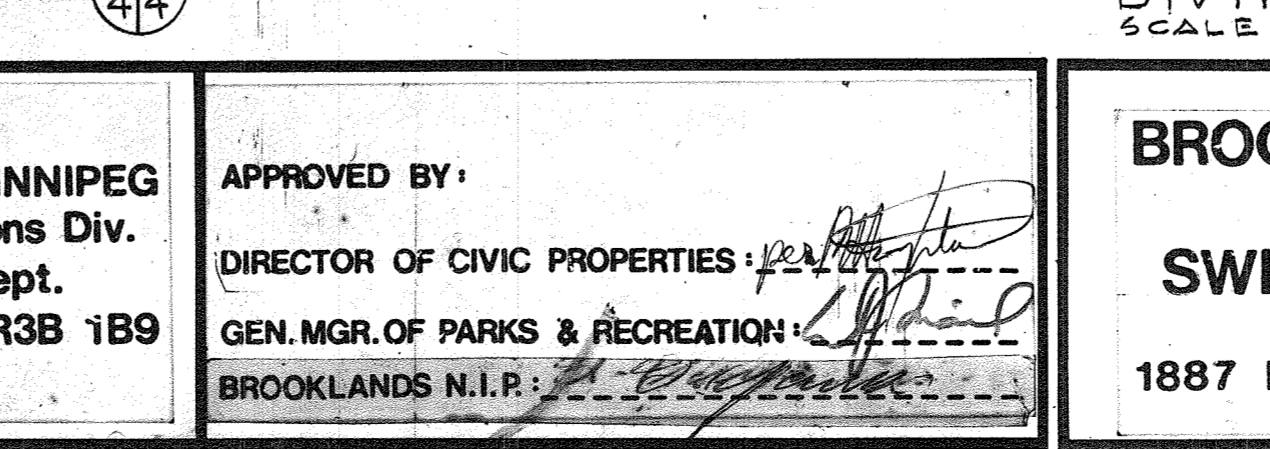
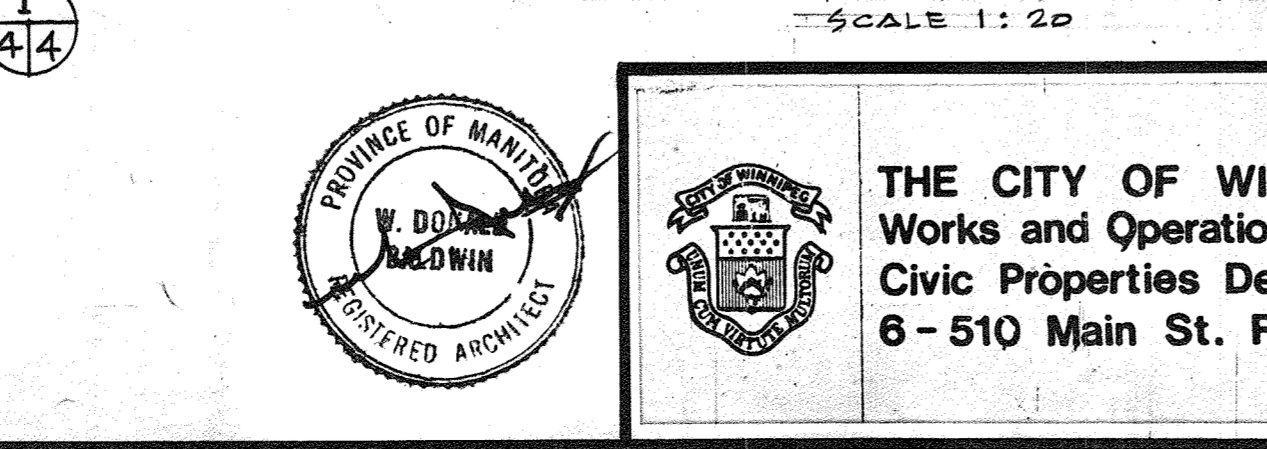
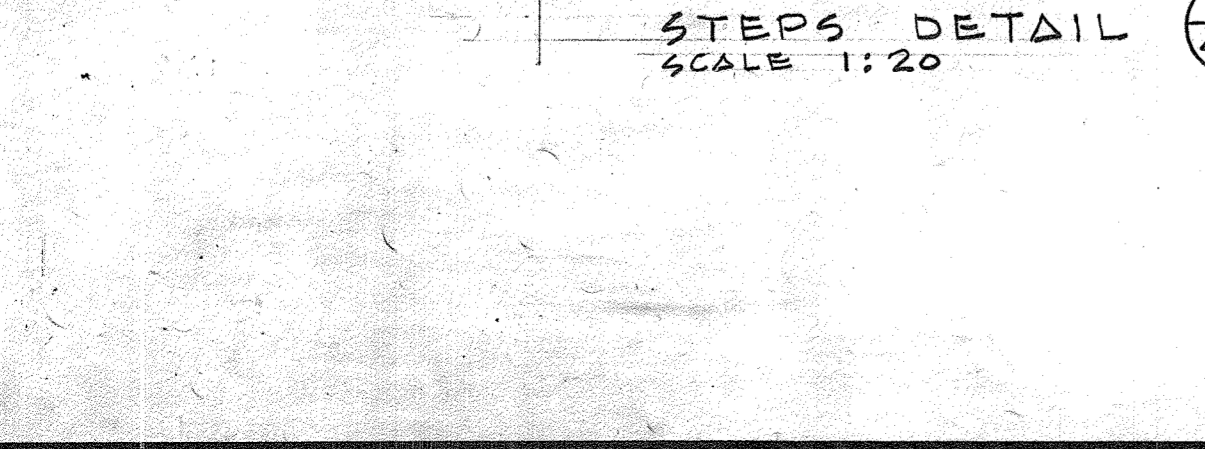
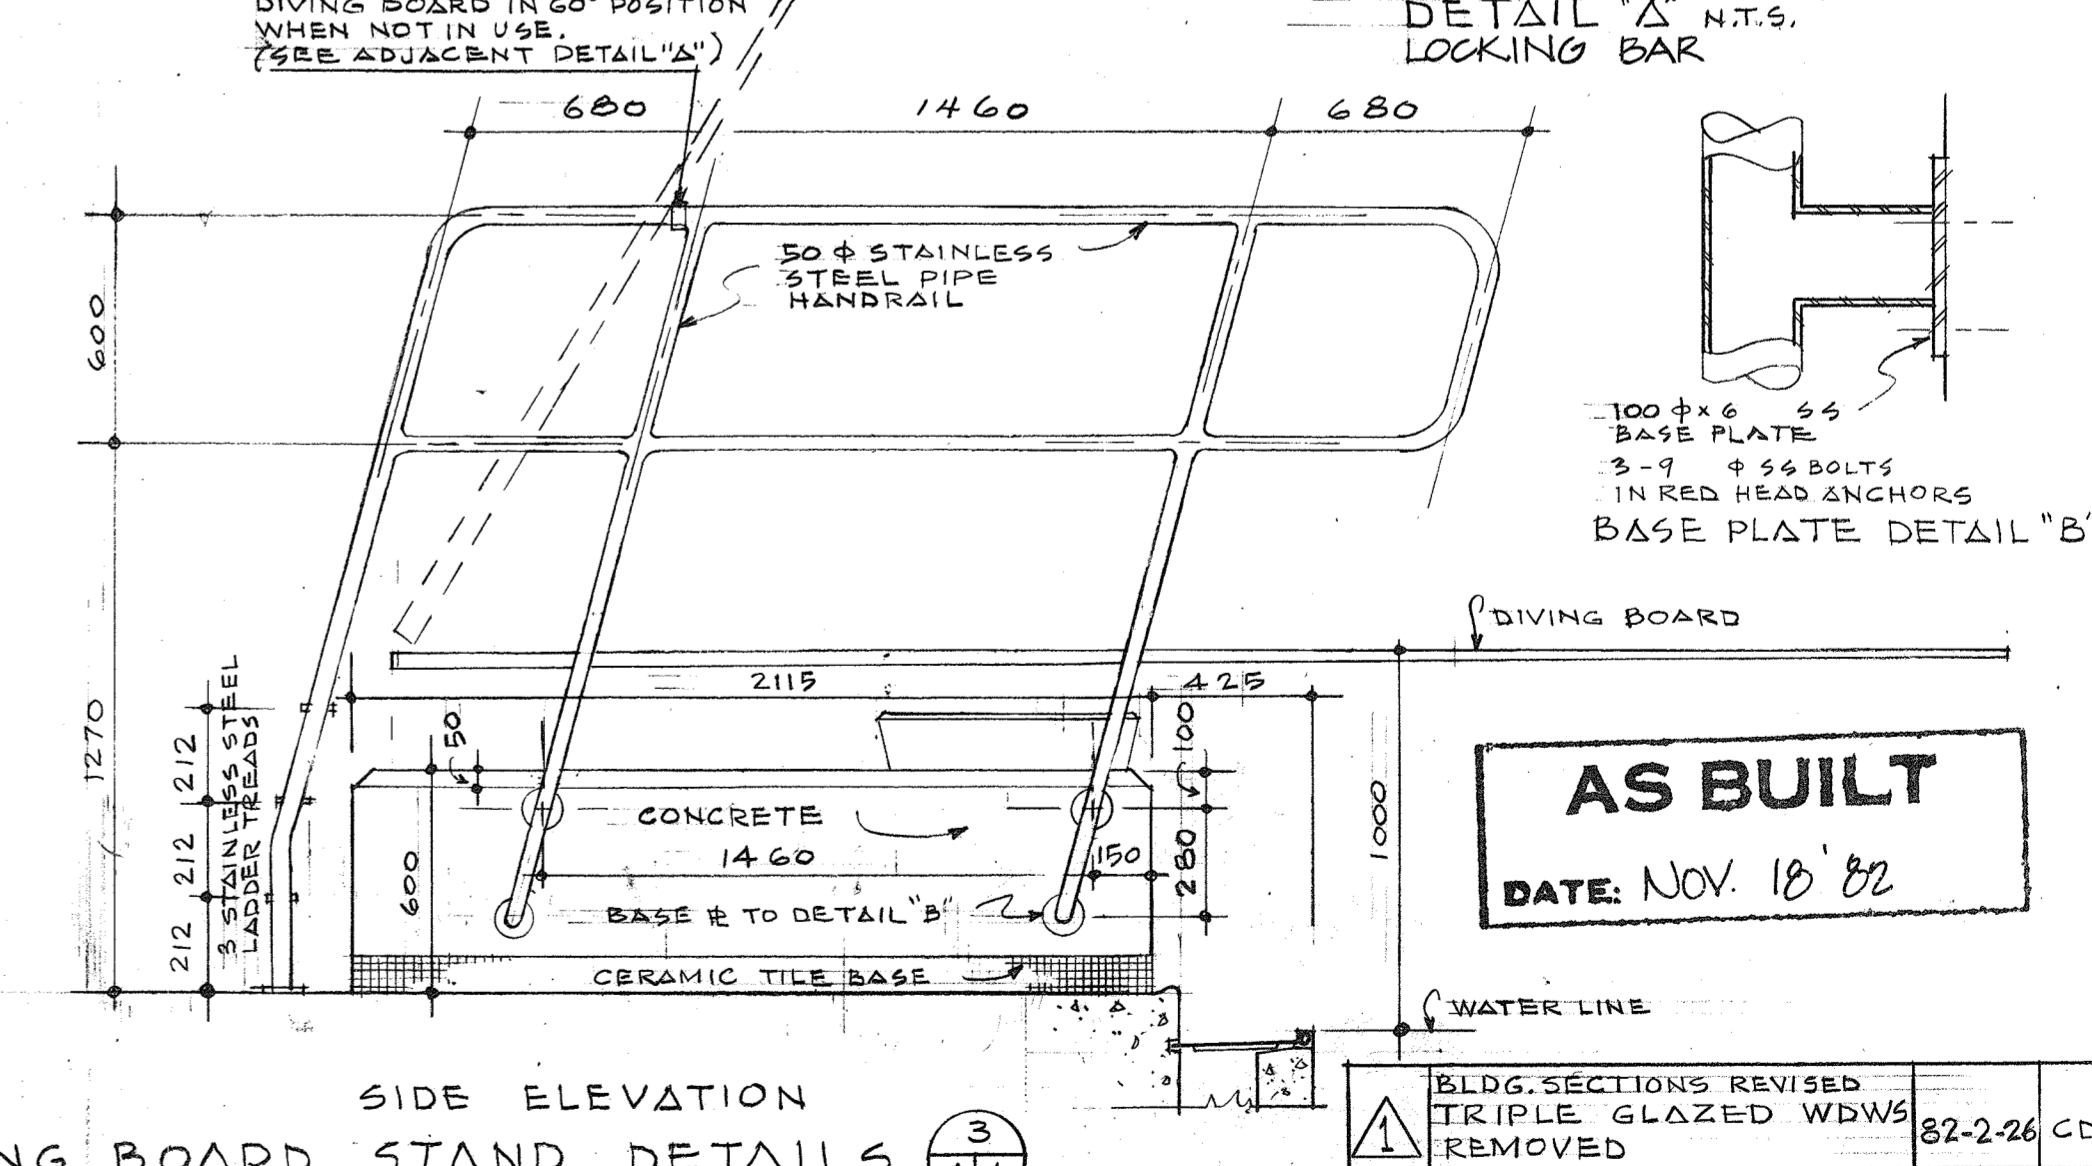
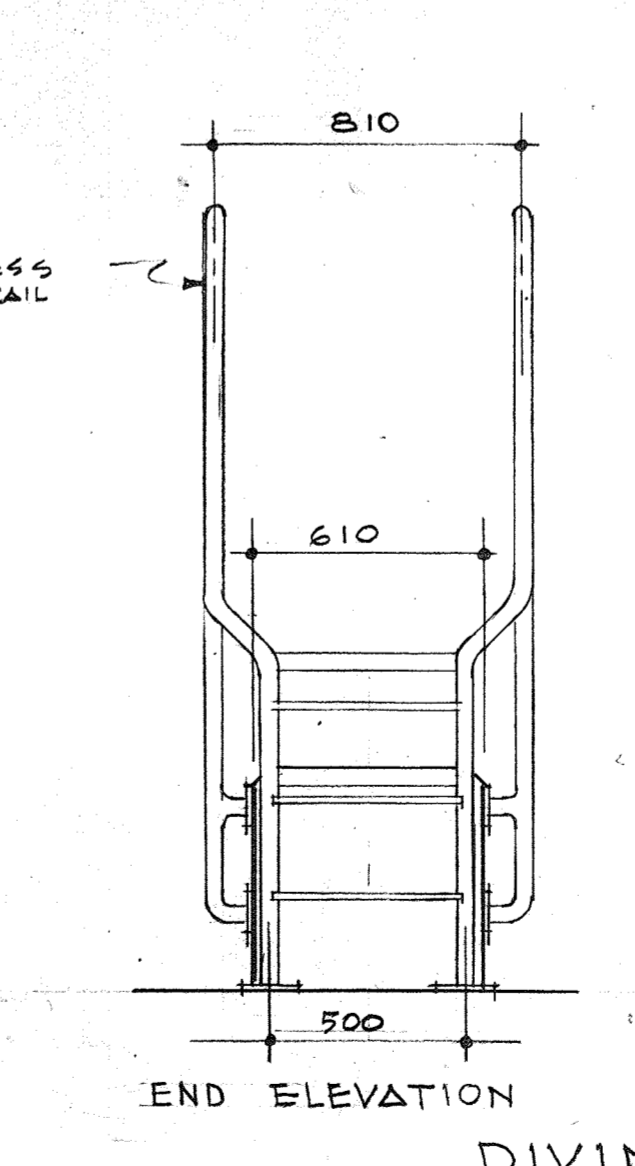
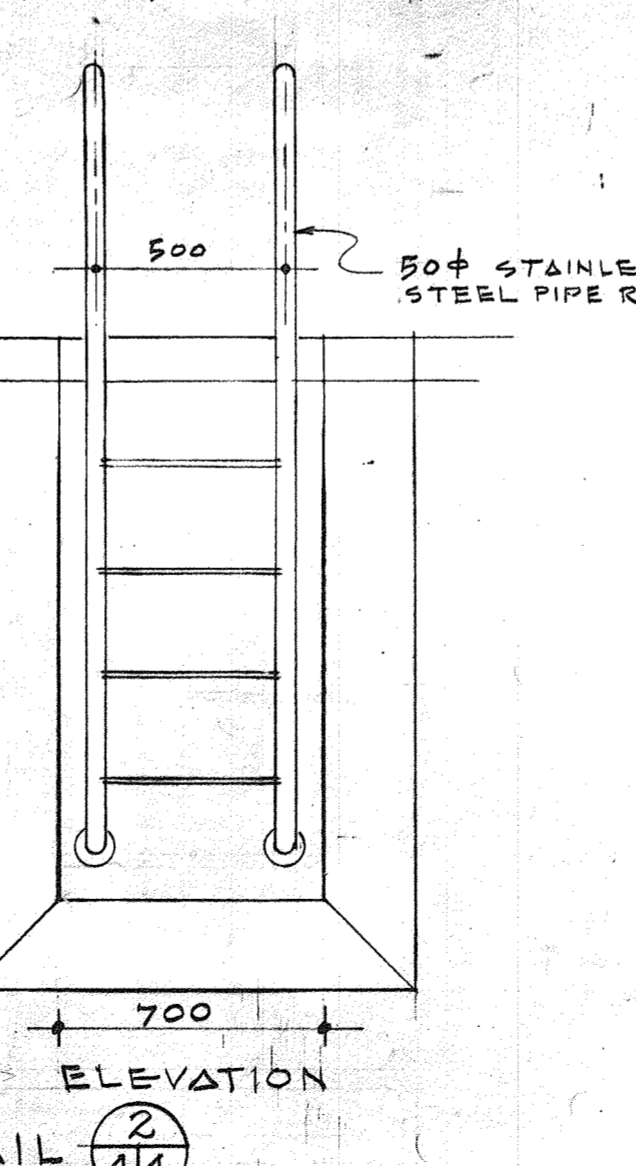
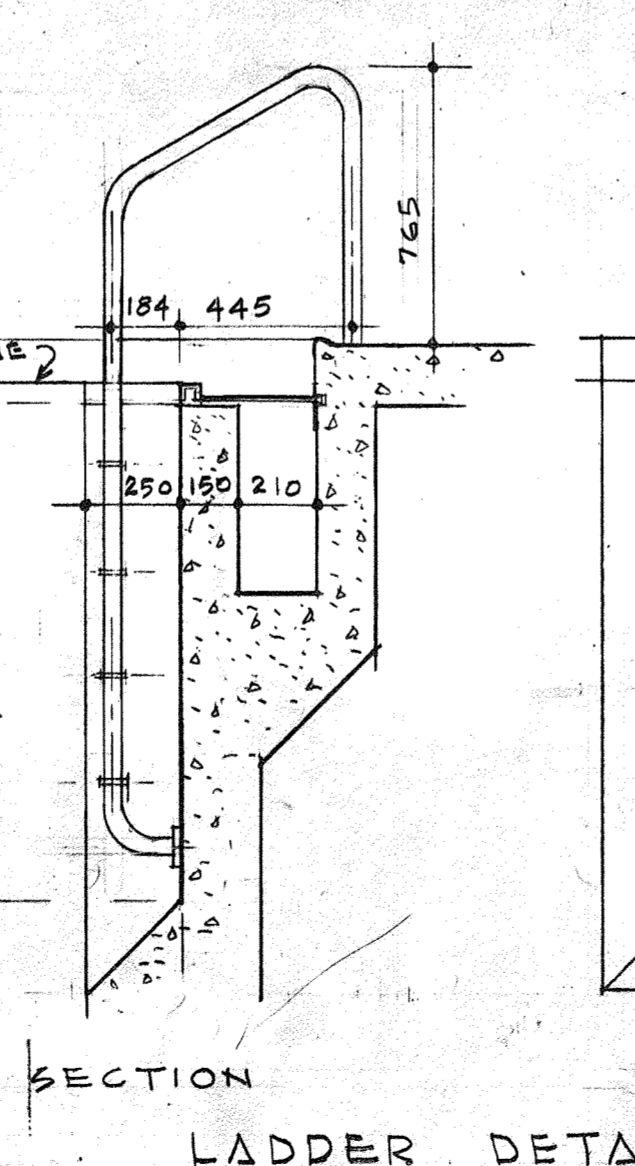
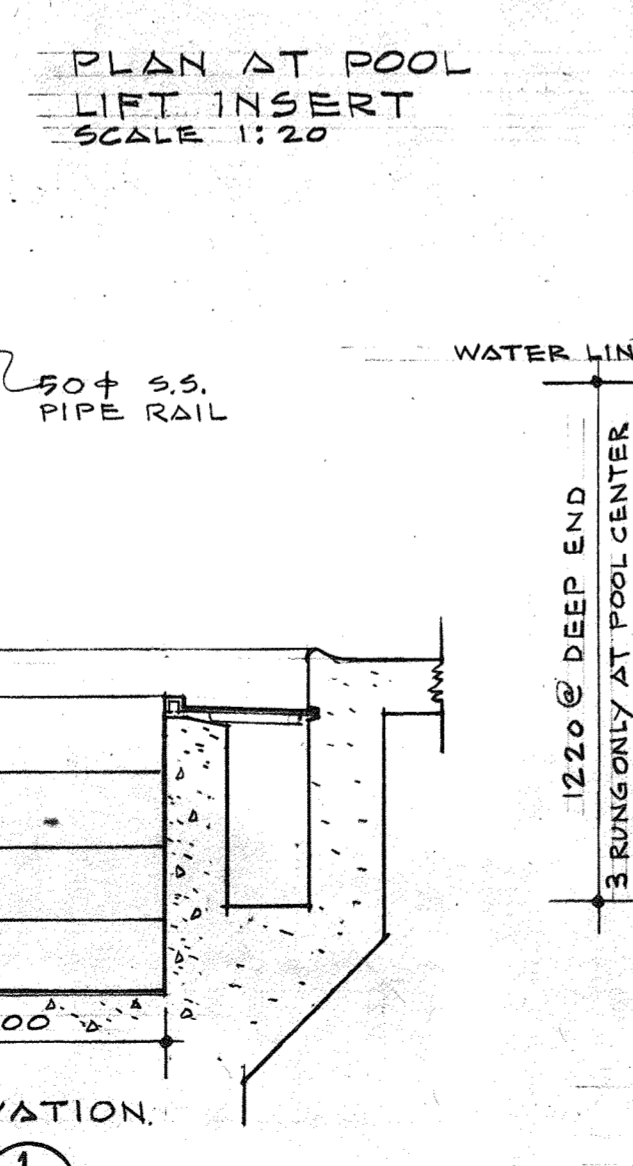
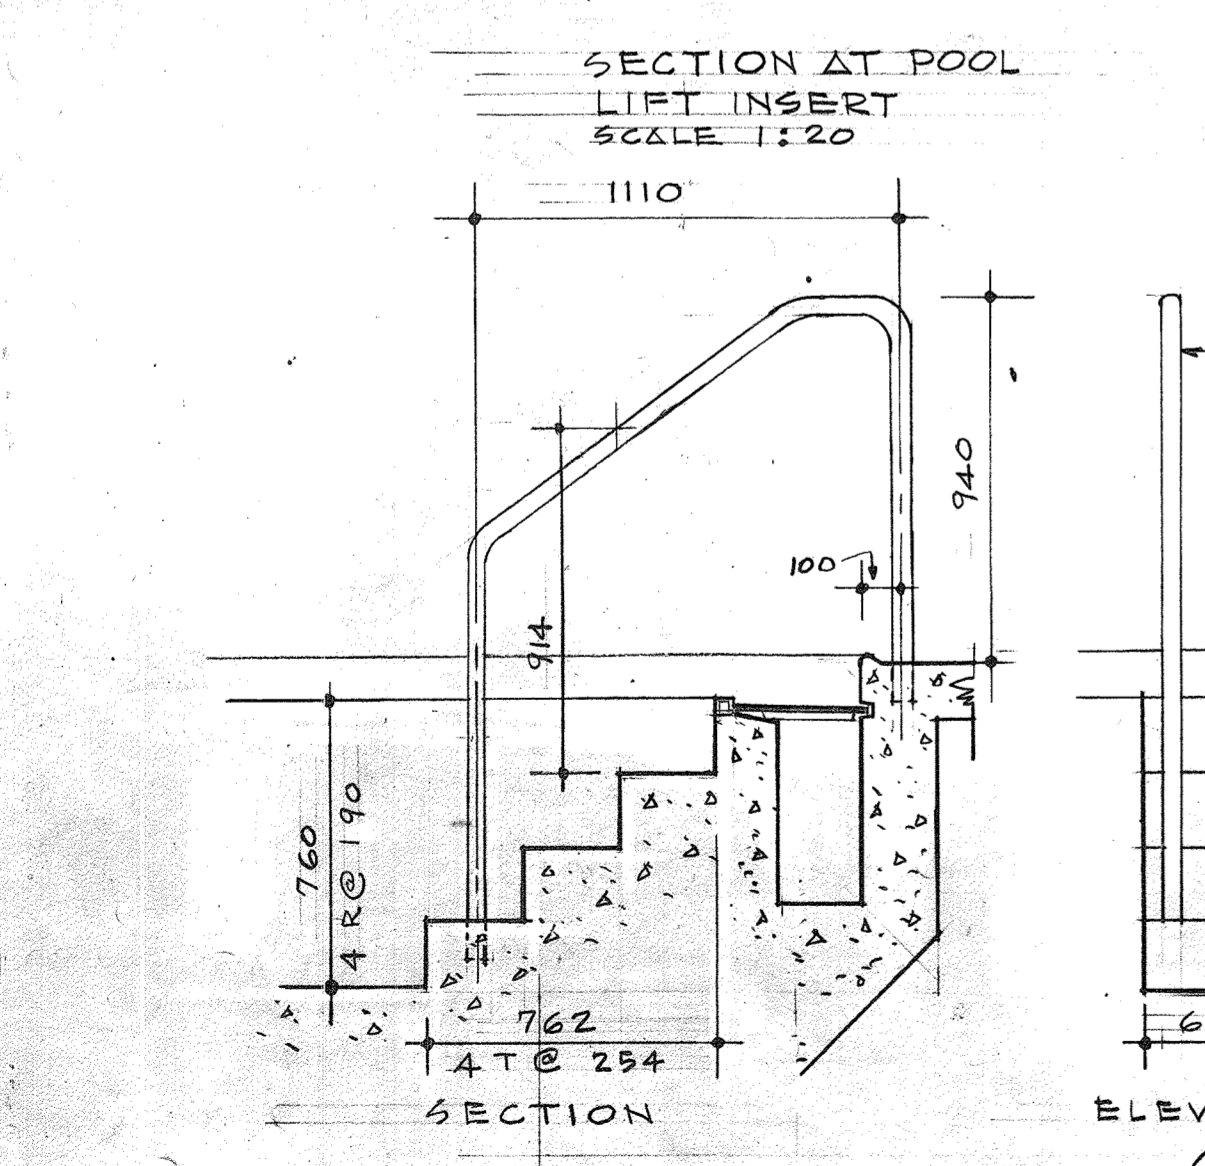
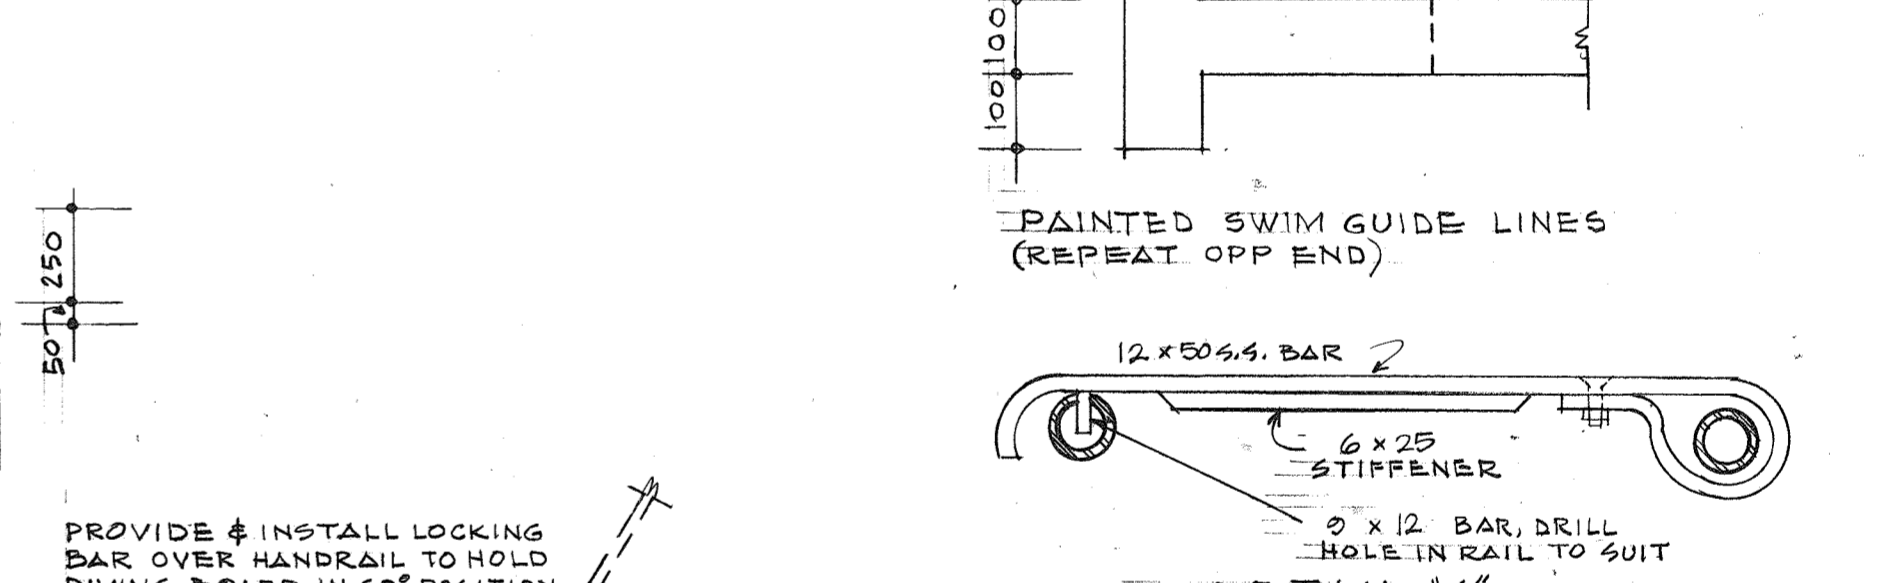
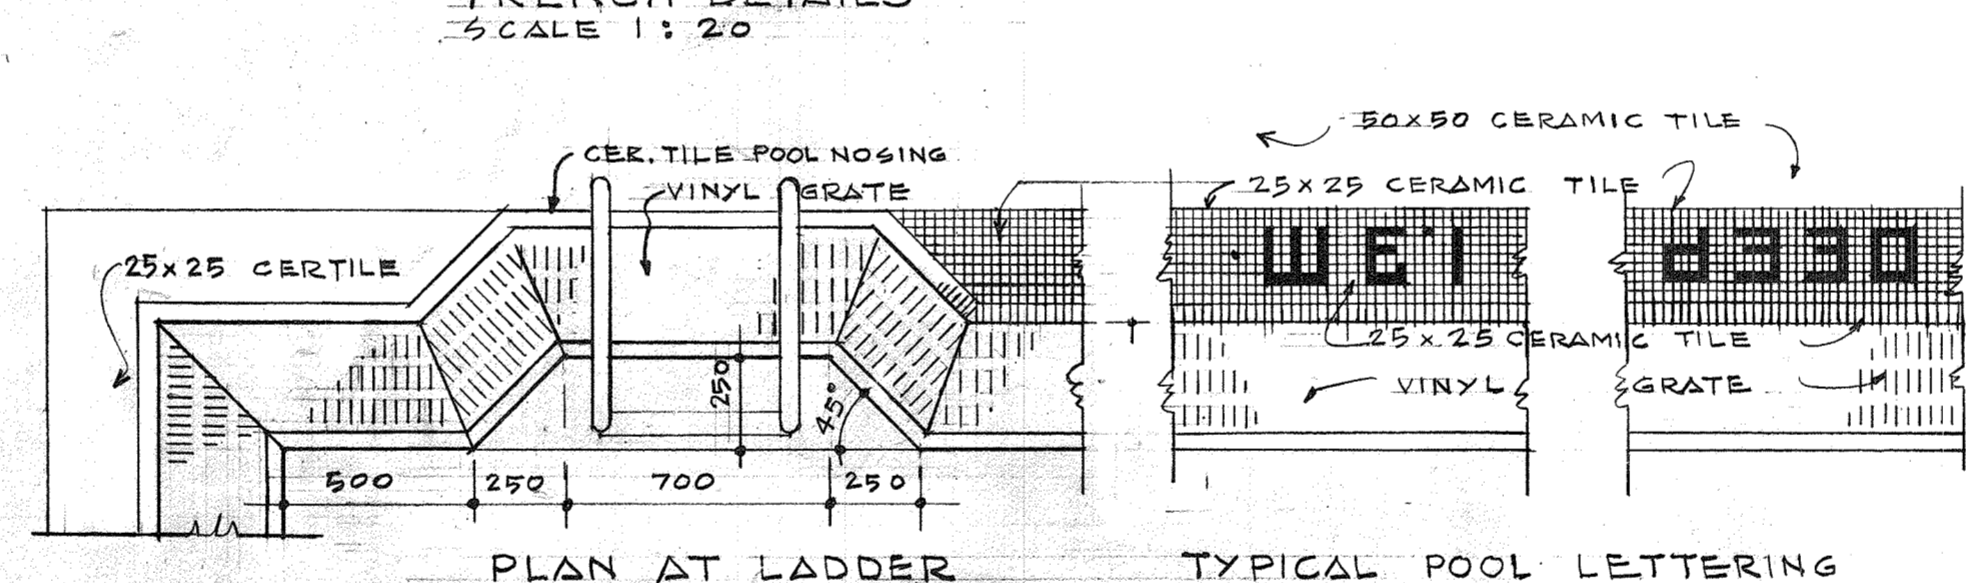
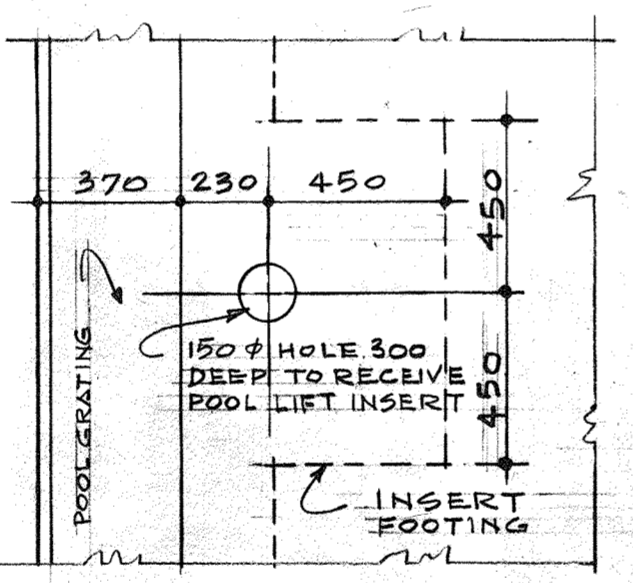
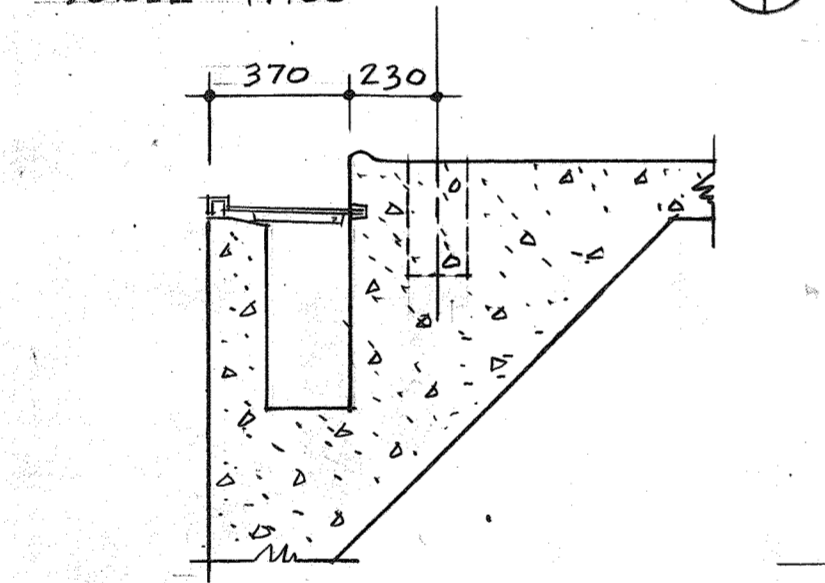
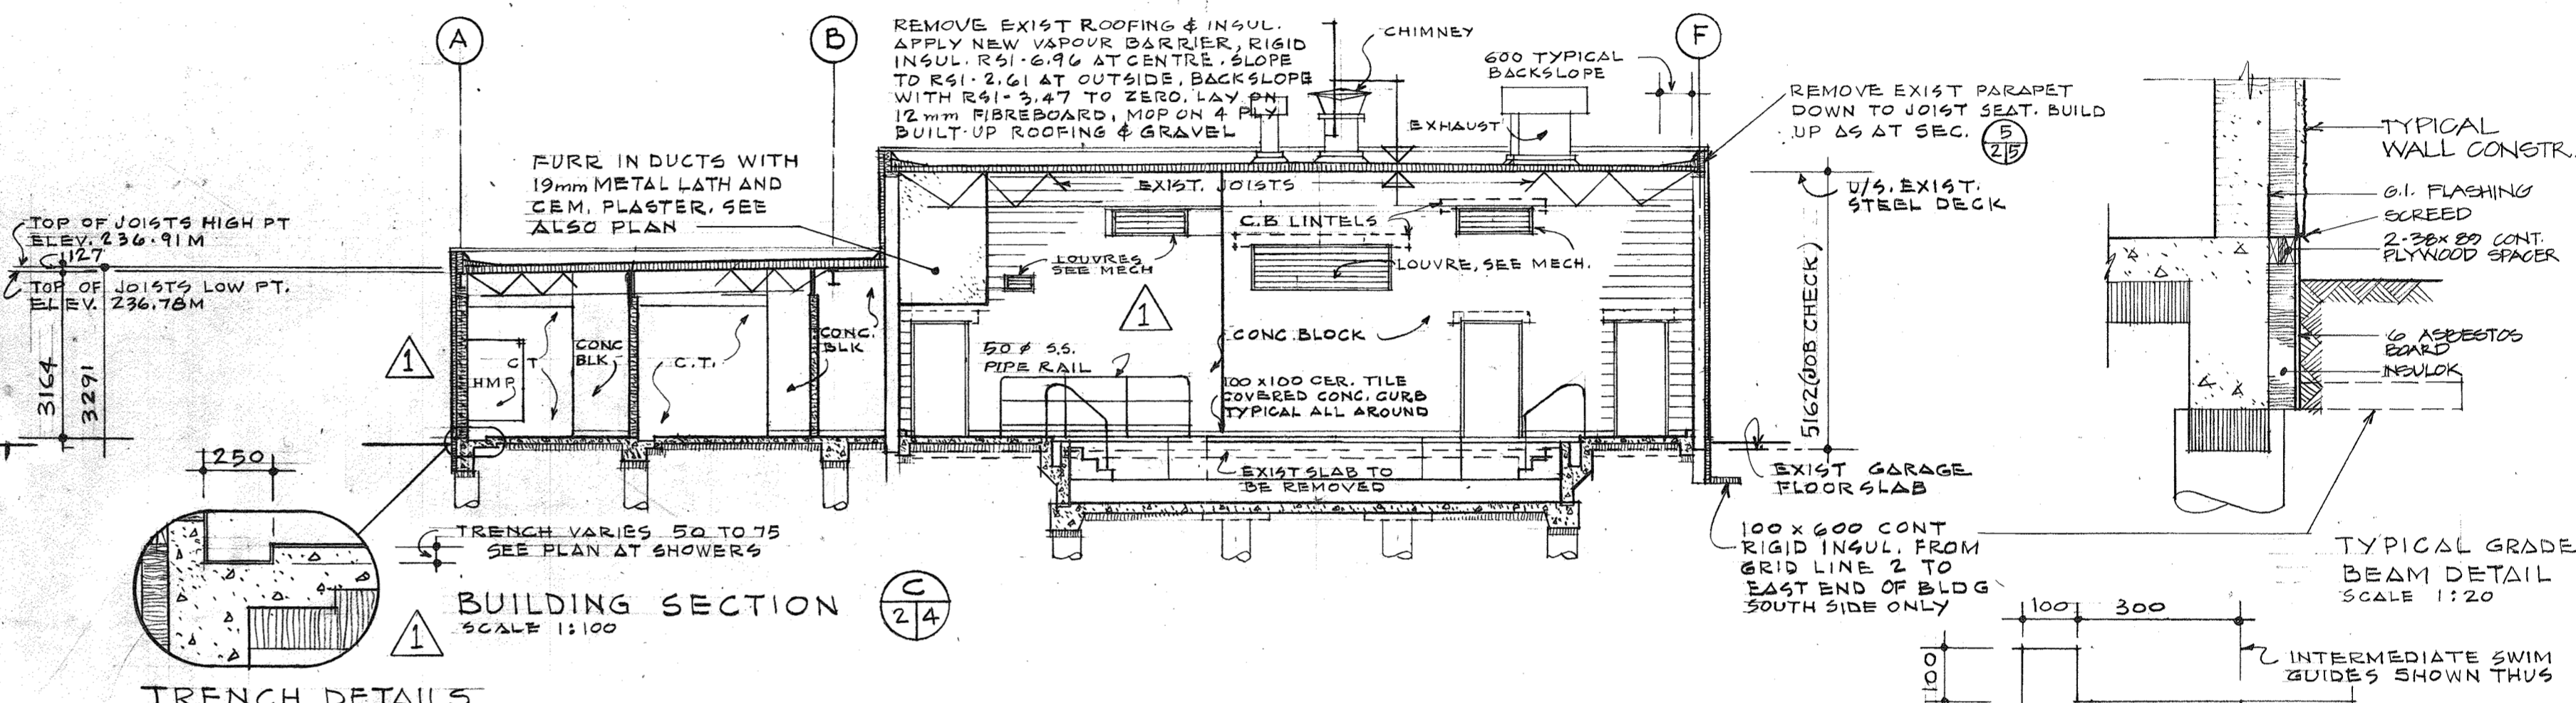
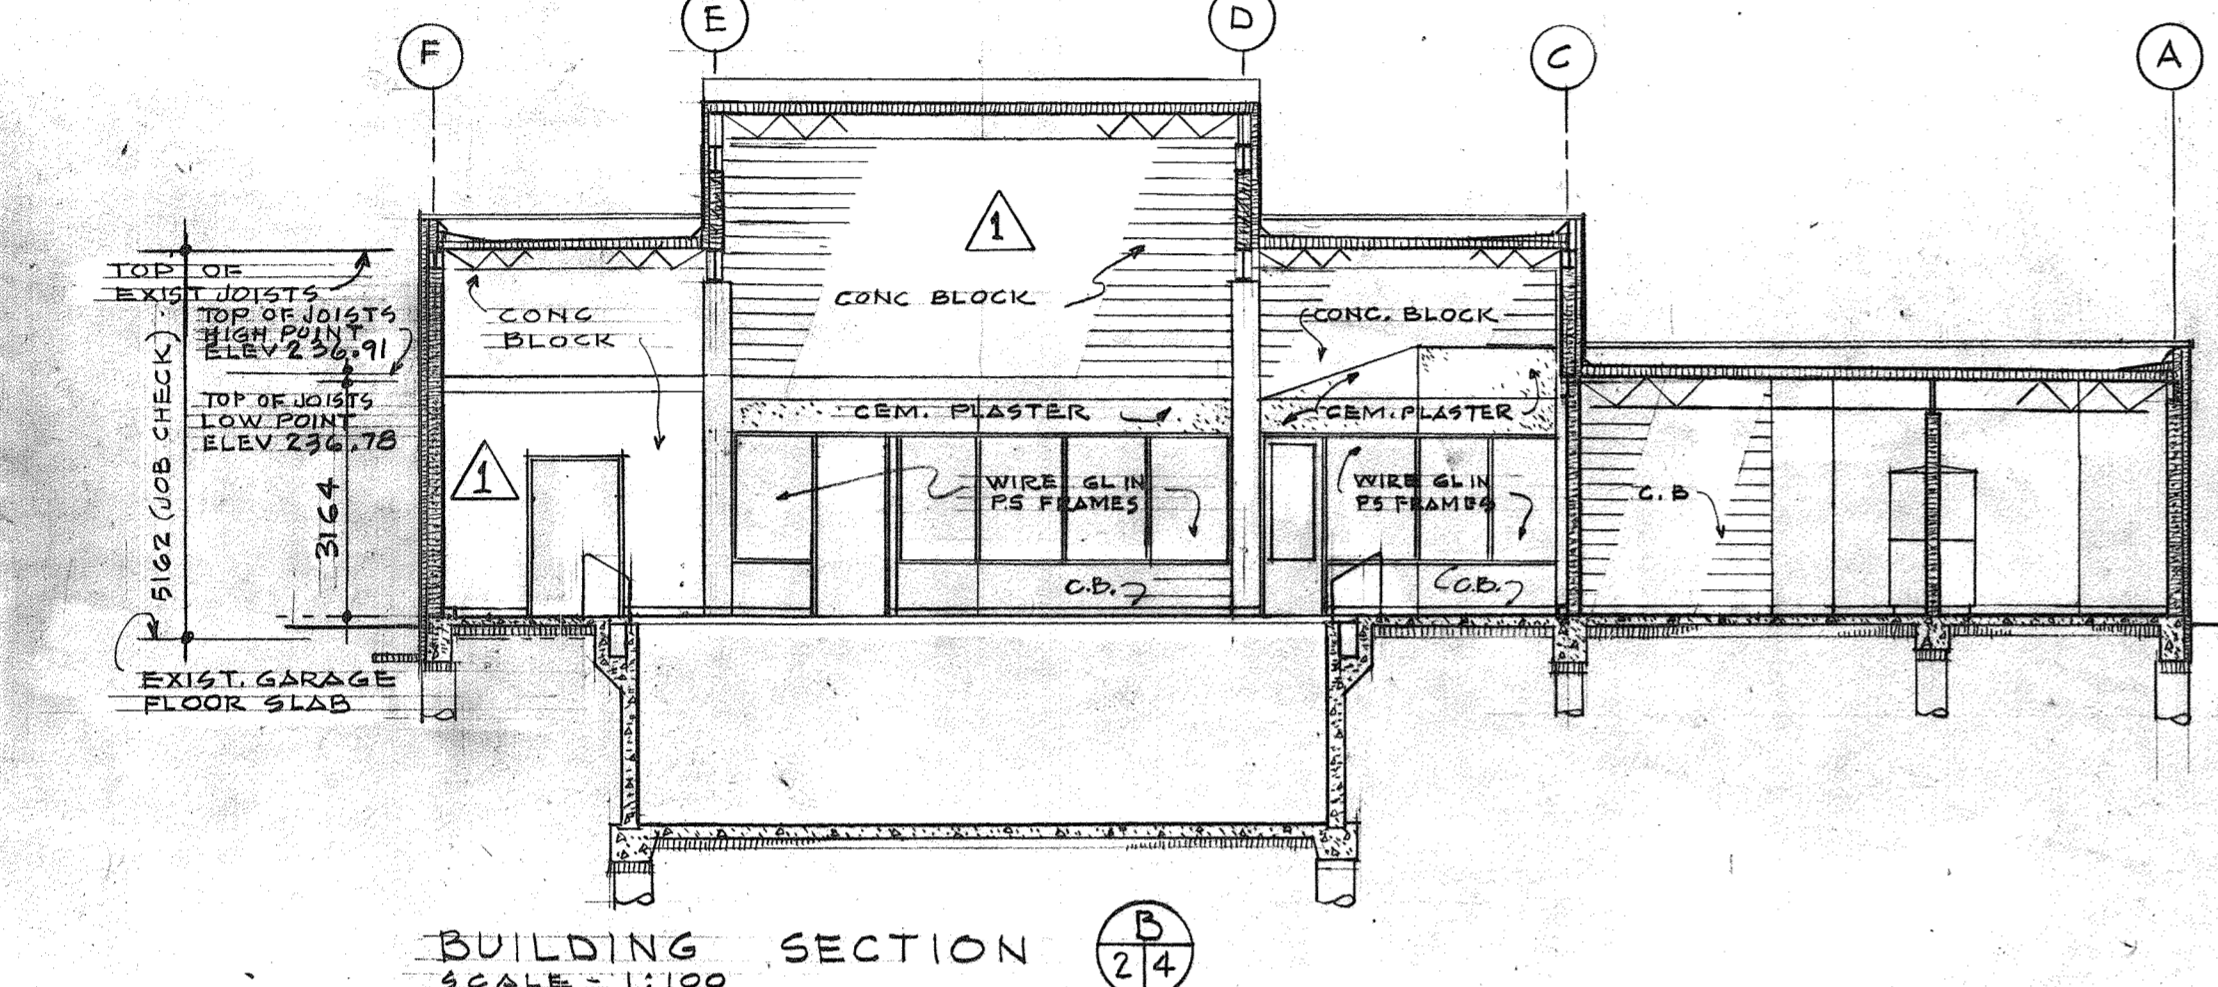


BUILDING SECTIONS

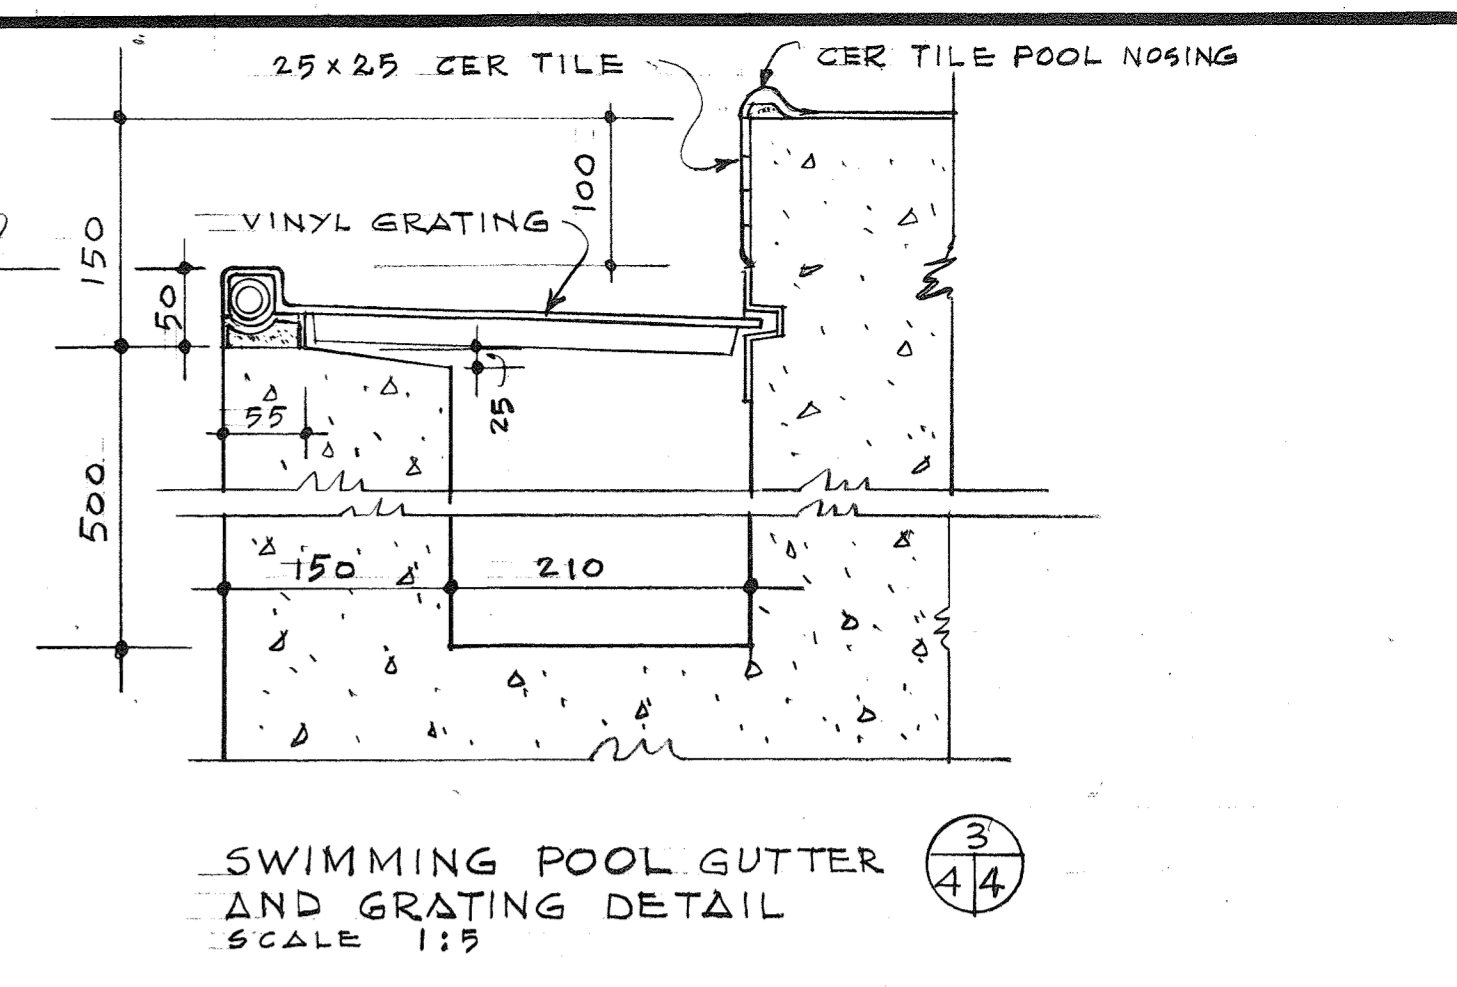

AS BUILT
DATE: NOV. 18 '82

NO	REVISIONS	DATE	BY
1	BLDG. SECTIONS REVISED TRIPLE GLAZED WDW'S REMOVED	82-2-26	CD

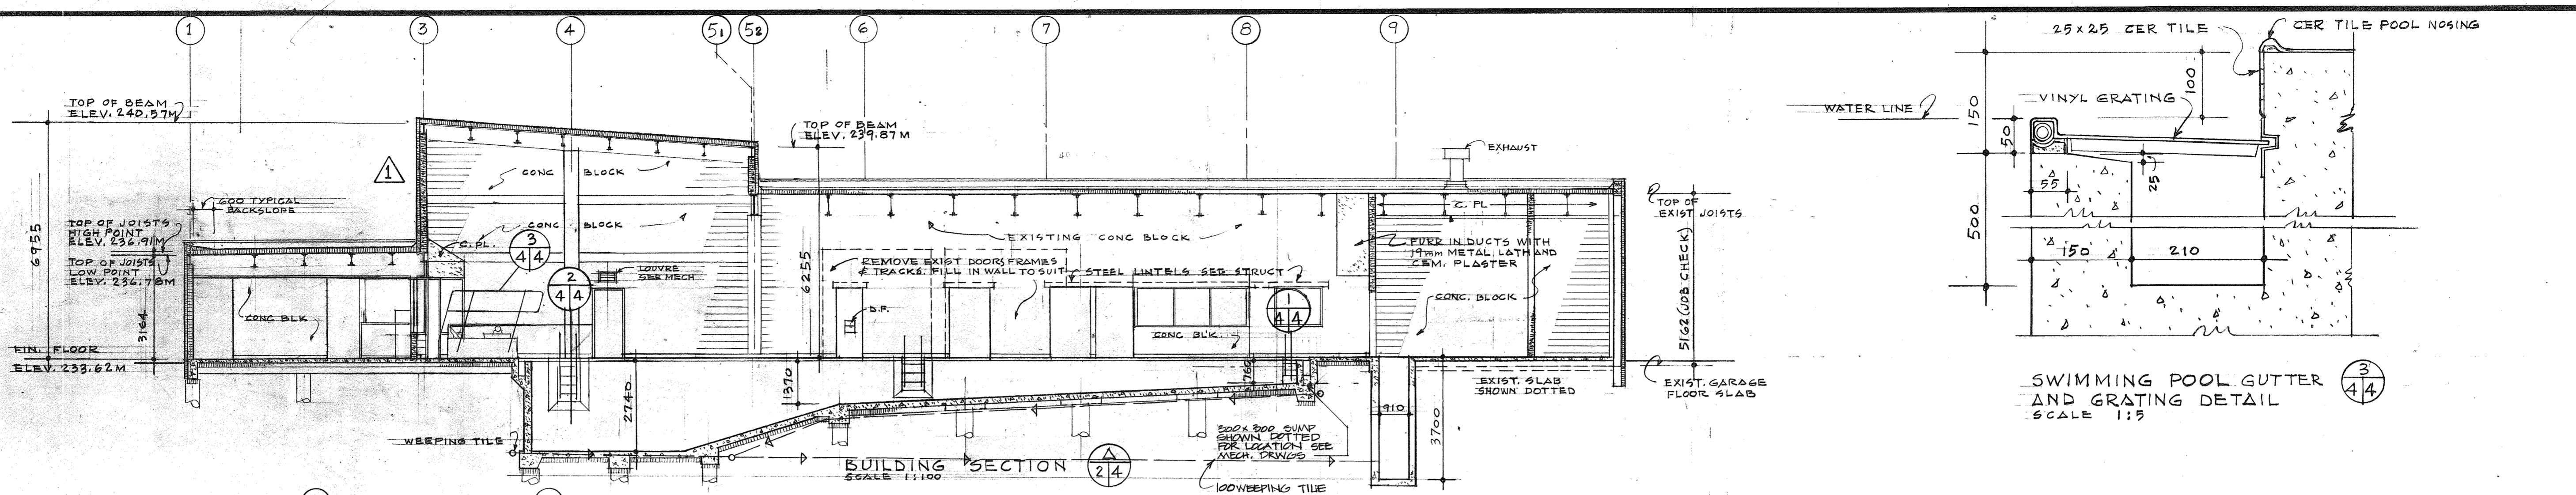

THE CITY OF WINNIPEG
Works and Operations Div.
Civic Properties Dept.
6-510 Main St. R3B 1B9

APPROVED BY:
DIRECTOR OF CIVIC PROPERTIES:
GEN. MGR. OF PARKS & RECREATION:
BROOKLANDS N.I.P.:

BROOKLANDS N.I.P.
INDOOR
SWIMMING POOL
1887 PACIFIC WINNIPEG

BUILDING SECTIONS
AS NOTED
DATE: 81-11-15
FILE: 8131
DIRECT NUMBER: 4

GBR ASSOCIATES
ARCHITECTS
ENGINEERS
WINNIPEG, CANADA