




SECTION 1
SCALE 1:40

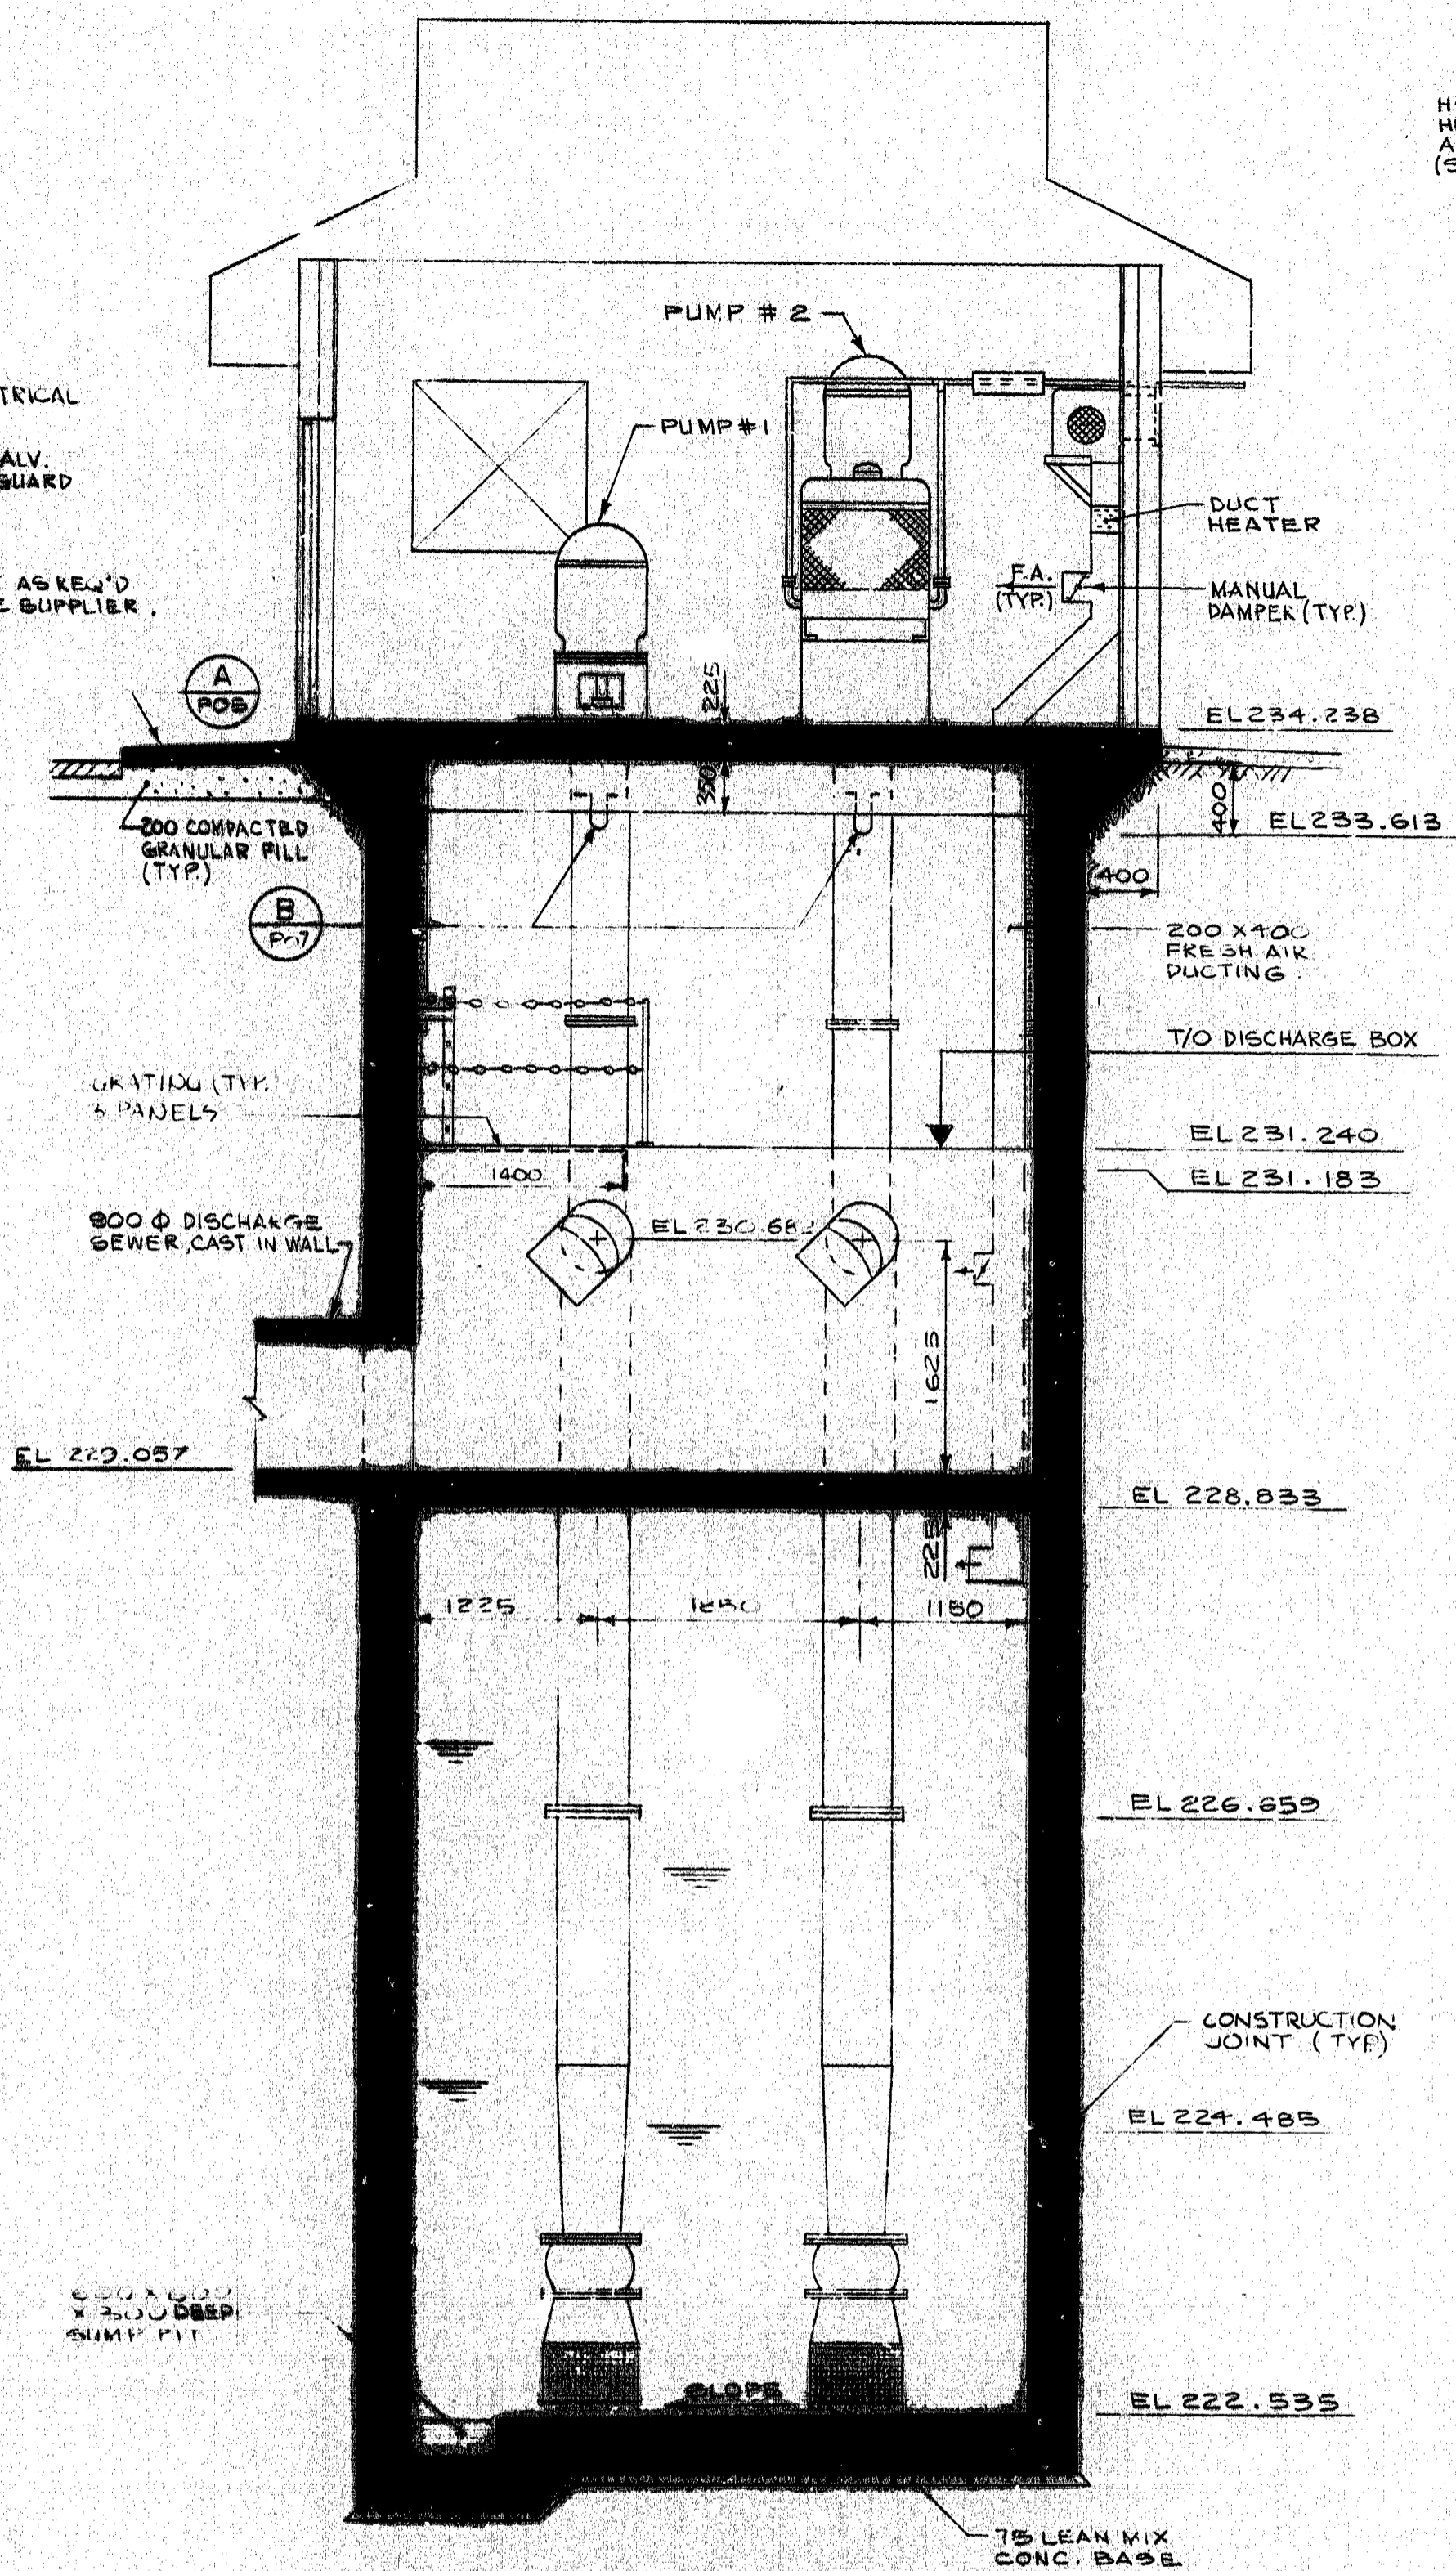

SECTION 2
SCALE 1:40

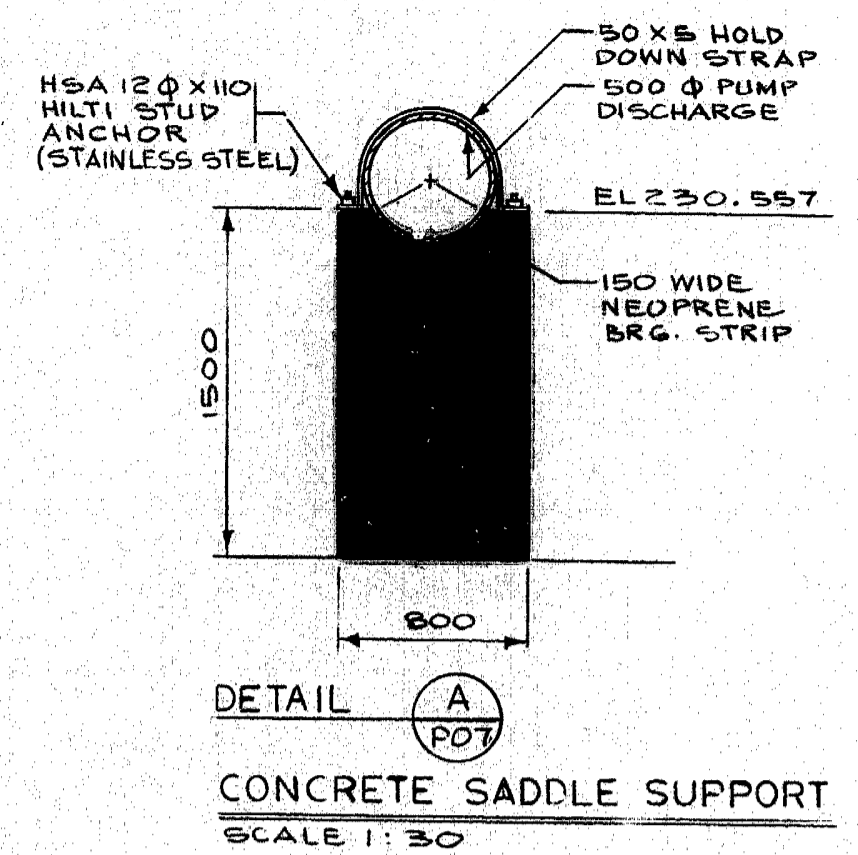


DETAIL A
CONCRETE SADDLE SUPPORT
SCALE 1:30

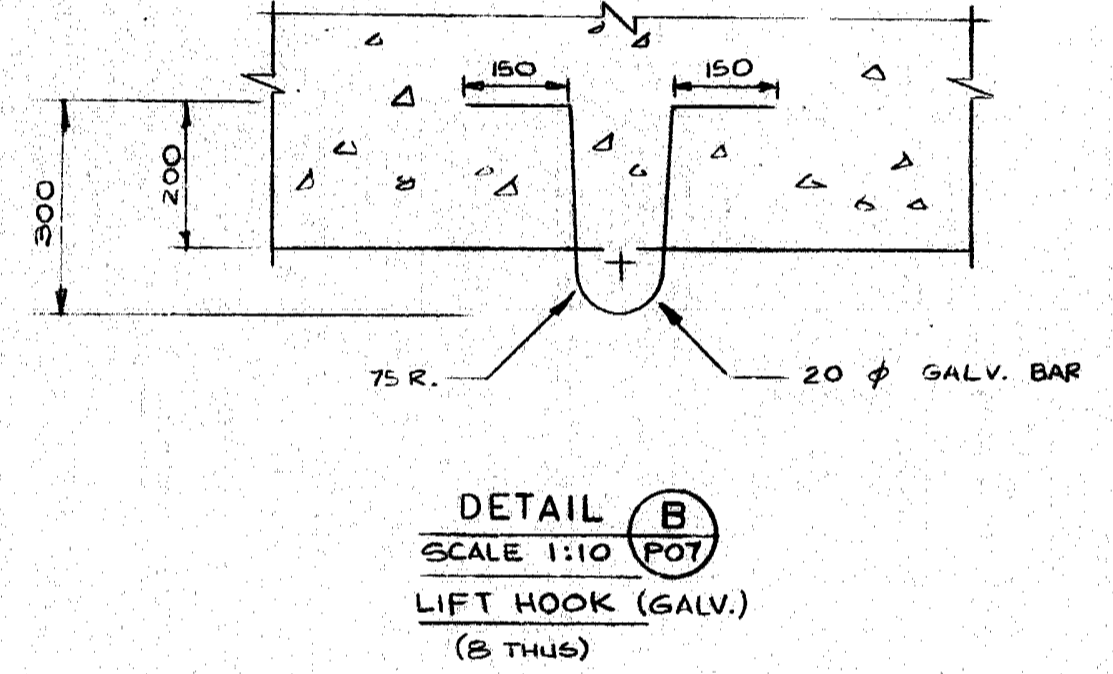

DETAIL B
LIFT HOOK (GALV.)
(B THUS)
SCALE 1:10

NOTES
1. CONCRETE NOTES DWG. P06

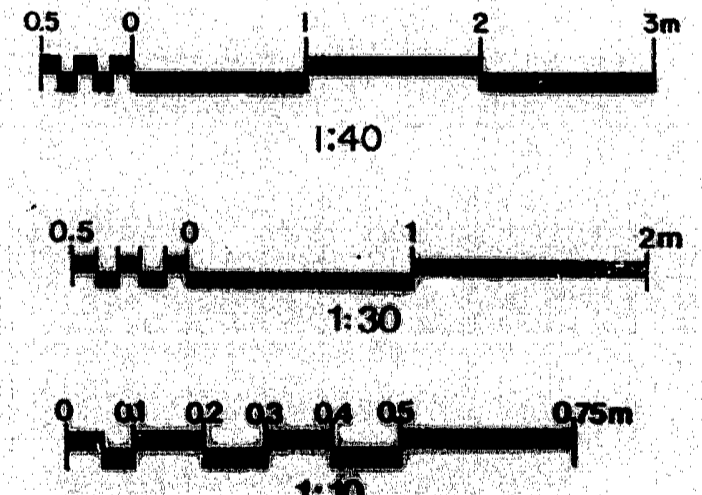

REVISED AS CONSTRUCTED
DATE 24.12.7 BY *B*
CHECKED BY *M. P. Eng*

1-5515-7
METRIC

WHOLE NUMBERS INDICATE MILLIMETRES
DECIMALIZED NUMBERS INDICATE METRES

DESIGNED BY: <i>Gum</i>	DRAWN BY: <i>Ross L</i>
CHECKED BY: <i>AC, AM</i>	DATE: 21-05-82
APPROVED BY: <i>A. W. M. Eng</i>	DATE: 10/6/82



INTERDISCIPLINARY
ENGINEERING
COMPANY
PROFESSIONAL ENGINEERS
WINNIPEG MANITOBA

THE CITY
OF WINNIPEG
WORKS & OPERATIONS
DIVISION
STREETS & TRANSPORTATION
DEPARTMENT

ROUTE 90 UNDERPASS	
PUMP STATION SECTIONS	
AUTHORIZED BY: <i>M. P. Eng</i>	1982-10-08
ACCEPTED BY: <i>M. P. Eng</i>	21/10/82
SCALE: AS SHOWN	DRAWING NO. U228-83-P07