



LIST OF MATERIALS


No	DESCRIPTION	QTY.
1	JUNCTION BOX	2
2	NEPTUNE COUNTER	2
3	BREAKER BOX	1
4	COIN BOX	1
5	HEATER	2
6	HYDRO CONNECTION BOX	1
7	FLUORESCENT LIGHT FIXTURE	1

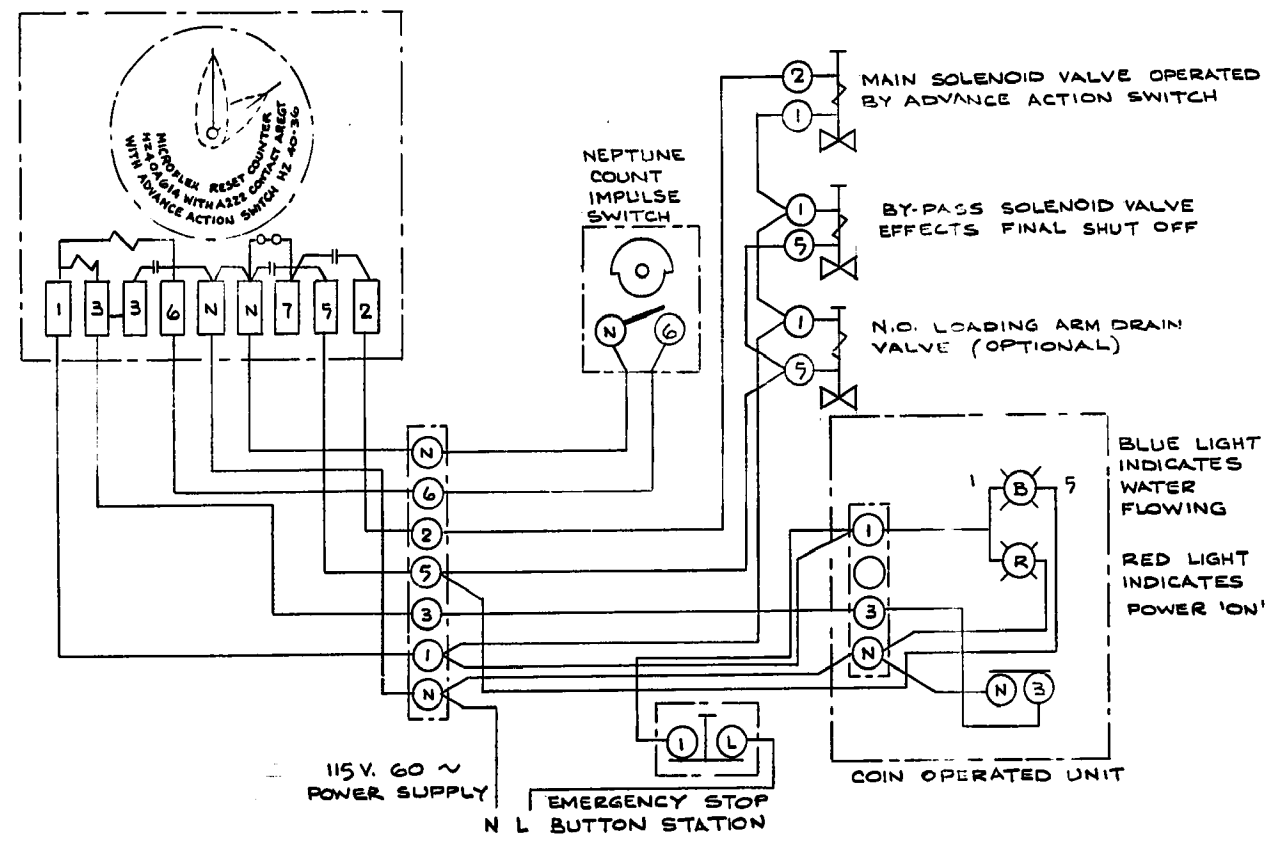


STAND PIPE SCHEMATIC

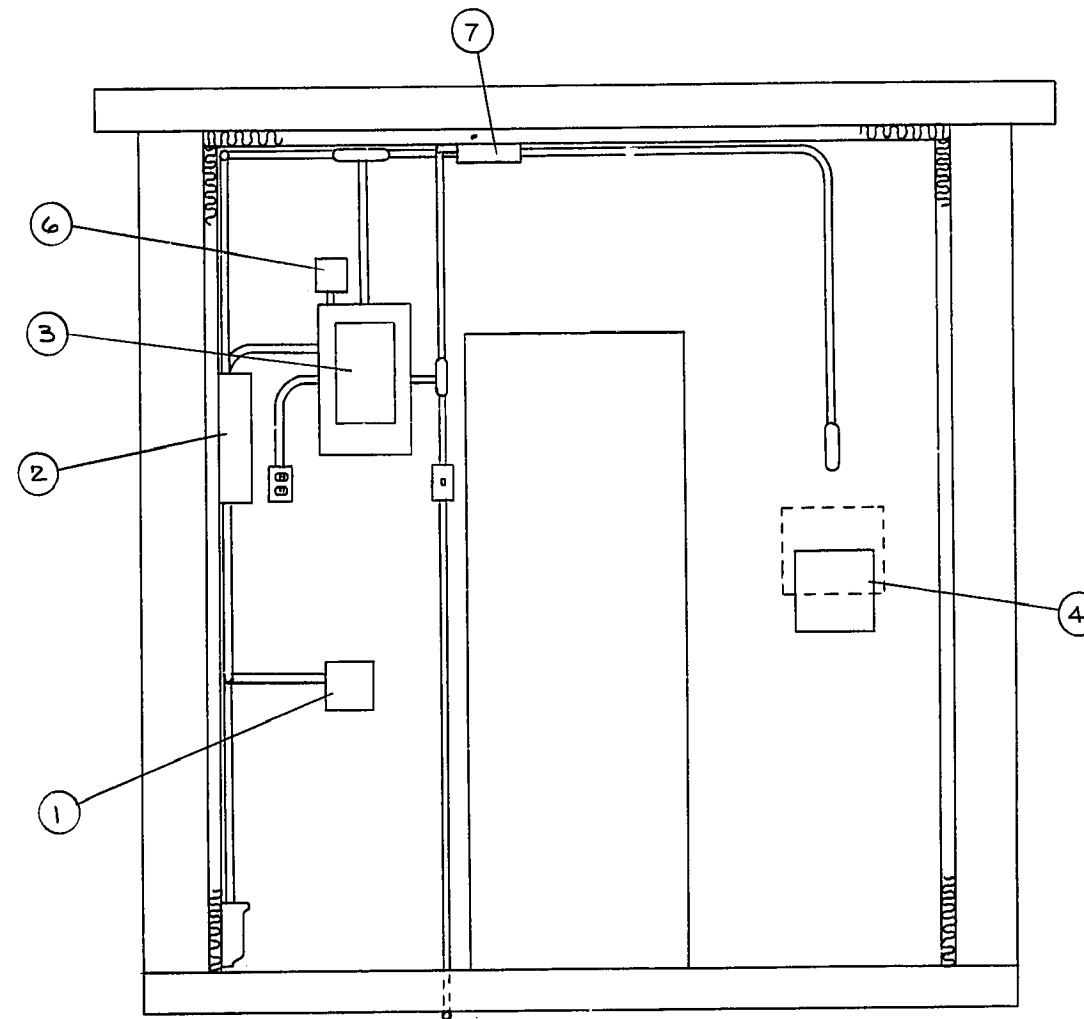

VIEW ON 'X'

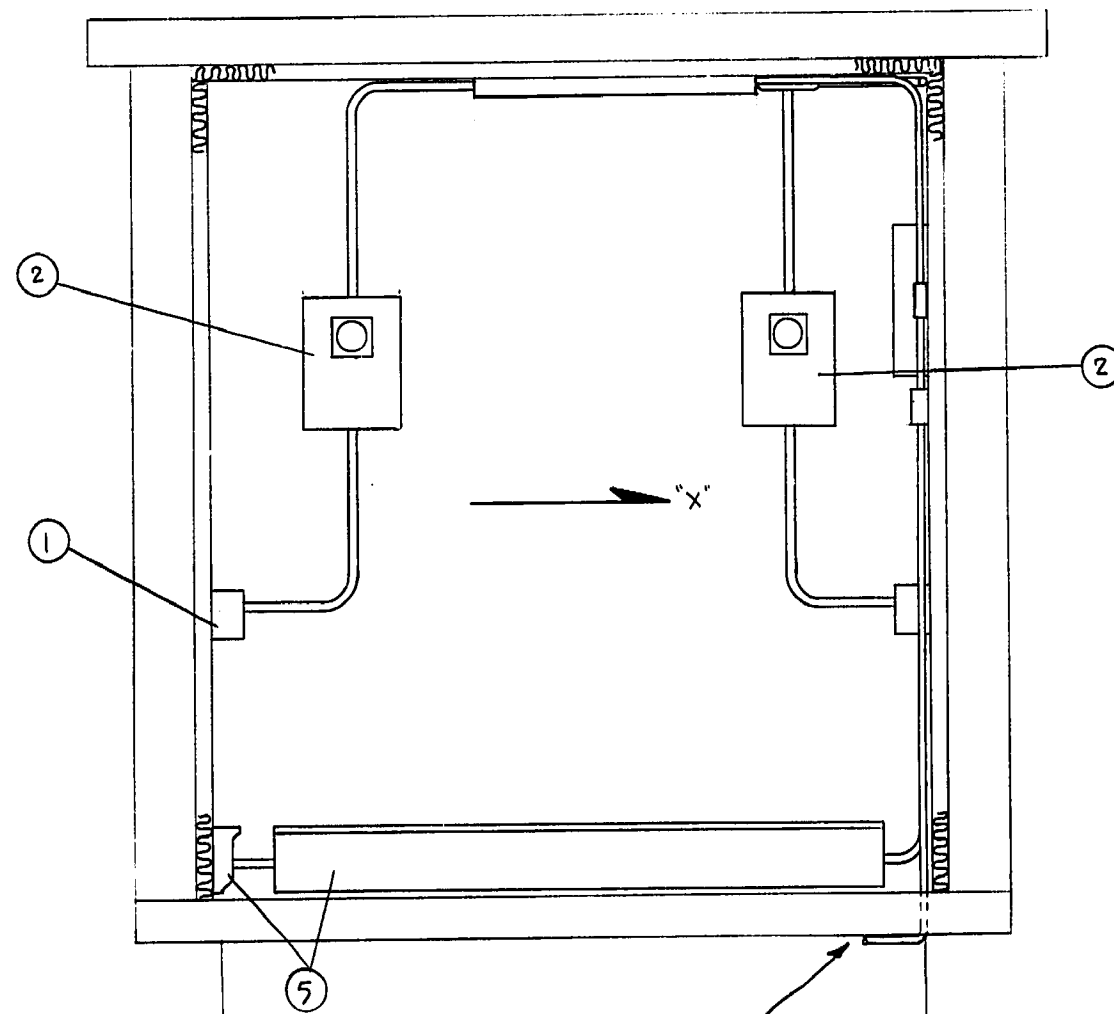

CONT'D ON DWG # D-1364

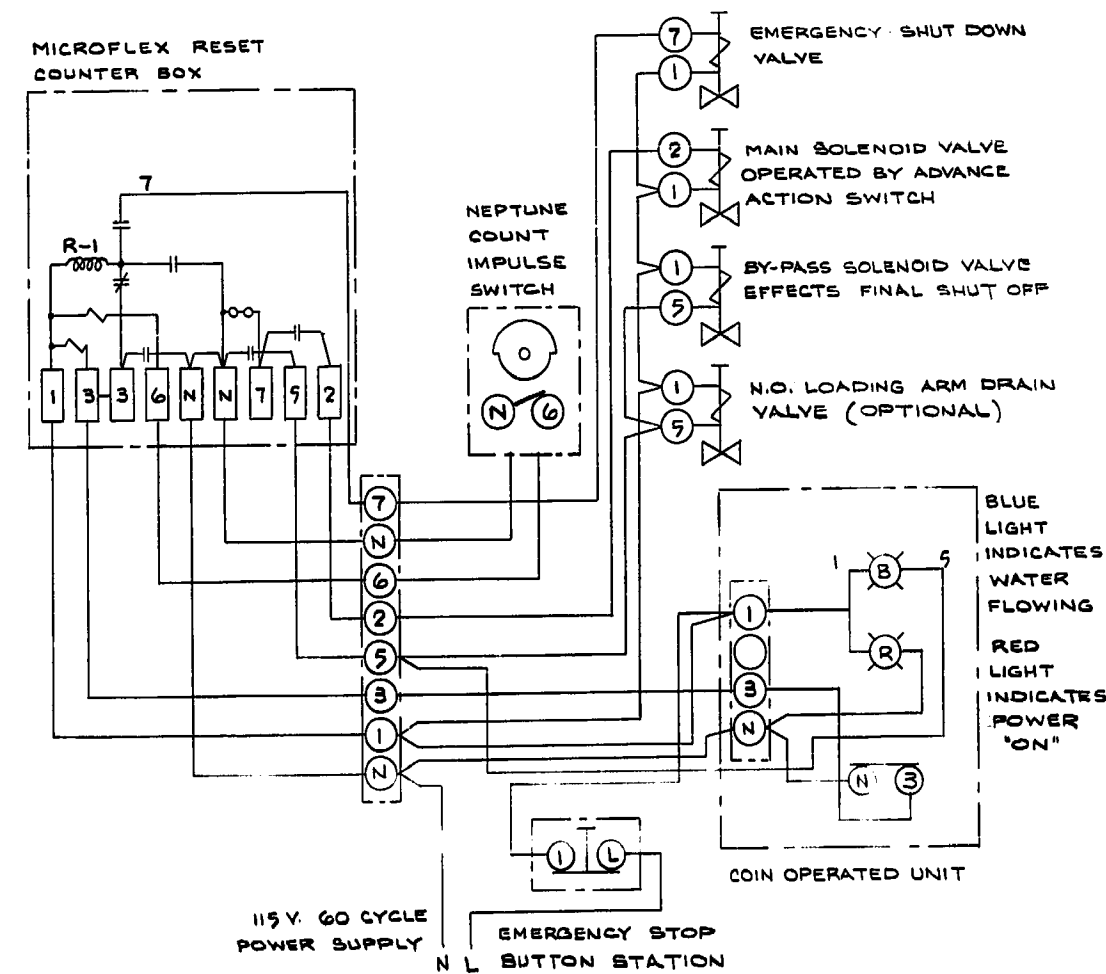

STAND PIPE SCHEMATIC

AS BUILT

SURVEY ENGINEERING DATE DEC 23 1977

NO.	DESCRIPTION	DATE	BY

REVISIONS

The City of Winnipeg
Waterworks, Waste and Disposal Division

ST JAMES - ASSINIBOIA STANDPIPE
ELECTRICAL HARDWARE LOCATION PLAN

DESIGNED BY	DRAWN BY RH
CHECKED BY	DATE 4-NOV-1977
APPROVED BY	
SCALE N.T.S.	DRAWING NO. D-1362