

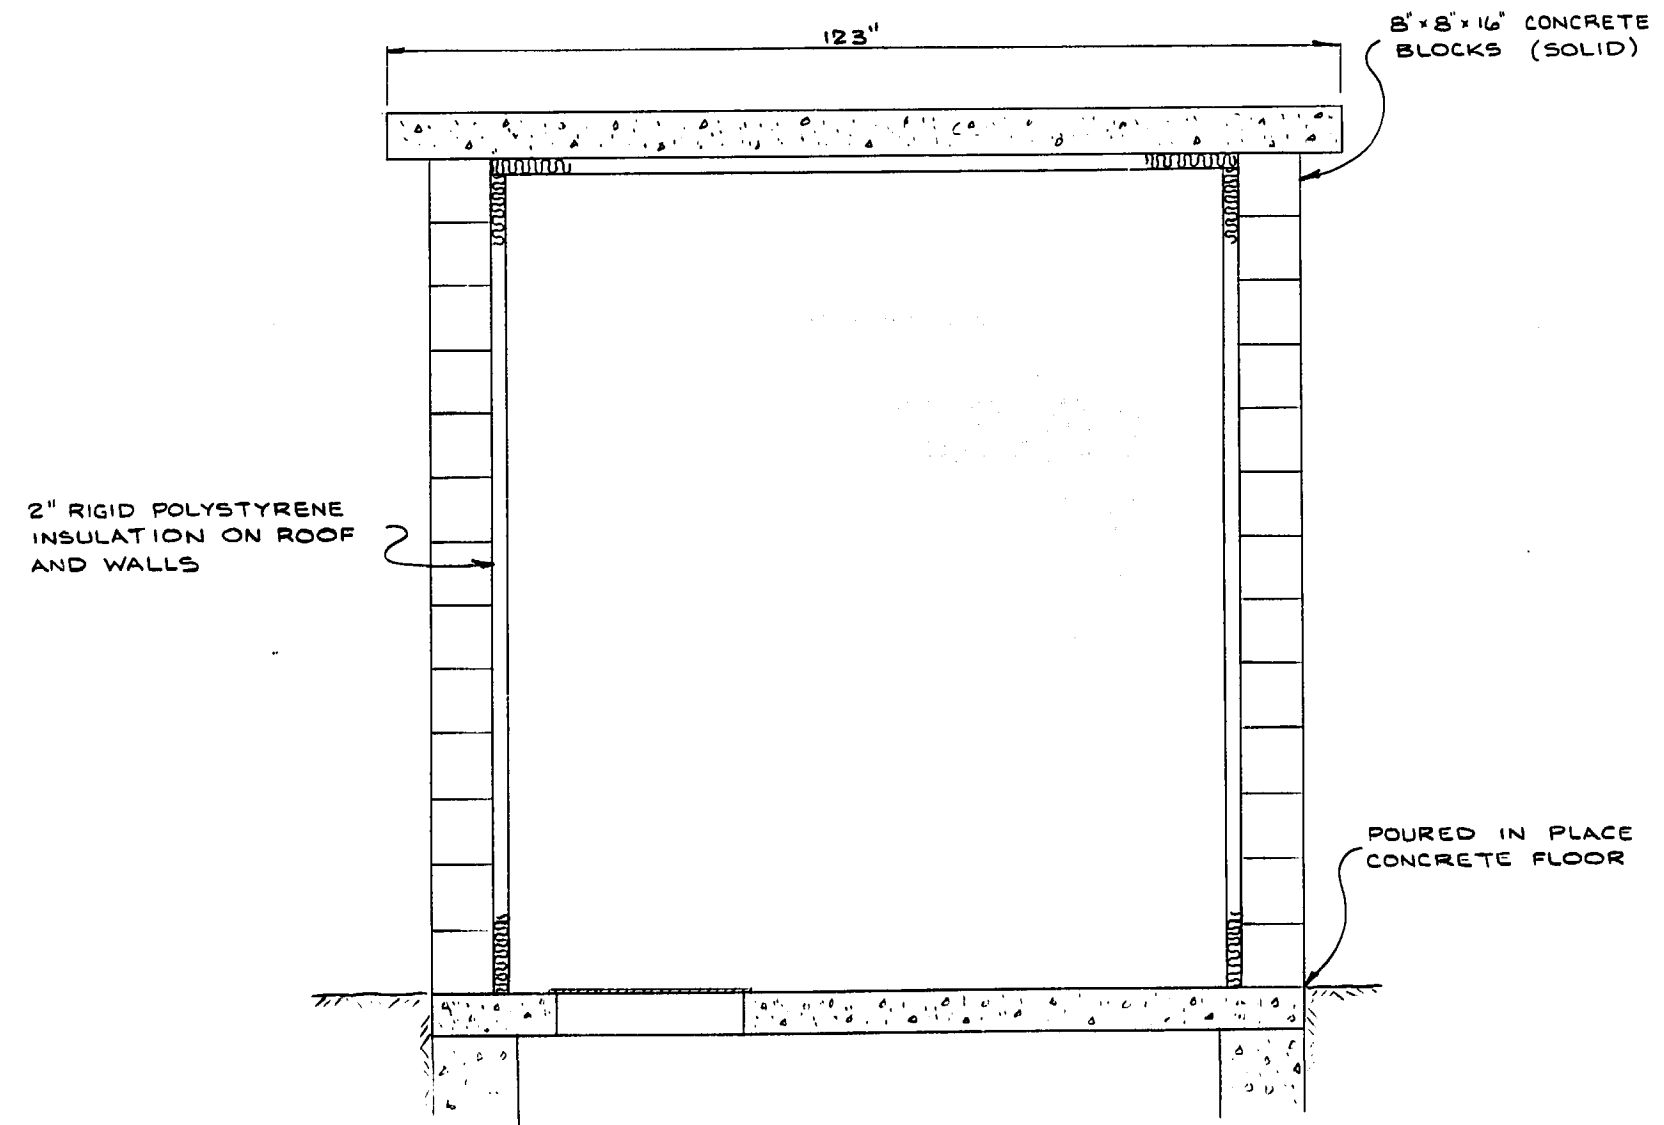


PLAN VIEW WITH ROOF REMOVED

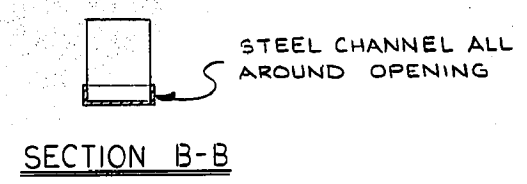

SECTION A-A

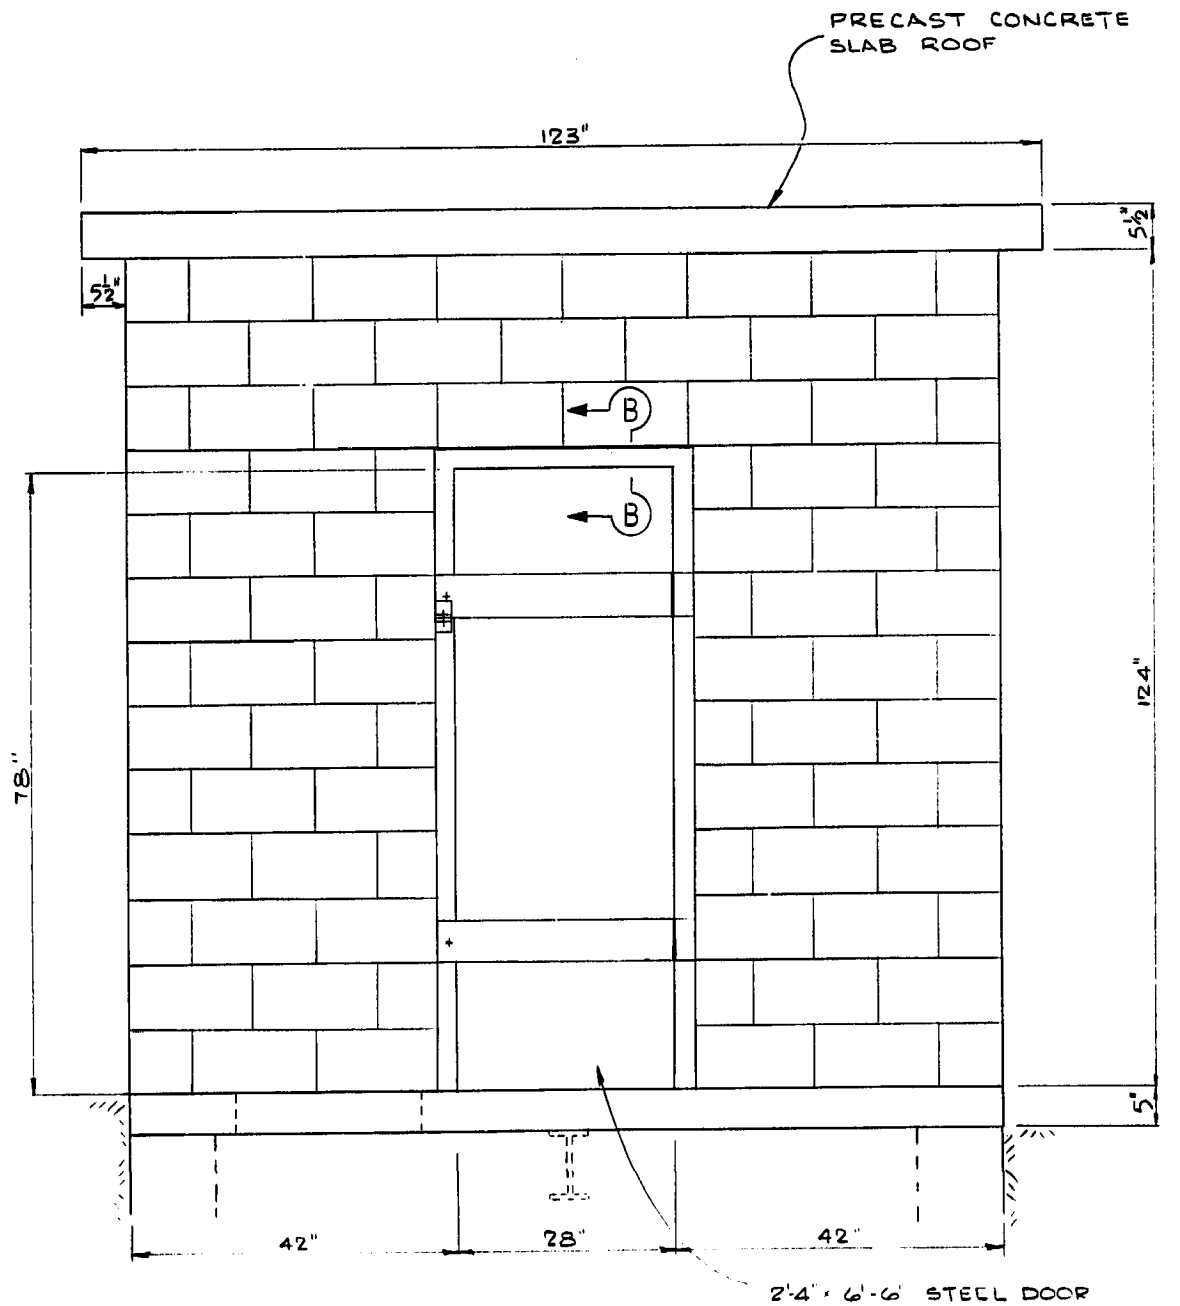

AS BUILT
SURVEY ENGINEERING DATE

- NOTES
1. EXTERIOR FINISH - STUCCO

NO.	DESCRIPTION	DATE	BY

The City of Winnipeg
Waterworks, Waste and Disposal Division

ST JAMES-ASSINIBOIA STANDPIPE
STANDPIPE BUILDING DETAIL

DESIGNED BY	DRAWN BY RH
CHECKED BY	DATE 31-OCT-1977
APPROVED BY	
SCALE N.T.S.	DRAWING NO. D-1363

MICROFILMED