


CHEVRIER BOULEVARD

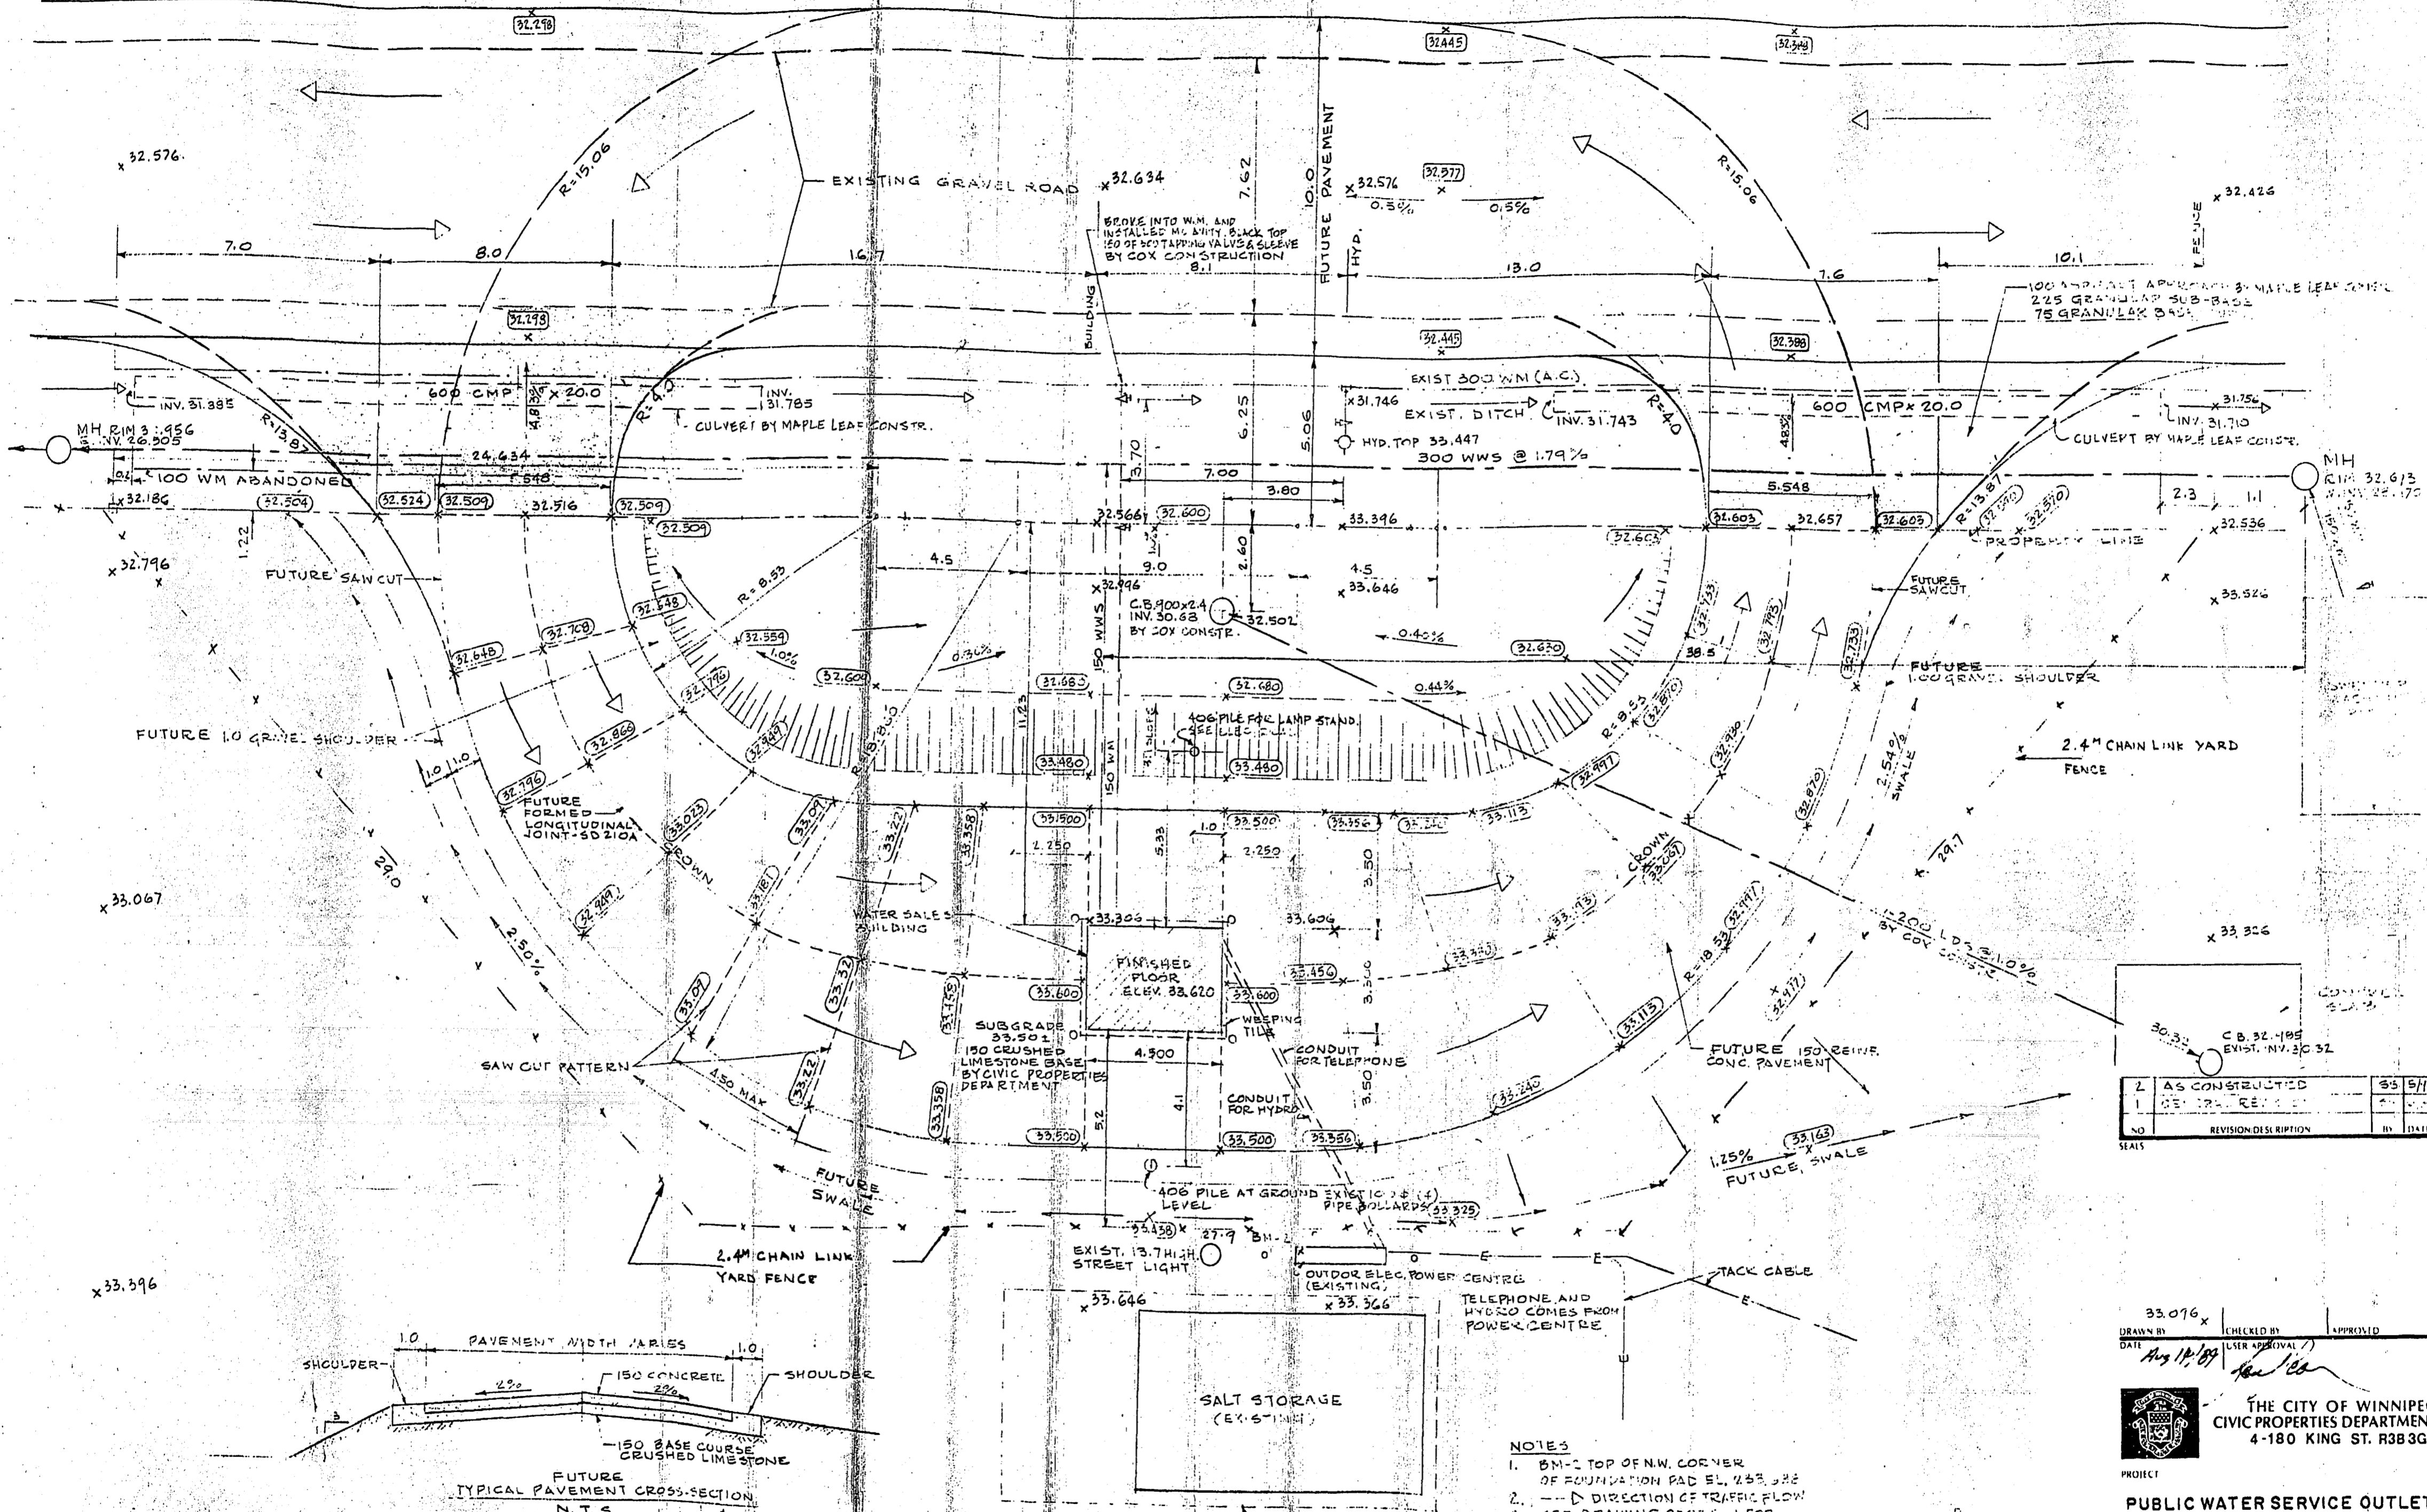

NO	REVISION DESCRIPTION	BY	DATE
2	AS CONSTRUCTED	SS	5/11
1	REVISED	SS	1/11
NO			

33,076
 DRAWN BY: [Signature]
 DATE: Aug 14, 89
 CHECKED BY: [Signature]
 USER APPROVAL: [Signature]

THE CITY OF WINNIPEG
 CIVIC PROPERTIES DEPARTMENT
 4-180 KING ST. R3B3G8

PROJECT
 PUBLIC WATER SERVICE OUTLET
 1539 WAVERLEY STREET
 (DISTRICT NO. 6 YARD)

SHEET TITLE
 SITE PLAN

- NOTES
- BM-2 TOP OF N.W. CORNER OF FOUNDATION PAD EL. 253.382
 - DIRECTION OF TRAFFIC FLOW
 - SEE DRAWING 87023-1 FOR GENERAL LEGEND
- 33,680 EXISTING GRADE
 33,325 FUTURE GRADE

CONSTRUCTED IN 1989 AND 1940
 BY PALCOR CONSTRUCTION

MANENGO ENGINEERING
 Telephone 885-7251 Winnipeg, Manitoba

SCALE: 1:100
 PROJECT NO:
 SHEET NO: