



SECTION LOOKING SOUTH
 SCALE: 1 : 50

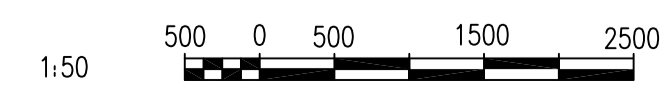


APCM
 Certificate of Authorization
 SNC-Lavalin Inc.
 No. 4489

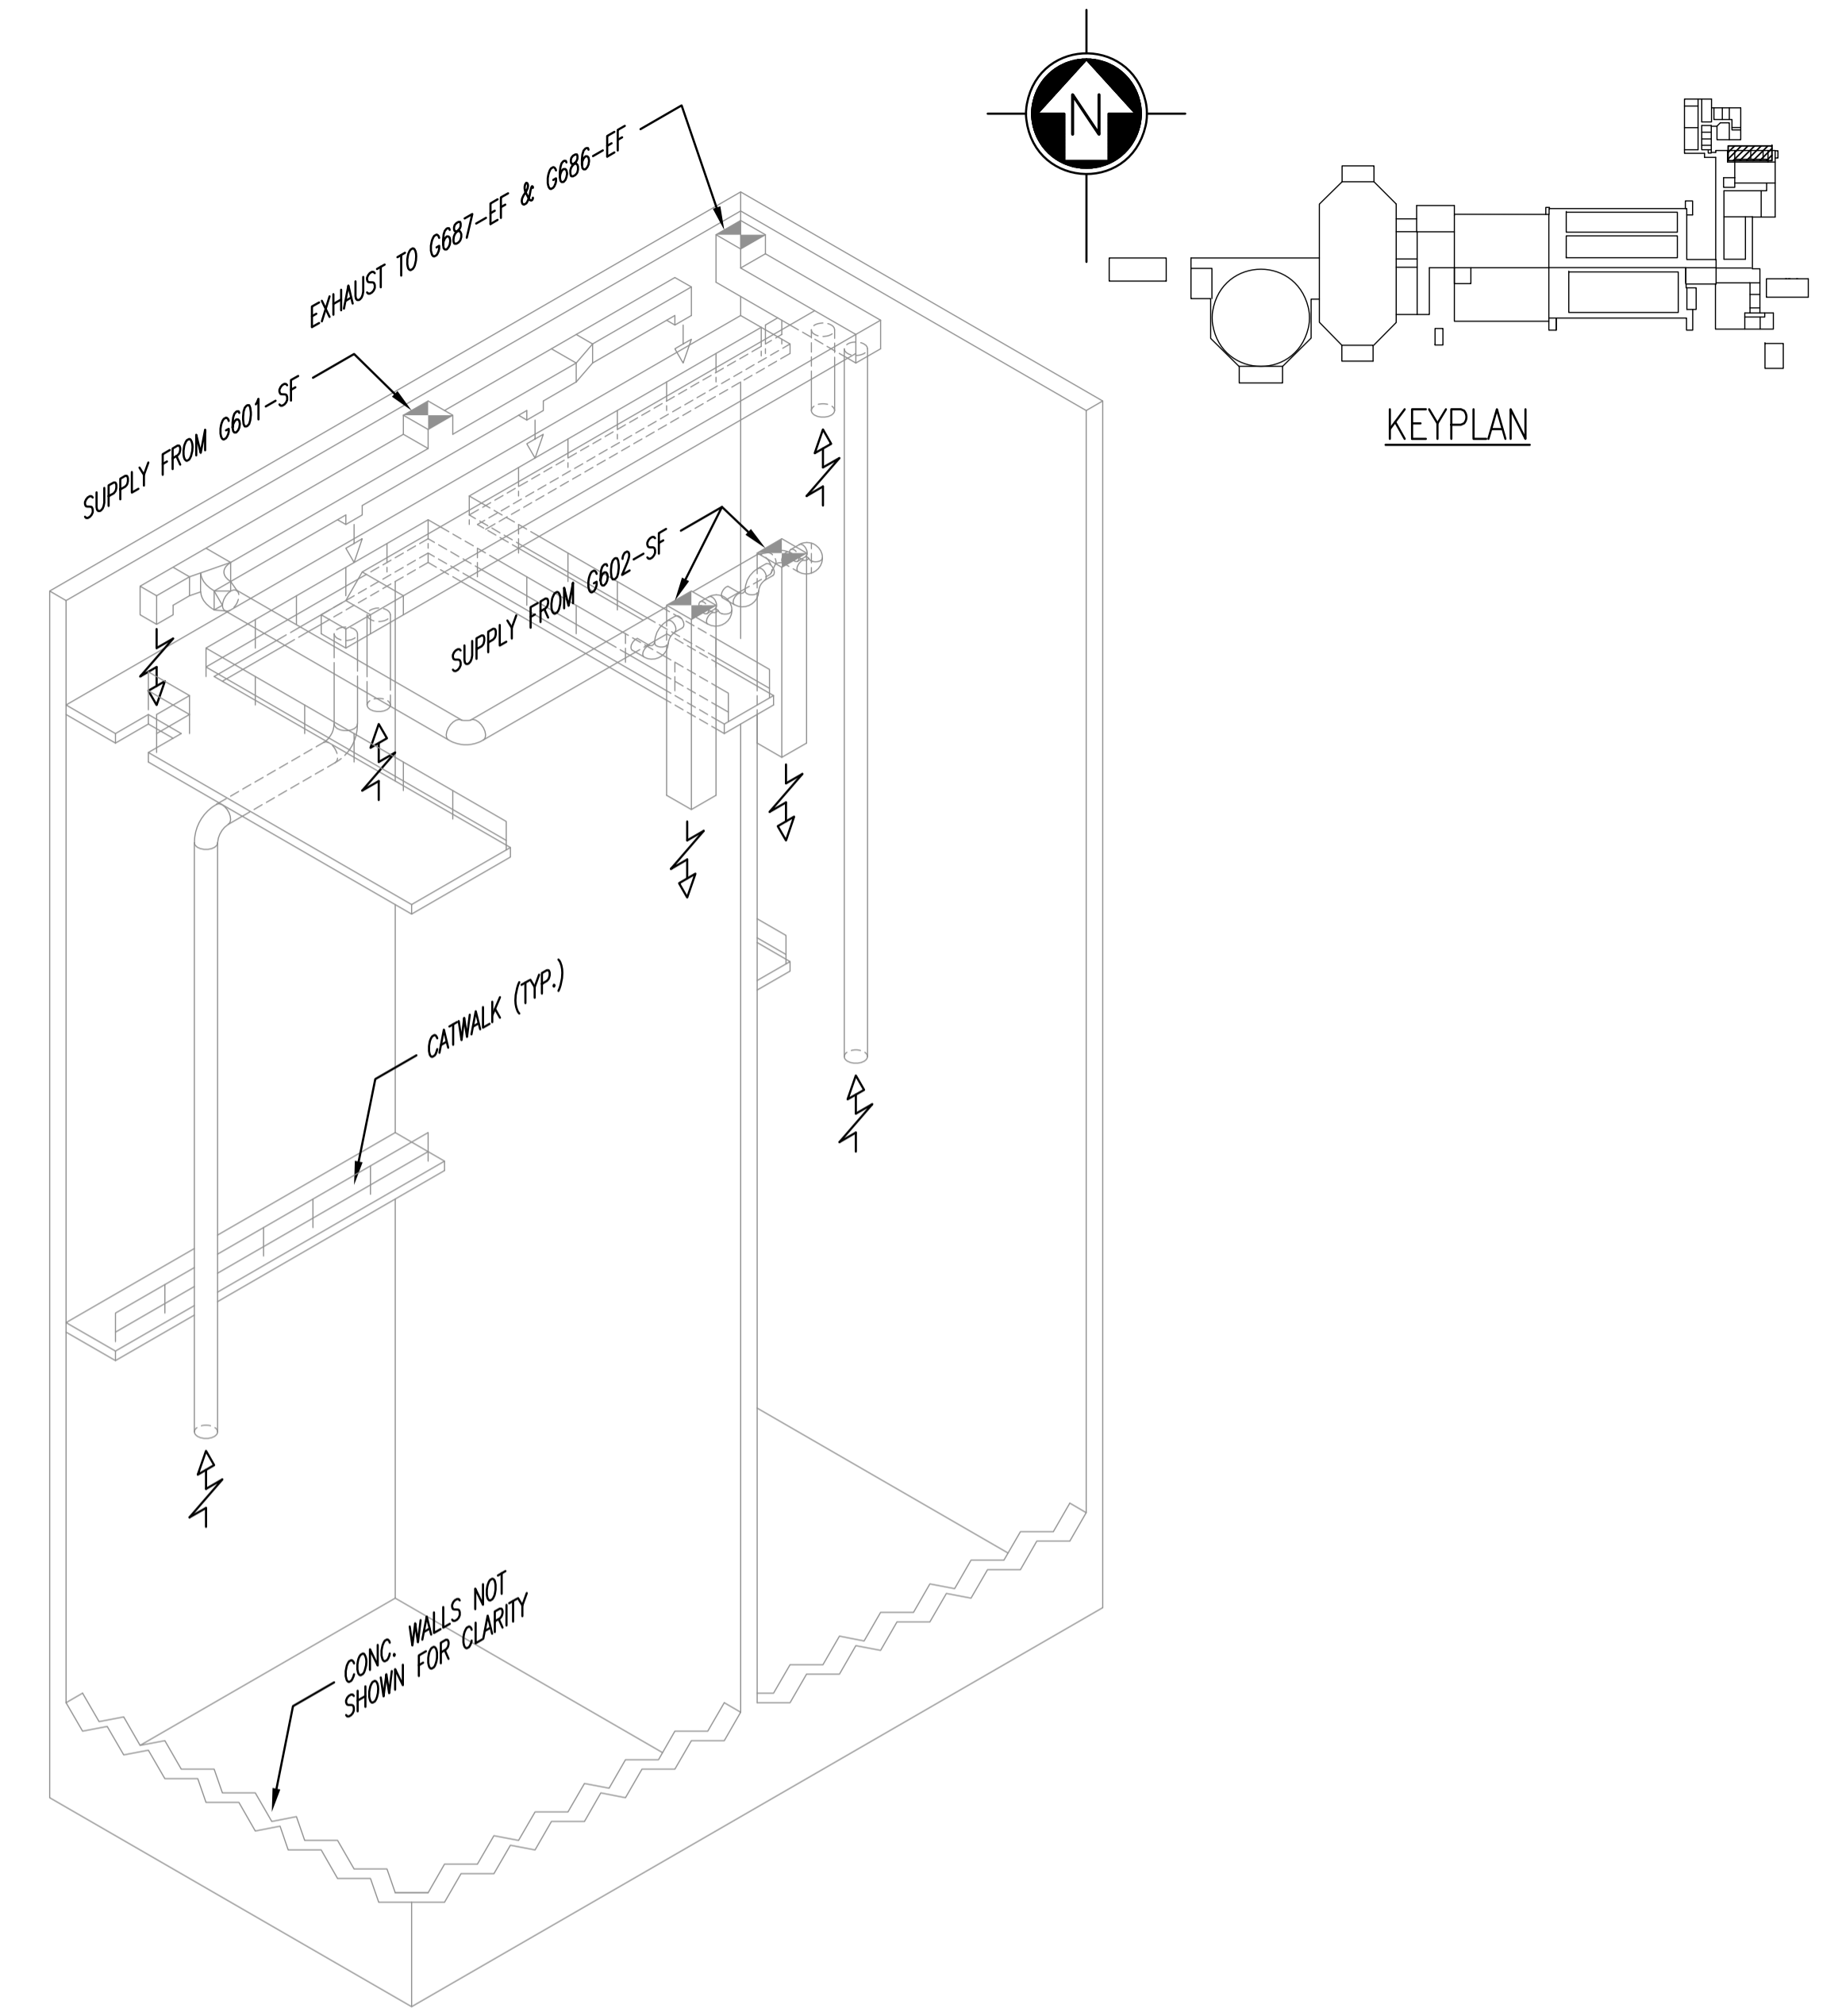

VENTILATION ISOMETRIC
 SCALE: NONE

- NOTES:
 1. INSPECT DUCTWORK FOR ANY POTENTIAL ASBESTOS CONTAINING MATERIALS. REFER TO ASBESTOS ABATEMENT SPECIFICATION FOR ABATEMENT PROCEDURES IF ASBESTOS IS ENCOUNTERED.

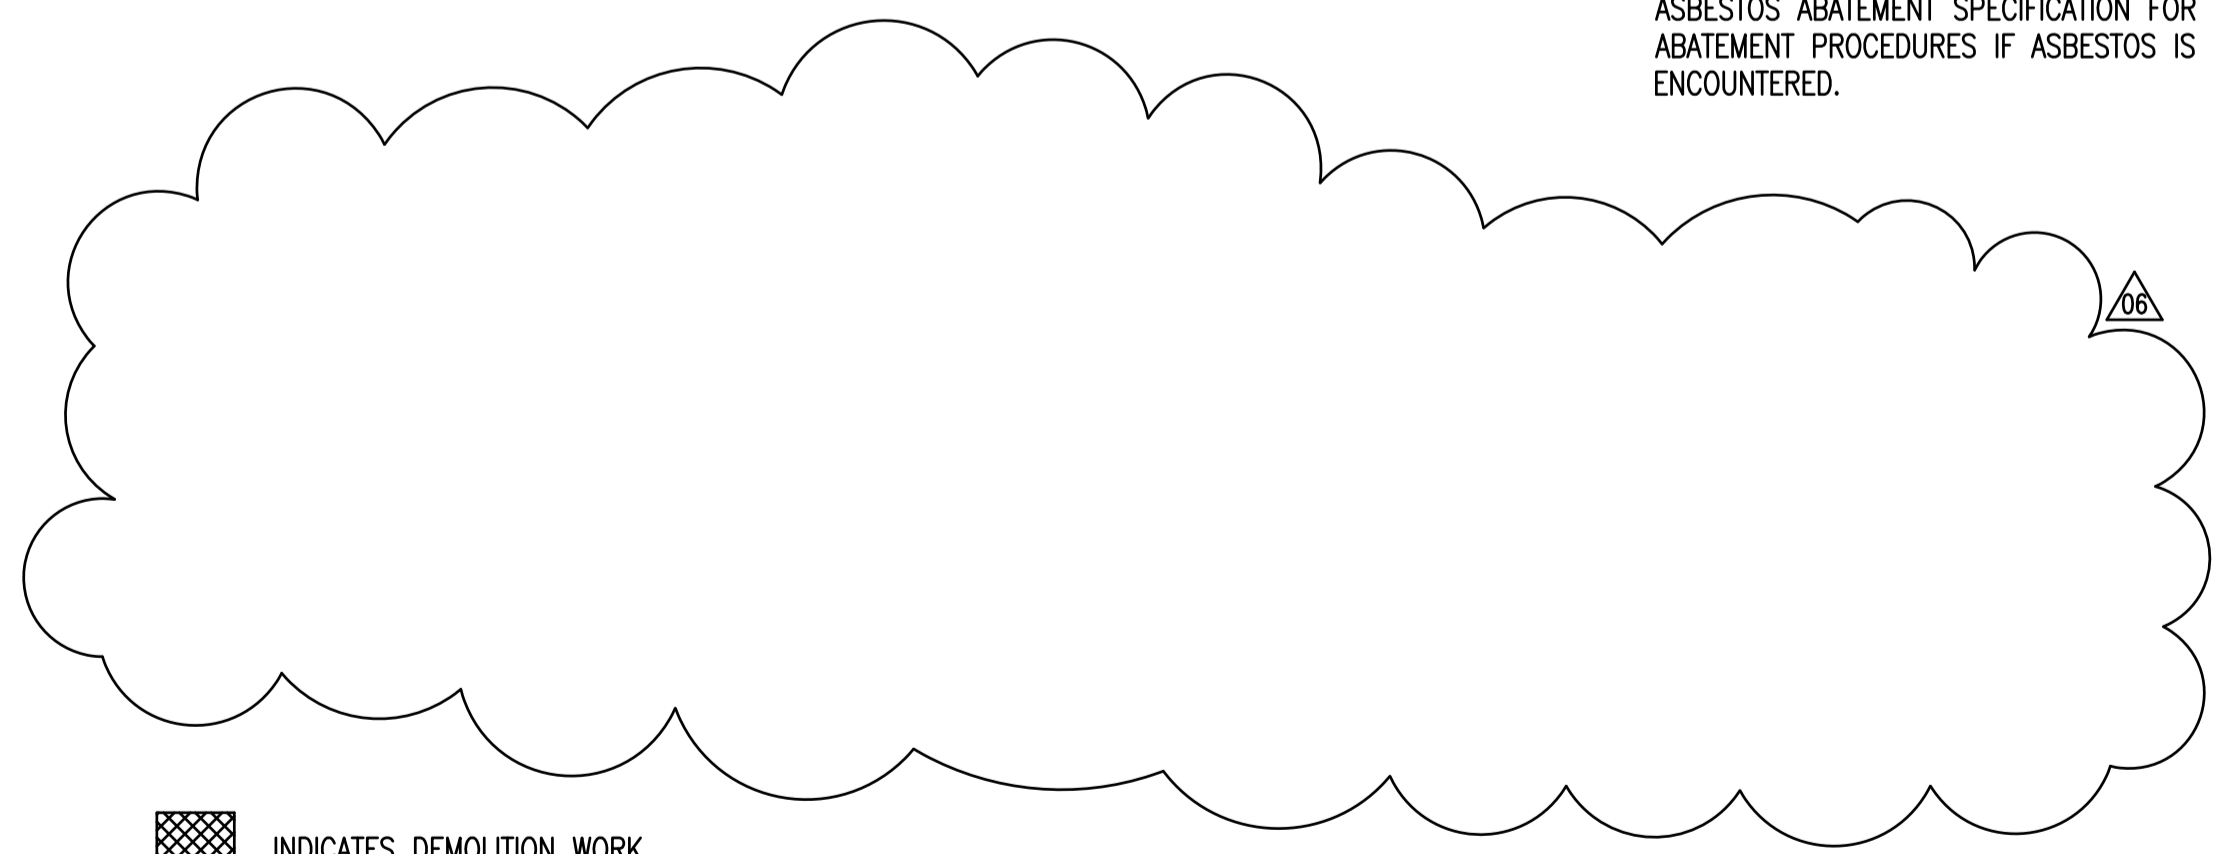

INDICATES DEMOLITION WORK

SNC-LAVALIN 148 Nature Park Way Winnipeg, MB, Canada R3P 0X7 204-786-8080				ENGINEER'S SEAL 		THE CITY OF WINNIPEG WATER AND WASTE DEPARTMENT SOUTH END WATER POLLUTION CONTROL CENTRE VENTILATION & MISC. UPGRADES HVAC DUCTING SECTION WET WELL VENTILATION	
06 ISSUED FOR ADDENDUM 4 - 976-2016 05 ISSUED FOR CONSTRUCTION - 976-2016 04 ISSUED FOR 90% PRELIMINARY REVIEW 03 AS-BUILT, BID OPP. 42-2013 02 ISSUED FOR CONSTRUCTION 01 ISSUED FOR TENDER, BID OPP. 42-2013 00 ISSUED FOR TENDER, BID OPP. 545-2012	2017/06/30 2017/04/05 2016/05/08 2014/07/10 2013/10/23 2013/03/25 2012/09/10	K.F. J.C. K.F. J.C. K.F. J.C. T.M.C. TRS SN TRS SN TRS SN	DESIGNED BY: S. NORSWORTHY DRAWN BY: K. MOHAMMED DATE: 2017/04/05 CONSULTANT NO.: 112577-0116-45DD-0110	CHECKED BY: S. NORSWORTHY APPROVED BY: C. REIMER BY: J. SHUMKA DATE: 2017/04/05	SHEET 001 REV. 06 SIZE A1	CITY DRAWING NUMBER 1-0102G-M0010	1-0102G-M0010-001-04.dwg