


DRAWING NOTES:

1. SEE CITY DRAWING NUMBER 1-0102U-S0003-001 FOR GENERAL NOTES.

2. SEE CITY DRAWING NUMBER 1-0102U-S0003-001 FOR WALL, SLAB AND BEAM SCHEDULE.

3. SEE CITY DRAWING NUMBER 1-0102U-S0004-001 FOR CONCRETE SECTIONS & TYPICAL DETAILS.

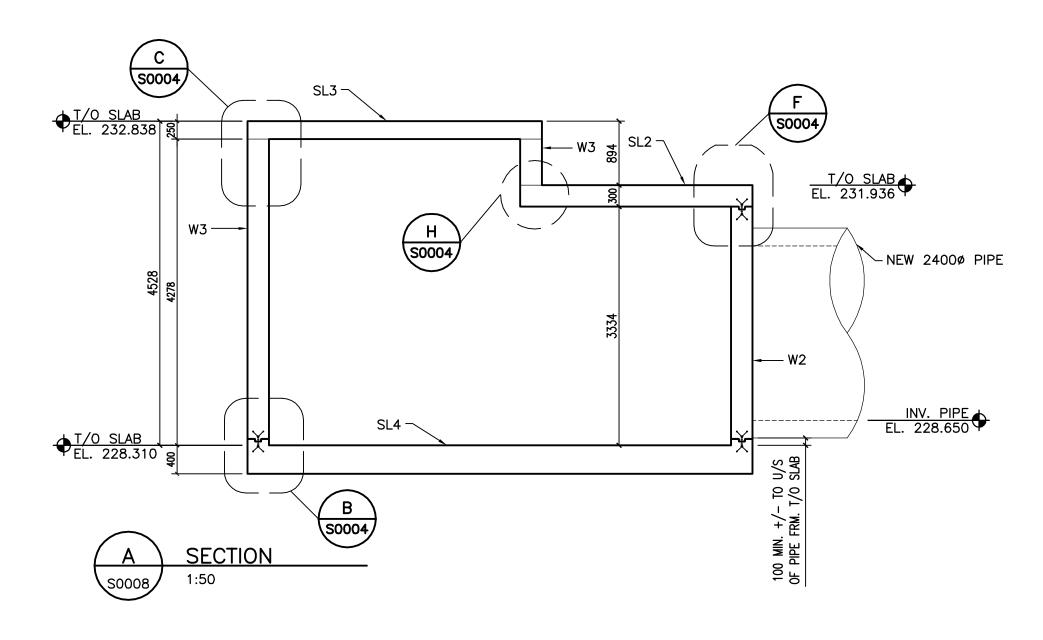

83R066 — N. side Frobisher Rd., 0.25km W. of St. Mary's Rd., Tblt. on top of 0.05m dia. x 1.2m iron pipe (near conc. gate chamber), 7.1m Nly. of N. side & 9.8m Wly. of W. side of conc. gate chamber 0.25km W. of St. Mary's Rd.

Certificate of Authorization
Stantec Consulting Ltd.
No. 1301

RECORD DRAWING

BY G.L. / M.F. DATE 12.08.27

CHECKED BY B.F.

CONSTRUCTION COMPLETION DATE - APRIL 2011

LOCATION APPROVED ENGINEER'S SEAL THE CITY OF WINNIPEG Stantec Consulting Ltd. UNDERGROUND STRUCTURES WATER AND WASTE DEPARTMENT 905 Waverley Street, Winnipeg, Manitoba Tel 204-489-5900 Fax 204-453-9012 Winnipeg SUPV. U/G STRUCTURES DATE COMMITTEE ORIGINAL Stantec SEALED BY SOUTH END WATER POLLUTION CONTROL CENTRE CHECKED BY DESIGNED B.E. FRASER T.D. P. ENG. INSTALLATION OF OUTFALL PIPE LOCATION OF UNDERGROUND STRUCTURES AS SHOWN ARE BASED ON THE BEST INFORMATION AVAILABLE BUT NO GUARANTEE IS GIVEN 12/08/28 APPROVED EFFLUENT SAMPLING FACILITY AND ASSOCIATED WORKS C.M. THAT ALL EXISTING UTILITIES ARE SHOWN OR THAT THE GIVEN LOCATIONS ARE EXACT. CONFIRMATION OF EXISTENCE AND EXACT LOCATION OF ALL SERVICES MUST BE OBTAINED FROM THE INDIVIDUAL UTILITIES BEFORE PROCEEDING WITH CONSTRUCTION. CHAMBER NO.4 2 DWG WAS 1-0102A-S0006-001 |12.10.02 SW PLAN & SECTION AS NOTED RELEASED FOR CONSTRUCTION: HOR. SCALE: 12.02.03 G.L. RECORD DRAWING VERTICAL: BID OPPORTUNITY NO. 09.10.13 H.A.K. ISSUED FOR TENDER 1-0102U-S0008-001 709-2009 DATE BY NO. REVISIONS DATE 09.09.21 DATE

11208958\584_Drawing\record\Sheet Files\03_Structura\08958_cmbr_s1

METRIC
WHOLE NUMBERS INDICATE MILLIMETRES
DECIMALIZED NUMBERS INDICATE METRES