




**1 SECTION/ELEVATION**  
1403C 1404C 1 : 25  
- HANDRAILS NOT SHOWN

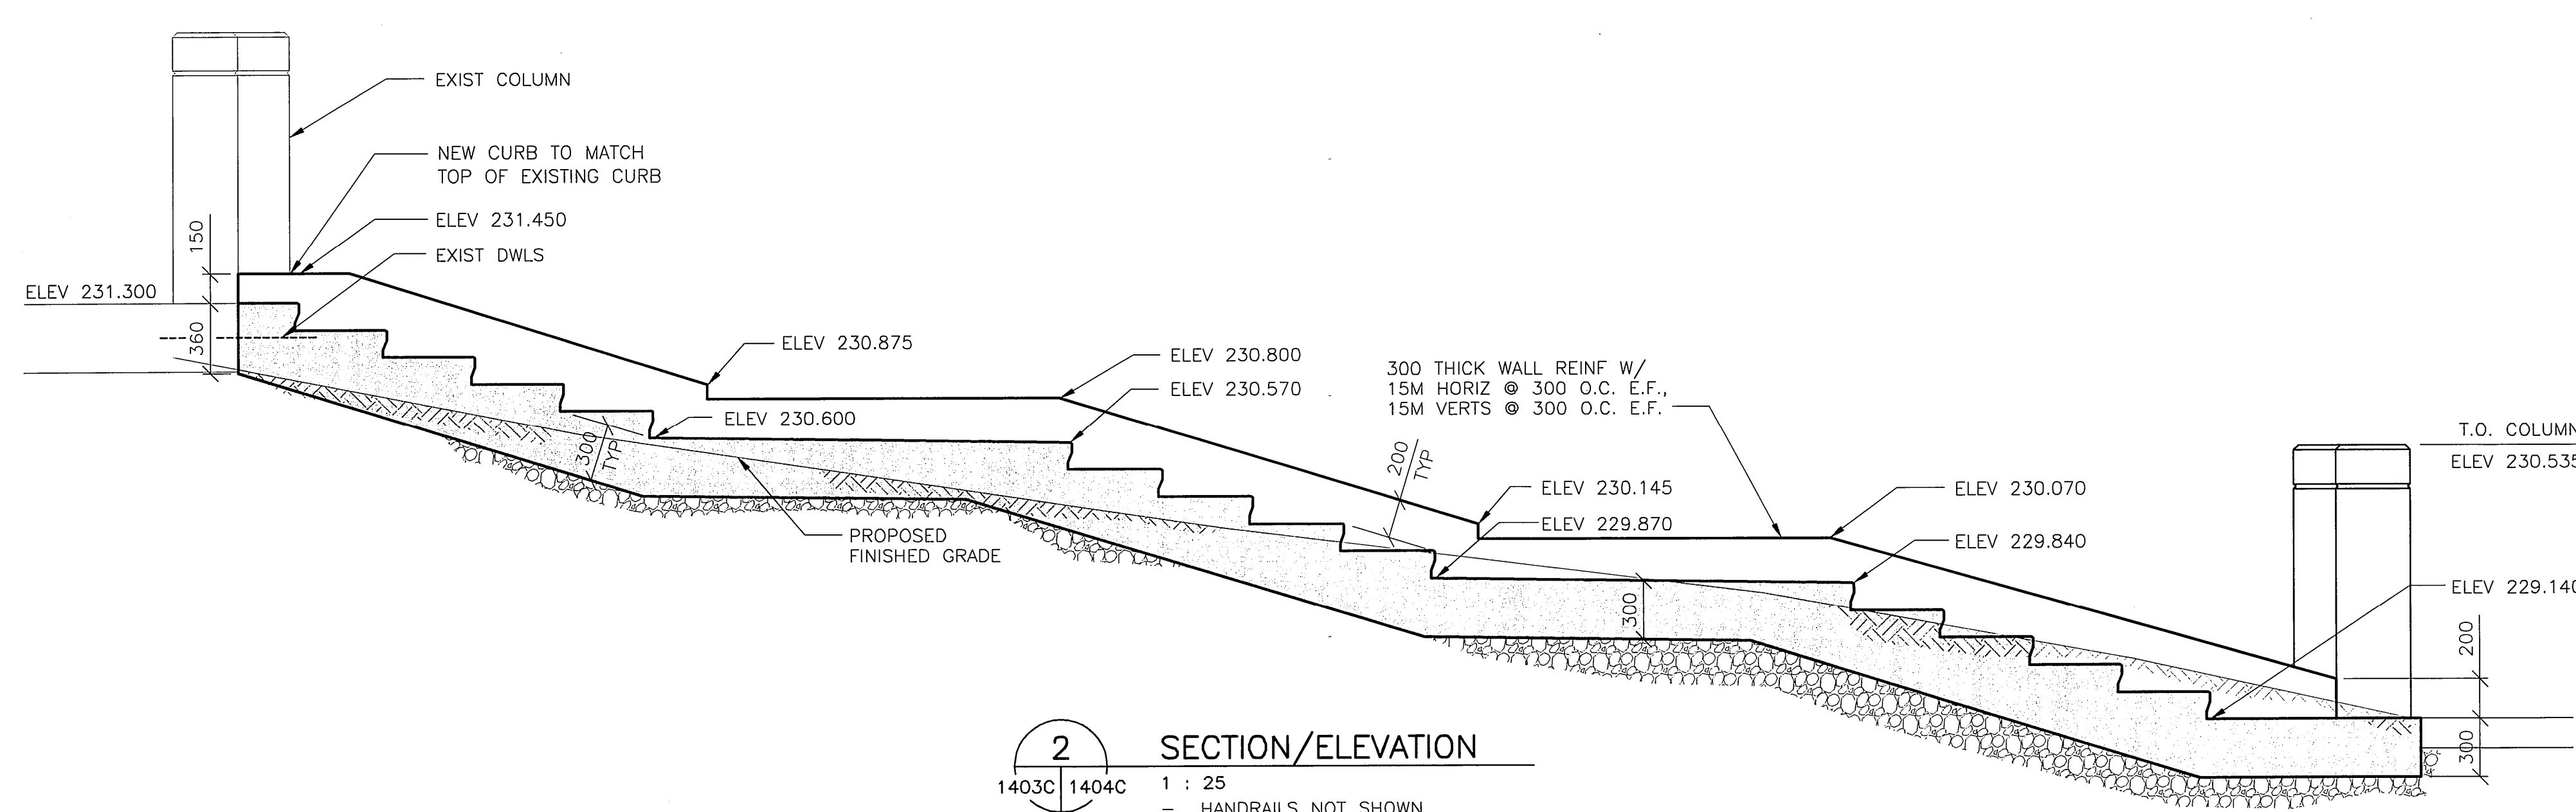


**2 SECTION/ELEVATION**  
1403C 1404C 1 : 25  
- HANDRAILS NOT SHOWN

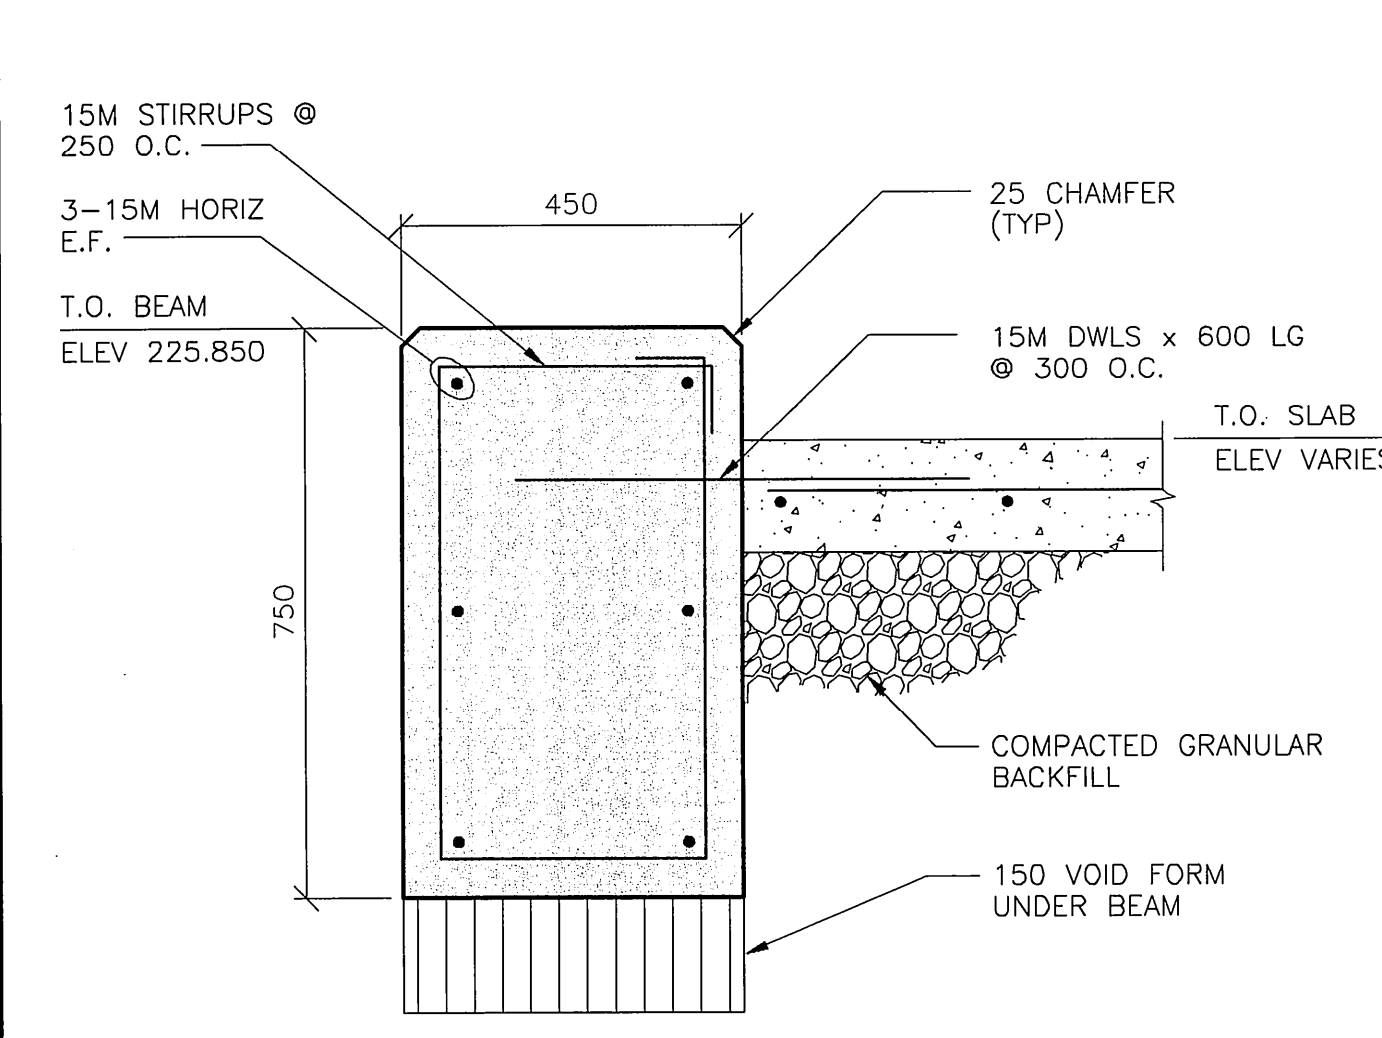


**3 SECTION**  
1403C 1404C 1 : 10

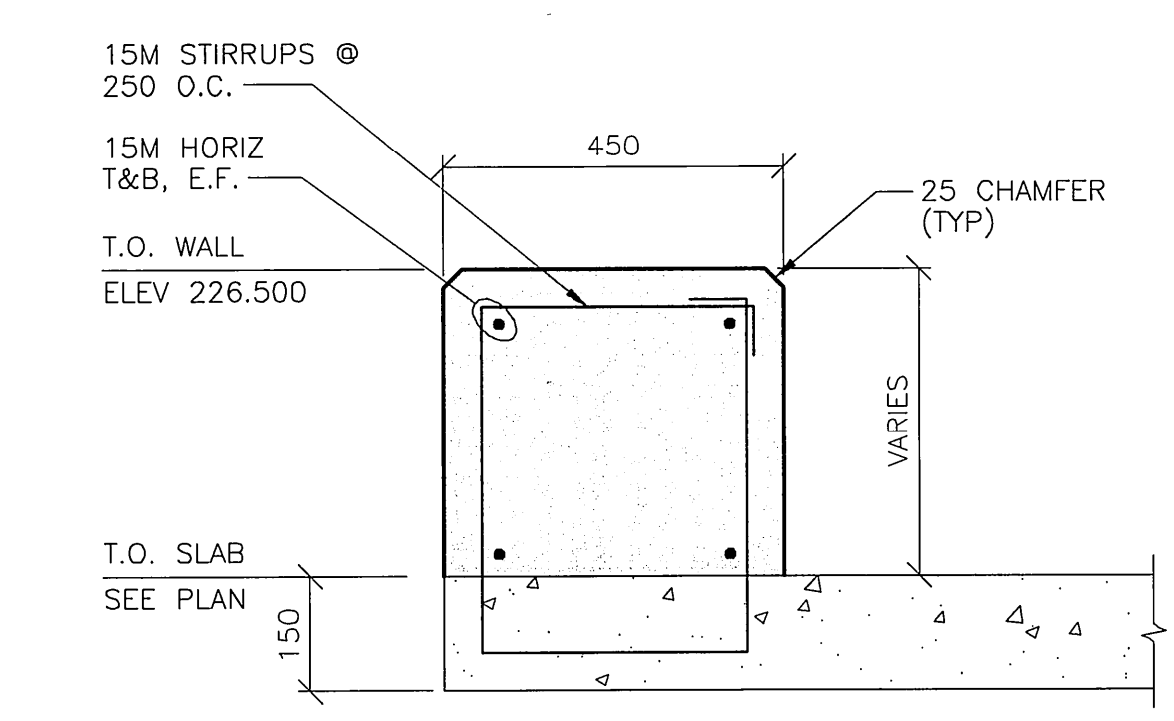


**4 SECTION**  
1403C 1404C 1 : 10

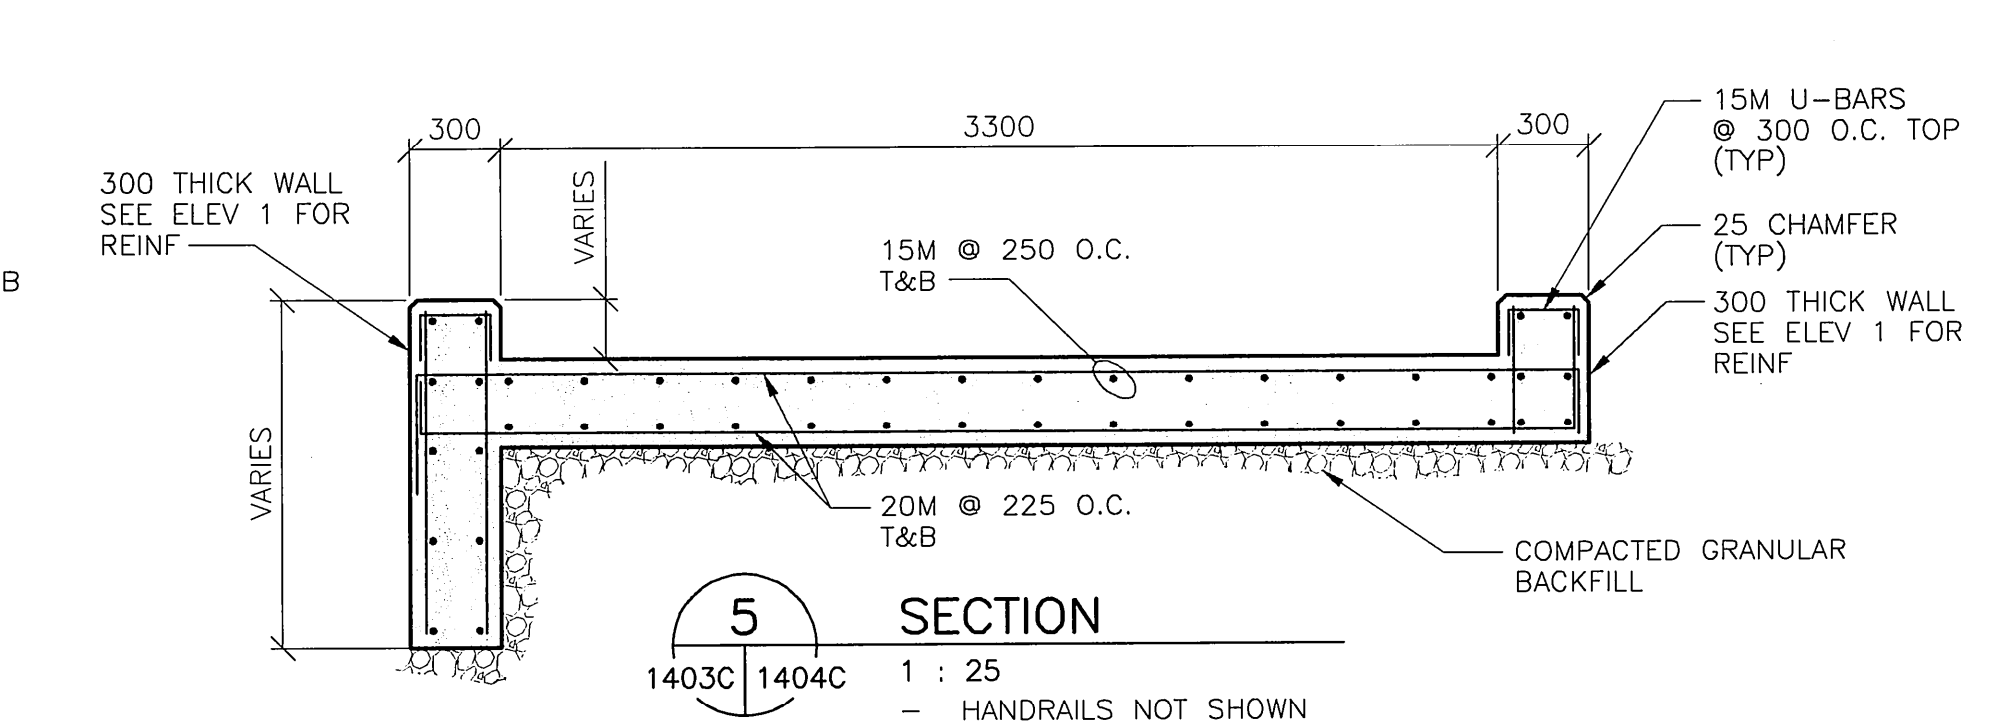


**5 SECTION**  
1403C 1404C 1 : 25  
- HANDRAILS NOT SHOWN

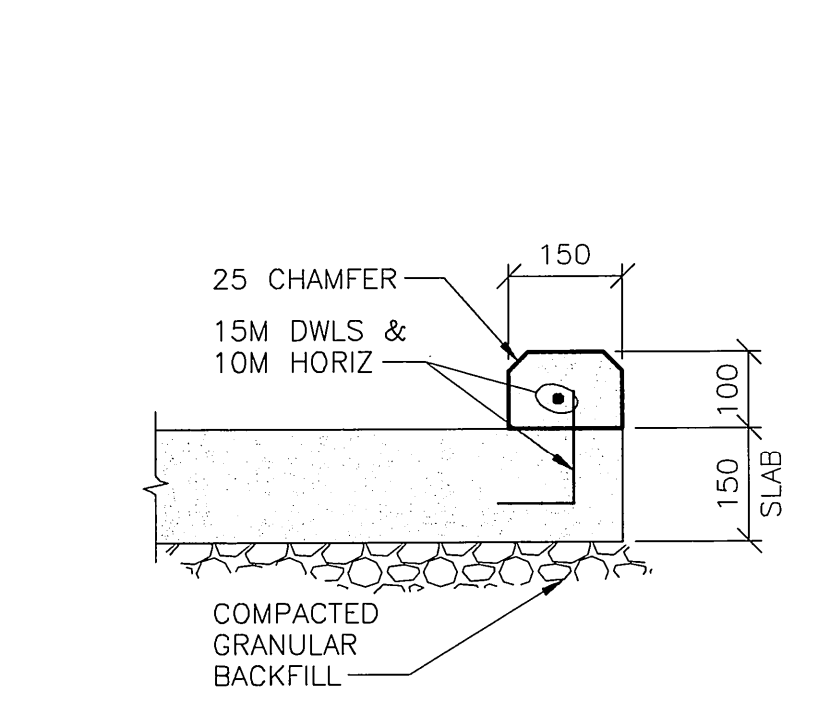

**6 CURB DETAIL**  
1403C 1404C 1 : 10

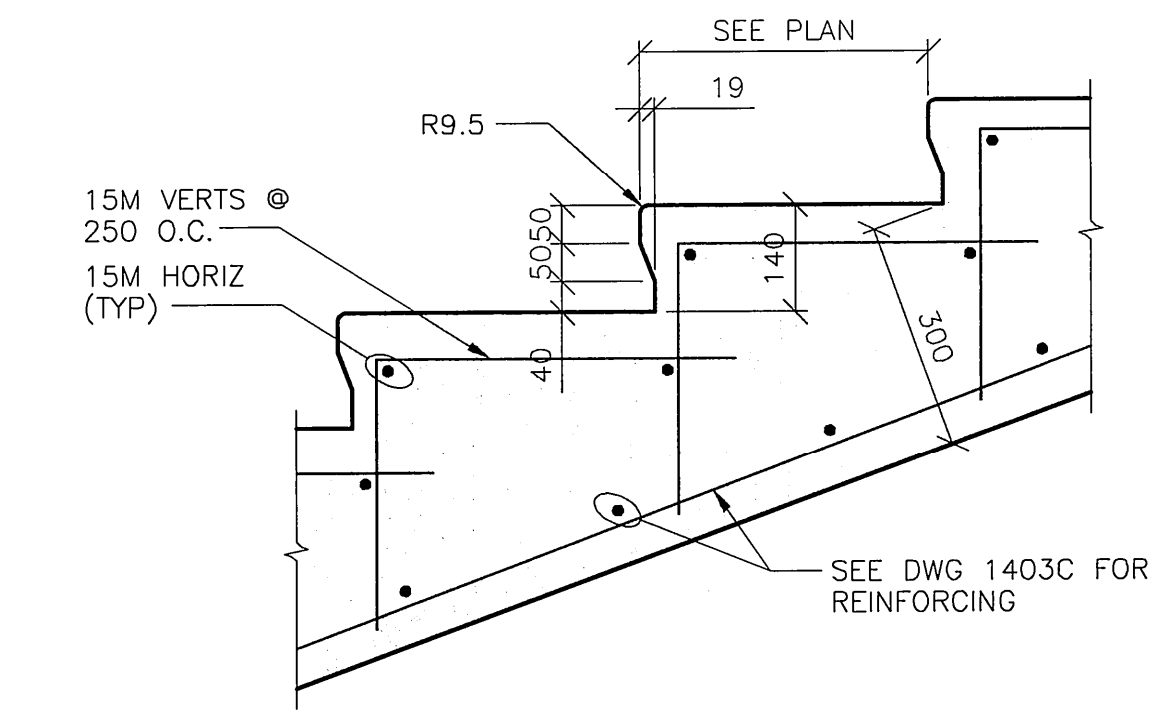


**7 TYP NOSING DETAIL**  
1403C 1404C 1 : 10  
- SEE DWG 1303 FOR NONSLIP TAPE DETAILS

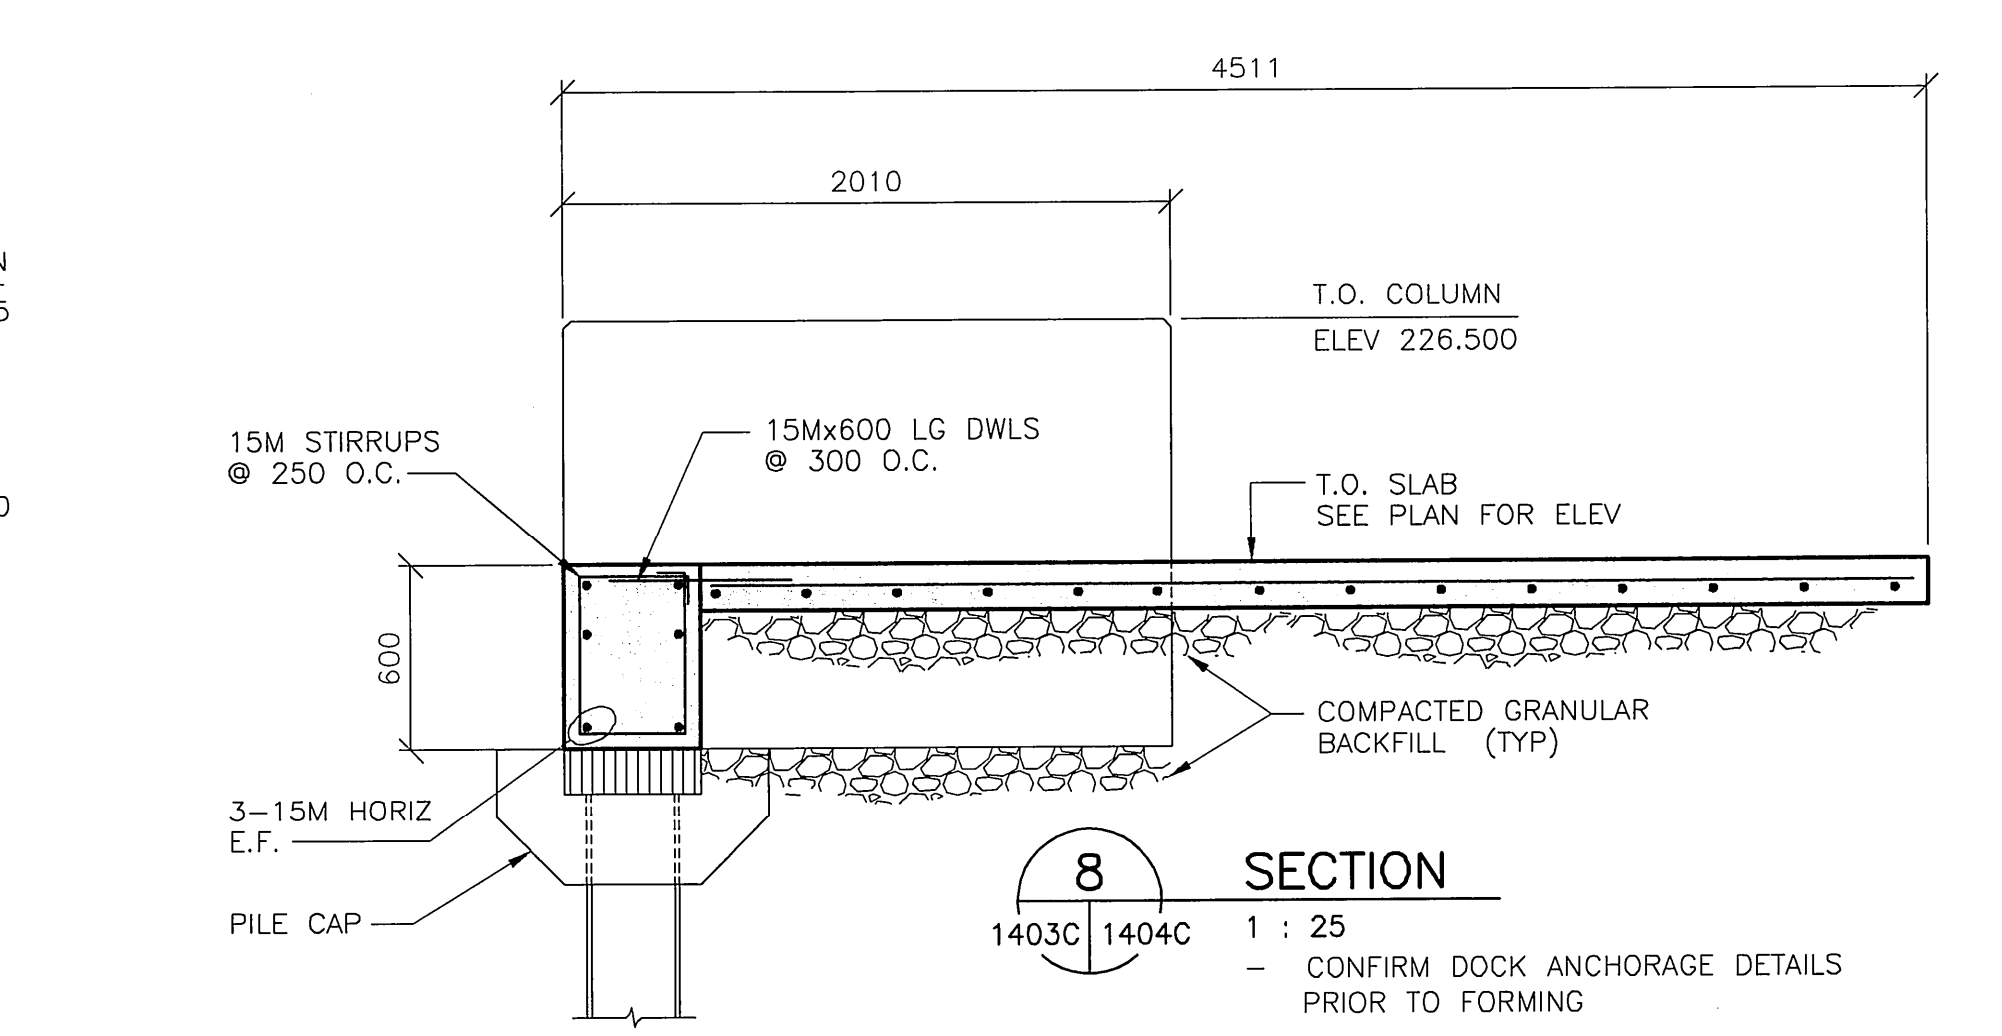

**8 SECTION**  
1403C 1404C 1 : 25  
- CONFIRM DOCK ANCHORAGE DETAILS PRIOR TO FORMING

**RECORD DRAWING**  
DATE 05.01.20 BY G.I.  
REVIEWED BY *BF*

**APEGM**  
Certificate of Authorization  
Wardrop Engineering Inc.  
No. 195 Expiry: April 30, 2004

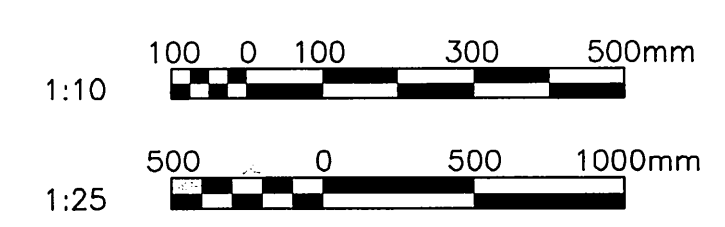

B.M. ELEV.	F.B.	<b>WARDROP</b> Engineering Inc.	ORIGINAL DRAWING REVISION "0" SEALED BY C.R. MICHALUK 03.10.10	<b>THE CITY OF WINNIPEG</b> PUBLIC WORKS DEPARTMENT ENGINEERING DIVISION	CITY DRAWING NUMBER <b>B231-02-128</b> SHEET OF
DESIGNED BY S.B./C.R.M.	CHECKED BY C.R.M.	DRAWN BY G.I.	APPROVED BY R.H.W.	CONSULTANT DRAWING NO. 010007-13-05	<b>PROVENCHER PAIRED BRIDGES PROJECT</b> PEDESTRIAN BRIDGE
1 RECORD DRAWING 05.01.20 <i>BF</i>		HOR. SCALE: AS NOTED	ACCEPTED BY		<b>EAST LANDING ELEVATIONS, SECTIONS AND DETAILS</b>
0 ISSUED FOR CCO No. 45 03.10.10 C.R.M.		VERTICAL:	DATE 03.10.10		
NO. REVISIONS	DATE	BY	DATE		