

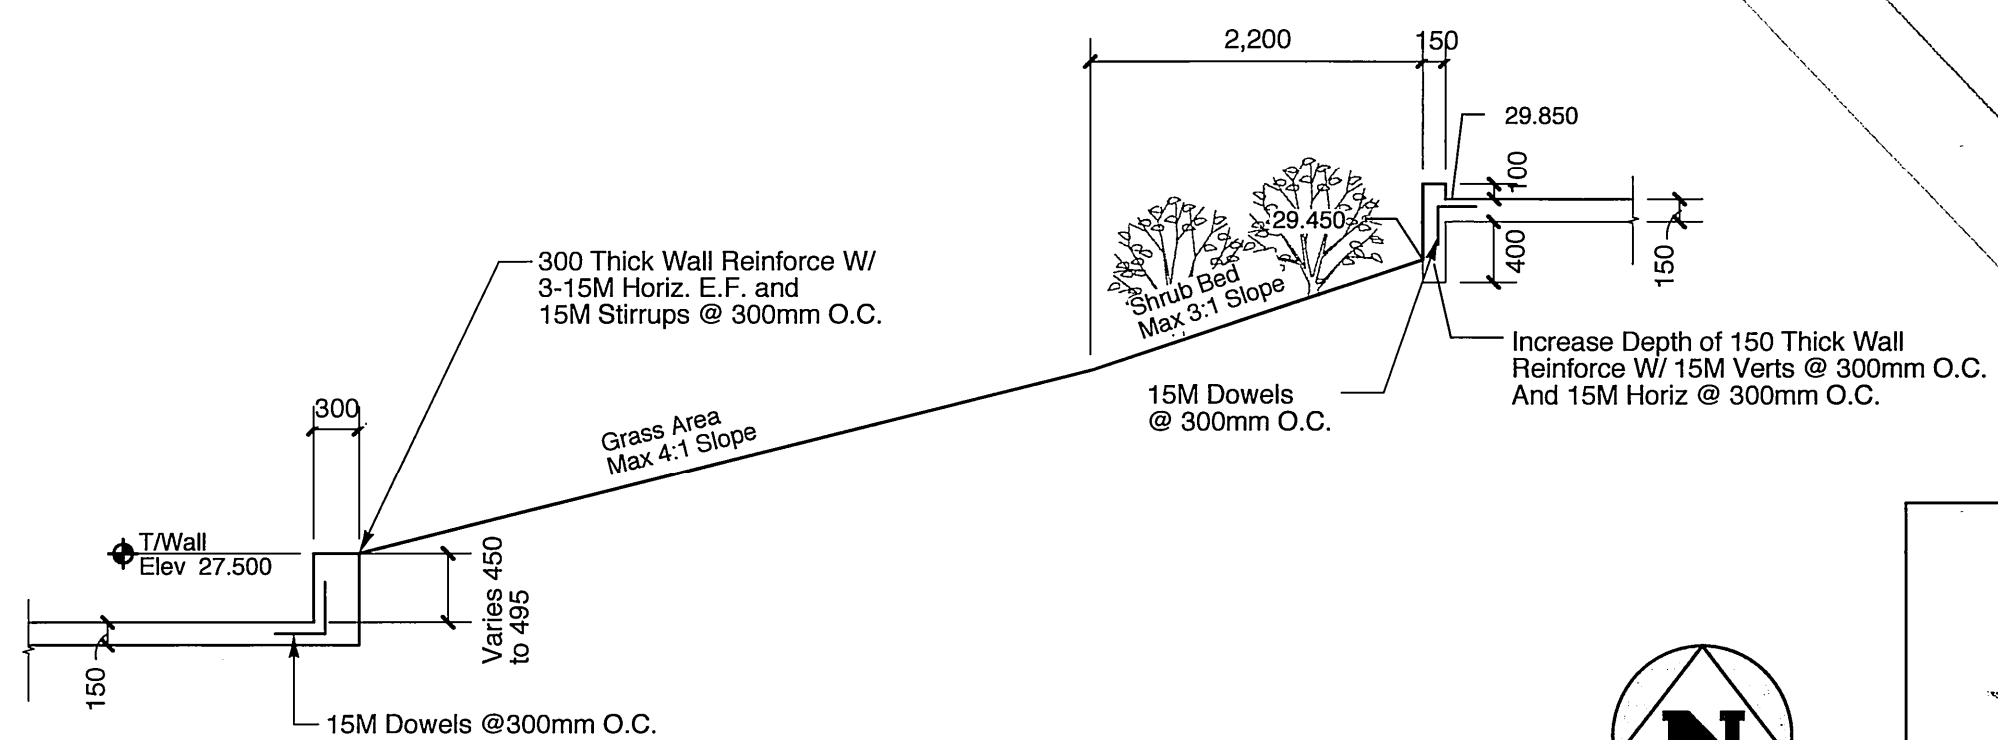


2 Grading Section Through Drainage Swale
1412 1:50

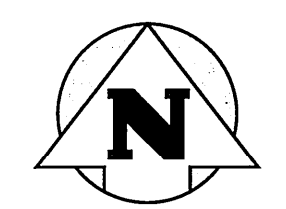

1 Grading Section Detail
1412 1:50

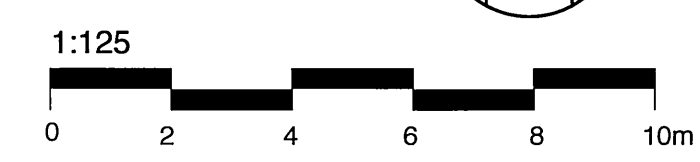

RECORD DRAWING
DATE 05-01-21 BY CKR
REVIEWED BY RGM

HILDERMAN THOMAS FRANK CRAM
Landscape Architecture • Planning
500-115 Bannatyne Avenue East, Winnipeg, Manitoba R3B 0K3
Telephone 204-944-9907 Facsimile 204-957-1467

NO.	REVISIONS	DATE	BY
4	RECORD DRAWING	05.01.20	
3	SWALE / WALKWAY REVISED	03.10.15	
2	ISSUED FOR C.C.O. #45	03.10.10	
1	ISSUED FOR PRICING	03.08.15	
0	ISSUED FOR PRICING	03.06.30	

WARDROP Engineering Inc.

DESIGNED BY	RGM	CHECKED BY	
DRAWN BY	KG/CKR	APPROVED BY	
HOR. SCALE:	1:125	ACCEPTED BY	
VERTICAL:	or as noted	DATE	
DATE	03.10.10	B. ERENSPANZER P. ENG. BRIDGE DESIGN AND PROJECTS ENGINEER	

ORIGINAL DRAWING
REVISION "0" SEALED BY
GLEN MANNING

CONSULTANT DRAWING NO.

THE CITY OF WINNIPEG
PUBLIC WORKS DEPARTMENT
ENGINEERING DIVISION

Winnipeg

PROVENCHER PAIRED BRIDGES PROJECT
PEDESTRIAN BRIDGE

EAST LANDING
GRADING PLAN

CITY DRAWING NUMBER
B231-02-137
SHEET OF

1412 C