


Ref. or Drawing No. **WEP-128-A**
DETAILS FILE # **WS 10675**

BEAM SCHEDULE					
MARK	SIZE	REINFORCING			
B01	400x600	5-25M T.	7-25M B.	1-15M E.F.	10M STIRR @ 200
B02	400x600/700	4-20M T.	4-30M B.	2-15M E.F.	15M STIRR @ 200
B03	400x400	2-15M T.	2-20M B.		10M STIRR @ 200
B04	400x500	3-20M T.	5-20M B.		10M STIRR @ 200


NOTE: DEPTH OF BEAMS AS INDICATED IS MEASURED FROM EL. 245.250

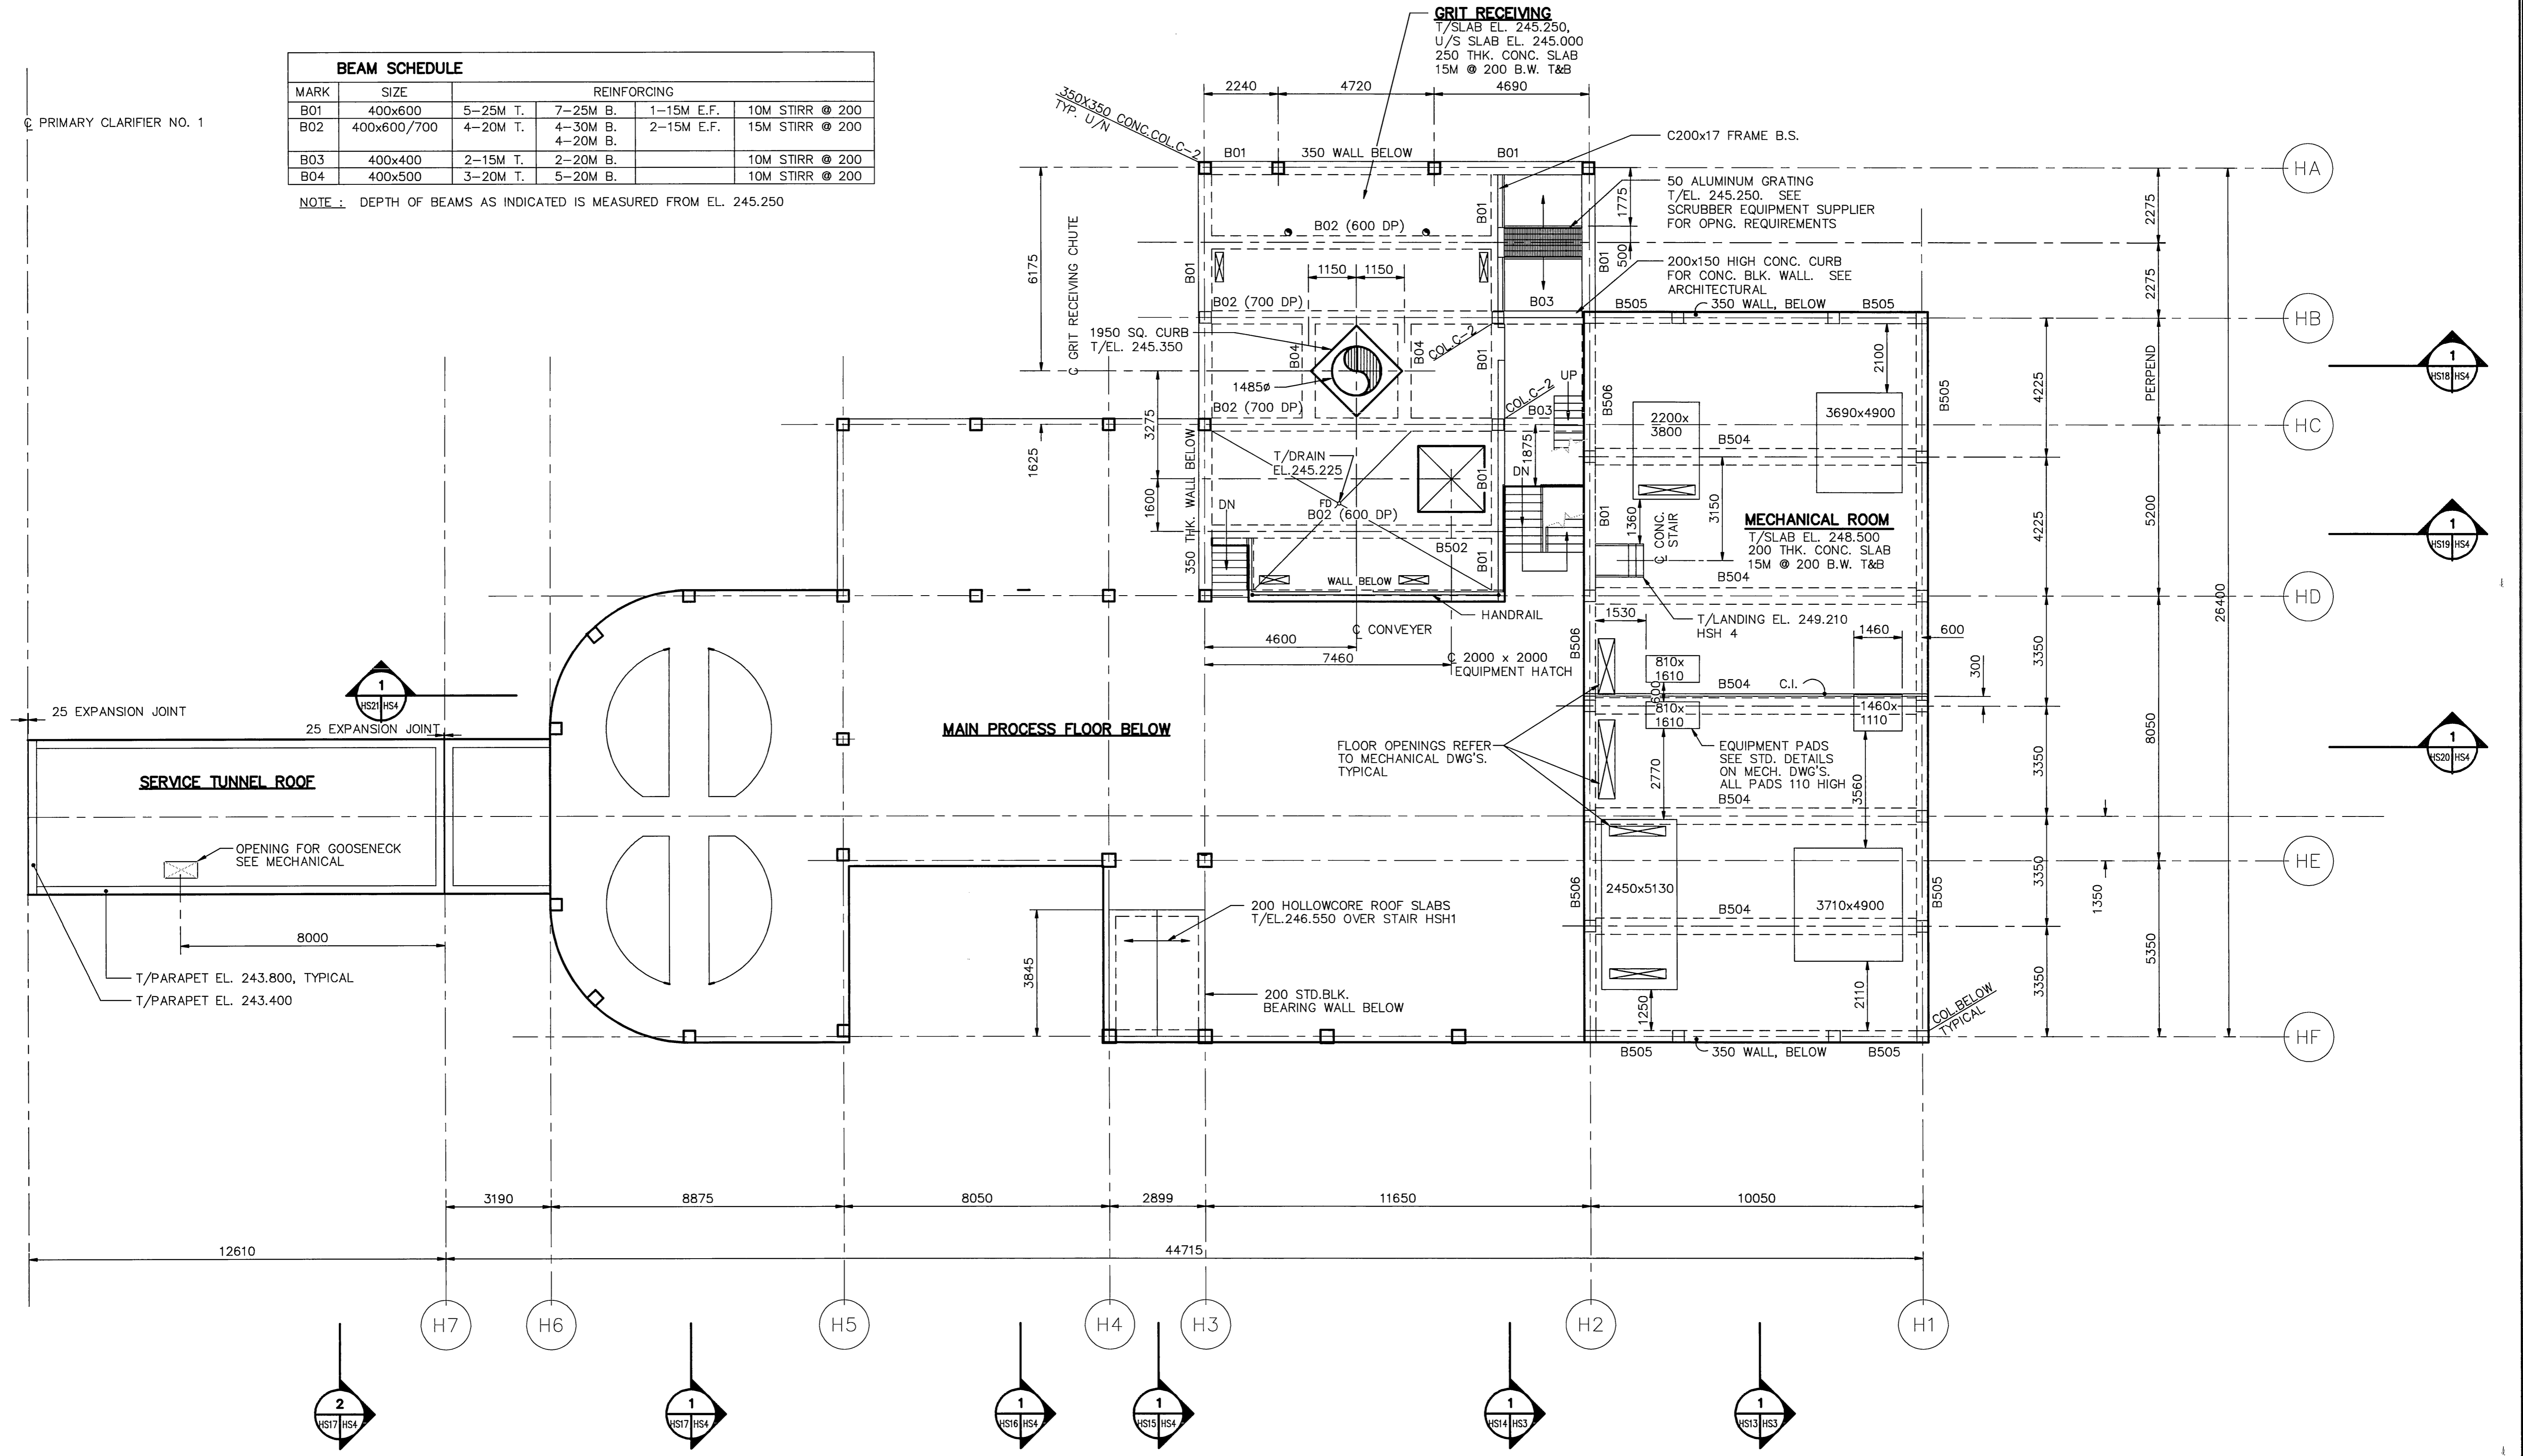

PLAN SHOWING GRIT RECEIVING AND VENTILATION FLOOR SLABS
FLOOR BEAM LAYOUT

detail symbol

A detail number
B drawing where detail shown
C cross reference to drawing where detail taken

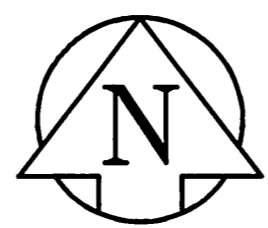

B.M. ELEV.	69-006	237.636 m	
DESIGNED BY	DJT	94/09/28	
DRAWN BY	GAM	91/12/13	
ISSUED FOR TENDER	PAL	91/06/17	
NO. REVISIONS	DATE	BY	
2	AS CONSTRUCTED	94/09/28	DJT
1	GRIT RECEIVING FLR. REVISED	91/12/13	
0	ISSUED FOR TENDER	91/06/17	PAL

Reid Crowther

DESIGNED BY: DJT
DRAWN BY: GAM
CHECKED BY: []
APPROVED BY: []

HOR. SCALE: 1:100
VERTICAL: []

DATE: 91-01-31

ENGINEER'S SEAL

ORIGINAL SIGNED BY: H.V. PAUL
DATE: 91/04/18

CONSULTANT DRAWING NO. 60910 - HS8

THE CITY OF WINNIPEG
WORKS AND OPERATIONS DIVISION
WATERWORKS WASTE AND DISPOSAL DEPT.

WEST END WATER POLLUTION CONTROL CENTRE EXPANSION
AREA H - HEADWORKS

STRUCTURAL PLAN AT EL. 248.500

CITY DRAWING NUMBER: []
SHEET OF: []

WEP-128-A

