



4 SECTION SCALE 1:50

EAST WEST

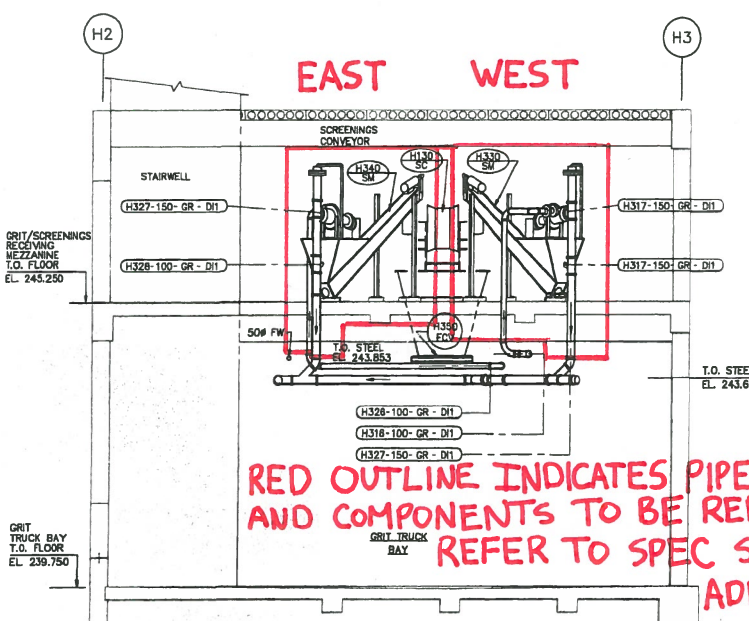

RED OUTLINE INDICATES PIPE AND COMPONENTS TO BE REPLACED REFER TO SPEC SECTION E9 FOR ADDITIONAL DETAILS

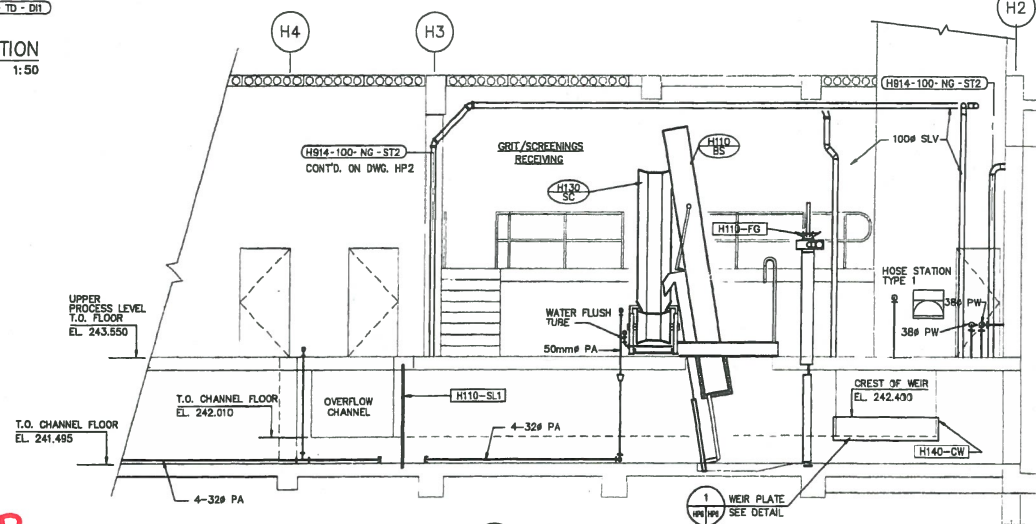

THE ENGINEER THAT SEALED THIS DRAWING IS RESPONSIBLE FOR ONLY THE AS-CONSTRUCTED CHANGES ON THIS DRAWING. THE ORIGINAL DESIGN WAS THE RESPONSIBILITY OF THE DESIGN ENGINEER WHO SEALED THE ISSUED FOR TENDER DRAWINGS IN 1991.

REID, CROWTHER & PARTNERS LIMITED WINNIPEG
AS CONSTRUCTED
 S10... DATE: Nov. 29, 1994

detail symbol

A detail number

B drawing where detail shown

C cross reference to drawing where detail taken

B.M.	69-005		
ELEV.	237.638 m		
DESIGNED BY	DJT	CHECKED BY	
DRAWN BY	PAL/GSB	APPROVED BY	
1 AS CONSTRUCTED	04.09.28 DJT	HOR. SCALE:	1:50
0 ISSUED FOR TENDER	01.04.17 PAL	VERTICAL:	
NO. REVISIONS	DATE BY	DATE	94-09-28

Reid Crowther

DESIGNED BY: DJT
 DRAWN BY: PAL/GSB
 CHECKED BY:
 APPROVED BY:

RELEASED FOR CONSTRUCTION

CONSULTANT DRAWING NO. 80910 - HP6

ENGINEER'S SEAL

LEONA

PROFESSIONAL ENGINEER

THE CITY OF WINNIPEG
 WORKS AND OPERATIONS DIVISION
 WASTEWATER WASTE AND DISPOSAL DEPT.

WEST END WATER POLLUTION CONTROL CENTRE
 AREA H - HEADWORKS

GRIT AND SCREENING EQUIPMENT PROCESS SECTIONS

CITY DRAWING NUMBER
 SHEET OF
 WEP-151

File # WS10202