

NOTE: * H350/FCV IS LOCATED IN THE GRIT TRUCK BAY @ EL. 243.8
 ** H350/HS SELECTOR SWITCH IS LOCATED IN THE GRIT TRUCK BAY ADJACENT TO THE KNIFE GATE VALVE H350/FCV

SCREENINGS RECEIVING ROOM FLOOR PLAN

THE ENGINEER THAT SEALED THIS DRAWING IS RESPONSIBLE FOR ONLY THE AS-CONSTRUCTED CHANGES ON THIS DRAWING.
 THE ORIGINAL DESIGN WAS THE RESPONSIBILITY OF THE DESIGN ENGINEER WHO SEALED THE ISSUED FOR TENDER DRAWINGS IN 1991.


REID, CROWTHER & PARTNERS LIMITED
 WINNIPEG
AS CONSTRUCTED
 DATE: *Nov. 21/94*

detail symbol
 A detail number
 B drawing where detail shown
 C cross reference to drawing where detail taken



B.M.	69-006		
ELEV.	237.636 m		
NO.	REVISIONS	DATE	BY
1	AS BUILT	93/11	DE
0	ISSUED FOR TENDER		

Reid Crowther
 DESIGNED BY: JVH/KC
 DRAWN BY: BAR
 HOR. SCALE: 1:50
 VERTICAL: _____
 CHECKED BY: KC
 APPROVED BY: _____
 RELEASED FOR CONSTRUCTION: _____
 DATE: 90-10-10

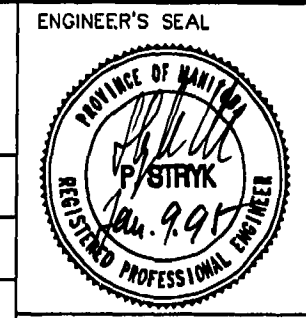

CONSULTANT DRAWING NO.
 60910 - H13

THE CITY OF WINNIPEG
 WORKS AND OPERATIONS DIVISION
 WATERWORKS WASTE AND DISPOSAL DEPT.
 WEST END WATER POLLUTION CONTROL CENTRE
 AREA H - HEADWORKS
 SCREENINGS ROOM MEZZANINE LEVEL INSTRUMENTATION LAYOUT
 CITY DRAWING NUMBER
 SHEET OF
WEP-166

216 # WS10217