


INSTRUMENT LOOP DIAGRAM

LOOP NO. - H345

FIELD

FIELD DEVICE PANEL

D.C.S.

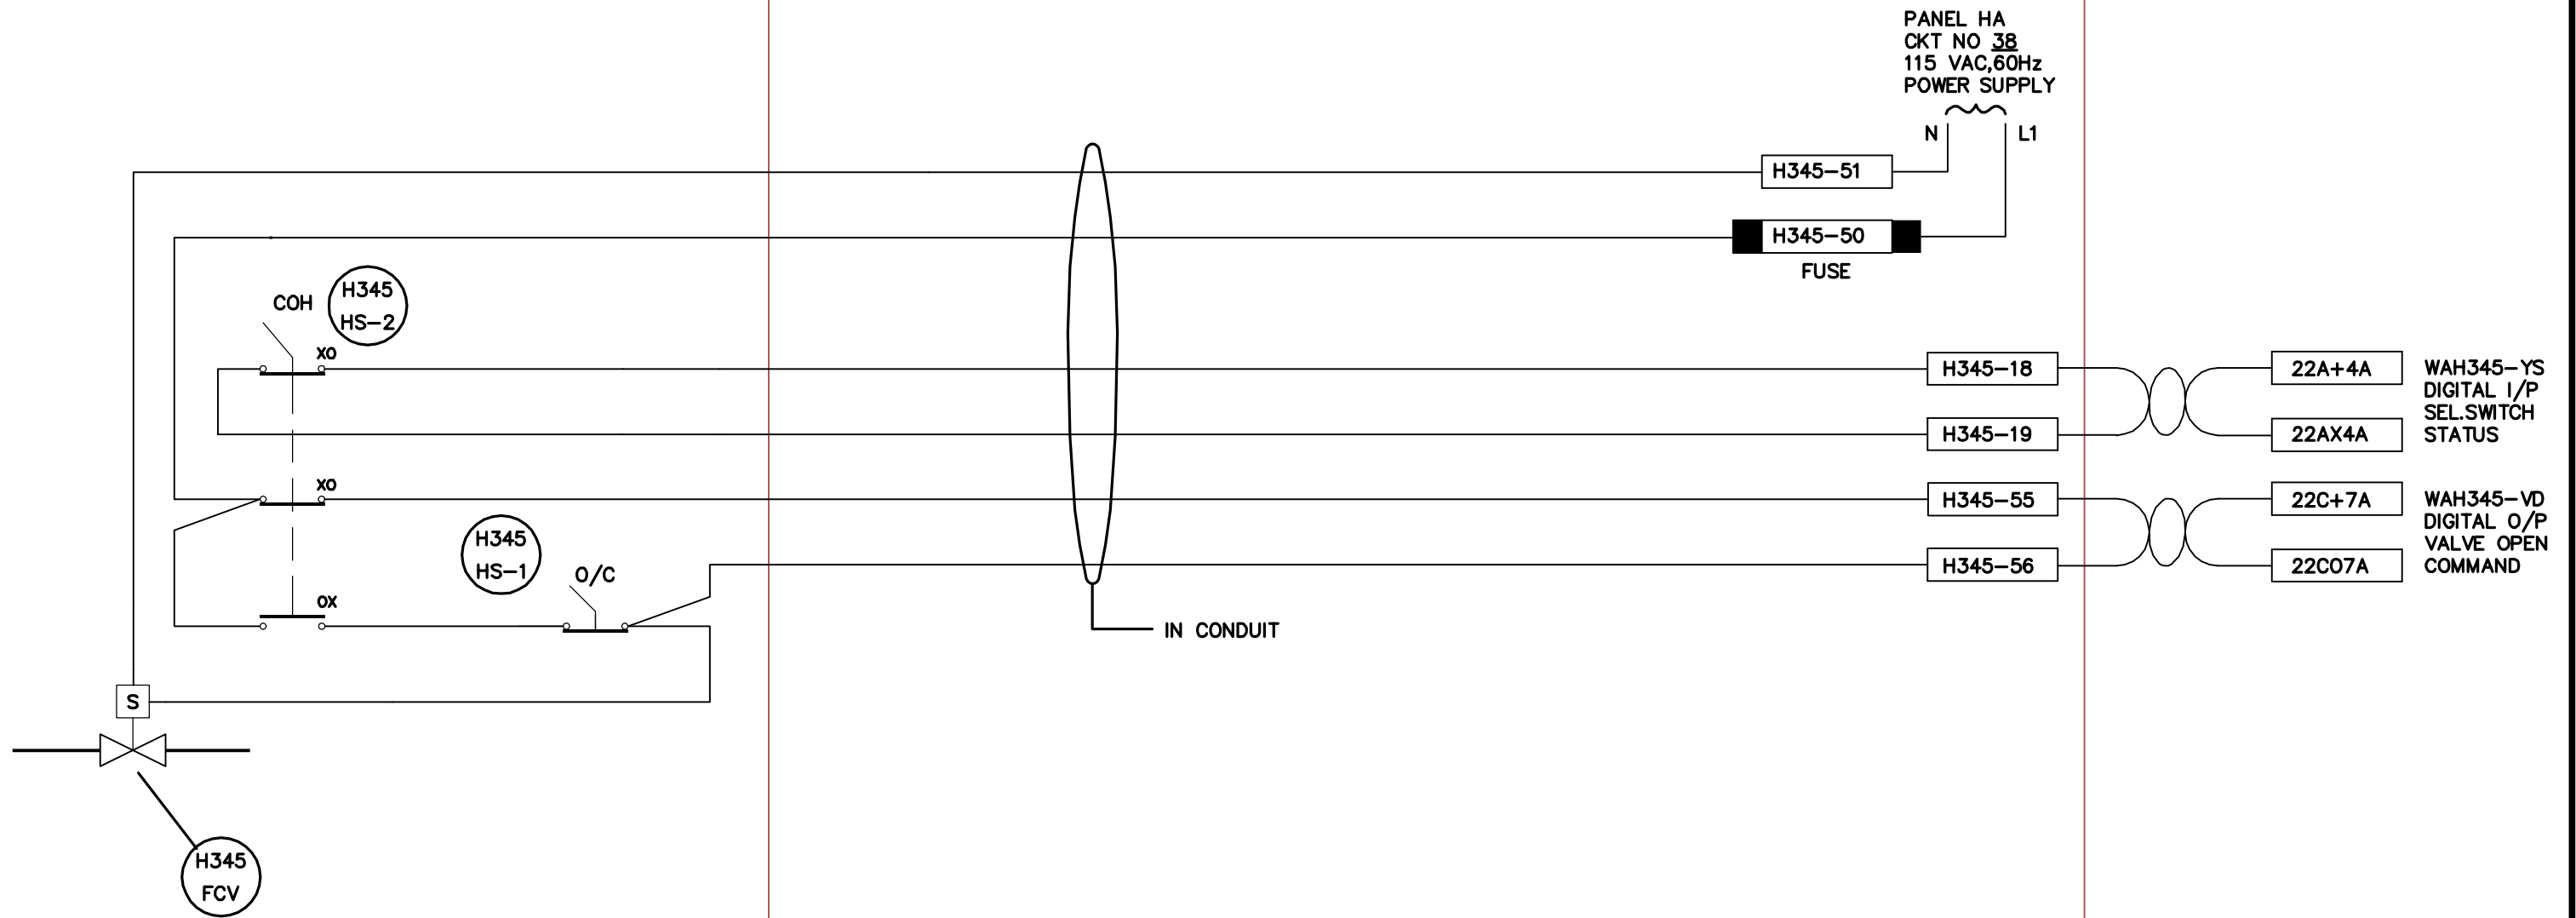

ILD-TYP14  
426-H345

BAILEY TERMINAL NUMBERING

TYPICAL TERMINAL NUMBER → 4 1 A + 7 A

CABINET NUMBER (0-9) \_\_\_\_\_  
 ROW NUMBER (1-10) \_\_\_\_\_  
 ZONE IDENTIFIER (A/A1 - D/D1) \_\_\_\_\_  
 TERMINAL IDENTIFIER \_\_\_\_\_

Reid  
Crowther

OCT./93	AS BUILT	
DATE	REVISION	APP.



THE CITY OF WINNIPEG  
 WORKS AND OPERATIONS DIVISION  
 WATERWORKS, WASTE AND DISPOSAL DEPT.  
 WEST END WATER POLLUTION CONTROL CENTRE

HEADWORKS - DEWATERING CONVEYOR #2  
 FLUSHING WATER VALVE WAH345

SCALE N.T.S.  
 DATE MAY 1991  
 DES JVH DWN GGB  
 CKD BL APP \_\_\_\_\_

DRAWING NO.

WEP-426