

APPENDIX F – RW754 1999 WORKS



THE CITY OF WINNIPEG


PROPERTY AND DEVELOPMENT SERVICES DEPARTMENT

CITY OF WINNIPEG / PROVINCE OF MANITOBA

TACHE AVENUE RIVERBANK RESTORATION AND RELATED WORKS

TACHE AVENUE, RUE DESPINS TO AVE DE LA CATHEDRAL (SITE WW5)

TENDER NO. 1540-99

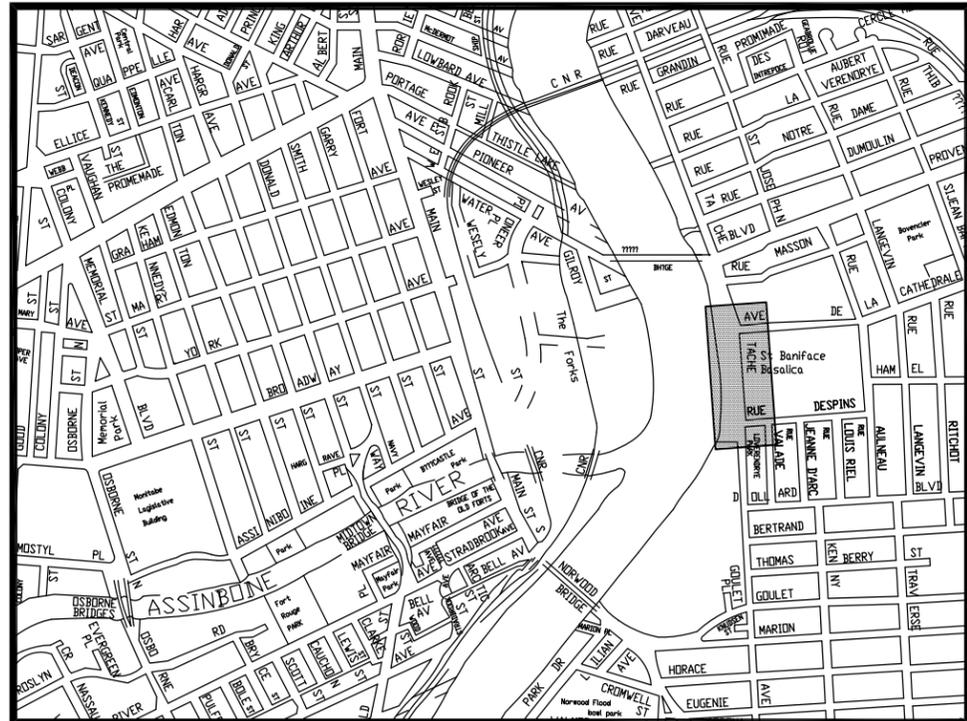

LOCATION PLAN

DRAWING LIST

SHT. NO.	TITLE	CONSULTANT DWG. NO.
1	COVER SHEET	
	FAST BANK SLOPE RESTORATION	
2	PLAN	99-6738-01
3	CROSS SECTION & DETAILS	99-6738-02
4	SOIL LOGS	99-6738-03
	ASPHALT RESURFACING	
5	TACHE AVENUE EAST GUTTER - STA. 0+94 TO 2+40	99-6738-04
6	TACHE AVENUE EAST GUTTER - STA. 2+40 TO 4+00	99-6738-05
7	TACHE AVENUE WEST GUTTER - STA. 0+94 TO 2+40	99-6738-06
8	TACHE AVENUE WEST GUTTER - STA. 2+40 TO 4+00	99-6738-07




RELEASED FOR CONSTRUCTION

DATE



WEST GUTTER PROFILE

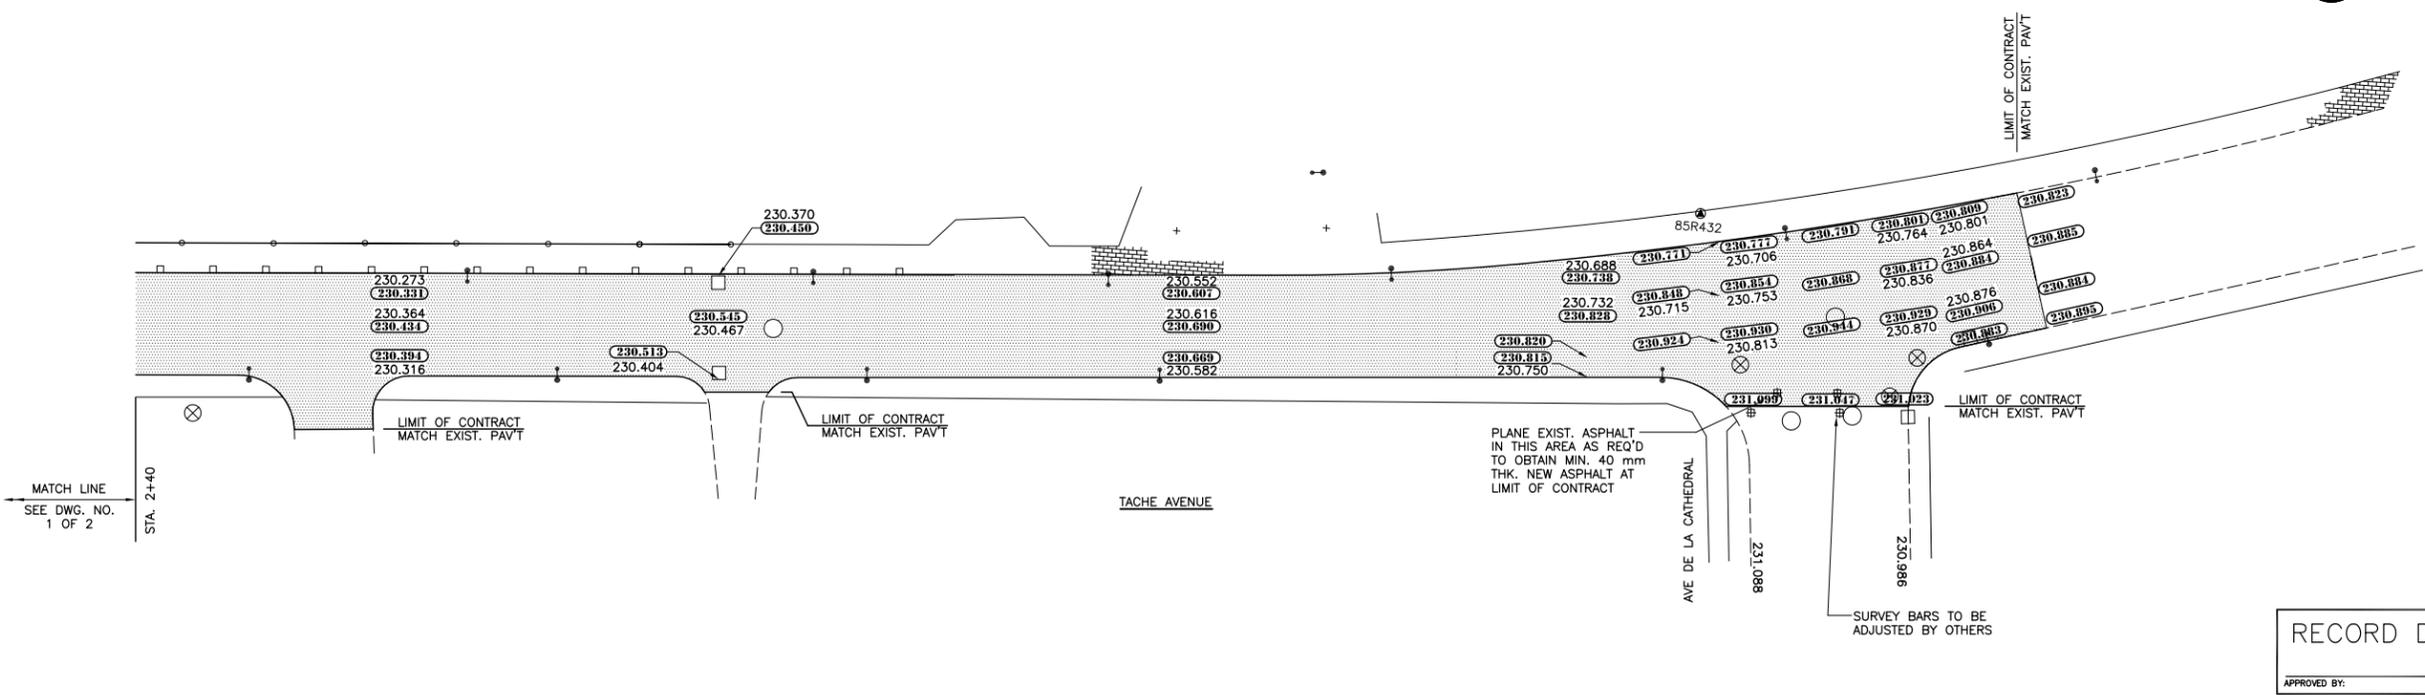


RECORD DRAWING
APPROVED BY: _____ DATE: _____

150 mm W.M.	WATERMAIN	150 mm W.M.	HYDRO	150 mm W.M.	WATERMAIN	150 mm W.M.	WATERMAIN	150 mm W.M.
Hydrant symbol	HYDRANT	Hydrant symbol	M.T.S.	Hydrant symbol	HYDRANT	Hydrant symbol	HYDRANT	Hydrant symbol
Valve symbol	VALVE	Valve symbol	CONCRETE	Valve symbol	VALVE	Valve symbol	VALVE	Valve symbol
300 mm L.D.S.	LAND DRAINAGE SEWER	300 mm L.D.S.	ASPHALT	300 mm L.D.S.	LAND DRAINAGE SEWER	300 mm L.D.S.	LAND DRAINAGE SEWER	300 mm L.D.S.
250 mm W.W.S.	WASTE WATER SEWER	250 mm W.W.S.	PROPERTY LINE	250 mm W.W.S.	WASTE WATER SEWER	250 mm W.W.S.	WASTE WATER SEWER	250 mm W.W.S.
Manhole symbol	MANHOLE	Manhole symbol	SURVEY BAR	Manhole symbol	MANHOLE	Manhole symbol	MANHOLE	Manhole symbol
Catch basin symbol	CATCH BASIN	Catch basin symbol		Catch basin symbol	CATCH BASIN	Catch basin symbol	CATCH BASIN	Catch basin symbol
Curb inlet symbol	CURB INLET	Curb inlet symbol		Curb inlet symbol	CURB INLET	Curb inlet symbol	CURB INLET	Curb inlet symbol
Junction symbol	JUNCTIONS	Junction symbol		Junction symbol	JUNCTIONS	Junction symbol	JUNCTIONS	Junction symbol
Culvert symbol	CULVERT	Culvert symbol		Culvert symbol	CULVERT	Culvert symbol	CULVERT	Culvert symbol
Gas symbol	GAS	Gas symbol		Gas symbol	GAS	Gas symbol	GAS	Gas symbol
Existing symbol	EXISTING	Proposed symbol	PROPOSED	Existing symbol	EXISTING	Proposed symbol	PROPOSED	Existing symbol
Legend-Plan	LEGEND-PLAN	Legend-Profile	LEGEND-PROFILE	Legend-Plan	LEGEND-PLAN	Legend-Profile	LEGEND-PROFILE	Legend-Plan

UNDERGROUND STRUCTURES
SUPV. U/G STRUCTURES COMMITTEE DATE
NOTE:
LOCATION OF UNDERGROUND STRUCTURES AS SHOWN ARE BASED ON THE BEST INFORMATION AVAILABLE BUT NO GUARANTEE IS GIVEN THAT ALL EXISTING UTILITIES ARE SHOWN OR THAT THE GIVEN LOCATIONS ARE EXACT. CONFIRMATION OF EXISTENCE AND EXACT LOCATION OF ALL SERVICES MUST BE OBTAINED FROM THE INDIVIDUAL UTILITIES BEFORE PROCEEDING WITH CONSTRUCTION.

B.M. ELEV.	DESIGNED BY	A.S.
	DRAWN BY	A.S.
	CHECKED BY	D.P.K.
	APPROVED BY	
	HOR. SCALE	1:250
	VERTICAL	1:10
	RELEASED FOR CONSTRUCTION	
NO. REVISIONS	DATE	BY
	DATE	DEC. 1999

PLANE EXIST. ASPHALT IN THIS AREA AS REQ'D TO OBTAIN MIN. 40 mm THK. NEW ASPHALT AT LIMIT OF CONTRACT

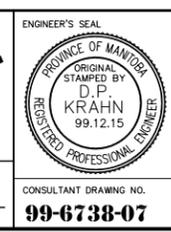


CONSULTANT DRAWING NO. 99-6738-07

THE CITY OF WINNIPEG
PROPERTY AND DEVELOPMENT SERVICES DEPARTMENT


TACHE AVENUE
RUE DESPINS TO AVE DE LA CATHEDRAL
ASPHALT OVERLAY

STA. 2+40 TO STA. 4+00

CITY DRAWING NUMBER	1540-99
SHEET	8 OF 8
TENDER NO.	

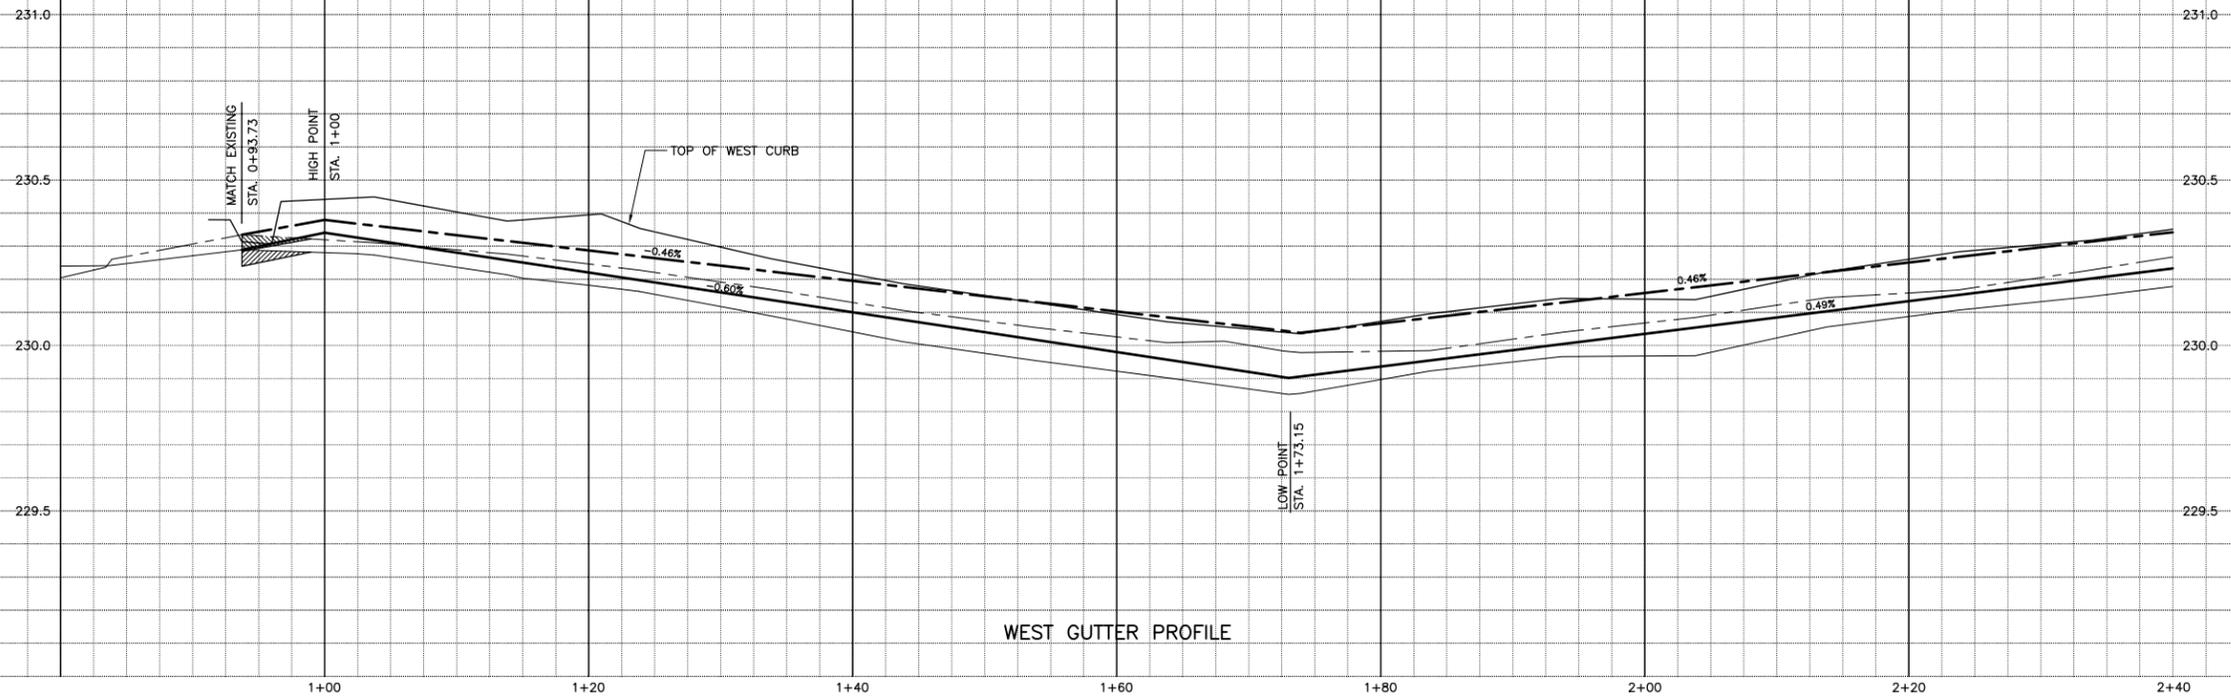

WEST GUTTER PROFILE

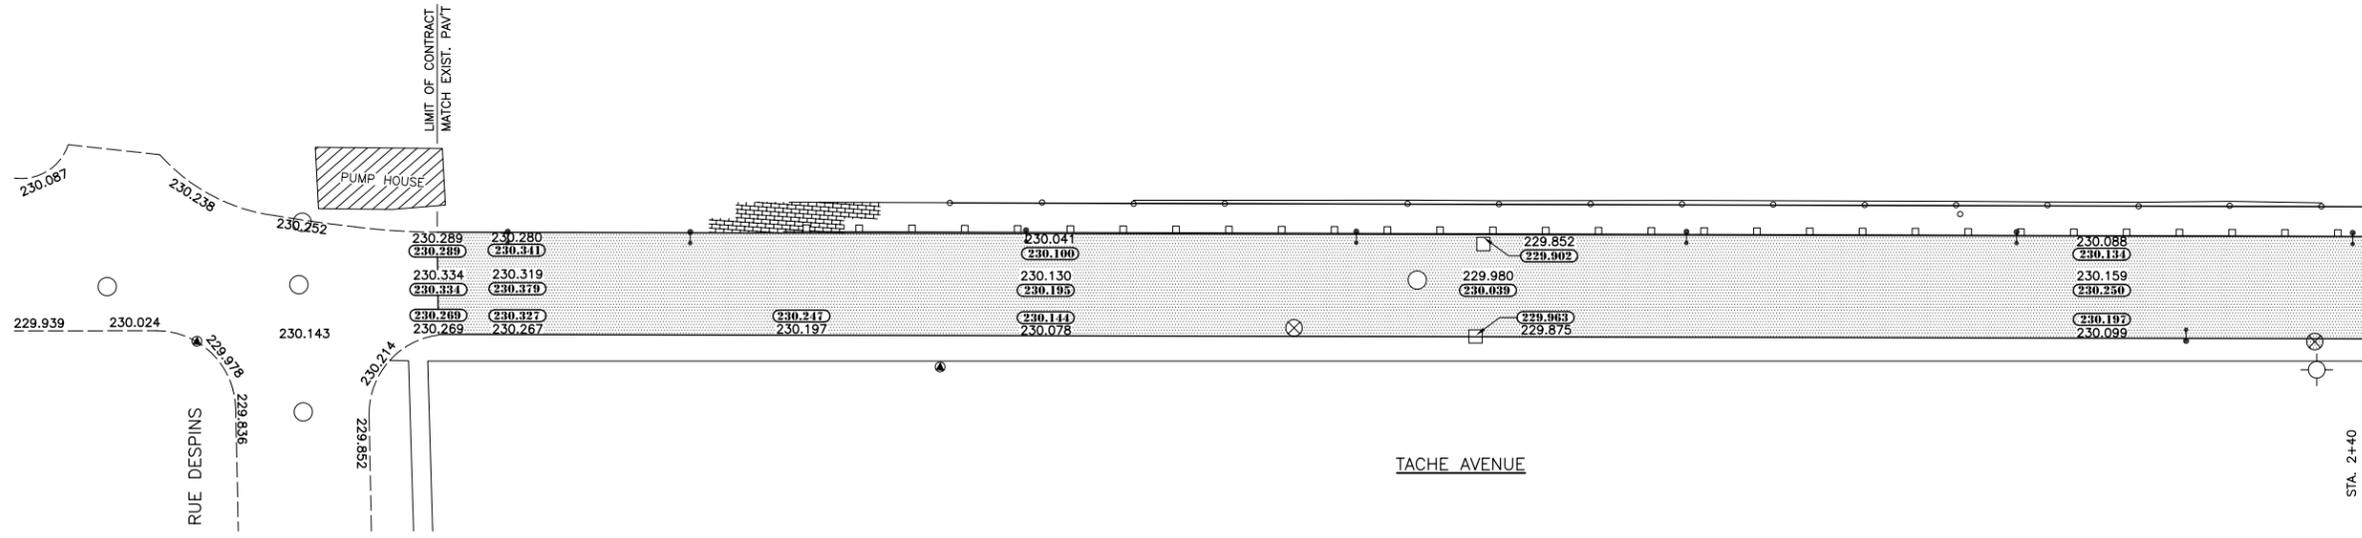

MATCH LINE
SEE DWG. NO.
2 OF 2

RECORD DRAWING
APPROVED BY: _____ DATE: _____

150 mm W.M.	WATERMAIN	150 mm W.M.	HYDRO	150 mm W.M.	WATERMAIN	150 mm W.M.
Hydrant symbol	HYDRANT	Hydrant symbol	M.T.S.	Hydrant symbol	HYDRANT	Hydrant symbol
Valve symbol	VALVE	Valve symbol	CONCRETE	Valve symbol	VALVE	Valve symbol
300 mm L.D.S.	LAND DRAINAGE SEWER	300 mm L.D.S.	ASPHALT	300 mm L.D.S.	LAND DRAINAGE SEWER	300 mm L.D.S.
250 mm W.W.S.	WASTE WATER SEWER	250 mm W.W.S.	PROPERTY LINE	250 mm W.W.S.	WASTE WATER SEWER	250 mm W.W.S.
Manhole symbol	MANHOLE	Manhole symbol	SURVEY BAR	Manhole symbol	MANHOLE	Manhole symbol
Catch basin symbol	CATCH BASIN	Catch basin symbol		Catch basin symbol	CATCH BASIN	Catch basin symbol
Curb inlet symbol	CURB INLET	Curb inlet symbol		Curb inlet symbol	CURB INLET	Curb inlet symbol
Junctions symbol	JUNCTIONS	Junctions symbol		Junctions symbol	JUNCTIONS	Junctions symbol
Culvert symbol	CULVERT	Culvert symbol		Culvert symbol	CULVERT	Culvert symbol
Gas symbol	GAS	Gas symbol		Gas symbol	GAS	Gas symbol
Existing symbol	EXISTING	Proposed symbol	Proposed	Existing symbol	EXISTING	Proposed symbol
Legend-Plan	LEGEND-PLAN	Legend-Profile	LEGEND-PROFILE	Legend-Plan	LEGEND-PLAN	Legend-Profile

UNDERGROUND STRUCTURES
SUPV. U/G STRUCTURES COMMITTEE DATE
NOTE:
LOCATION OF UNDERGROUND STRUCTURES AS SHOWN ARE BASED ON THE BEST INFORMATION AVAILABLE BUT NO GUARANTEE IS GIVEN THAT ALL EXISTING UTILITIES ARE SHOWN OR THAT THE GIVEN LOCATIONS ARE EXACT. CONFIRMATION OF EXISTENCE AND EXACT LOCATION OF ALL SERVICES MUST BE OBTAINED FROM THE INDIVIDUAL UTILITIES BEFORE PROCEEDING WITH CONSTRUCTION.

B.M. ELEV.	DESIGNED BY	A.S.
	DRAWN BY	A.S.
	CHECKED BY	D.P.K.
	APPROVED BY	
	HOR. SCALE	1:250
	VERTICAL	1:10
	RELEASED FOR CONSTRUCTION	
	DATE	DEC. 1999
NO. REVISIONS	DATE	BY

DILLON CONSULTING

PROVINCE OF MANITOBA
ORIGINAL STAMPED BY
D.P. KRAHN
99.12.15
REGISTERED PROFESSIONAL ENGINEER


CONSULTANT DRAWING NO.
99-6738-06

THE CITY OF WINNIPEG
PROPERTY AND DEVELOPMENT SERVICES DEPARTMENT


TACHE AVENUE
RUE DESPINS TO AVE DE LA CATHEDRAL
ASPHALT OVERLAY

STA. 0+94 TO STA. 2+40

CITY DRAWING NUMBER	1540-99
SHEET	7 OF 8
TENDER NO.	

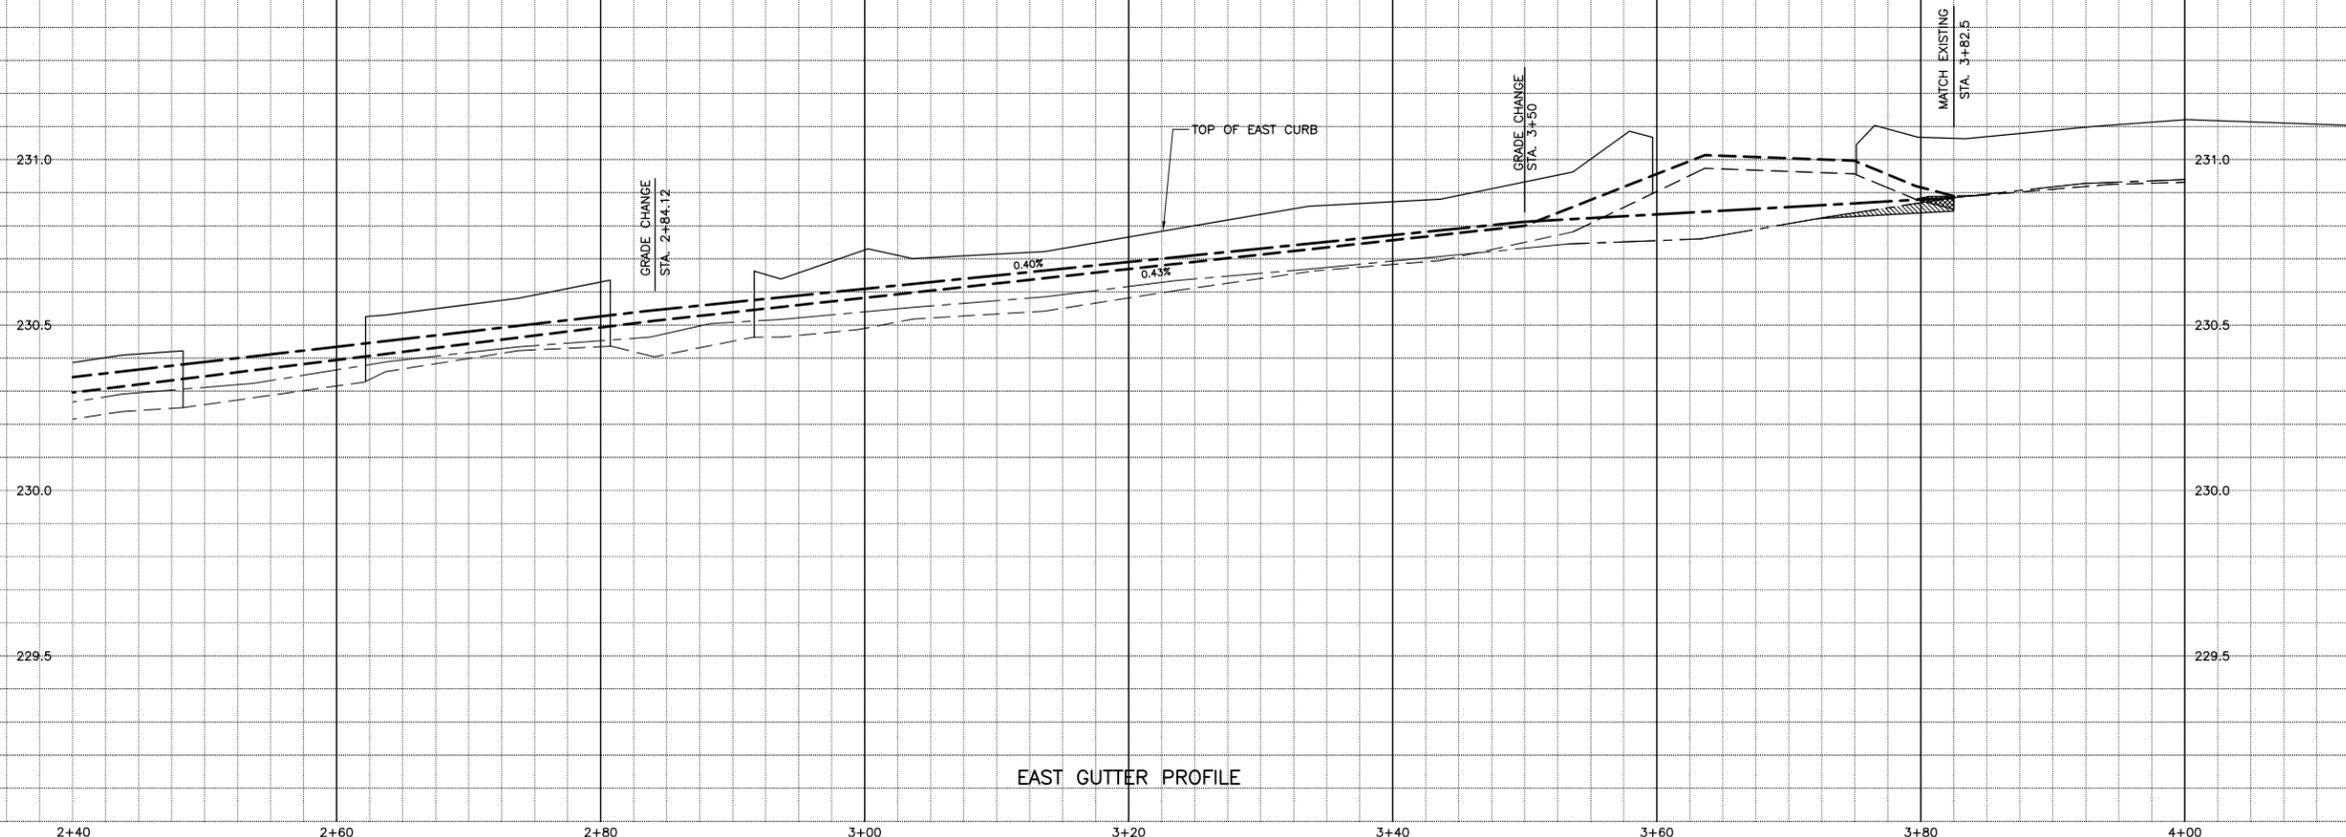

EAST GUTTER PROFILE

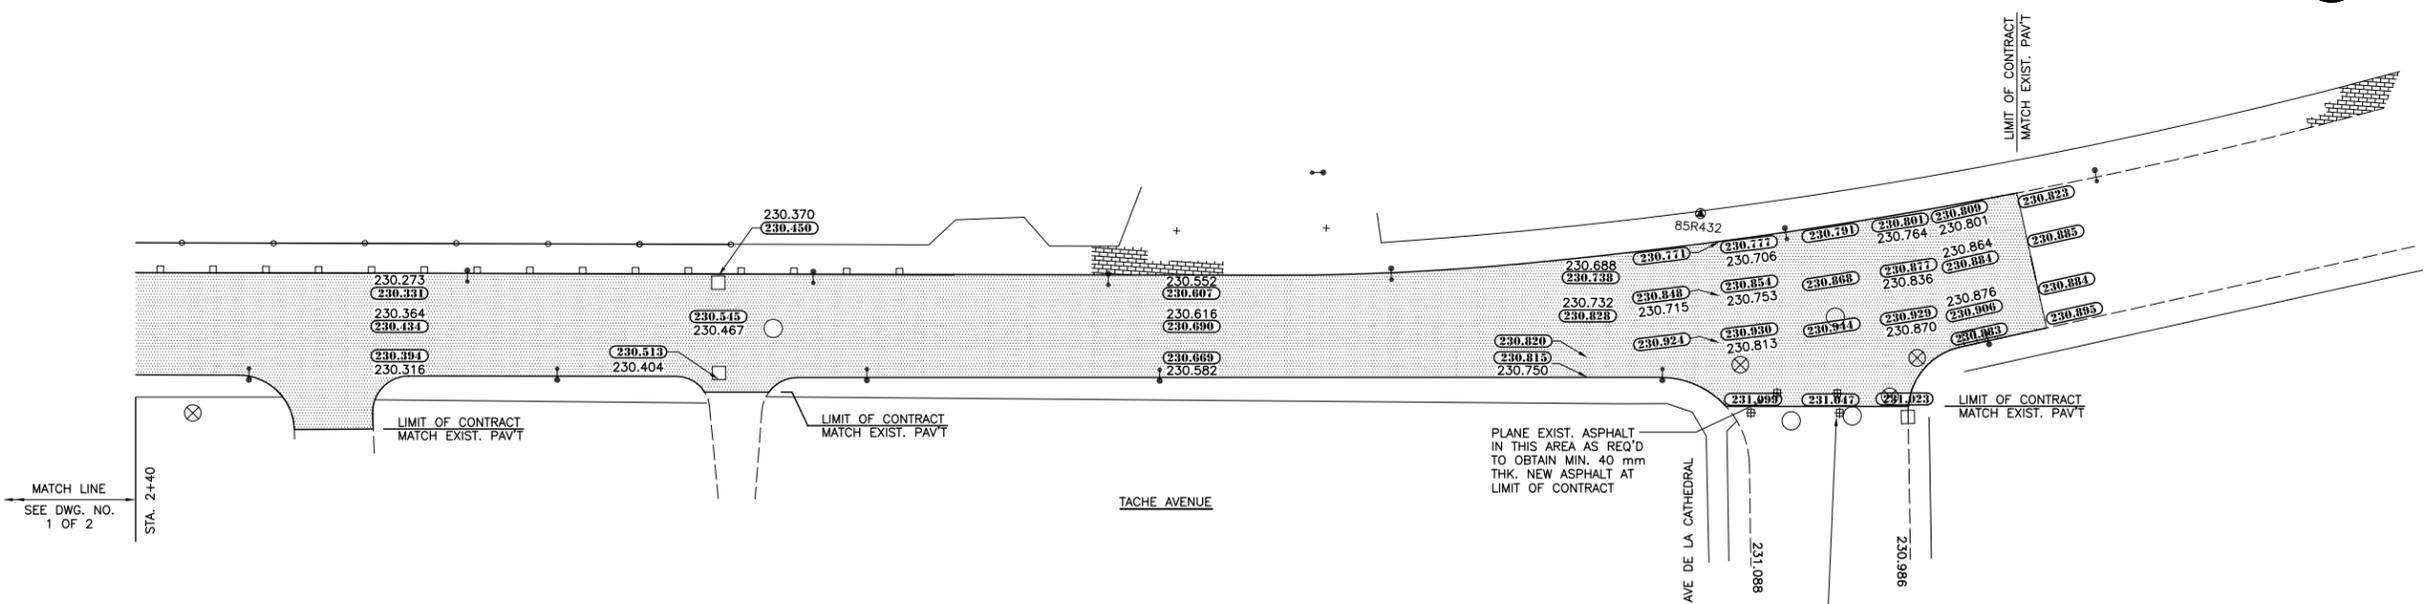

RECORD DRAWING
APPROVED BY: _____ DATE: _____

150 mm W.M.	WATERMAIN	150 mm W.M.	HYDRO	150 mm W.M.	WATERMAIN	150 mm W.M.
Hydrant symbol	HYDRANT	Hydrant symbol	M.T.S.	Hydrant symbol	HYDRANT	Hydrant symbol
Valve symbol	VALVE	Valve symbol	CONCRETE	Valve symbol	VALVE	Valve symbol
300 mm L.D.S.	LAND DRAINAGE SEWER	300 mm L.D.S.	ASPHALT	300 mm L.D.S.	LAND DRAINAGE SEWER	300 mm L.D.S.
250 mm W.W.S.	WASTE WATER SEWER	250 mm W.W.S.	PROPERTY LINE	250 mm W.W.S.	WASTE WATER SEWER	250 mm W.W.S.
Manhole symbol	MANHOLE	Manhole symbol	SURVEY BAR	Manhole symbol	MANHOLE	Manhole symbol
Catch basin symbol	CATCH BASIN	Catch basin symbol		Catch basin symbol	CATCH BASIN	Catch basin symbol
Curb inlet symbol	CURB INLET	Curb inlet symbol		Curb inlet symbol	CURB INLET	Curb inlet symbol
Junction symbol	JUNCTIONS	Junction symbol		Junction symbol	JUNCTIONS	Junction symbol
Culvert symbol	CULVERT	Culvert symbol		Culvert symbol	CULVERT	Culvert symbol
Gas symbol	GAS	Gas symbol		Gas symbol	GAS	Gas symbol
Existing symbol	LEGEND-PLAN	Proposed symbol	LEGEND-PLAN	Existing symbol	LEGEND-PROFILE	Proposed symbol

UNDERGROUND STRUCTURES
SUPV. U/G STRUCTURES COMMITTEE DATE
NOTE:
LOCATION OF UNDERGROUND STRUCTURES AS SHOWN ARE BASED ON THE BEST INFORMATION AVAILABLE BUT NO GUARANTEE IS GIVEN THAT ALL EXISTING UTILITIES ARE SHOWN OR THAT THE GIVEN LOCATIONS ARE EXACT. CONFIRMATION OF EXISTENCE AND EXACT LOCATION OF ALL SERVICES MUST BE OBTAINED FROM THE INDIVIDUAL UTILITIES BEFORE PROCEEDING WITH CONSTRUCTION.

B.M. ELEV.	DESIGNED BY	A.S.
	DRAWN BY	A.S.
	CHECKED BY	D.P.K.
	APPROVED BY	
	HOR. SCALE	1:250
	VERTICAL	1:10
	RELEASED FOR CONSTRUCTION	
NO. REVISIONS	DATE	BY
	DATE	DEC. 1999

DILLON CONSULTING

PROVINCE OF MANITOBA
ORIGINAL STAMPED BY
D.P. KRAHN
99.12.15
REGISTERED PROFESSIONAL ENGINEER

CONSULTANT DRAWING NO.
99-6738-05

THE CITY OF WINNIPEG
PROPERTY AND DEVELOPMENT SERVICES DEPARTMENT

TACHE AVENUE
RUE DESPINS TO AVE DE LA CATHEDRAL
ASPHALT OVERLAY

STA. 2+40 TO STA. 4+00

CITY DRAWING NUMBER	1540-99
SHEET	6 OF 8
TENDER NO.	

