




A SECTION
A101 104 SCALE 1:100

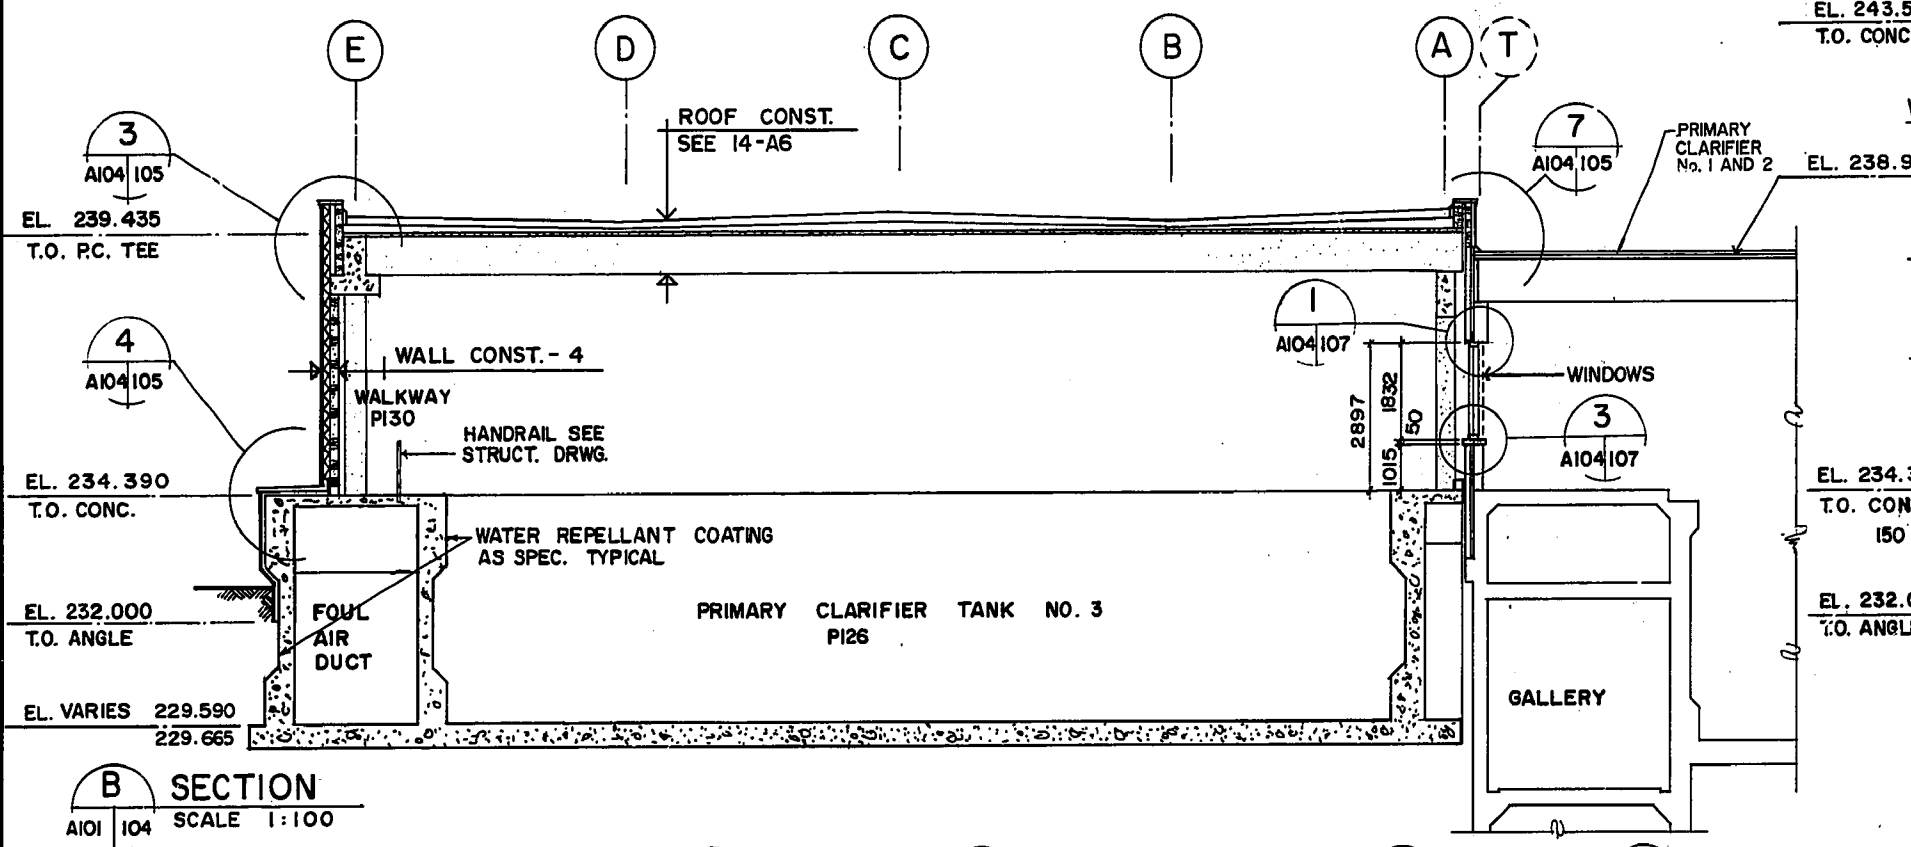


B SECTION
A101 104 SCALE 1:100

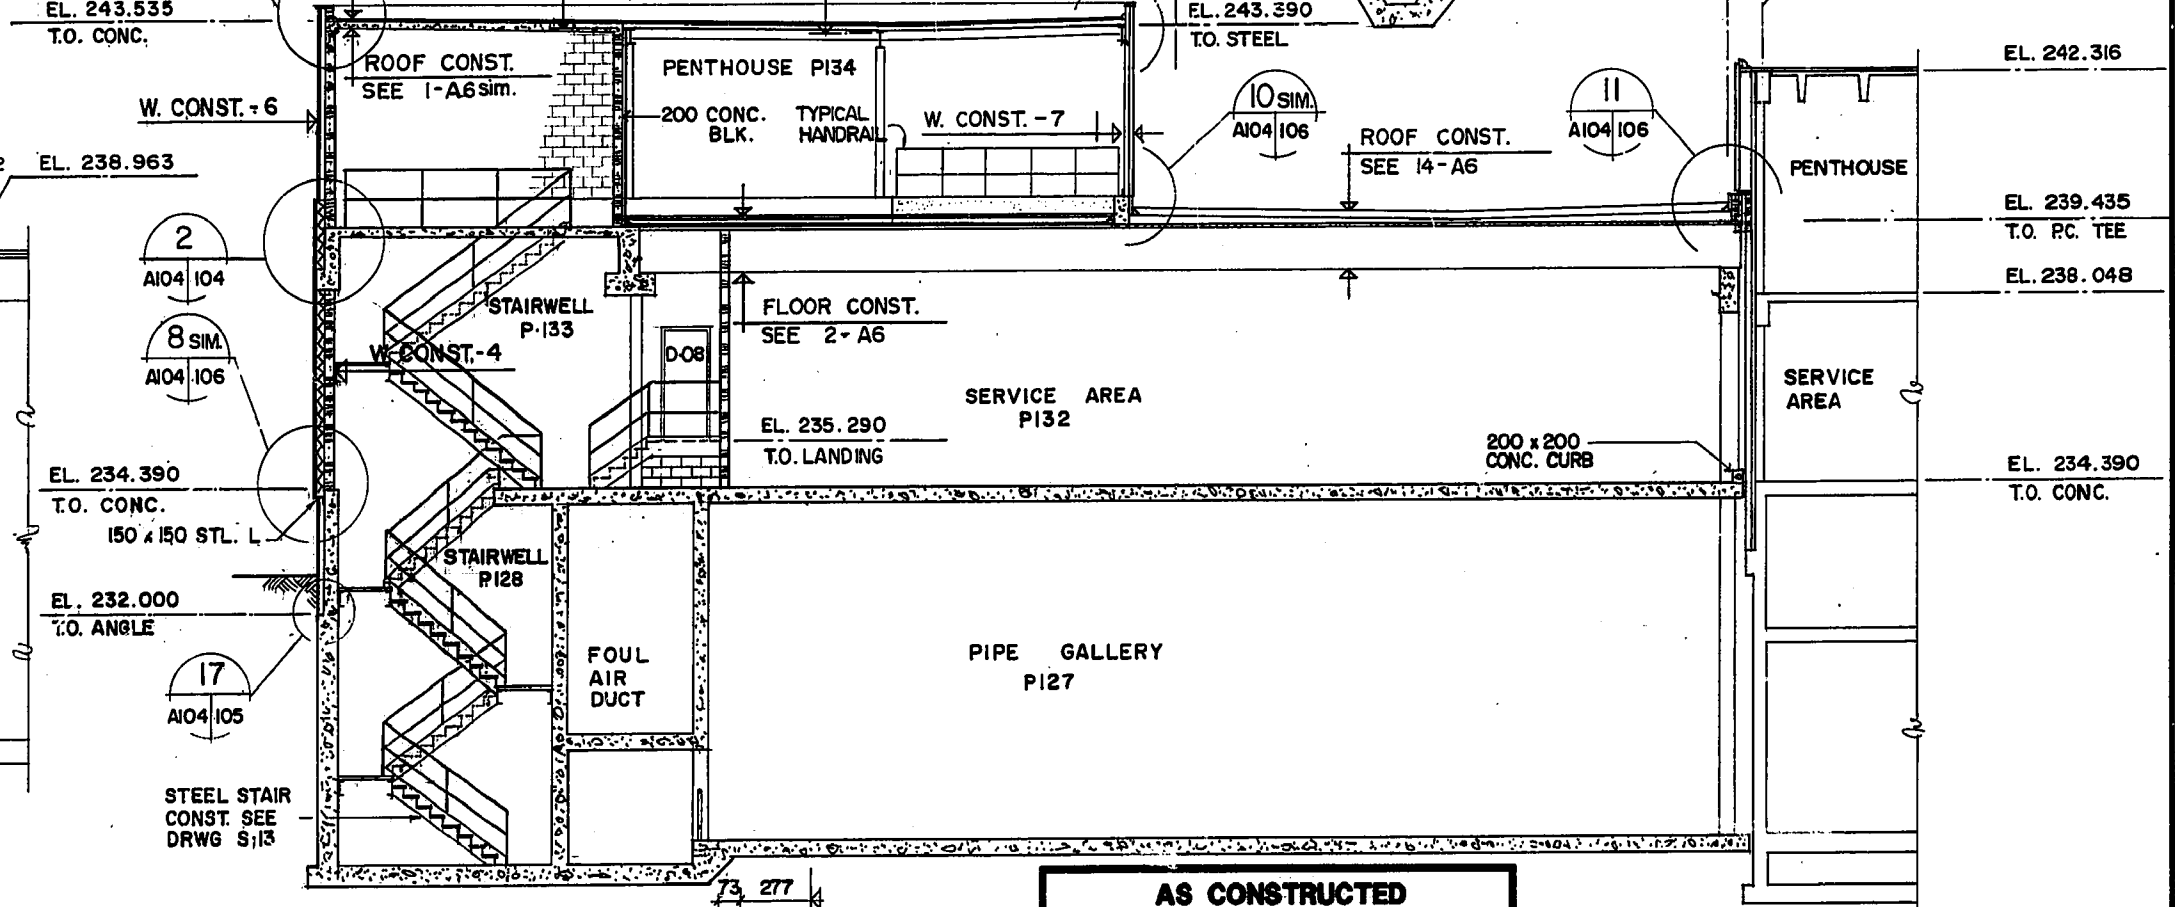


C SECTION
A101 104 SCALE 1:100

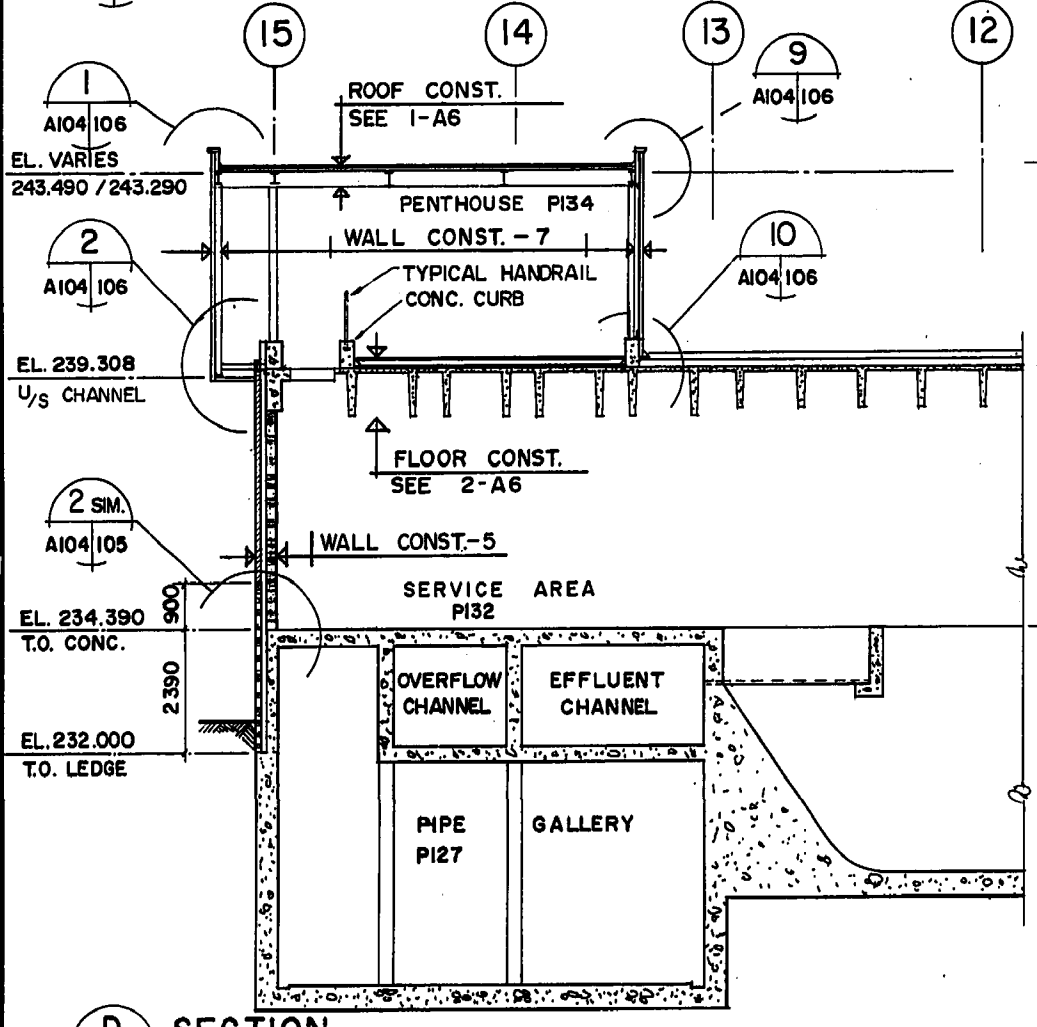

D SECTION
A101 104 SCALE 1:100

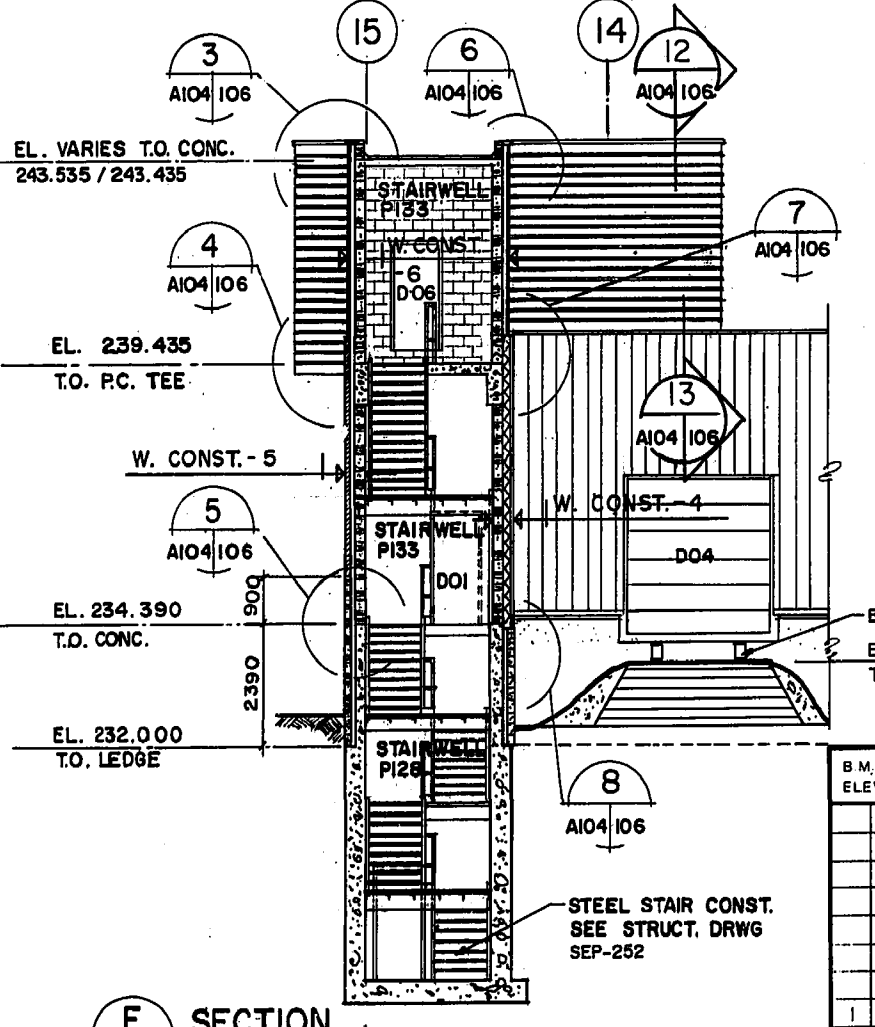

E SECTION
A101 104 SCALE 1:100

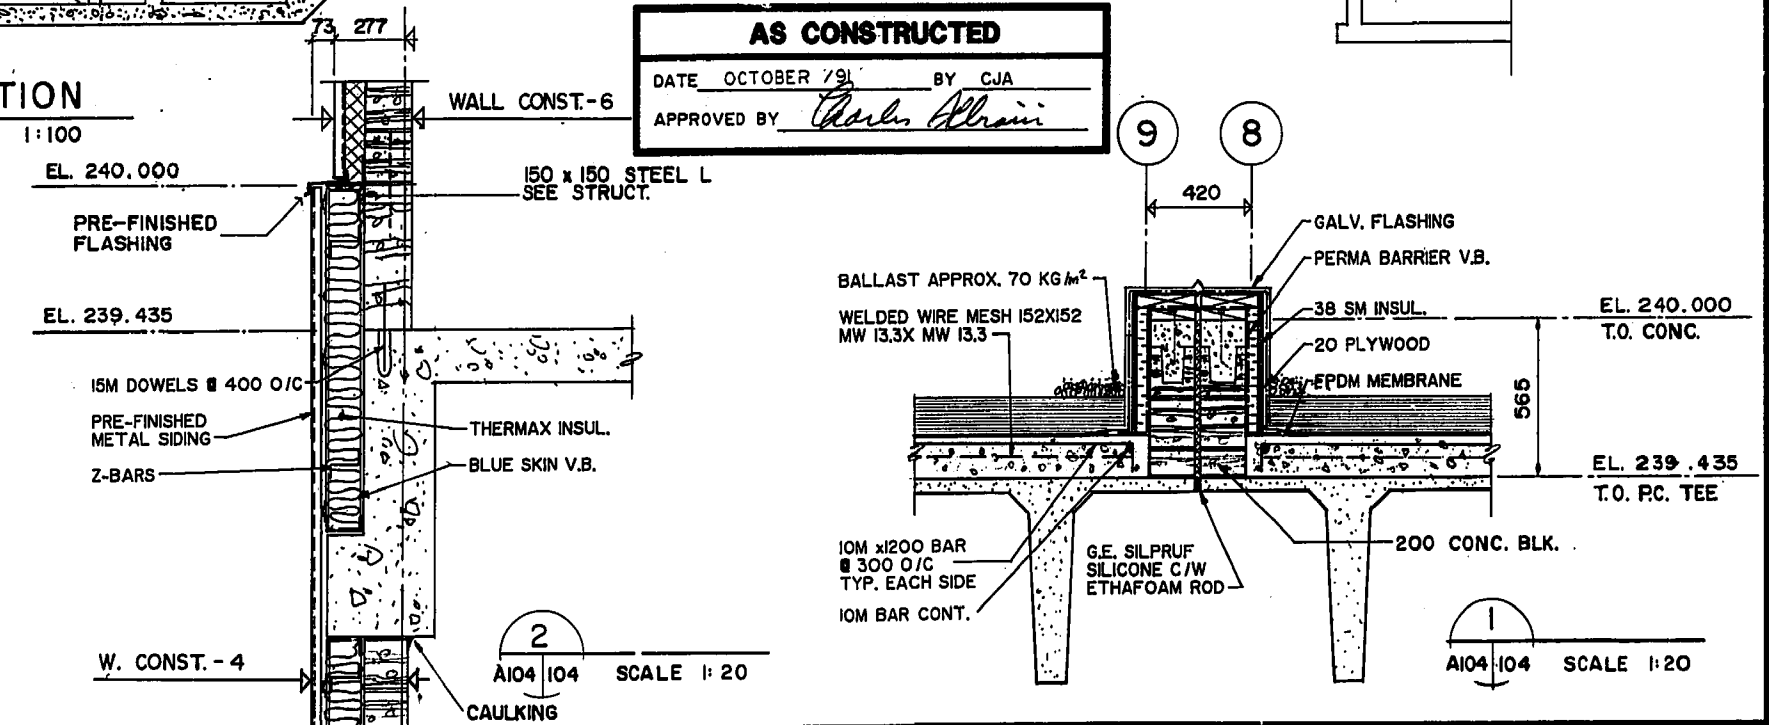

F SECTION
A104 104 SCALE 1:20

AS CONSTRUCTED
 DATE OCTOBER 79 BY CJA
 APPROVED BY *Charles Almain*

B.M. ELEV.		MAC LAREN ENGINEERS INC. WARDROP ENGINEERING INC. ENGINEERING CONSULTANTS		ARCHITECT'S SEAL C. Tomcoy SNIDER TOMCOY REGISTERED ARCHITECTS		THE CITY OF WINNIPEG WORKS AND OPERATIONS DIVISION WATERWORKS, WASTE & DISPOSAL DEPARTMENT SOUTH END WATER POLLUTION CONTROL CENTRE PRIMARY CLARIFIER - ARCHITECTURAL	
DESIGNED BY	KRS	CHECKED BY	AT			CITY DRAWING NUMBER	
DRAWN BY	WHT, DG	APPROVED BY	<i>[Signature]</i>	CONSULTANT DRAWING NO.		SHEET OF	
HOR. SCALE:	AS SHOWN	RELEASED FOR CONSTRUCTION	<i>[Signature]</i>	870012-01-16-A 104		BUILDING SECTIONS	
NO. REVISIONS		DATE	AUGUST 1989	DATE		SEP 236	