


PLAN ABOVE EL 229.665

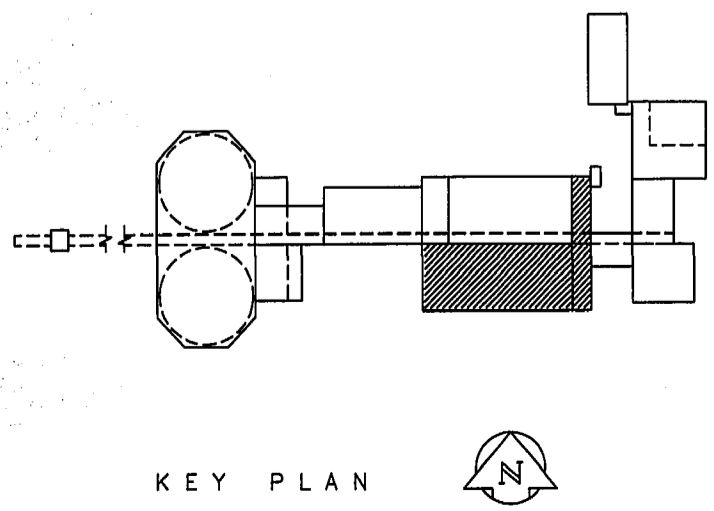

**AS CONSTRUCTED**  
 DATE OCTOBER /91 BY CJA  
 APPROVED BY *Charles Allison*

B.M. ELEV.	MacLAREN ENGINEERS INC. WARDROP ENGINEERING INC.		ENGINEER'S SEAL <i>T. Y. A. LEE</i> REGISTERED PROFESSIONAL ENGINEER PROVINCE OF ONTARIO	THE CITY OF WINNIPEG WORKS AND OPERATIONS DIVISION WATERWORKS, WASTE & DISPOSAL DEPARTMENT	
	DESIGNED BY AL	CHECKED BY AL			SOUTH END WATER POLLUTION CONTROL CENTRE PRIMARY CLARIFIER - STRUCTURAL
	DRAWN BY RL	APPROVED BY <i>[Signature]</i>			
1 AS CONSTRUCTED 10/91 CJA	HOR. SCALE: 1 : 100	RELEASED FOR CONSTRUCTION:	CONSULTANT DRAWING NO. 43525-S102	SHEET OF	
0 ISSUED FOR TENDER 08/89 EH	VERTICAL: 1 : 100	DATE	DATE AUGUST, 1989	PLAN ABOVE EL. 229.665	
NO. REVISIONS	DATE	BY	DATE	SEP-241	