


PLAN ABOVE EL 229.665m
SCALE N.T.S.

NOTE:
SEE DWG M107 FOR LEGEND

AS CONSTRUCTED
DATE OCTOBER / 91 BY S.Q.
APPROVED BY *Sean Quigley*

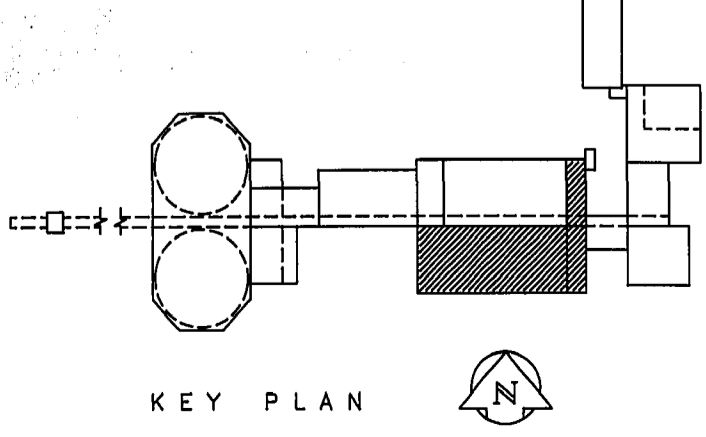

B.M. ELEV.					
DESIGNED BY	RDJ/CS/HS	CHECKED BY	RDJ	MacLAREN ENGINEERS INC. WARDROP ENGINEERING INC.	
DRAWN BY	TL / CAD	APPROVED BY	<i>[Signature]</i>	ENGINEERING CONSULTANTS	
NO.	REVISIONS	DATE	BY	DATE	DATE
1	AS CONSTRUCTED	10/91	S.Q.		
0	ISSUED FOR TENDER	08/89	E.H.		

ORIGINALLY DESIGNED BY
R. JUANEZA
LICENSED PROFESSIONAL ENGINEER
PROVINCE OF ONTARIO
CONSULTANT DRAWING NO.
43525 - M101

THE CITY OF WINNIPEG
WORKS AND OPERATIONS DIVISION
WATERWORKS, WASTE & DISPOSAL DEPARTMENT

SOUTH END WATER POLLUTION CONTROL CENTRE
PRIMARY CLARIFIER - MECHANICAL

CITY DRAWING NUMBER
SHEET OF
SEP-255

PLAN ABOVE EL 229.665