


PLAN ABOVE EL 234.390m
SCALE 1:100

NOTE:
SEE DWG M107 FOR LEGEND

AS CONSTRUCTED
DATE OCTOBER /91 BY S.Q.
APPROVED BY *Sean Quigley*

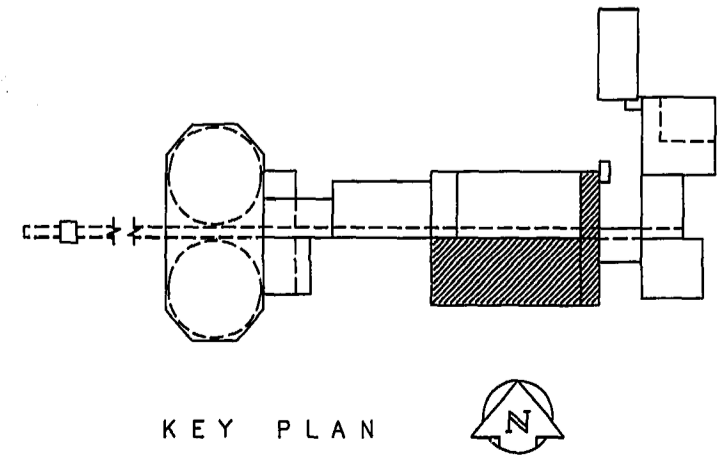

B.M. ELEV.					
DESIGNED BY	RDJ/CS/HS	CHECKED BY	RDJ		
DRAWN BY	TL /CAD	APPROVED BY	<i>[Signature]</i>		
HOR. SCALE:		VERTICAL:	1:100		
1 AS CONSTRUCTED	10/91	S.Q.			
0 ISSUED FOR TENDER	08/89	E.H.			
NO. REVISIONS	DATE	BY	DATE		

ORIGINALLY DESIGNED BY



THE CITY OF WINNIPEG
WORKS AND OPERATIONS DIVISION
WATERWORKS, WASTE & DISPOSAL DEPARTMENT

SOUTH END WATER POLLUTION CONTROL CENTRE
PRIMARY CLARIFIER— MECHANICAL

CONSULTANT DRAWING NO.
43525 - M102

PLAN ABOVE EL 234.390

CITY DRAWING NUMBER
SHEET OF
SEP-256