


3 SECTION
M101 105 1:50

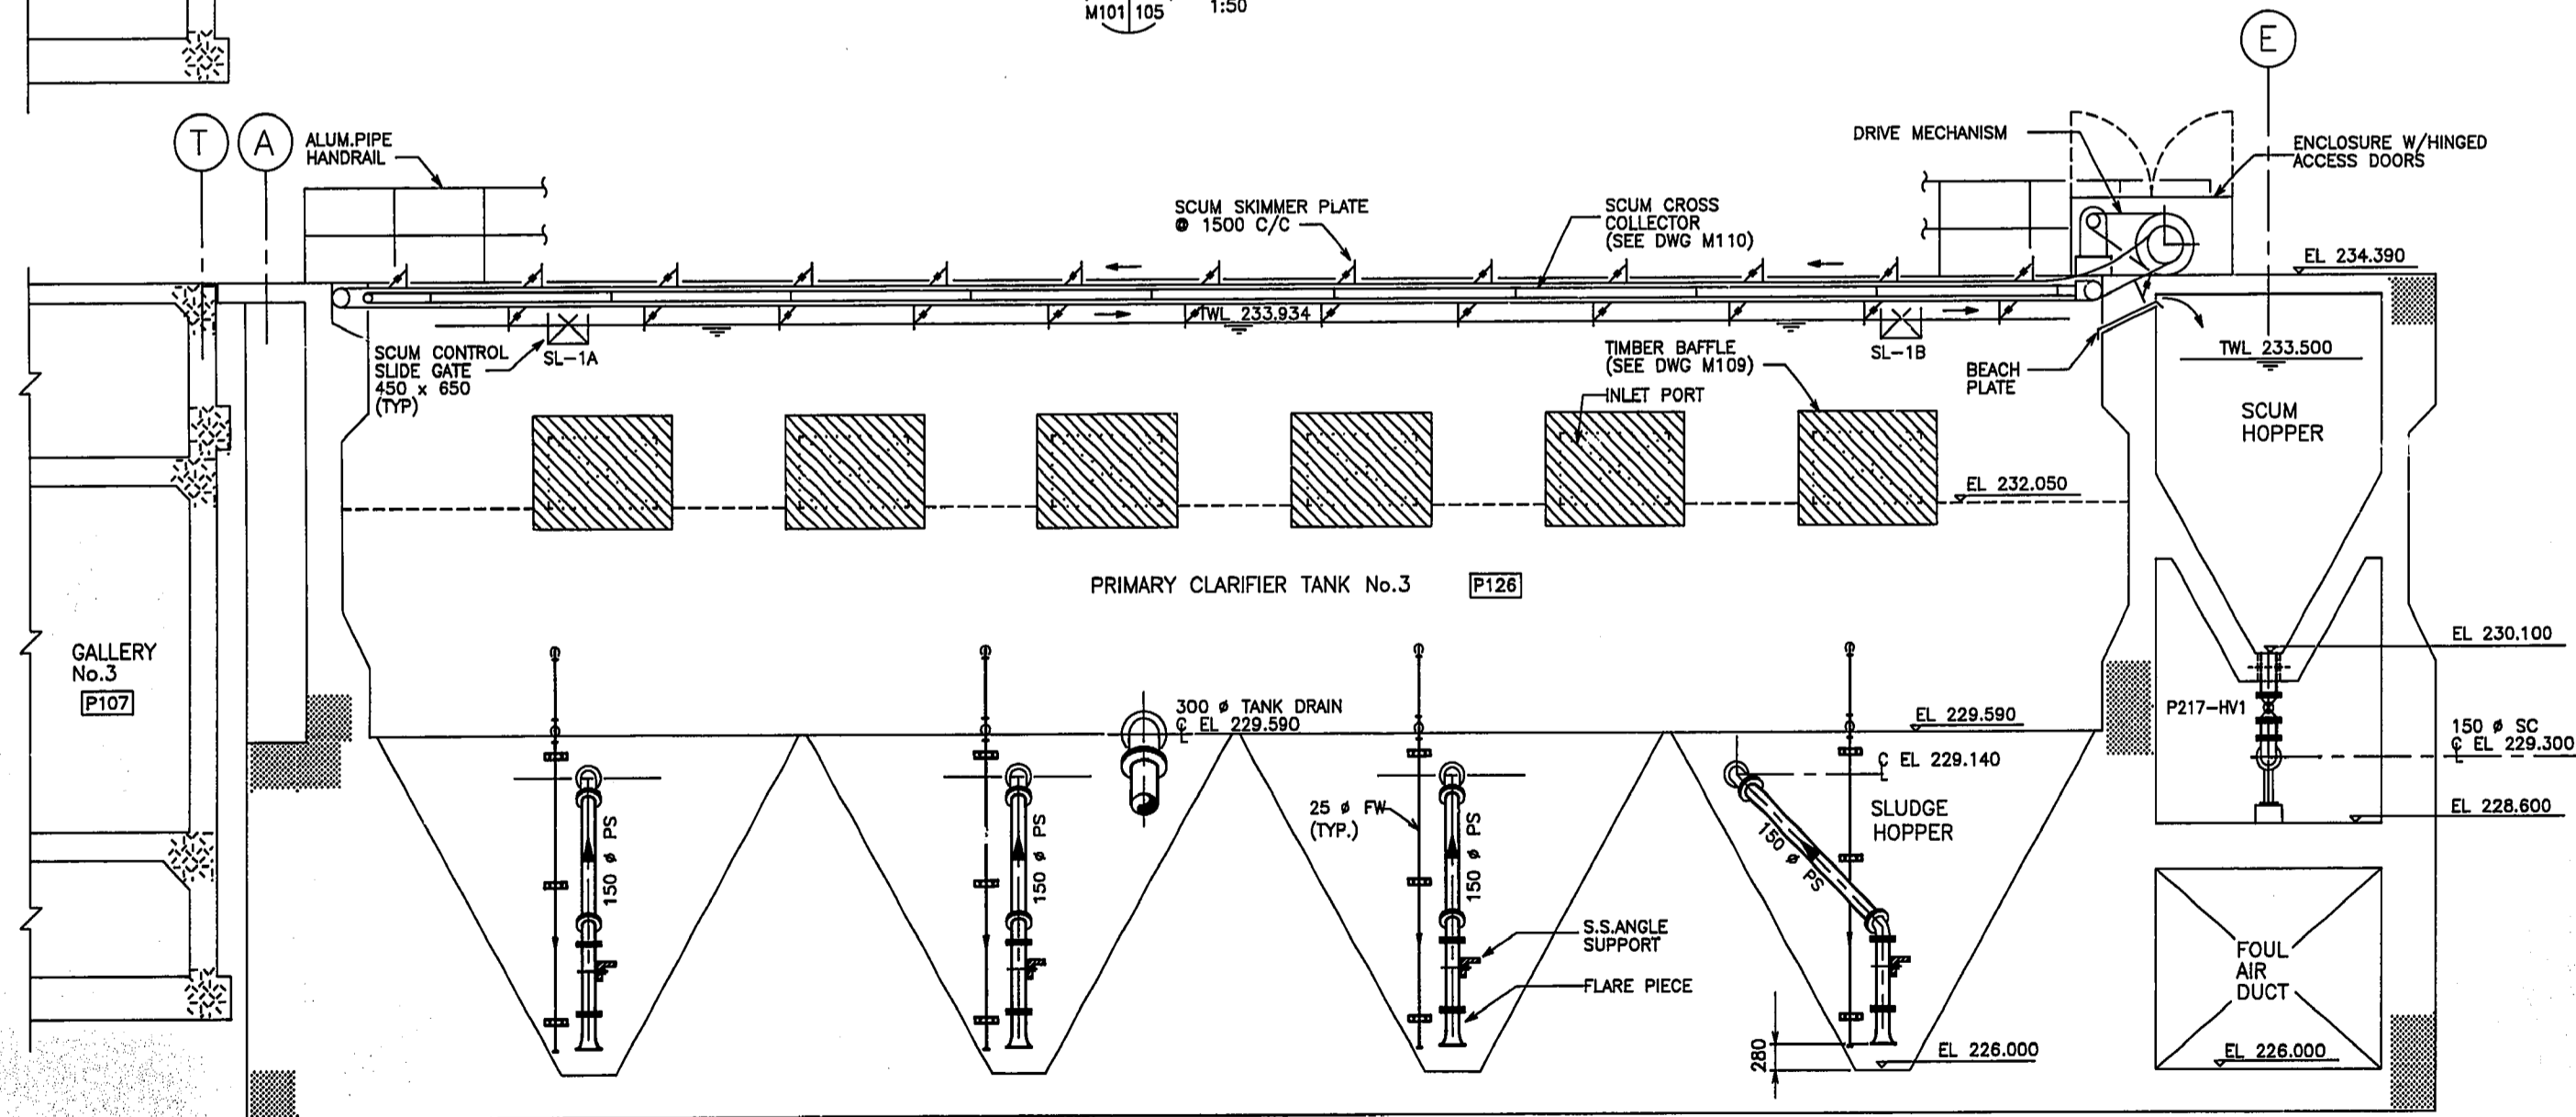

4 SECTION
M101 105 1:50

NOTE:
SEE DWG M107 FOR LEGEND

AS CONSTRUCTED
DATE OCTOBER/91 BY S.Q.
APPROVED BY Sean Quigley

B.M. ELEV.					
1	AS CONSTRUCTED	10/91	S.Q.		
0	ISSUED FOR TENDER	08/89	E.H.		
NO.	REVISIONS	DATE	BY	DATE	

ORIGINALLY DESIGNED BY
MACLAREN ENGINEERS INC.
WARDROP ENGINEERING INC.
ENGINEERING CONSULTANTS
DESIGNED BY RDJ/CS/HS
CHECKED BY RDJ
DRAWN BY TL/CAD
APPROVED BY [Signature]
HOR. SCALE: 1:50
VERTICAL: 1:50
RELEASED FOR CONSTRUCTION:
DATE

CONSULTANT DRAWING NO.
43525 - M105

THE CITY OF WINNIPEG
WORKS AND OPERATIONS DIVISION
WATERWORKS, WASTE & DISPOSAL DEPARTMENT
SOUTH END WATER POLLUTION CONTROL CENTRE
PRIMARY CLARIFIER - MECHANICAL
CITY DRAWING NUMBER
SHEET OF
SECTIONS
SEP-259