




1 DETAIL
NTS

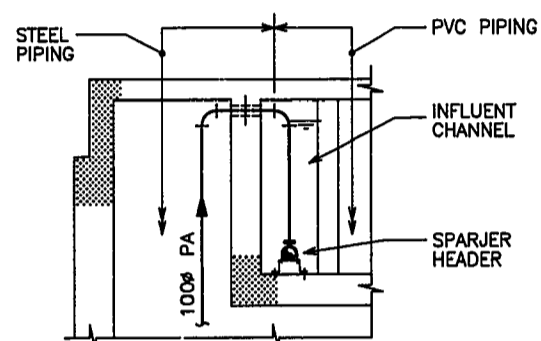


10 SECTION
M103/106 1:50

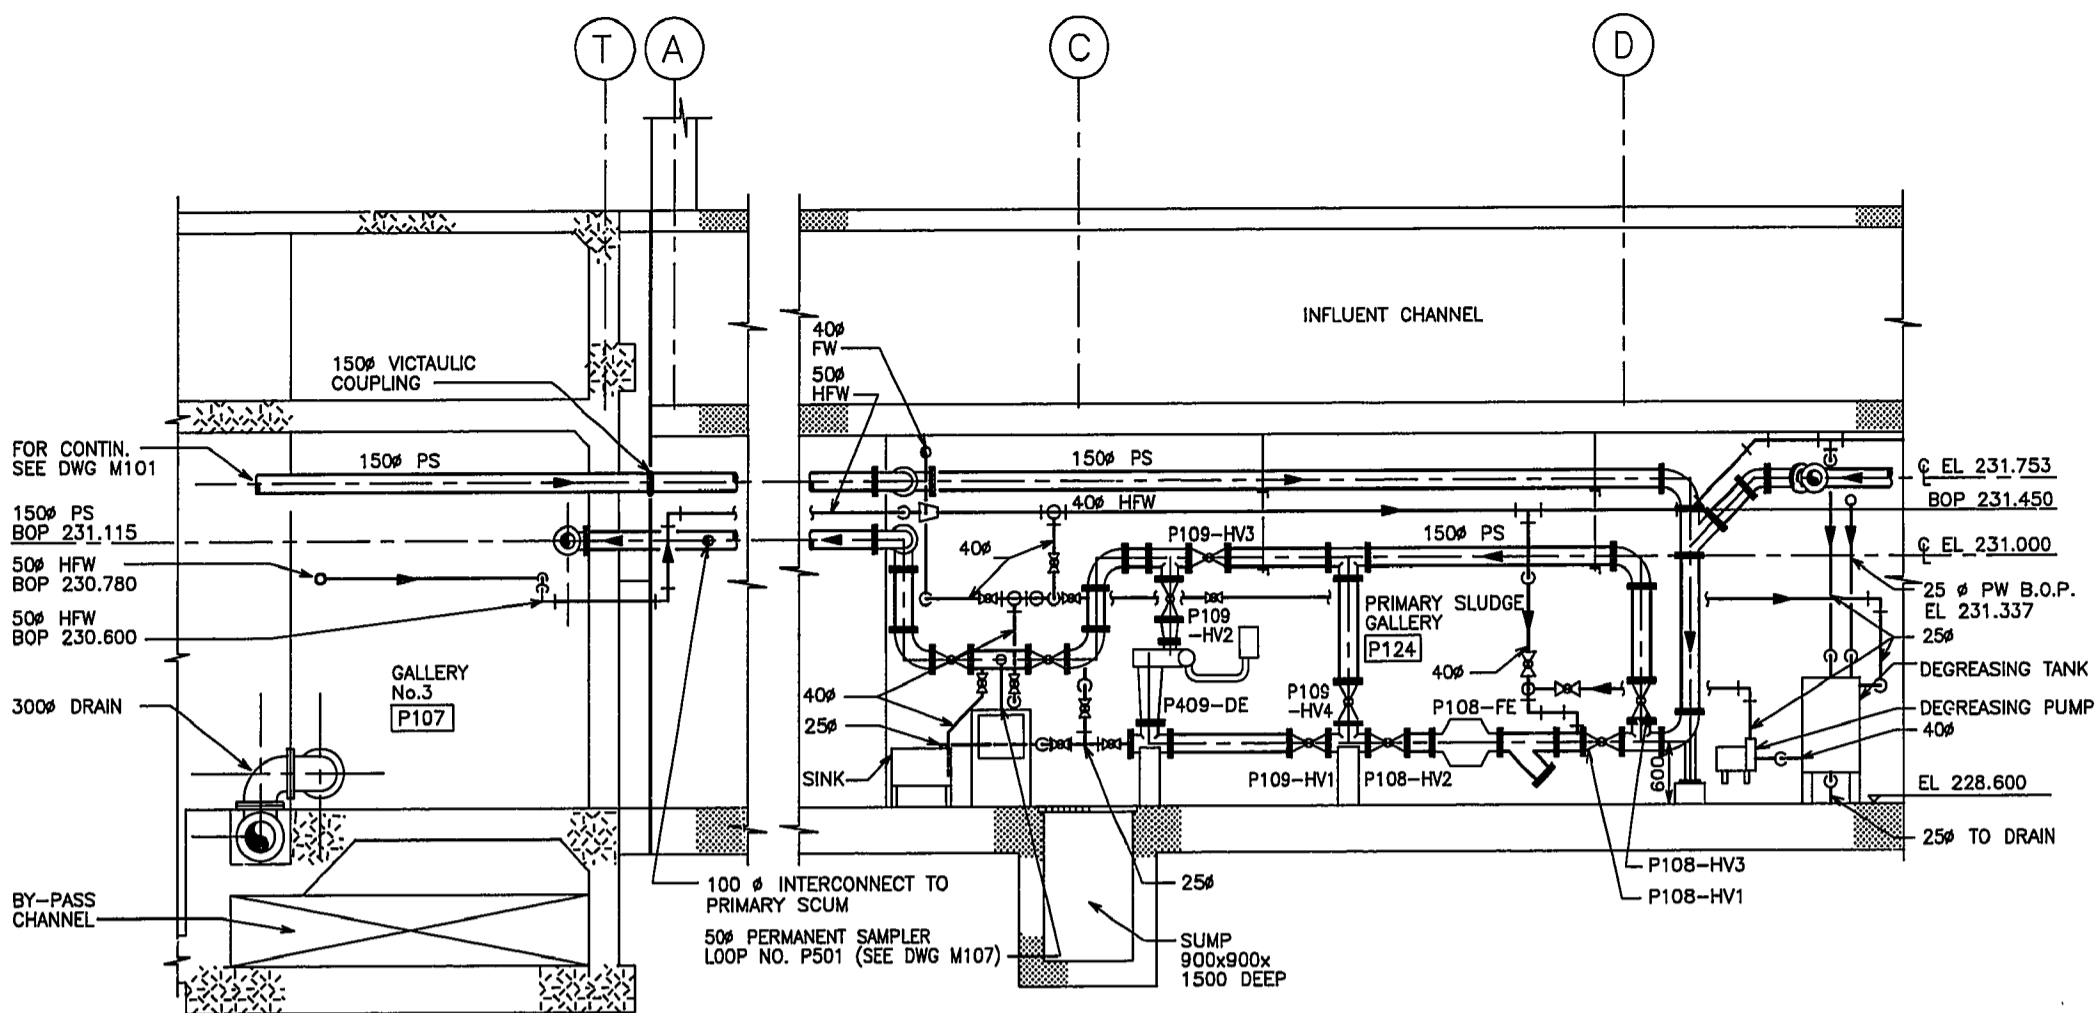


7 SECTION
M101/106 N.T.S.

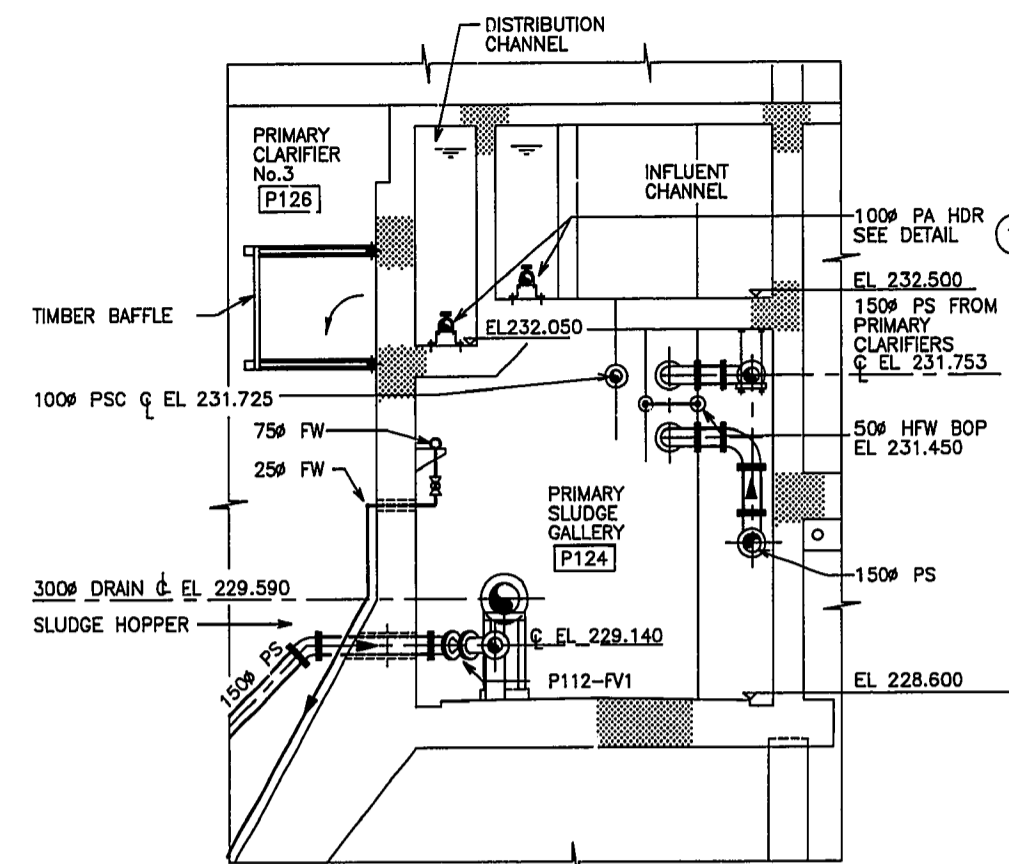


8 SECTION
M101/106 1:50

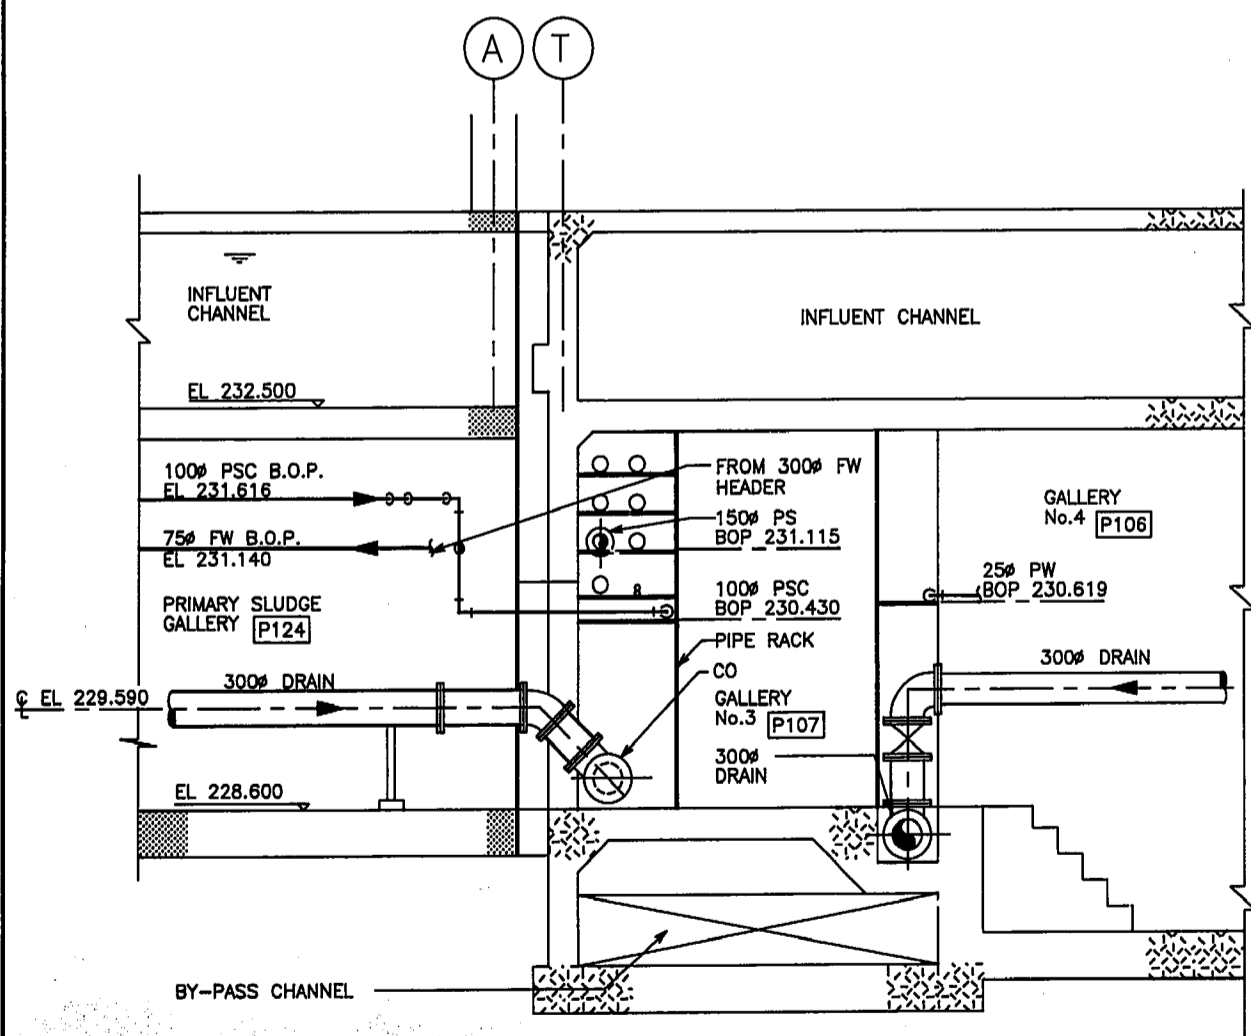

6 SECTION
M101/106 1:50

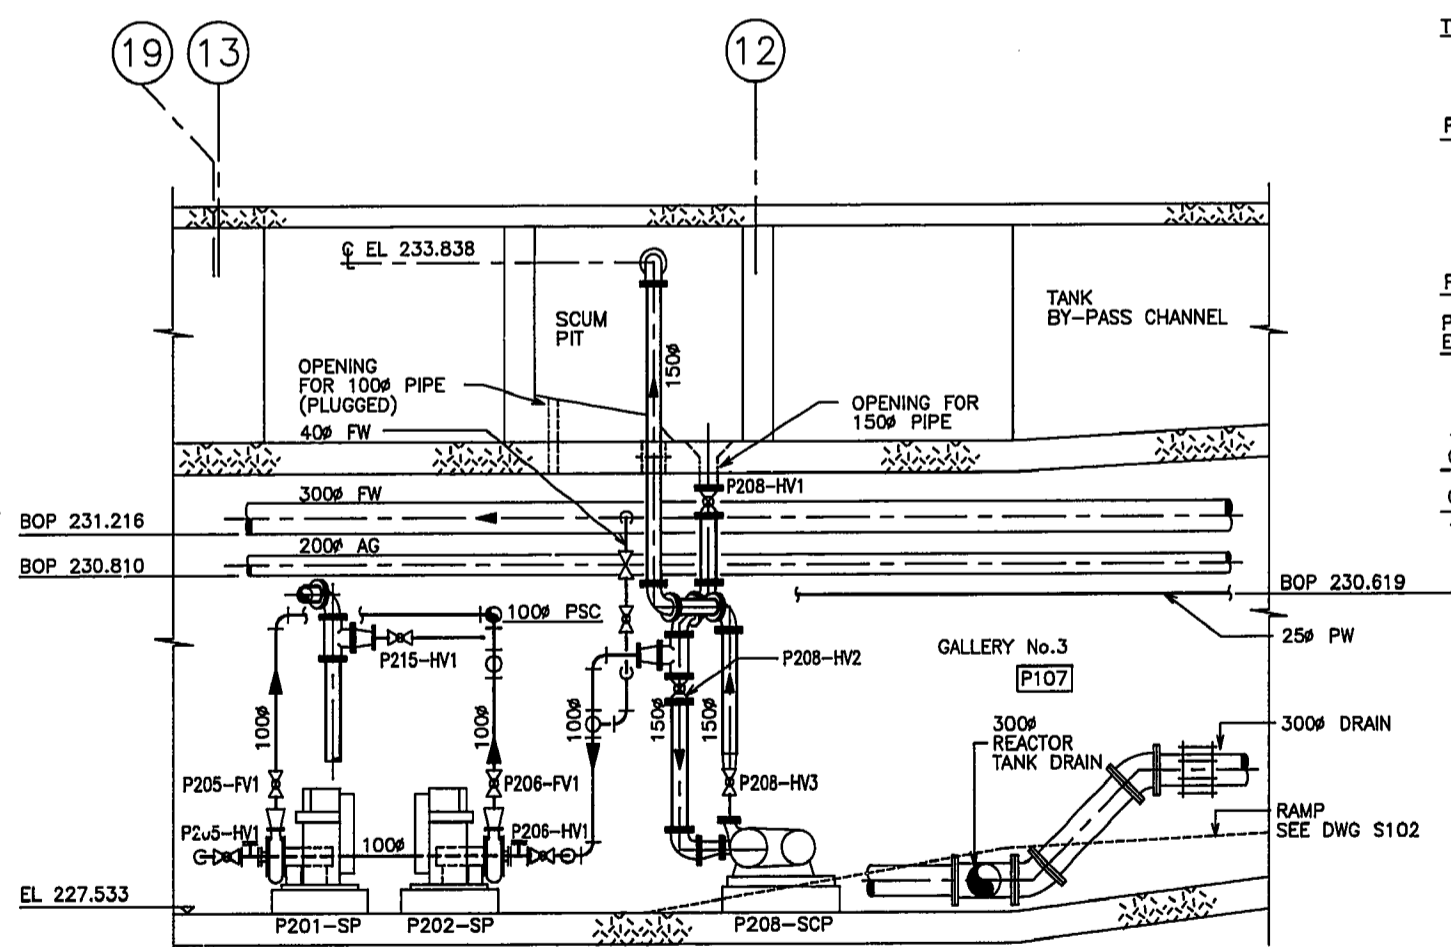

5 SECTION
M101/106 1:50

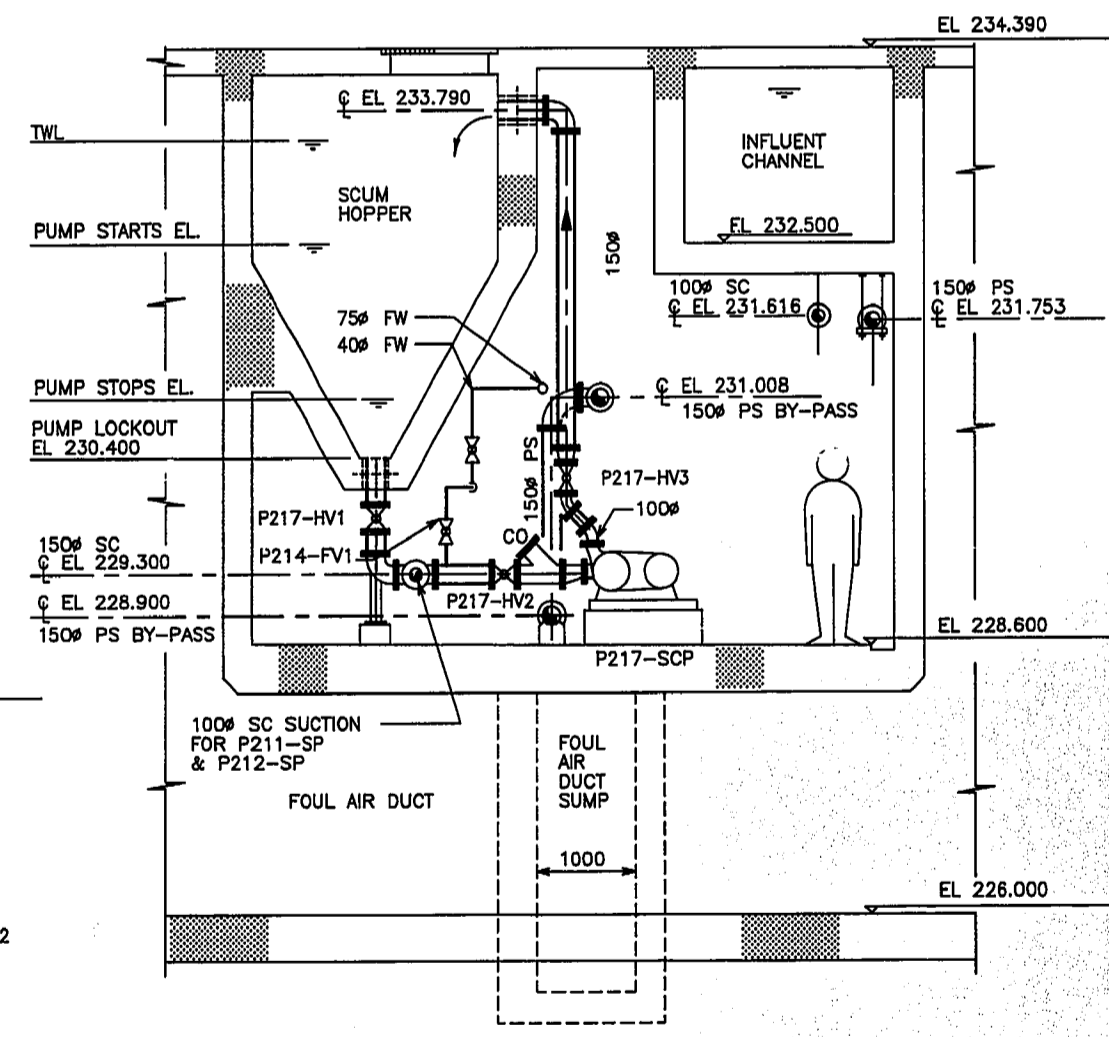

9 SECTION
M101/106 1:50

NOTE:
SEE DWG M107 FOR LEGEND

AS CONSTRUCTED
DATE OCTOBER / 91 BY S.Q.
APPROVED BY Sean Quigley

B.M. ELEV.	DATE	BY

MacLAREN ENGINEERS INC. WARDROP ENGINEERING INC. ENGINEERING CONSULTANTS	
DESIGNED BY RDJ/CS/HS	CHECKED BY RDJ
DRAWN BY TL / CAD	APPROVED BY <i>[Signature]</i>
HOR. SCALE: 1:50 VERTICAL: 1:50	
RELEASED FOR CONSTRUCTION: DATE:	

ORIGINALLY DESIGNED BY

 CONSULTANT DRAWING NO.
43525 - M106

THE CITY OF WINNIPEG
WORKS AND OPERATIONS DIVISION
 WATERWORKS, WASTE & DISPOSAL DEPARTMENT

SOUTH END WATER POLLUTION CONTROL CENTRE
 PRIMARY CLARIFIER - MECHANICAL

CITY DRAWING NUMBER
SHEET OF
SEP-260