
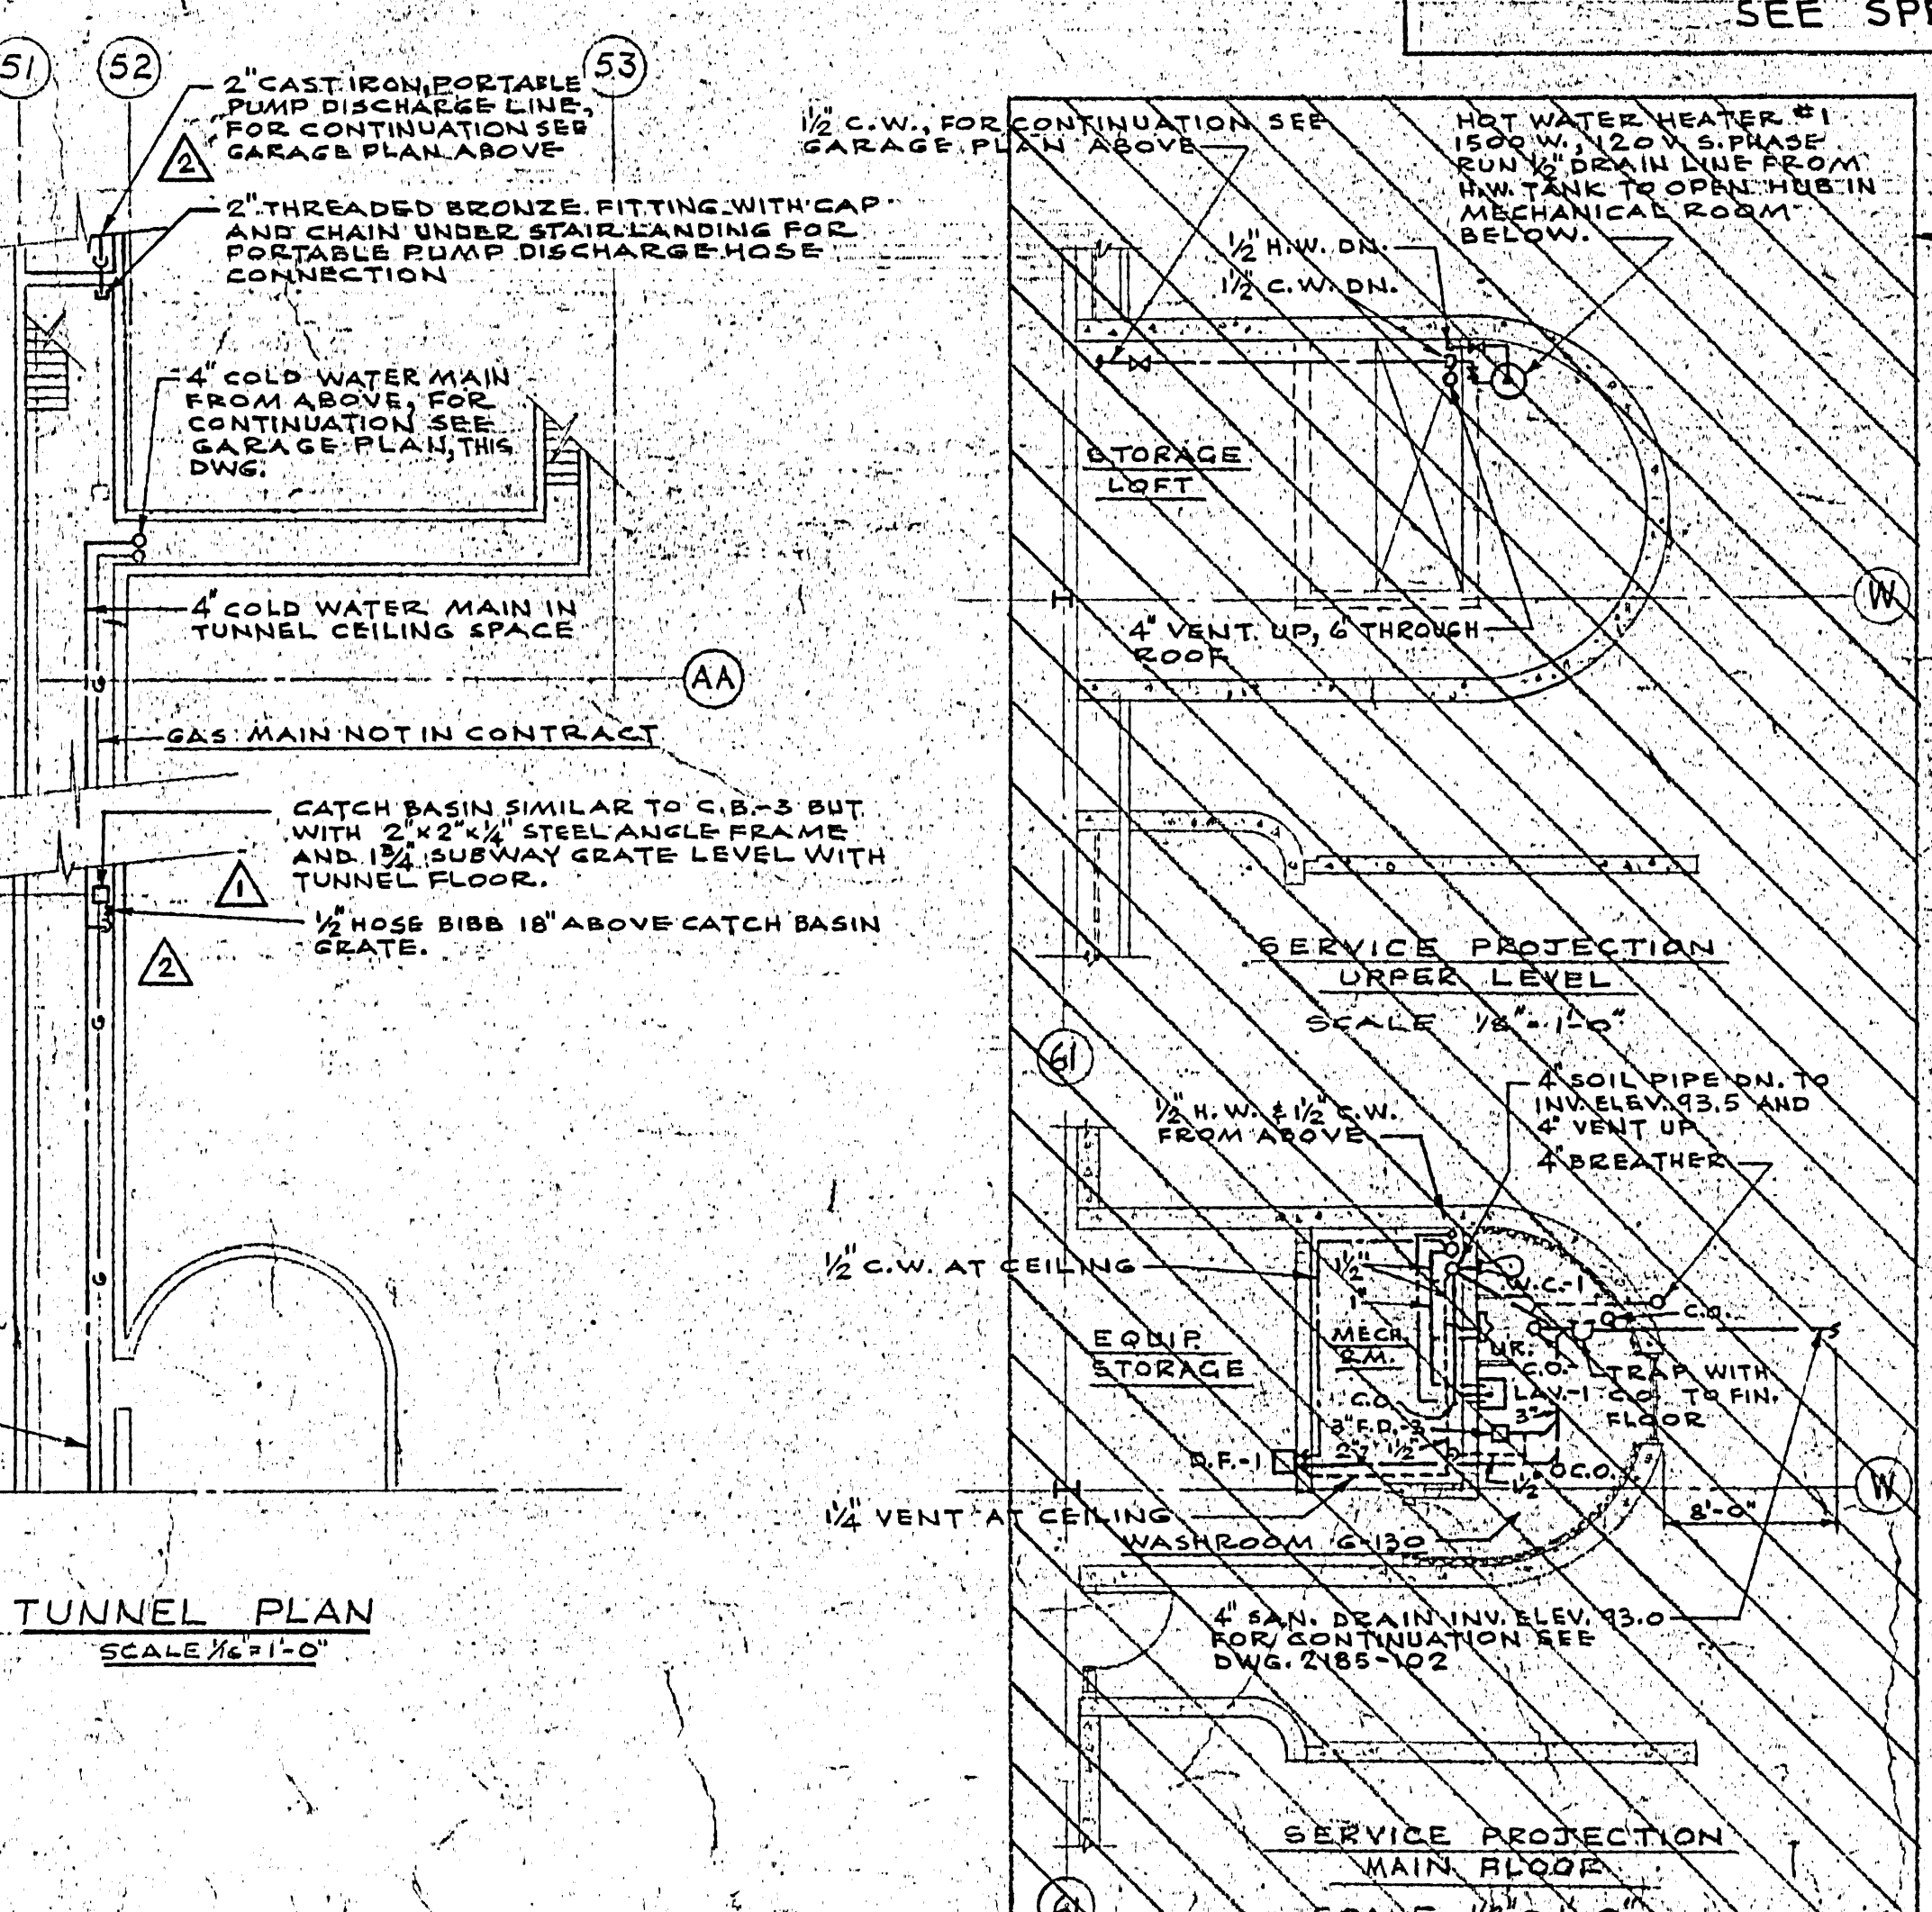
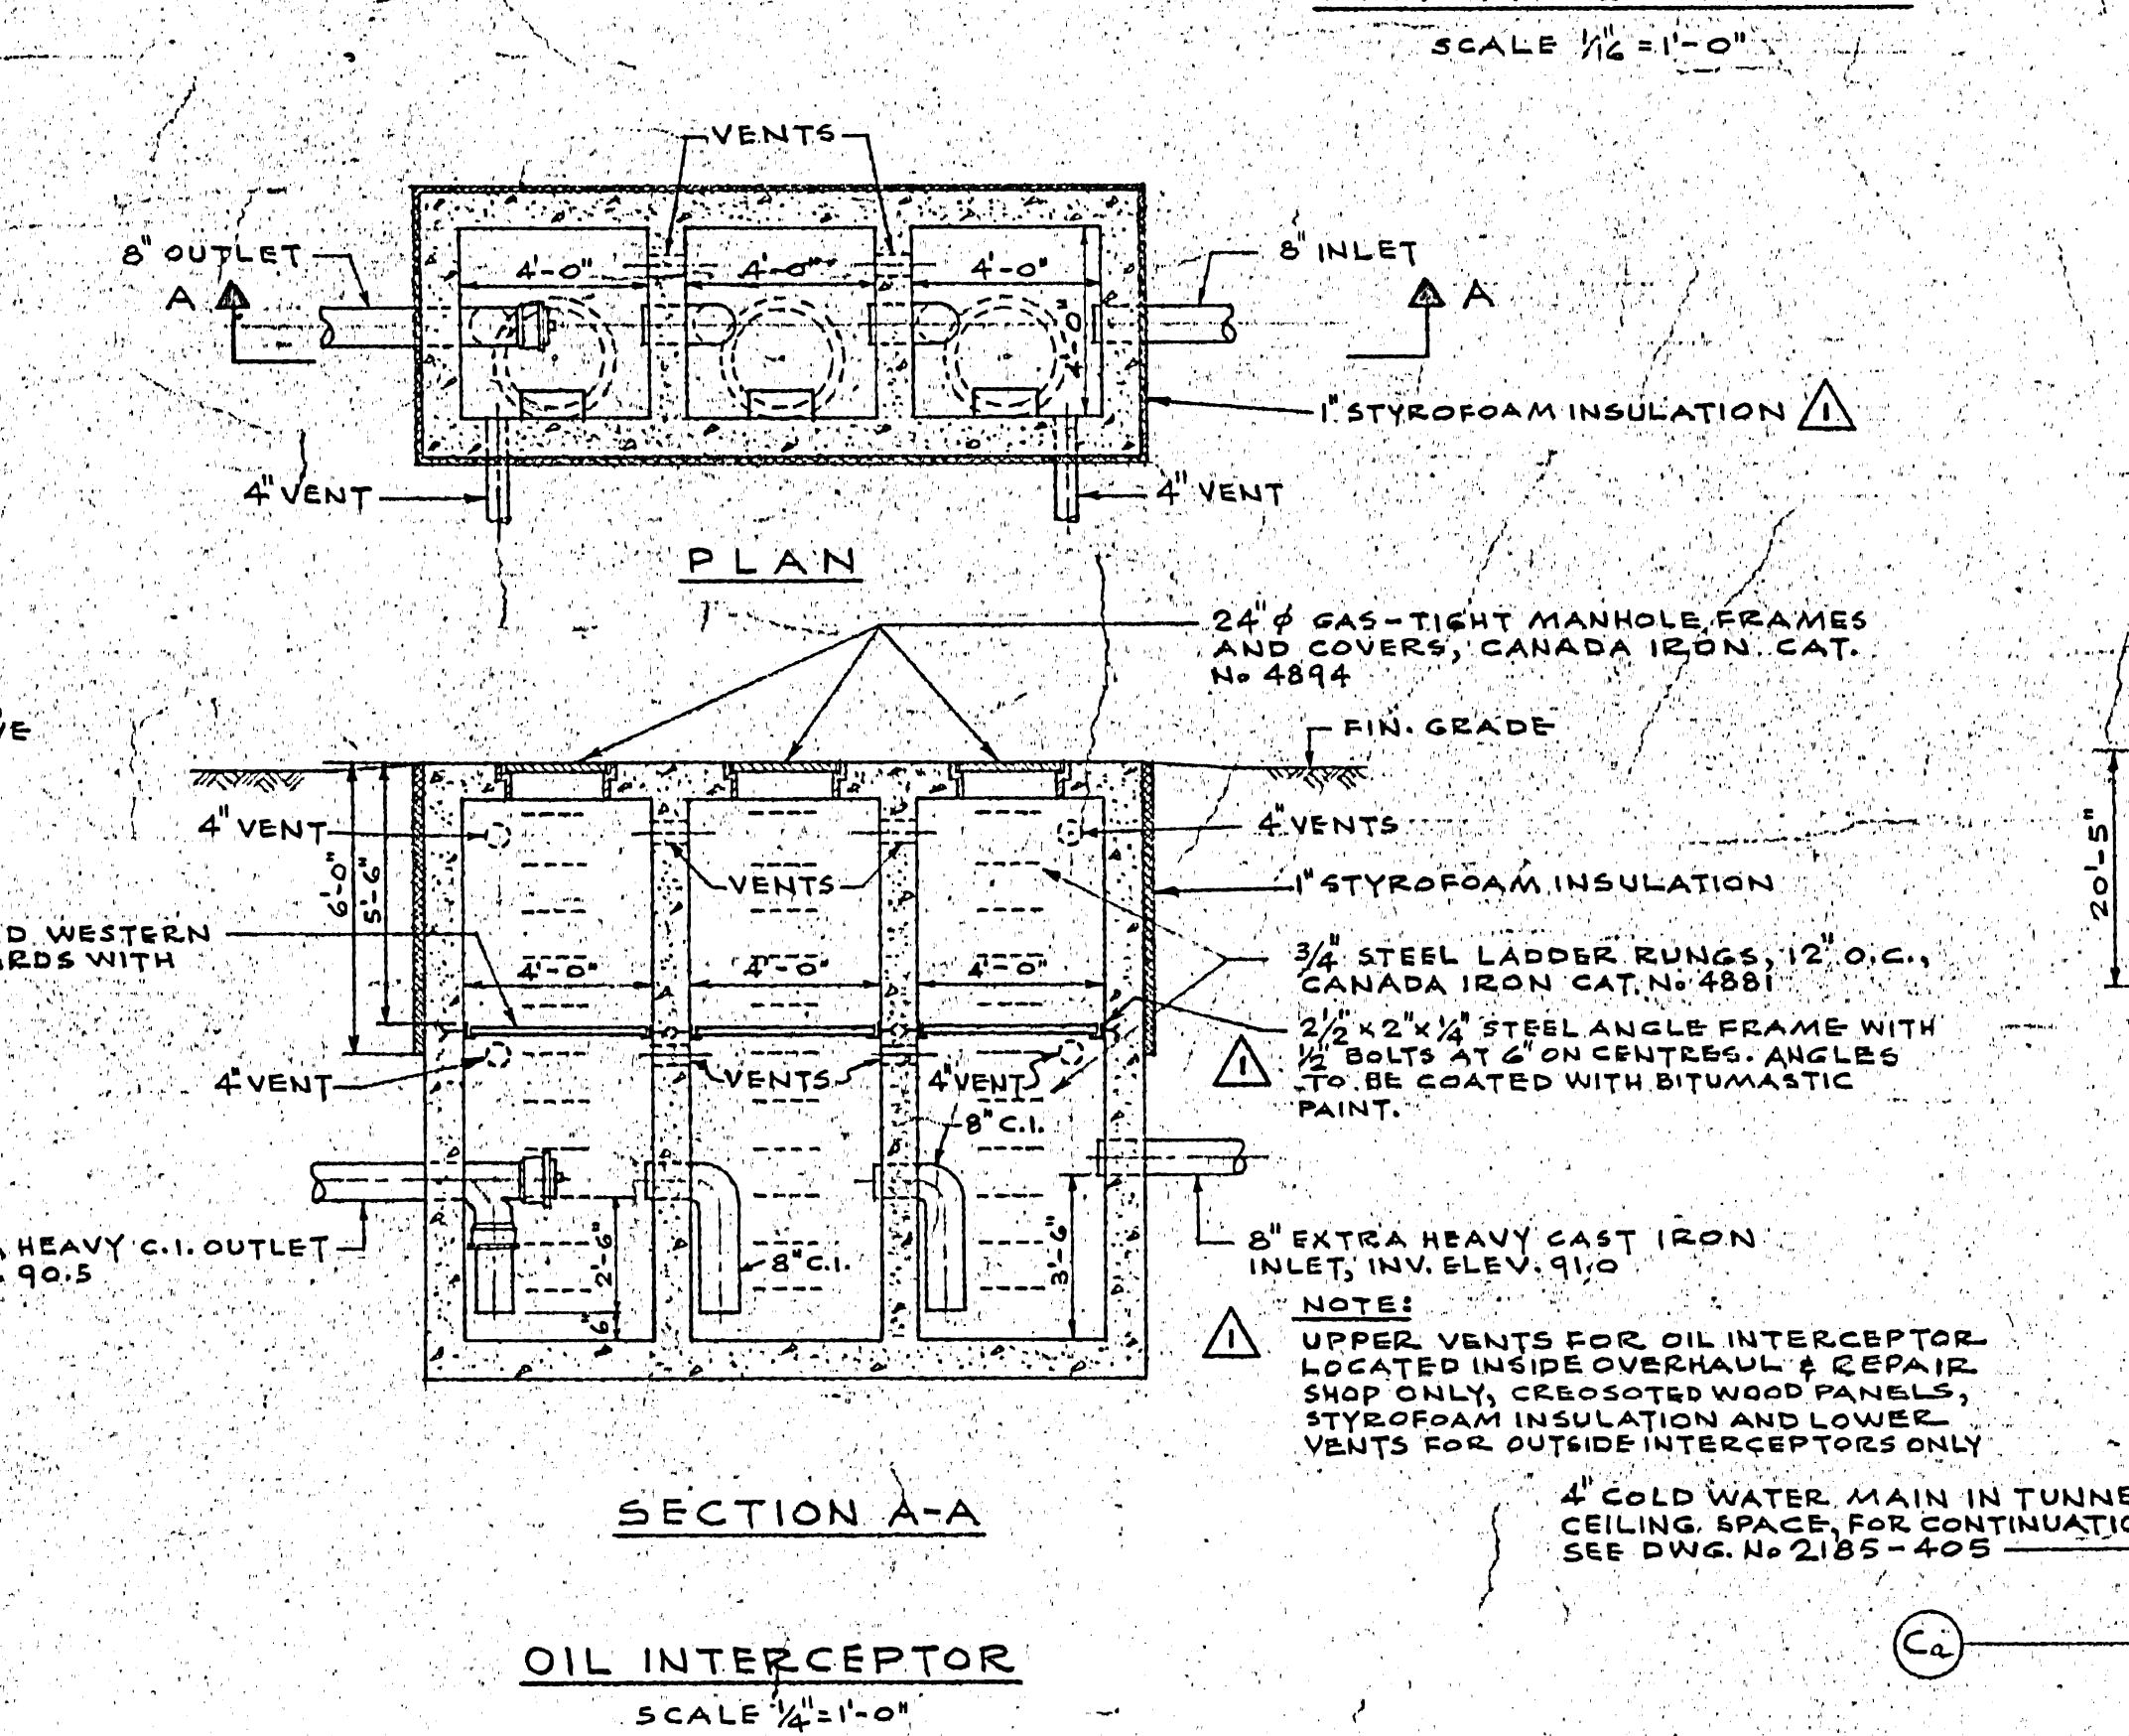
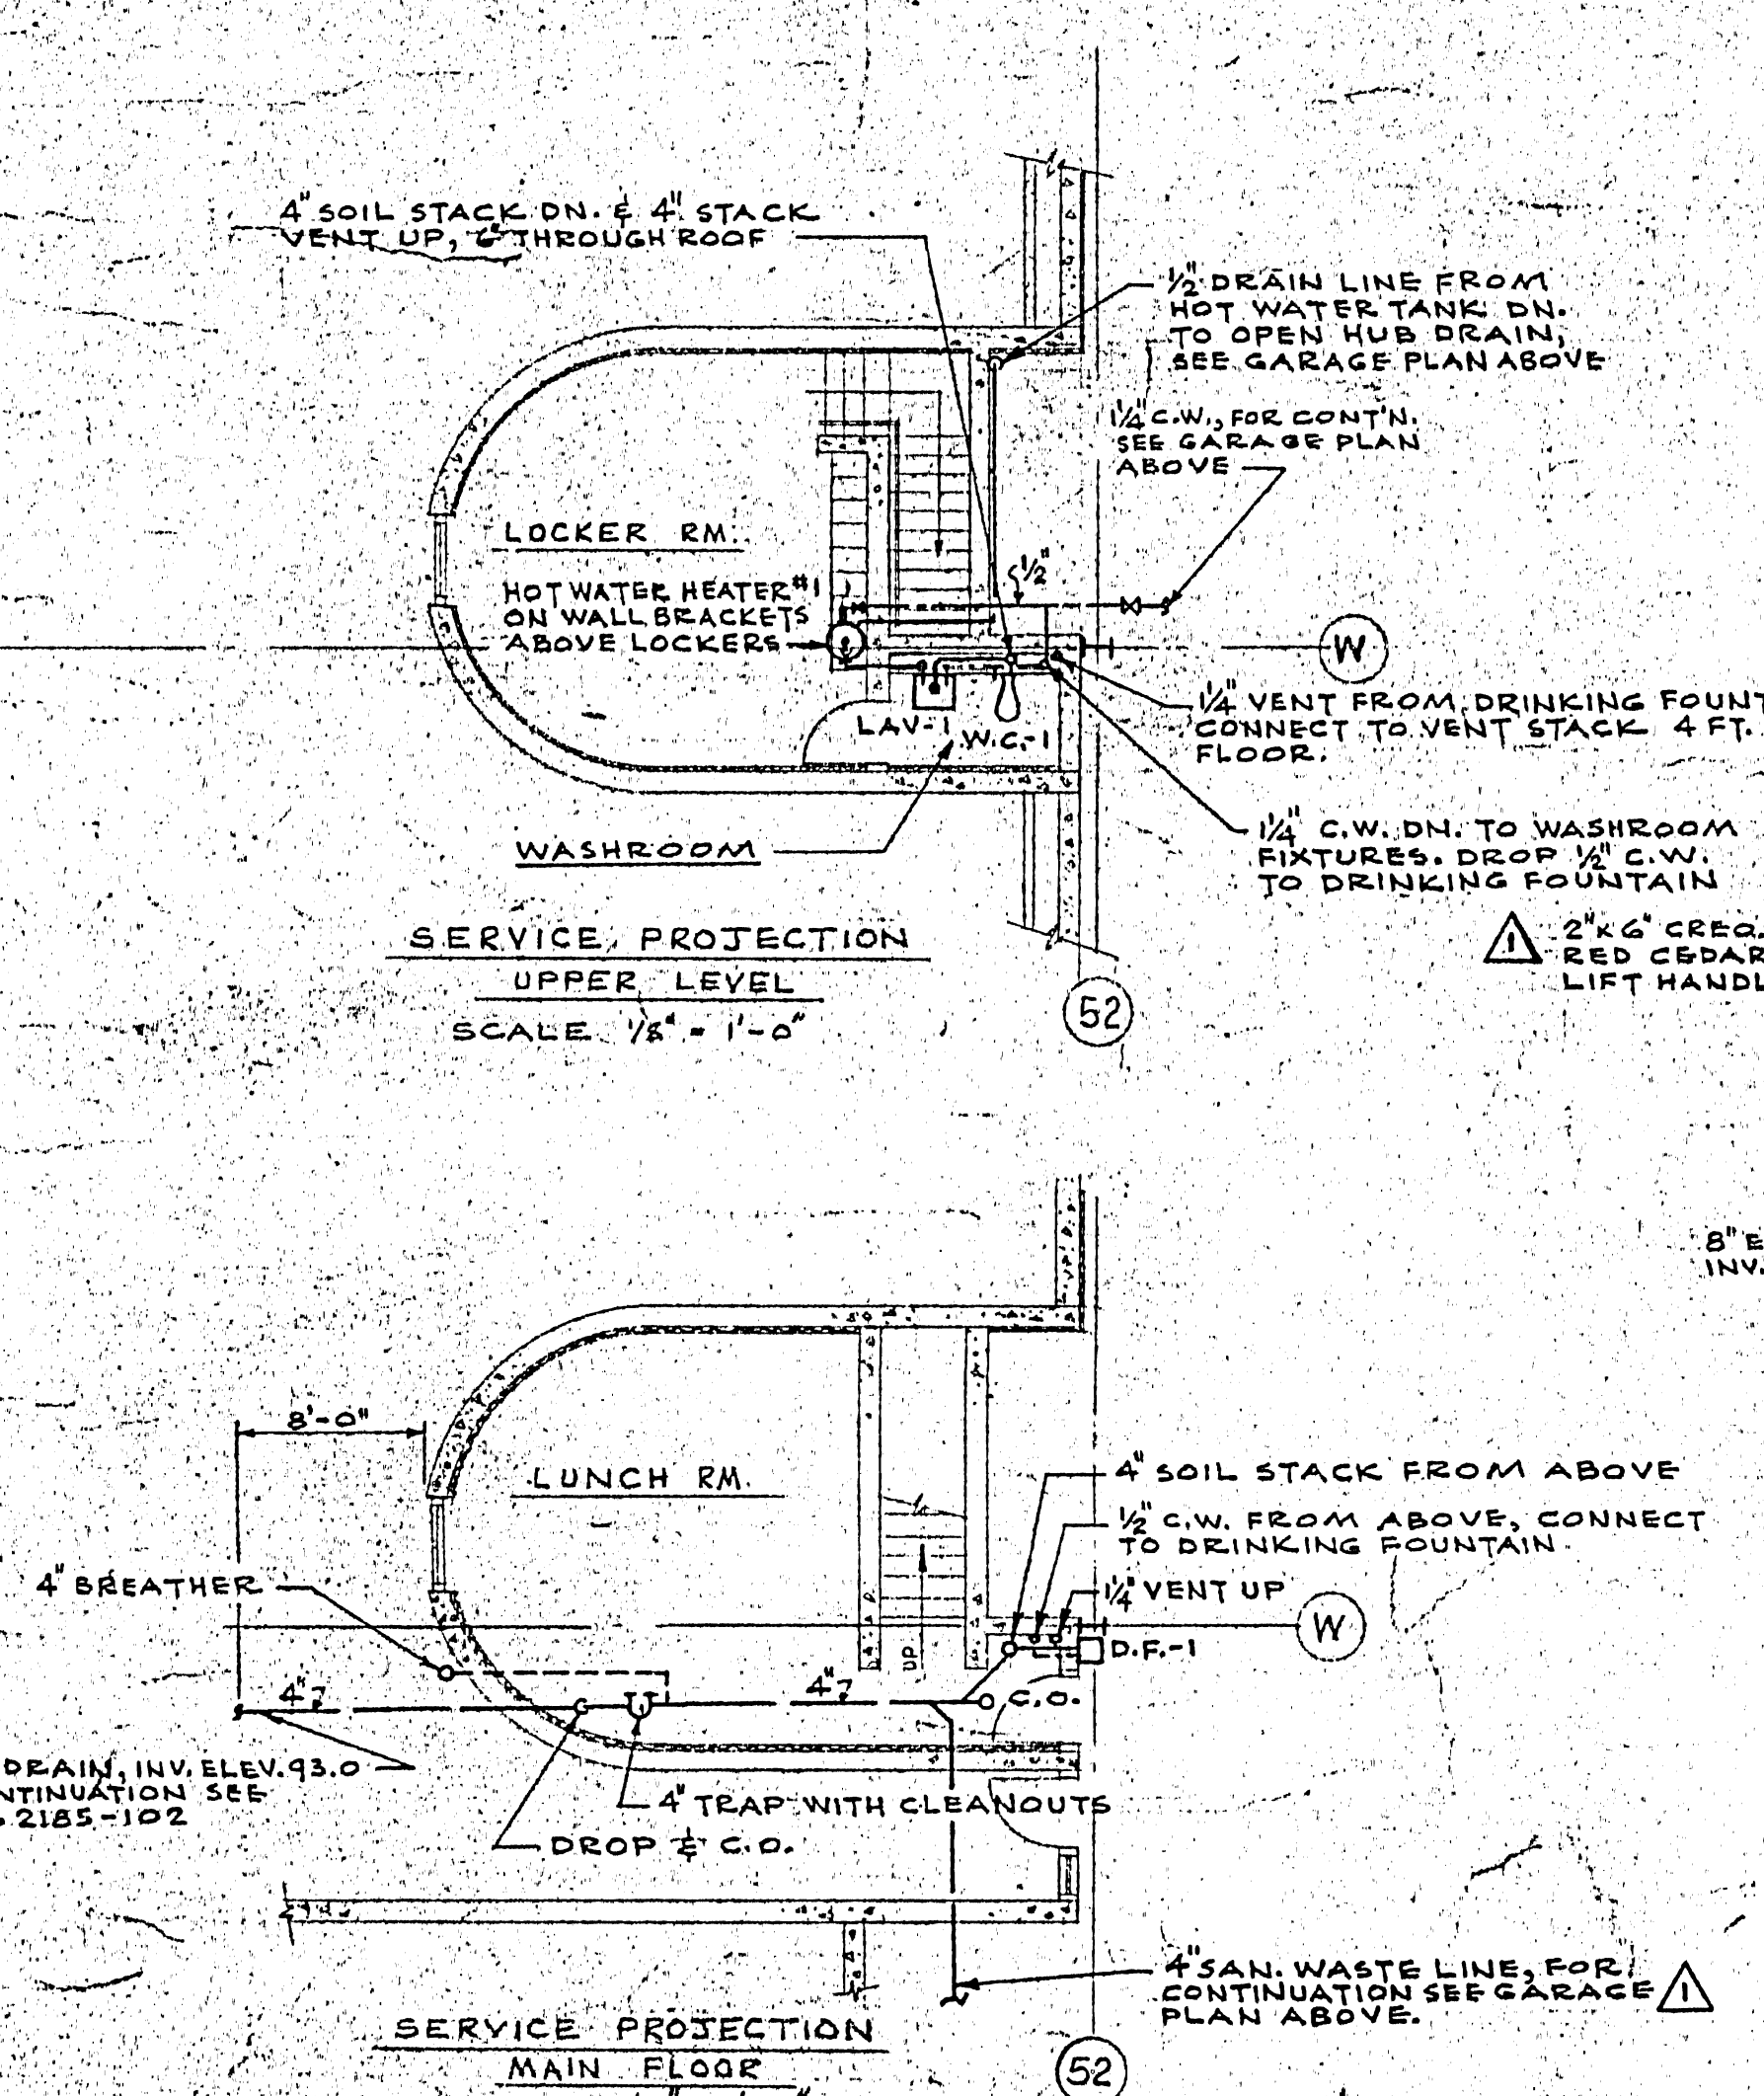


TRANSIT STORAGE & SHOP FACILITIES
 2185-402
 GARAGE & SERVICE BAY - PLUMBING & DRAINAGE - PLANS & DETAILS

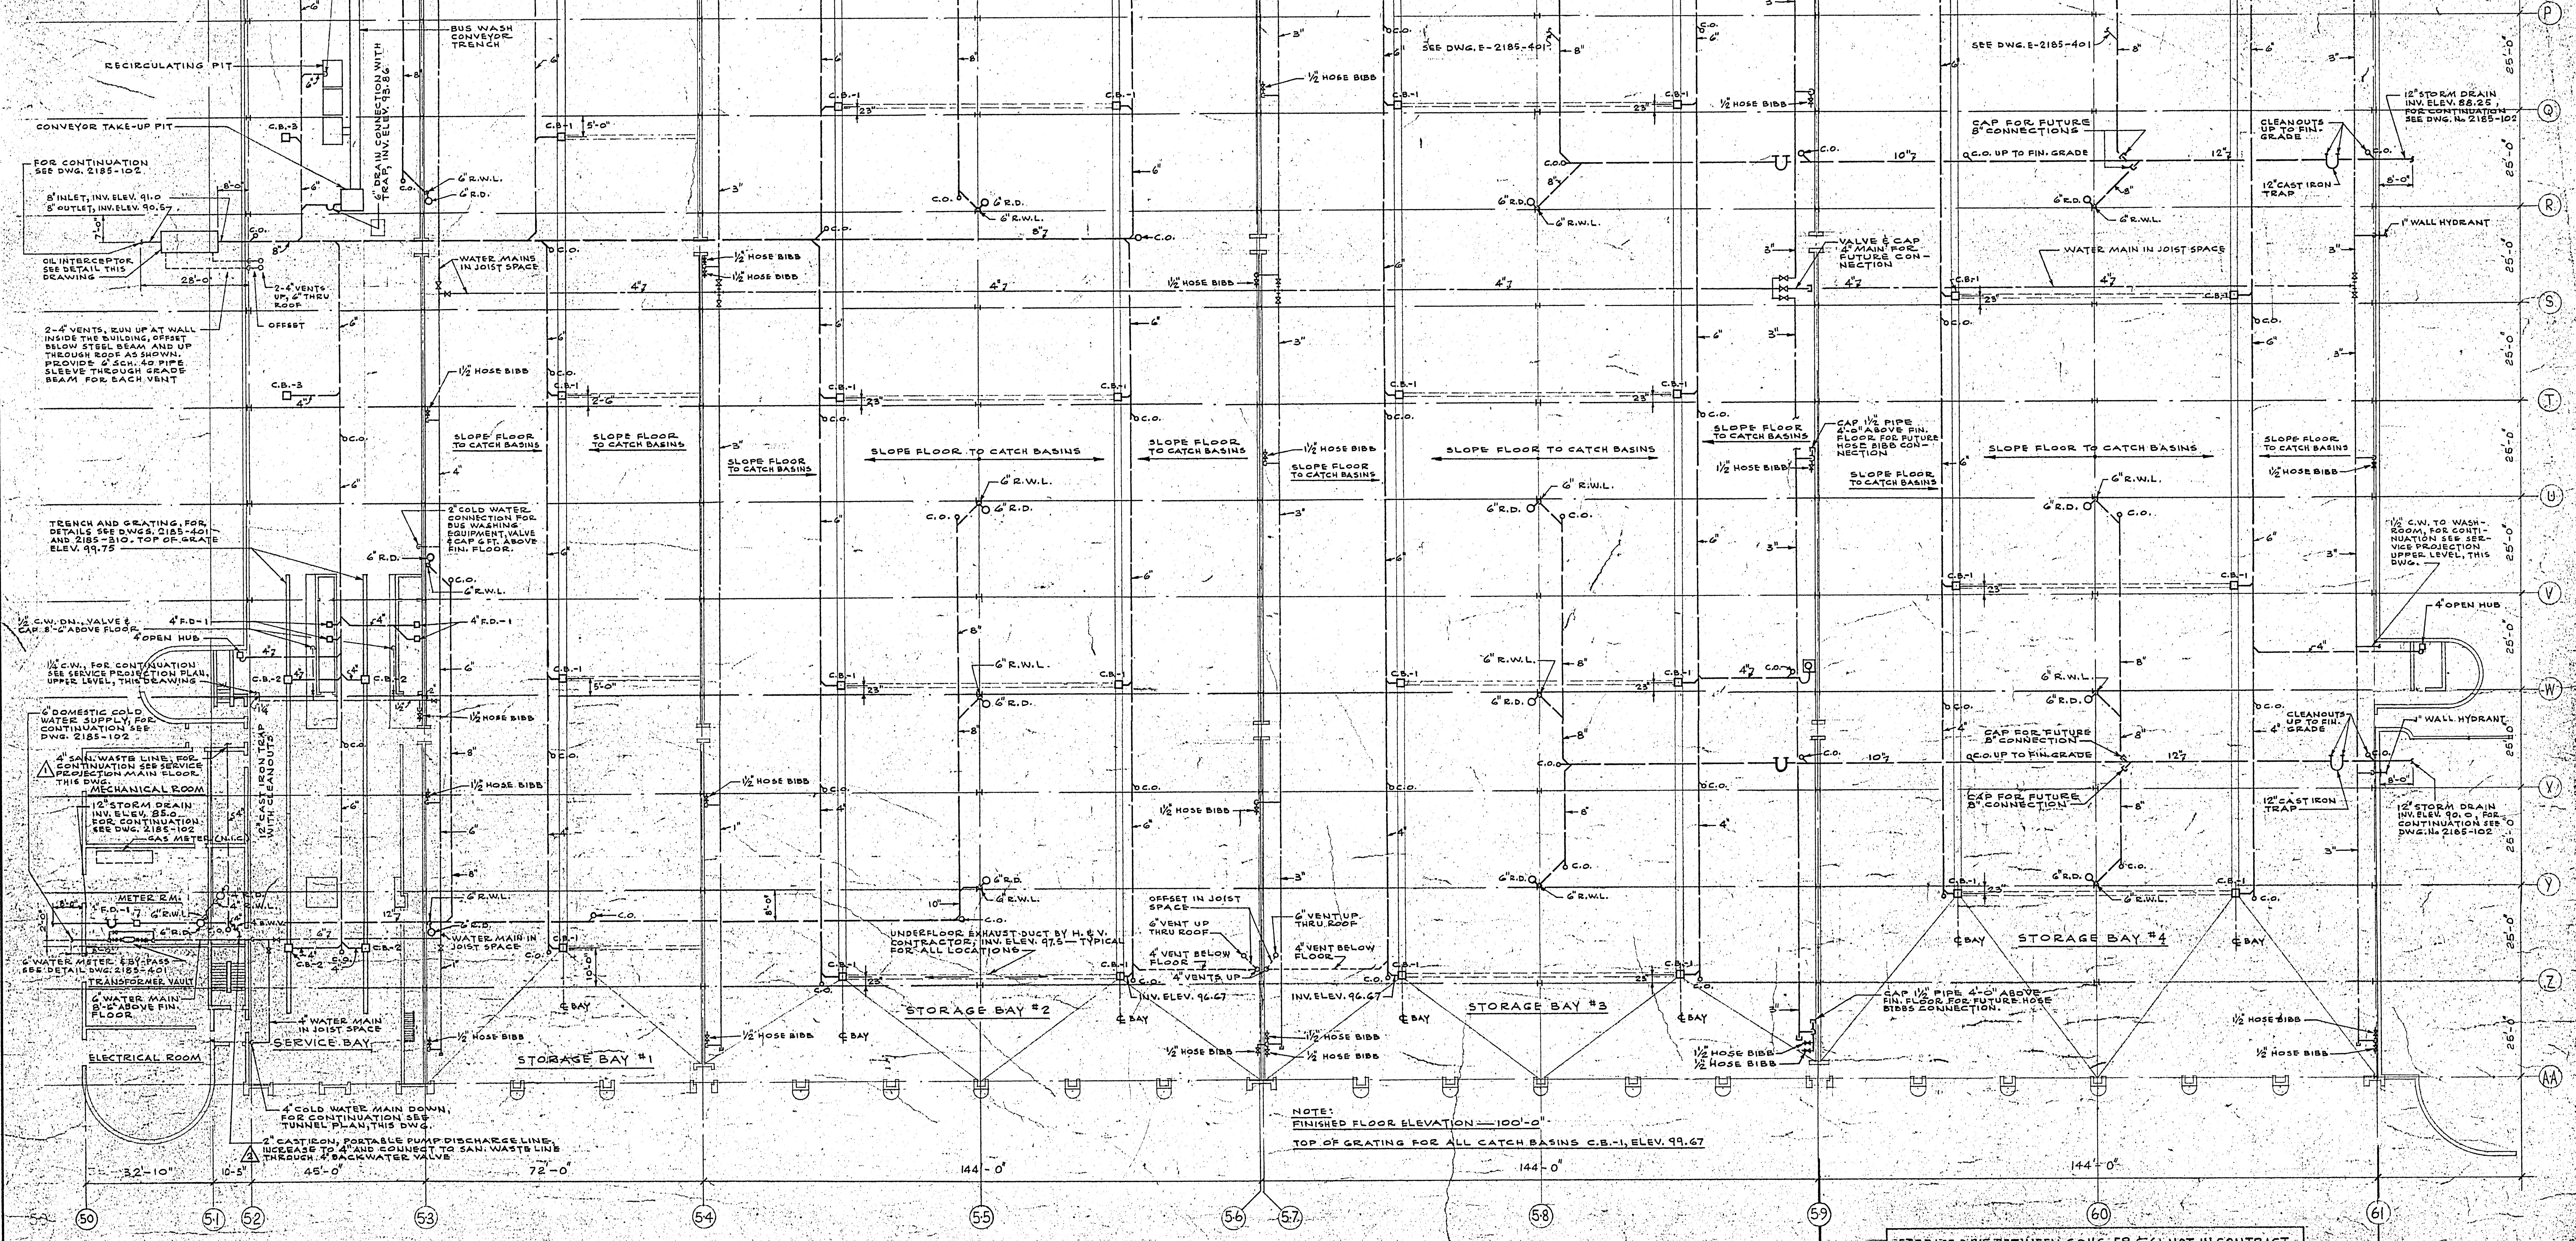

2185-402

LICENSED TO PRACTICE IN THE PROVINCE OF MANITOBA
 My License Expires: 31 Jan. 1983

DATE	ISSUE NO.	REV. NO.	DESCRIPTION	DRAWN BY
30/9/67	1		AS BUILT	J.L.
7/6/68	5		REVISED PER PROPOSED NOTICE OF CHANGE # 17	J.L.
23/6/68	4		REVISED PER PROPOSED NOTICE OF CHANGE # 12	J.L.
29/6/68	3		FOR CONSTRUCTION	J.L.
17/1/69	2		FOR TENDER	J.L.
02/2/67	1		FOR APPROVAL	J.L.

METROPOLITAN CORPORATION OF GREATER WINNIPEG
 STREETS AND TRANSIT DIVISION

TRANSIT STORAGE AND SHOP FACILITIES
 GARAGE & SERVICE BAY
 PLUMBING & DRAINAGE - PLAN & DETAILS

CONSULTING PROFESSIONAL ENGINEERS
 A. D. HARRISON AND ASSOCIATES LIMITED
 1155 LESLIE STREET, DON MILLS, ONTARIO

ARCHITECTS
 WILKINSON TOMES & BLANKENHORN GILLMER HANCOCK
 1155 LESLIE STREET, DON MILLS, ONTARIO

APPROVED: [Signature]
 DEPUTY DIRECTOR OF STREETS AND TRANSIT

DRAWN BY: J.L.
 CHECKED: J.T.T.
 FILE NO.:
 SHEET NO.: 2185-402 MECHANICAL