

CONSTRUCTION NOTES:

- ALL DIMENSIONS ARE TO BACK OF CURB.
- ISOLATE MISCELLANEOUS ITEMS IN NEW CONCRETE WORKS AS PER SD-228C.
- LEGAL PLAN AND UNDERGROUND INFORMATION FROM CITY OF WINNIPEG LBIS. CONTRACTOR TO VERIFY ALL UNDERGROUNDS IN THE FIELD.
- CONTRACTOR TO TAKE PRECAUTIONARY STEPS TO AVOID DAMAGE FROM CONSTRUCTION ACTIVITIES TO TREES WITHIN THE LIMITS OF CONSTRUCTION.
- LOCATION OF EXISTING SERVICES TO BE CONFIRMED IN THE FIELD BY THE CONTRACTOR.
- CB LEADS TO BE INSTALLED AT MIN. 1.0% SLOPE OR AS DIRECTED BY CONTRACT ADMINISTRATOR.
- LIMITS OF SIDEWALK RENEWAL TO BE FINALIZED IN THE FIELD BY THE CONTRACT ADMINISTRATOR.
- LIMITS OF BOULEVARD GRADING TO BE FINALIZED IN THE FIELD BY THE CONTRACT ADMINISTRATOR.
- ALL EXISTING LONG WATER SERVICES TO BE INSULATED AS PER SD-018 (AS REQUIRED).
- ALL BOULEVARDS TO BE SOD UNLESS OTHERWISE NOTED.
- CONTRACTOR TO TAKE PRECAUTIONARY STEPS TO PROTECT EXISTING TREES WITHIN THE LIMITS OF CONSTRUCTION FROM DAMAGE BY CONSTRUCTION ACTIVITIES AS OUTLINED IN THE SPECIFICATIONS.
- INSTALL 6 m OF 150 mm SUBDRAIN TO CATCH BASINS IN BOTH DIRECTIONS PARALLEL TO ROADWAY AS PER SD-245 AND CAP ENDS.
- INSTALL 150 mm SUBDRAIN ALONG ROADWAY NEAR RETAINING WALLS THROUGHOUT UNDERPASS AREA.
- MODIFIED BARRIER CURB AT ALL INTERSECTION RADI (SEE SHEETS CT-001 AND CT-002).
- ADJUST MANHOLE FRAMES, CATCH BASIN RIMS AND VALVES TO NEW GRADES, AS REQUIRED.
- CONTRACTOR TO TAKE PRECAUTIONARY STEPS WHEN WORKING IN PROXIMITY TO 200 mm HYDRO GAS LINE, INCLUDING SAFETY WATCH AS REQUIRED.

f.o.b. = FACE OF BARRIER
b.o.c. = BACK OF CURB


METRIC

WHOLE NUMBERS INDICATE MILLIMETRES
DECIMAL NUMBERS INDICATE METRES

WARNING

IF POWER EQUIPMENT OR EXPLOSIVES ARE TO BE USED FOR EXCAVATION ON THIS PROJECT THE CONTRACTOR MUST:

- NOTIFY THE GAS COMPANY OF THE PROPOSED LOCATION OF EXCAVATION.
- TAKE PRECAUTION TO AVOID DAMAGE TO GAS COMPANY INSTALLATIONS SEE PROVINCIAL REGULATION 210/72 FOR DETAILS.
- OBTAIN EXCAVATION PERMITS PRIOR TO CONSTRUCTION.

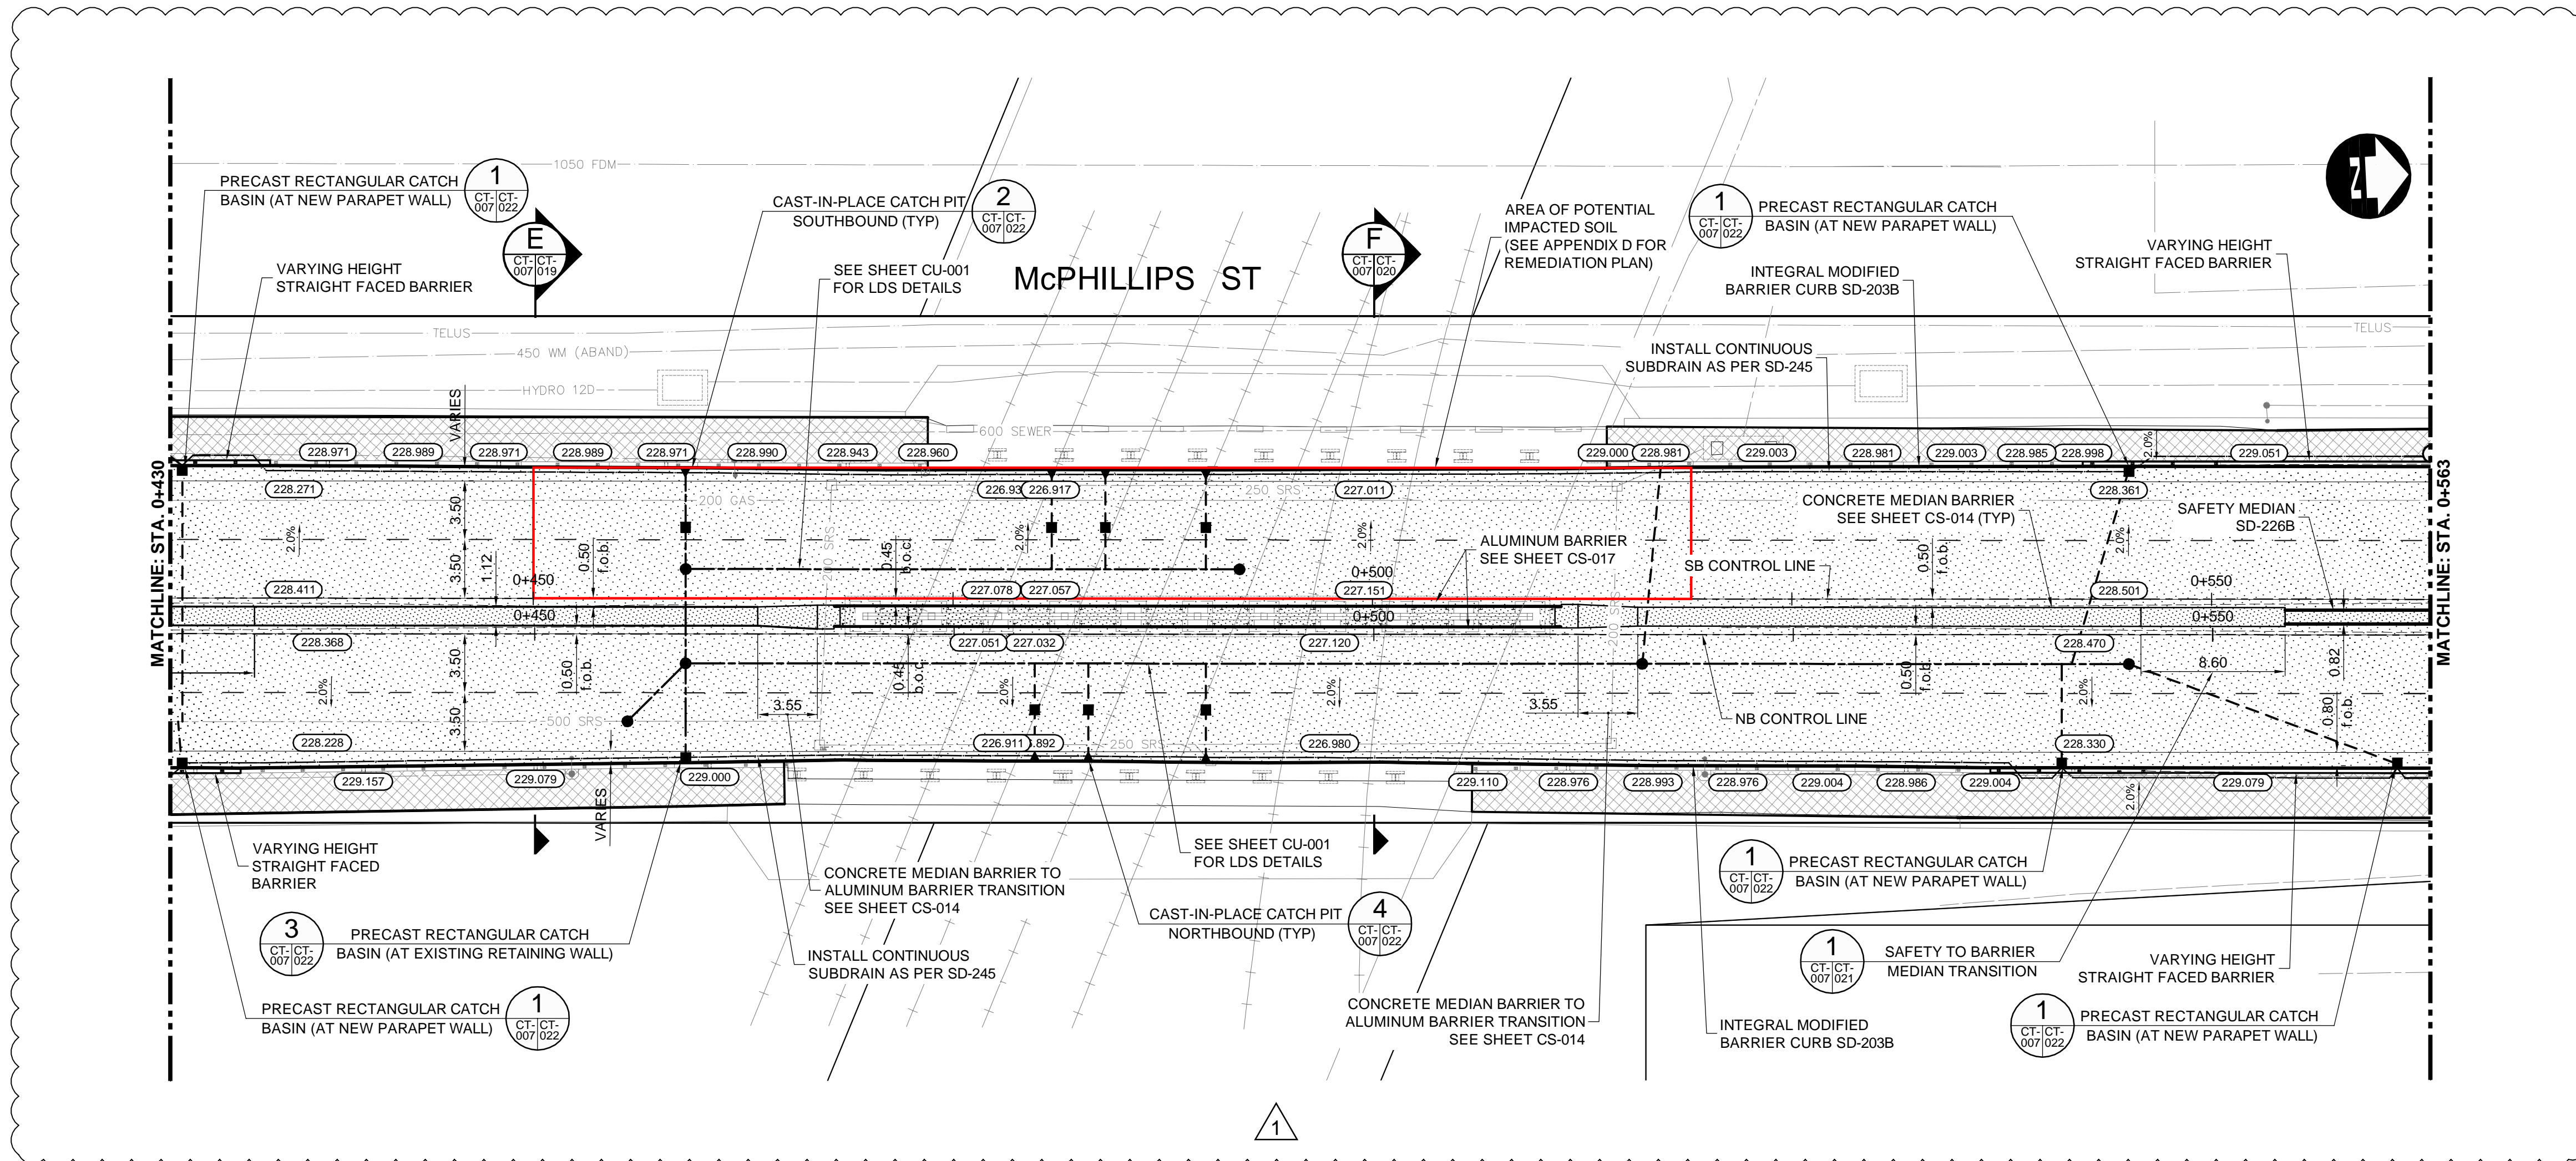

G:\CAD\176152\Drawings\Roadworks\Contract\176152-CON-CT-PLAN-PROFILE.dwg

150 WM	WATERMAIN	150 WM	CONCRETE	150 WM	WATERMAIN	150 WM	WATERMAIN
300 LDS	HYDRANT	300 LDS	ASPHALT	300 LDS	LAND DRAINAGE SEWER	300 LDS	LAND DRAINAGE SEWER
250 WWS	VALVE	250 WWS	PLANING	250 WWS	WASTE WATER SEWER	250 WWS	WASTE WATER SEWER
MANHOLE	MANHOLE	MANHOLE	SIDEWALK	HYDRANT	HYDRANT	HYDRANT	HYDRANT
CATCH BASIN	CATCH BASIN	CATCH BASIN	PAVING STONES	VALVE	VALVE	VALVE	VALVE
CURB INLET	CURB INLET	CURB INLET	STRUCTURAL SIDEWALK	PROFILE	PROFILE	PROFILE	PROFILE
300 LDS	LAND DRAINAGE SEWER	300 LDS	PROPERTY LINE	NORTH/WEST GUTTER	NORTH/WEST GUTTER	NORTH/WEST GUTTER	NORTH/WEST GUTTER
250 WWS	WASTE WATER SEWER	250 WWS	DRAINAGE ARROW	SOUTH/EAST GUTTER	SOUTH/EAST GUTTER	SOUTH/EAST GUTTER	SOUTH/EAST GUTTER
HYDRO	HYDRO	HYDRO	CURB RAMP (SD-229C)	NORTH/WEST DITCH	NORTH/WEST DITCH	NORTH/WEST DITCH	NORTH/WEST DITCH
MTS	M.T.S.	MTS	DETECTABLE WARNING SURFACE TILE (SD-229AA)	SOUTH/EAST DITCH	SOUTH/EAST DITCH	SOUTH/EAST DITCH	SOUTH/EAST DITCH
100 GAS	GAS	100 GAS					
EXISTING	LEGEND-PLAN	PROPOSED	EXISTING	LEGEND-PLAN	PROPOSED	EXISTING	LEGEND-PROFILE

UNDERGROUND STRUCTURES

SUPV. U/G STRUCTURES DATE

LOCATION OF UNDERGROUND STRUCTURES AS SHOWN ARE BASED ON THE BEST INFORMATION AVAILABLE, BUT NO GUARANTEE IS GIVEN THAT ALL EXISTING UTILITIES ARE SHOWN OR THAT THE GIVEN LOCATIONS ARE EXACT. CONFIRMATION OF EXISTENCE AND EXACT LOCATION OF ALL SERVICES MUST BE OBTAINED FROM THE INDIVIDUAL UTILITIES BEFORE PROCEEDING WITH CONSTRUCTION.

B.M. ELEV.					
1	ISSUED FOR ADDENDUM 1	18/03/26	TJP		
0	ISSUED FOR TENDER	18/03/16	TJP		
NO.	REVISIONS	DATE	BY	DATE	

DESIGNED BY	RTP
DRAWN BY	TJH
CHECKED BY	TS
APPROVED BY	TJP
HOR. SCALE	1:250
VERTICAL	1:10

DILLON CONSULTING

RELEASED FOR CONSTRUCTION

DATE

ENGINEER'S SEAL

PROVINCE OF MANITOBA

T.J. PETERS

18/03/16

Member 22309

REGISTERED PROFESSIONAL ENGINEER

CONSULTANT PROJECT NUMBER

17-6152

THE CITY OF WINNIPEG
PUBLIC WORKS DEPARTMENT

2018 REGIONAL STREET RENEWAL PROJECT
McPHILLIPS STREET RECONSTRUCTION AND UNDERPASS
STRUCTURAL IMPROVEMENTS
LOGAN AVENUE TO JARVIS AVENUE

CITY DRAWING NUMBER
P-3492-2018-CT-007

SHEET 007 OF 022

CONSULTANT DRAWING NUMBER
CT-007

McPHILLIPS STREET - STA. 0+430 TO 0+563 (PLAN)