



NOTE:
 1. EXISTING 150Ø PERFORATED SA PIPE TO BE REPLACED WITH SCH80 PVC PIPE. DISCHARGE INTO SBR INLET. SEE DRAWING D-1002.

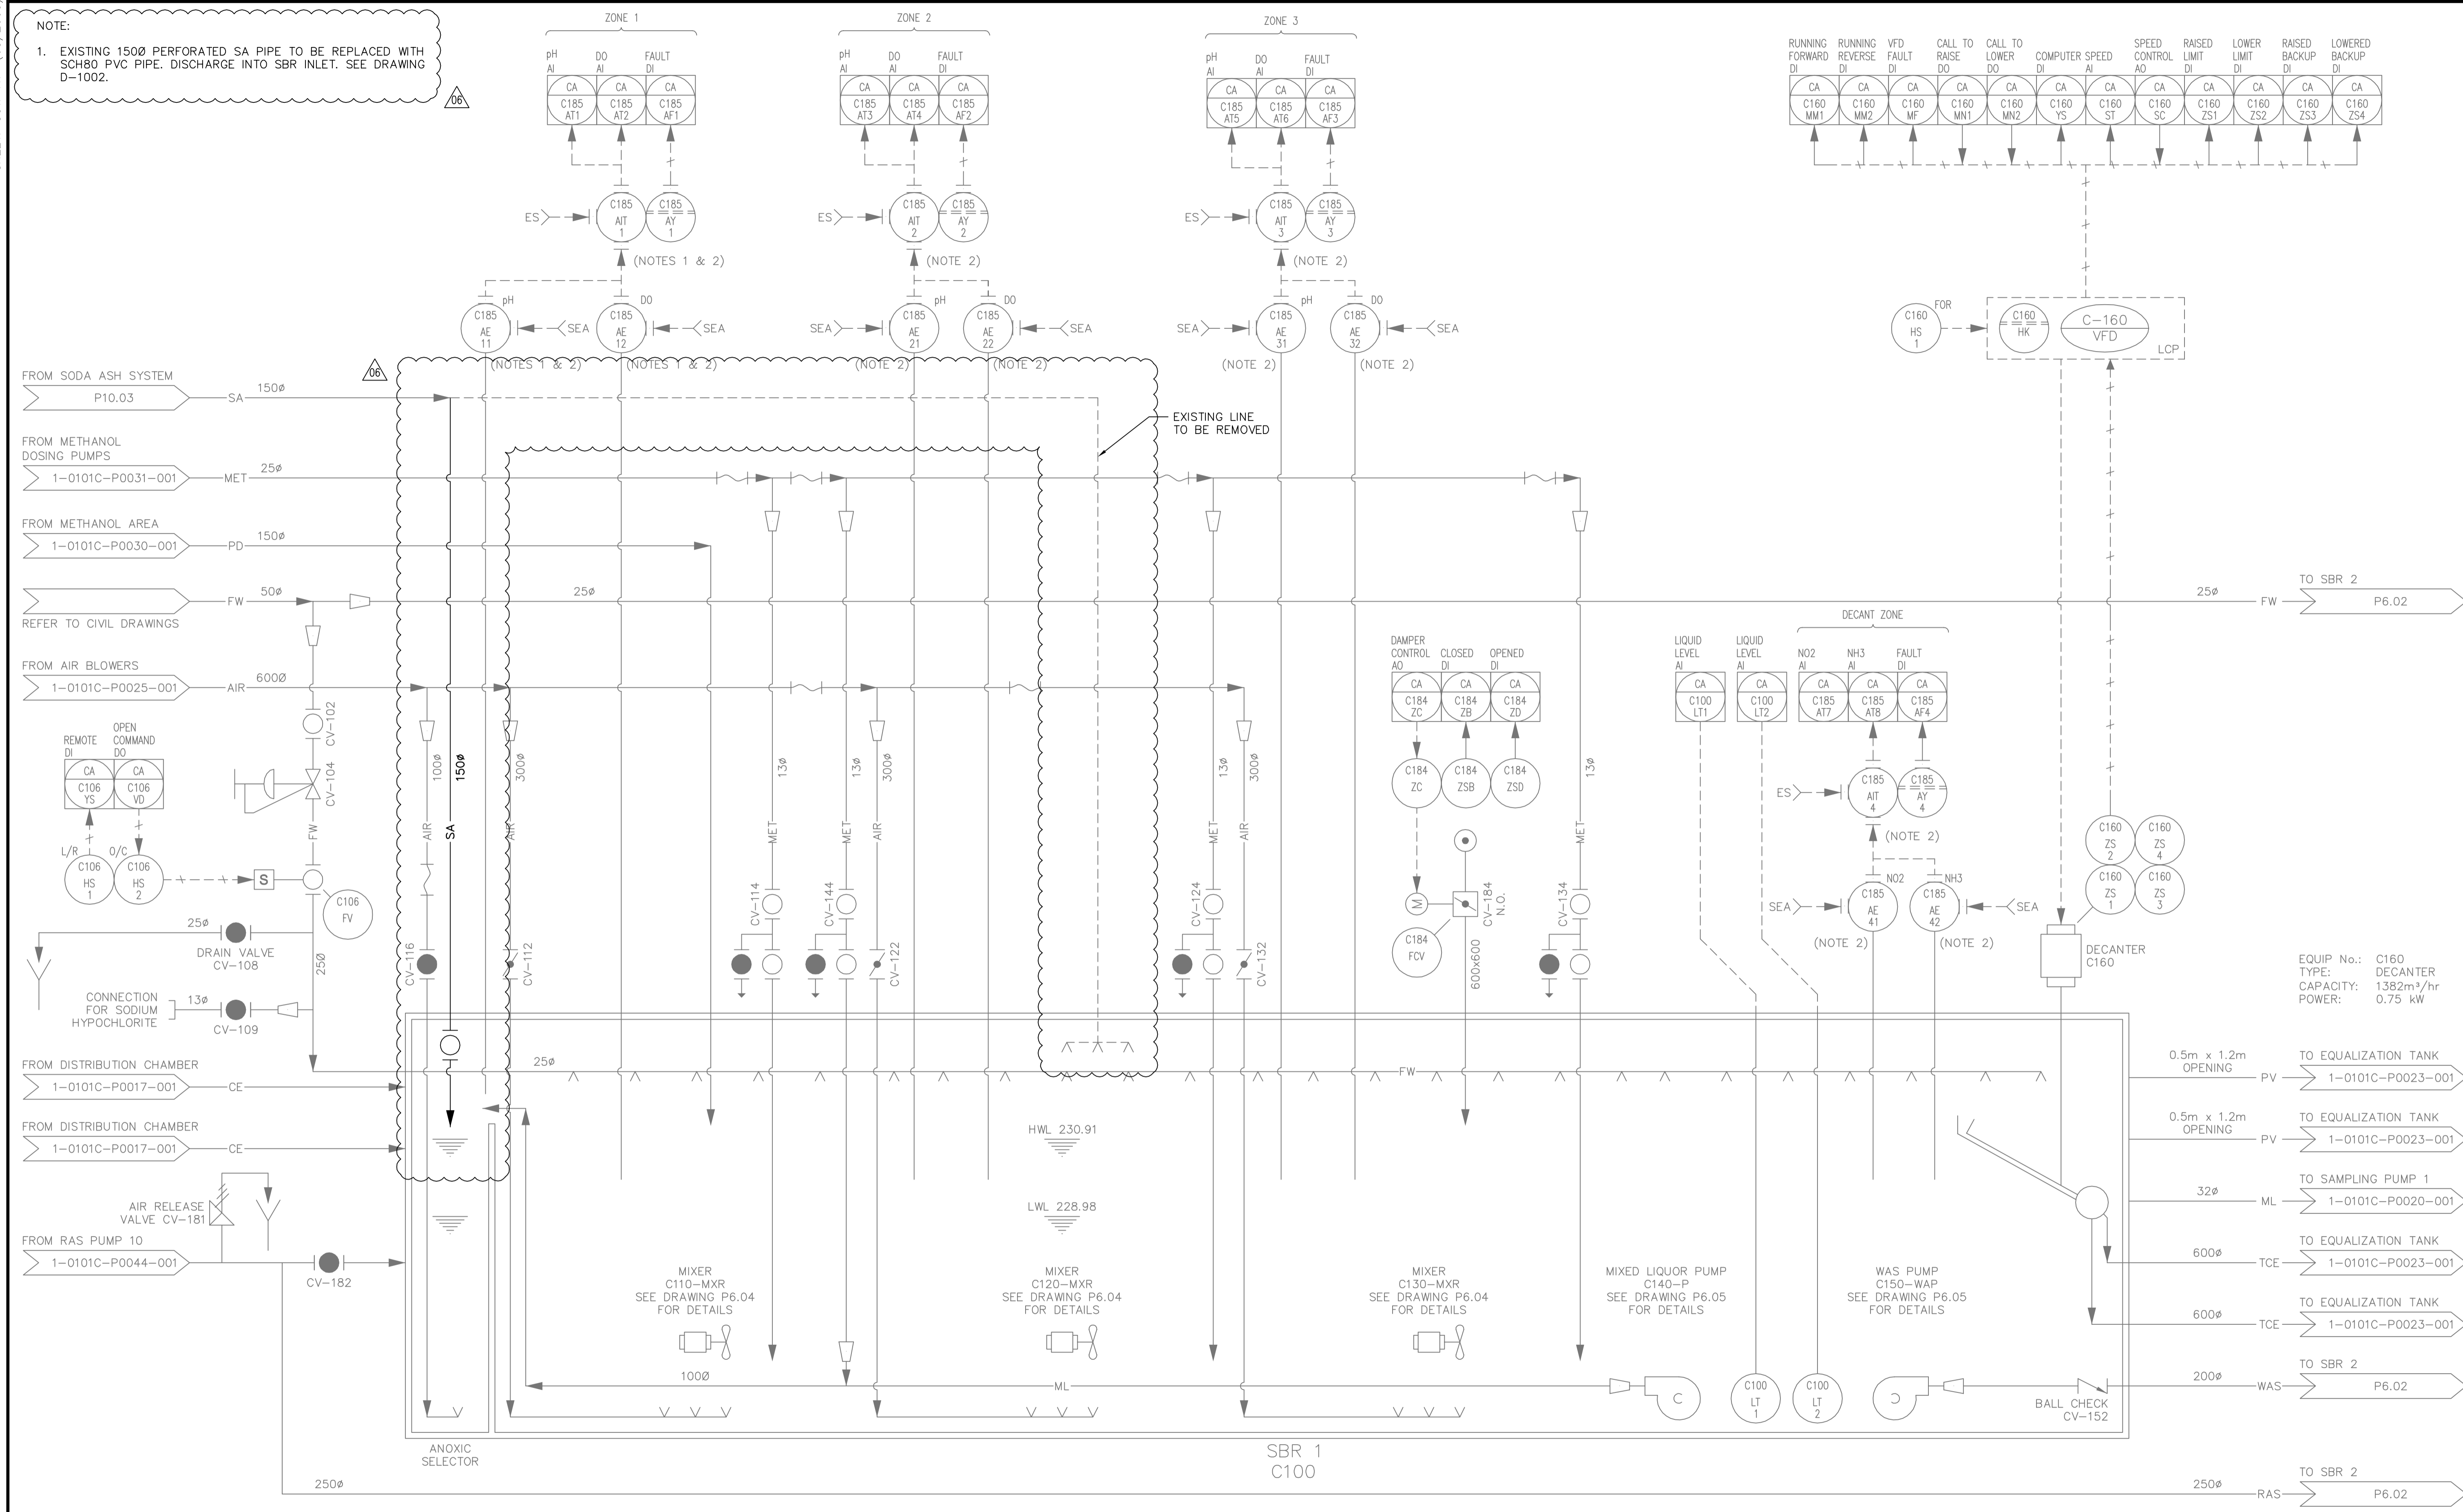

EQUIP No.: C160
 TYPE: DECANTER
 CAPACITY: 1382m³/hr
 POWER: 0.75 kW

NOTICE:
 AS-CONSTRUCTED DIMENSIONS, MEASUREMENTS AND OTHER DETAILS CONTAINED IN THIS RECORD DRAWING HAVE BEEN OBTAINED BY AECOM CANADA LTD. ("AECOM") FROM VARIOUS SOURCES. SUCH INFORMATION REPRESENTS THE BEST INFORMATION AVAILABLE TO AECOM AT THE TIME OF PREPARATION OF THIS RECORD DRAWING. AECOM DOES NOT IN ANY WAY REPRESENT OR WARRANT THAT SUCH INFORMATION IS ACCURATE AND ASSUMES NO RESPONSIBILITY FOR ANY ERRORS OR OMISSIONS CONTAINED THEREIN.

REVISION 06 CHANGES THE ENGINEER'S DESIGN RESPONSIBILITIES ARE LIMITED TO THE CHANGES INDICATED IN THE CLOUDED WORK	
DESIGNED BY: NK	CHECKED BY: KJS
DRAWN BY: ES	APPROVED BY: KJS
DATE: 18/04/12	RELEASED FOR CONSTR. DATE: 18/04/12

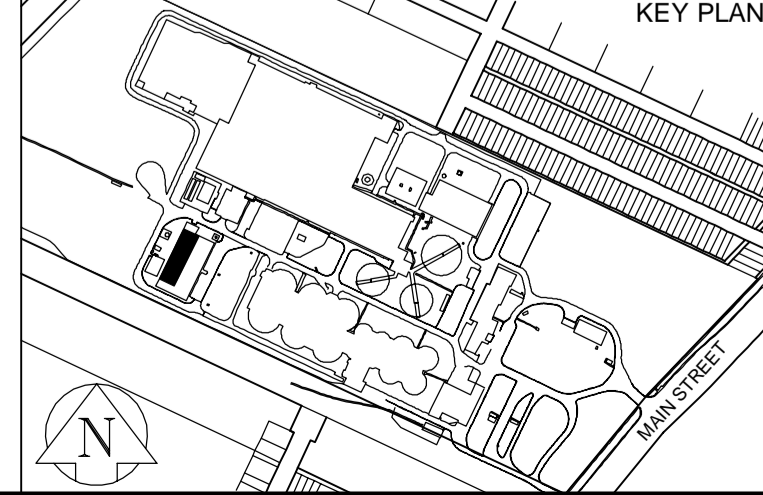

NO.	REVISIONS	DATE	BY
06	ISSUED FOR TENDER: BID OP 281-2018	18/04/12	ES
05	ISSUED FOR CONSTRUCTION: 16/10/06	16/10/06	SE
04	ISSUED FOR TENDER: BID OP 547-2016	16/06/23	SRG
03	AS-CONSTRUCTED DRAWING	09/02/19	DEP
02	ISSUED FOR DCS PROGRAMMING	07/12/17	GLG
01	ISSUED FOR CONSTRUCTION	06/08/30	GLG
00	ISSUED FOR TENDER	06/05/15	SRP

AECOM

DESIGNED BY: YL/CD
 CHECKED BY: SB/PS
 DRAWN BY: SRP
 APPROVED BY: [Signature]
 SCALE: NONE
 RELEASED FOR CONSTRUCTION BY: [Signature]
 DATE: 2006/01/16

ENGINEER'S SEAL
 CONSULTANT DRAWING NO. P6.01

THE CITY OF WINNIPEG
 WATER AND WASTE DEPARTMENT
 ENGINEERING DIVISION

NEWPC CENTRATE NUTRIENT TREATMENT NITROGEN REMOVAL FACILITY

PROCESS SBR 1
 PROCESS & INSTRUMENTATION DIAGRAM

CITY FILE NUMBER: [Blank]
 SHEET 4 OF 5
 CITY DRAWING NUMBER: 1-0101C-P0018-001-06