

HEATED SHELTER AND LARGE CANOPY
 N.T.S.


REFER TO SHOP DRAWINGS SUPPLIED BY ENSEICOM FOR ALL CANOPIES, SHELTERS, KIOSKS, AND SIGNS.

REFER TO ELECTRICAL DRAWINGS FOR ALL WIRING CONNECTIONS TO ALL SIGNS, CANOPIES AND STRUCTURES.


ALL DIMENSIONS PROVIDED FOR INFORMATION ON DESIGN EXTENT.

LOCATION UNDERGROUND	APPROVED STRUCTURES	B.M. ELEV.	B.M. ELEV.	DESIGNED BY	SR/JW		LANDSCAPE ARCHITECT'S SEAL THE CITY OF WINNIPEG TRANSIT DEPARTMENT SOUTHWEST RAPID TRANSIT CORRIDOR - STAGE 1 STATION CONSTRUCTION, WARSAW RECONSTRUCTION & ASSOCIATED WORKS HEATED SHELTER & LARGE CANOPY DETAILS 20/04/11 CONSULTANT PROJECT NO. 08-028
SUPV. U/C STRUCTURES COMMITTEE	DATE			DRAWN BY	JW/MH		
				CHECKED BY	JW/SR		
				APPROVED BY			
NOTE:							
LOCATION OF UNDERGROUND STRUCTURES AS SHOWN ARE BASED ON THE BEST INFORMATION AVAILABLE, BUT NO GUARANTEE IS GIVEN THAT ALL EXISTING UTILITIES ARE SHOWN OR THAT THE GIVEN LOCATIONS ARE EXACT. CONFIRMATION OF EXISTENCE AND EXACT LOCATION OF ALL SERVICES MUST BE OBTAINED FROM THE INDIVIDUAL UTILITIES BEFORE PROCEEDING WITH CONSTRUCTION.							
NO. REVISIONS		DATE	BY	HOR. SCALE		RELEASED FOR CONSTRUCTION ORIGINAL SIGNED BY BARRY FINCAS	
2		20/08/12	JW	VERTICAL			
1		20/04/11	JW				
				DATE	2011-04-20		


K:\08-028 Southwest BRT Consider\Draw\07 - Stations\Record drawings 2012-08-10\07-L-5008-5007-5008-RECORD-2013-03-15-awilkins.dwg

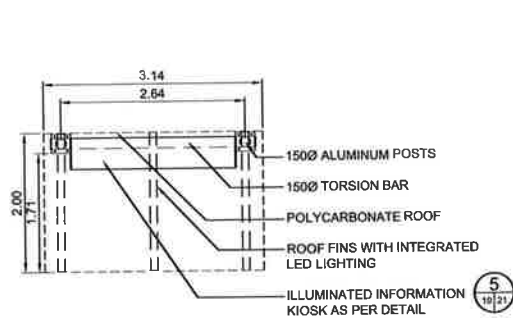


PLAN
SINGLE BAY LOW CANOPY WITH INFORMATION KIOSK
N.T.S.

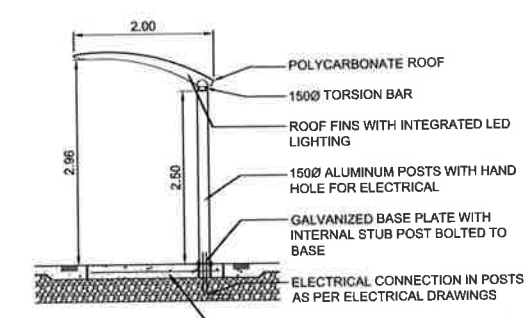


SECTION

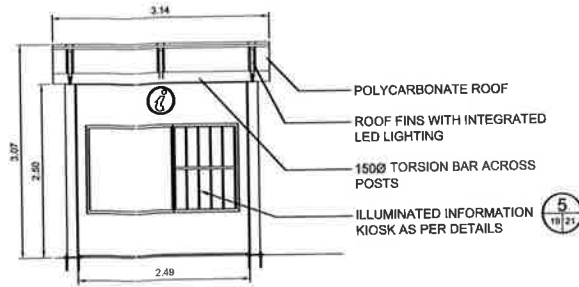


ELEVATION

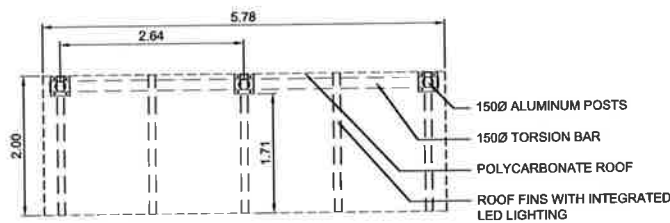


PLAN
SURFACE MOUNT LOW CANOPY
N.T.S.

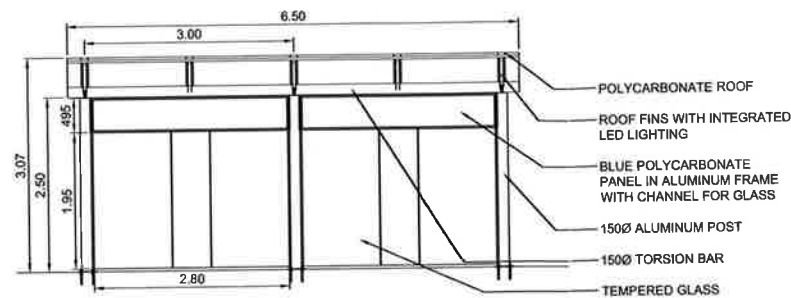


ELEVATION

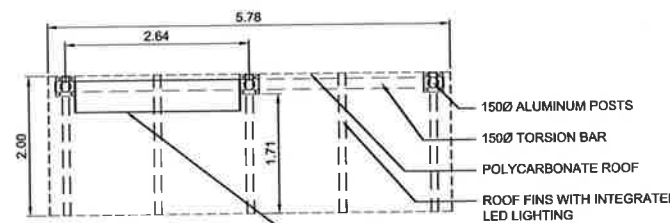


PLAN
WALL MOUNTED LOW CANOPY WITH INFORMATION KIOSK
N.T.S.

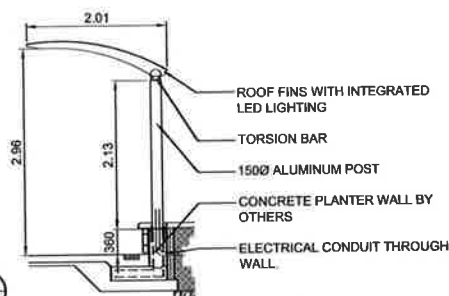


SECTION

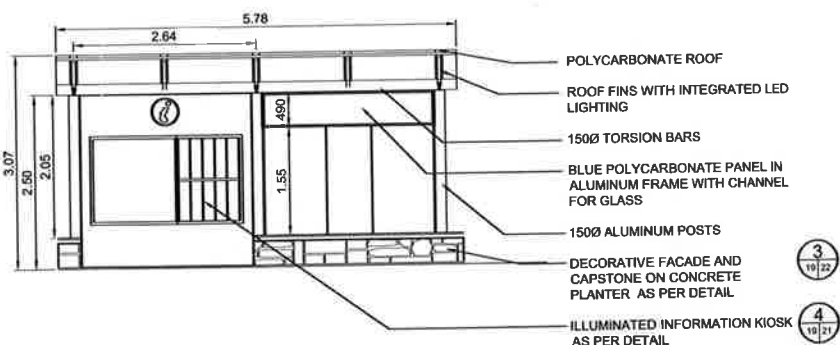

ELEVATION

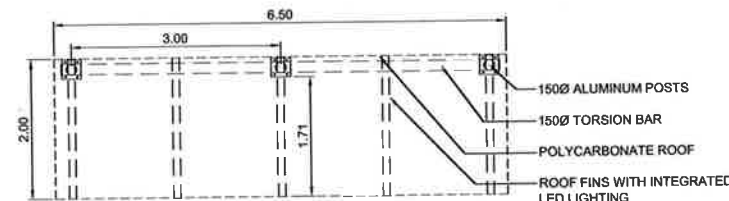

PLAN
WALL MOUNTED LOW CANOPY
N.T.S.

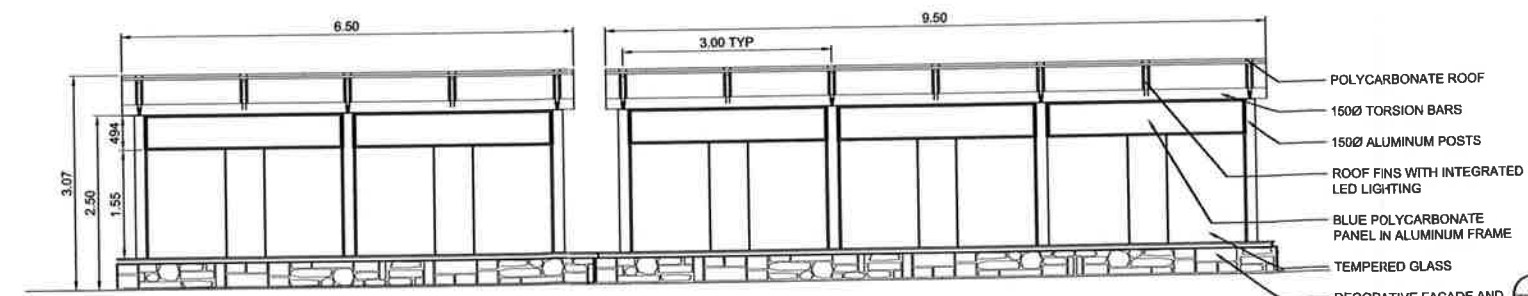

2 BAY CANOPY

3 BAY CANOPY

RECORD DRAWING
ORIGINAL SIGNED BY: JACKIE WILKIE
APPROVED BY: _____
DATE: AUG 23, 2012

REFER TO SHOP DRAWINGS SUPPLIED BY ENSEICOM FOR ALL CANOPIES, SHELTERS, KIOSKS, AND SIGNS.

REFER TO ELECTRICAL DRAWINGS FOR ALL WIRING CONNECTIONS TO ALL SIGNS, CANOPIES AND STRUCTURES.

ALL DIMENSIONS PROVIDED FOR INFORMATION ON DESIGN EXTENT.

LOCATION UNDERGROUND	APPROVED STRUCTURES	B.M. ELEV.	BM ELEV	DESIGNED BY	SR/JW	
SUPV. U/G STRUCTURES COMMITTEE	DATE			DRAWN BY	JWMH	
				CHECKED BY	JW/SR	
				APPROVED BY		
NOTE: LOCATION OF UNDERGROUND STRUCTURES AS SHOWN ARE BASED ON THE BEST INFORMATION AVAILABLE, BUT NO GUARANTEE IS GIVEN THAT ALL EXISTING UTILITIES ARE SHOWN OR THAT THE GIVEN LOCATIONS ARE EXACT. CONFIRMATION OF EXISTENCE AND EXACT LOCATION OF ALL SERVICES MUST BE OBTAINED FROM THE INDIVIDUAL UTILITIES BEFORE PROCEEDING WITH CONSTRUCTION.		2	ISSUED FOR RECORD DRAWING	03/08/12	TM	HOR. SCALE
	1	ISSUED FOR TENDER	02/04/11	JW	VERTICAL	
NO. REVISIONS			DATE	BY	DATE	
					2011-04-20	

LANDSCAPE ARCHITECT'S SEAL

ORIGINALLY SIGNED BY
JACKIE WILKIE
20/04/11

CONSULTANT PROJECT NO.
08-028

RELEASED FOR CONSTRUCTION ORIGINAL SIGNED BY SANDY DINGAS
DATE: APRIL 20, 2011

THE CITY OF WINNIPEG
TRANSIT DEPARTMENT

SOUTHWEST RAPID TRANSIT CORRIDOR - STAGE 1
STATION CONSTRUCTION, WARSAW
RECONSTRUCTION & ASSOCIATED WORKS


LOW CANOPIES

CITY DRAWING NUMBER
P-3325-19


SHEET 19 OF 28

CONSULTANT DRAWING NUMBER
C7-L-5008


X:\08-028_Southwest_rtr_Corridor\eng\c7 - Stations\record drawings 2012-08-10\c7-L-5008-007-008-RECORD-2012-03-03-15-11-11-11.dwg

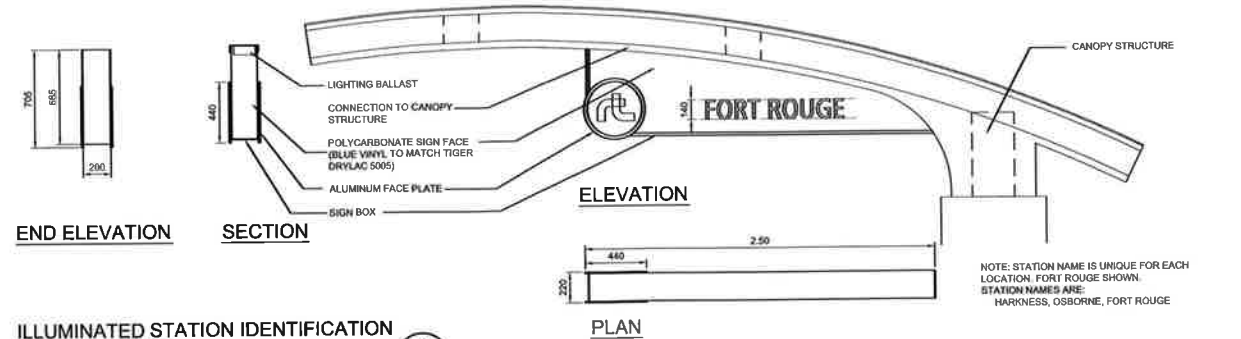


ILLUMINATED STATION IDENTIFICATION SIGN ON LARGE CANOPY
N.T.S. 12/14/18 21

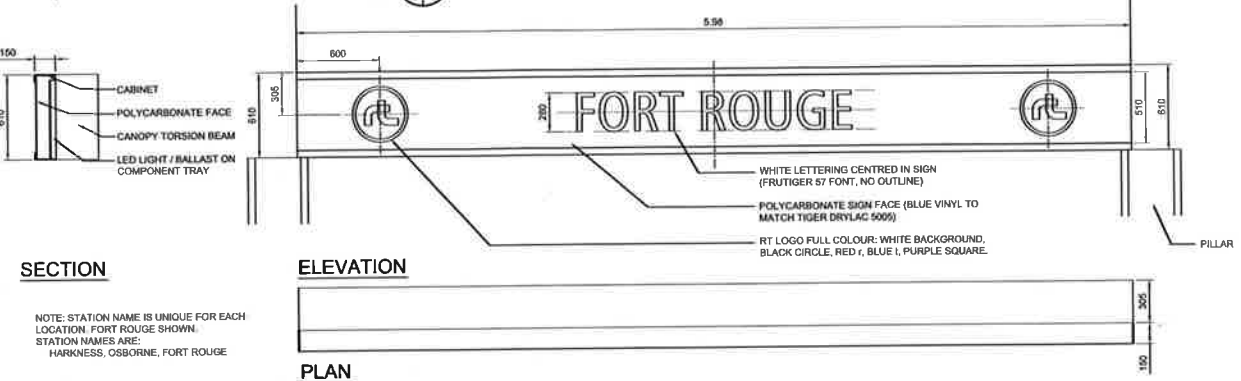


ILLUMINATED SIGN BETWEEN PILLARS ON LARGE CANOPY
N.T.S. 17/18 21

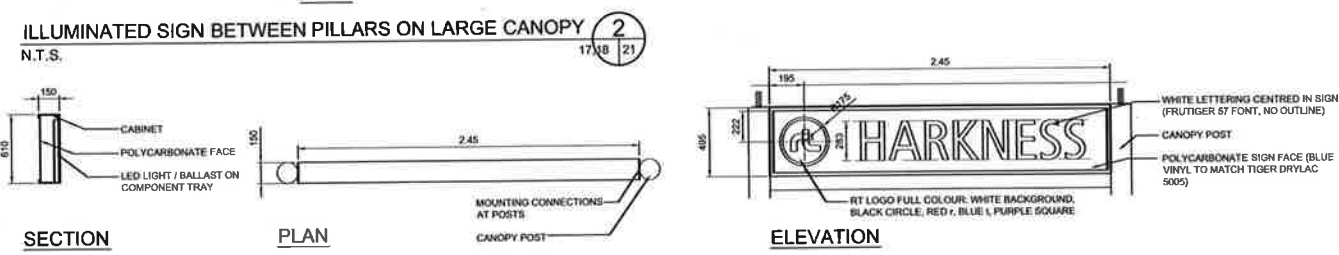


ILLUMINATED SIGN ON NORTHBOUND HARKNESS CANOPY
N.T.S. 12/21 21

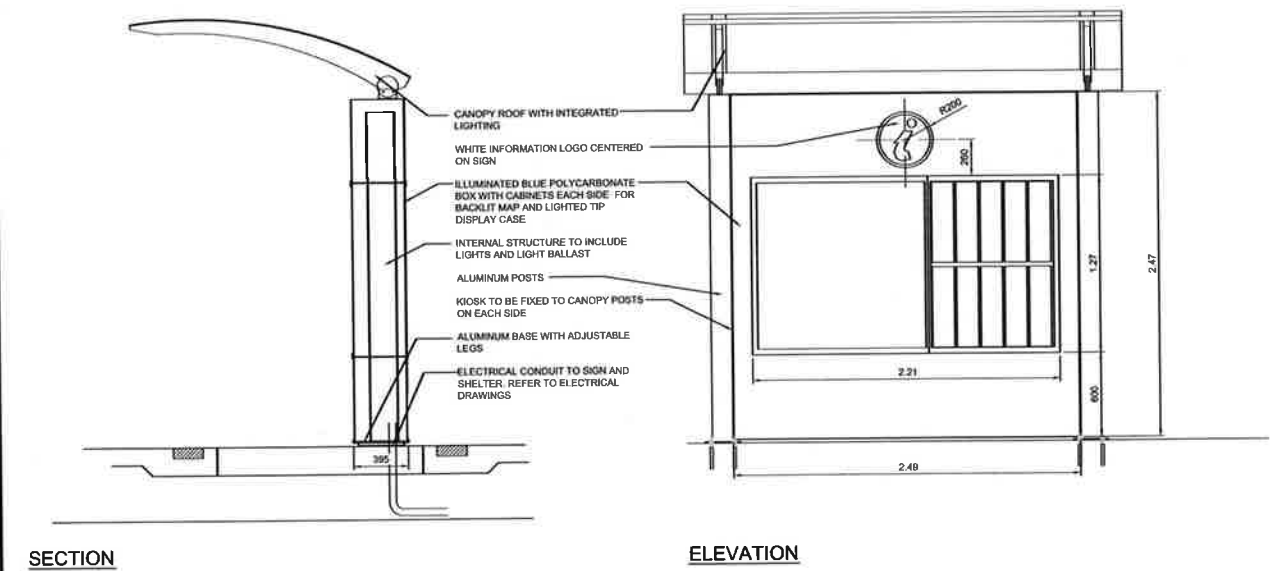

INFORMATION KIOSK AT FORT ROUGE STATION
N.T.S. 19/21 21

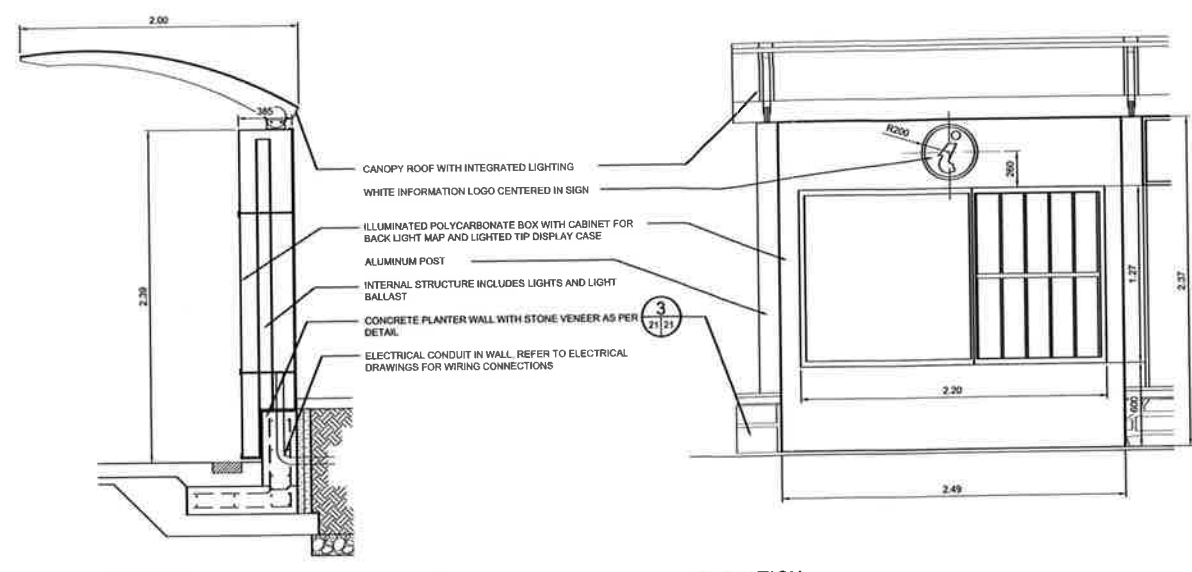

INFORMATION KIOSK AT SOUTHBOUND HARKNESS STATION
N.T.S. 19/21 21

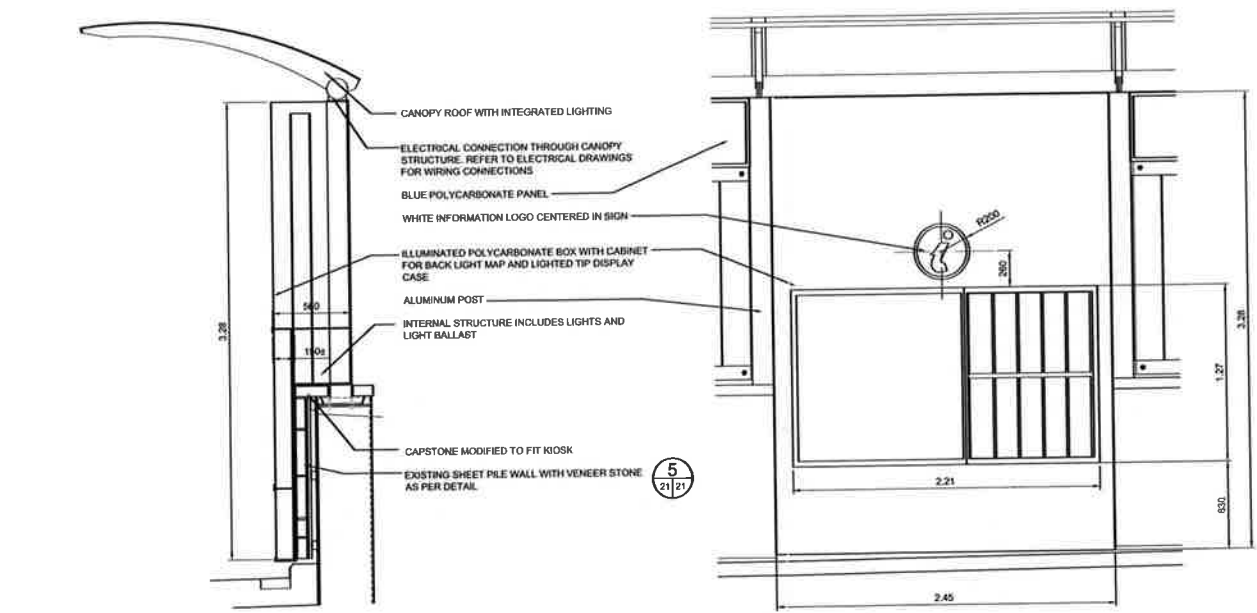

INFORMATION KIOSK AT NORTHBOUND HARKNESS STATION
N.T.S. 12/17 21

REFER TO ELECTRICAL DRAWINGS FOR ALL WIRING CONNECTIONS TO ALL SIGNS, CANOPIES AND STRUCTURES.

REFER TO SHOP DRAWINGS SUPPLIED BY ENSEICOM FOR ALL CANOPIES, SHELTERS, KIOSKS, AND SIGNS.

ALL DIMENSIONS PROVIDED FOR INFORMATION ON DESIGN EXTENT.

RECORD DRAWING
ORIGINAL SIGNED BY: JACKIE WILKIE
APPROVED BY: DATE: AUG 10, 2012

LOCATION UNDERGROUND	APPROVED STRUCTURES	B.M. ELEV.	BM ELEV.	DESIGNED BY	SR/JW	LANDSCAPE ARCHITECT'S SEAL
SUPV. U/C STRUCTURES	DATE			DRAWN BY	PB	
NOTE: LOCATION OF UNDERGROUND STRUCTURES AS SHOWN ARE BASED ON THE BEST INFORMATION AVAILABLE. BUT NO GUARANTEE IS GIVEN THAT ALL EXISTING UTILITIES ARE SHOWN OR THAT THE GIVEN LOCATIONS ARE EXACT. CONFIRMATION OF EXISTENCE AND EXACT LOCATION OF ALL SERVICES MUST BE OBTAINED FROM THE INDIVIDUAL UTILITIES BEFORE PROCEEDING WITH CONSTRUCTION.				CHECKED BY	JW/SR	
				APPROVED BY		
				HOR. SCALE		
				VERTICAL		<p>RELEASED FOR CONSTRUCTION ORIGINAL SIGNED BY: RANNEY FINCAS</p> <p>DATE: APRIL 20, 2011</p>
				NO. REVISIONS	DATE BY	<p>CONSULTANT PROJECT NO. 08-028</p>

THE CITY OF WINNIPEG TRANSIT DEPARTMENT

Winnipeg






SOUTHWEST RAPID TRANSIT CORRIDOR - STAGE 1
STATION CONSTRUCTION, WARSAW RECONSTRUCTION, & ASSOCIATED WORKS

CITY DRAWING NUMBER: P-3325 - 21
SHEET 21 OF 28
CONSULTANT DRAWING NUMBER: C7-L-5010

ORIGINALLY SIGNED BY: JACKIE WILKIE
DATE: 20/04/11

X:\08-028 Southwestern BRT Corridor\Sign\CT - Station\wood drawings\2012-08-10\CT-L-5009-5010-REC010-2013-03-15-signage.dwg

X:\08-228 Southwestern BRT Corridor\eng\07 - Stations\record drawings\2012-08-10\07-L-5009-3010-REC000-2013-03-19-19-wipnrg.dwg

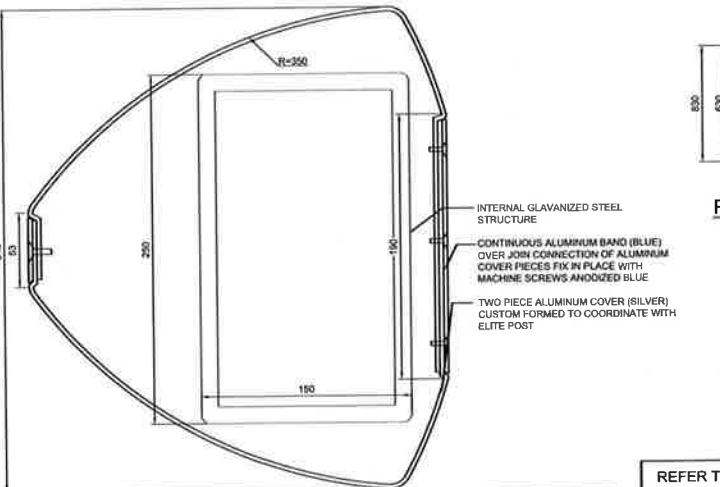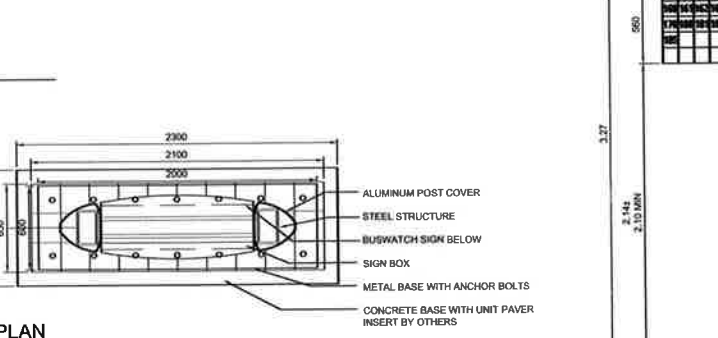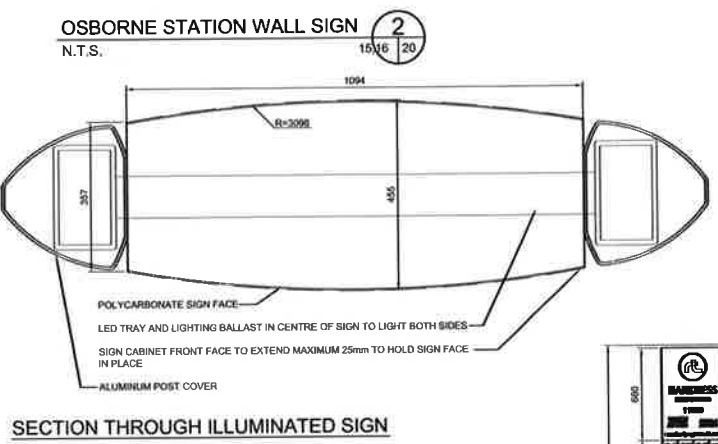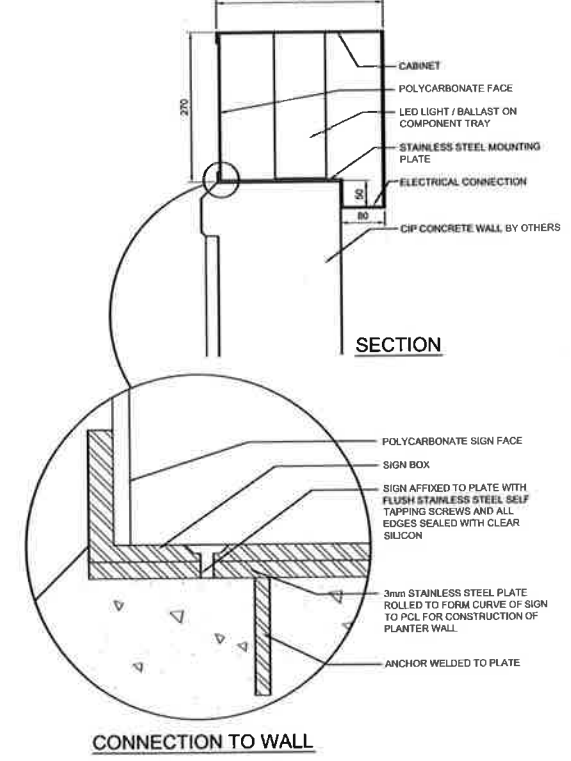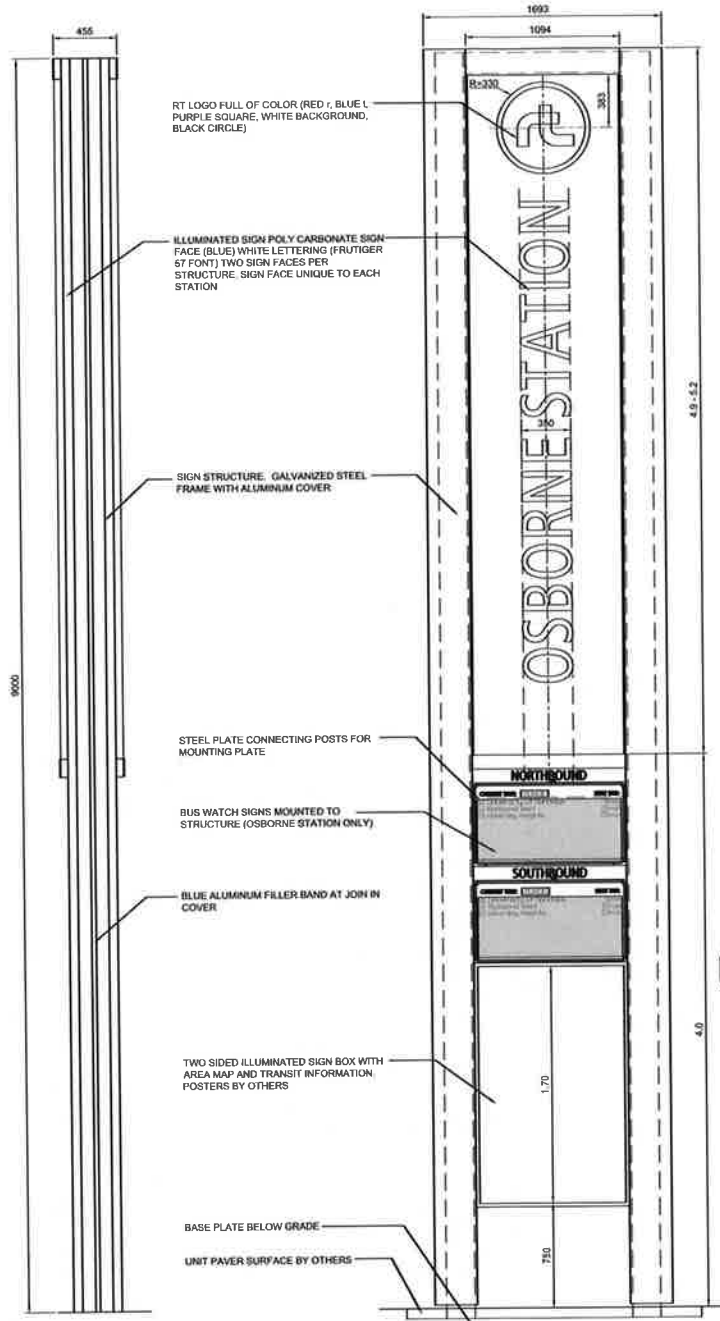


POST ENLARGEMENT
PYLON SIGN
N.T.S.
12.14/15 20


ALL DIMENSIONS PROVIDED FOR INFORMATION ON DESIGN EXTENT.

REFER TO SHOP DRAWINGS SUPPLIED BY ENSEICOM FOR ALL CANOPIES, SHELTERS, KIOSKS, AND SIGNS.

REFER TO ELECTRICAL DRAWINGS FOR ALL WIRING CONNECTIONS TO ALL SIGNS, CANOPIES AND STRUCTURES.

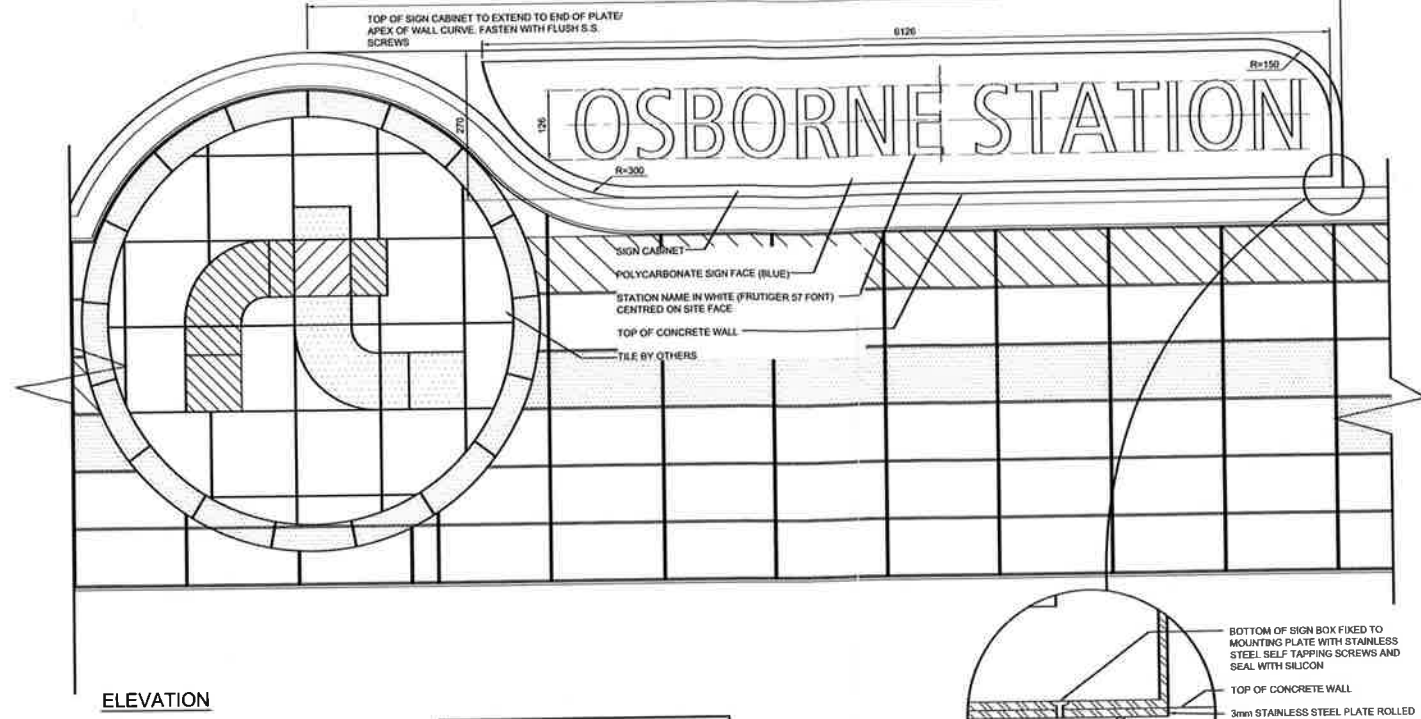


RECORD DRAWING
ORIGINAL SIGNED BY: JACKIE WILKIE
APPROVED BY: DATE: AUG 10, 2012

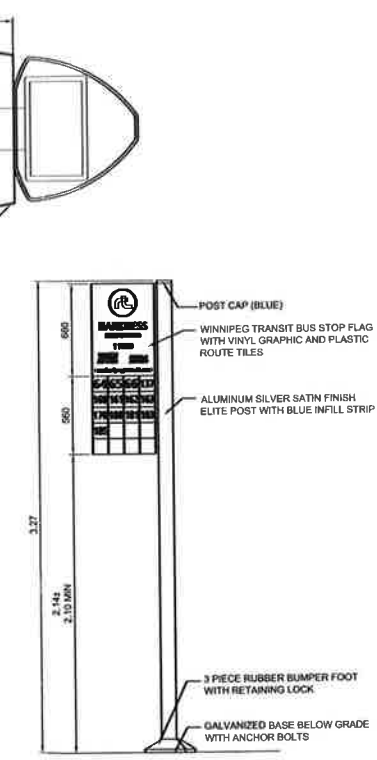

FLAG ON STANDARD HEIGHT POST
BUS STOP FLAGS
N.T.S.
12.14/17 20



FLAG ON BUSWAY

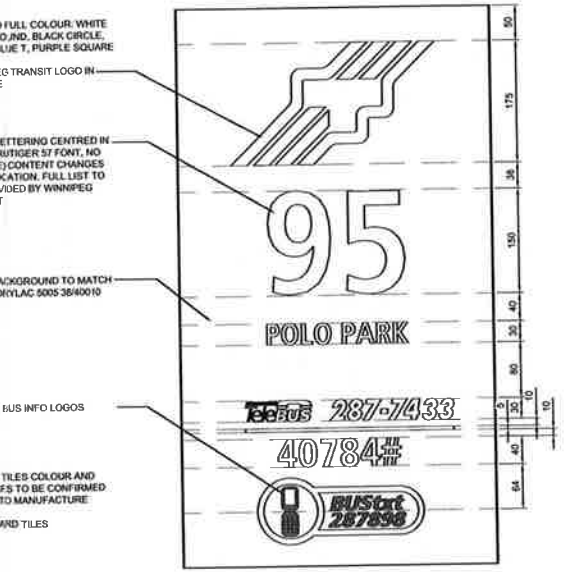

FLAG AT BUS LOOP

NO.	REVISIONS	DATE	BY
2	ISSUED FOR RECORD DRAWING	10/08/12	JM
1	ISSUED FOR TENDER	20/04/11	JW

DESIGNED BY: SR/JW		LANDSCAPE ARCHITECT'S SEAL THE CITY OF WINNIPEG TRANSIT DEPARTMENT
DRAWN BY: PB		
CHECKED BY: JWSR		ORIGINALLY SIGNED BY: JACKIE WILKIE 20/04/11
APPROVED BY:	RELEASED FOR CONSTRUCTION ORIGINAL SIGNED BY: HANZI ENGAS DATE: APRIL 20, 2011	CONSULTANT PROJECT NO.: 08-028
LOCATION UNDERGROUND STRUCTURES SUPV. U/C STRUCTURES COMMITTEE: DATE:		SOUTHWEST RAPID TRANSIT CORRIDOR - STAGE 1 STATION CONSTRUCTION, WARSAW RECONSTRUCTION, & ASSOCIATED WORKS
NOTE: LOCATION OF UNDERGROUND STRUCTURES AS SHOWN ARE BASED ON THE BEST INFORMATION AVAILABLE. ONLY NO GUARANTEE IS GIVEN THAT ALL EXISTING UTILITIES ARE SHOWN OR THAT THE GIVEN LOCATIONS ARE EXACT. CONFIRMATION OF EXISTENCE AND EXACT LOCATION OF ALL UTILITIES MUST BE OBTAINED FROM THE RELEVANT UTILITIES BEFORE PROCEEDING WITH CONSTRUCTION.		CITY DRAWING NUMBER: P-3325 - 20 SHEET OF 28 CONSULTANT DRAWING NUMBER: C7-L-5009

1
12.14/15 20