



BILL OF MATERIALS

QTY	MARK	DESCRIPTION	LENGTH	WEIGHT	REMARKS
ONE	026	HANDRAIL	9'-5 1/4"	-	-
ONE	a	1 1/2"Ø STD. PIPE	24-11" LINEAL	-	A53 GRADE B
26	b	1/2" Ø BAR	2'-1"	-	-
ONE	P029	PL 1/4x2 1/2"	0'-8"	-	-
		FIELD BOLTS			
2		1/2"Ø A316 SS	0'-1 1/2"	-	-

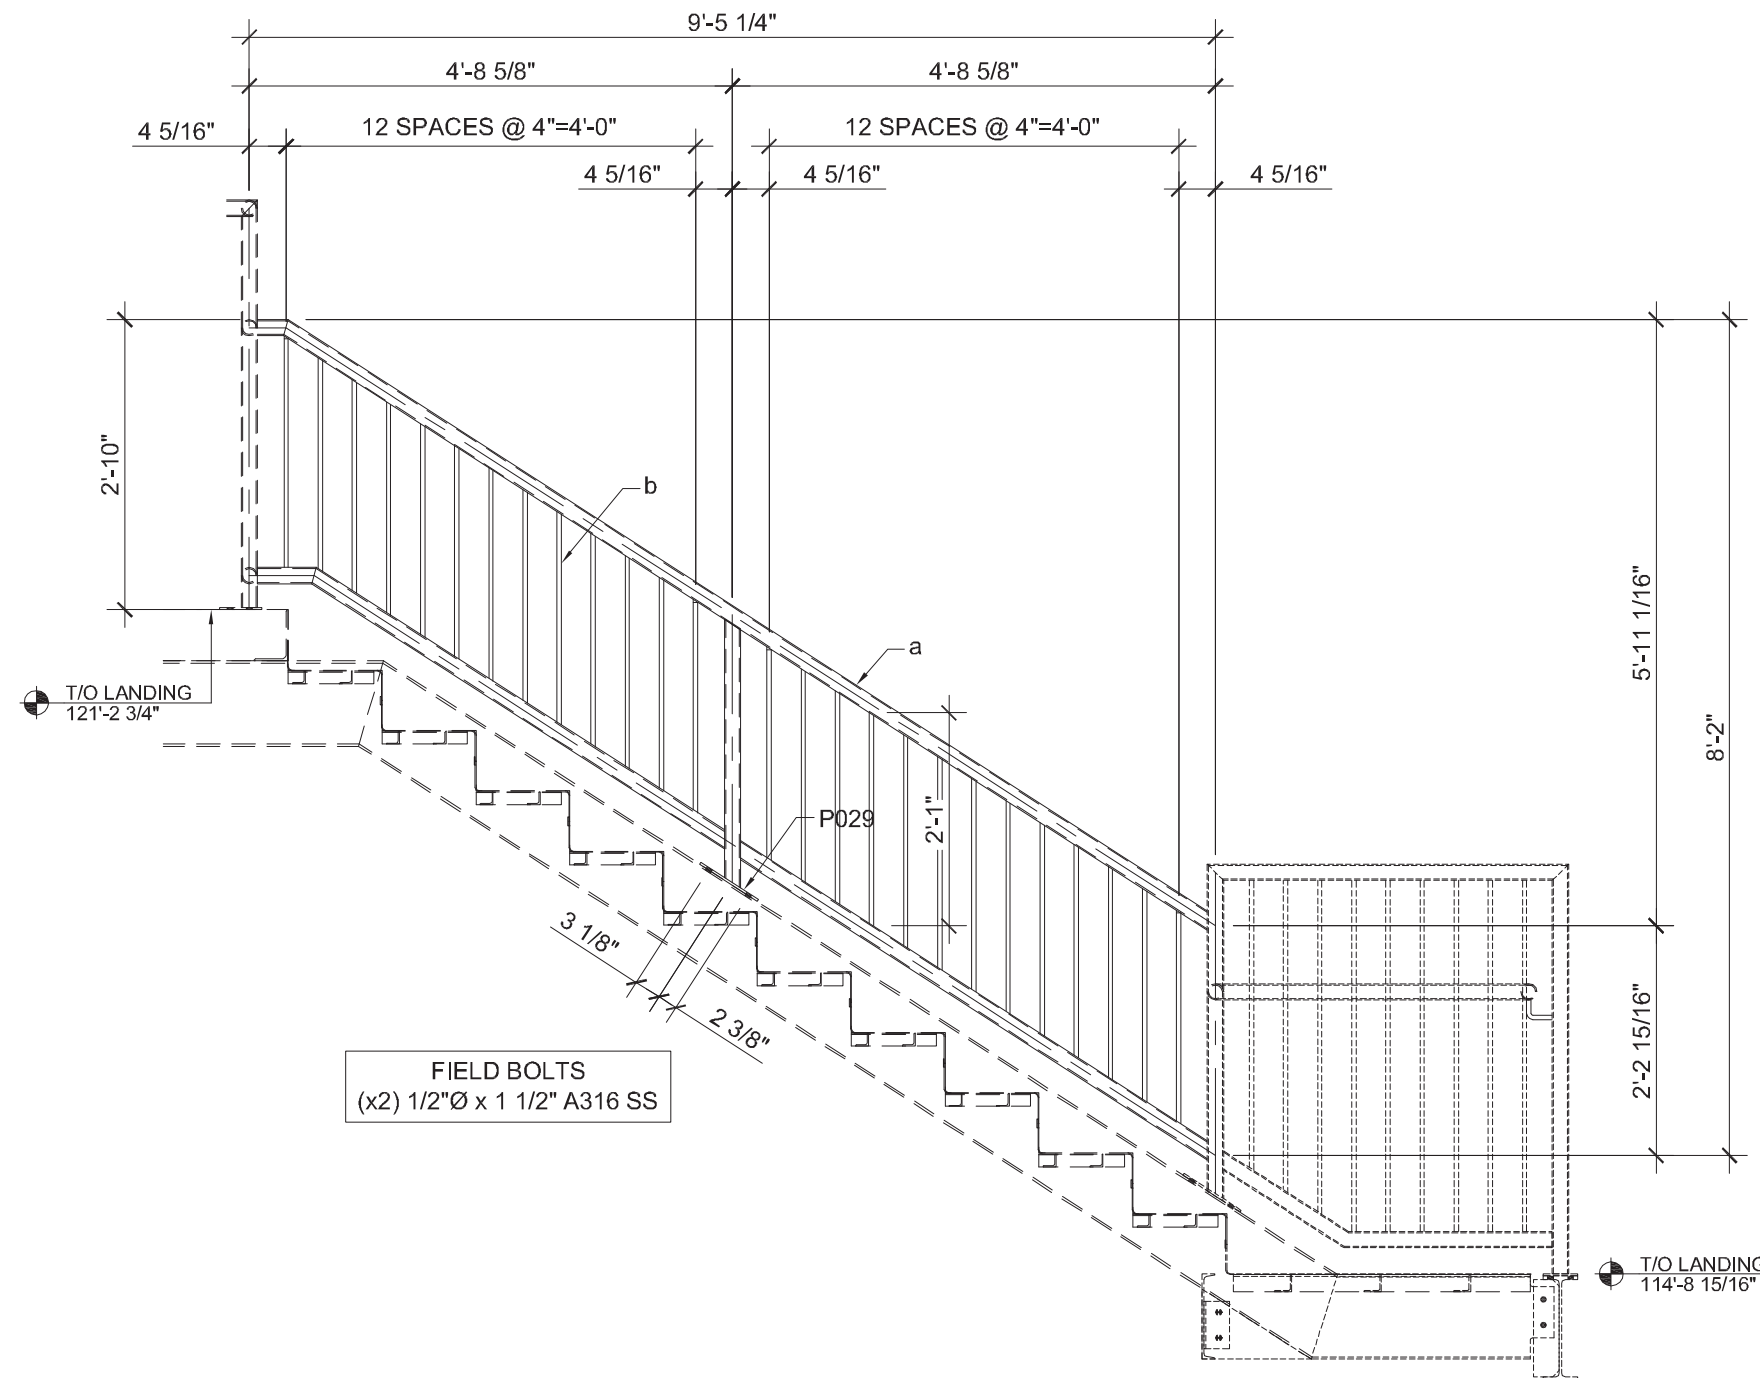

FIELD BOLTS
(x2) 1/2"Ø x 1 1/2" A316 SS

MK 026 - HANDRAIL x 9'-5 1/4"
(ONE REQUIRED AS SHOWN)

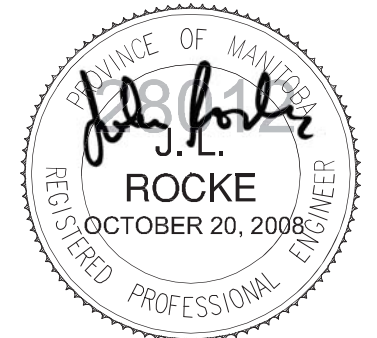

DRAWING NOTES: NOTE	TOTAL WEIGHT 0.0 LBS	HOLES 13/16"Ø U.N.O.				<p>Tractus Group Incorporated 70 Arthur Street, Studio 100 Winnipeg, Manitoba, R3B 1G7</p> <p>P (204) 942-6035 F (204) 942-6034 E Info@tractusgroup.com</p>	PROJECT/CLIENT WESTERN RECREATION ELMWOOD KILDONAN POOL WATERSLIDE STAIR 909 CONCORDIA AVENUE, WINNIPEG, MANITOBA					
	STEEL GRADE ALL STRUCT. STEEL TO CSA G40.21 W SECT, LIGHT GA STL: 350W U.N.O. HSS SECT: 350W CLASS C U.N.O. CHNLS, L'S, PL, ETC.: 300W U.N.O.	FINISH GALVANIZED + EPOXY PAINT						MEMBER DESCRIPTION HANDRAIL				
LIABILITY FOR THESE DRAWINGS IS LIMITED TO DRAFTING SERVICES ONLY. NO ENGINEERING RESPONSIBILITY INCLUDED.	WELD MIN. 3/16" FILLET U.N.O.	REF DWG & MEMBER LOCATION (S) E01 & E02 GRID C2 GRID 1.1 & 1.2	1 AS-BUILT	OCT/20/2008	JMH	RLA	DRAWN BY JC	DRAWN DATE JULY/07/2008	SCALE NTS	SIZE B	DRAWING NUMBER 026	REV 1
FABRICATOR/ERECTOR IS RESPONSIBLE FOR VERIFYING ALL DIMENSIONS & ELEVATIONS AND CHECKING ALL SITE CONDITIONS THAT COULD AFFECT STEEL ERECTION & PLACEMENT TO DIMENSIONS INDICATED ON ERECTION DRAWINGS.			0 FOR APPROVAL	JULY/17/2008	JMH	RLA	CHK'D BY RLA	CHECKED DATE JULY/07/2008	JOB No. 28012			
			REV	DESCRIPTION	DATE	BY	CHK'D					