


PLAN VIEW: UNDERGROUND CONSTRUCTION
1:250

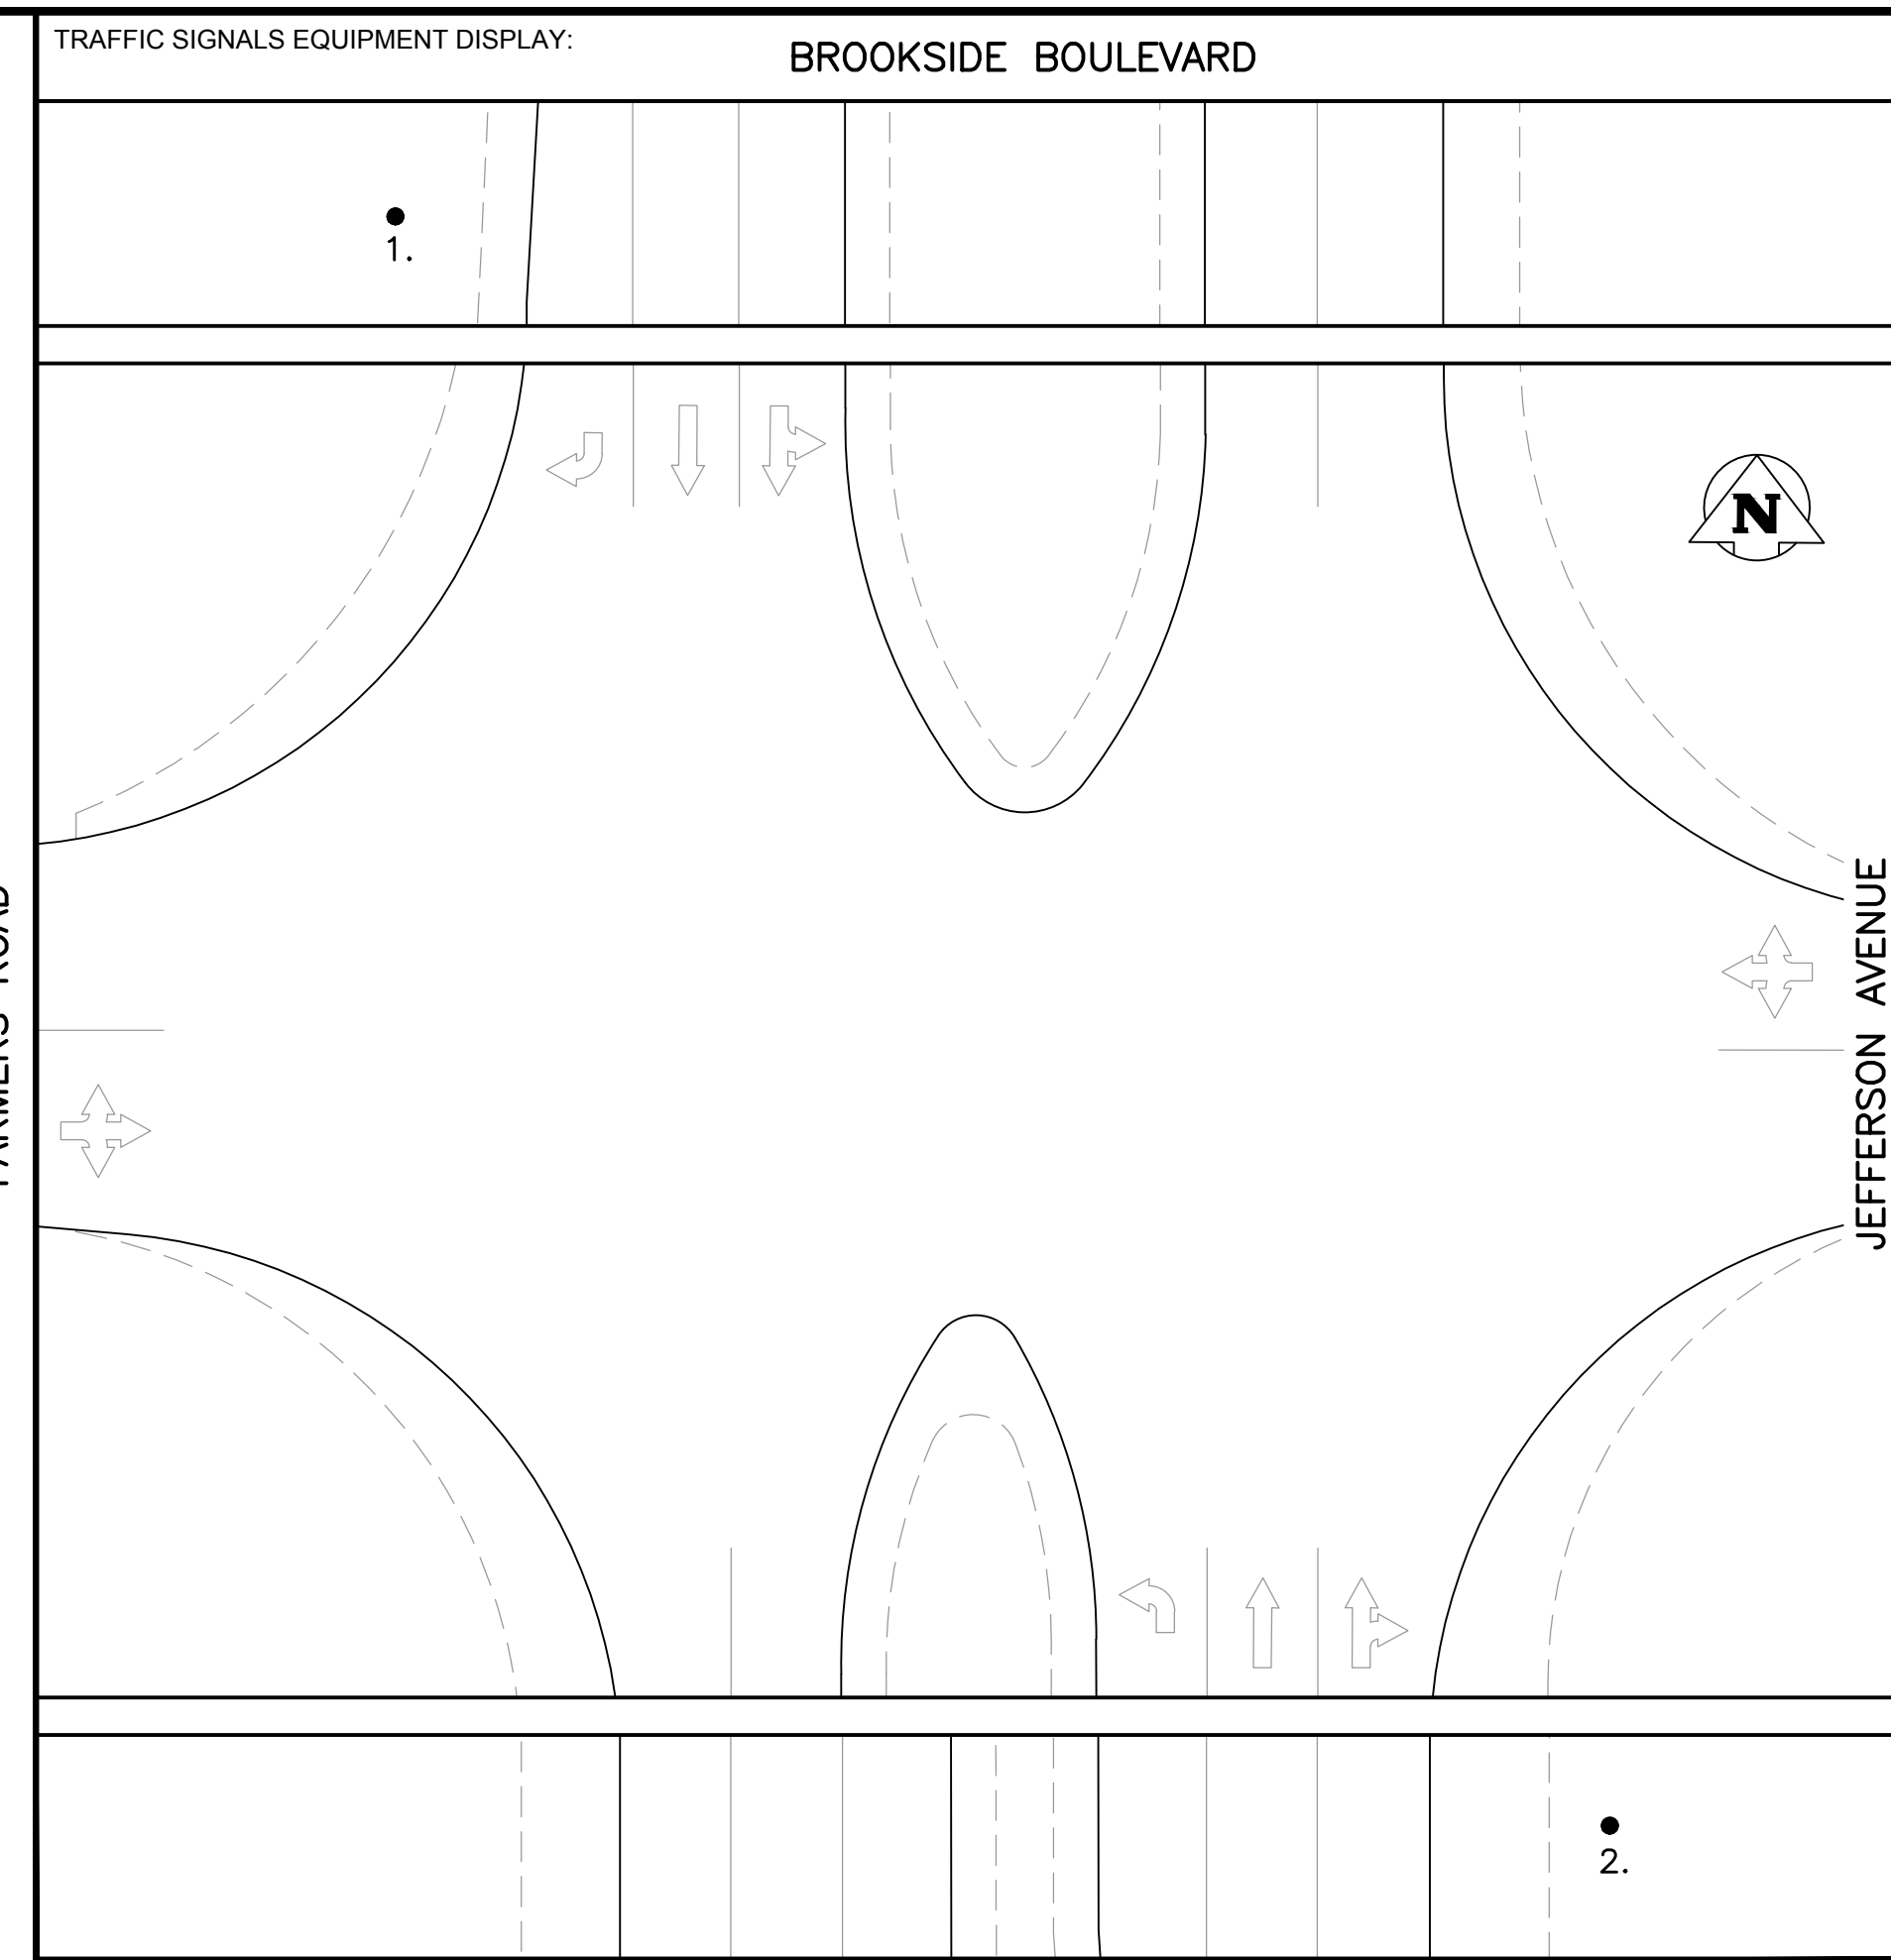

EQUIPMENT DISPLAY LEGEND

	PEDESTRIAN HEAD		LANE DESIGNATION		TRAFFIC SIGNAL HEAD
	PEDESTRIAN HEAD (WITH PCS)		VEHICLE DETECTION AREA		EXISTING
	PEDESTRIAN HEAD (OLD STYLE)		PUSH BUTTON & DIRECTION		EXISTING
	PEDESTRIAN CORRIDOR HEAD		APS SINGLE DIRECTION		APS DUAL DIRECTION (2 SEPARATE SPEAKERS)
			RRFB		

NO.	EQUIPMENT LIST	ARM	BASE	B.B.	NO.	EQUIPMENT LIST	ARM	BASE	B.B.
1.	18" SIGNAL		G	G					
	STREET NAME SIGN								
2.	18" SIGNAL		G	G					
	STREET NAME SIGN								

TRAFFIC SIGNALS UNDERGROUND LEGEND		SIGNAL BASE BOLT SQUARE TYPES	
	POLE BASE		CONDUIT STUB
	CONTROLLER BASE		LOOPS - SAW CUT
	PEDESTAL BASE		LOOPS - PREFORMED
	TERMINAL BASE		BOLT SQUARE (B.S.)
	SERVICE BOX (PIT)		
	24" PRECAST PIT		
	30" PRECAST PIT		
	36" PRECAST PIT		
	1 1/2" CONDUIT		
	2" CONDUIT		
	3" CONDUIT		
	AERIAL/BURIED CABLE		

EXISTING	LEGEND	PROPOSED	EXISTING	LEGEND	PROPOSED	EXISTING	LEGEND	PROPOSED
	WATERMAIN			CONCRETE			TELEPHONE	
	HYDRANT			SIDEWALK			COMMUNICATION	
	VALVE			CURB RAMP			WOOD POLE	
	SEWER			WARNING TILE			STREET LIGHT	
	MANHOLE			ASPHALT			BANNER POLE	
	CATCH BASIN			SLOPE			RAILWAY POLE	
	CURB INLET			CULVERT			GUY-WIRE	
	HYDRO			BUILDING			FENCE	
	GAS						TREE	

UNDERGROUND STRUCTURES

ORIGINAL SIGNED BY: _____

UNDERGROUND STRUCTURES COMMITTEE DATE: _____

NOTE:
LOCATIONS OF UNDERGROUND STRUCTURES AS SHOWN ARE BASED ON THE BEST INFORMATION AVAILABLE, BUT NO GUARANTEE IS GIVEN THAT ALL EXISTING UTILITIES ARE SHOWN OR THAT THE GIVEN LOCATIONS ARE EXACT. CONFIRMATION OF EXISTENCE AND EXACT LOCATION OF ALL SERVICES MUST BE OBTAINED FROM THE INDIVIDUAL UTILITIES BEFORE PROCEEDING WITH CONSTRUCTION.

CONSTRUCTION REVISIONS

NO.	REVISION	DATE	BY
1	ISSUED FOR RECORD	Jul. 10/19	A.M.
0	ISSUED FOR CONSTRUCTION	May 28/18	M.C.

DESIGNED BY: _____

A.M.

DRAWN BY: _____

J.S.

CHECKED BY: _____

APPROVED BY: _____

RELEASED FOR CONSTRUCTION: _____

TRAFFIC SIGNALS ENGINEER: _____

DATE: _____

LIABILITY DISCLAIMER NOTICE:
THE DIGITAL INFORMATION PROVIDED FOR YOUR CONVENIENCE HEREIN IS FOR USE AT YOUR OWN RISK. THE CITY OF WINNIPEG, PUBLIC WORKS DEPARTMENT, SHALL ASSUME NO RESPONSIBILITY FOR THE INFORMATION AND IT SHOULD NOT BE CONSTRUED AS ASBULT INFORMATION. THE INFORMATION SHOULD BE USED FOR PLANNING PURPOSES ONLY AND SHOULD BE VERIFIED BY SURVEY. THE DEPARTMENT SHALL NOT IN ANY WAY SUFFER ANY LIABILITY WHATSOEVER TO ANY PARTY FOR INJURY, LOSS OR DAMAGES SUFFERED BY SUCH PARTY ARISING FROM THEIR USE OF, OR RELIANCE UPON, THIS INFORMATION.

THE CITY OF WINNIPEG
PUBLIC WORKS DEPARTMENT
TRANSPORTATION DIVISION

ADVANCE STREET NAME SIGNS
BROOKSIDE BLVD. &
FARMERS RD./JEFFERSON AVE.

RECORD DRAWING

SCALE: 1:250
(ALL DIMENSIONS ARE IN METERS UNLESS OTHERWISE NOTED)

DRAWING NUMBER: S-1980