



100 Ferry Road  
 address  
 91-201  
 project no.  
 Bourkevale Park Storage Building  
 description  
 2 of 3  
 sheet no.  
 Construction Details - Workshop Counter


**ROOF CONSTRUCTION**

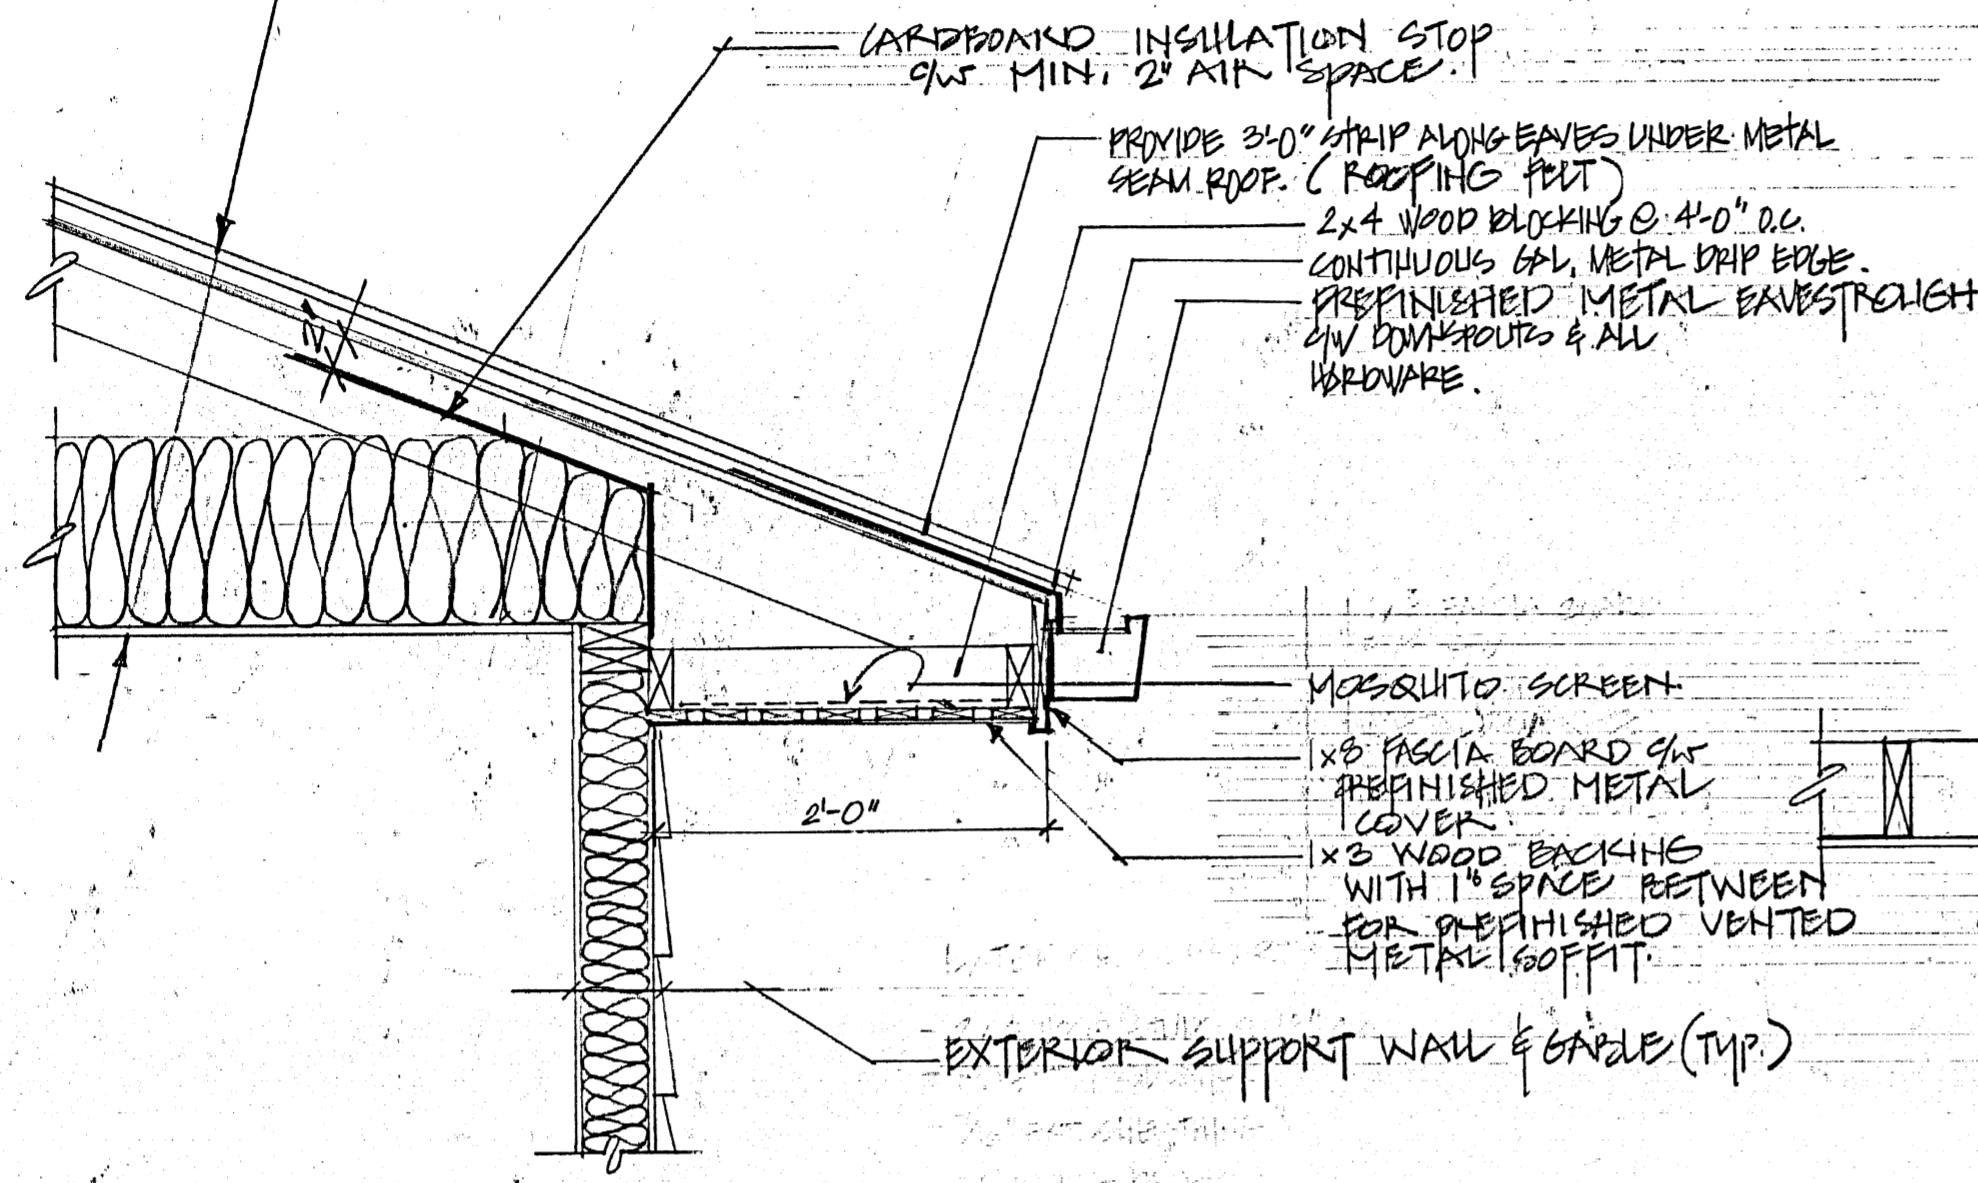


1 ROOF OVERHANG DETAIL  
 2 1/2 x 12"

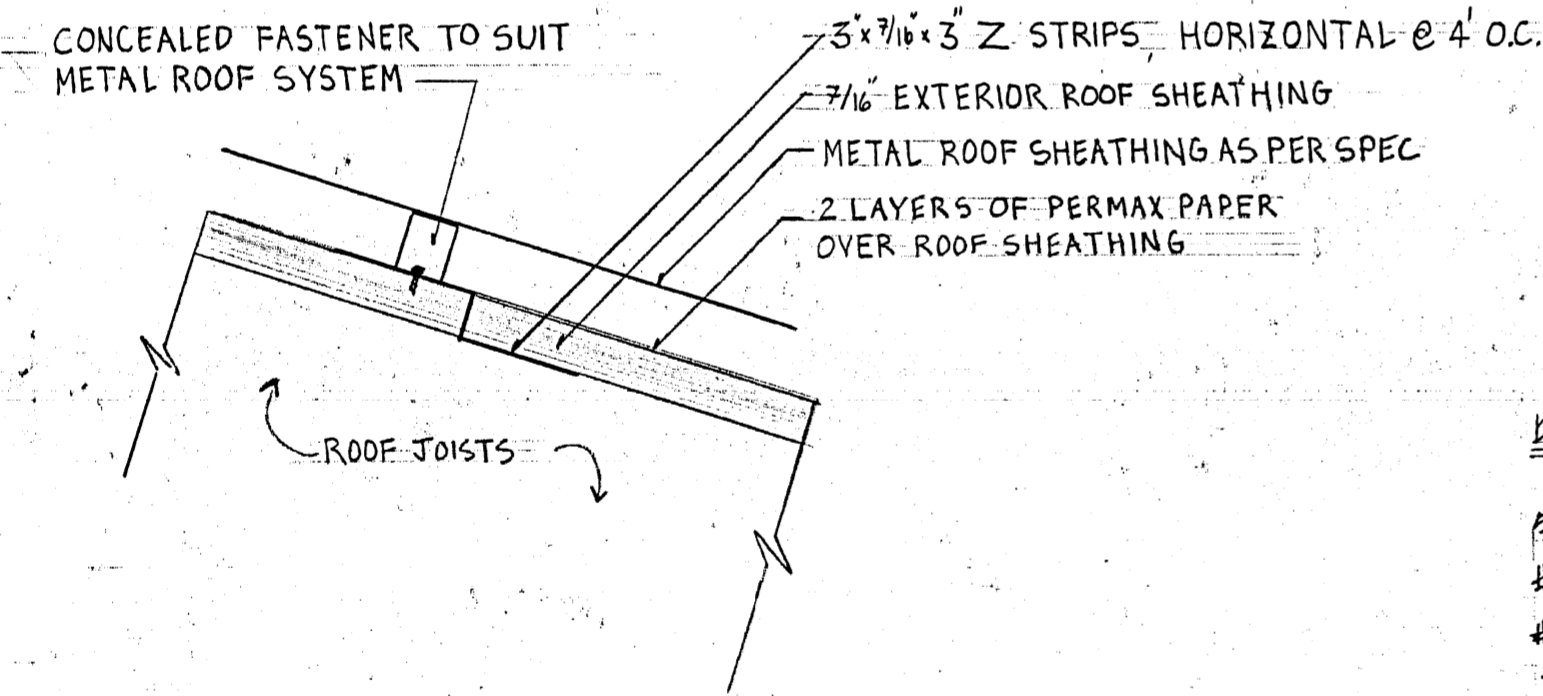

ROOF DETAIL - METAL ROOF

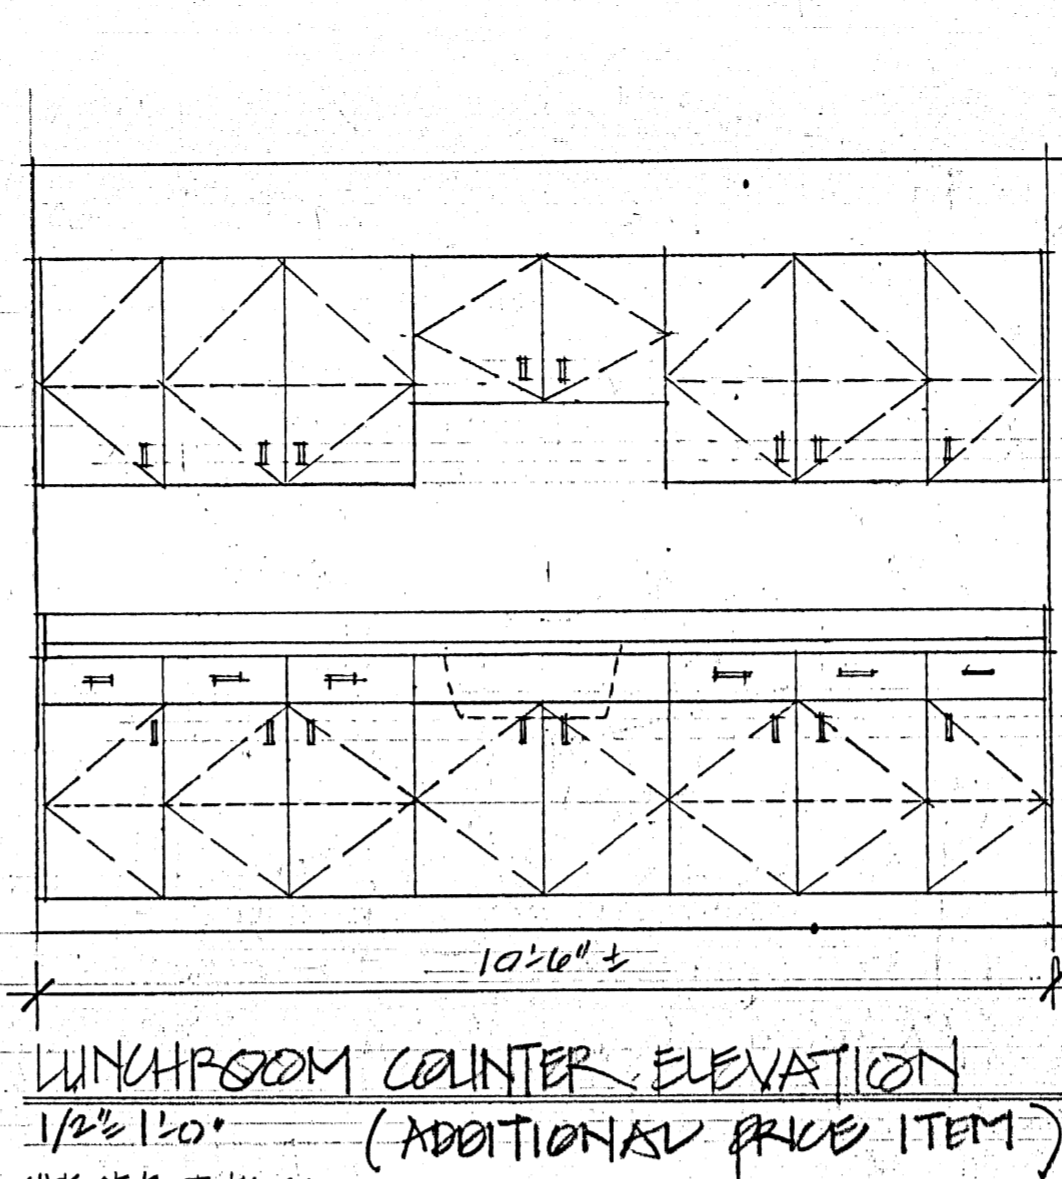


WORKSHOP COUNTER ELEVATION  
 1/2 x 12\"/>

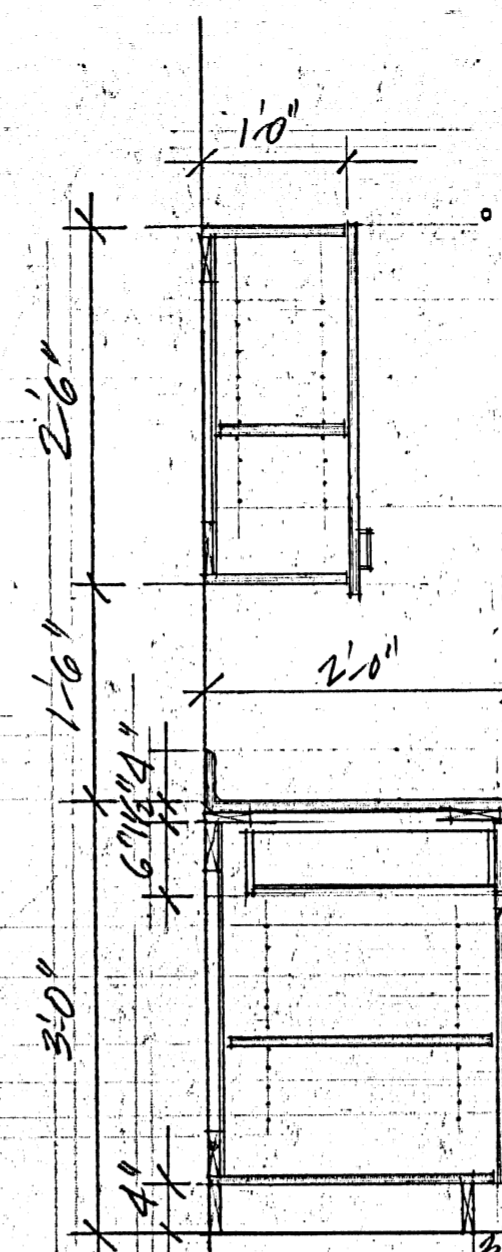


CABINET SECTION (ADDITIONAL PRICE ITEM)  
 3/4 x 12\"/>

**CABINET CONSTRUCTION**

1/16\"/>

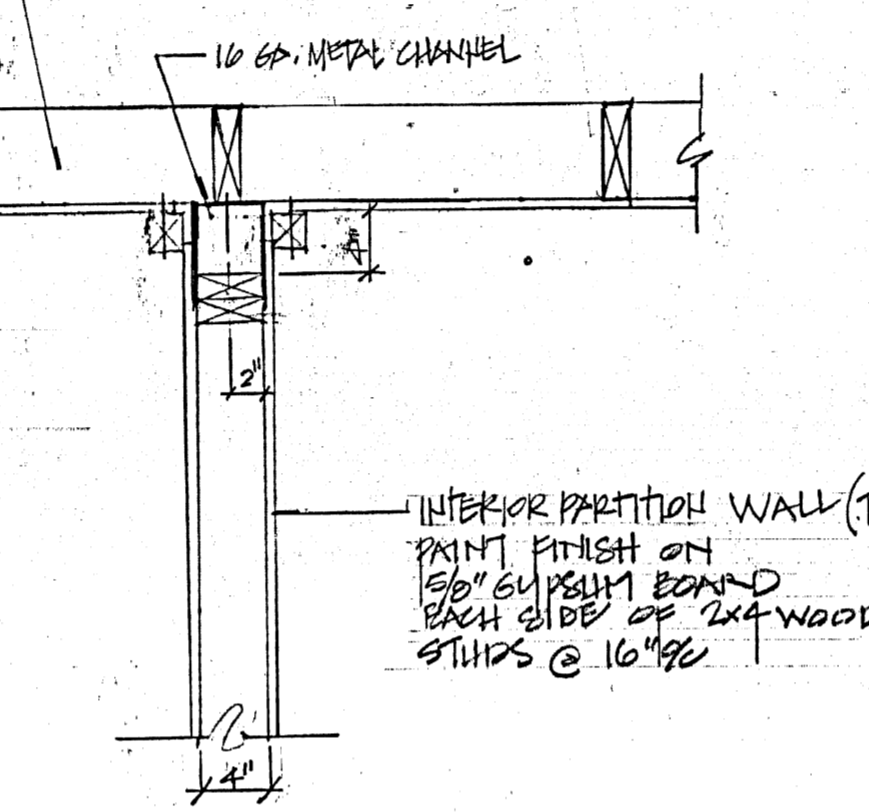


SLIP JOINT DETAIL - TYPICAL  
 1/2 x 12\"/>

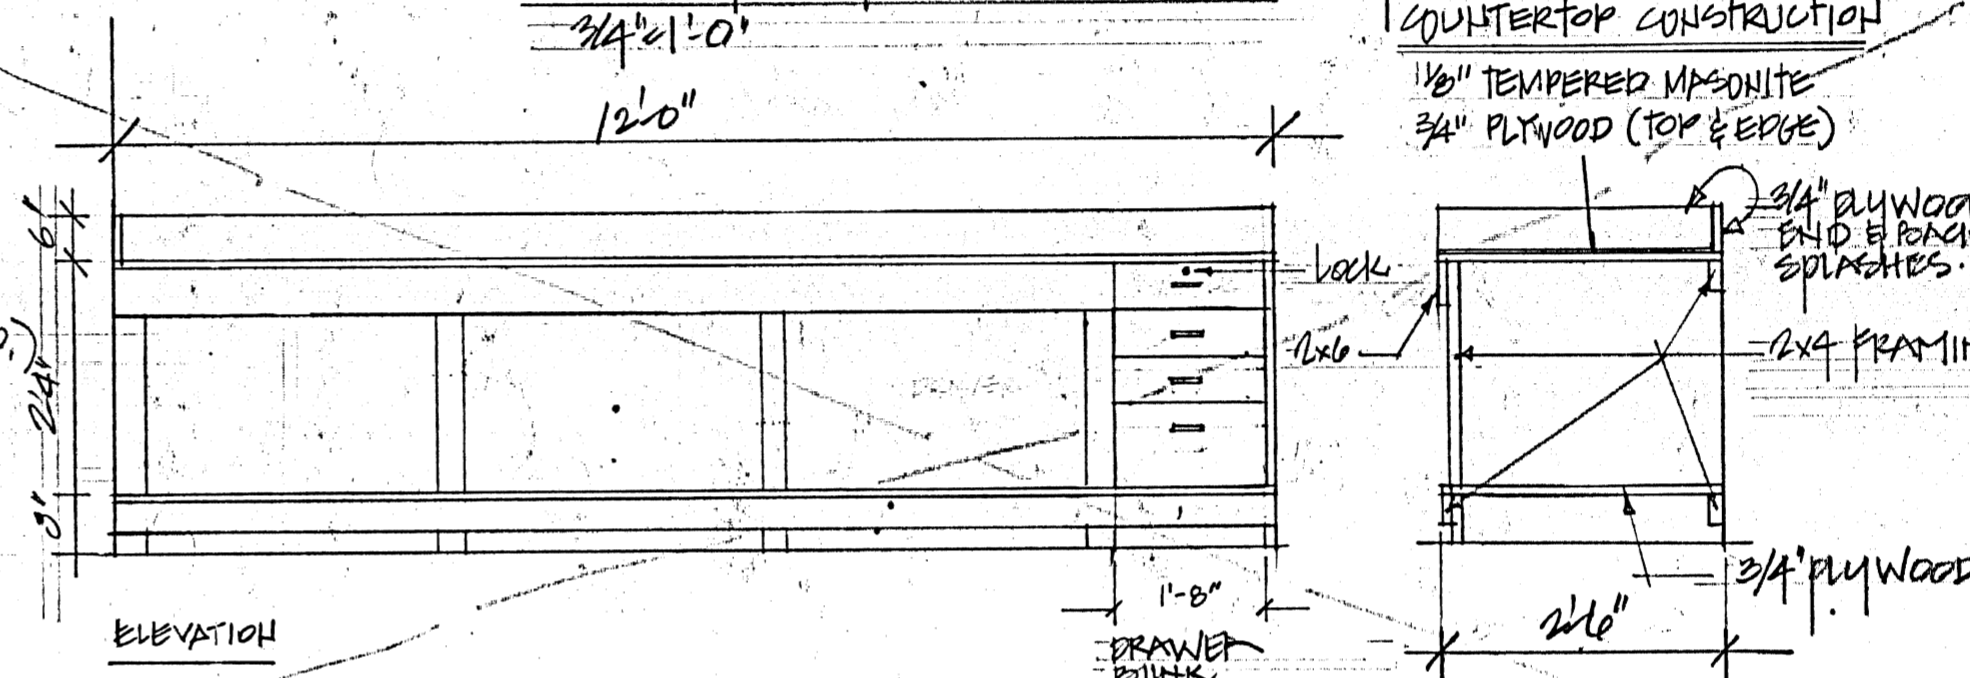

WORKSHOP COUNTER (CONCRETE)  
 1/2 x 12\"/>

**DRIVEWAY AND CONSTRUCTION**

5\"/>

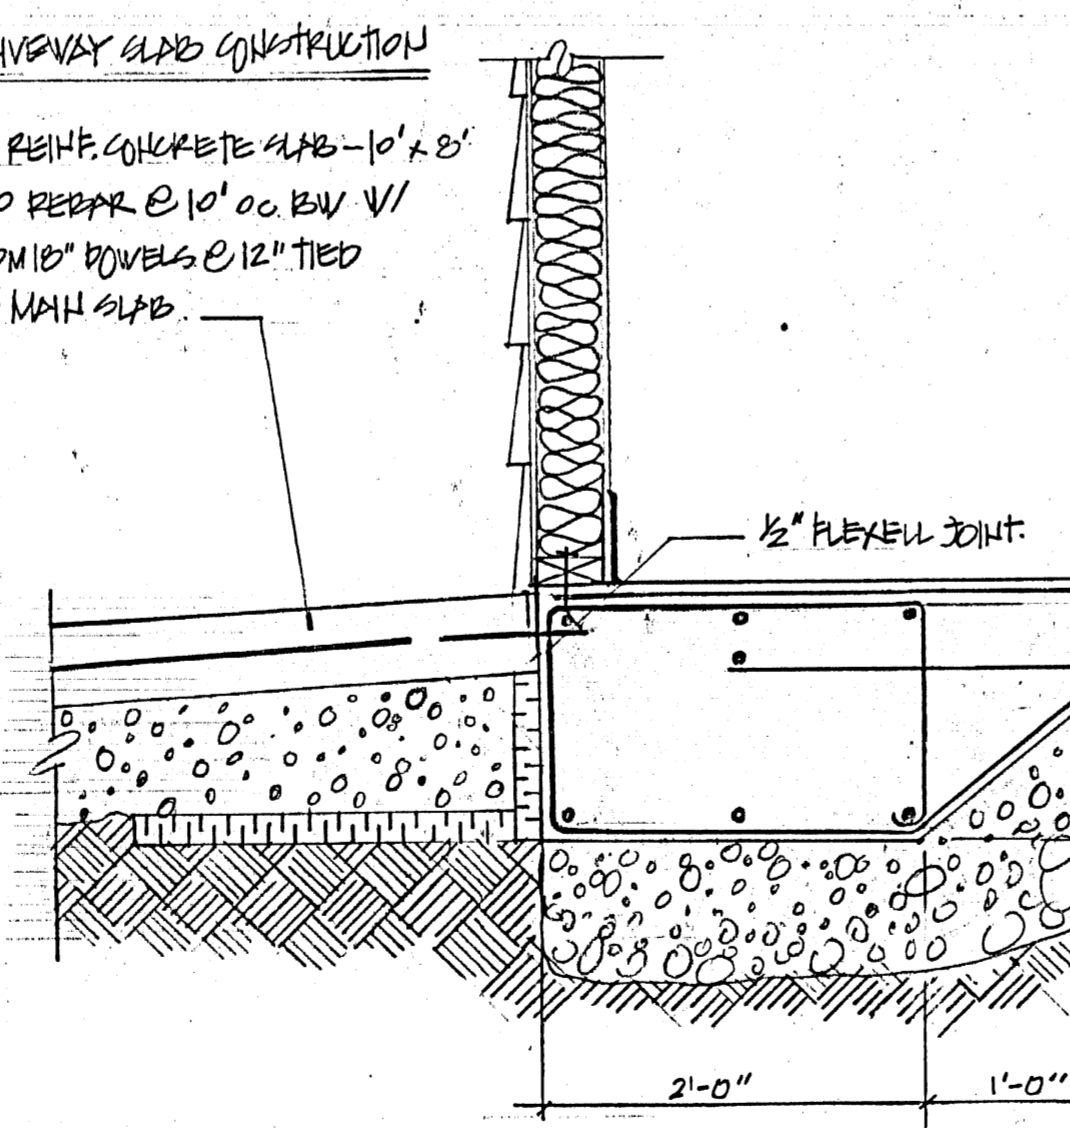


3 DRIVEWAY DETAIL  
 1/2 x 12\"/>

**NOTE:**

ALL GRANULAR COMPACTED TO 95% MODIFIED PROCTOR DENSITY. ALL CONCRETE SHALL BE 30 MPa, 4\"/>

**FOUNDATION SLAB**

6\"/>

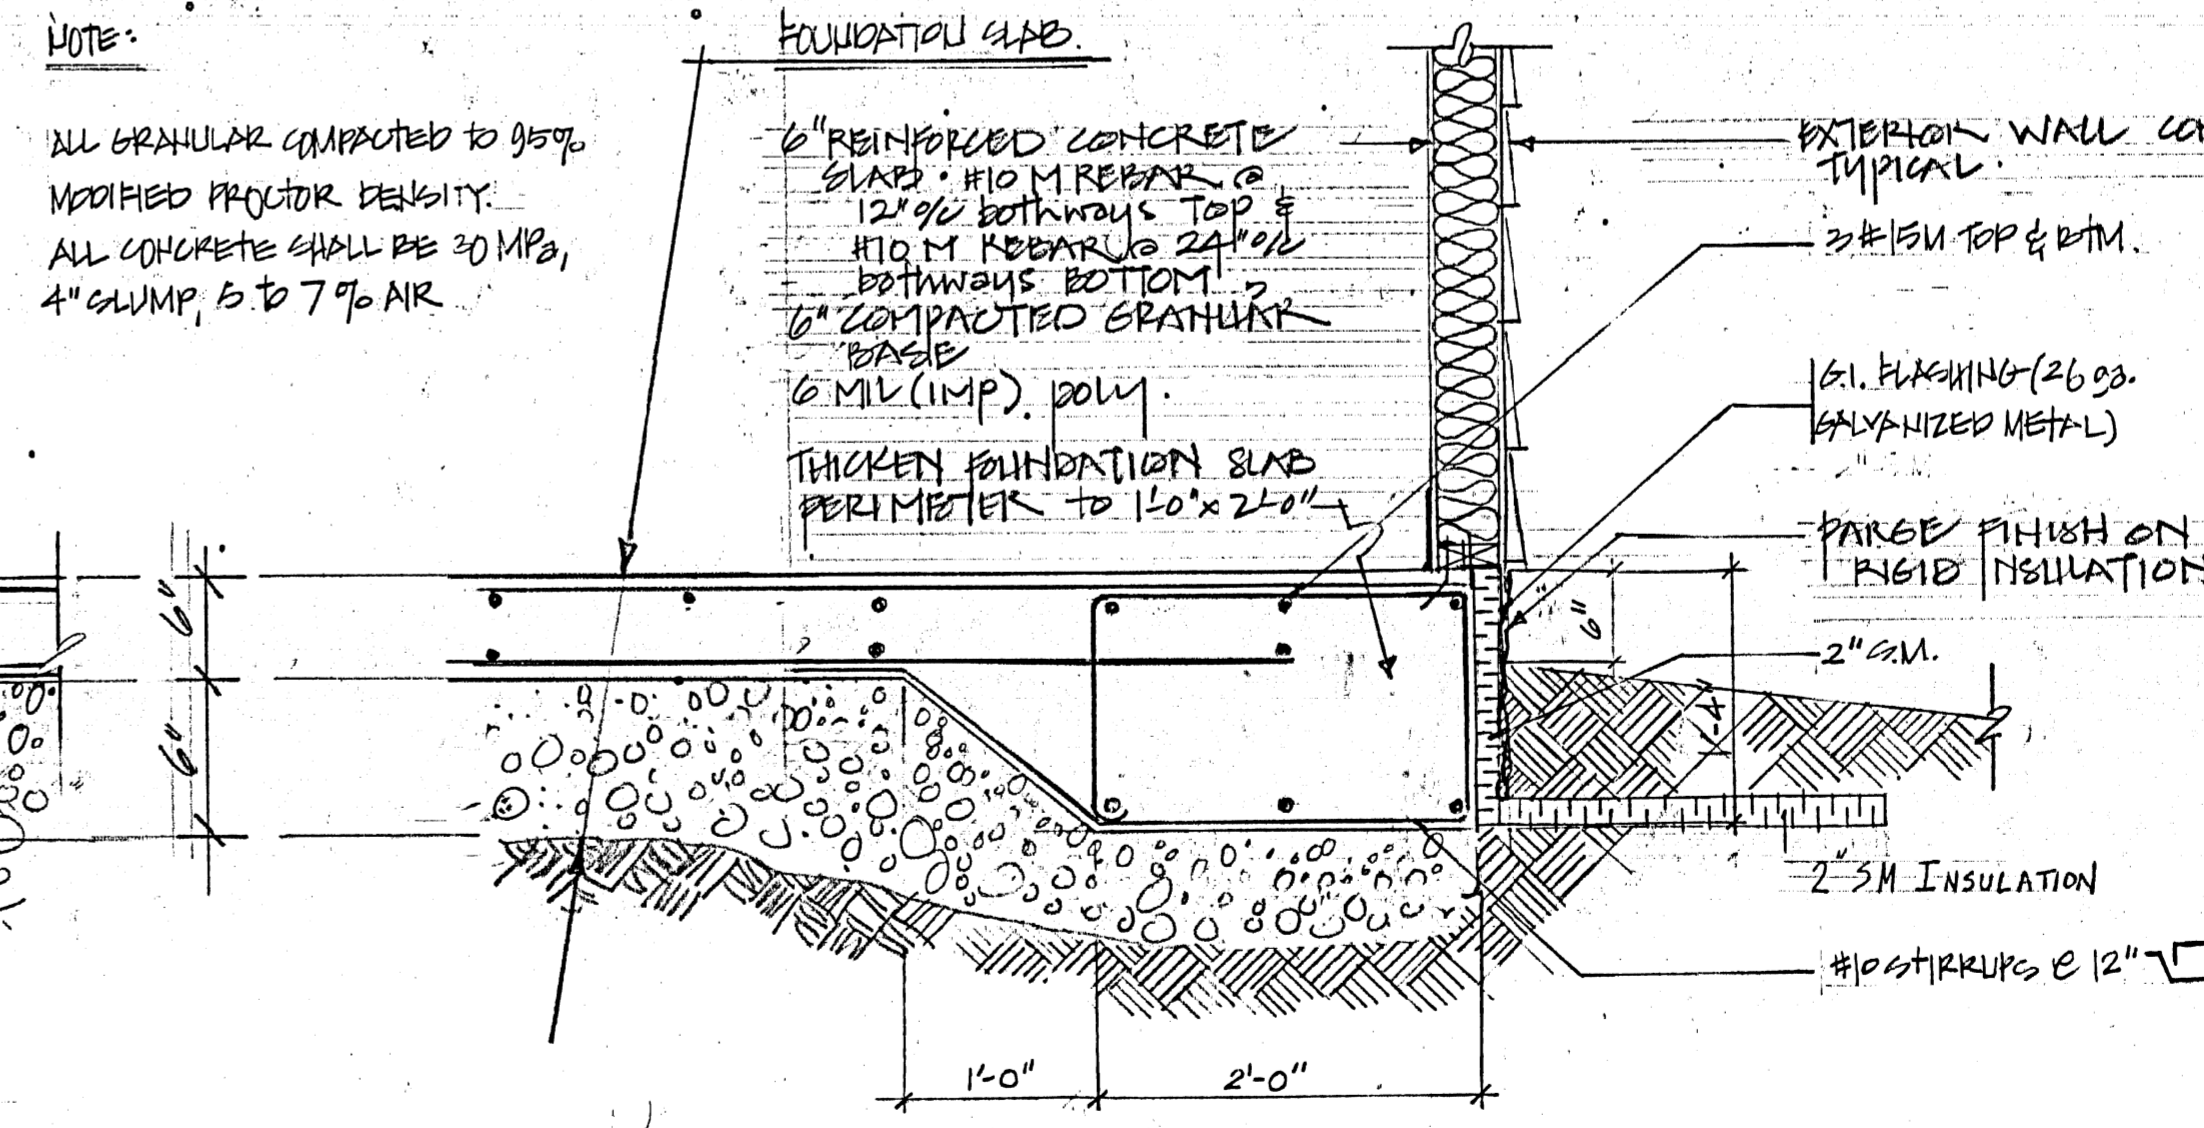


4 FOUNDATION DETAIL  
 1/2 x 12\"/>

**STRUCTURAL NOTES:**

- ALL WORK SHALL COMPLY W/ LATEST EDITION OF MANITOBA BUILDING CODE.
- FOUNDATION - CONCRETE SLAB ON GRADE CONSTRUCTION.
- ROOF TRUSSES & BRACING SHALL BE PROVIDED BY MANUFACTURER IN ACCORDANCE TO PART 9 OF N.B.C. OF CANADA AND CSA006 FOR SHED LOADS OF 36 PSF OR 1.72 KN/M<sup>2</sup> - SHOP DRAWINGS SHALL BE REVIEWED BY MANUFACTURER AND SEALED BY A PROFESSIONAL ENGINEER REGISTERED IN MANITOBA.
- CONCRETE - ALL CONCRETE SHALL BE 30 MPa, 20mm AGGREGATE, 90mm SLUMP IN ACCORDANCE TO CITY OF WINNIPEG STANDARD CONSTRUCTION SPECIFICATIONS. CONTRACTOR SHALL CHECK ALL FOUNDATION DIMENSIONS ON STRUCTURAL DRAWINGS FOR COMPLIANCE W/ ARCHITECTURAL AND MECHANICAL DRAWINGS. LOCATION OF ALL ANCHOR BOLTS AND MECHANICAL OPENINGS MUST BE CHECKED & VERIFIED BY THE ENGINEER PRIOR TO POURING. ANY DISCREPANCY OR AMBIGUITY IN STRUCTURAL DRAWINGS SHALL BE REPORTED TO THE DESIGN ENGINEER IN WRITING.
- ALL FRAME WALLS (INTERIOR & EXTERIOR) SHALL BE BOLTED TO THE SLAB USING 3/8\"/>

NO.	REVISION/DESCRIPTION	BY	DATE
2	DELETE WORKSHOP COUNTER	BRD	APRIL 27/92
1	DELETE EXHAUST DETAIL		

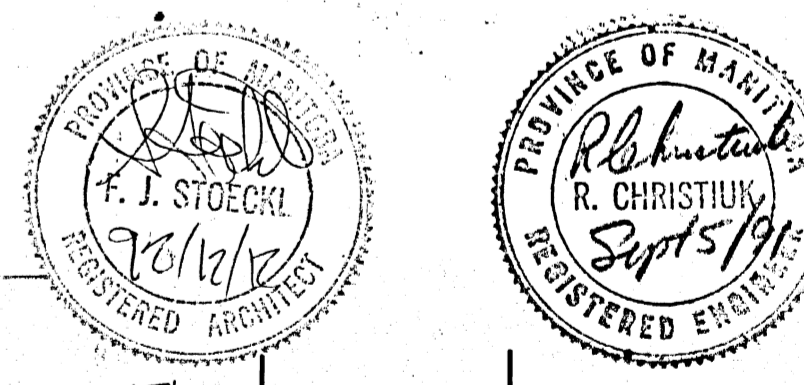

DRAWN BY: LJE  
 CHECKED BY: [Signature]  
 APPROVED: [Signature]

THE CITY OF WINNIPEG  
 CIVIC PROPERTIES DEPARTMENT  
 4-180 KING ST. R3B 3G8

PROJECT: BOURKEVALE PARK STORAGE BUILDING - FERRY ROAD.

SHEET TITLE: CONSTRUCTION DETAILS, WORKSHOP COUNTER DRAWINGS.

SCALE: 1/4" = 1'-0"  
 PROJECT NO: 91201  
 SHEET NO: 2 OF 3