

APPENDIX 'C'

REFERENCE DRAWINGS



CITY OF WINNIPEG


WORKS AND OPERATIONS DIVISION

STREETS AND TRANSPORTATION DEPARTMENT

ROUTE 90 CULVERT AT OMAND'S CREEK
TOP SLAB REHABILITATION, STRUCTURAL
STRENGTHENING AND RELATED WORKS

TOP SLAB

P.D. NO. 85-104

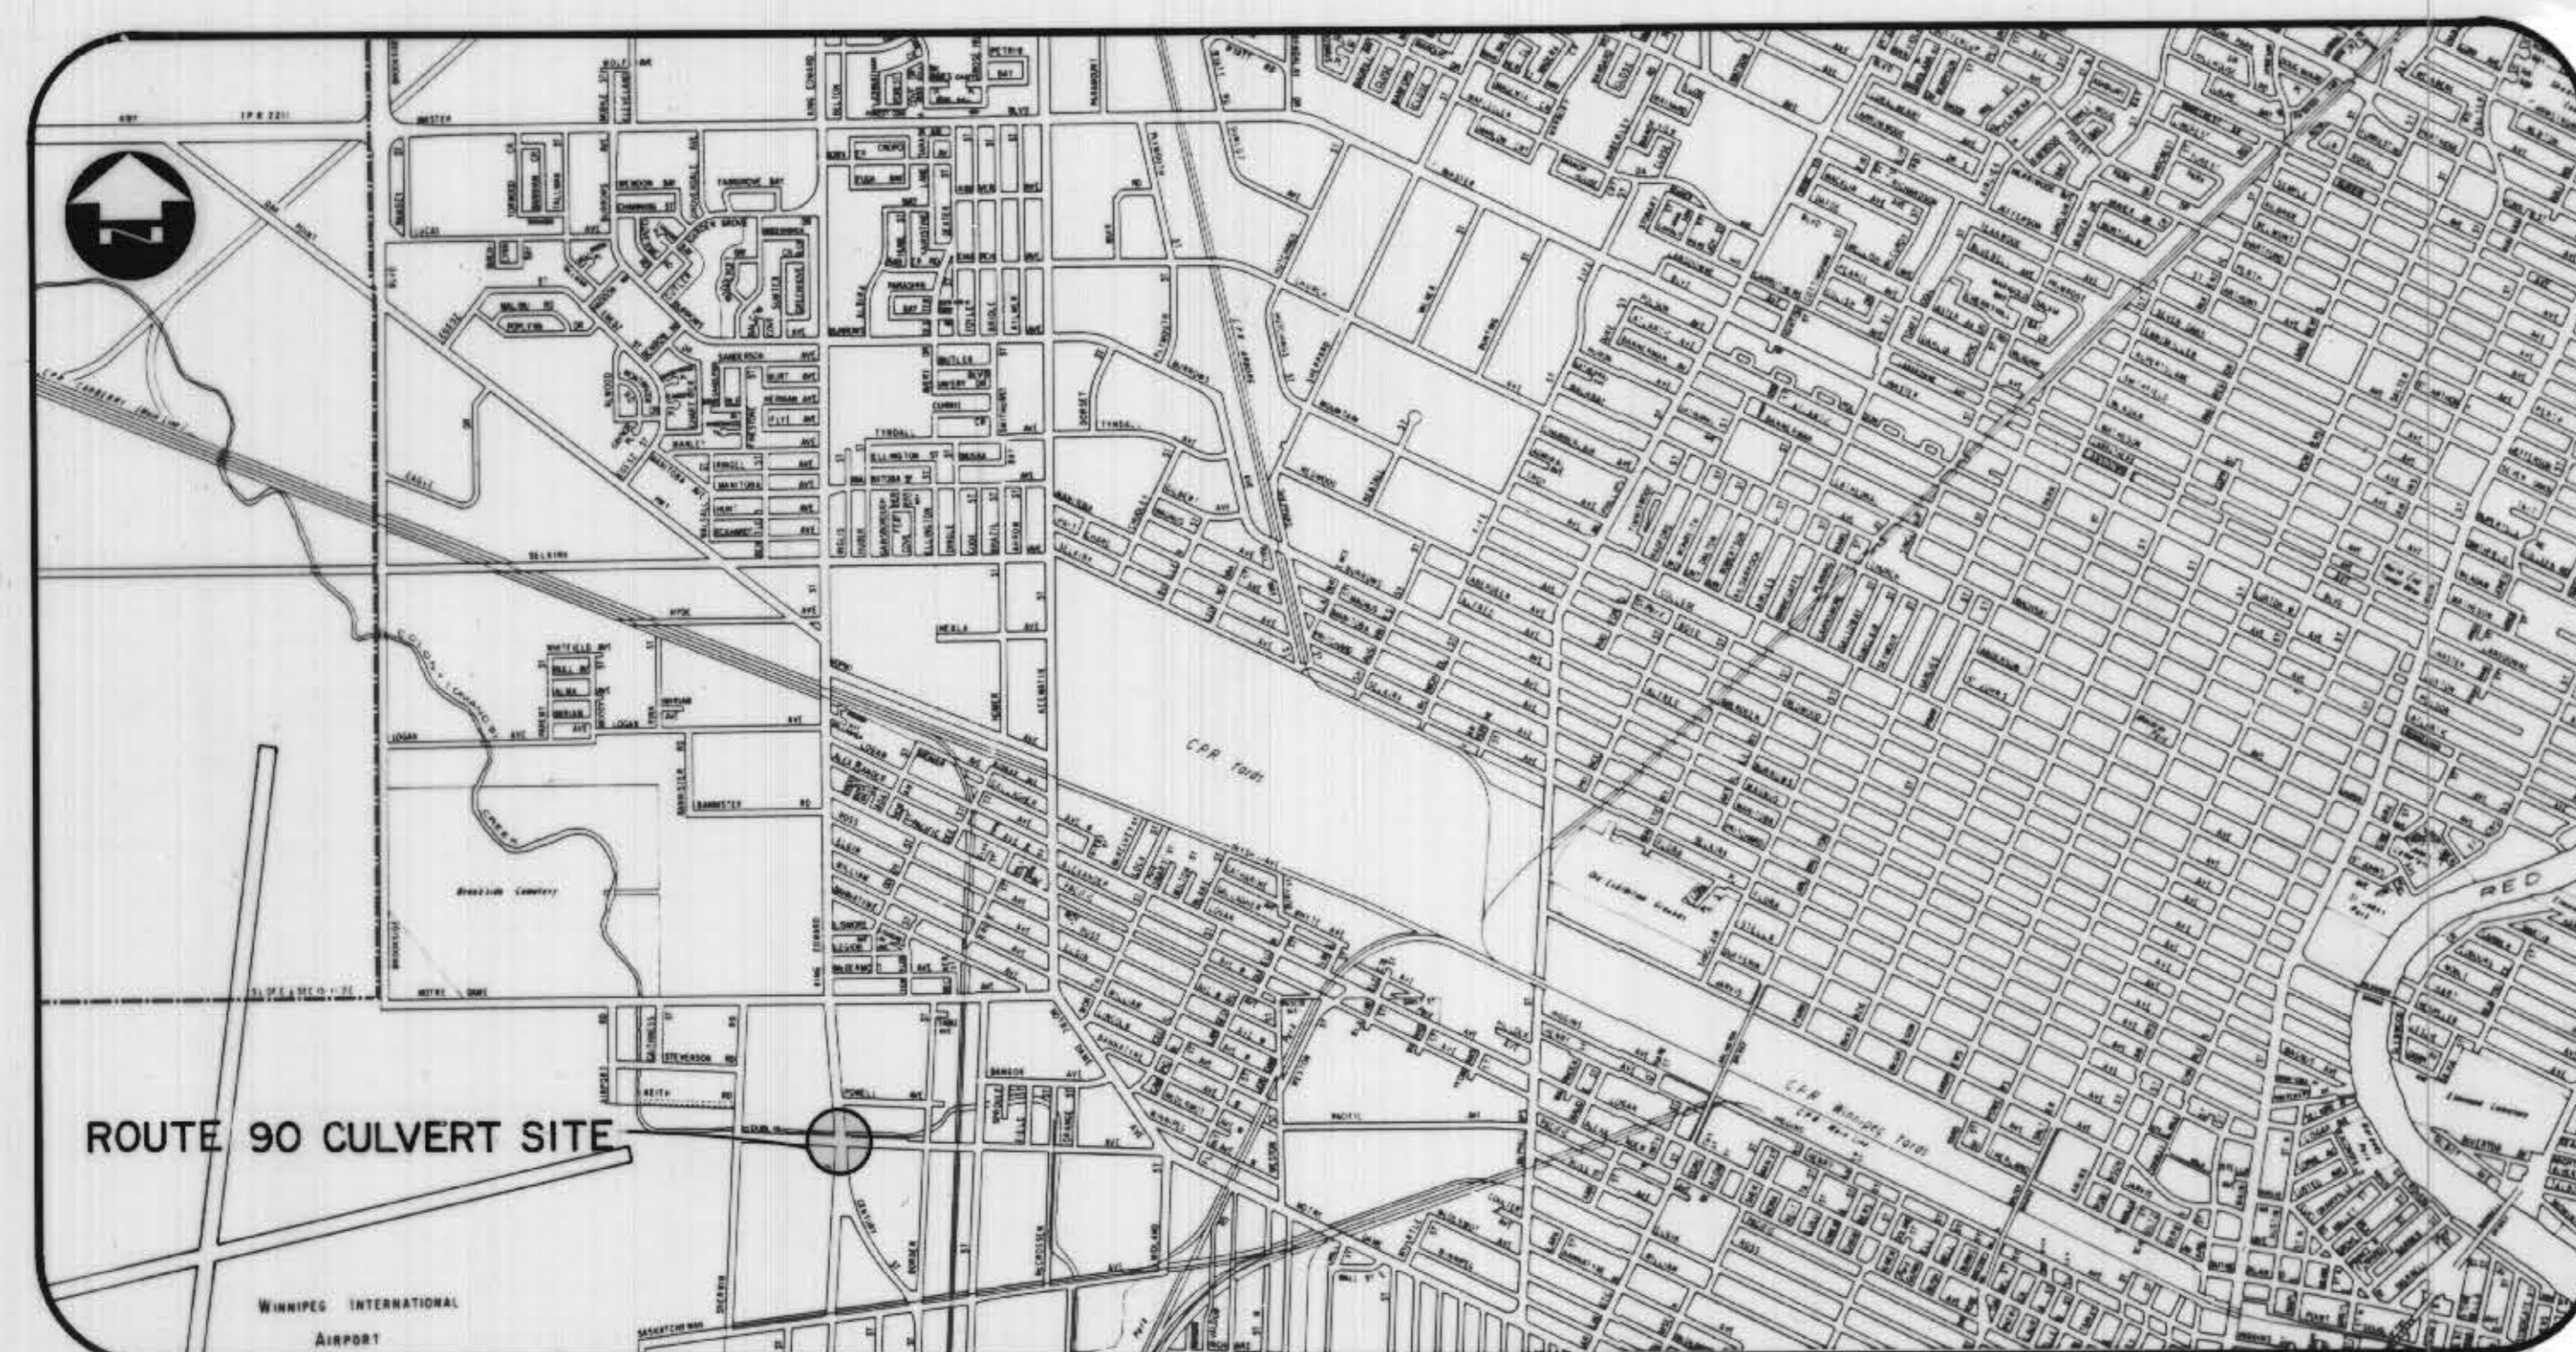

LOCATION PLAN

DESIGN DATA

| | | |
|-------------------------------------|---|--|
| DESIGN SPECIFICATIONS | - | AASHTO 1983 |
| LIVE LOADING | - | HSS 25-44 TRUCK LOADING HS 25-44 LANE LOADING |
| STRUCTURAL CONCRETE | - | $f'_c = 30$ MPa |
| REINFORCING STEEL | - | CSA G30.12-M77 GRADE 400 |
| STRUCTURAL STEEL | - | CSA CAN 3 - G40.21-M81 GRADE 300W |
| ALUMINUM | - | ASTM B221 |
| HIGH DENSITY CONCRETE | - | 100mm CONCRETE TOPING ON CULVERT TOP SLAB |
| CLEAR COVER TO REINFORCING STEEL | - | 60mm ± 10mm |

DRAWING LIST

| | |
|------------|--|
| C315-85-01 | COVER SHEET |
| C315-85-02 | GENERAL ARRANGEMENT & LOCATION OF PROPOSED WORKS |
| C315-85-03 | TRAFFIC ROUTING & CONSTRUCTION SEQUENCE |
| C315-85-04 | DETAILS OF TOP SLAB MODIFICATIONS AND APPROACH SLABS |
| C315-85-05 | ASPHALT OVERLAY - LAYOUT & GRADES |
| C315-85-06 | LAYOUT & DETAILS OF ALUMINUM PEDESTRIAN HANDRAIL |
| C315-85-07 | LAYOUT OF BALANCED ALUMINUM SHOULDER BARRIER, HEADWALL CHAINLINK FENCE & RIPRAP |
| C315-85-08 | BALANCED ALUMINUM SHOULDER BARRIER STANDARD DETAILS |
| C315-85-09 | DETAILS OF ALUMINUM BRIDGE RAIL POSTS |


DILLON
Consulting Engineers & Planners

RELEASED FOR CONSTRUCTION
Small R. Ogilby 85 of 03
MANAGER OF STREETS AND TRAFFIC

AS BUILT
APPROVED BY: *R. [Signature]*

DWG. NO. C315-85-01

B-5530-1

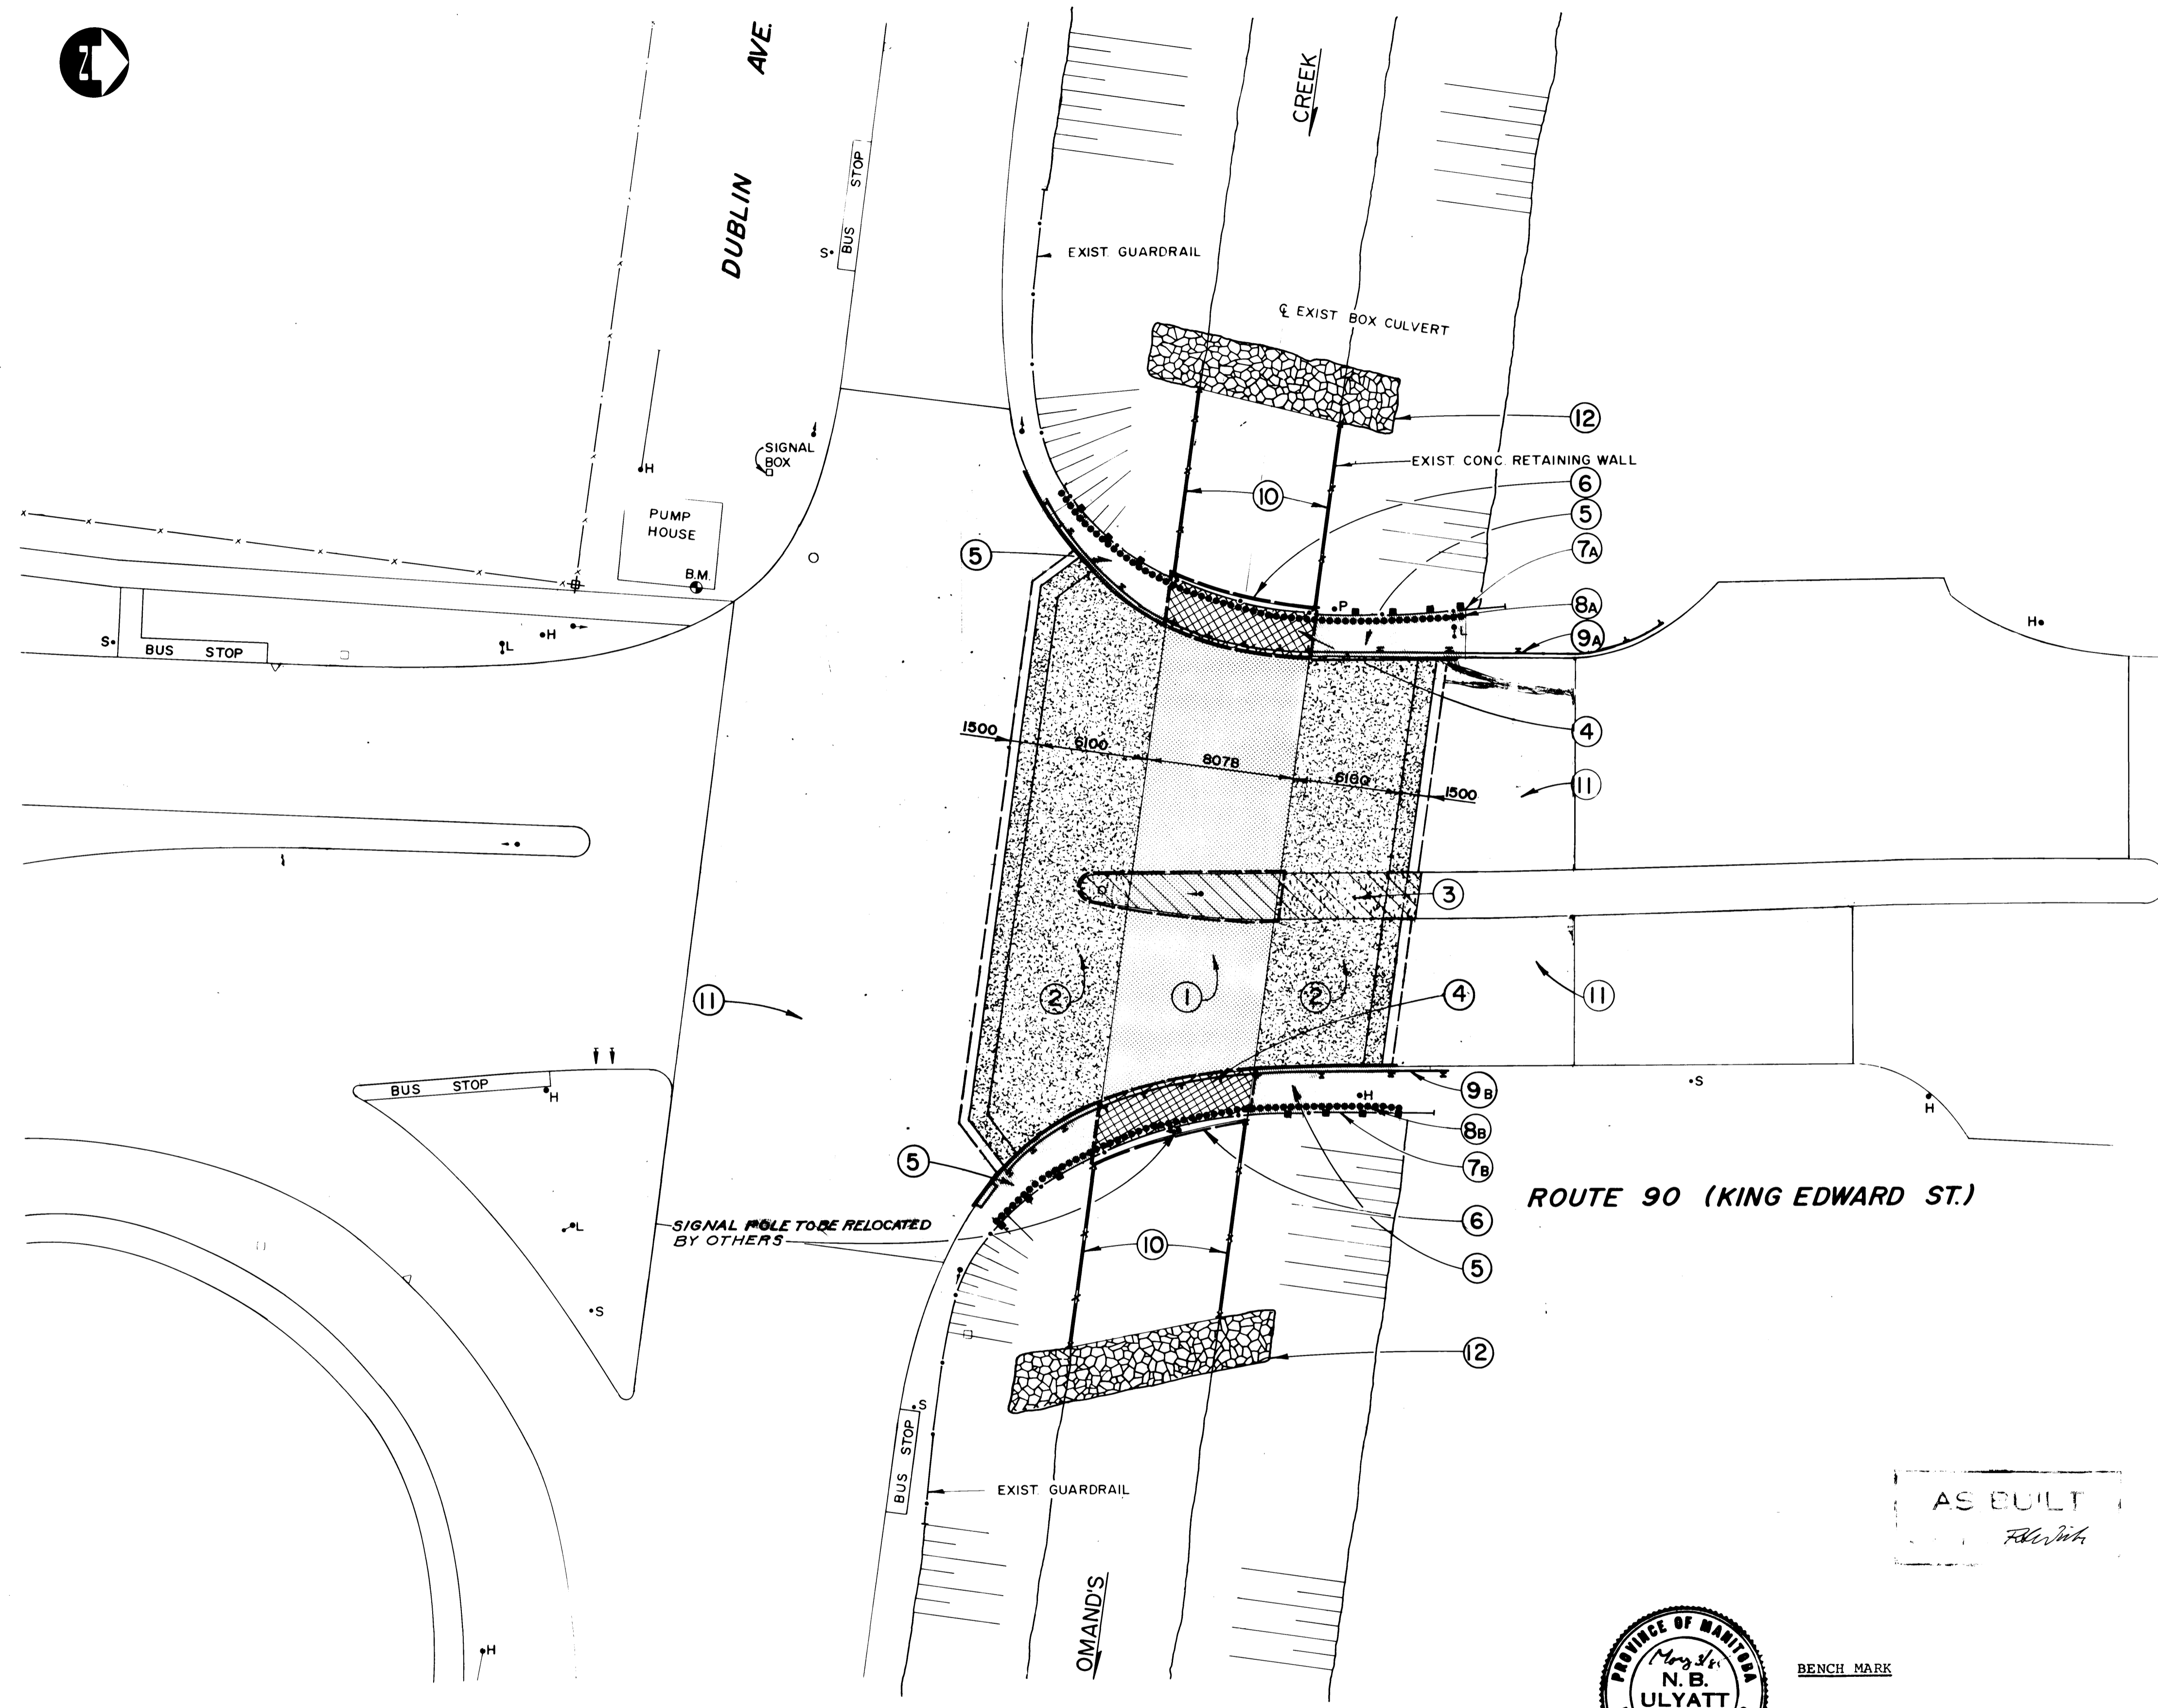

| PROPOSED WORKS | REFERENCE DRAWING NUMBER |
|--|--------------------------|
| 1 REMOVE EXISTING CONCRETE FROM MEDIAN SLAB, CULVERT WALLS, 25 - 50mm FROM CULVERT TOP SLAB. CONSTRUCT NEW APPROACH SLAB SEATS. PLACE ADDITIONAL REINFORCING STEEL, SAND BLAST EXISTING REINFORCING STEEL AND PLACE MIN. 100mm THICK HIGH DENSITY CONCRETE TOPPING | C315-85-04 |
| 2 REMOVE EXISTING APPROACH SLABS, CURBS, AND APPROACH SIDEWALK SLABS. CONSTRUCT NEW APPROACH SLABS | C315-85-04 |
| 3 CONSTRUCT NEW MONOLITHIC CONCRETE APPROACH MEDIAN SLAB | C315-85-04 |
| 4 CONSTRUCT CULVERT SIDEWALK MODIFICATIONS C/W MONOLITHIC PARAPET | C315-85-04 |
| 5 CONSTRUCTION OF NEW APPROACH STRUCTURAL SIDEWALK SLABS C/W MONOLITHIC PARAPET AND CAISSONS | C315-85-02,04 |
| 6 APPLY SURFACE MEMBRANE ON CULVERT SIDEWALKS | C315-85-04 |
| 7 REMOVE EXISTING FLEX-BEAM TRAFFIC/ PEDESTRIAN BARRIER | C315-85-02 |
| A - LENGTH = 54M B - LENGTH = 54M | |
| 8 INSTALL NEW ALUMINUM PEDESTRIAN HANDRAIL | C315-05-06 |
| A - LENGTH = 23.5M B - LENGTH = 23.5M | |
| 9 INSTALL NEW BALANCED ALUMINUM SHOULDER BARRIER | C315-85-07,08,09 |
| A - LENGTH = 37M B - LENGTH = 27M | |
| 10 INSTALL NEW GALVANIZED CHAINLINK FENCING ON HEADWALLS | C315-85-07 |
| 11 ASPHALT OVERLAY AND RELATED WORK | C315-85-05 |
| 12 INSTALL GROUTED FIELDSTONE RIPRAP | C315-85-07 |

NOTE: THE EXECUTION OF PROPOSED WORKS ABOVE SHALL BE IN ACCORDANCE WITH THE TRAFFIC ROUTING AND CONSTRUCTION SEQUENCE SHOWN ON DRAWING C315-85-03.

GENERAL NOTES


- STRUCTURAL CONCRETE:

| | 28-Day STRENGTH (MPa) | AGGR. (mm) | SLUMP (mm) | CEMENT TYPE | ENTRAINED AIR % |
|---|-----------------------|------------|------------|-------------|-----------------|
| A) APPROACH SLABS | 30 | 40 | 60 | 10 | 4 - 7 |
| B) APPROACH SLAB SEATS AND ALL OTHER CONCRETE | 30 | 20 | 80±25 | 50 | 5 - 8 |
| C) SIDEWALKS | 30 | 20 | 80±25 | 10 | 5 - 8 |
| D) CAISSONS | 30 | 40 | 100±25 | 50 | 3 - 6 |

REFER TO SPECS FOR ADDITIONAL PROPERTIES OF STRUCTURAL CONCRETE.
- REINFORCING STEEL SHALL BE NEW DEFORMED BILLET BARS TO CSA G30.12-M77 STIRRUPS AND TIES GRADE 300 ALL OTHER BARS GRADE 400
- ALL NEW TOP BARS AND ALL BARS MARKED THUS * SHALL BE FACTORY EPOXY COATED.
- ALL EXPOSED EXISTING REINFORCING STEEL SHALL BE SANDBLASTED UNLESS OTHERWISE SPECIFIED FOR REPLACEMENT WITH NEW EPOXY COATED BARS.
- MINIMUM LAP SPLICE LENGTHS SHALL BE 40 BAR DIAMETERS UNLESS OTHERWISE NOTED.
- CONCRETE CLEAR COVER TO REINFORCING STEEL SHALL BE 60mm UNLESS OTHERWISE NOTED.
- ALL EXPOSED CONCRETE EDGES SHALL BE CHAMFERED 13mm UNLESS OTHERWISE SHOWN.
- CONSTRUCTION JOINTS THAT ARE REQUIRED BUT NOT SHOWN ARE TO HAVE FORMED KEY AND MUST BE APPROVED BY THE ENGINEER.

ROUTE 90 (KING EDWARD ST.)

AS BUILT
File with

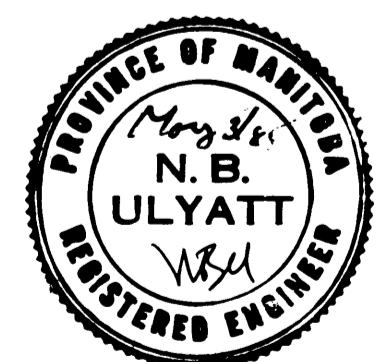

BENCH MARK

B.M. #23022 S.W. CORNER KING EDWARD STREET @ DUBLIN AVE. TBLT. IN EAST FOUNDATION OF PUMPING STATION 4 m. NORTH EAST. 1 m. BELOW TOP OF PLATFORM ELEVATION 234.879

B-5530-2
METRIC

WHOLE NUMBERS INDICATE MILLIMETRES
DECIMALIZED NUMBERS INDICATE METRES

PLAN

| ITEM | EXISTING | PROPOSED |
|--------------------------|----------|----------|
| POLES - HYDRO(H) MTS.(T) | — | — |
| SIGNAL POLE | — | — |
| LIGHT STANDARD | — | — |
| SURVEY BAR | — | — |
| FIRE HYDRANT | — | — |
| WATER VALVE | — | — |
| EDGE OF PAV'T NO CURB | — | — |
| EDGE OF PAV'T CURBED | — | — |
| EDGE PAV'T CURB & GUTTER | — | — |
| PARAPLEGIC RAMP | — | — |
| ELEVATIONS | 40265 | (40265) |
| ASPHALT OVERLAY | — | — |
| PROPERTY LINE | — | — |
| MANHOLE | ○ | ● |
| CATCH BASIN | □ | ■ |
| CATCH BASIN INLET | ▽ | ▼ |

WARNING

IF POWER EQUIPMENT OR EXPLOSIVES ARE TO BE USED FOR EXCAVATION ON THIS PROJECT THE CONTRACTOR MUST:

1. NOTIFY THE GAS COMPANY OF THE PROPOSED LOCATION OF EXCAVATION.
2. TAKE PRECAUTION TO AVOID DAMAGE TO GAS COMPANY INSTALLATIONS.

SEE PROVINCIAL REGULATION 270-72 FOR DETAILS

| LOCATION APPROVED | DATE | SUPERVISOR |
|------------------------|------|------------|
| UNDERGROUND STRUCTURES | | |

LOCATIONS OF UNDERGROUND STRUCTURES AS SHOWN ARE BASED ON THE BEST INFORMATION AVAILABLE BUT NO GUARANTEE IS GIVEN THAT ALL EXISTING UTILITIES ARE SHOWN OR THAT THE GIVEN LOCATIONS ARE EXACT CONFIRMATION OF EXISTENCE AND EXACT LOCATION OF ALL SERVICES MUST BE OBTAINED FROM THE INDIVIDUAL UTILITIES BEFORE PROCEEDING WITH CONSTRUCTION



DILLON
Consulting Engineers & Planners

S.S.R. C.R.B.
N.B.U. MAY/85

APPROVED BY: *W.B. Ulyatt* DATE: *1985-05-03*

THE CITY OF WINNIPEG




WORKS & OPERATIONS DIVISION
STREETS & TRANSPORTATION DEPARTMENT

ROUTE 90 CULVERT AT OMAND'S CREEK
TOP SLAB REHABILITATION, STRUCTURAL STRENGTHENING AND RELATED WORKS

GENERAL ARRANGEMENT AND LOCATION OF PROPOSED WORKS

APPROVED BY: *W.B. Ulyatt* DATE: *1985-05-03*

SCALE 1:200 DRAWING NO. C315-85-02

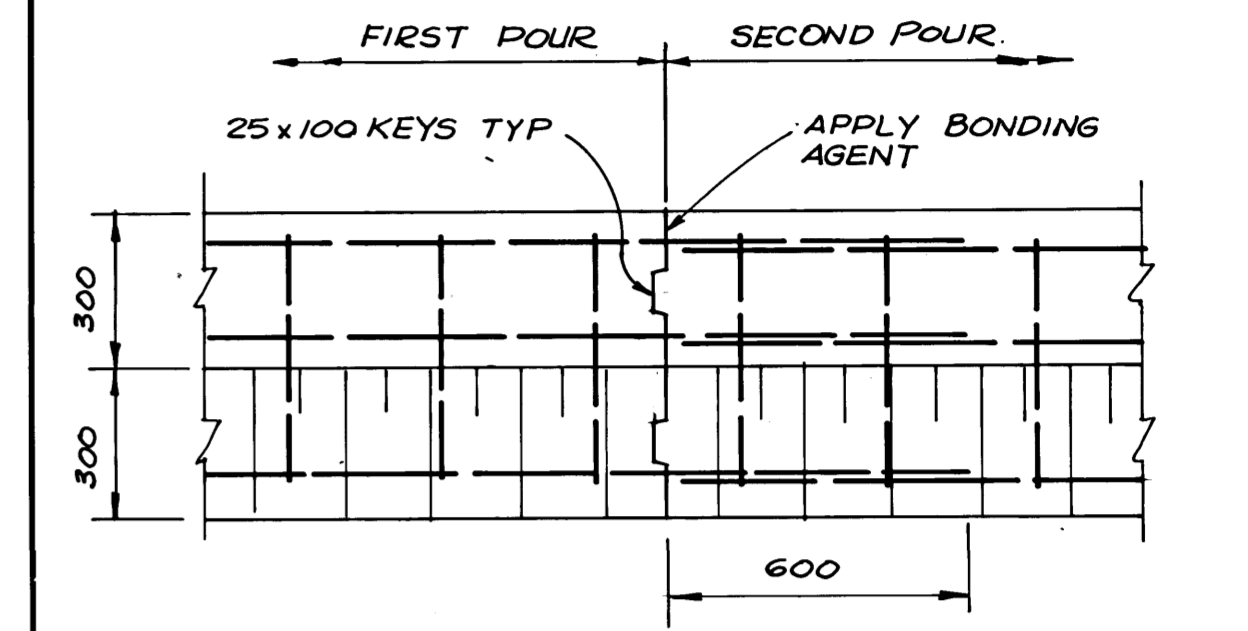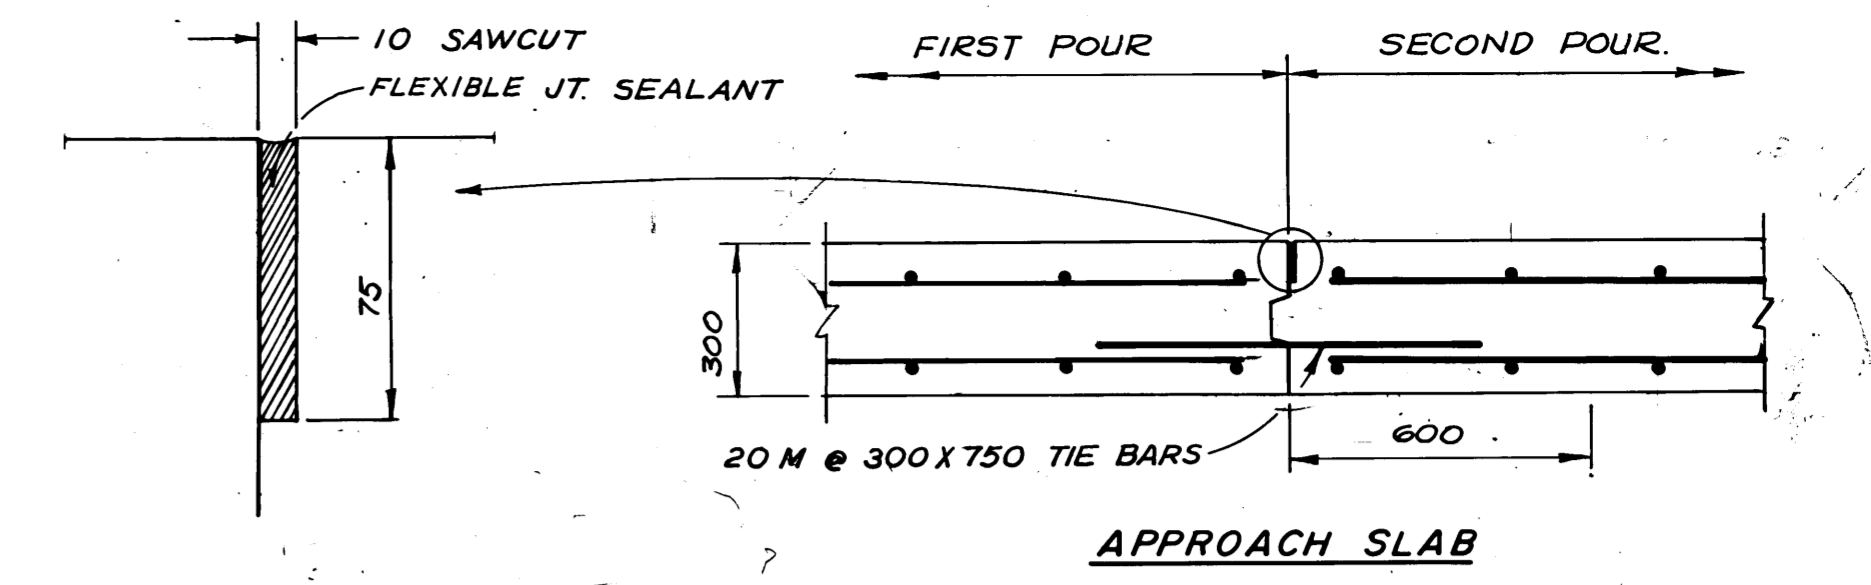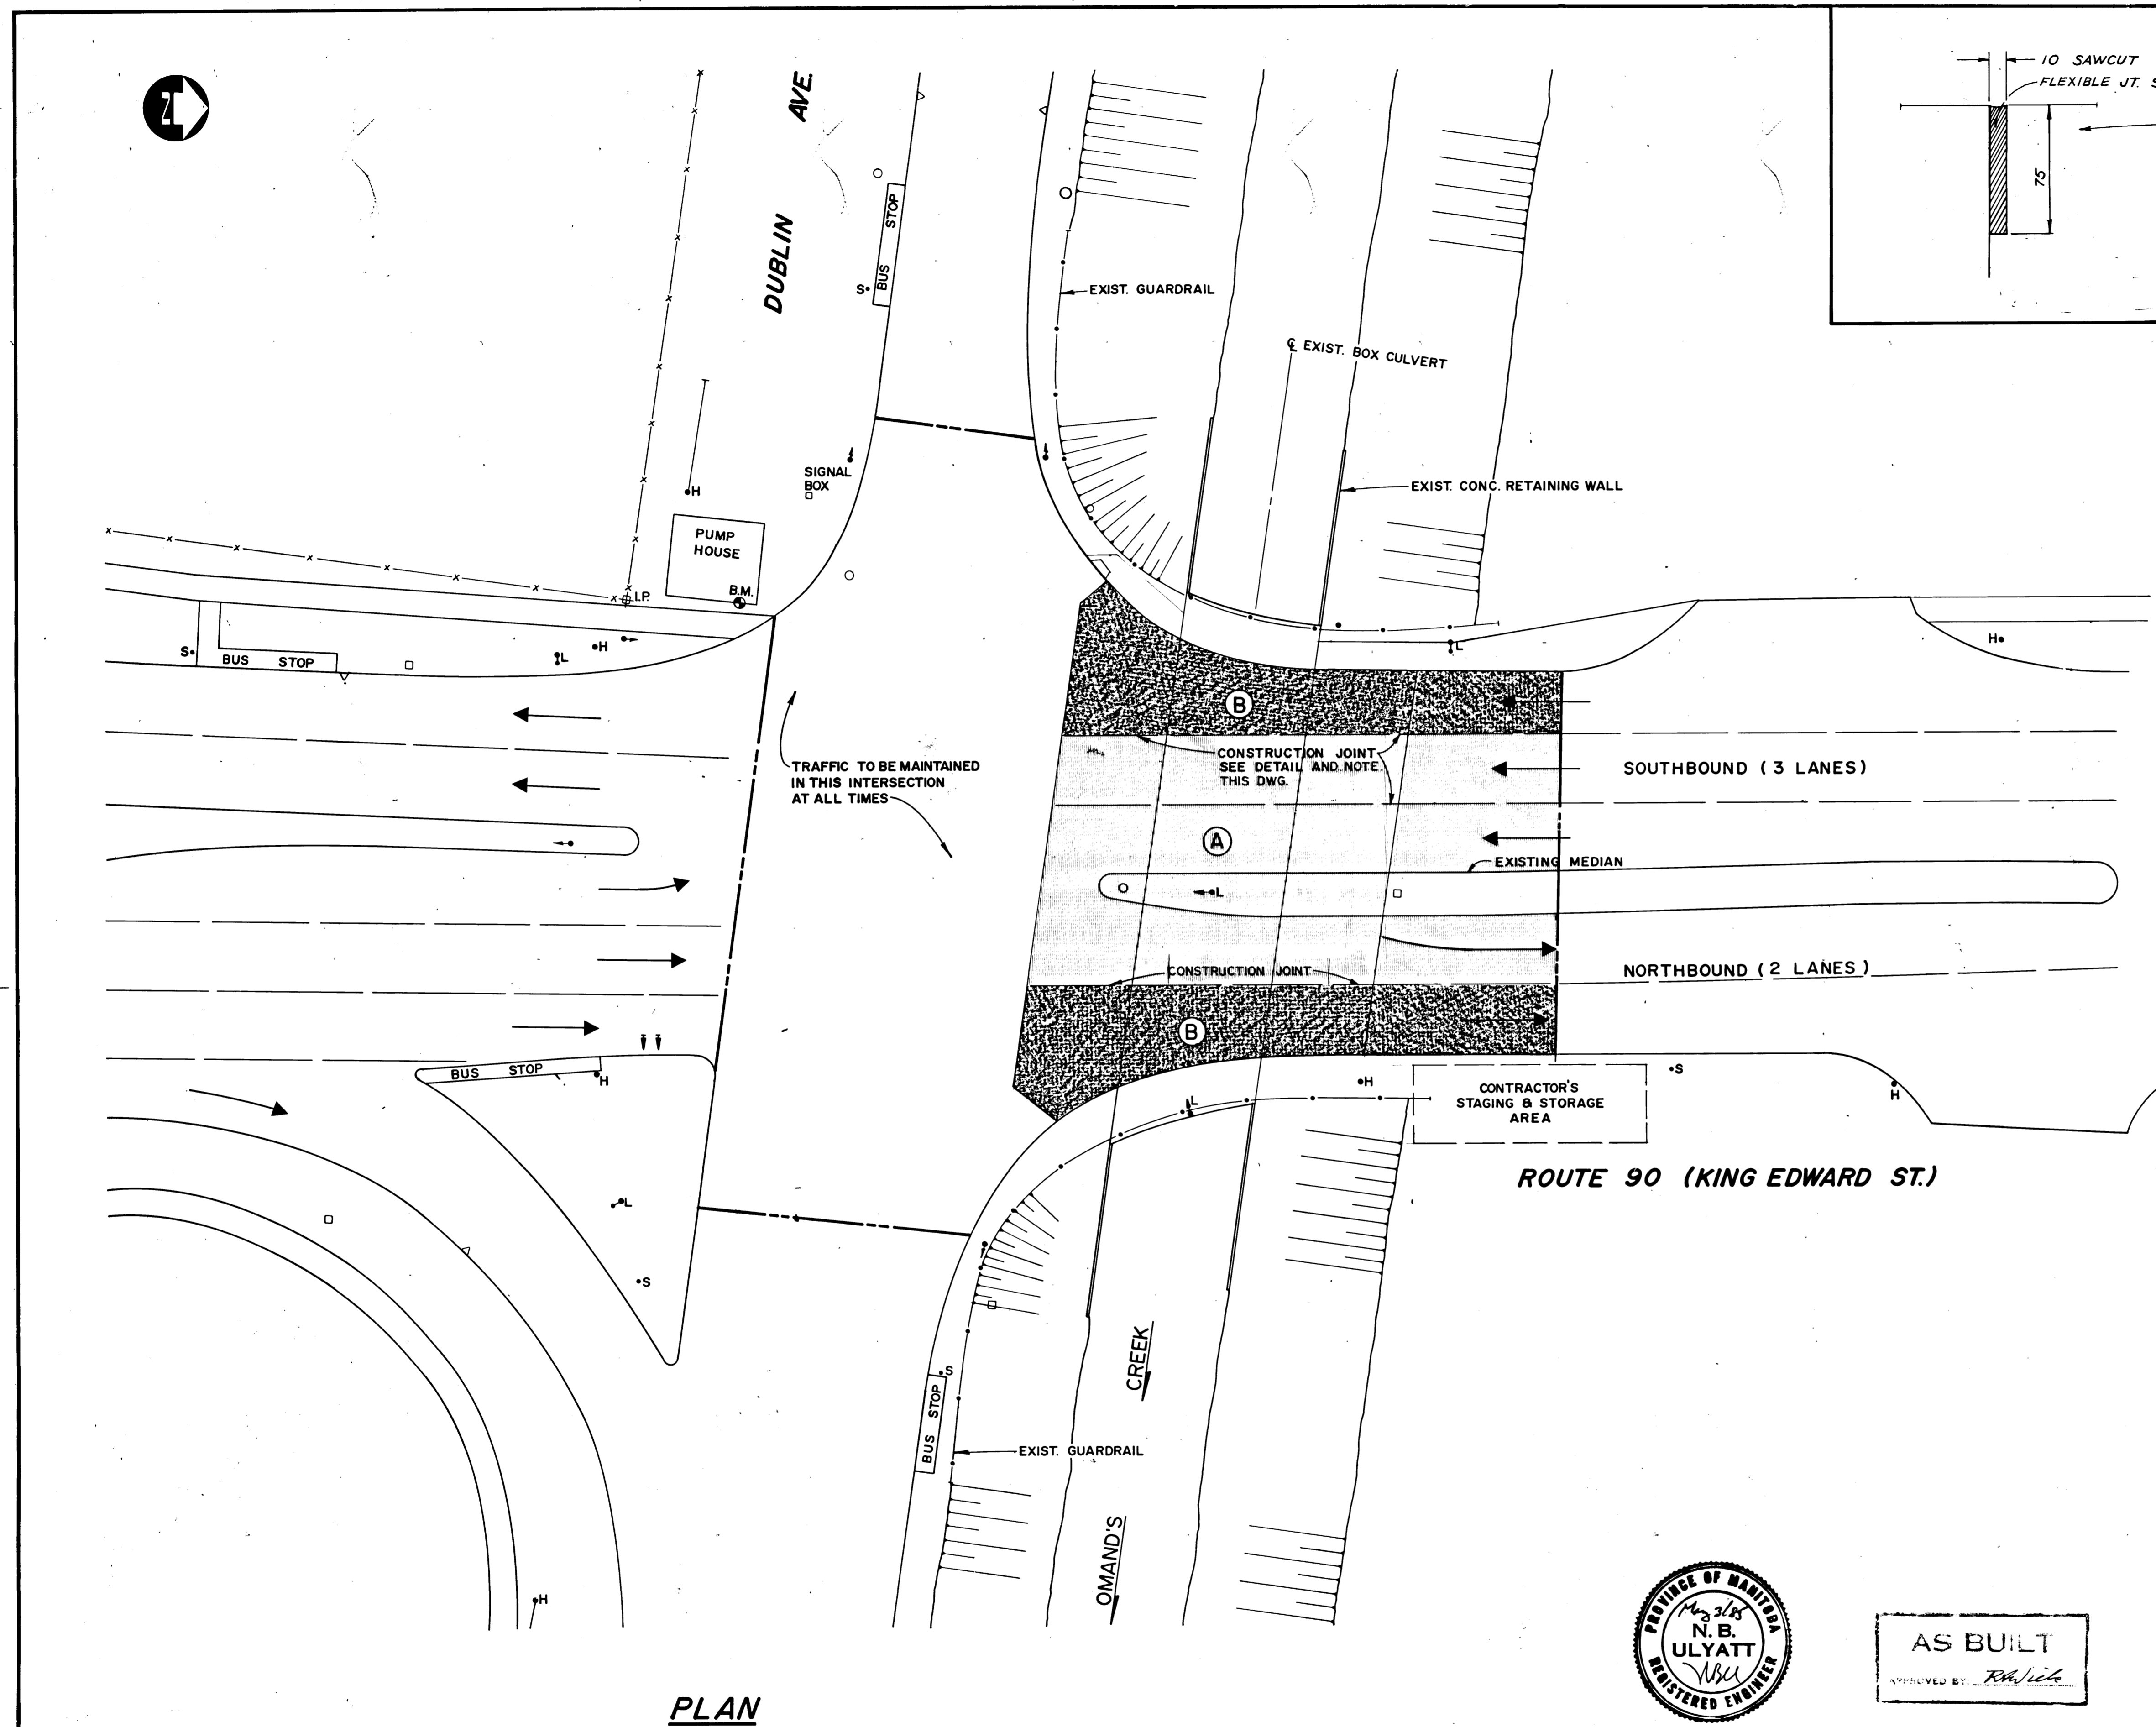


CONSTRUCTION JOINTS
1:15

- NOTES**
1. CONCRETE SHEAR KEY IS NOT REQ'D. FOR CONST. JT. @ R/W KING EDWARD.
 2. BOTTOM LAYER OF REINFORCING STL. SHALL BE CONTINUOUS @ CONST. JT. @ R/W KING EDWARD.





- CONSTRUCTION SEQUENCE**
1. AT LEAST ONE LANE OF TRAFFIC IS TO BE MAINTAINED IN THE NORTHBOUND AND SOUTHBOUND DIRECTIONS AT ALL TIMES.
 2. THE WORKS SHALL BE UNDERTAKEN IN STAGES. CLOSURES BY THE CONTRACTOR WILL BE PERMITTED SEPARATELY IN AREAS "A" AND "B" IN THE SEQUENCE INDICATED BELOW. PARTIAL CLOSURES BY THE CONTRACTOR WILL BE ALLOWED FOR ASPHALT RESURFACING AND ALL OTHER RELATED WORKS WHILE MAINTAINING TRAFFIC IN THE INTERSECTION.
 - A) STAGE I: CONSTRUCT APPLICABLE PORTIONS OF CONCRETE WORKS (1), (2), (4), (5), (6), AND (11) (SEE DRAWING C315-85-02) BY CLOSING AREA "A" BUT KEEPING AREA "B" OPEN TO TRAFFIC.
 - B) STAGE II: CONSTRUCT APPLICABLE PORTIONS OF CONCRETE WORKS (1), (2), (3), AND (6) IN AREA "B" WHILE KEEPING AREA "A" OPEN TO TRAFFIC.
 - C) STAGE III: CARRY OUT ASPHALT RESURFACING IN ONE LANE AT A TIME AFTER COMPLETION OF STAGE I AND II.
 3. ANY REQUEST FOR DEVIATION FROM THE ABOVE IDENTIFIED CONSTRUCTION SEQUENCE MUST BE SUBMITTED TO THE ENGINEER IN WRITING WITH AT LEAST SEVEN (7) DAYS NOTICE.
 4. AT LEAST ONE OF THE TWO EXISTING TRAFFIC SIGNAL LIGHTS FOR NORTHBOUND TRAFFIC LOCATED ON THE STRUCTURE IS TO REMAIN IN SERVICE AT ALL TIMES DURING STAGE I AND STAGE II WORKS.
 5. INSTALLATION OF TEMPORARY OVERHEAD POWER LINES AS WELL AS REMOVAL AND REINSTALLATION OF THE SIGNAL POLES WILL BE CARRIED OUT BY OTHERS.

PLAN

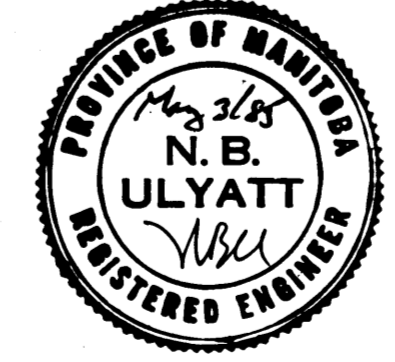

B-5530-3

| <table border="1"> <thead> <tr> <th>ITEM</th> <th>EXISTING</th> <th>PROPOSED</th> </tr> </thead> <tbody> <tr> <td>POLES - HYDRO(H) MTS (T)</td> <td>—</td> <td>—</td> </tr> <tr> <td>SIGNAL POLE</td> <td>—</td> <td>—</td> </tr> <tr> <td>LIGHT STANDARD</td> <td>—</td> <td>—</td> </tr> <tr> <td>SURVEY BAR</td> <td>—</td> <td>—</td> </tr> <tr> <td>FIRE HYDRANT</td> <td>—</td> <td>—</td> </tr> <tr> <td>WATER VALVE</td> <td>—</td> <td>—</td> </tr> <tr> <td>EDGE OF PAV'T NO CURB</td> <td>—</td> <td>—</td> </tr> <tr> <td>EDGE PAV'T CURB & GUTTER</td> <td>—</td> <td>—</td> </tr> <tr> <td>PARAPLEGIC RAMP</td> <td>—</td> <td>—</td> </tr> <tr> <td>ELEVATIONS</td> <td>40.265</td> <td>(40.265)</td> </tr> <tr> <td>ASPHALT OVERLAY</td> <td>—</td> <td>—</td> </tr> <tr> <td>PROPERTY LINE</td> <td>—</td> <td>—</td> </tr> <tr> <td>MANHOLE</td> <td>—</td> <td>—</td> </tr> <tr> <td>CATCH BASIN</td> <td>—</td> <td>—</td> </tr> <tr> <td>CATCH BASIN INLET</td> <td>—</td> <td>—</td> </tr> </tbody> </table> | ITEM | EXISTING | PROPOSED | POLES - HYDRO(H) MTS (T) | — | — | SIGNAL POLE | — | — | LIGHT STANDARD | — | — | SURVEY BAR | — | — | FIRE HYDRANT | — | — | WATER VALVE | — | — | EDGE OF PAV'T NO CURB | — | — | EDGE PAV'T CURB & GUTTER | — | — | PARAPLEGIC RAMP | — | — | ELEVATIONS | 40.265 | (40.265) | ASPHALT OVERLAY | — | — | PROPERTY LINE | — | — | MANHOLE | — | — | CATCH BASIN | — | — | CATCH BASIN INLET | — | — | <p>WARNING</p> <p>IF POWER EQUIPMENT OR EXPLOSIVES ARE TO BE USED FOR EXCAVATION ON THIS PROJECT THE CONTRACTOR MUST:</p> <ol style="list-style-type: none"> 1) NOTIFY THE GAS COMPANY OF THE PROPOSED LOCATION OF EXCAVATION. 2) TAKE PRECAUTION TO AVOID DAMAGE TO GAS COMPANY INSTALLATIONS. <p>SEE PROVINCIAL REGULATION 210/72 FOR DETAILS</p> | <p>LOCATION APPROVED UNDERGROUND STRUCTURES</p> <p>DATE _____ SUPERVISOR _____</p> <p>LOCATIONS OF UNDERGROUND STRUCTURES AS SHOWN ARE BASED ON THE BEST INFORMATION AVAILABLE BUT NO GUARANTEE IS GIVEN THAT ALL EXISTING UTILITIES ARE SHOWN OR THAT THE GIVEN LOCATIONS ARE EXACT CONFIRMATION OF EXISTENCE AND EXACT LOCATION OF ALL SERVICES MUST BE OBTAINED FROM THE INDIVIDUAL UTILITIES BEFORE PROCEEDING WITH CONSTRUCTION</p> | <table border="1"> <thead> <tr> <th>NO</th> <th>REVISIONS</th> <th>DATE</th> <th>APP</th> </tr> </thead> <tbody> <tr> <td> </td> <td> </td> <td> </td> <td> </td> </tr> </tbody> </table> | NO | REVISIONS | DATE | APP | | | | | <p>DILLON Consulting Engineers & Planners</p> <p>DESIGNED BY: S.S.R. DRAWN BY: C.R.B.</p> <p>CHECKED BY: N.B.U. DATE: MAY/85</p> <p>APPROVED BY: [Signature] DATE: [Signature]</p> | <p>THE CITY OF WINNIPEG WORKS & OPERATIONS DIVISION STREETS & TRANSPORTATION DEPARTMENT</p> | <p>ROUTE 90 CULVERT AT OMAND'S CREEK TOP SLAB REHABILITATION, STRUCTURAL STRENGTHENING AND RELATED WORKS</p> <p>TRAFFIC ROUTING AND CONSTRUCTION SEQUENCE</p> <p>AUTHORIZED BY: [Signature] DATE: 1985-05-03</p> <p>ACCEPTED BY: [Signature] DATE: 1985-05-03</p> <p>SCALE: 1:200 DRAWING NO: C315-85-03</p> |
|---|
| ITEM | EXISTING | PROPOSED | | | | | | | | | | | | | | | | | | | | | | | | | | | | | | | | | | | | | | | | | | | | | | | | | | | | | | | | | | | | |
| POLES - HYDRO(H) MTS (T) | — | — | | | | | | | | | | | | | | | | | | | | | | | | | | | | | | | | | | | | | | | | | | | | | | | | | | | | | | | | | | | | |
| SIGNAL POLE | — | — | | | | | | | | | | | | | | | | | | | | | | | | | | | | | | | | | | | | | | | | | | | | | | | | | | | | | | | | | | | | |
| LIGHT STANDARD | — | — | | | | | | | | | | | | | | | | | | | | | | | | | | | | | | | | | | | | | | | | | | | | | | | | | | | | | | | | | | | | |
| SURVEY BAR | — | — | | | | | | | | | | | | | | | | | | | | | | | | | | | | | | | | | | | | | | | | | | | | | | | | | | | | | | | | | | | | |
| FIRE HYDRANT | — | — | | | | | | | | | | | | | | | | | | | | | | | | | | | | | | | | | | | | | | | | | | | | | | | | | | | | | | | | | | | | |
| WATER VALVE | — | — | | | | | | | | | | | | | | | | | | | | | | | | | | | | | | | | | | | | | | | | | | | | | | | | | | | | | | | | | | | | |
| EDGE OF PAV'T NO CURB | — | — | | | | | | | | | | | | | | | | | | | | | | | | | | | | | | | | | | | | | | | | | | | | | | | | | | | | | | | | | | | | |
| EDGE PAV'T CURB & GUTTER | — | — | | | | | | | | | | | | | | | | | | | | | | | | | | | | | | | | | | | | | | | | | | | | | | | | | | | | | | | | | | | | |
| PARAPLEGIC RAMP | — | — | | | | | | | | | | | | | | | | | | | | | | | | | | | | | | | | | | | | | | | | | | | | | | | | | | | | | | | | | | | | |
| ELEVATIONS | 40.265 | (40.265) | | | | | | | | | | | | | | | | | | | | | | | | | | | | | | | | | | | | | | | | | | | | | | | | | | | | | | | | | | | | |
| ASPHALT OVERLAY | — | — | | | | | | | | | | | | | | | | | | | | | | | | | | | | | | | | | | | | | | | | | | | | | | | | | | | | | | | | | | | | |
| PROPERTY LINE | — | — | | | | | | | | | | | | | | | | | | | | | | | | | | | | | | | | | | | | | | | | | | | | | | | | | | | | | | | | | | | | |
| MANHOLE | — | — | | | | | | | | | | | | | | | | | | | | | | | | | | | | | | | | | | | | | | | | | | | | | | | | | | | | | | | | | | | | |
| CATCH BASIN | — | — | | | | | | | | | | | | | | | | | | | | | | | | | | | | | | | | | | | | | | | | | | | | | | | | | | | | | | | | | | | | |
| CATCH BASIN INLET | — | — | | | | | | | | | | | | | | | | | | | | | | | | | | | | | | | | | | | | | | | | | | | | | | | | | | | | | | | | | | | | |
| NO | REVISIONS | DATE | APP | | | | | | | | | | | | | | | | | | | | | | | | | | | | | | | | | | | | | | | | | | | | | | | | | | | | | | | | | | | |
| | | | | | | | | | | | | | | | | | | | | | | | | | | | | | | | | | | | | | | | | | | | | | | | | | | | | | | | | | | | | | | |

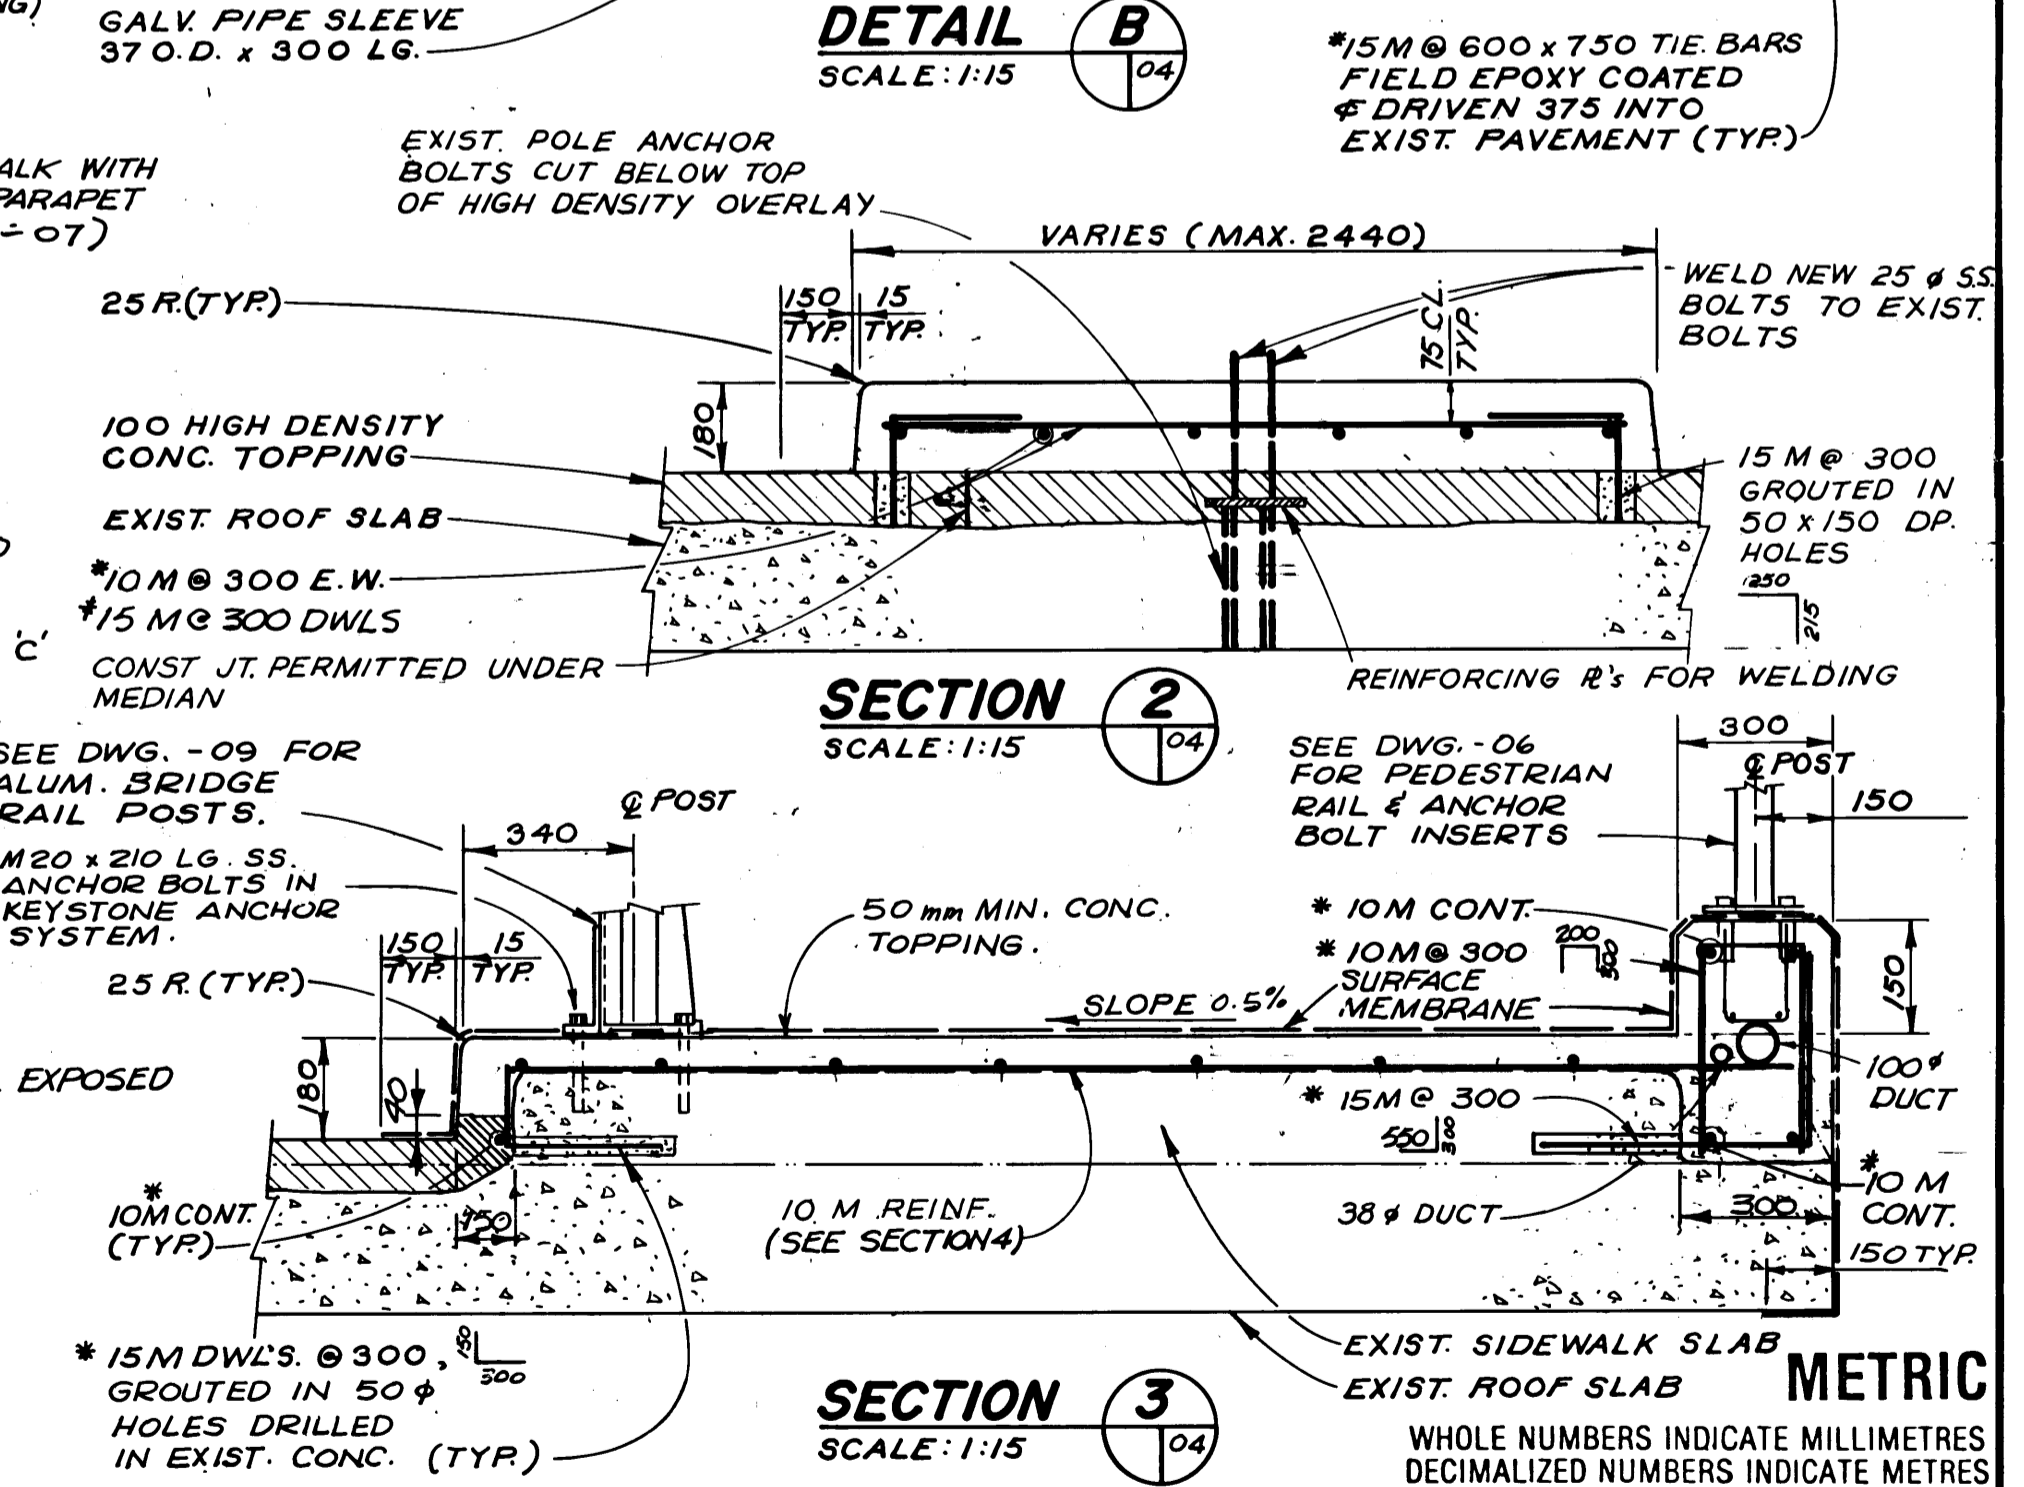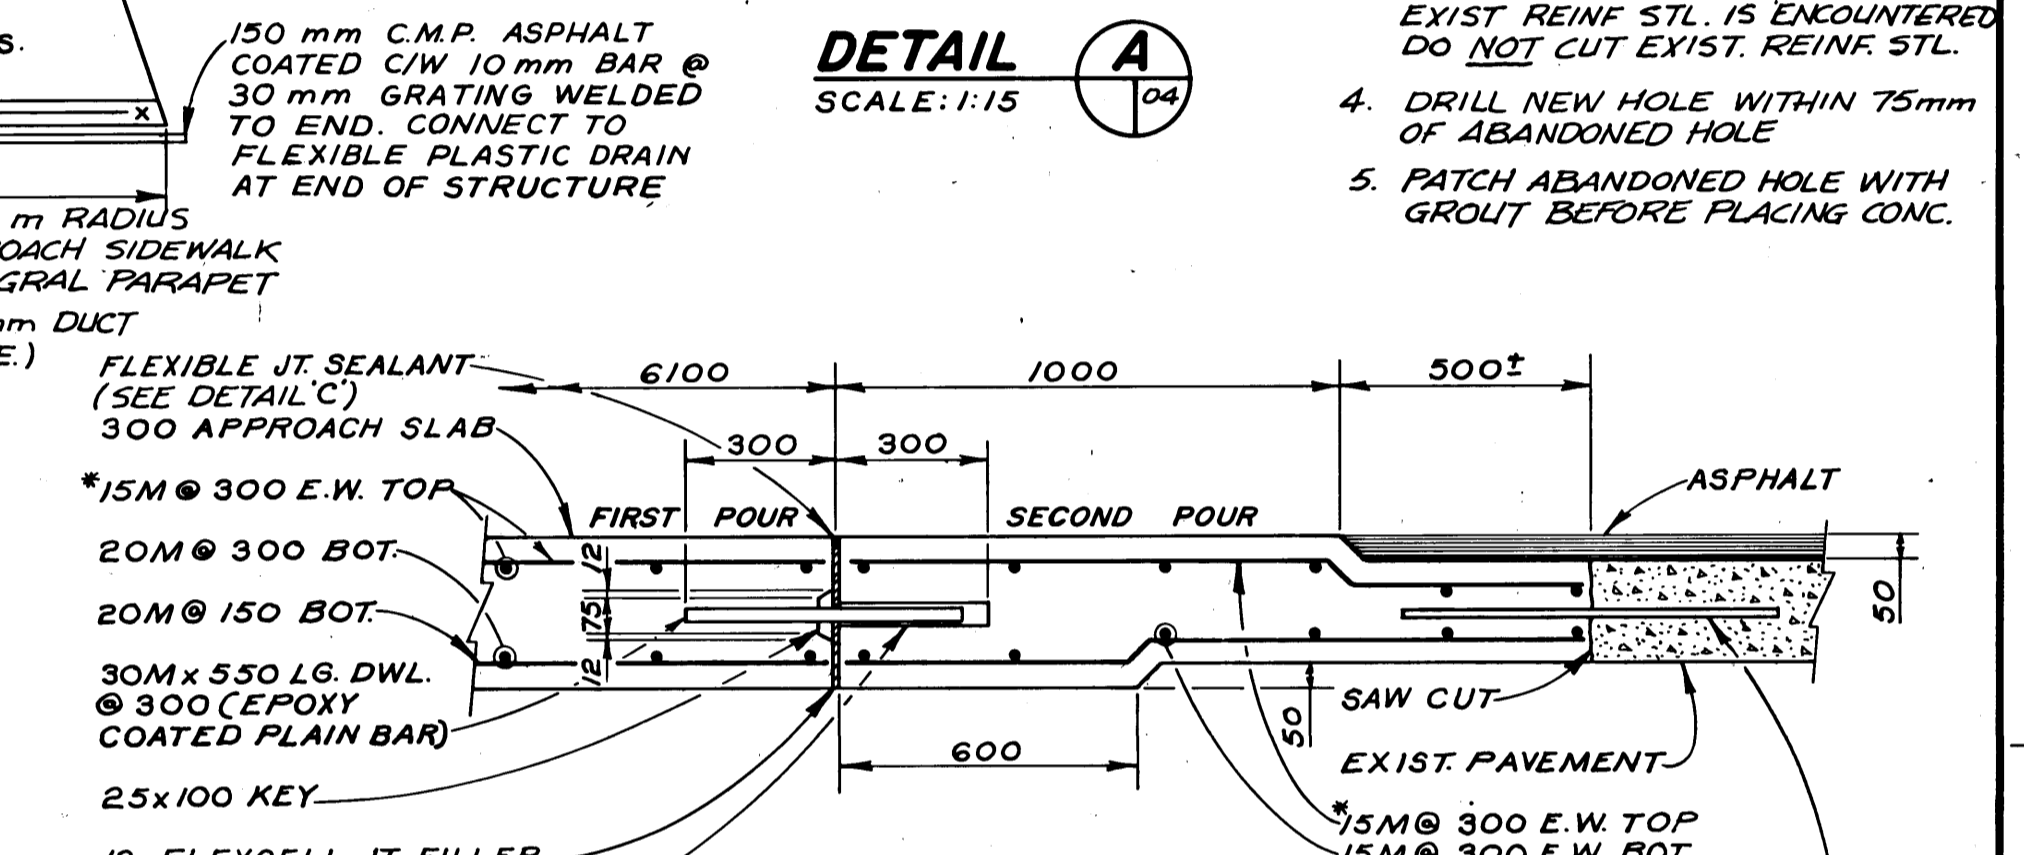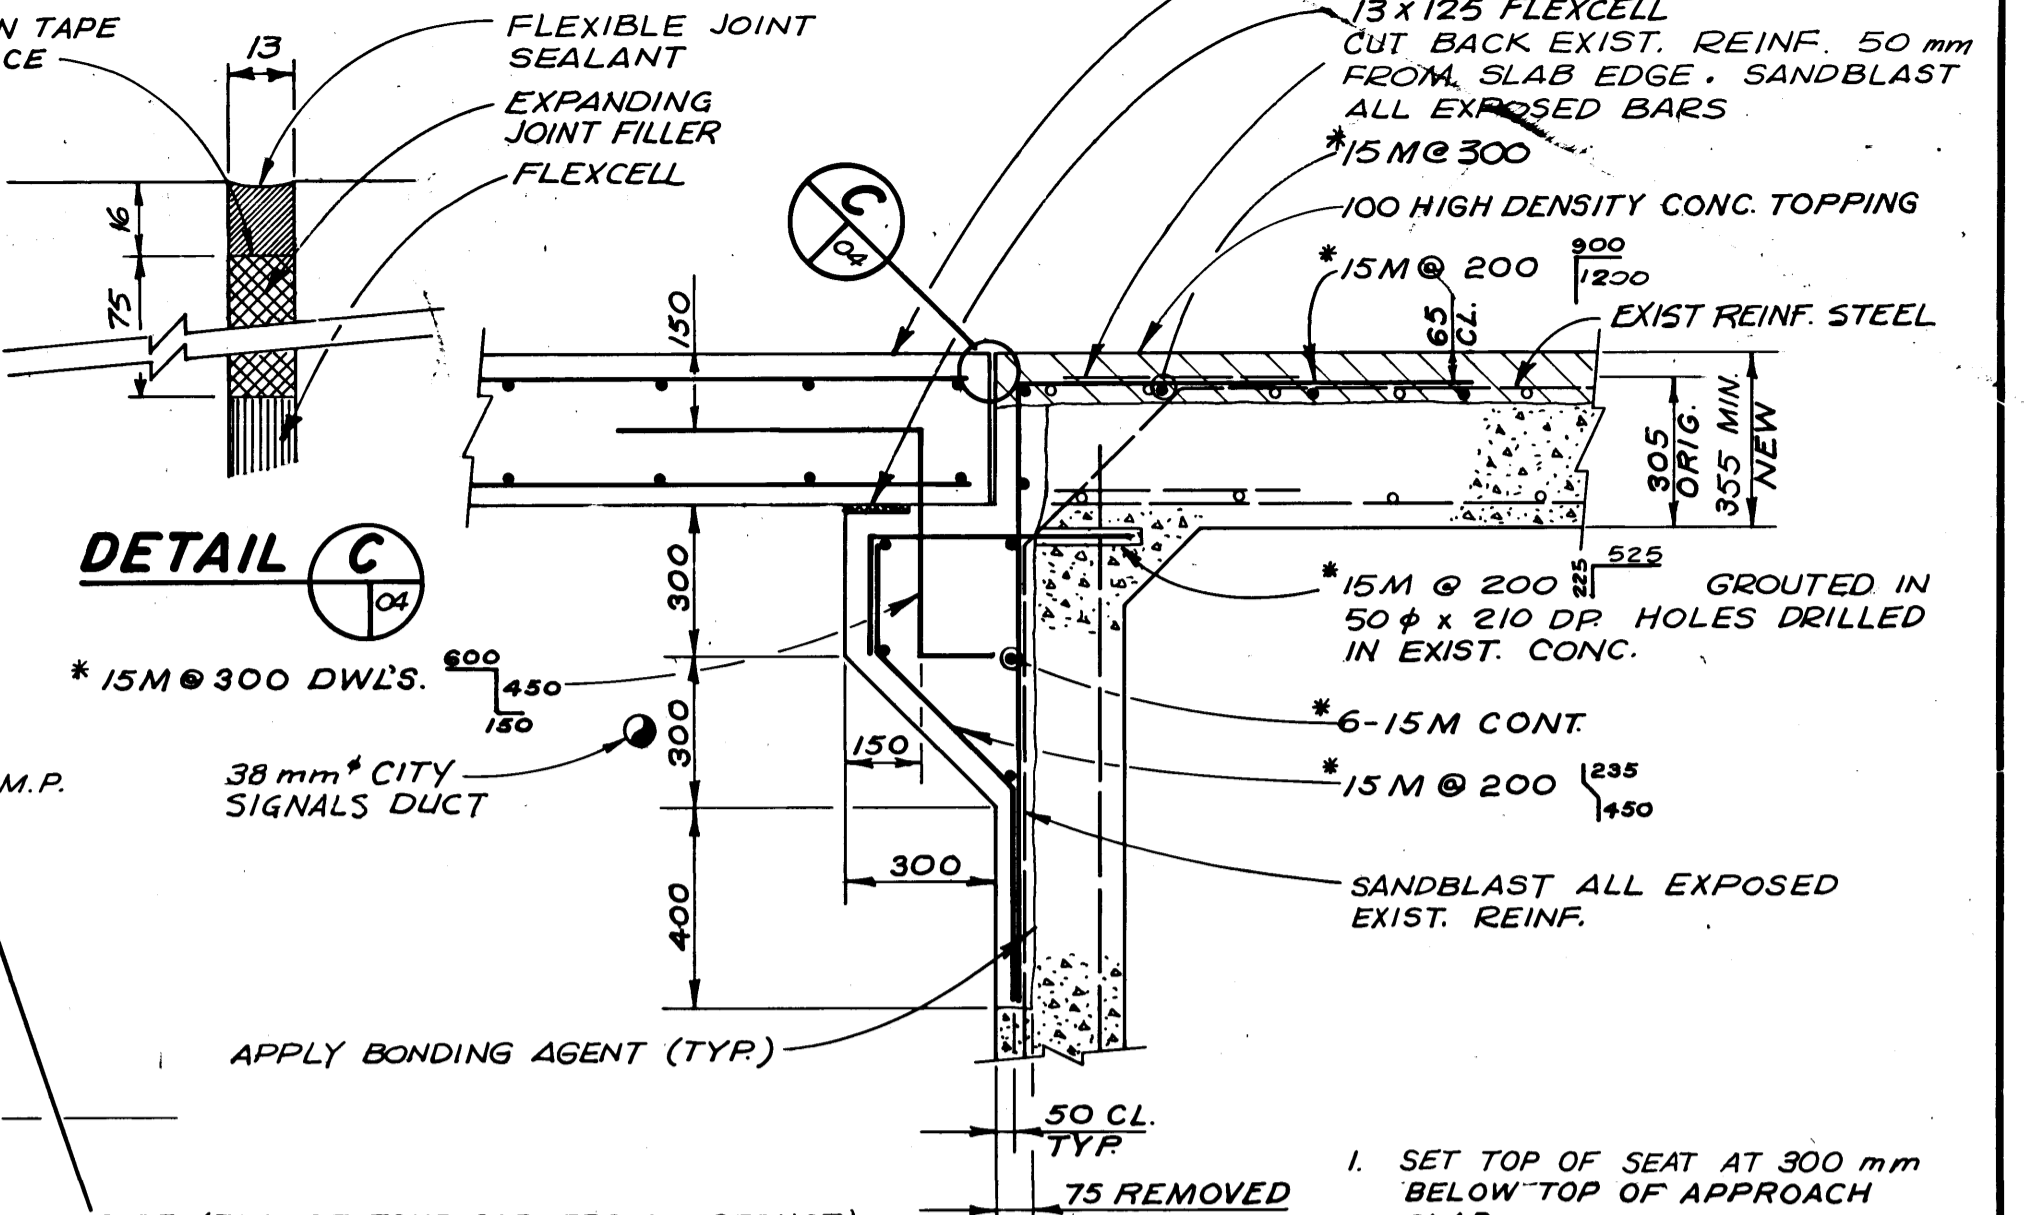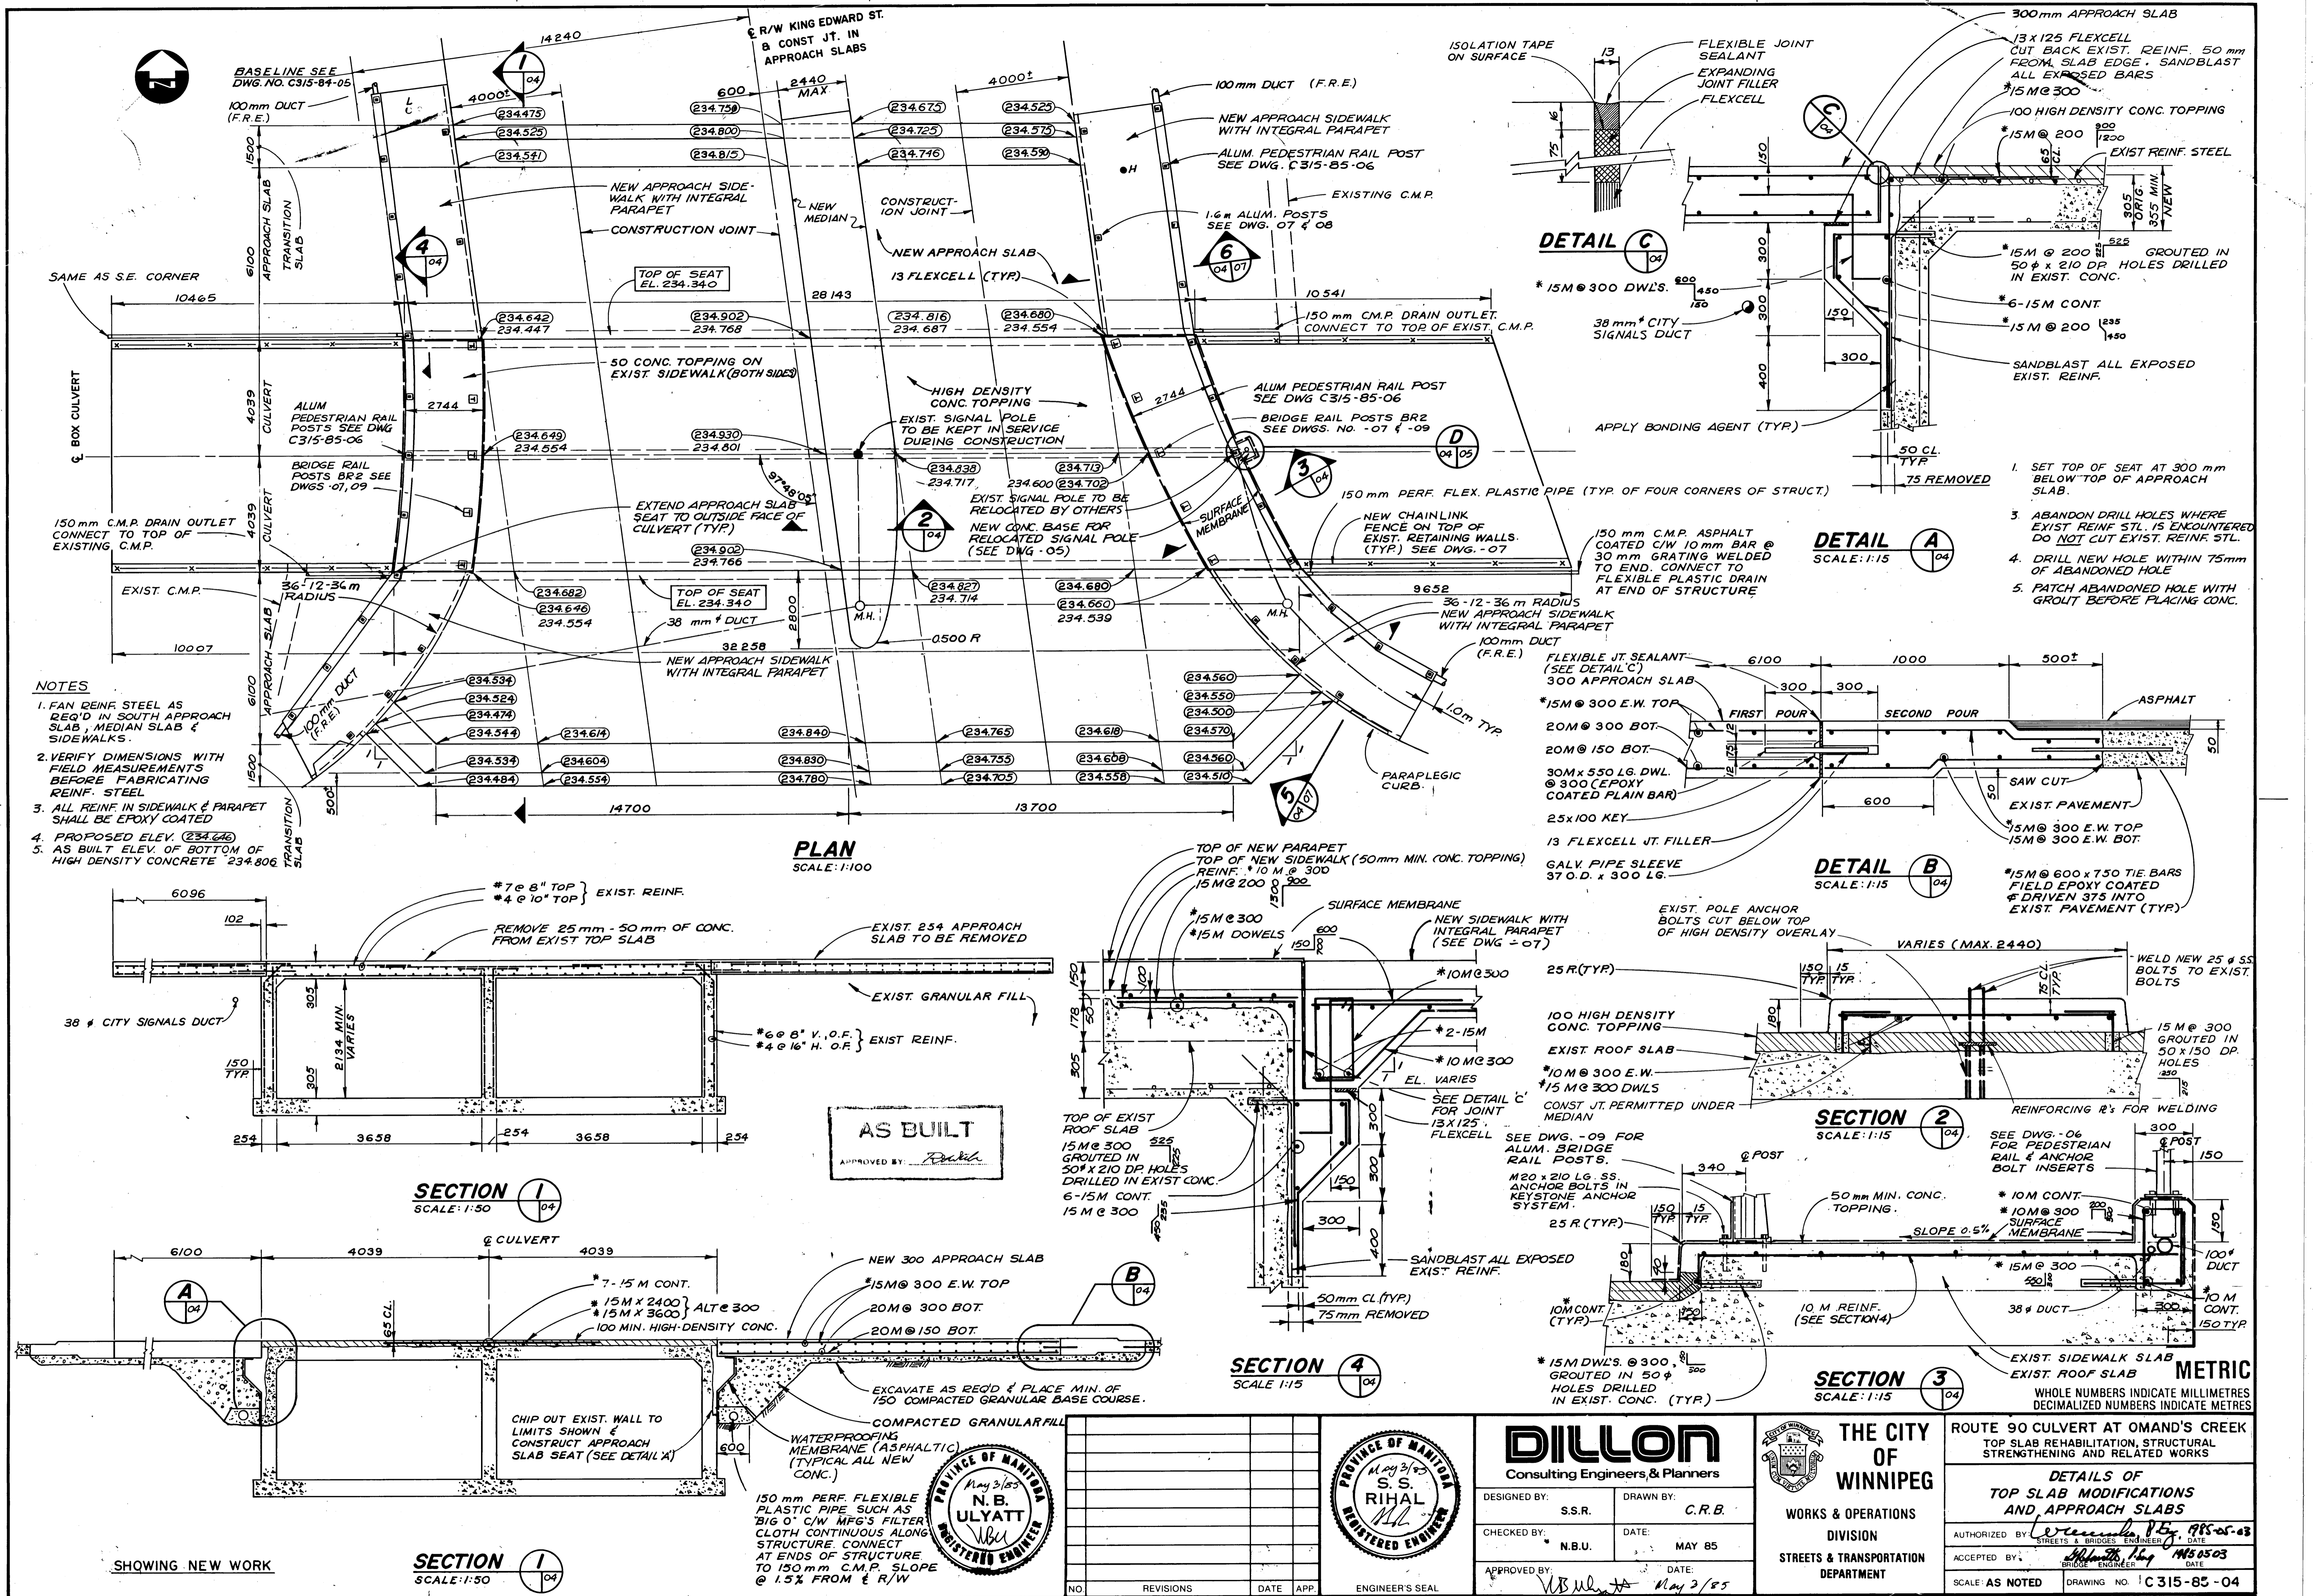

- NOTES**
1. FAN REINF. STEEL AS REQ'D IN SOUTH APPROACH SLAB, MEDIAN SLAB & SIDEWALKS.
 2. VERIFY DIMENSIONS WITH FIELD MEASUREMENTS BEFORE FABRICATING REINF. STEEL
 3. ALL REINF. IN SIDEWALK & PARAPET SHALL BE EPOXY COATED
 4. PROPOSED ELEV. (234.44)
 5. AS BUILT ELEV. OF BOTTOM OF HIGH DENSITY CONCRETE 234.806

PLAN
SCALE: 1:100

AS BUILT
APPROVED BY: *[Signature]*

SECTION 1
SCALE: 1:50

SECTION 4
SCALE: 1:15



SECTION 2
SCALE: 1:15

SECTION 3
SCALE: 1:15

METRIC
WHOLE NUMBERS INDICATE MILLIMETRES
DECIMALIZED NUMBERS INDICATE METRES

SHOWING NEW WORK

SECTION 1
SCALE: 1:50



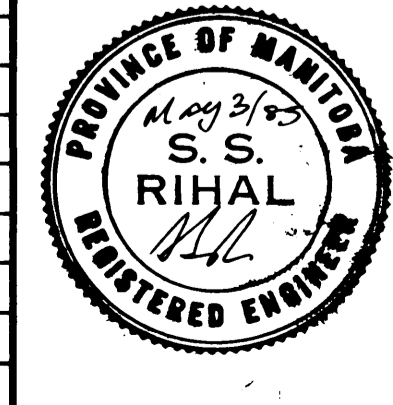
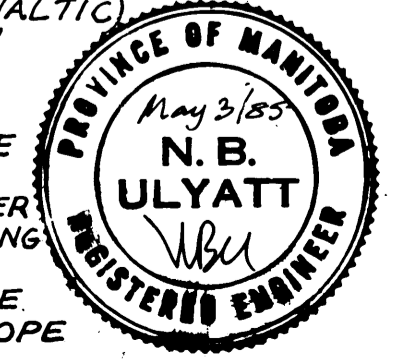


DILLON
Consulting Engineers & Planners

DESIGNED BY: S.S.R. DRAWN BY: C.R.B.
CHECKED BY: N.B.U. DATE: MAY 85
APPROVED BY: *[Signature]* DATE: May 2/85

THE CITY OF WINNIPEG
WORKS & OPERATIONS
DIVISION
STREETS & TRANSPORTATION
DEPARTMENT

ROUTE 90 CULVERT AT OMAND'S CREEK
TOP SLAB REHABILITATION, STRUCTURAL
STRENGTHENING AND RELATED WORKS
**DETAILS OF
TOP SLAB MODIFICATIONS
AND APPROACH SLABS**
AUTHORIZED BY: *[Signature]* 885-05-83
ACCEPTED BY: *[Signature]* MS 0503
SCALE: AS NOTED DRAWING NO: C315-85-04

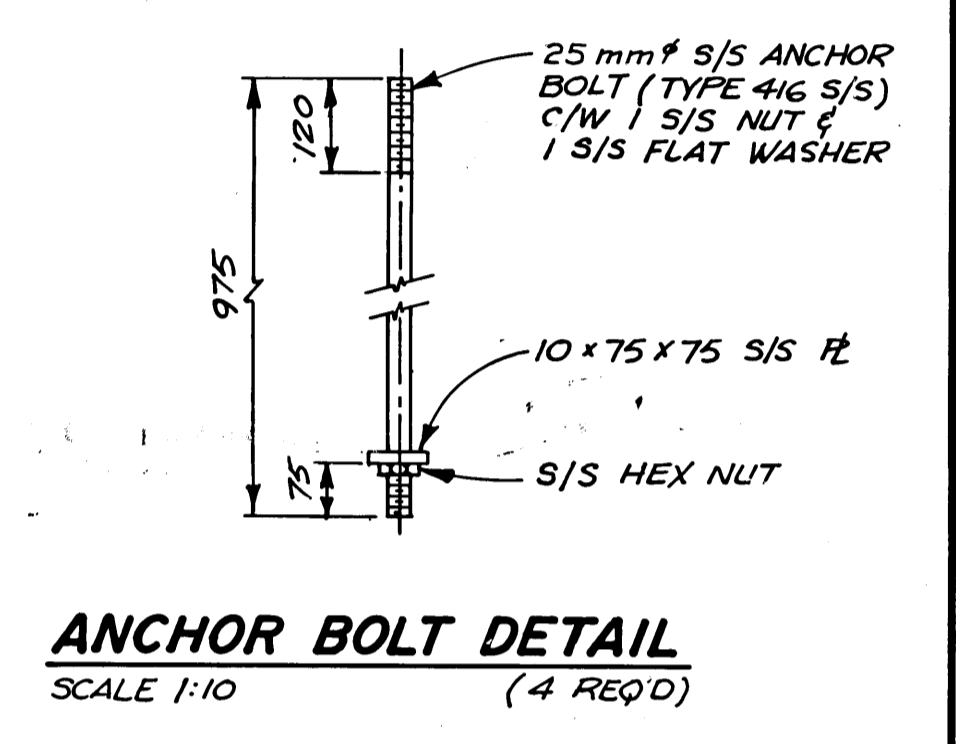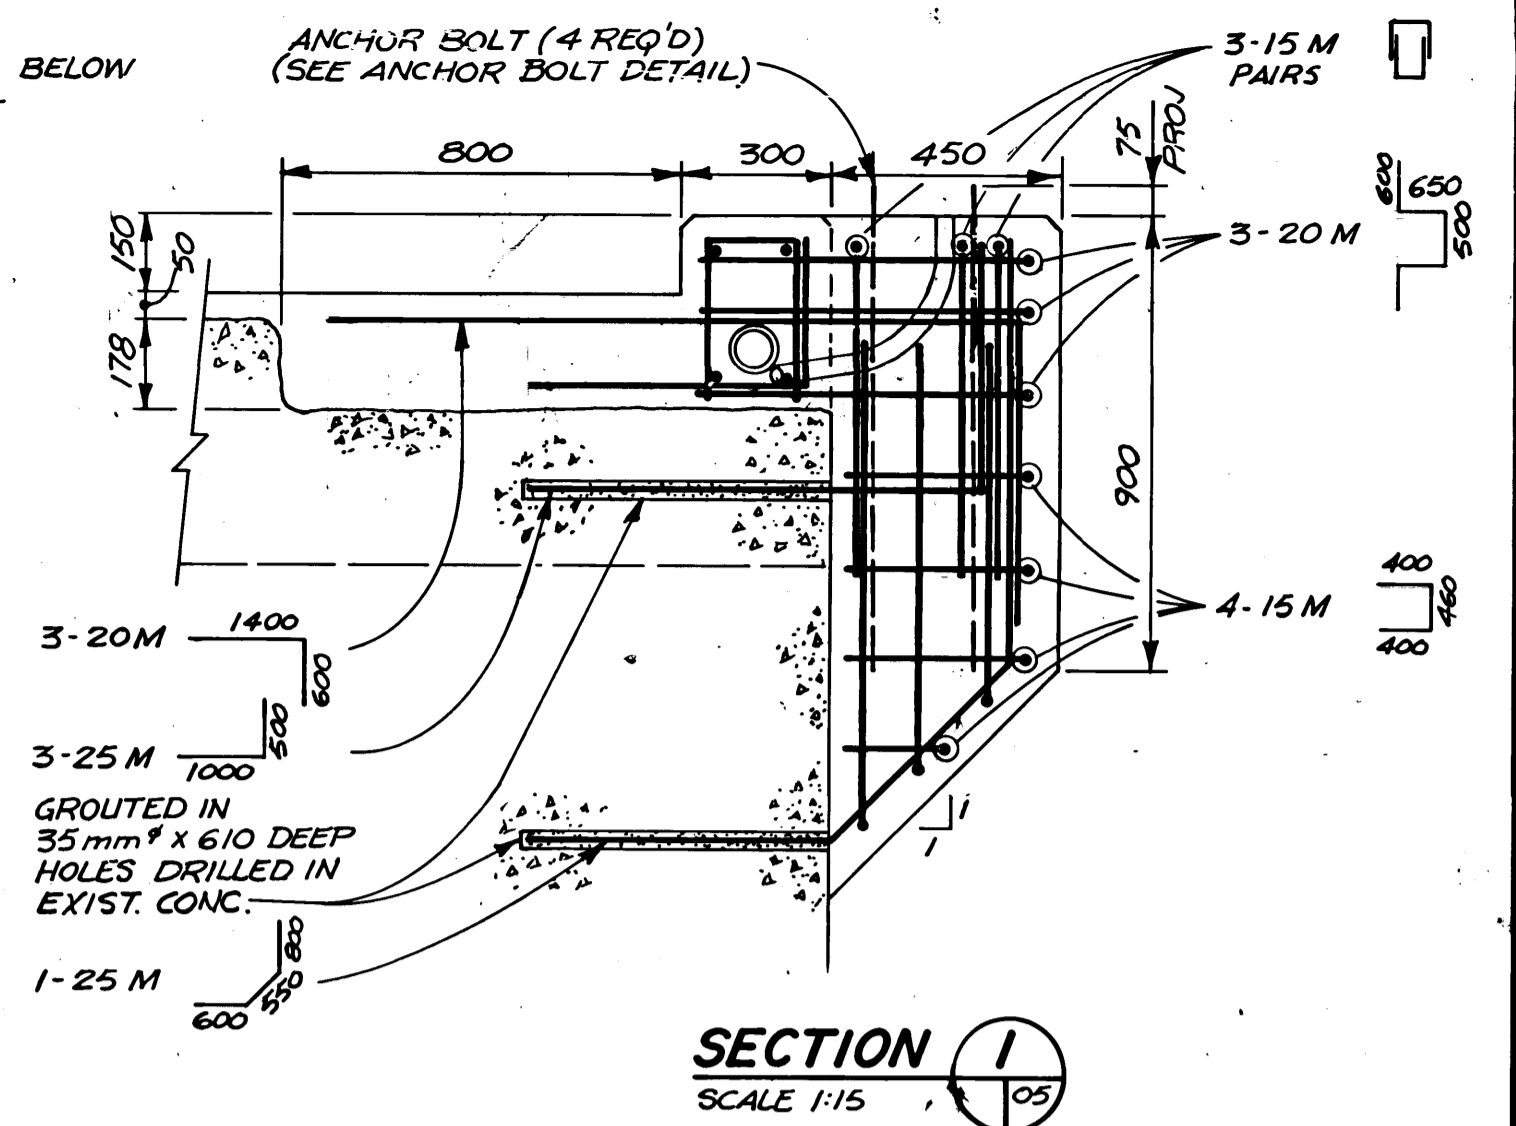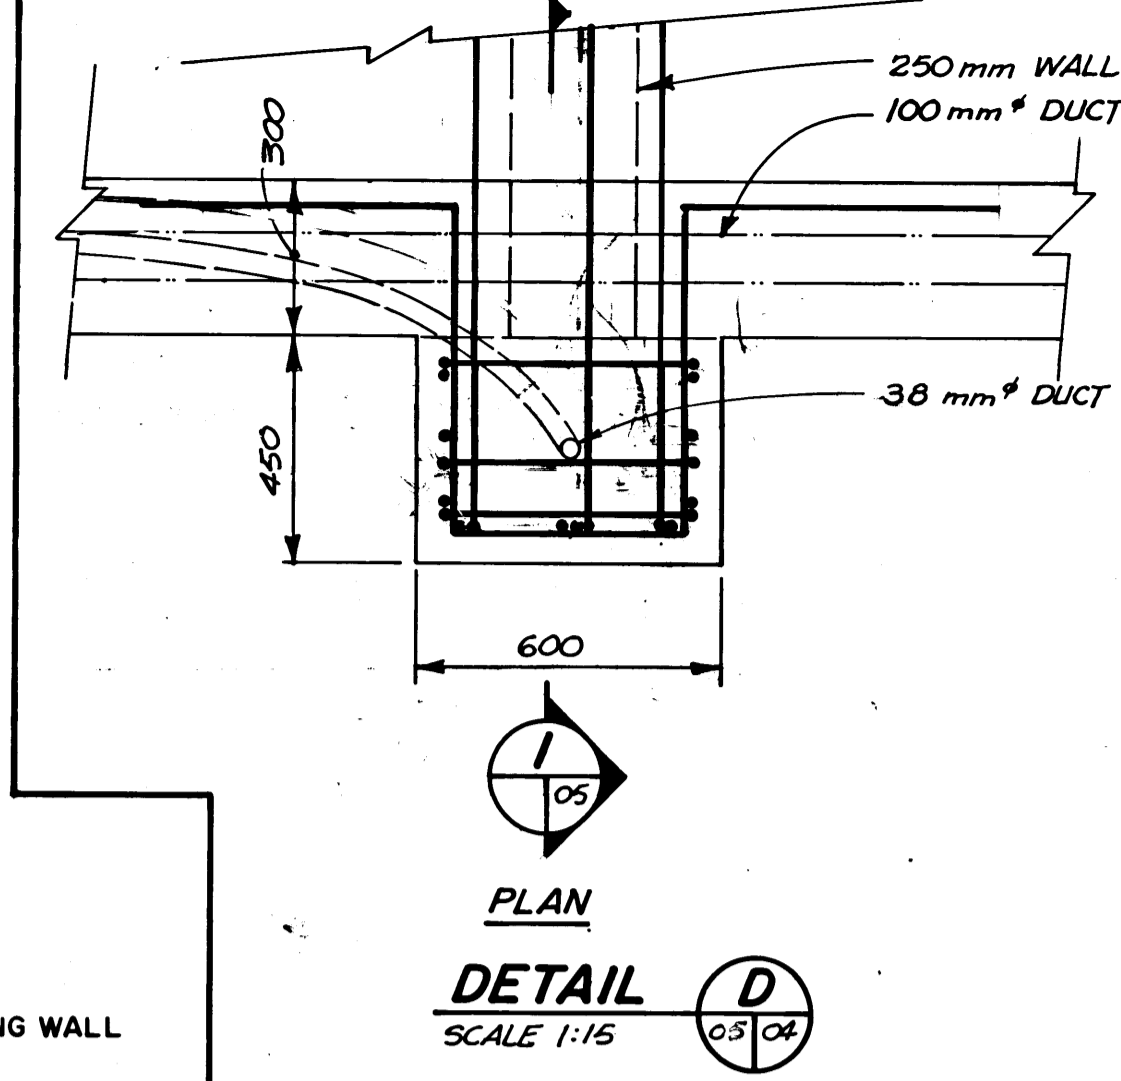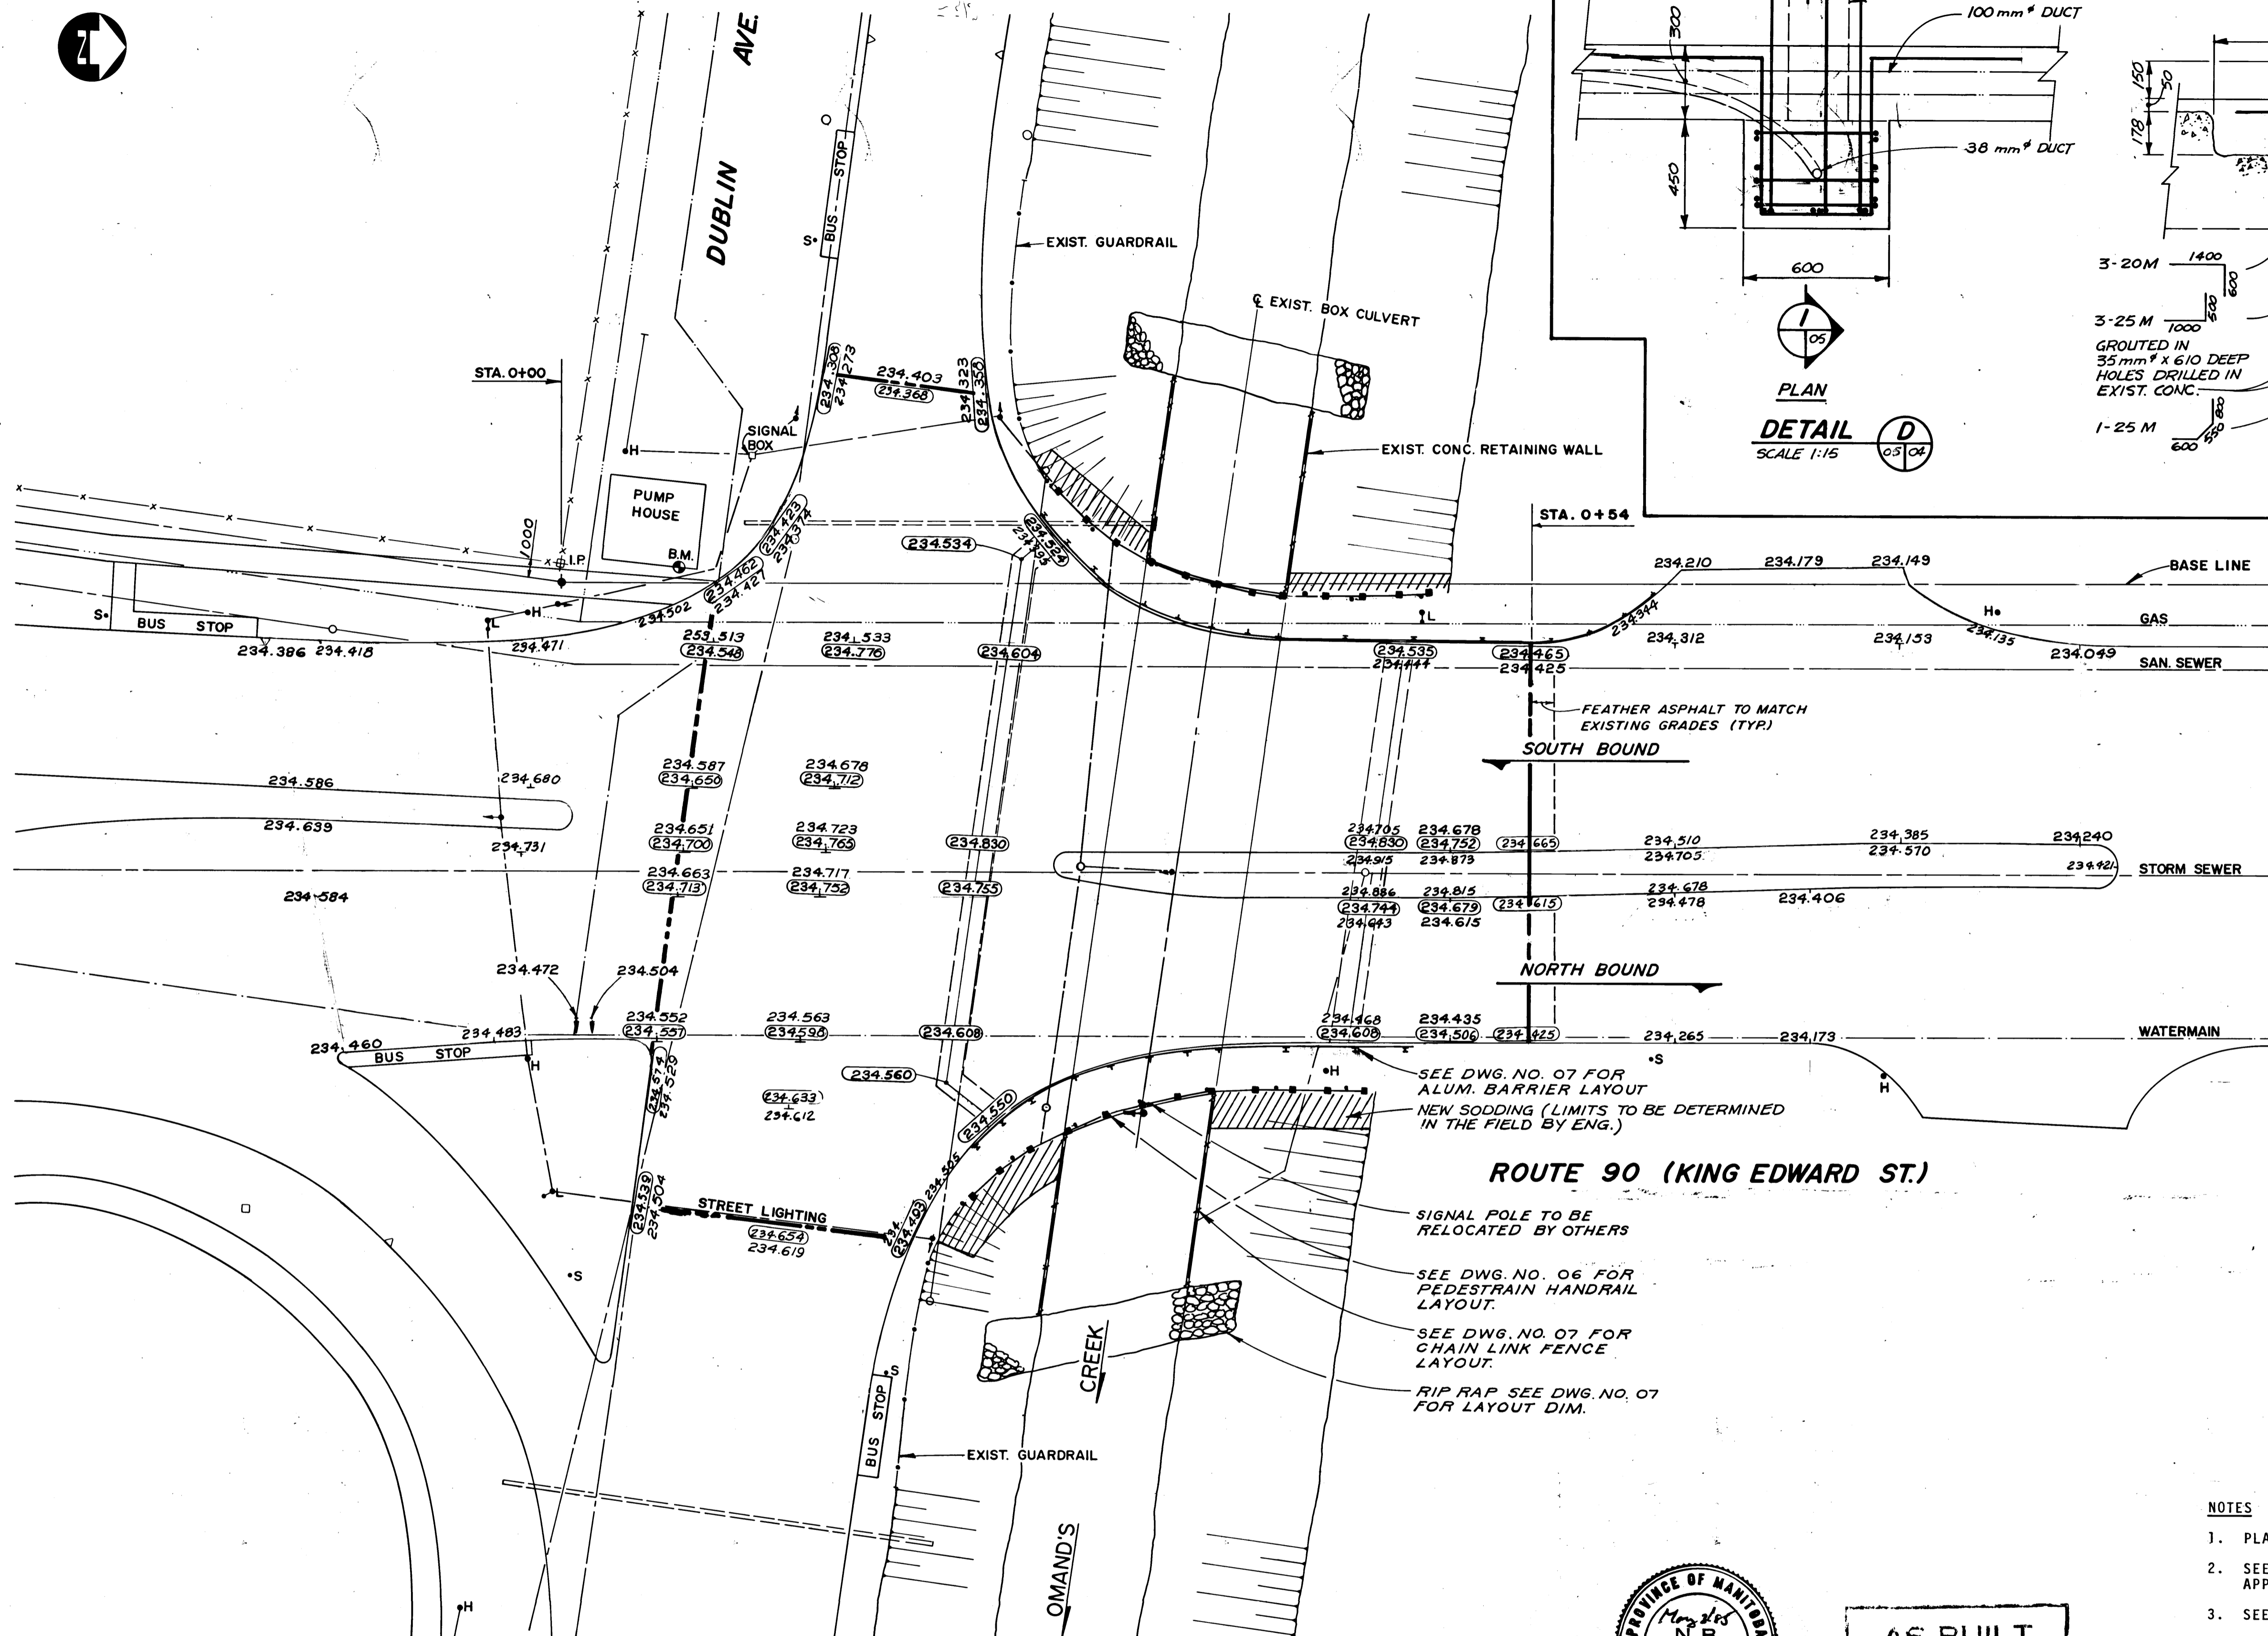

PLAN

| ITEM | EXISTING | PROPOSED |
|--------------------------|----------|----------|
| POLES - HYDRO(H) MTS.(T) | ⊙ | ⊙ |
| SIGNAL POLE | ⊙ | ⊙ |
| LIGHT STANDARD | ⊙ | ⊙ |
| SURVEY BAR | ⊙ | ⊙ |
| FIRE HYDRANT | ⊙ | ⊙ |
| WATER VALVE | ⊙ | ⊙ |
| EDGE OF PAV'T NO CURB | --- | --- |
| EDGE OF PAV'T CURBED | --- | --- |
| EDGE PAV'T CURB & GUTTER | --- | --- |
| PARAPLEGIC RAMP | --- | --- |
| ELEVATIONS | 40265 | (40265) |
| ASPHALT OVERLAY | --- | --- |
| PROPERTY LINE | --- | --- |
| MANHOLE | ○ | ● |
| CATCH BASIN | □ | ■ |
| CATCH BASIN INLET | ▽ | ▽ |
| CULVERT | --- | --- |

WARNING

IF POWER EQUIPMENT OR EXPLOSIVES ARE TO BE USED FOR EXCAVATION ON THIS PROJECT THE CONTRACTOR MUST:

- NOTIFY THE GAS COMPANY OF THE PROPOSED LOCATION OF EXCAVATION.
- TAKE PRECAUTION TO AVOID DAMAGE TO GAS COMPANY INSTALLATIONS.


SEE PROVINCIAL REGULATION 210/72 FOR DETAILS

LOCATION APPROVED UNDERGROUND STRUCTURES

DATE: _____ SUPERVISOR: _____

LOCATIONS OF UNDERGROUND STRUCTURES AS SHOWN ARE BASED ON THE BEST INFORMATION AVAILABLE, BUT NO GUARANTEE IS GIVEN THAT ALL EXISTING UTILITIES ARE SHOWN OR THAT THE GIVEN LOCATIONS ARE EXACT. CONFIRMATION OF EXISTENCE AND EXACT LOCATION OF ALL SERVICES MUST BE OBTAINED FROM THE INDIVIDUAL UTILITIES BEFORE PROCEEDING WITH CONSTRUCTION.

1 ASPHALT GRADES & AREA 29-5-85

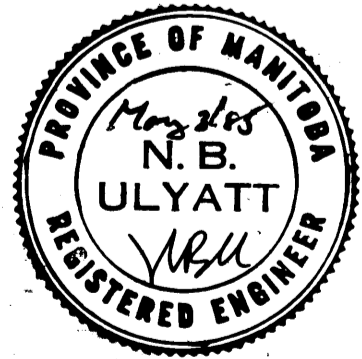

AS BUILT

APPROVED BY: *[Signature]*

- NOTES**
- PLACE ASPHALT TOPPING IN SHADED AREAS TO NEW GRADES.
 - SEE DWG. NO. 04 FOR DESIGN ELEV. ON STRUCTURE AND APPROACH SLABS.
 - SEE DWG. NO. 04 FOR APPROACH SIDEWALK

B-5530-5 METRIC

WHOLE NUMBERS INDICATE MILLIMETRES
DECIMALIZED NUMBERS INDICATE METRES



DILLON
Consulting Engineers & Planners

DESIGNED BY: S.S.R. DRAWN BY: C.R.B.

CHECKED BY: N.B.U. DATE: MAY 85

APPROVED BY: *[Signature]* DATE: *[Signature]*

THE CITY OF WINNIPEG

WORKS & OPERATIONS DIVISION

STREETS & TRANSPORTATION DEPARTMENT


ROUTE 90 CULVERT AT OMAND'S CREEK TOP SLAB REHABILITATION, STRUCTURAL STRENGTHENING AND RELATED WORKS

ASPHALT OVERLAY LAYOUT AND GRADES


AUTHORIZED BY: *[Signature]* 1985-05-03

ACCEPTED BY: *[Signature]* 1985-05-03


SCALE 1:200 DRAWING NO. C315-85-05

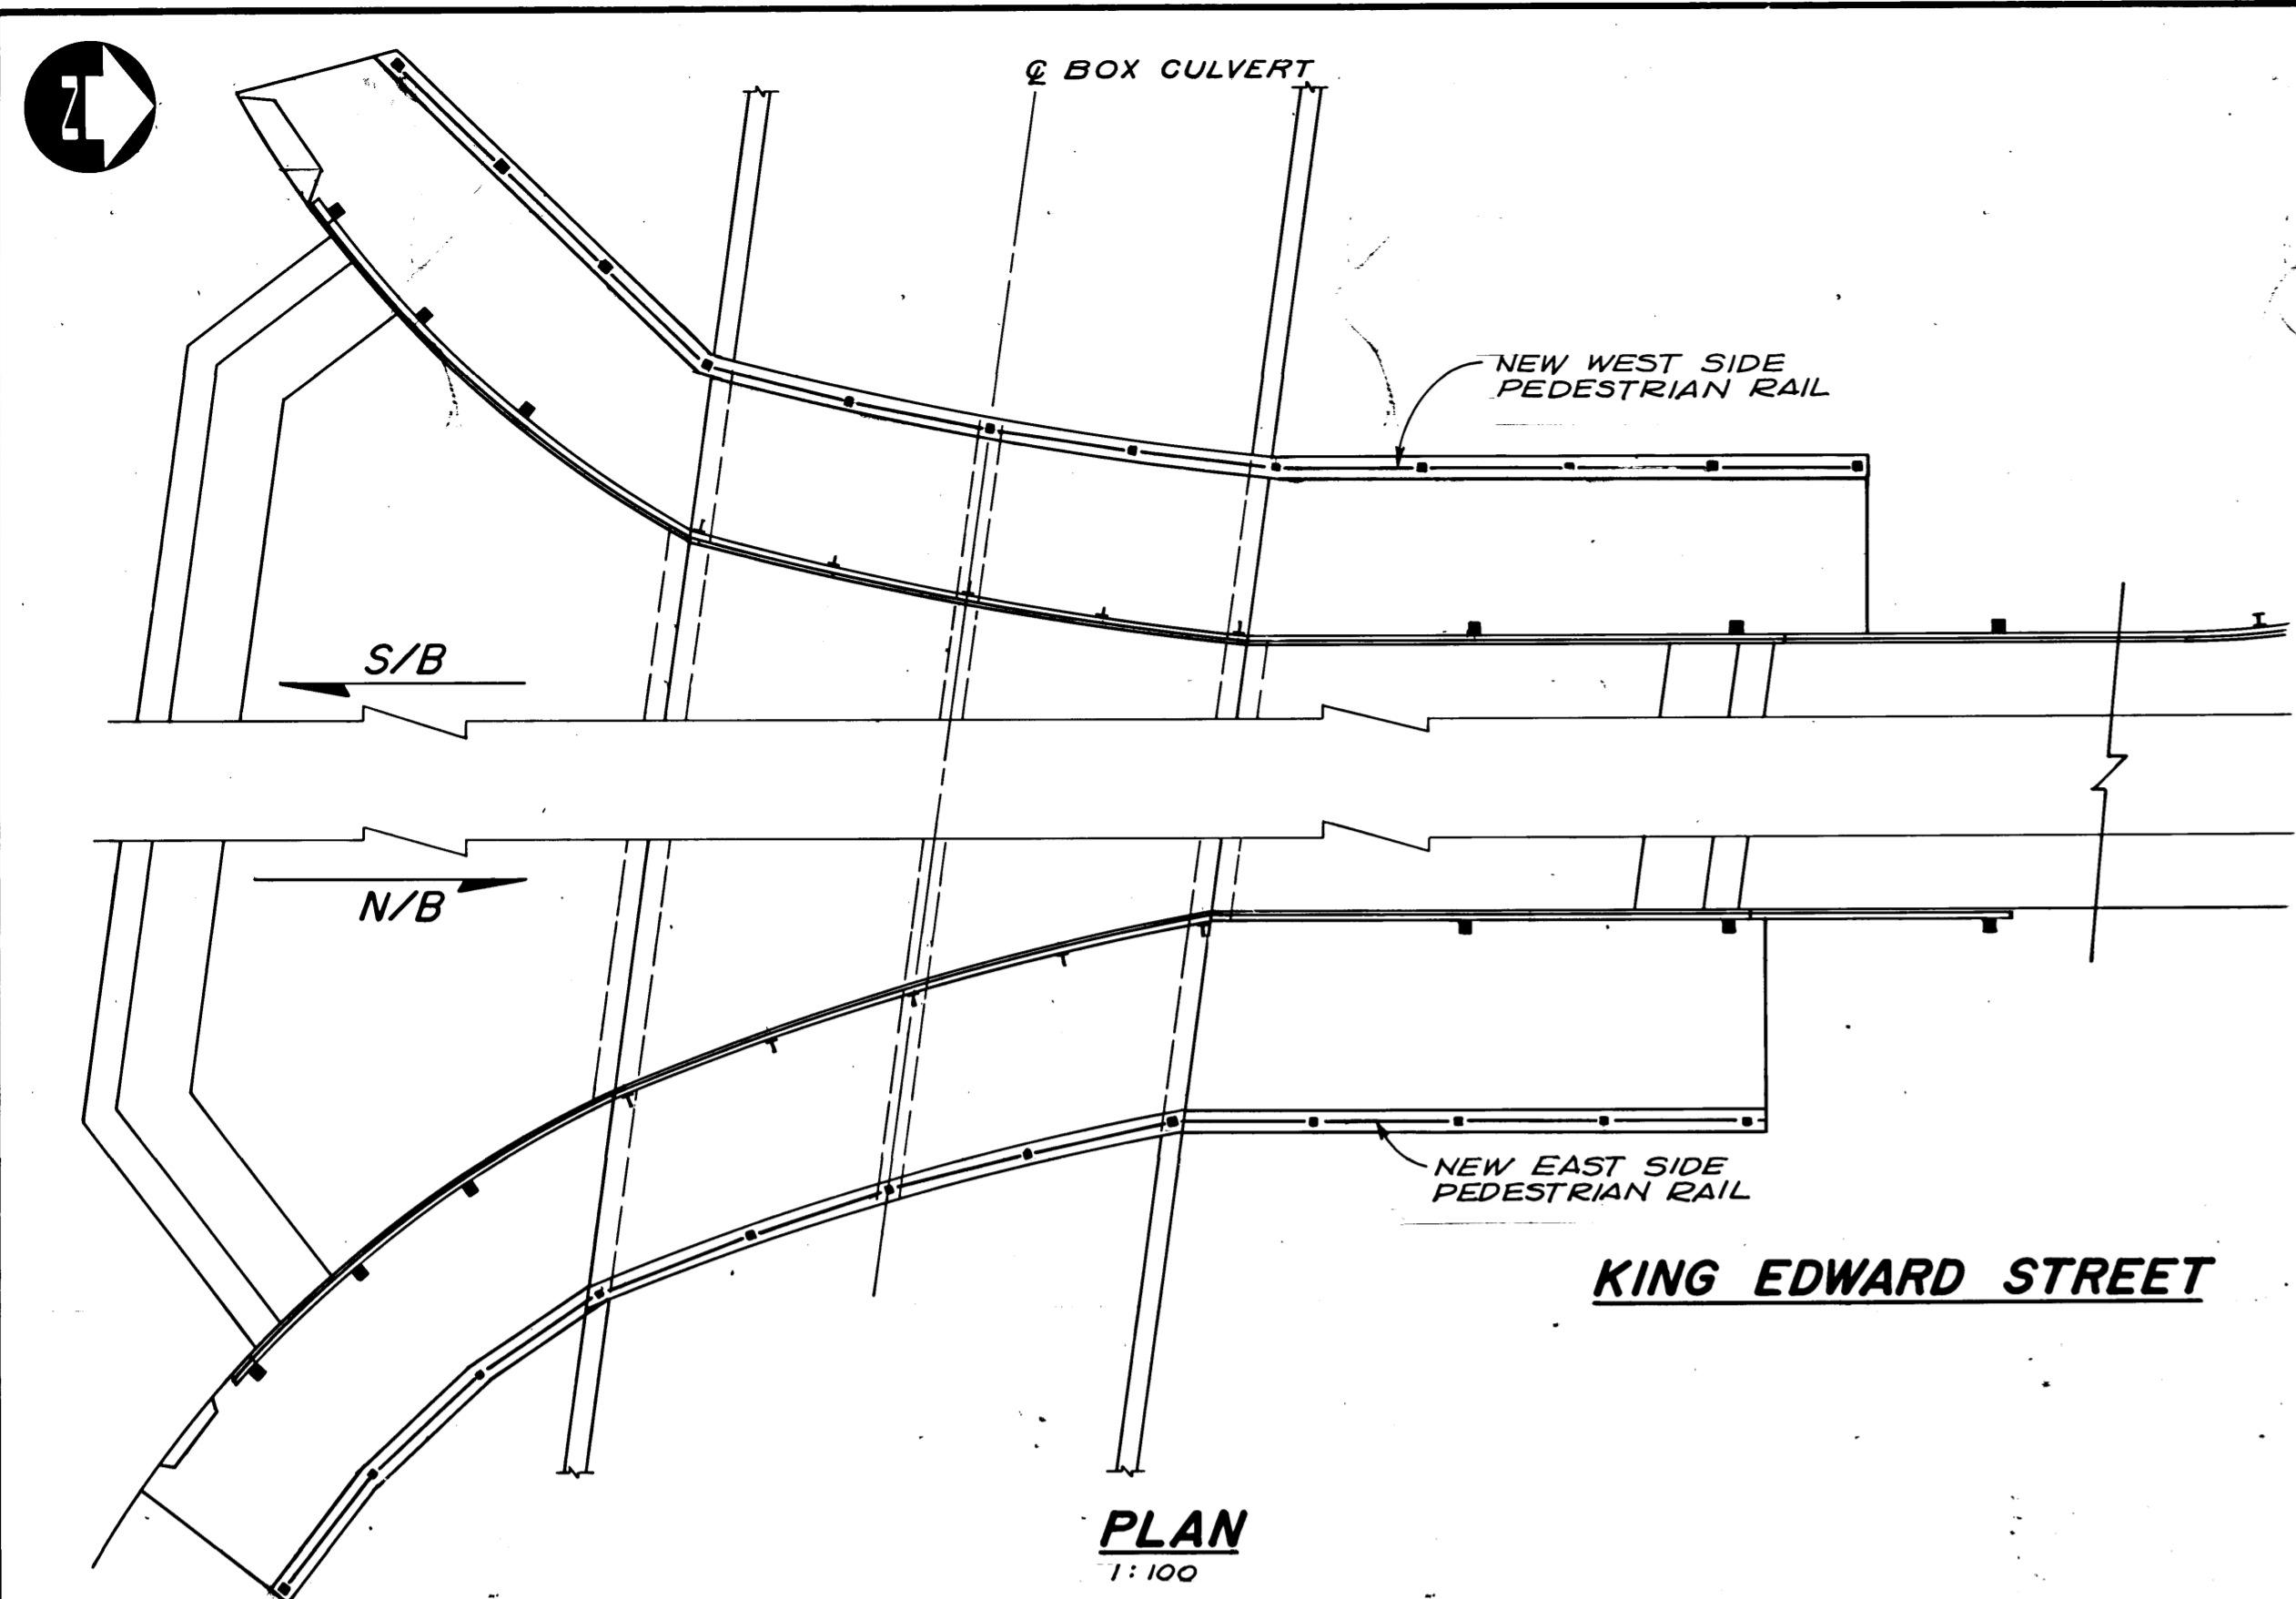


PLAN
1:100

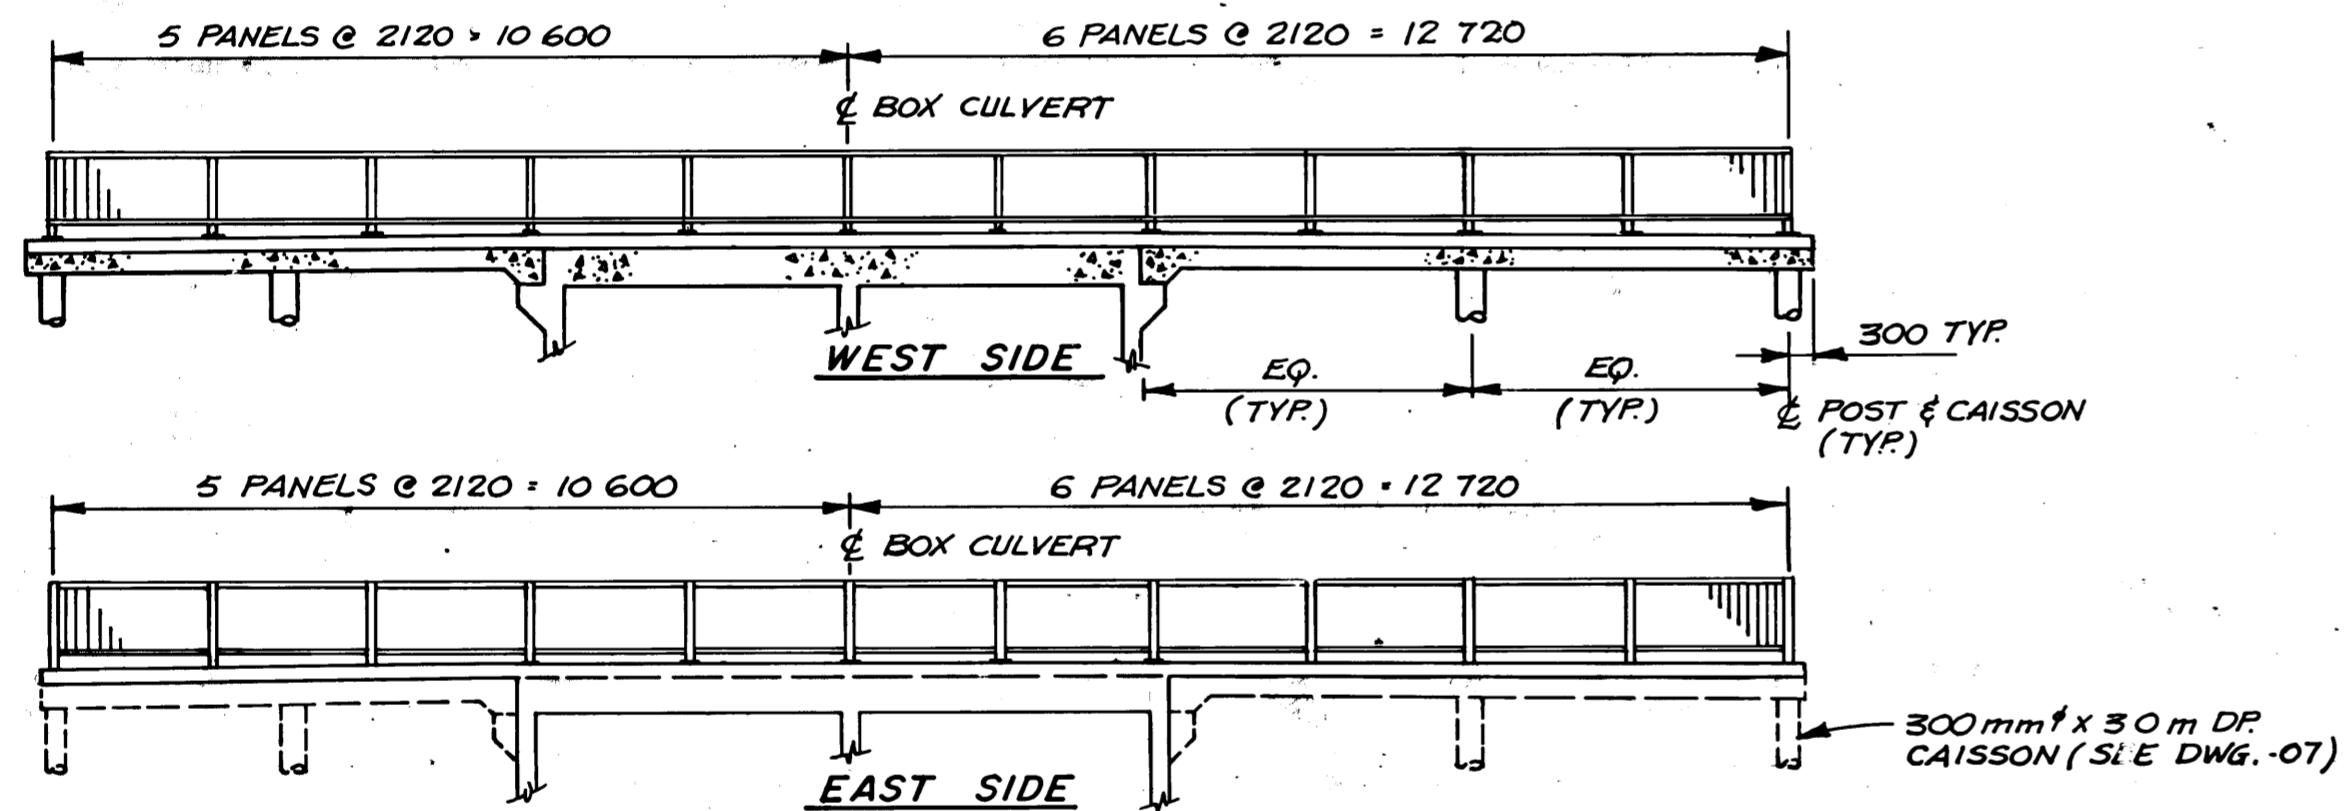


ELEVATIONS OF PEDESTRIAN RAILS (LOOKING WEST)

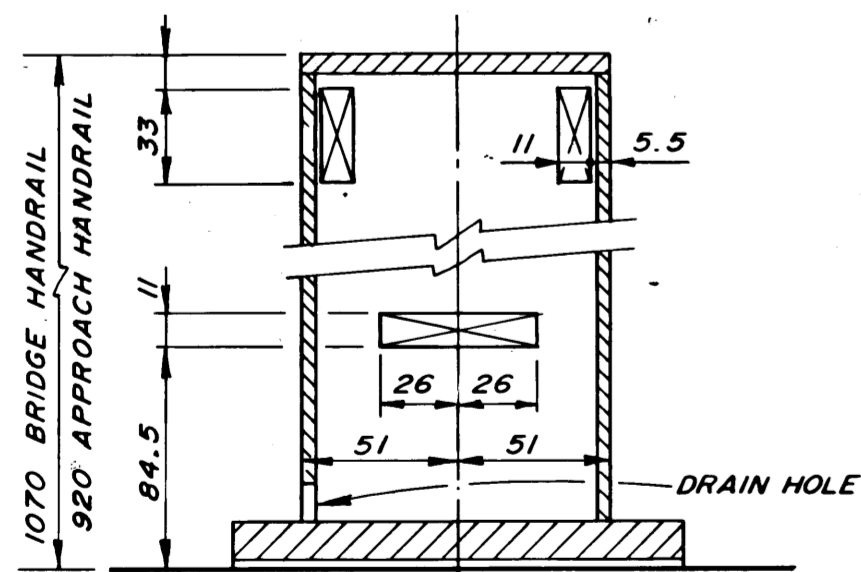

POST DETAIL
SHOWING SLOTS FOR RAIL SEATS
SCALE 1:2.5

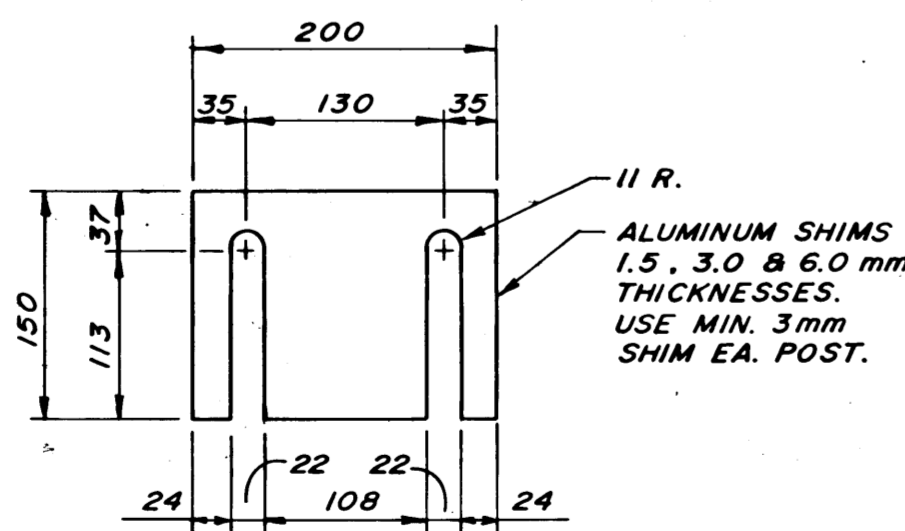


PEDESTRIAN POST SHIM
SCALE 1:5

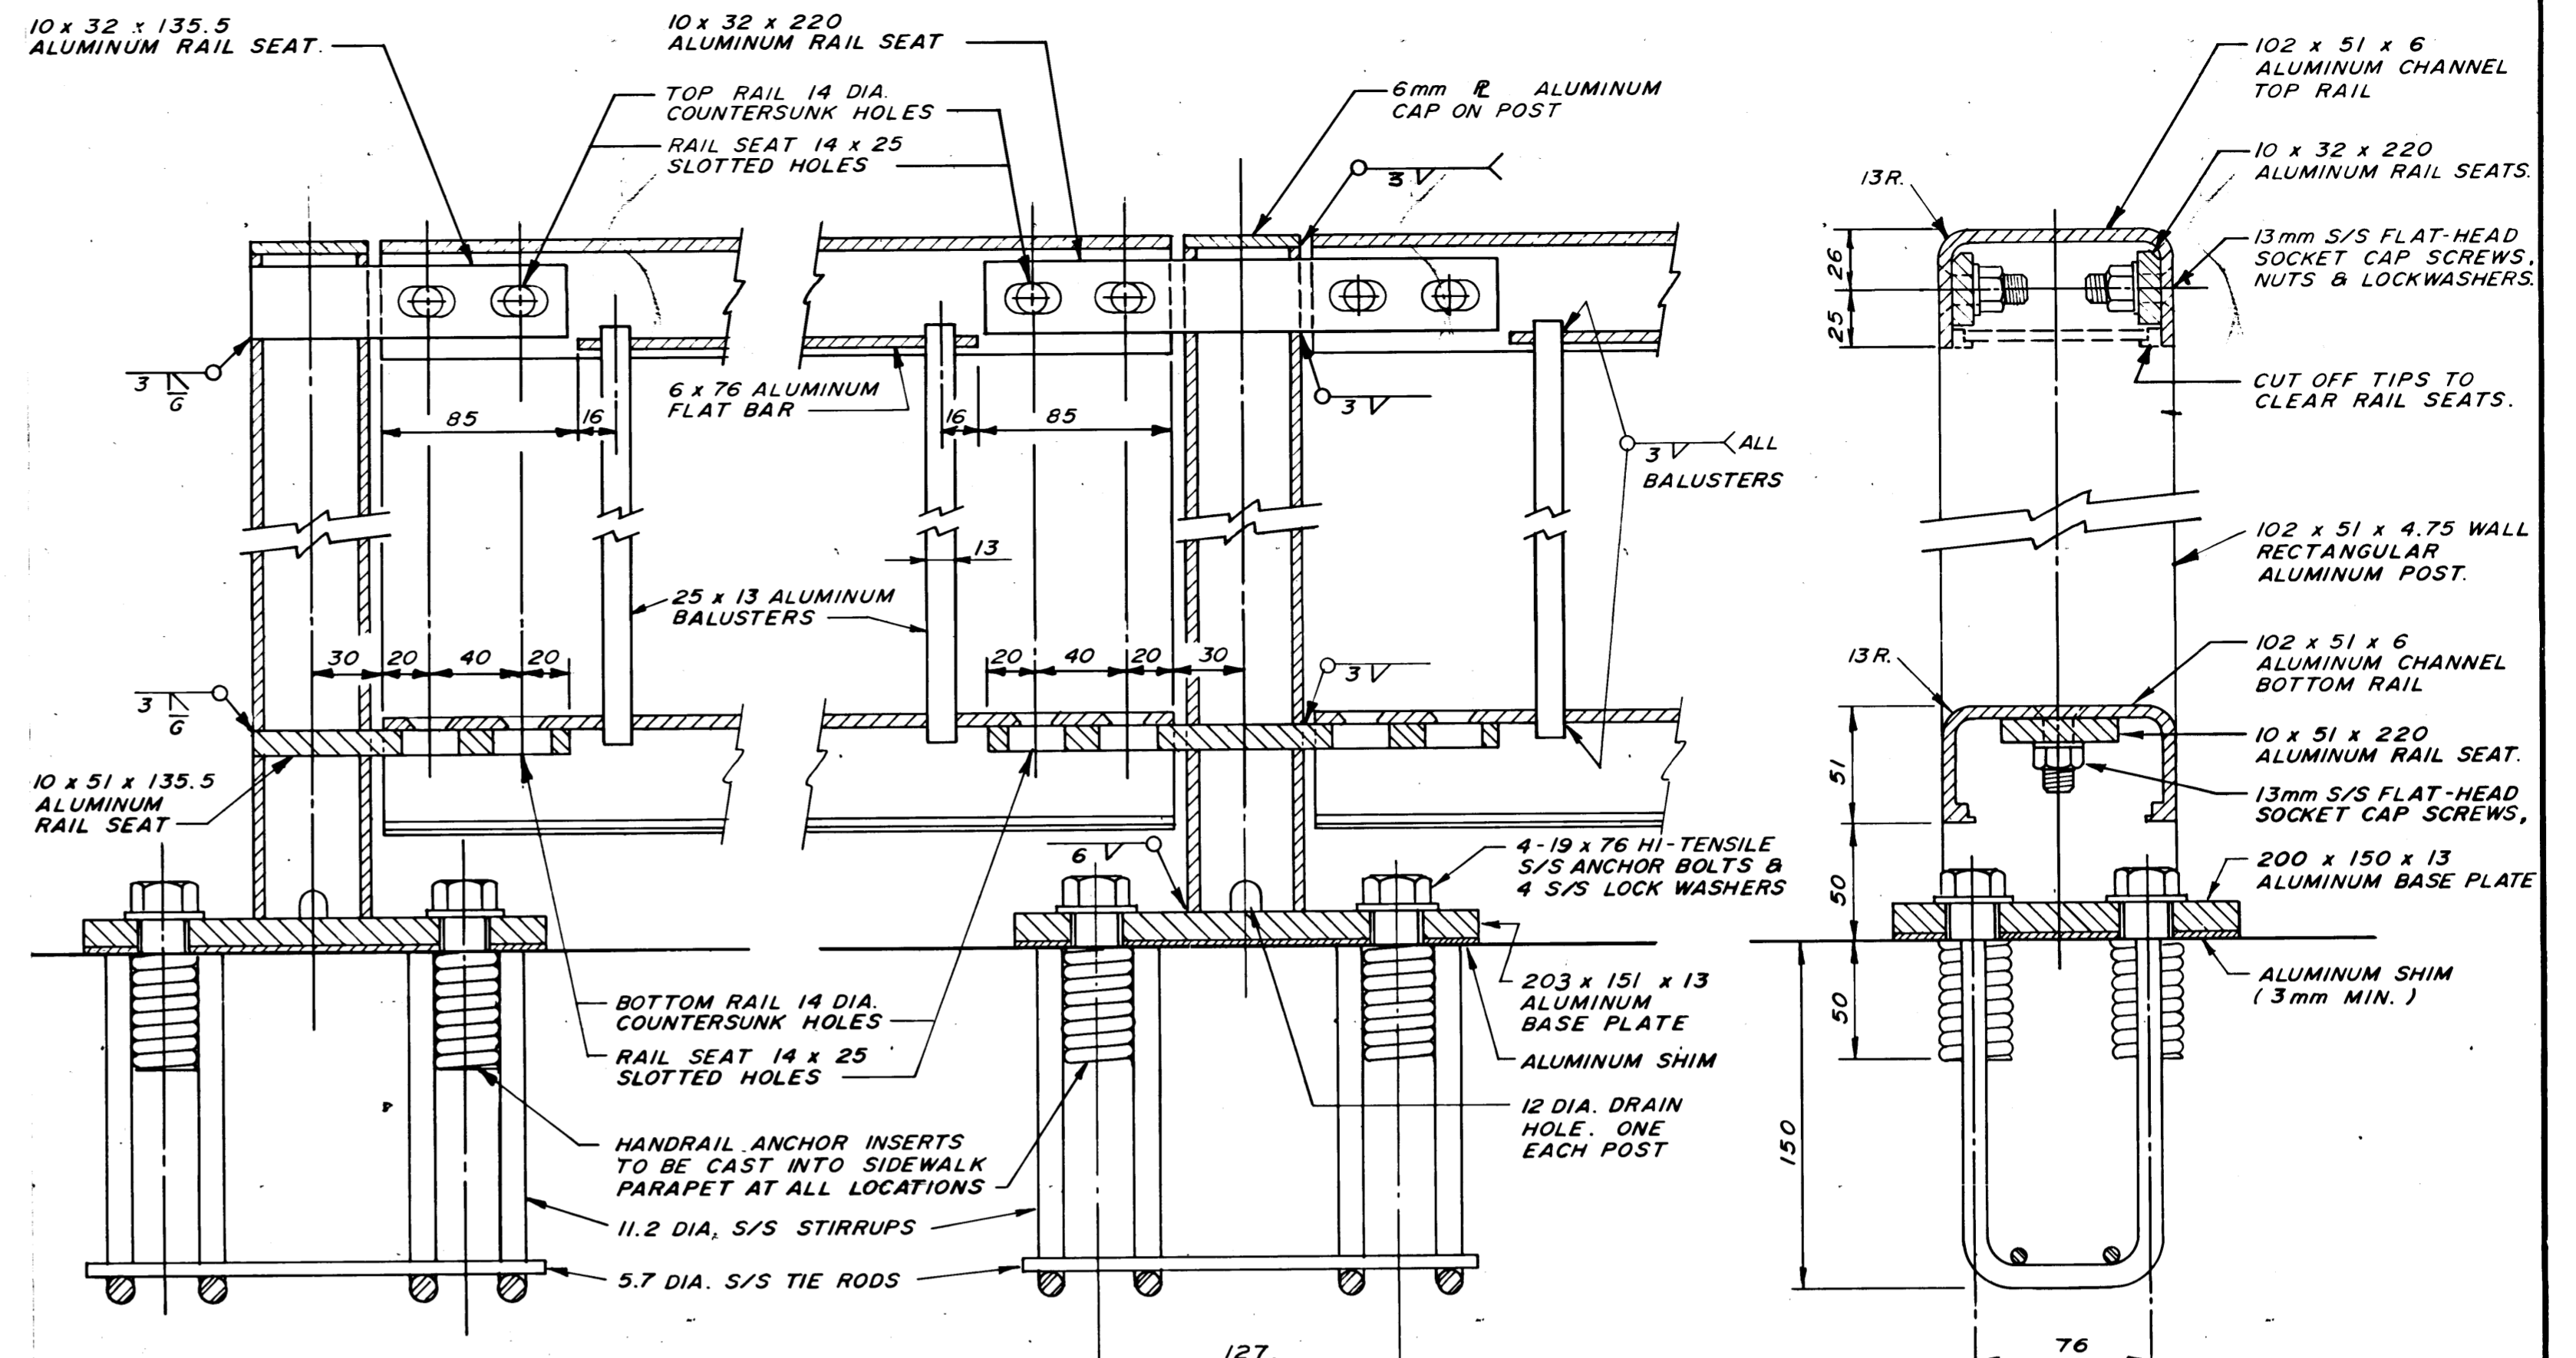


DETAIL AT END POSTS
SCALE 1:2.5

DETAIL AT INTERMEDIATE POSTS
SCALE 1:2.5

SECTION 1
SCALE 1:2.5

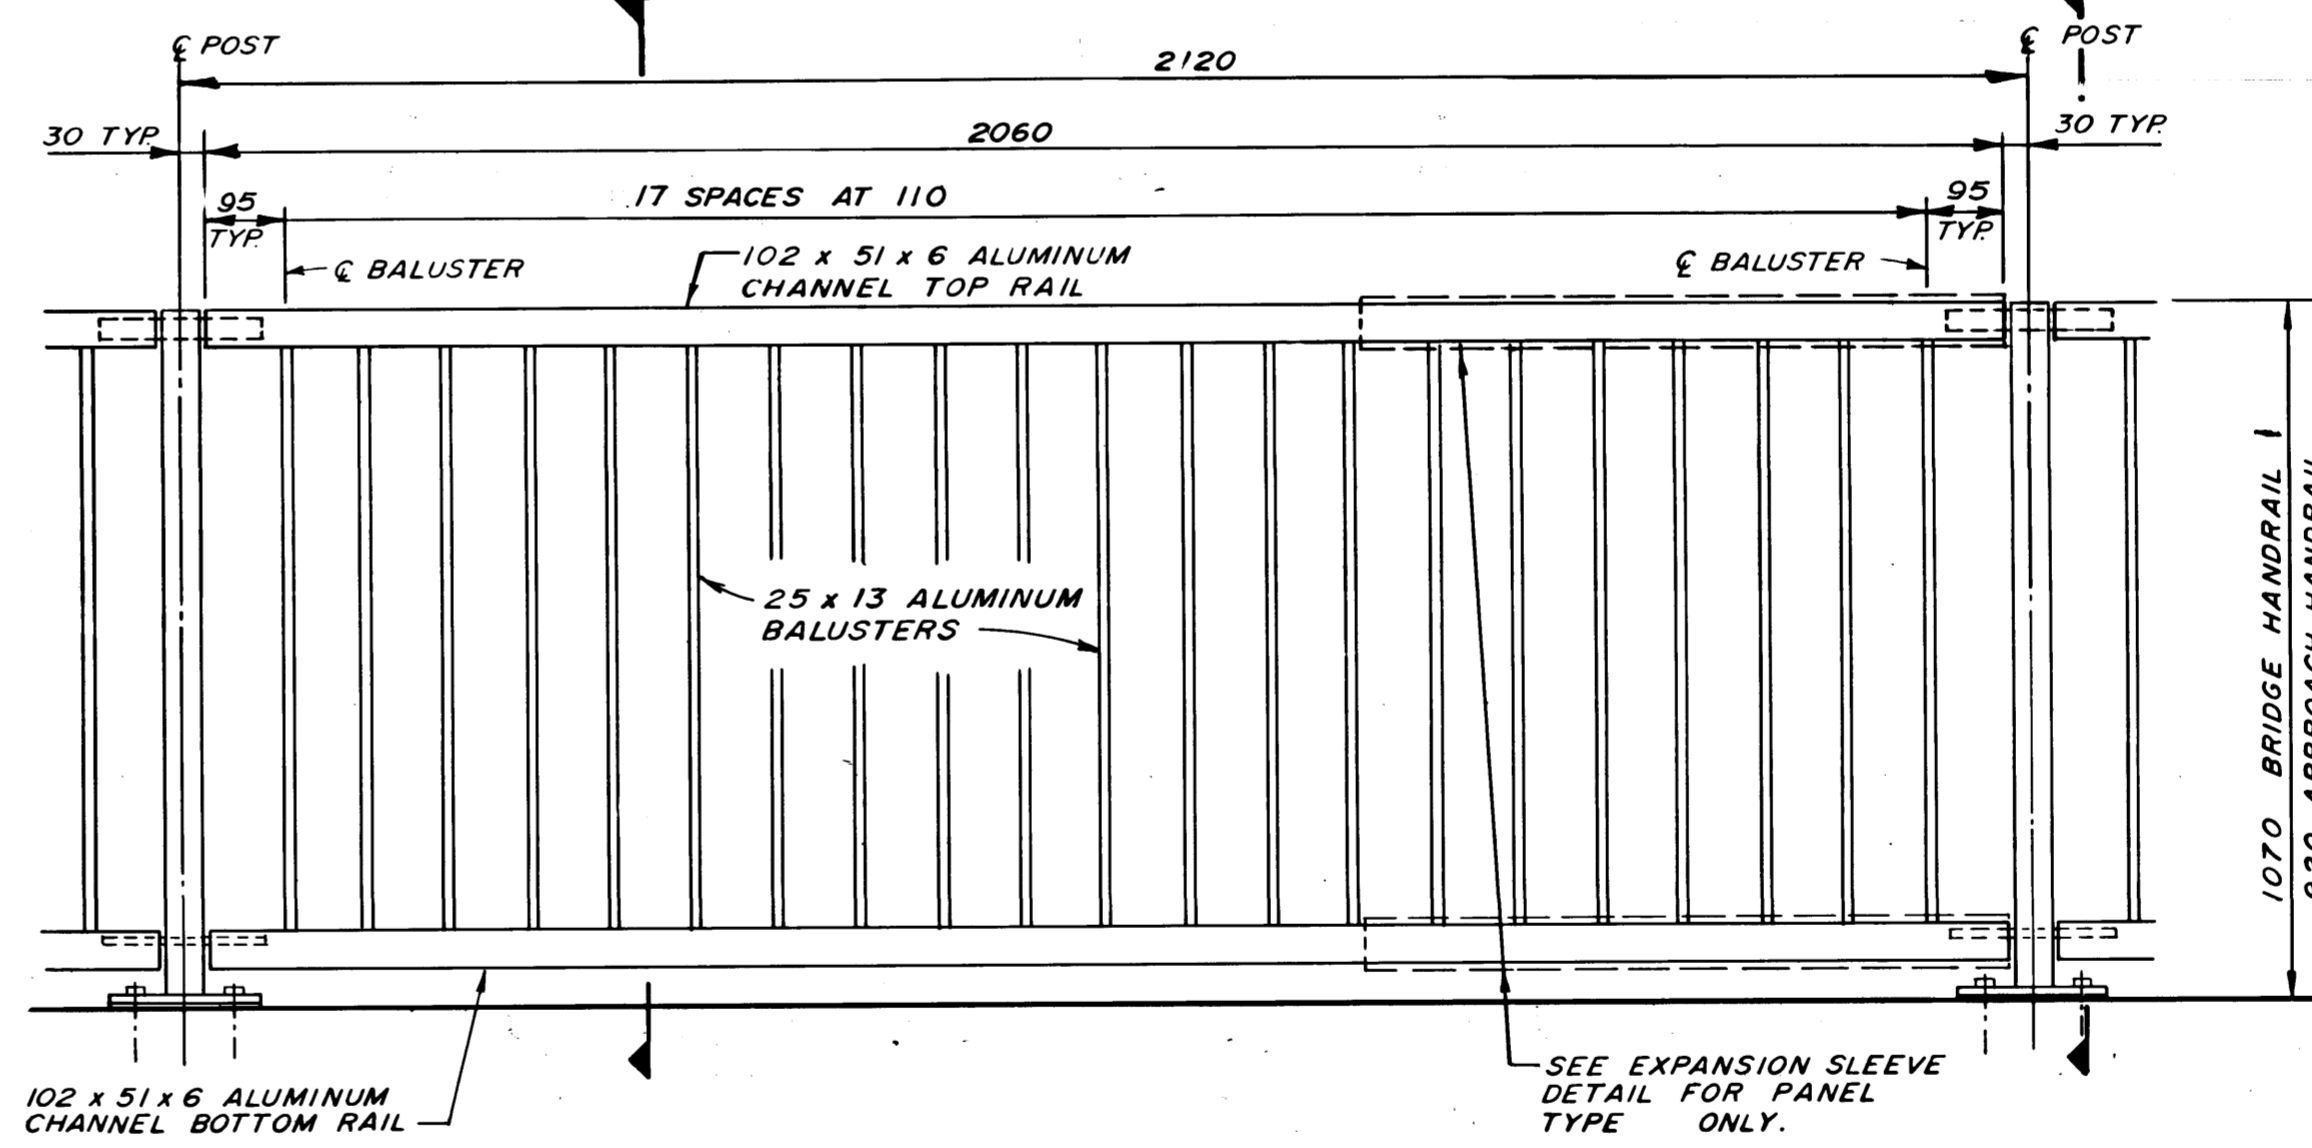

PANEL ELEVATION
N.T.S.

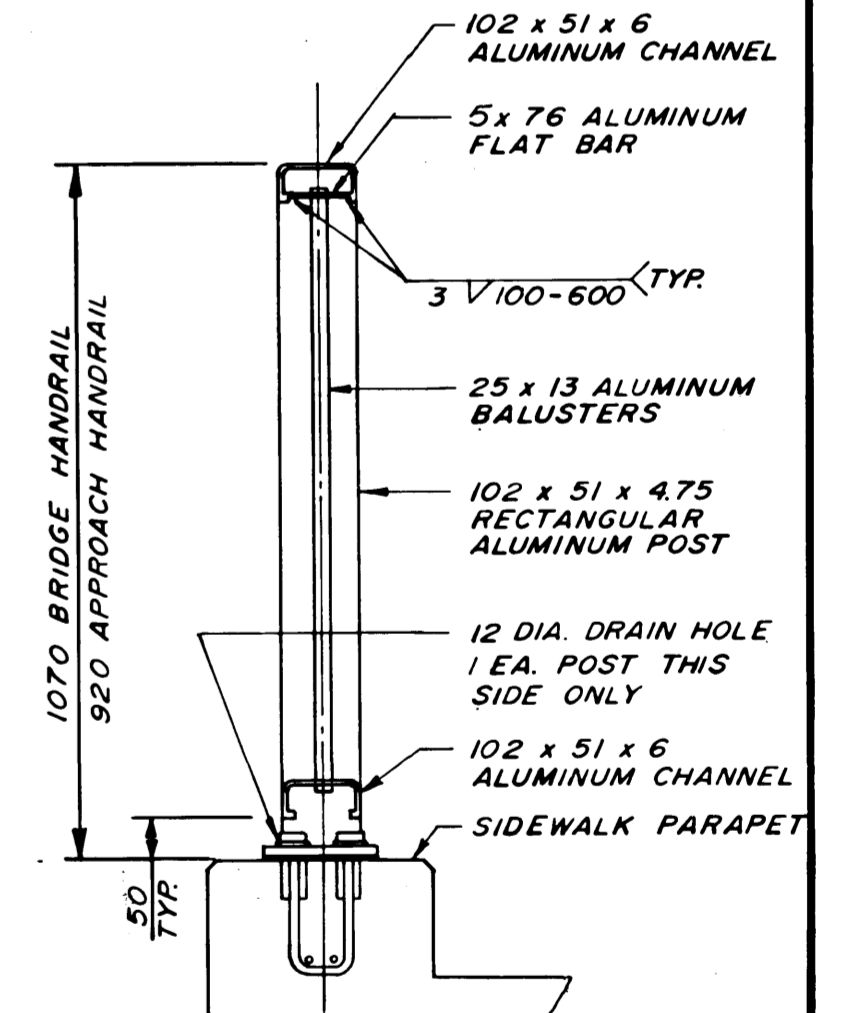


SECTION 2
SCALE 1:10

NOTES

1. ALL ALUMINUM CHANNELS, POSTS AND BARS SHALL CONFORM TO ASTM B221, ALLOY 6061-T6 OR ALLOY 6351-T6.
2. PAINT UNDERSIDE OF POST SHIMS WITH 2 COATS OF ALKALI-RESISTANT BITUMINOUS PAINT MEETING THE REQUIREMENTS OF CGSB 31-GP-3M. EACH COAT TO BE 1mm IN THICKNESS.
3. ALL BOLTS, NUTS, WASHERS & MISC. HARDWARE SHALL BE STAINLESS STEEL TYPE 304.
4. POST ANCHORAGE SYSTEM SHALL BE STAINLESS STEEL ACROW - RICHMOND TYPE DGR-1 C/W TYPE 416 HI-TENSILE STAINLESS STEEL BOLTS AND WASHERS.
5. REMOVE EXISTING CONCRETE, ANCHOR BOLTS AND INSERTS WHERE REQUIRED TO INSTALL NEW ANCHORAGE SYSTEM.
6. USE A COMBINATION OF 1.5mm, 3.0mm OR 6.0mm ALUMINUM SHIMS AS REQUIRED TO SET POSTS VERTICAL TO THE SPECIFIED HEIGHT. A MINIMUM 3.0mm SHIM IS REQUIRED AT EACH POST.
7. VERIFY ALL DIMENSIONS AND BENDS REQUIRED IN RAIL SEATS BY FIELD MEASUREMENTS PRIOR TO FABRICATION.
8. ALL SLOTTED HOLES SHALL BE FINISHED SMOOTH AND TRUE.
9. THE M.I.C. PROCESS OF WELDING SHALL BE USED.

AS BUILT
APPROVED BY: *[Signature]*

B-5530-6

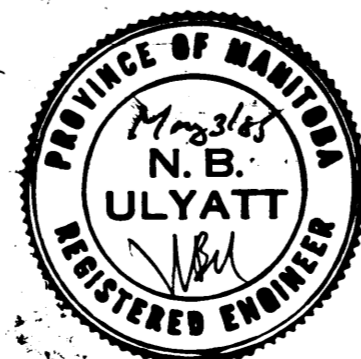


DILLON
Consulting Engineers & Planners

DESIGNED BY: S.S.R. DRAWN BY: W.P.S.
CHECKED BY: N.B.U. DATE: MAY 85
APPROVED BY: *[Signature]* DATE: *[Signature]*


THE CITY OF WINNIPEG
WORKS & OPERATIONS DIVISION
STREETS & TRANSPORTATION DEPARTMENT

ROUTE 90 CULVERT AT OMAND'S CREEK
TOP SLAB REHABILITATION, STRUCTURAL STRENGTHENING AND RELATED WORKS
LAYOUT & DETAILS OF ALUMINUM PEDESTRIAN HANDRAIL
AUTHORIZED BY: *[Signature]* DATE: 1985-05-03
ACCEPTED BY: *[Signature]* DATE: 1985-05-03
SCALE: 1:100 OR AS NOTED DRAWING NO: C315-85-06
M.M.D. 9439-01
FIELD BOOK NO. B-43-1


| NO | REVISIONS | DATE | APP. | ENGINEER'S SEAL |
|----|-----------|------|------|-----------------|
| | | | | |
| | | | | |
| | | | | |

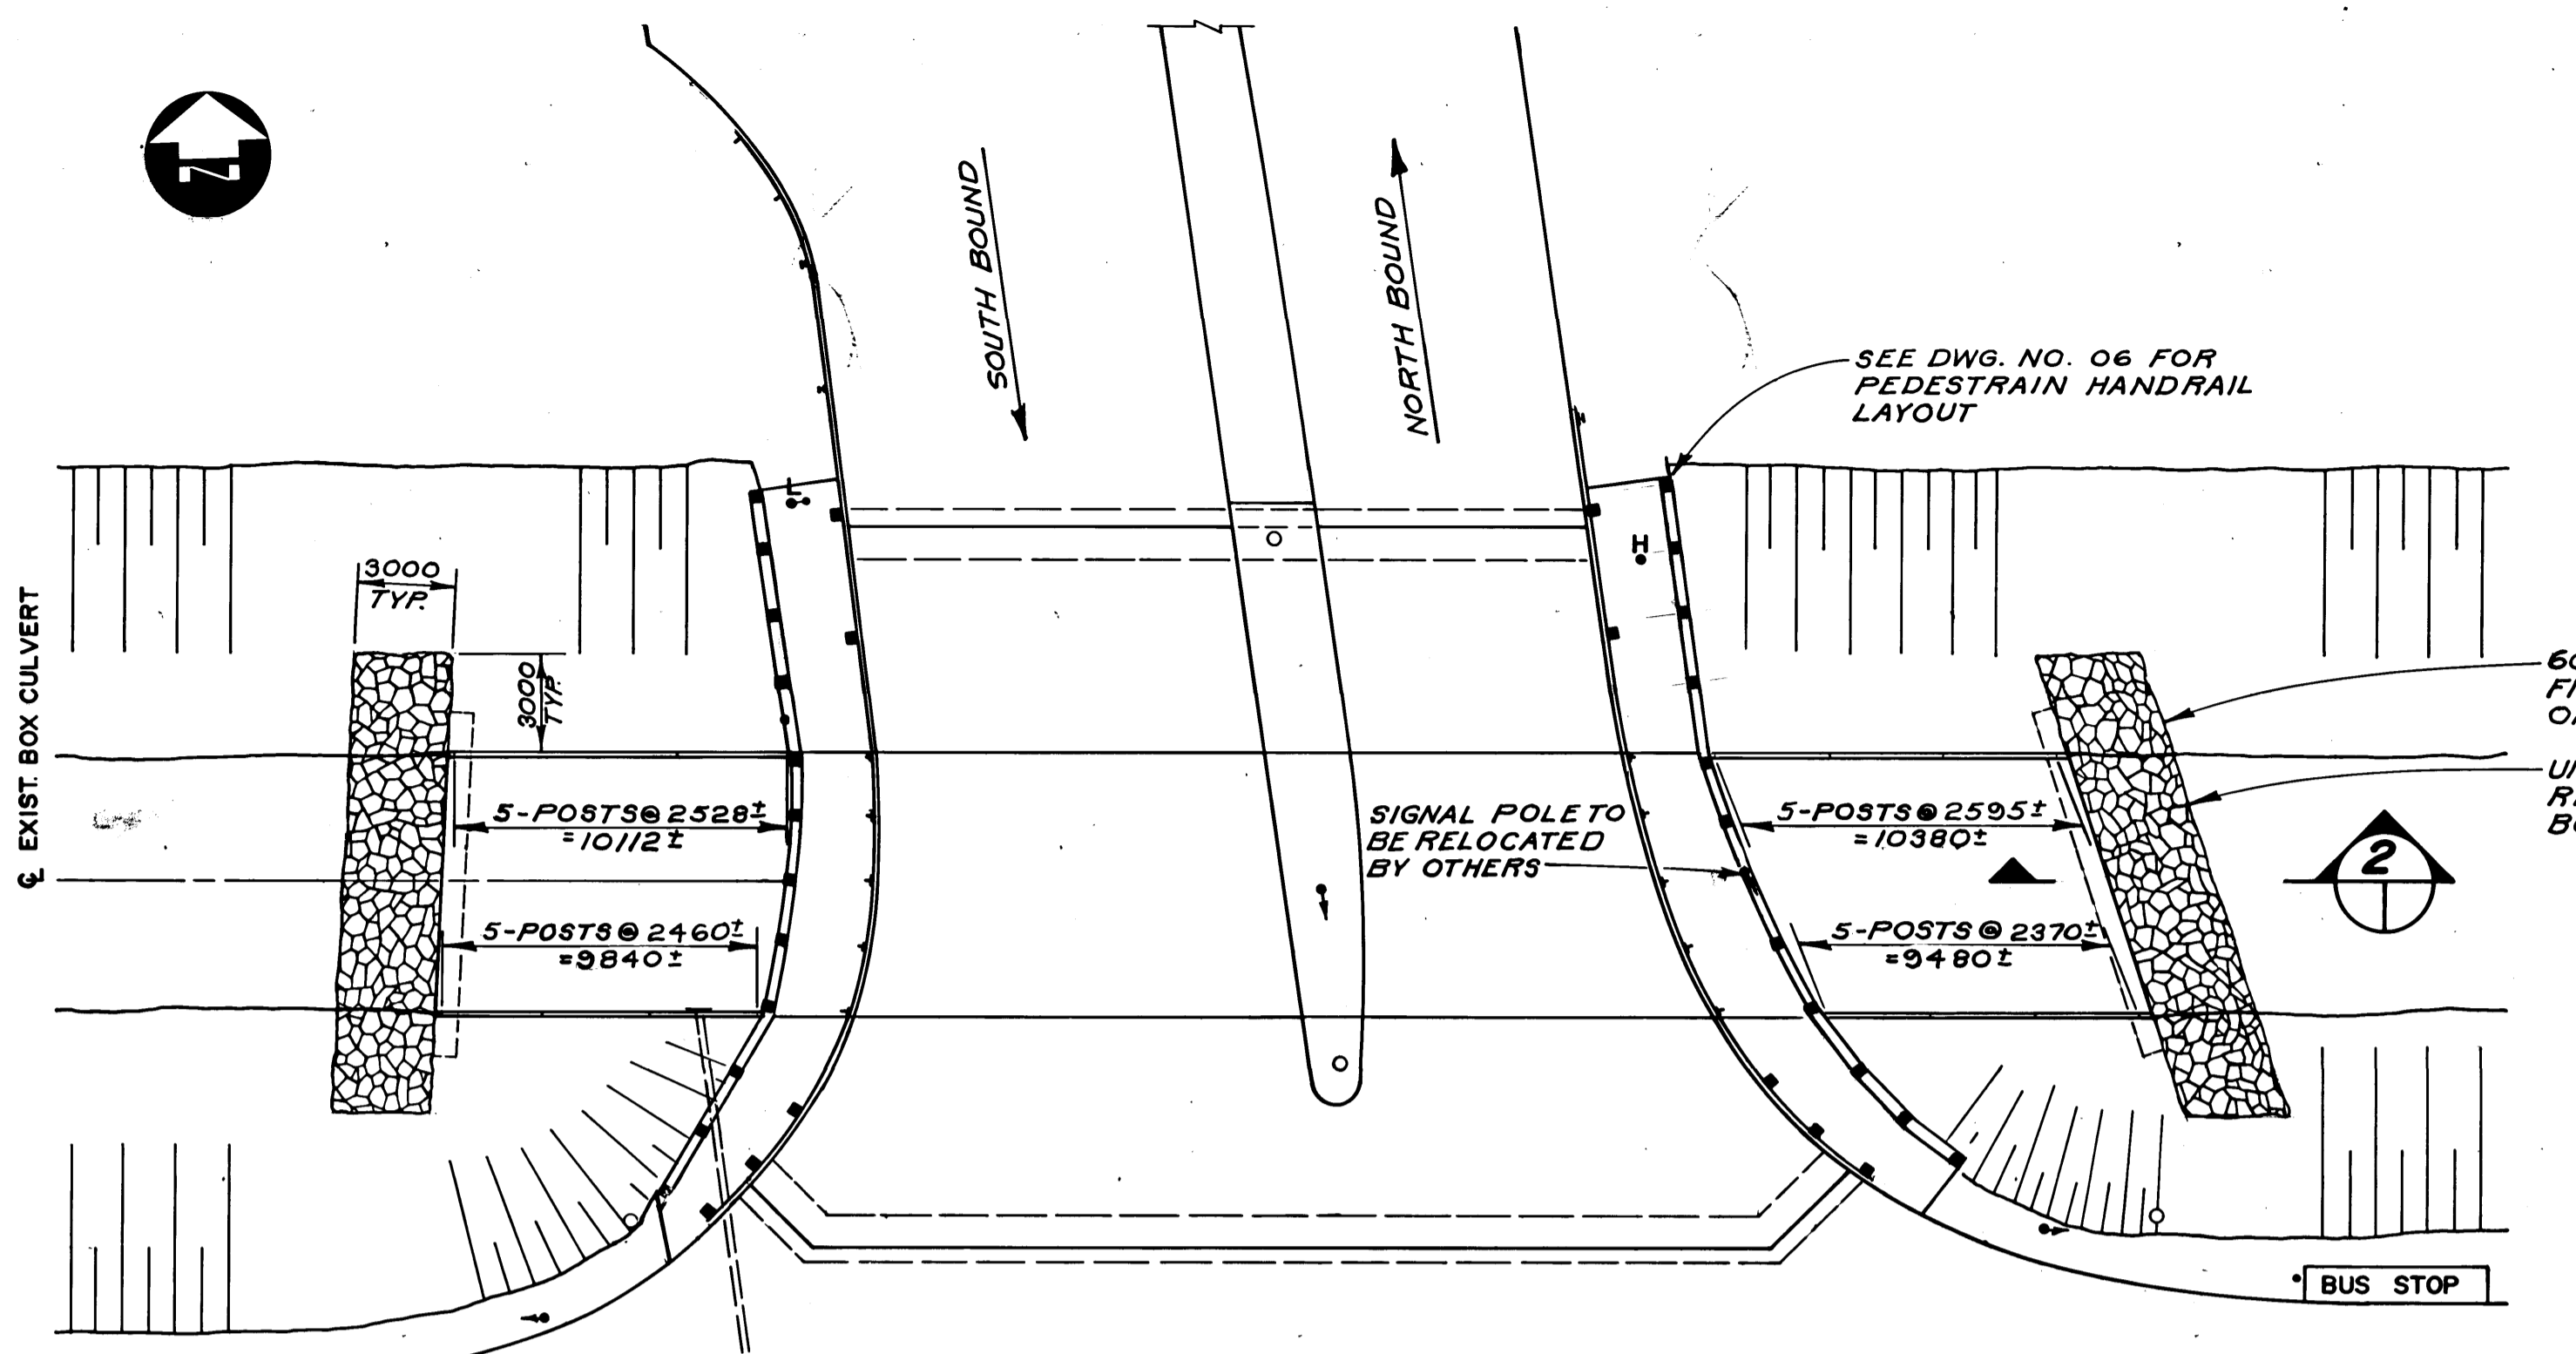


PLAN
SCALE: 1:200

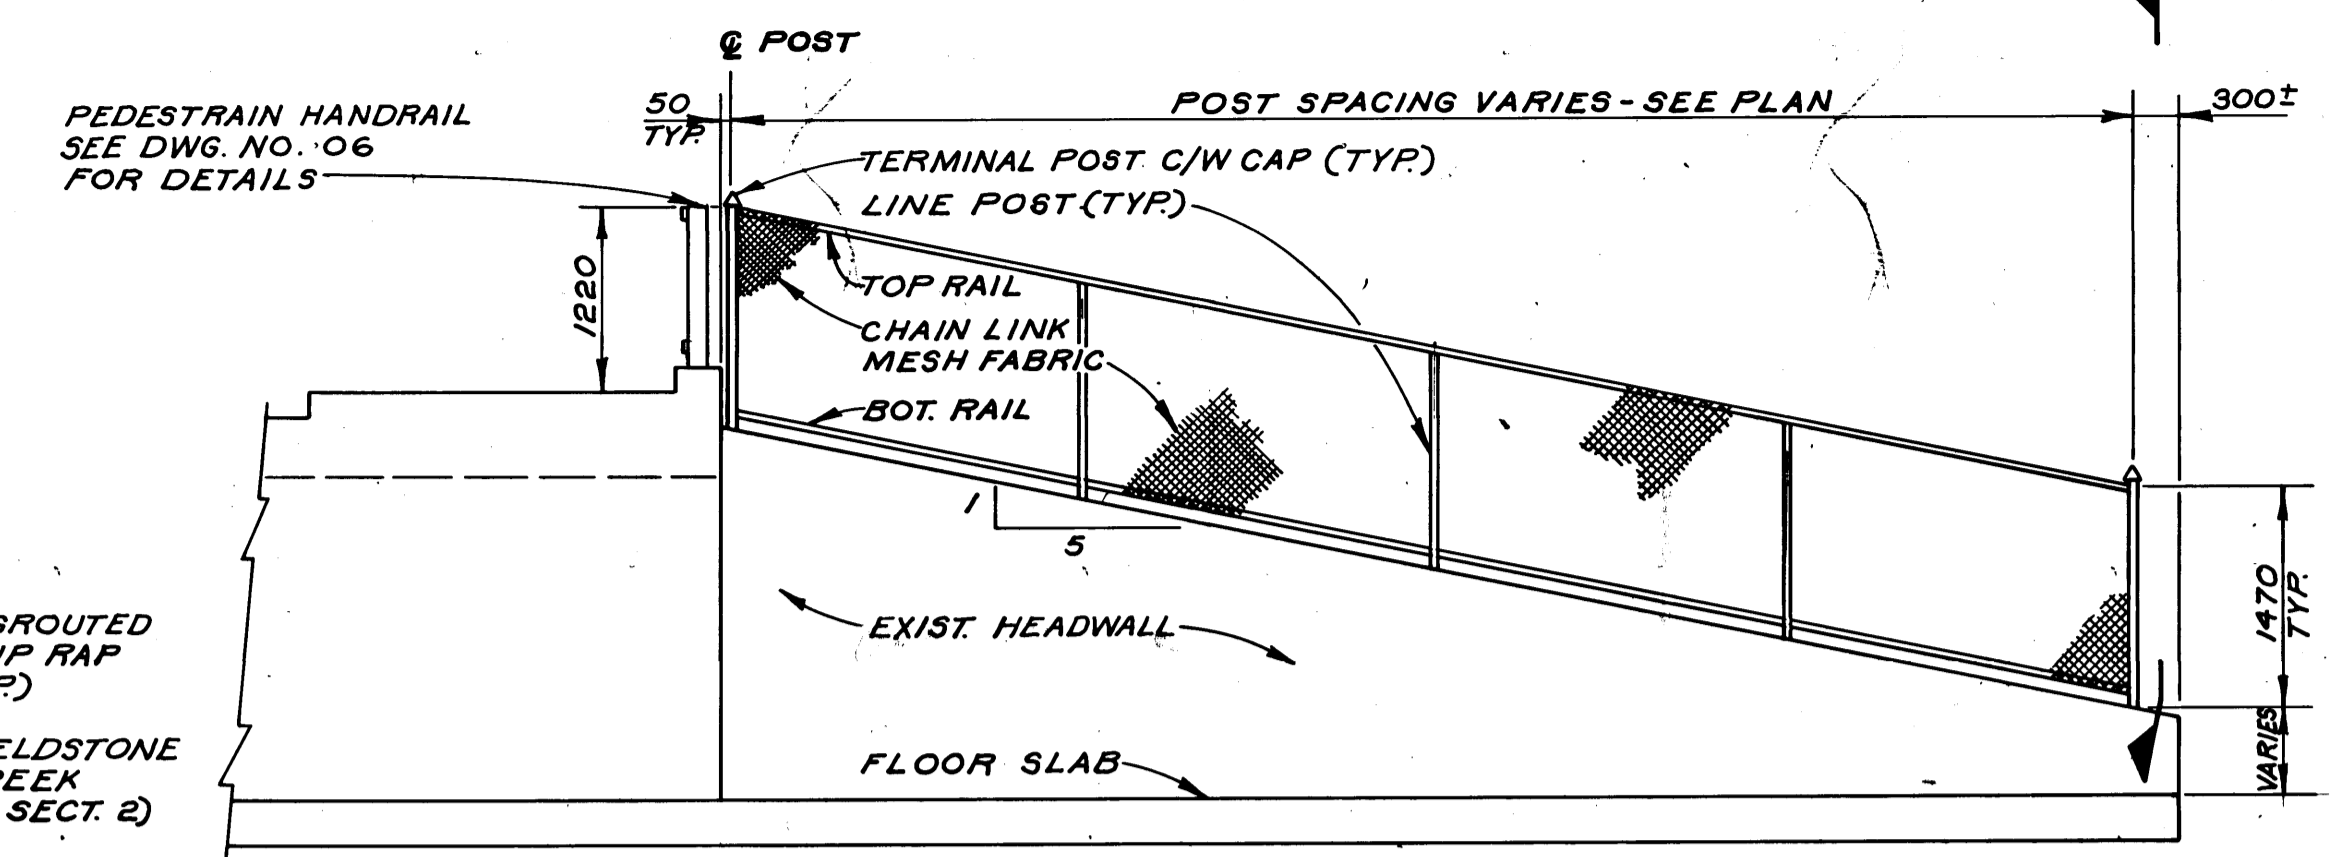


ELEVATION - SHOWING CHAIN LINK FENCE
SCALE: 1:50

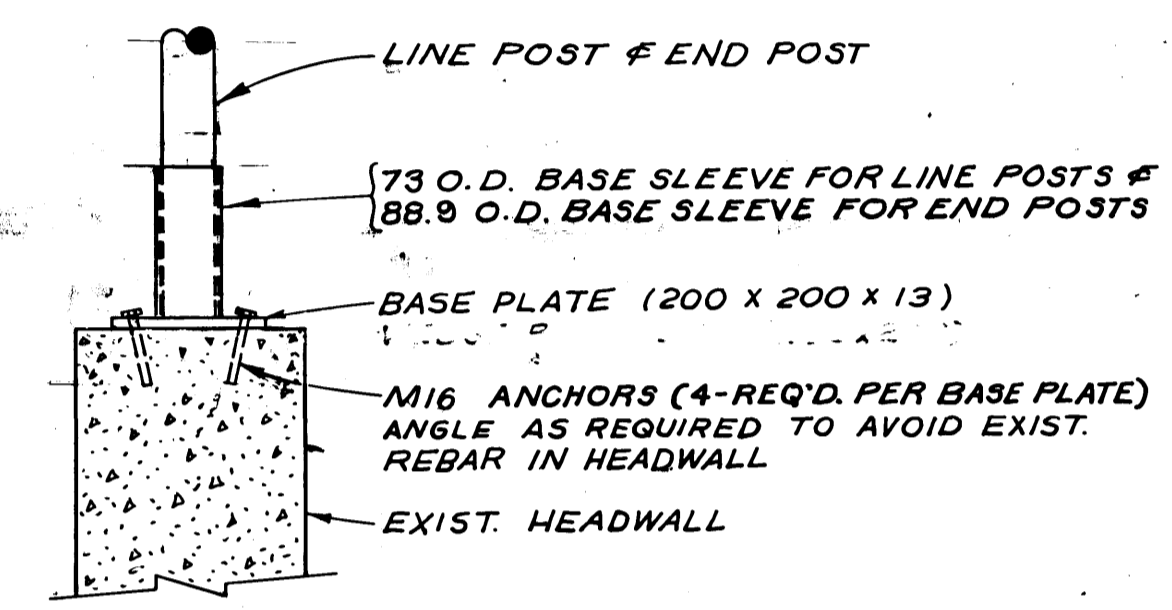


SECTION 1
SCALE: 1:10

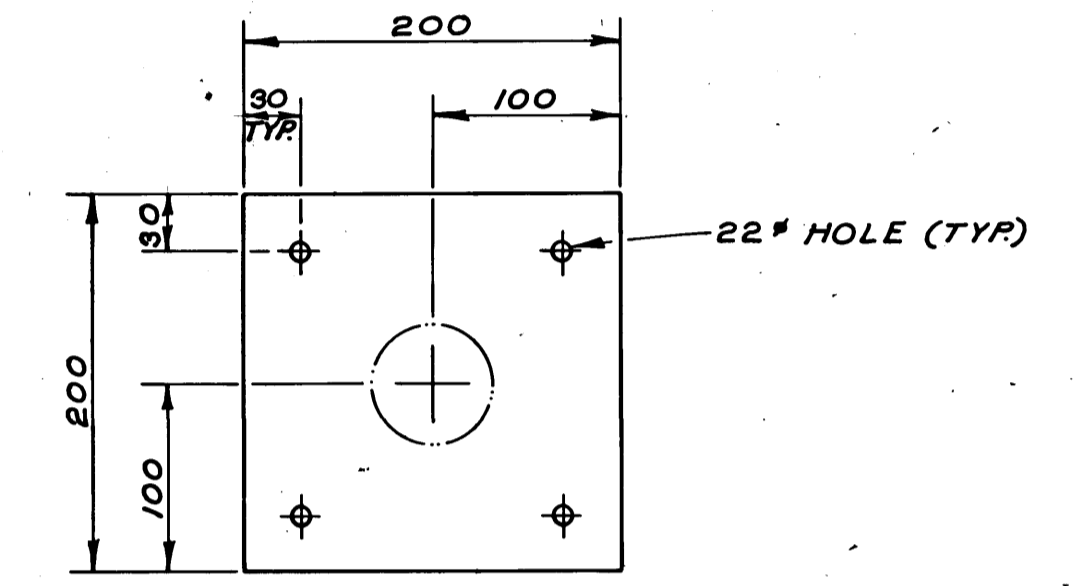


BASE PLATE DETAIL
SCALE: 1:40

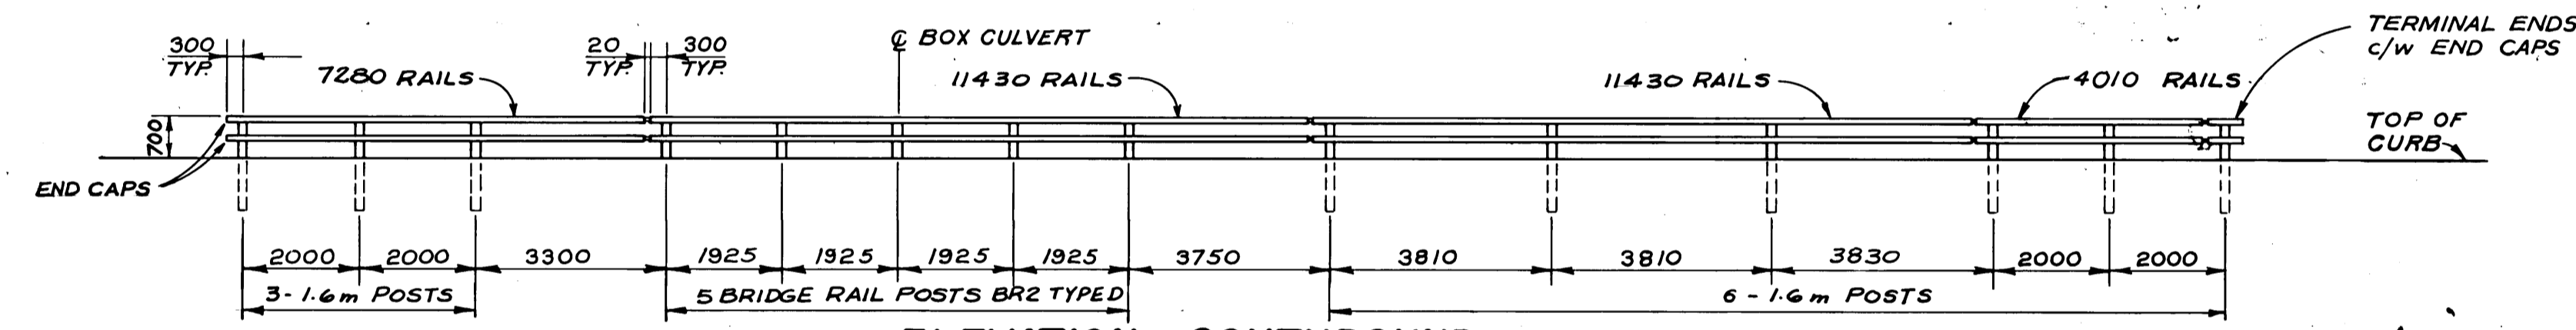


ELEVATION - SOUTHBOUND (LOOKING WEST)
SCALE: 1:100

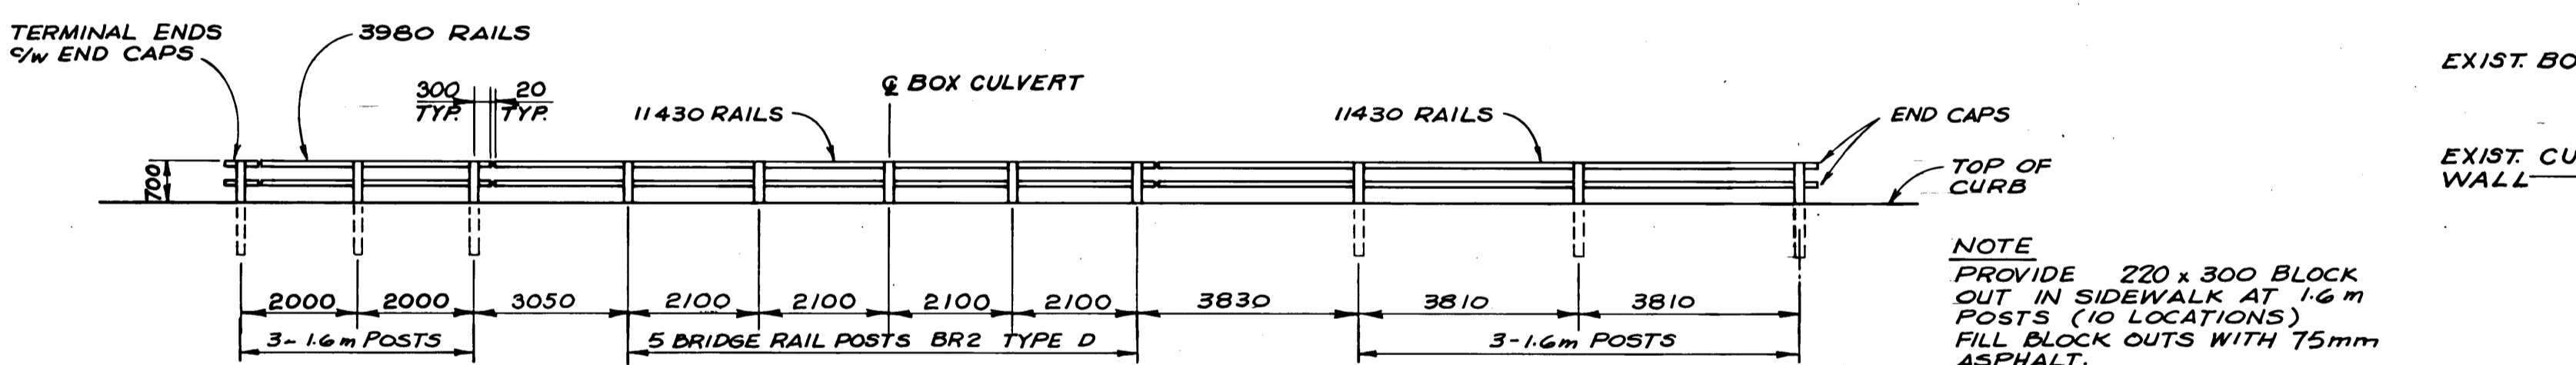

ELEVATION - NORTHBOUND (LOOKING WEST)
SCALE: 1:100

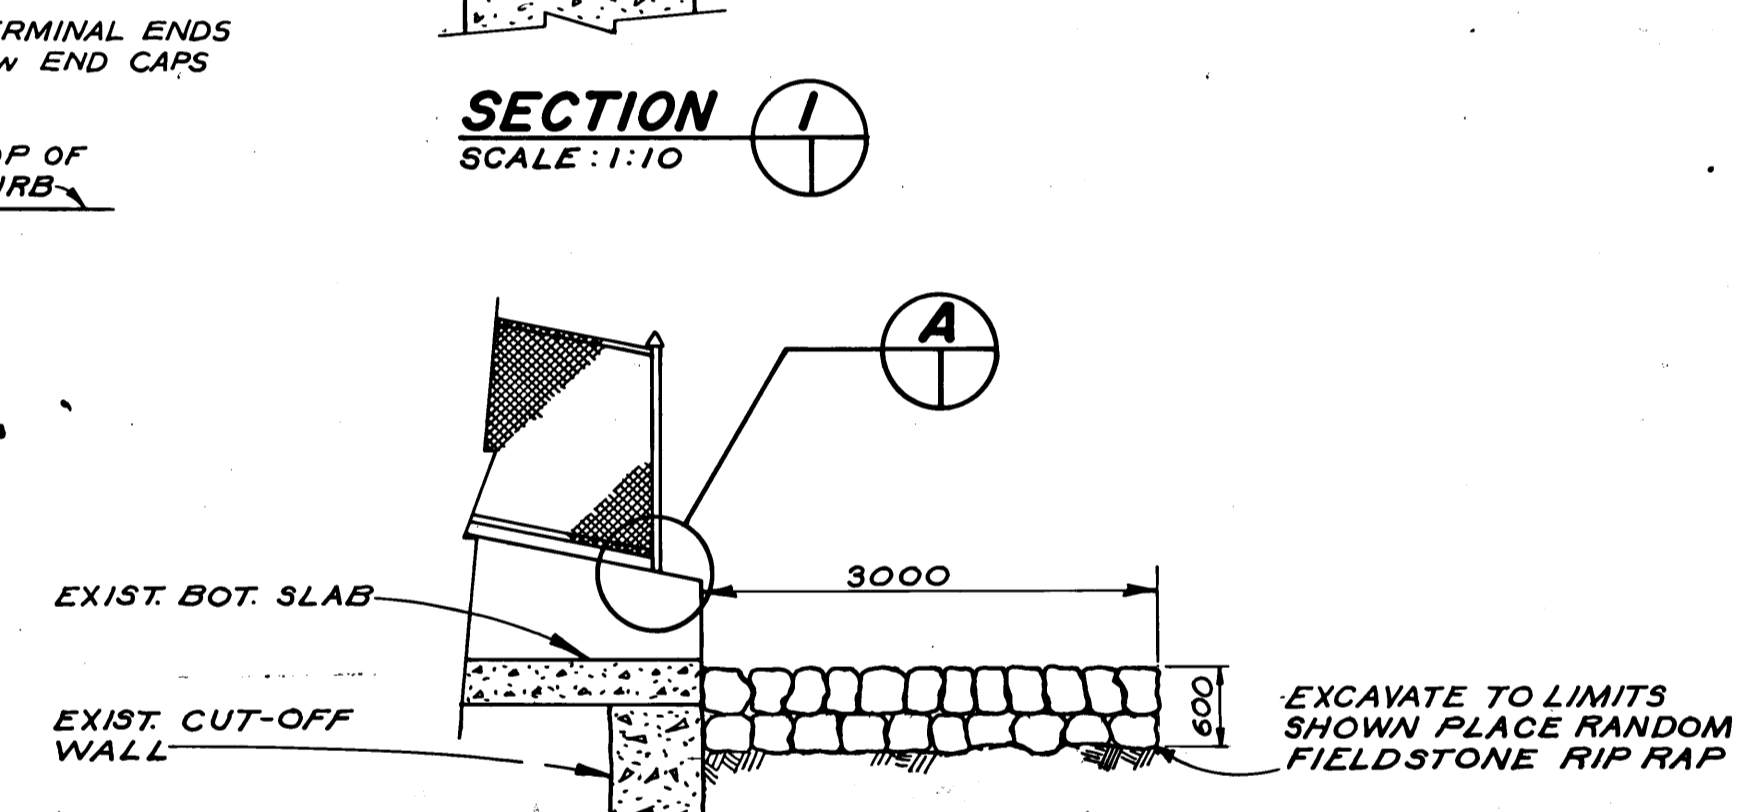


SECTION 2
SCALE: 1:50

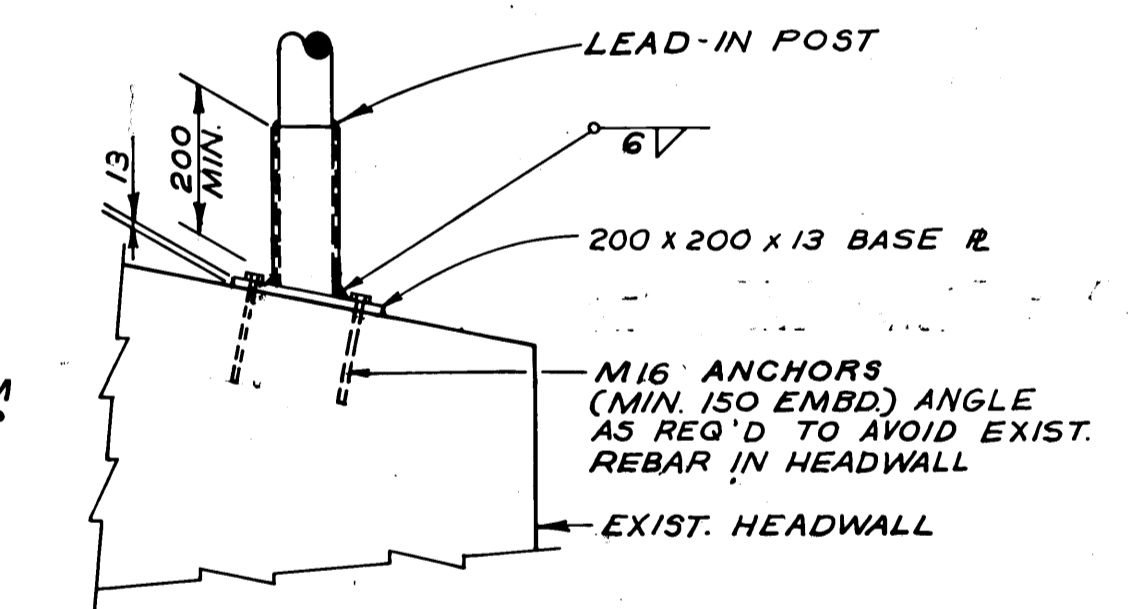

DETAIL A
SCALE: 1:50

NOTE
PROVIDE 220 x 300 BLOCK OUT IN SIDEWALK AT 1.6m POSTS (10 LOCATIONS) FILL BLOCK OUTS WITH 75mm ASPHALT.

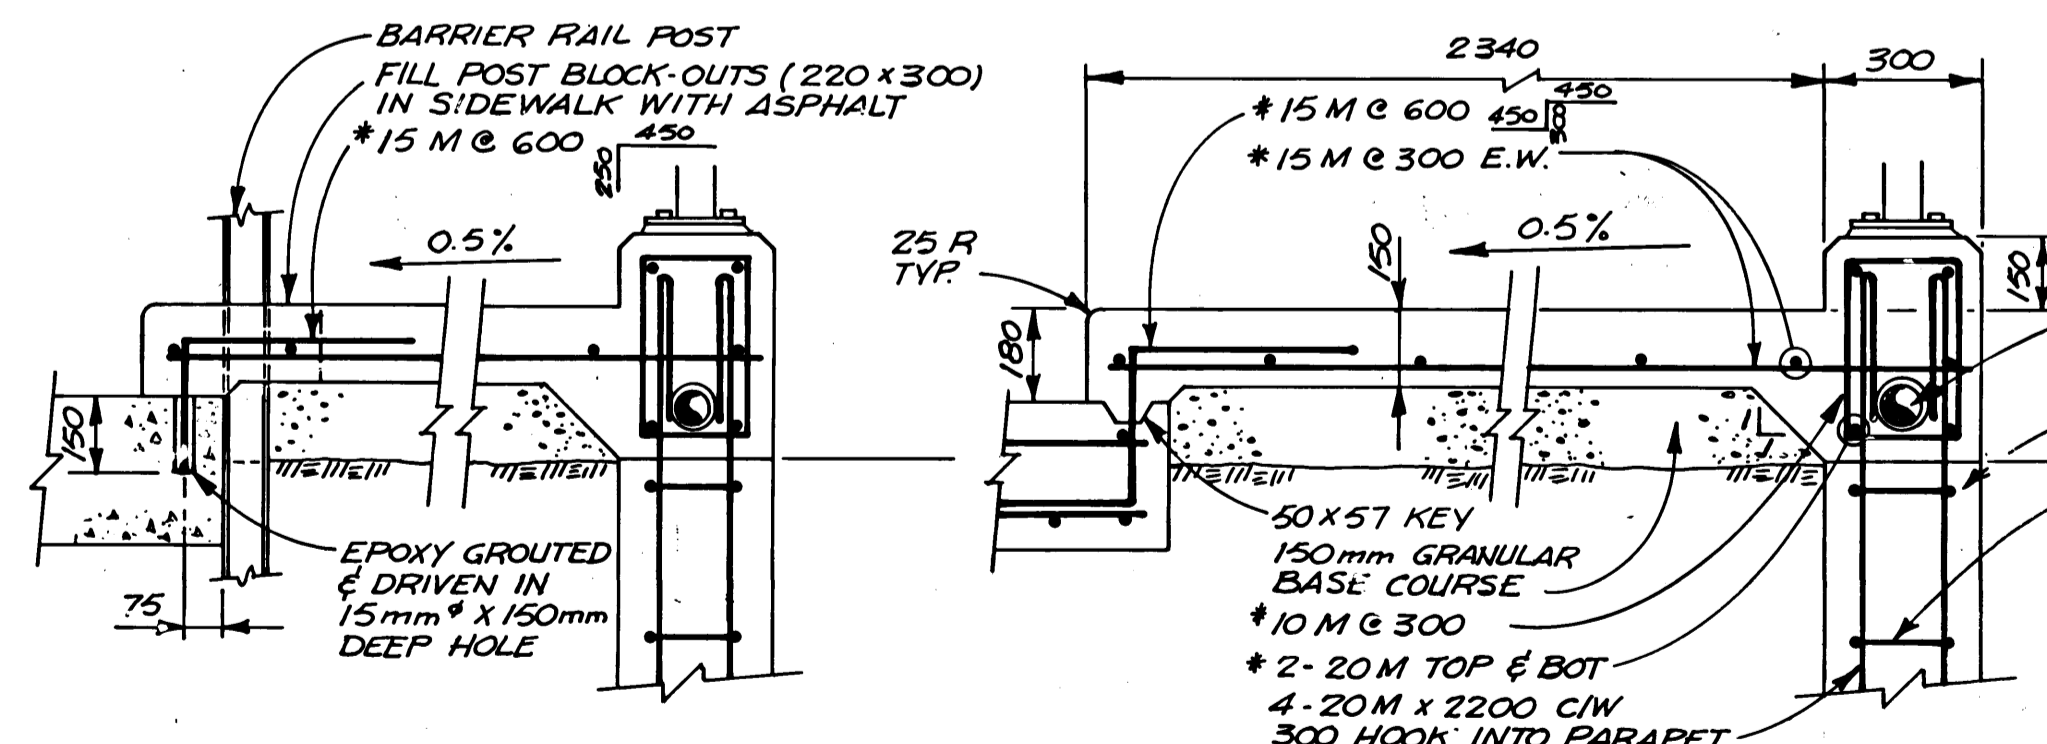

SECTION 5
SCALE: 1:15

SECTION 6
SCALE: 1:15

CHAINLINK FENCE NOTES

1. VERIFY ALL DIMENSIONS BY FIELD MEASUREMENTS PRIOR TO FABRICATION.
2. ALL FENCING MATERIALS TO BE GALVANIZED, AS SPECIFIED, AND TOUCHED UP USING "GALVALLOY".
3. CHAIN LINK MESH FABRIC TO BE CONNECTED TO POSTS AND RAILS WITH A "SLINKY" COIL.
4. NO SHARP POINTS SHALL REMAIN ON ENDS OF WIRE MESH FABRIC.
5. POSTS SHALL BE LEADED INTO GALVANIZED STEEL BASE SLEEVES.
6. POSTS AND RAILS TO BE SCH.40 PIPE.
7. ALL TERMINAL AND CORNER POSTS TO BE 73.0 mm O.D.
8. ALL LINE POSTS TO BE 60.3 mm O.D.
9. TOP AND BOTTOM RAILS TO BE 42.9 mm O.D.
10. FABRIC MESH TO BE 3.77 mm (9 GAUGE) WIRE.
11. ANCHOR BOLTS - TO BE S/S 20 mm Ø "KEYSTON ANCHOR SYSTEMS" EACH C/W S/S NUT AND S/S WASHER.

| ALUMINUM TRAFFIC BARRIER RAIL COMPONENTS BILL OF MATERIALS | | |
|--|------------------|-------------|
| ITEM | FOR INSTALLATION | FOR STANDBY |
| BARRIER RAIL 11430 (STRAIGHT) | 4 | - |
| BARRIER RAIL 11430 (PREBENT) | 4 | 1 |
| BARRIER RAIL 7280 (PREBENT) | 2 | 1 |
| BARRIER RAIL 4010 (PREBENT) | 2 | 1 |
| BARRIER RAIL 3980 (PREBENT) | 2 | 1 |
| TERMINAL ENDS | 4 | - |
| BRIDGE RAIL POSTS (BR 2 TYPE D) | 10 | - |
| BARRIER POST (1600) | 15 | 1 |
| STANDARD SPLICE BAR | 14 | - |
| RAIL CLAMP BAR | 104 | - |
| CAP SCREWS | 264 | - |
| WASHERS | 264 | - |
| SHIMS FOR RAIL POSTS | AS REQUIRED | - |
| SHIMS FOR RAIL END SECTION | AS REQUIRED | - |
| RAIL END CAPS | 8 | - |
| RAIL POST ANCHOR BOLTS | 50 | - |



NOTE: RADIUS OF ALL PREBENT RAILS SHALL BE CHECKED WITH FIELD MEASUREMENTS TO SUIT FIELD CONDITIONS PRIOR TO FABRICATION

WARNING

IF POWER EQUIPMENT OR EXPLOSIVES ARE TO BE USED FOR EXCAVATION ON THIS PROJECT THE CONTRACTOR MUST:
 1) NOTIFY THE GAS COMPANY OF THE PROPOSED LOCATION OF EXCAVATION.
 2) TAKE PRECAUTION TO AVOID DAMAGE TO GAS COMPANY INSTALLATIONS.
 SEE PROVINCIAL REGULATION 210/72 FOR DETAILS.

LOCATION APPROVED UNDERGROUND STRUCTURES

LOCATIONS OF UNDERGROUND STRUCTURES AS SHOWN ARE BASED ON THE BEST INFORMATION AVAILABLE, BUT NO GUARANTEE IS GIVEN THAT ALL EXISTING UTILITIES ARE SHOWN OR THAT THE GIVEN LOCATIONS ARE EXACT. CONFIRMATION OF EXISTENCE AND EXACT LOCATION OF ALL SERVICES MUST BE OBTAINED FROM THE INDIVIDUAL UTILITIES BEFORE PROCEEDING WITH CONSTRUCTION.

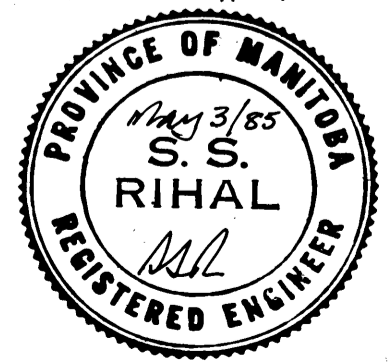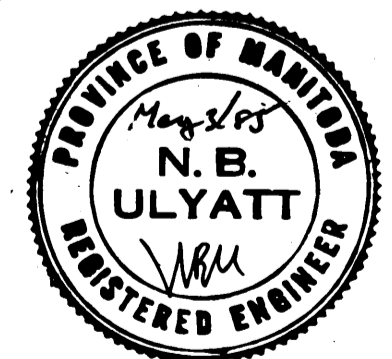

DILLON
Consulting Engineers & Planners

| | |
|--------------------------|------------------|
| DESIGNED BY: S.S.R. | DRAWN BY: C.R.B. |
| CHECKED BY: N.B.U. | DATE: MAY 85 |
| APPROVED BY: [Signature] | DATE: [Blank] |

THE CITY OF WINNIPEG
WORKS & OPERATIONS DIVISION
STREETS & TRANSPORTATION DEPARTMENT

ROUTE 90 CULVERT AT OMAND'S CREEK
TOP SLAB REHABILITATION, STRUCTURAL STRENGTHENING AND RELATED WORKS

LAYOUT OF BALANCED ALUMINUM SHOULDER BARRIER, HEADWALL CHAINLINK FENCE AND RIP RAP


AUTHORIZED BY: [Signature] 1985-05-03
ACCEPTED BY: [Signature] 1985-05-03

SCALE: 1:100 OR AS NOTED DRAWING NO: C315-85-07


AS BUILT
APPROVED BY: [Signature]

B-5530-7 METRIC


WHOLE NUMBERS INDICATE MILLIMETRES
DECIMAL NUMBERS INDICATE METRES

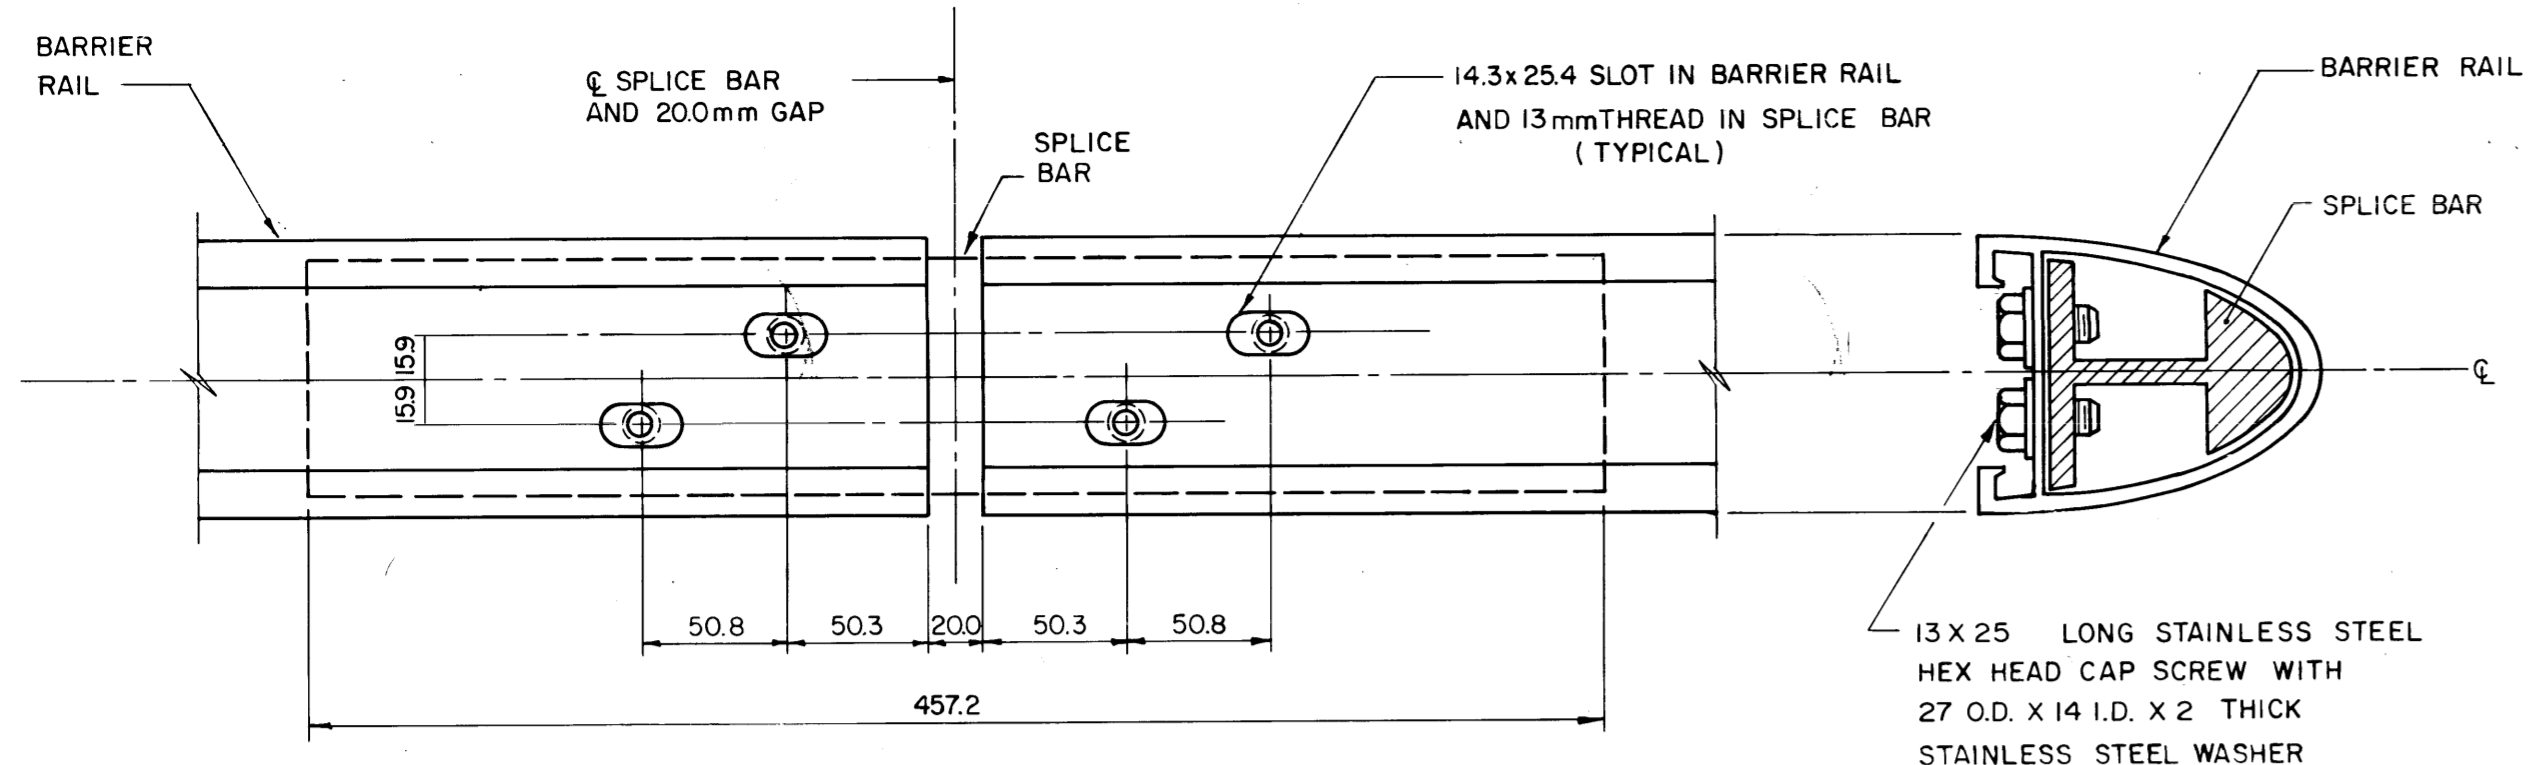


SPLICE BAR TO RAIL ASSEMBLY DETAIL

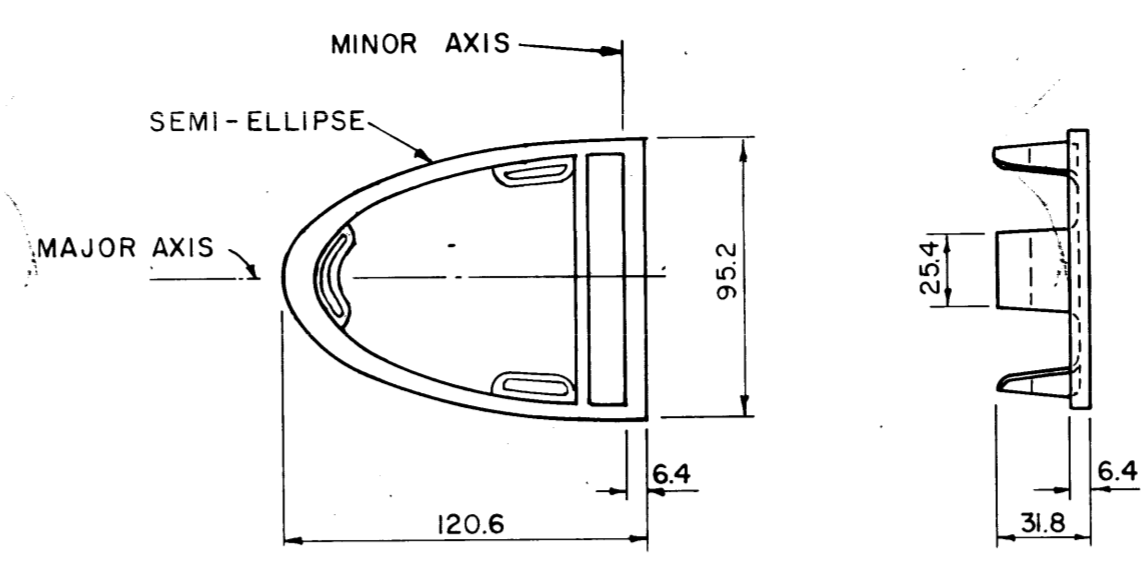


RAIL END CAP

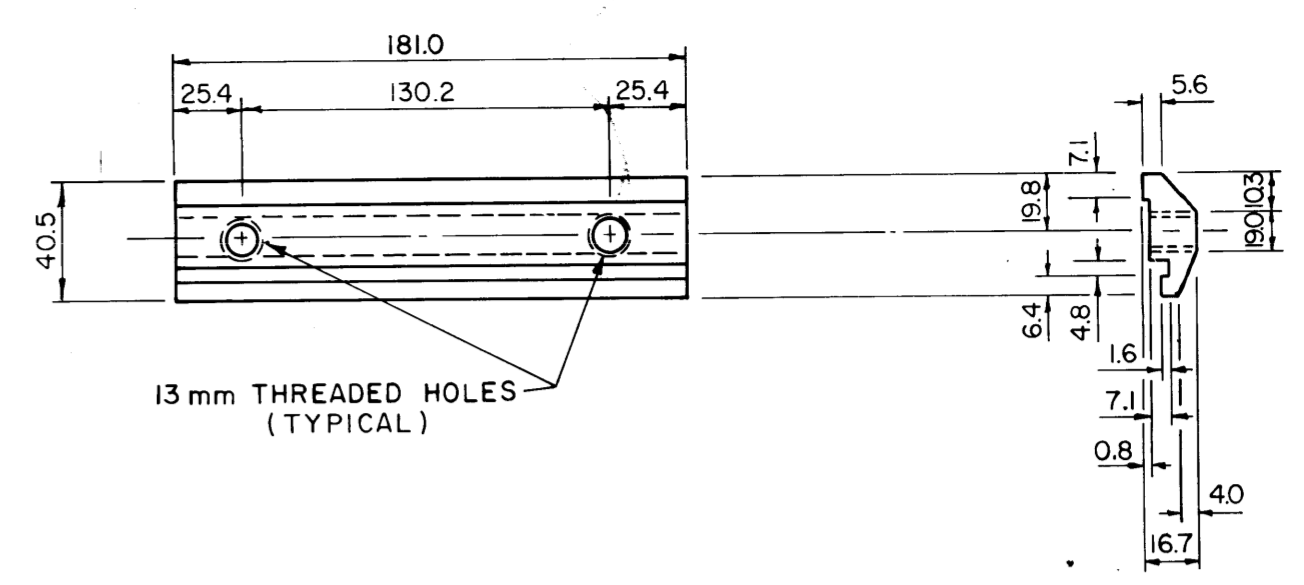


RAIL CLAMP BAR

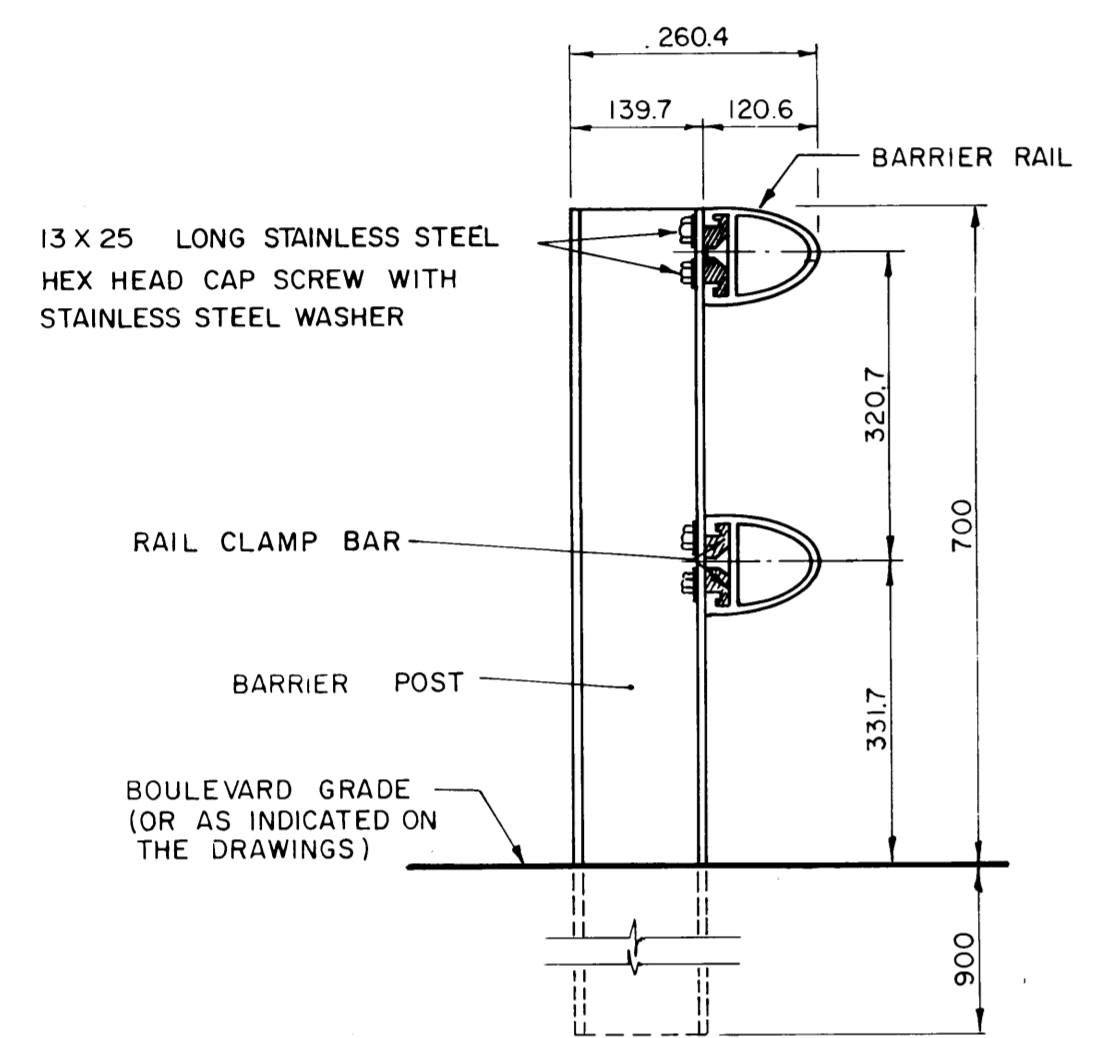


RAIL TO POST ASSEMBLY DETAIL

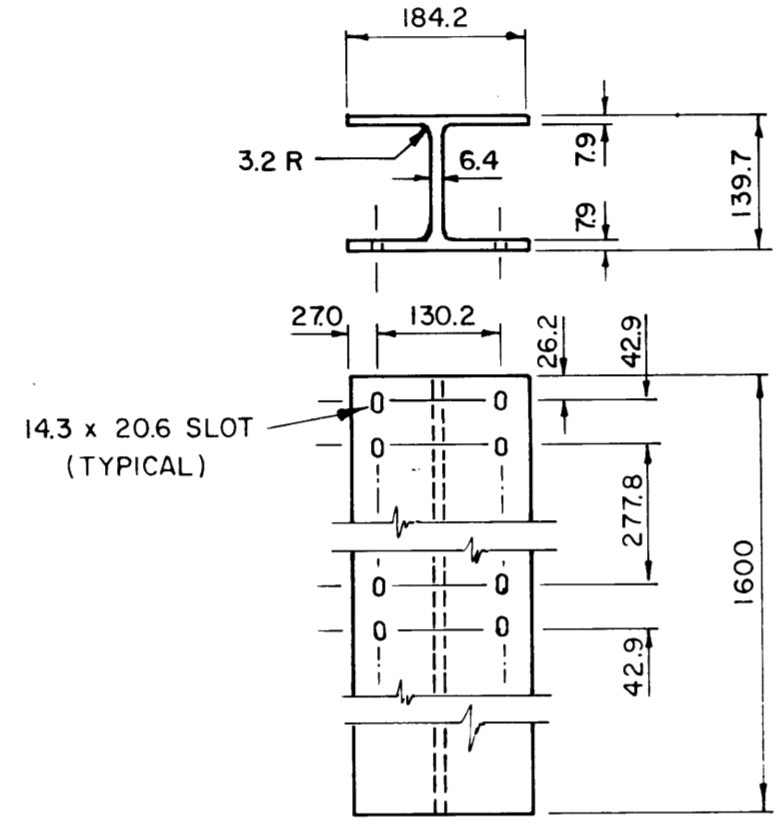


1600 m POST
(0800 m POST SIMILAR EXCEPT WITH ONLY FOUR SLOTS AT TOP OF POST)

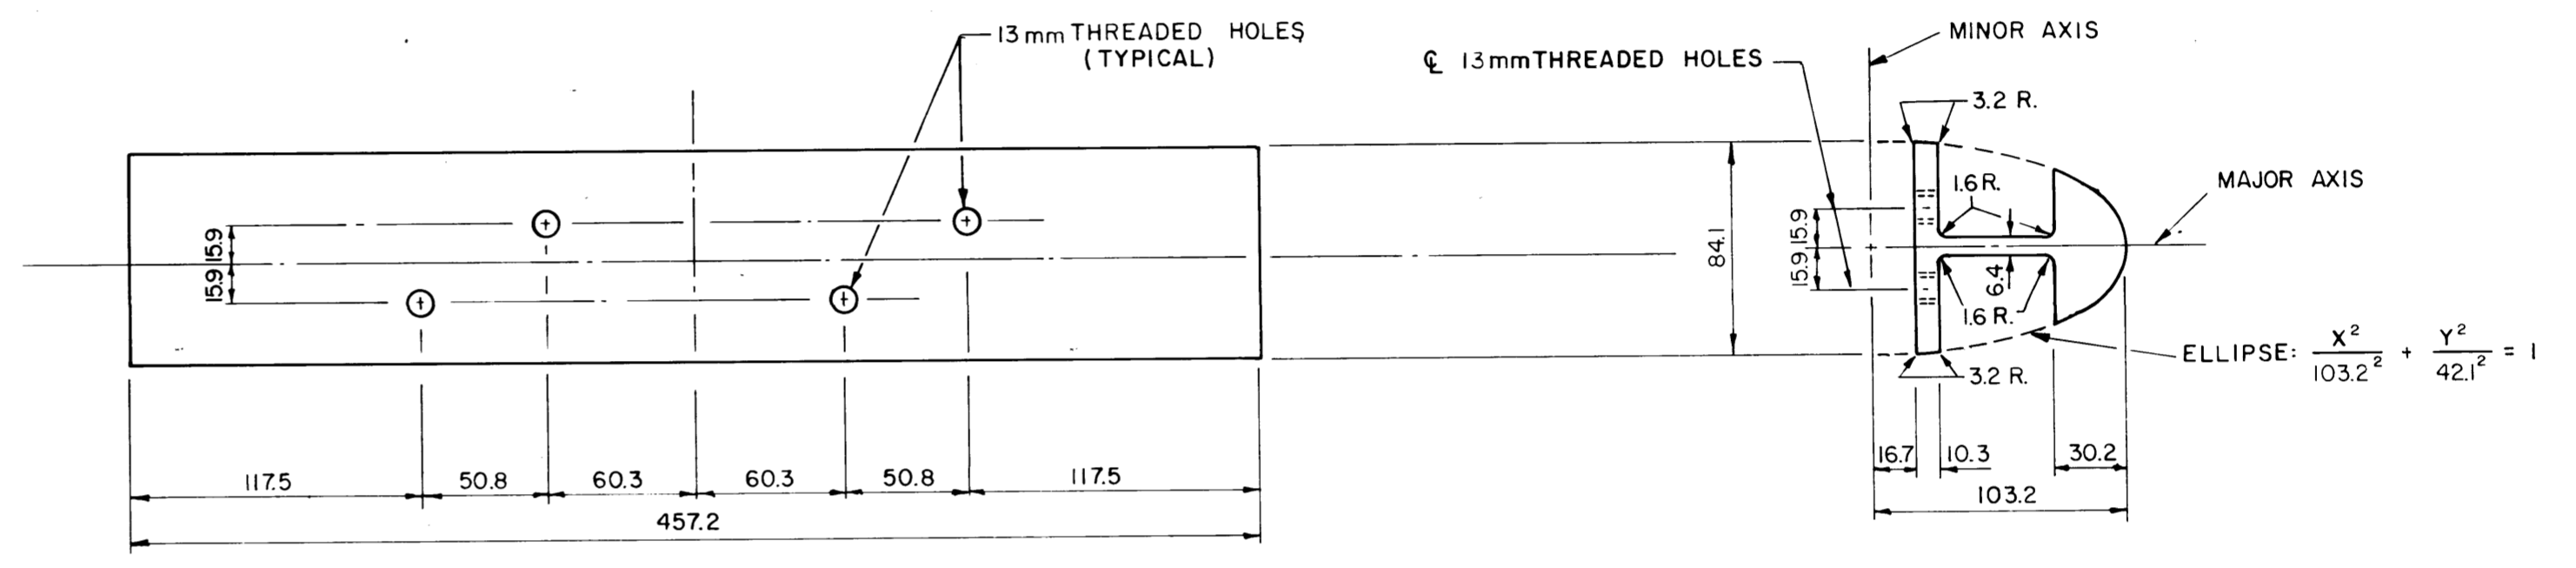


SPLICE BAR

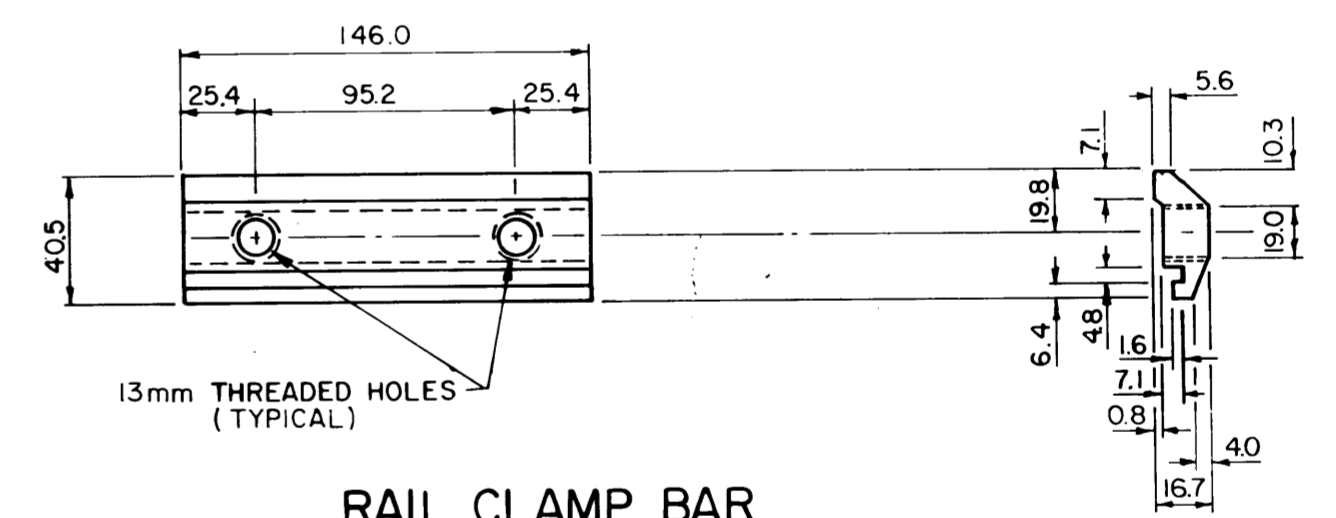

RAIL CLAMP BAR
(FOR BR1C BRIDGE RAIL POST)

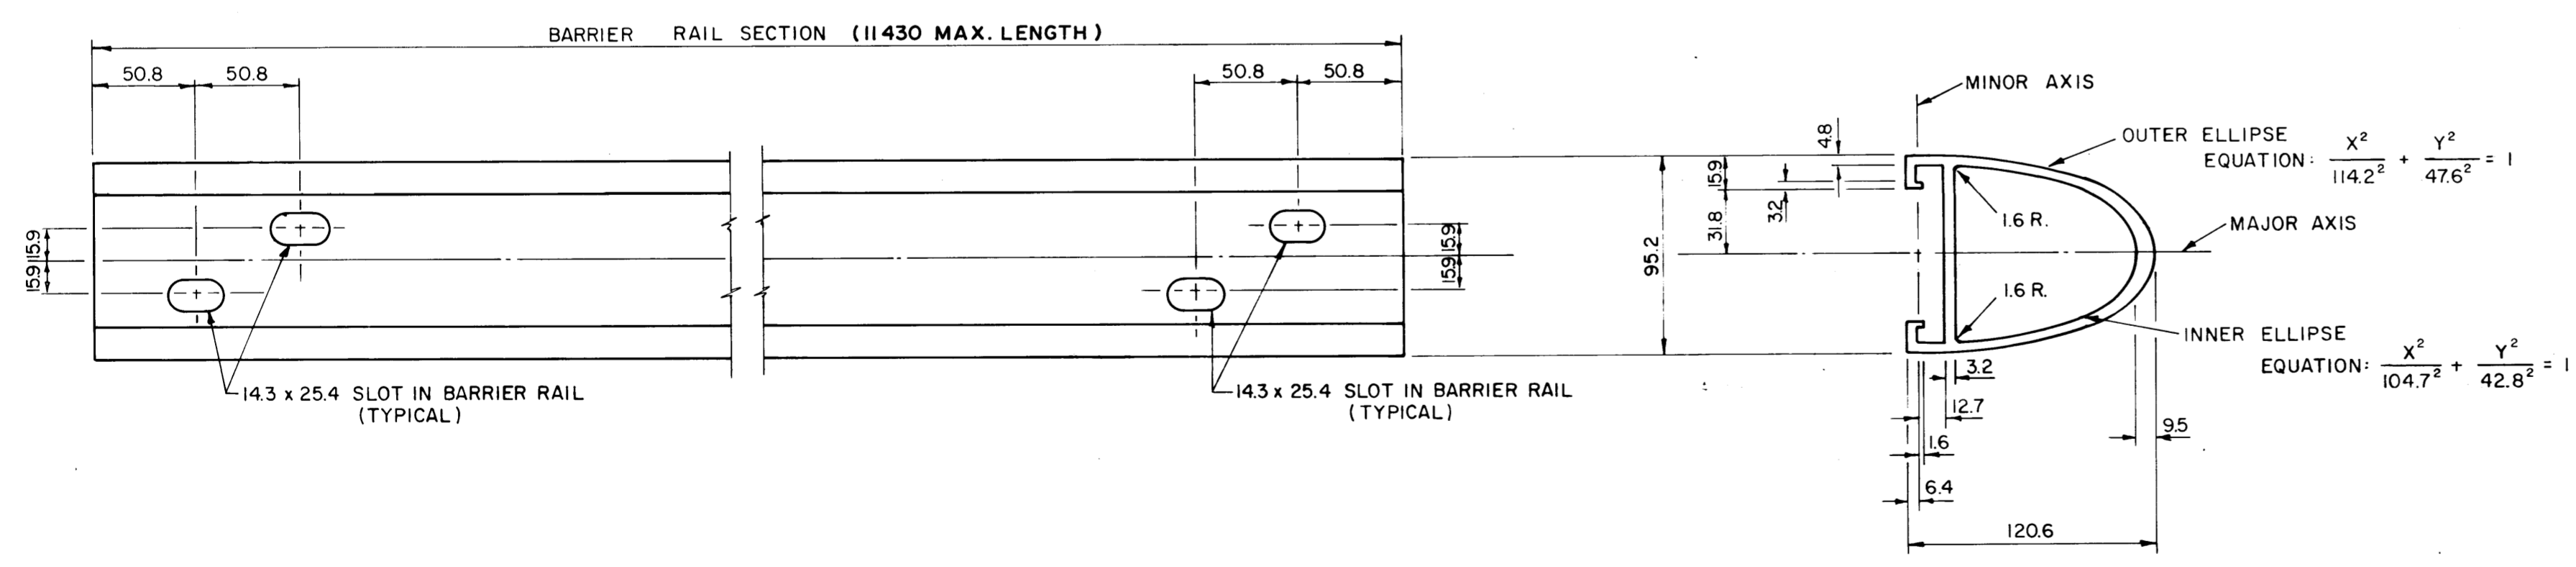

BARRIER RAIL

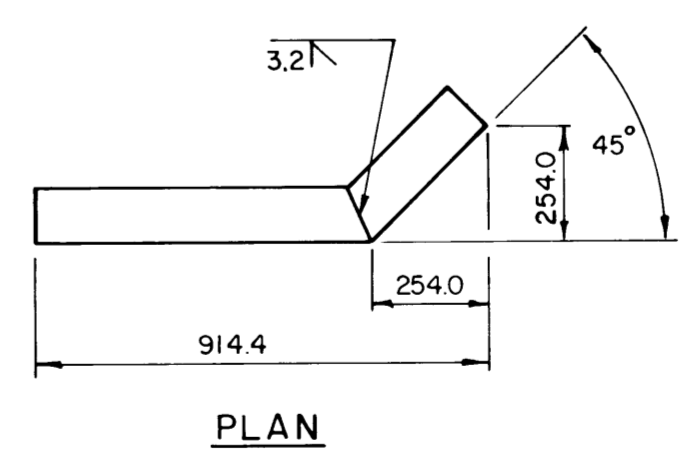

TERMINAL END
(FABRICATED FROM BARRIER RAIL)

MATERIAL SPECIFICATIONS

1. ALUMINUM RAILS, POSTS, SPLICE BARS, CLAMP-BARS, AND END CAPS SHALL CONFORM TO ASTM B221, ALLOY 6061-T6, OR ALLOY 6351-T6.
2. STAINLESS STEEL WASHERS SHALL CONFORM TO ASTM A296.
3. CAP SCREWS SHALL CONFORM TO ASTM A276, TYPE 316 STAINLESS STEEL.
4. NOTE THAT ALL FASTENERS ARE SPECIFIED IN IMPERIAL UNITS.

METRIC
ALL DIMENSIONS SHOWN ON THIS PLAN ARE IN MILLIMETRES EXCEPT AS OTHERWISE INDICATED

| NO. | REVISIONS | DATE | APP. |
|-----|-----------------------------|----------|------|
| R2 | RE-DRAWN | 83-12-21 | |
| R1 | BRIDGE RAIL CLAMP BAR ADDED | 83-6-16 | |

N.A.

DIRECON
Consulting Engineers & Planners

DESIGNED BY: N.A.
DRAWN BY: GFN
CHECKED BY: ZVK
DATE: 80-03-18
APPROVED BY: *John J. Parkin*
DATE: 83-12-22

THE CITY OF WINNIPEG
WORKS & OPERATIONS DIVISION
STREETS & TRANSPORTATION DEPARTMENT

ROUTE 90 CULVERT AT OMAND'S CREEK
TOP SLAB REHABILITATION, STRUCTURAL STRENGTHENING AND RELATED WORKS

BALANCED SHOULDER BARRIER STANDARD DETAIL

DESIGNED BY: *Winnipeg, P. Eng.* 1983-12-23
APPROVED BY: *John J. Parkin* 1983-12-22
SCALE: N.T.S. DRAWING NO: C315-85-08

B-5530-8

