

GENERAL NOTES

- THE GENERAL NOTES AND STRUCTURAL STANDARD DETAILS ARE GENERAL AND APPLY TO THE ENTIRE PROJECT EXCEPT WHERE THERE ARE SPECIFIC INDICATIONS TO THE CONTRARY.
- ALL DIMENSIONS ARE IN MILLIMETERS UNLESS NOTED OTHERWISE. ALL ELEVATIONS ARE IN METRES AND ARE TO GEODETIC DATUM. THE CONTRACTOR SHALL VERIFY DIMENSIONS BEFORE BEGINNING CONSTRUCTION AND REPORT DISCREPANCIES TO THE CONTRACT ADMINISTRATOR BEFORE PROCEEDING WITH THE WORK. DO NOT SCALE THE DRAWINGS.
- THE DESIGN AND CONSTRUCTION IS IN ACCORDANCE WITH THE NATIONAL BUILDING CODE OF CANADA 1995, ITS SUPPLEMENTS AND THE LATEST EDITIONS (UNLESS OTHERWISE NOTED) OF REFERENCED CODES AND STANDARDS THEREIN. WATER RETAINING STRUCTURES HAVE BEEN DESIGNED IN ACCORDANCE WITH ACI 350.
- REFER TO THE ARCHITECTURAL, MECHANICAL, AND ELECTRICAL DRAWINGS FOR LOCATIONS AND DIMENSIONS OF OPENINGS, SLEEVES AND OTHER BUILDING COMPONENTS NOT SHOWN ON THE STRUCTURAL DRAWINGS. REPORT DISCREPANCIES TO THE CONTRACT ADMINISTRATOR BEFORE PROCEEDING WITH CONSTRUCTION
- CONTRACTOR TO CONFIRM ALL OCCURRENCES OF INTERFERENCE BETWEEN NEW AND EXISTING. REPORT ALL DISCREPANCIES BETWEEN THAT SHOWN ON THE DRAWINGS AND THAT WHICH EXISTS TO THE CONTRACT ADMINISTRATOR, IMMEDIATELY UPON DISCOVERY. KEEP ACCURATE AS-BUILT RECORDS OF ALL NEW WORKS AND RELOCATED OR MODIFIED EXISTING FACILITIES.
- CONSTRUCTION METHODS REQUIRING TEMPORARY SHORING, OR BRACING, SHALL BE SUBMITTED TO THE CONTRACT ADMINISTRATOR FOR REVIEW. THE CONTRACTOR SHALL RETAIN A PROFESSIONAL ENGINEER, REGISTERED IN THE PROVINCE OF MANITOBA, TO PERFORM AND TAKE RESPONSIBILITY FOR ANY SHORING OR OTHER DESIGNS REQUIRED TO COMPLETE THE CONSTRUCTION.
- VERIFY LOCATION OF ALL UNDERGROUND SERVICES PRIOR TO COMMENCING CONSTRUCTION AND BE RESPONSIBLE FOR DISRUPTIONS.

FOUNDATION NOTES

- ALL FOUNDATION CONSTRUCTION SHALL BE PERFORMED TO THE RECOMMENDATIONS GIVEN IN THE GEOTECHNICAL REPORT BY DYREGROV CONSULTANTS, DATED FEB. 2006 AND AMENDMENTS.
- AN EXCAVATION PLAN SHALL BE PREPARED, SEALED AND SIGNED BY A PROFESSIONAL ENGINEER REGISTERED IN THE PROVINCE OF MANITOBA WITH EXPERIENCE IN GEOTECHNICAL ANALYSIS INCLUDING SLOPE STABILITY. SUBMIT EXCAVATION PLAN FOR REVIEW.
- IF SHORING IS USED IN THE CONSTRUCTION, THE SHORING SHALL BE DESIGNED, SEALED AND SIGNED BY A PROFESSIONAL ENGINEER REGISTERED IN THE PROVINCE OF MANITOBA. SUBMIT SHORING PLAN AND DETAIL FOR REVIEW. THE PROFESSIONAL ENGINEER RETAINED BY THE CONTRACTOR TO PROVIDE THE SHORING DESIGN SHALL INSPECT THE SHORING AT CRITICAL STAGES AND CERTIFY IN WRITING TO THE CONTRACT ADMINISTRATOR THAT IT MEETS THE REQUIREMENTS OF HIS DESIGN.
- ALL FOUNDATIONS ARE DESIGNED AS DRIVEN, END BEARING, PRESTRESSED PRECAST CONCRETE PILES WITH THE FOLLOWING DESIGN CAPACITY:
 - .1 300mm HEX - ALLOWABLE LOAD CAPACITY = 445 kN
 - .2 350mm HEX - ALLOWABLE LOAD CAPACITY = 625 kN
 - .3 400mm HEX - ALLOWABLE LOAD CAPACITY = 800 kN
- A MINIMUM OF 450 mm OF PRESTRESSING STRAND LENGTHS SHALL BE EXPOSED FOLLOWING THE PILE CUT-OFF.
- SEE PILE SCHEDULE FOR PREBORING REQUIREMENTS

CONCRETE NOTES

- PROVIDE CONCRETE AND PERFORM WORK TO CSA A23.1-00, TEST CONCRETE TO CSA A23.2-00. THE CONTRACTOR SHALL HAVE A COPY OF THESE STANDARDS ON SITE AT ALL TIMES.
- ALL STRUCTURAL CONCRETE STRENGTH REFER TO SPECIFICATIONS.
- PROVIDE CONCRETE AND PERFORM WORK TO CSA-A23.1-00 UNLESS SPECIFIED HEREIN. THE CONTRACTOR SHALL HAVE A COPY OF THIS STANDARD ON SITE AT ALL TIMES. IN THE EVENT OF CONFLICT, THE MOST STRINGENT REQUIREMENT SHALL APPLY.
- FORMWORK AND FALSEWORK DESIGN SHALL BE COMPLETED BY A PROFESSIONAL ENGINEER REGISTERED IN THE PROVINCE OF MANITOBA. SUBMIT TO CONTRACT ADMINISTRATOR FOR REVIEW.
- SPECIFIED SLUMPS ARE PRIOR TO THE ADDITION OF ANY ACCEPTED PLASTICIZING ADMIXTURE. WHEN CONCRETE IS PLACED BY PUMPING, THE LISTED SLUMPS SHALL BE AT DISCHARGE. ALL CONCRETE SHALL BE NORMAL WEIGHT 2400 kg/CUBIC METER UNLESS NOTED OTHERWISE.
- PROVIDE 20mm CHAMFER ON ALL EXPOSED CONCRETE CORNERS.
- CONSTRUCTION JOINTS : SURFACE PREPARATION SHALL BE BY SAND BLASTING TO EXPOSE FINE AGGREGATE. REINFORCING STEEL SHALL BE CLEANED BY SAND BLASTING METHOD AS WELL.
- VOID FORM UNDER THE SBR BUILDING STRUCTURE SHALL BE GEOSPAN (SOLID FOAM MATERIAL). ALL OTHER VOIDFORM SHALL BE WAX COATED CARDBOARD TYPICAL.
- THE CONTRACTOR SHALL NOTIFY THE INSPECTION AND TESTING FIRM, IN AMPLE TIME TO PERMIT SCHEDULING, PRIOR TO ANY CONCRETE POUR. IF AMPLE TIME IS NOT ALLOWED, ALTERNATE CONCRETE TESTS WILL BE PERFORMED TO THE SATISFACTION OF THE CONTRACT ADMINISTRATOR AND PAID FOR BY THE CONTRACTOR.
- AT LEAST THREE CONCRETE CYLINDERS WILL BE TAKEN FOR EVERY 75 CUBIC METERS OR LESS OF EACH CLASS OF CONCRETE PLACED. ADDITIONAL FIELD CYLINDERS MAY BE TAKEN AS DIRECTED BY THE CONTRACT ADMINISTRATOR TO EXPEDITE CONSTRUCTION. AIR AND SLUMP TESTS MAY BE TAKEN ON EVERY CONCRETE LOAD. SLUMP TESTS WILL BE TAKEN PRIOR TO ADDITION OF SUPERPLASTI-SIZER.

MASONRY NOTES

- ALL MASONRY WORK SHALL CONFORM TO CSA S304.1, A371 AND TO DETAILS SHOWN ON DRAWINGS.
- MASONRY BLOCK UNITS SHALL CONFORM TO CSA A165. CLASSIFICATION H/15/A/M WITH A MIN. UNIT STRENGTH OF 15MPa, UNLESS NOTED OTHERWISE.
- ALL MORTAR SHALL CONFORM TO CSA A179 AND SHALL BE TYPE 'S'.
- ALL LINTELS, BOND BEAMS, AND PILASTERS SHALL BE FILLED WITH CONCRETE HAVING A MINIMUM COMPRESSIVE STRENGTH OF 20 MPa.
- PROVIDE DOWELS FROM CONCRETE BEAMS OR WALLS TO MATCH MASONRY WALL REINFORCING.

REINFORCING STEEL NOTES:

- DEFORMED BARS CONFORMING TO CSA G30.18 GRADE 400 PLAIN FINISH.
- REINFORCING WORK SHALL BE IN ACCORDANCE WITH CSA-A23.1 AND CSA-A23.3.
- REINFORCING SHALL BE DETAILED IN ACCORDANCE WITH THE LATEST REINFORCING STEEL INSTITUTE OF CANADA DETAILING MANUAL OF STANDARD PRACTICE.
- PROVIDE CLEAR CONCRETE COVER OVER REBAR AS FOLLOWS:
 - a.) BEAM STIRRUPS: 40mm
 - b.) SLABS TOP: 65mm
 - c.) SLAB BOTTOM SUPPORT ON PILES: 100mm
 - d.) SLAB BOTTOM OTHER: 65mm
 - e.) SLAB SIDE: 65mm
 - f.) COLUMN TIES : 40mm
 - g.) WALLS : 50mm UNLESS NOTED OTHERWISE

STRUCTURAL & MISC. STEEL NOTES


- FABRICATE AND ERECT STRUCTURAL STEEL TO CSA-S16.1.
- PROVIDE STRUCTURAL STEEL SHAPES AND PLATES TO CSA-G40.21, GRADE 350W.
- STEEL PLATES AND SECTIONS: CONFORMING TO CSA G40.21; TYPE W WITH A MINIMUM YIELD STRENGTH OF 300 MPa.
- HOLLOW STRUCTURAL SECTIONS: CONFORMING TO CSA G40.21; TYPE W WITH A MINIMUM YIELD STRENGTH OF 350 MPa.
- ANCHOR BOLTS: CONFORMING TO ASTM A307.
- WELDING MATERIALS: CONFORMING TO CSA W59.
- WELDING OF ALL LOAD CARRYING ASSEMBLIES IS TO BE PERFORMED BY A FIRM CERTIFIED BY THE CANADIAN WELDING BUREAU TO THE REQUIREMENTS OF CSA W47.1 IN DIVISION 2.
- GROUT: NON-SHRINK, NON-METALLIC, 35 MPa AT 28 DAYS.
- SUPPLY ALL COMPONENTS REQUIRED FOR PROPER ANCHORAGE OF MISCELLANEOUS METALS. FABRICATE ANCHORAGE AND RELATED COMPONENTS OF SAME MATERIAL AND FINISH AS METAL FABRICATIONS, UNLESS OTHERWISE SPECIFIED OR SHOWN.
- GALVANIZING CONFORMING TO CSA G164.
- CLEAN ALL STEEL PRIOR TO PRIMING TO SSPC SURFACE PREPARATION SPECIFICATION No. 7 "BRUSH-OFF BLAST CLEANING".
- PRIME STEEL SURFACES WITH ONE COAT OF PRIMER TO CISC/CPMA 2-75.

MISCELLANEOUS METALS - ALUMINUM

- ALUMINUM: CONFORMING TO ALUMINUM ASSOCIATION ALLOY AND TEMPER DESIGNATION 6061-T6.
- PERFORM WELDING OF ALUMINUM IN ACCORDANCE WITH REQUIREMENTS OF CSA W59.2; COMPANY CERTIFICATION TO DIVISION 2.
- BOLTS AND ANCHOR BOLTS: CONFORMING TO STAINLESS STEEL ASTM 316 C/W ISOLATION WASHERS.
- BITUMINOUS PAINT: ALKALI RESISTANT.
- ISOLATE ALUMINUM FROM FOLLOWING COMPONENTS, BY MEANS OF BITUMINOUS PAINT: 2 COATS
 - DISSIMILAR METALS EXCEPT STAINLESS STEEL, ZINC, GALVANIZED, OR WHITE BRONZE OF SMALL AREA.
 - CONCRETE AND GROUT.

STANDARD ABBREVIATIONS:

ADDITIONAL	ADD'L	SECTION	SECT.
AT	⊙	SHEET	SHT.
ANCHOR BOLT	A. BOLT	SIMILAR	SIM.
ALTERNATE	ALTER.	SCHEDULE	SCH.
ALUMINUM	ALUM.	SPECIFICATION	SPEC.
APPROXIMATE	APPROX.	STAINLESS STEEL	S.S.
ARCHITECTURAL	ARCH.	STANDARD	STD.
AVERAGE	AVG.	STIFFENER	STIFF.
BOTTOM	BOT.	STIRRUP	STIRR.
BETWEEN	BET.	STRUCTURAL	STRUCT.
BUILDING	BLDG.	SYMMETRICAL	SYM.
BENCH MARK	B.M.	TOP OF	T.O.
BEARING	BRG.	TYPICAL	TYP.
BY (Between dims)	x (lower case)	UNLESS NOTED	U/N
CENTERLINE	⊥	VERTICAL	VERT.
CAST IN PLACE	C.I.P.	WIND LOAD	W.L.
CONCRETE MASONRY UNIT	C.M.U.		
CONSTRUCTION	CONST.		
CONSTRUCTION JOINT	C.J.		
COMPLETE WITH	C/W		
COLUMN	COL.		
CONCRETE	CONC.		
CONTINUOUS	CONT.		
DEAD LOAD	D.L.		
DIAMETER	DIA.		
DIMENSION	DIM.		
DOWN	DN.		
DOUBLE	DBL.		
DRAWING	DWG.		
DOWEL	DWL.		
EACH FACE	E.F.		
EACH	EA.		
EACH WAY	E.W.		
ELEVATION	EL.		
ELECTRICAL	ELEC.		
EQUAL	EQ.		
EXISTING	EXIST.		
EXPANSION JOINT	EXP. J.		
EXPANSION	EXP.		
EXTERIOR	EXT.		
FACE TO FACE	F. to F.		
FLOOR	FLR.		
FACE OF CONCRETE	F.O.C.		
FIBERGLASS REINFORCED PLASTIC	FRP.		
FOUNDATION	FDN.		
FOOTING	FTG.		
GALVANIZE	GALV.		
HANGER	HGR.		
HIGH WATER LEVEL	H.W.L.		
HORIZONTAL	HORIZ.		
HOLLOW STRUCTURAL STEEL	HSS		
HEIGHT	HT.		
HOLLOWCORE	H.C.		
INSIDE FACE	I.F.		
INSIDE DIAMETER	I.D.		
INTERIOR	INT.		
INVERT	INVT.		
KILONEWTON	kN		
K.O. MASONRY BLOCK	K.O.		
KILOPASCAL	kPa		
LIVE LOAD	LL		
LONG	LG.		
LOCATION	LOC.		
MATERIAL	MATL.		
MAXIMUM	MAX.		
MEGA PASCAL	MPa		
MECHANICAL	MECH.		
MILLIMETER	mm		
MINIMUM	MIN.		
MISCELLANEOUS	MISC.		
NUMBER	No.		
NOT TO SCALE	N.T.S.		
ON CENTER	o/c (lower case)		
OUTSIDE FACE	O.F.		
OUT TO OUT	o/o		
OUTSIDE DIAMETER	O.D.		
OPENING	OPNG.		
OPEN WEB STEEL JOIST	OWSJ.		
OPPOSITE	OPP.		
ORIGINAL	ORIG.		
PLATE	PL.		
POLY VINYL COMPOSITE	PVC.		
PRELIMINARY	PRELIM.		
PROJECTION	PROJ.		
REINFORCE WITH	R/W		
REINFORCING	REINF.		
REQUIRED	REQ'D		
REVISION	REV.		

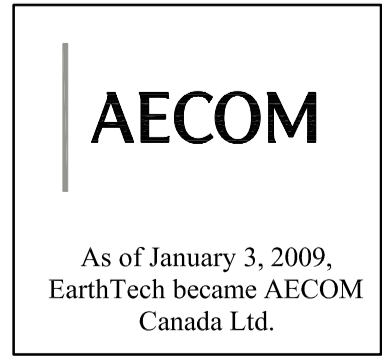

AECOM AS-CONSTRUCTED
 SIG..... DATE.....



B.M. ELEV.			
02 AS-CONSTRUCTED DRAWING	09/04/09	GLG	
01 ISSUED FOR CONSTRUCTION	06/08/30	GLG	
00 ISSUED FOR TENDER	06/05/15	WDB	
NO. REVISIONS	DATE	BY	

EarthTech
 A Tyco International Ltd. Company

DESIGNED BY	LLR	CHECKED BY	GGP
DRAWN BY	WDB	APPROVED BY	JEH
SCALE:		RELEASED FOR CONSTRUCTION BY:	K. MARTENS
DATE	2006/04/03	DATE	2006/05/15

ENGINEER'S SEAL
 ORIGINAL SIGNED BY
 L.L. RIDING
 2006/05/15
 CONSULTANT DRAWING NO.
 S0.01


THE CITY OF WINNIPEG
 WATER AND WASTE DEPARTMENT
 ENGINEERING DIVISION

Winnipeg


NEUPCC CENTRATE NUTRIENT TREATMENT NITROGEN REMOVAL FACILITY

CITY FILE NUMBER
 SHEET OF
 CITY DRAWING NUMBER
 1-0101C-S0001-001-02


STRUCTURAL SBR BUILDING GENERAL NOTES

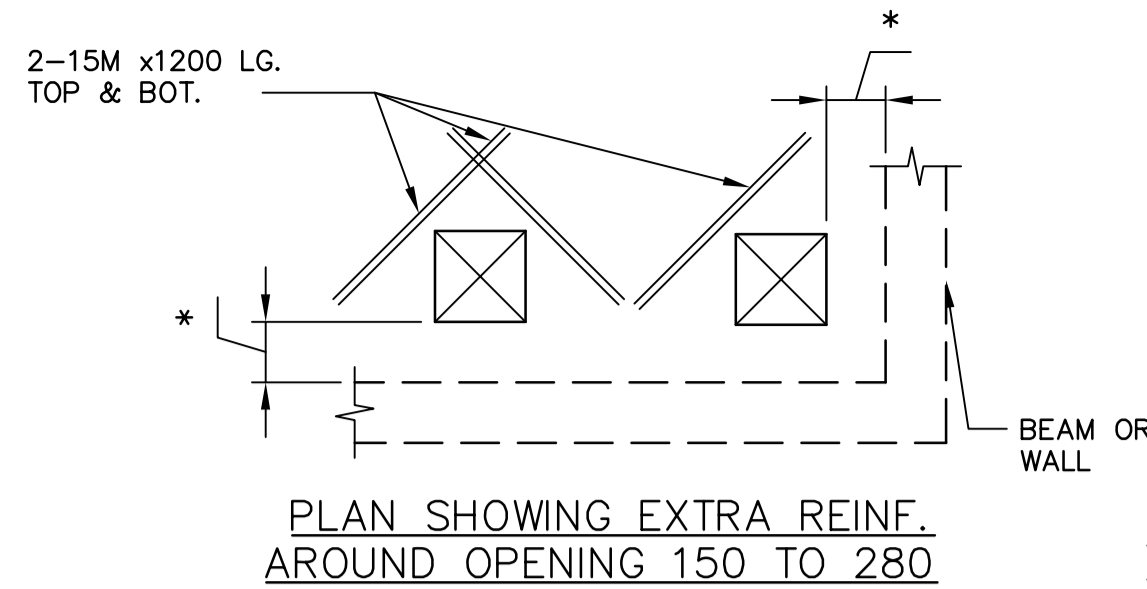


PLAN SHOWING EXTRA REINF. AROUND OPENING 150 TO 280

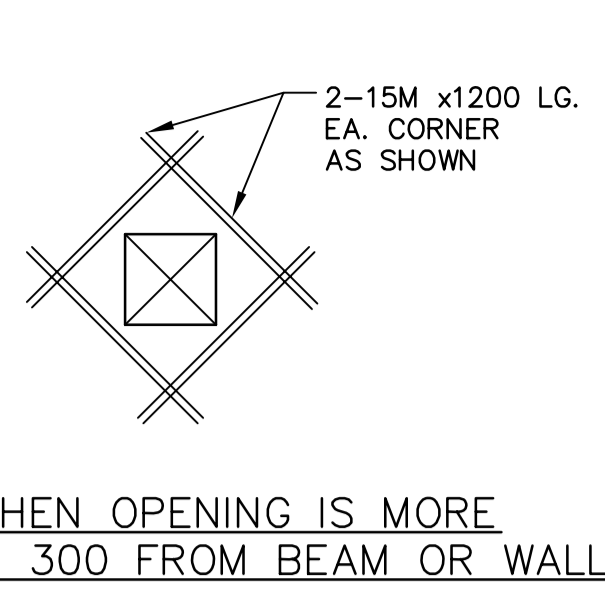

WHEN OPENING IS MORE THAN 300 FROM BEAM OR WALL

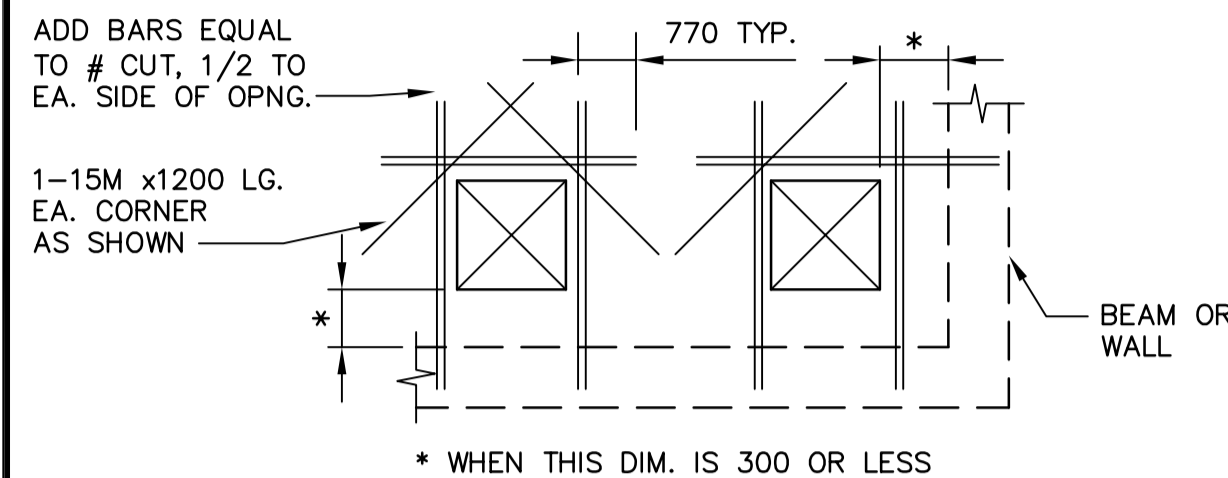


PLAN SHOWING EXTRA REINF. AROUND OPENING 300 TO 760

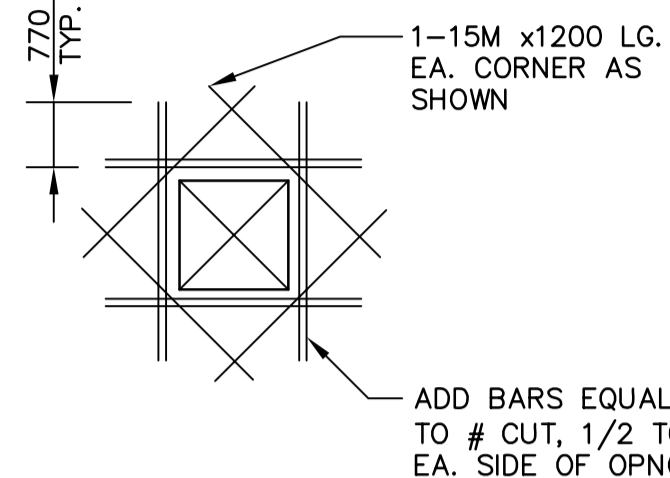


WHEN OPENING IS MORE THAN 300 FROM BEAM OR WALL

TYPICAL REINFORCING AROUND OPENINGS IN CONCRETE SLAB OR WALL
SCALE N.T.S.


1. NUMBER OF REINFORCING BARS TO BE CUT AT OPENING TO BE KEPT AT A MINIMUM. DEFLECT AS MANY BARS AS POSSIBLE AROUND OPENING.
2. REINFORCING BARS TO BE KEPT MINIMUM 50 CLEAR OF OPENING.
3. CIRCULAR OPENINGS TO BE TREATED IN SAME MANNER AS RECTANGULAR UNLESS OTHERWISE DETAILED.

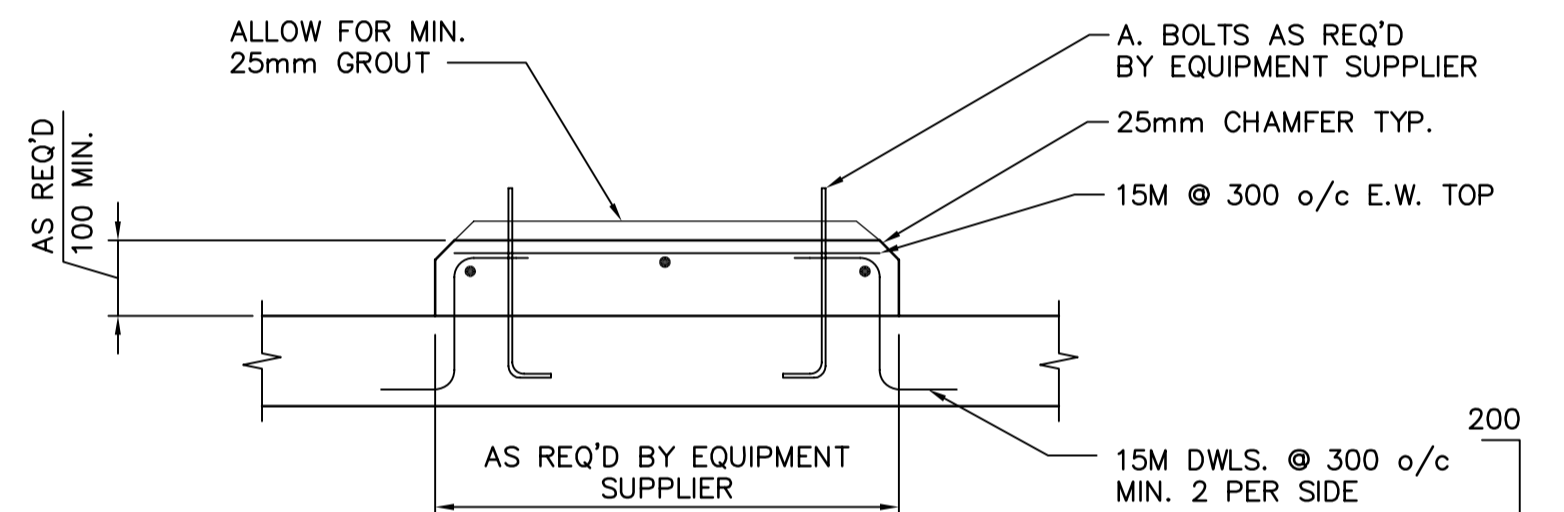


HOUSE KEEPING PADS FOR EQUIPMENT ON STRUCTURAL SLAB U/N OTHERWISE
SCALE N.T.S.

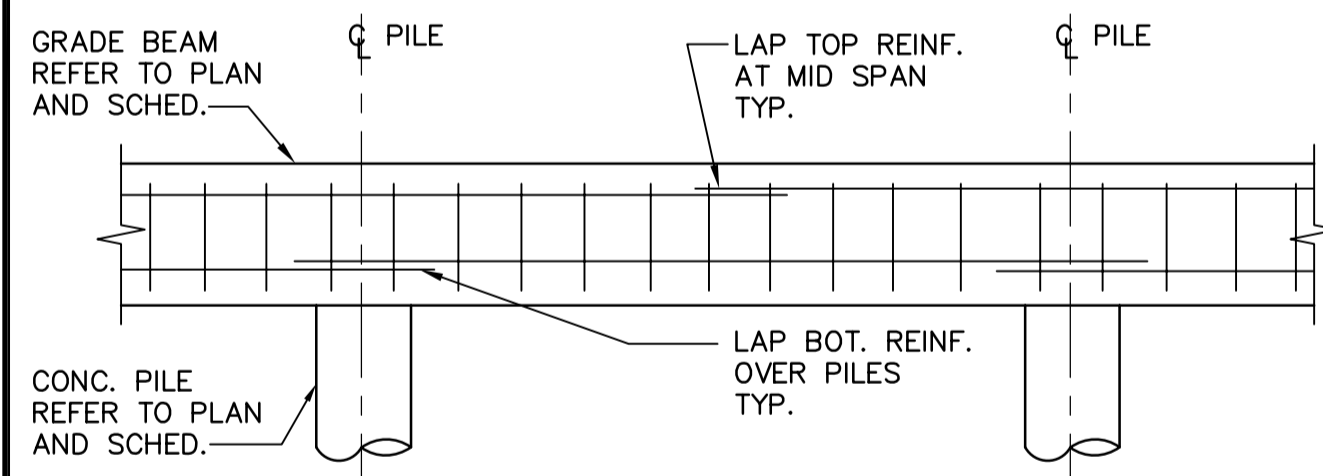


GRADE BEAM SPLICE DETAIL
SCALE N.T.S.

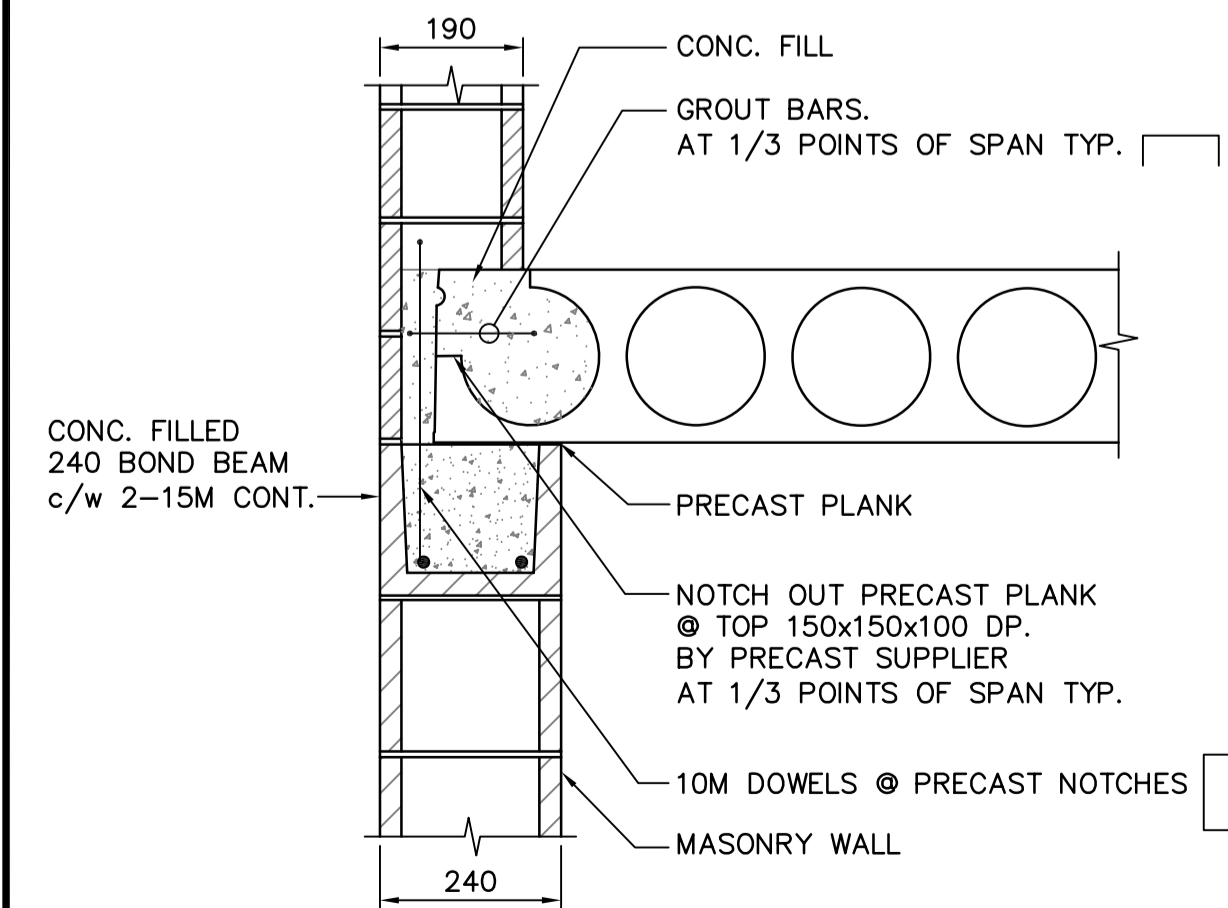


PRECAST PLANK PARALLEL TO MASONRY WALL DETAIL 1
SEE DWG S3.06 FOR MASONRY REINF.

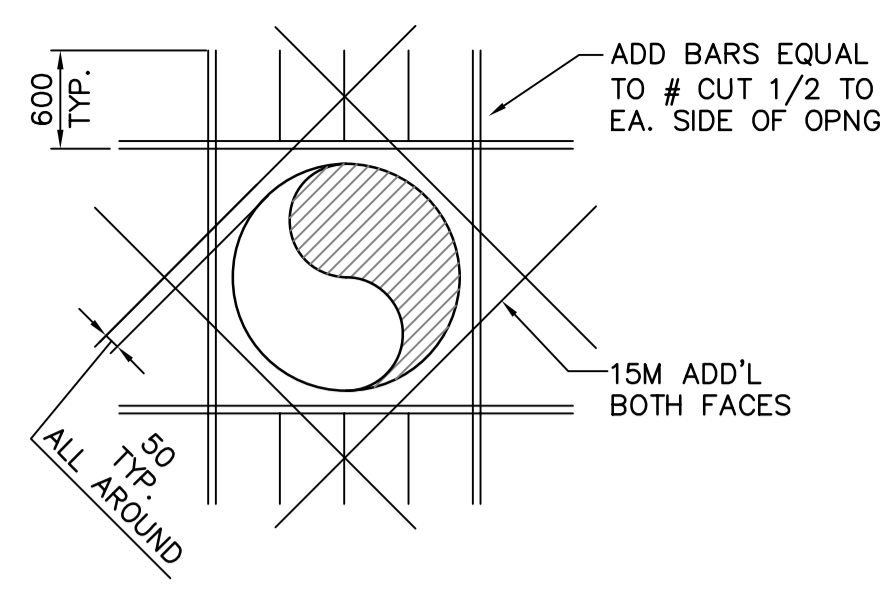


EXTRA REINFORCING AROUND PIPE UP TO 1250Ø MAX. CAST IN WALL OR FLOOR SLAB
SCALE N.T.S.

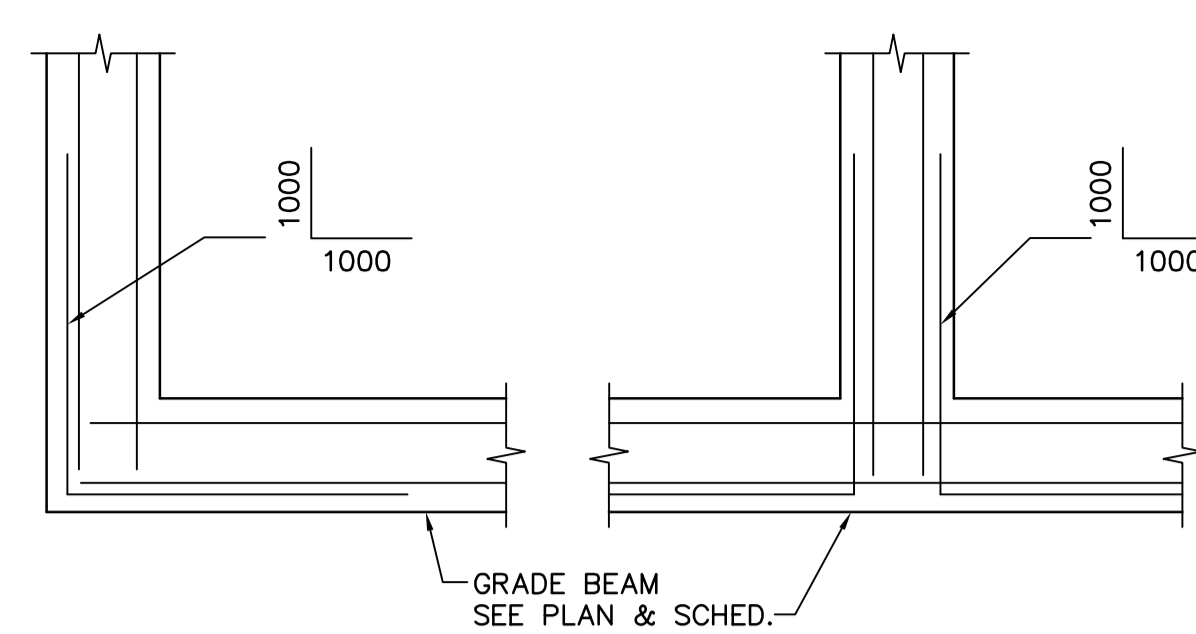

TYPICAL GRADE BEAM CORNER REINFORCING
SCALE N.T.S.
CORNER BARS SAME SIZE AND SPACING AS HORIZONTAL REINFORCING

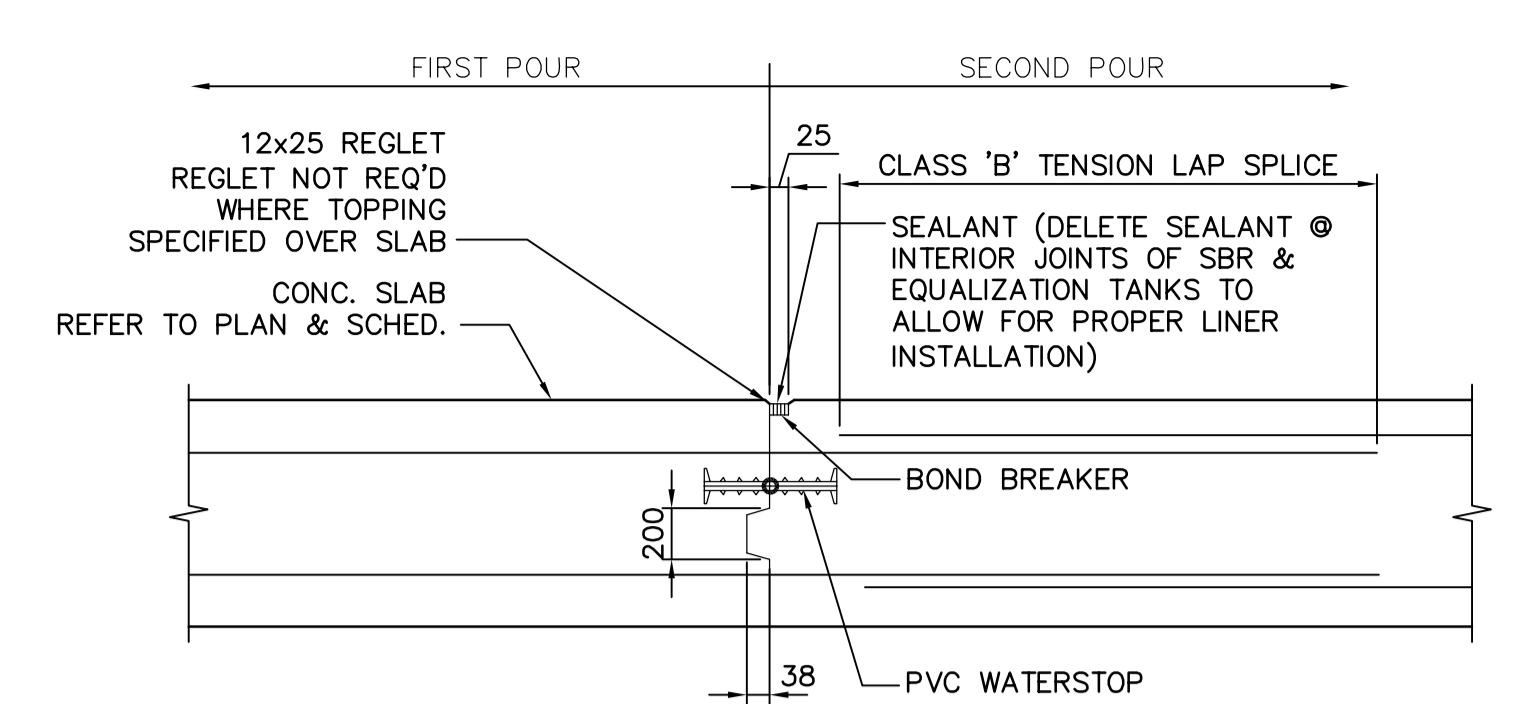


CONCRETE SLAB CONSTRUCTION JOINT
SCALE N.T.S.
TRANSVERSE REINFORCING NOT SHOWN FOR CLARITY.

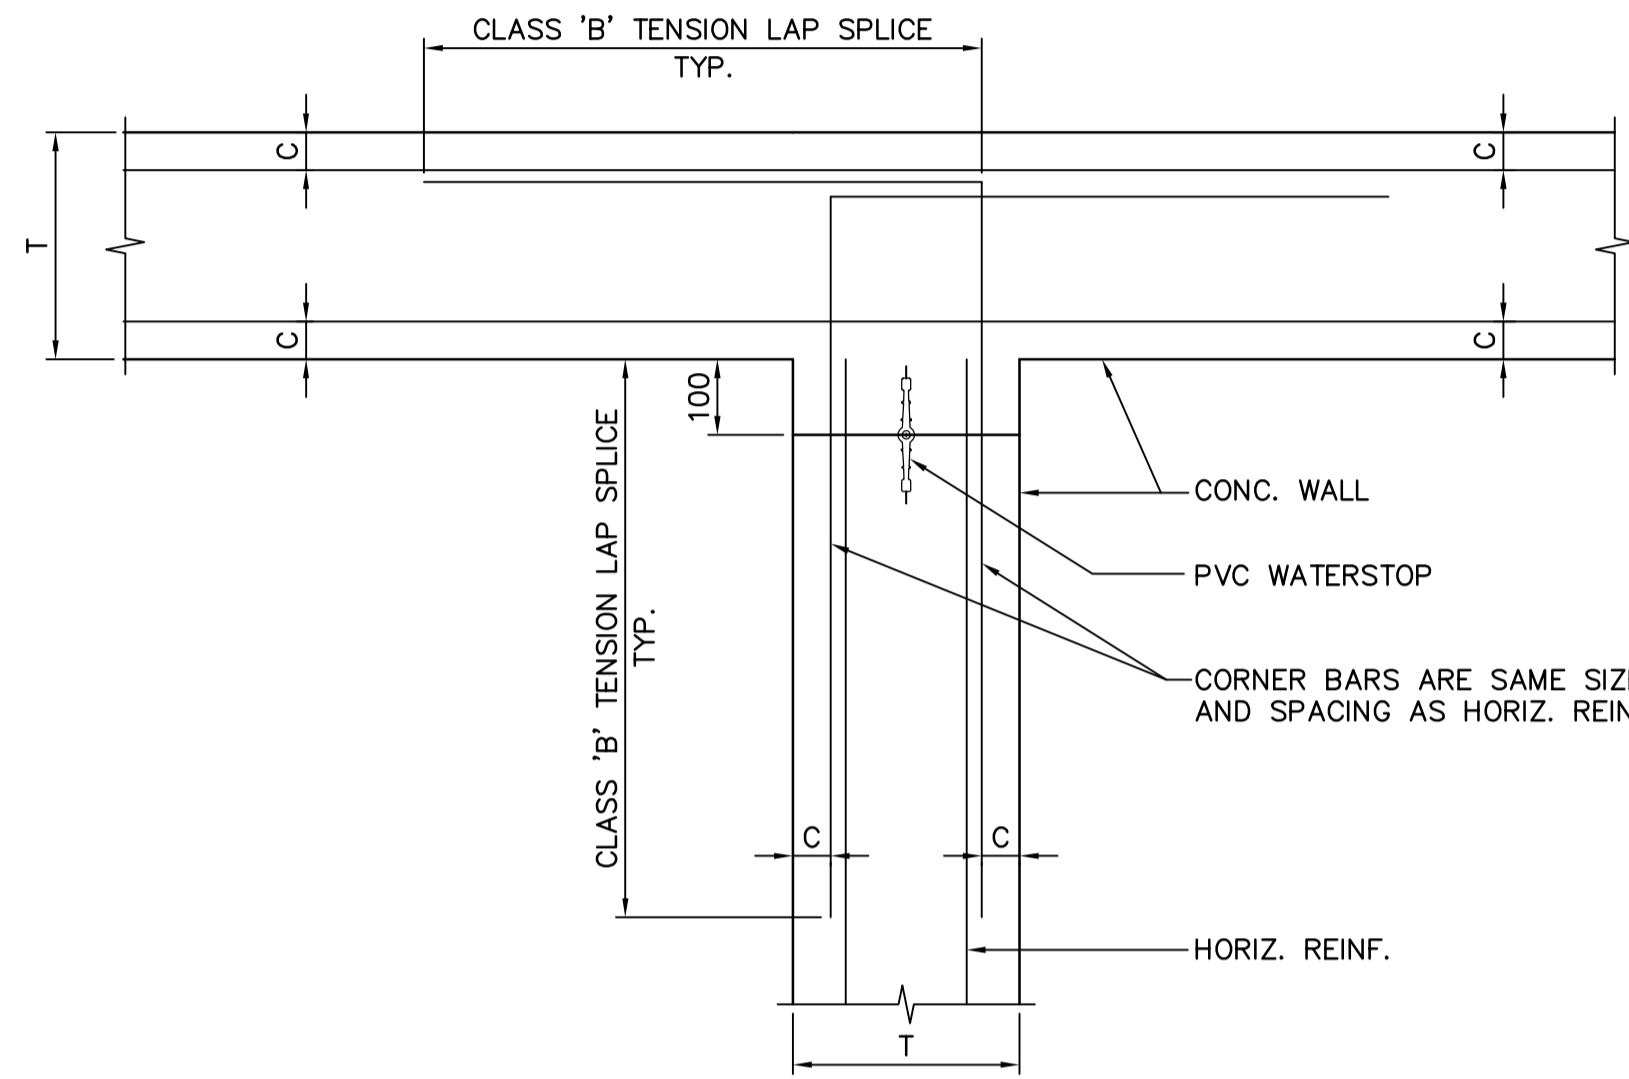


TYPICAL REINFORCING FOR WALL INTERSECTION
SCALE N.T.S.


VERTICAL REINFORCING NOT SHOWN FOR CLARITY.
C = CONC. COVER AS SPECIFIED
T = WALL THICKNESS, REFER TO SCHED.

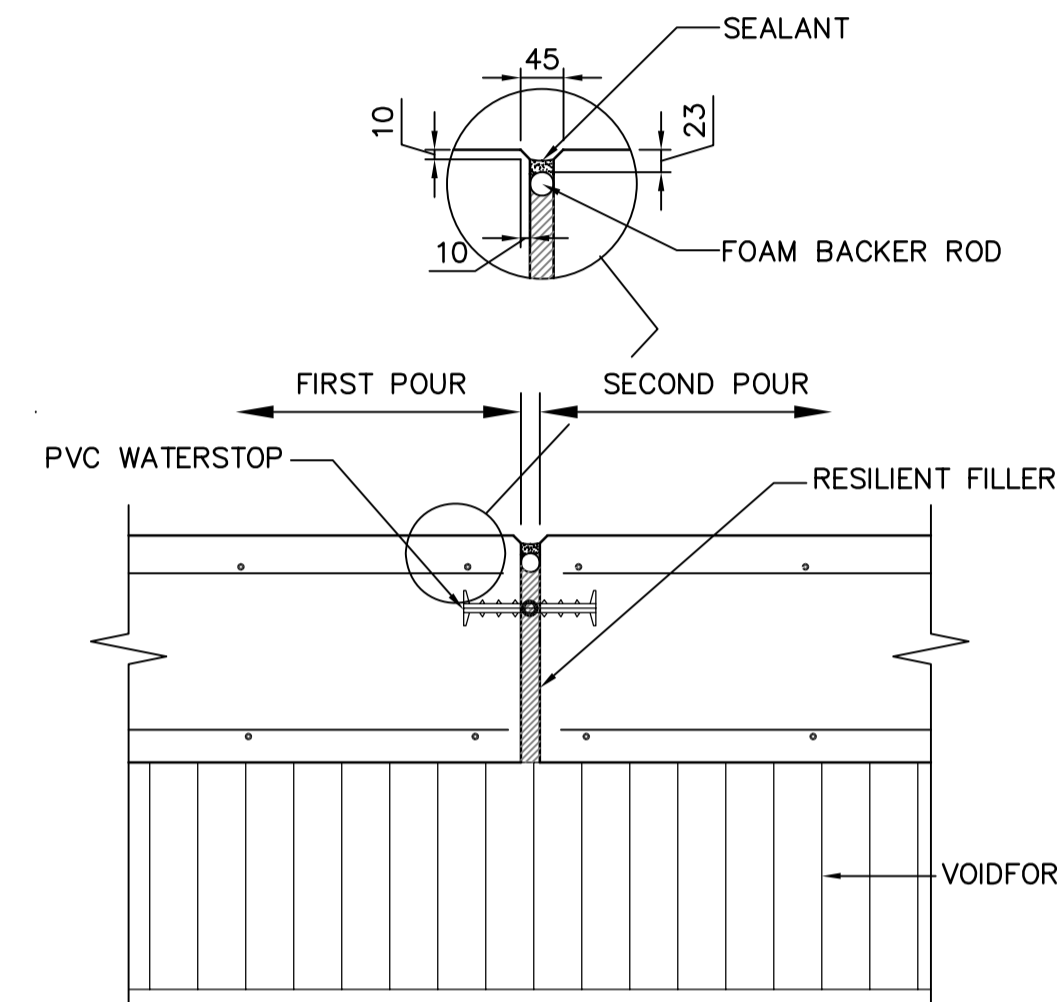


CONCRETE SLAB EXPANSION JOINT TYP.
SCALE N.T.S.

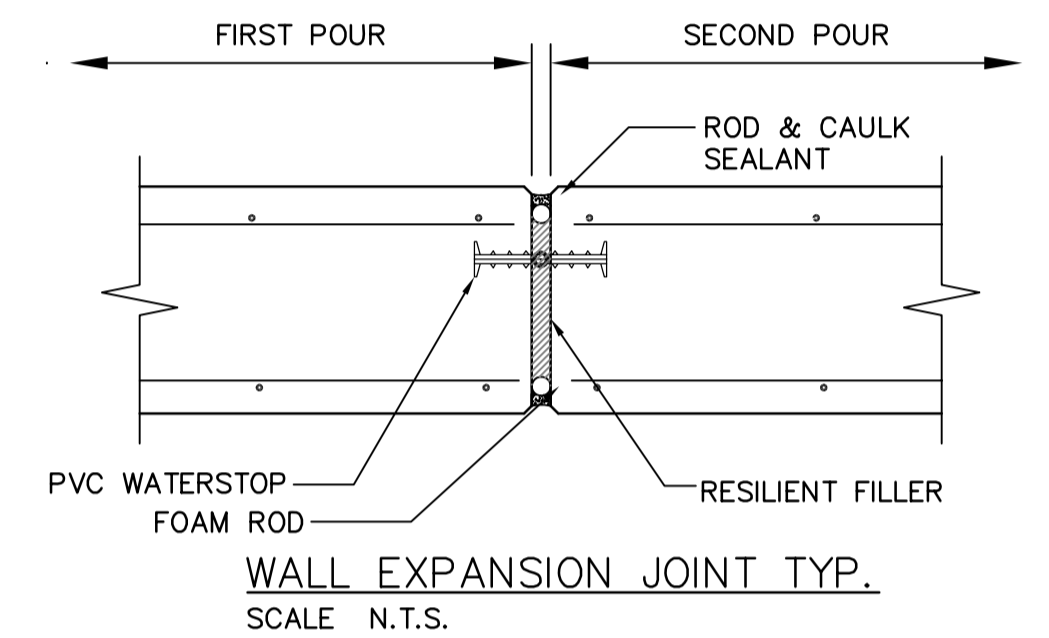


WALL EXPANSION JOINT TYP.
SCALE N.T.S.

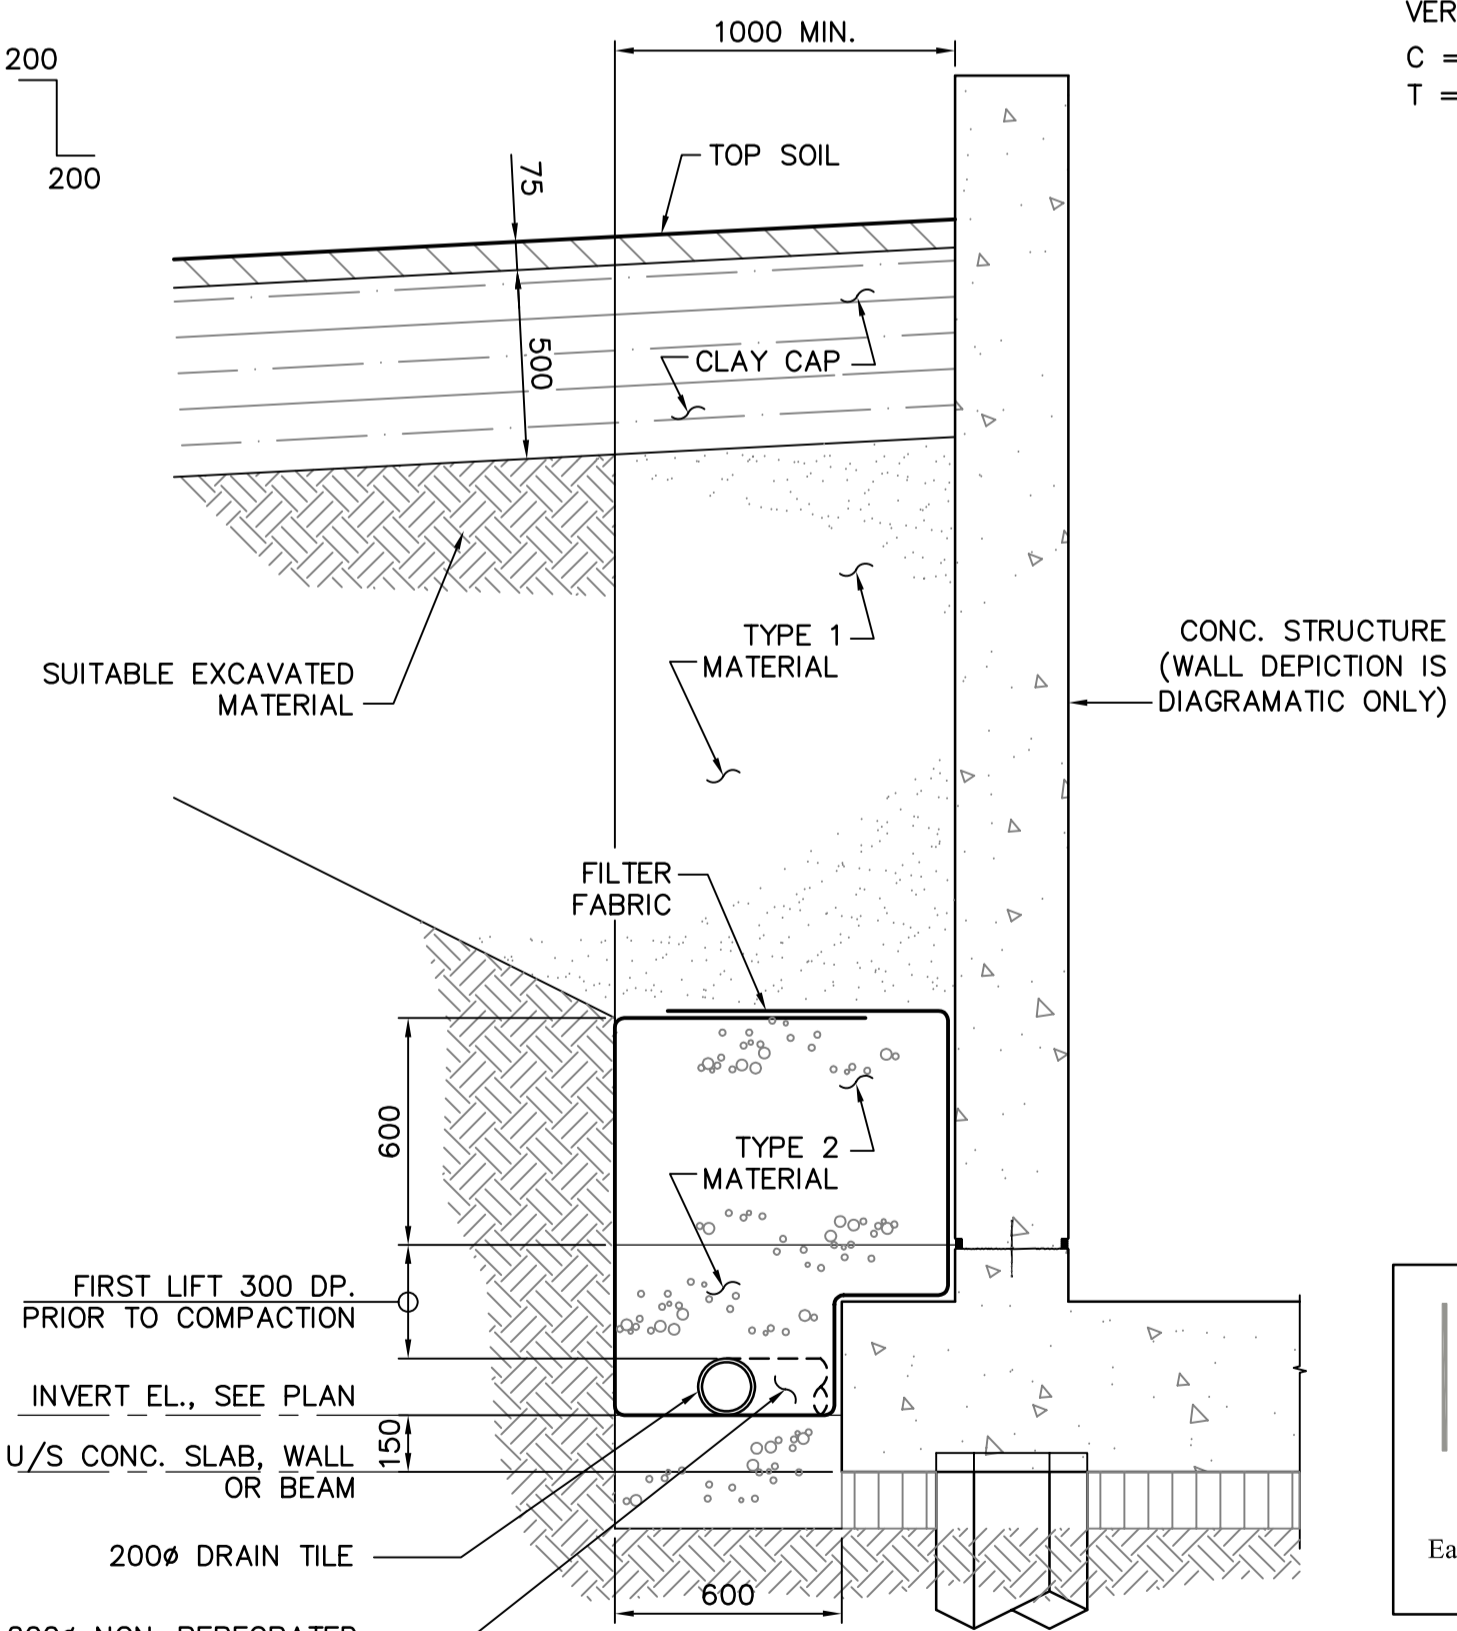

TYPICAL BACKFILL WITH OR WITHOUT DRAIN TILE
SCALE N.T.S.

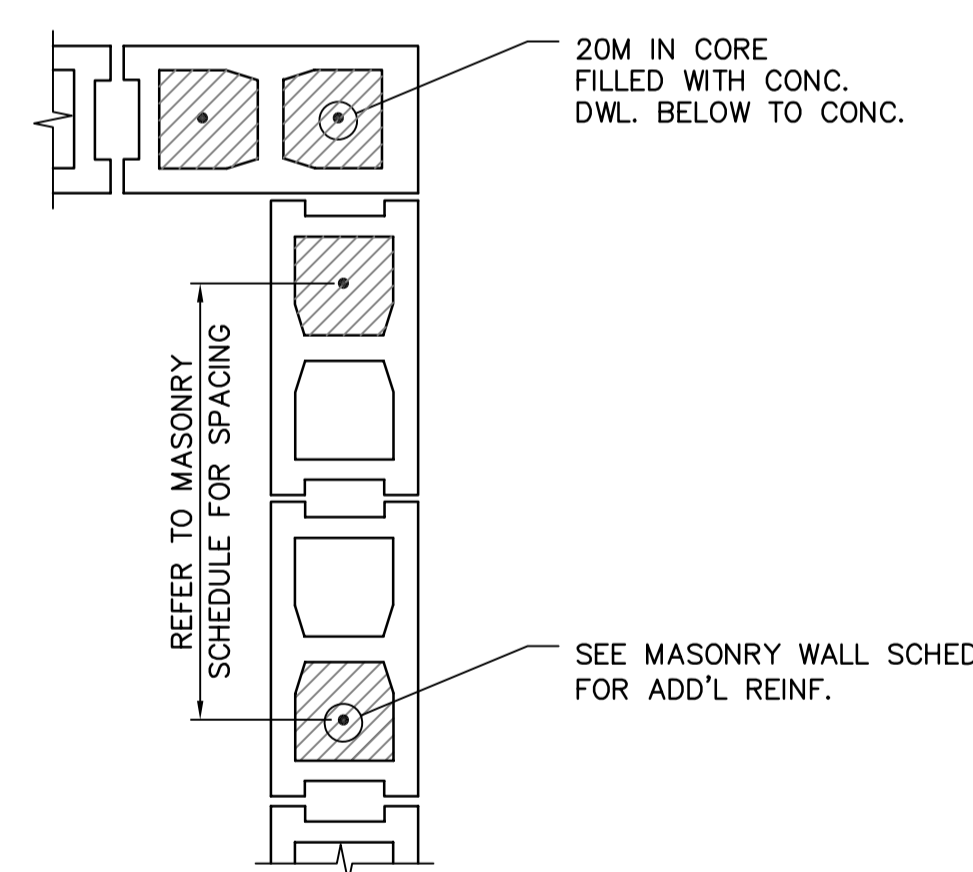

TYPICAL VERTICAL REINFORCING DETAIL
SCALE N.T.S.
MASONRY WALL VERTICAL REINFORCING SHALL BE INSTALLED AT ALL CORNERS IN MASONRY WALLS & AT END OF MASONRY WALLS.

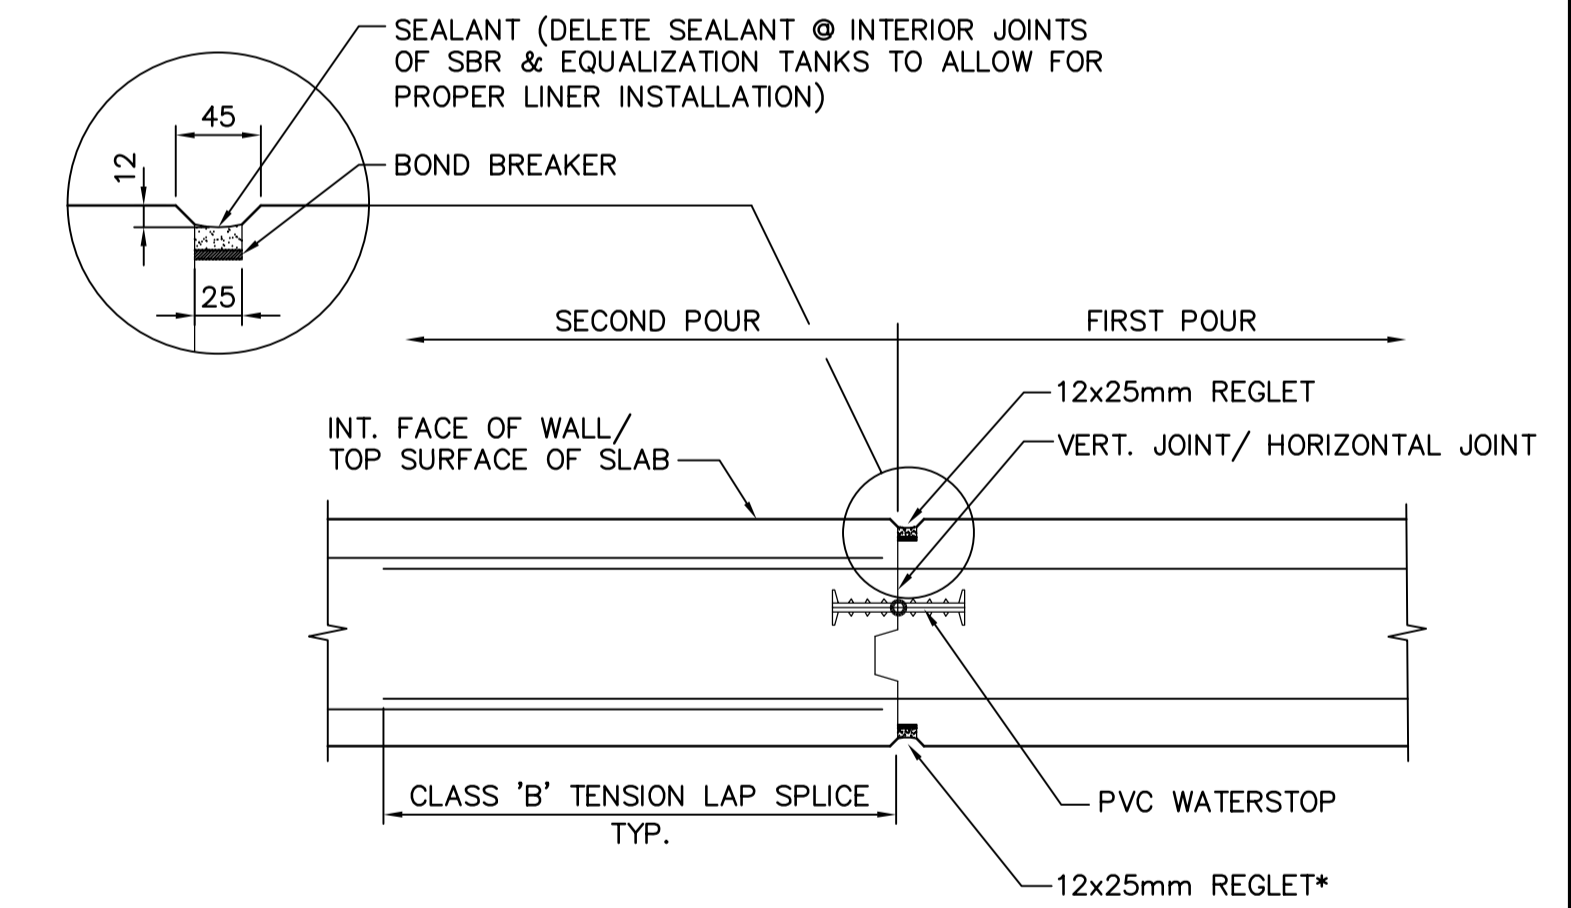

TYPICAL WALL CONSTRUCTION JOINT
SCALE N.T.S.

*NOT APPLICABLE FOR FLOOR SLABS
TRANSVERSE REINFORCING NOT SHOWN FOR CLARITY.

AECOM

As of January 3, 2009, EarthTech became AECOM Canada Ltd.

AECOM AS-CONSTRUCTED
SIG. DATE




NO.	REVISIONS	DATE	BY
03	AS-CONSTRUCTED DRAWING	09/04/09	R.J.H.
02	ISSUED FOR CONSTRUCTION	06/08/30	GLG
01	291-2006 ADDENDUM 6	06/07/26	CMF
00	ISSUED FOR TENDER	06/05/15	WDB


DESIGNED BY	LLR	CHECKED BY	GGP
DRAWN BY	WDB	APPROVED BY	JEH
SCALE:	AS NOTED	RELEASED FOR CONSTRUCTION BY:	K. MARTENS
DATE	2006/02/01	DATE	2006/05/15

ENGINEER'S SEAL
ORIGINAL SIGNED BY
L.L. RIDING
2006/05/15
CONSULTANT DRAWING NO.
S0.02

THE CITY OF WINNIPEG Winnipeg WATER AND WASTE DEPARTMENT ENGINEERING DIVISION	
NEWPCC CENTRATE NUTRIENT TREATMENT NITROGEN REMOVAL FACILITY	CITY FILE NUMBER
STRUCTURAL SBR BUILDING STANDARD DETAILS SHEET 1	SHEET OF
	CITY DRAWING NUMBER
	1-0101C-S0002-001-03

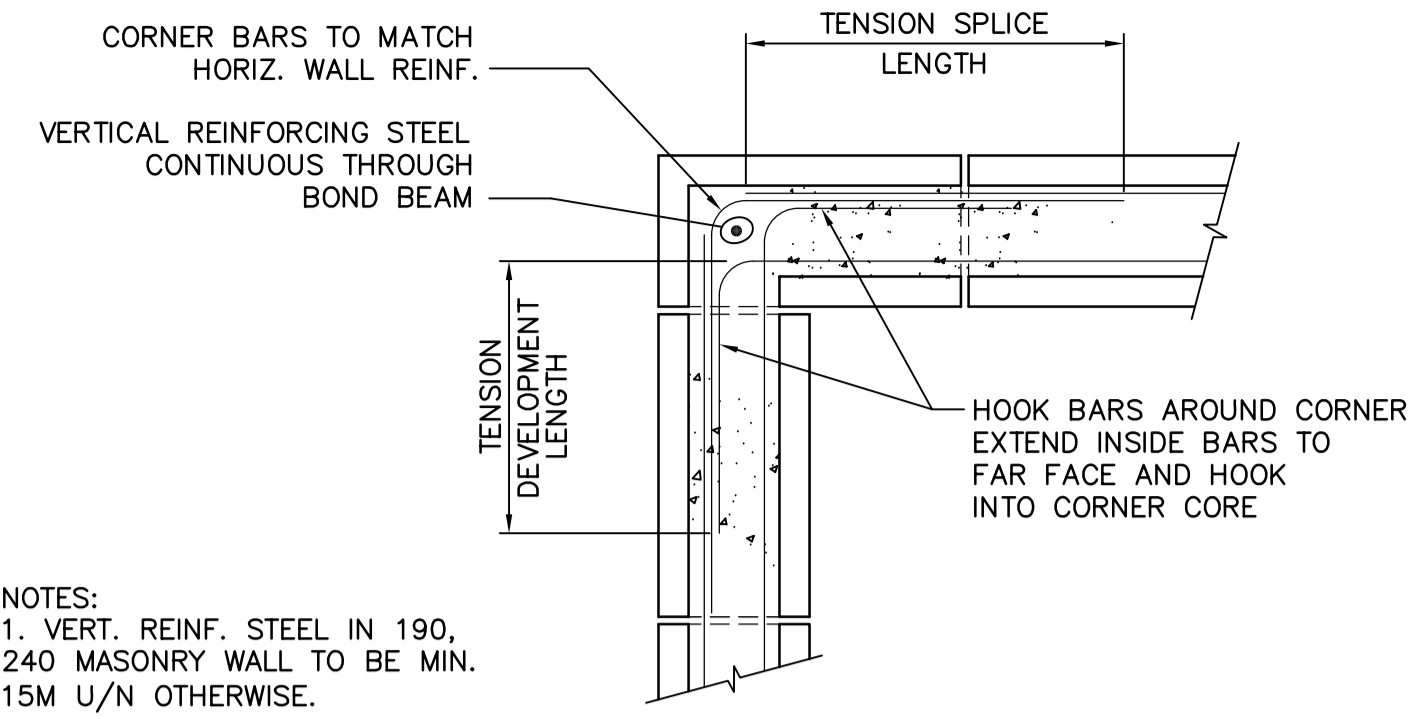


CORNER BOND BEAMS


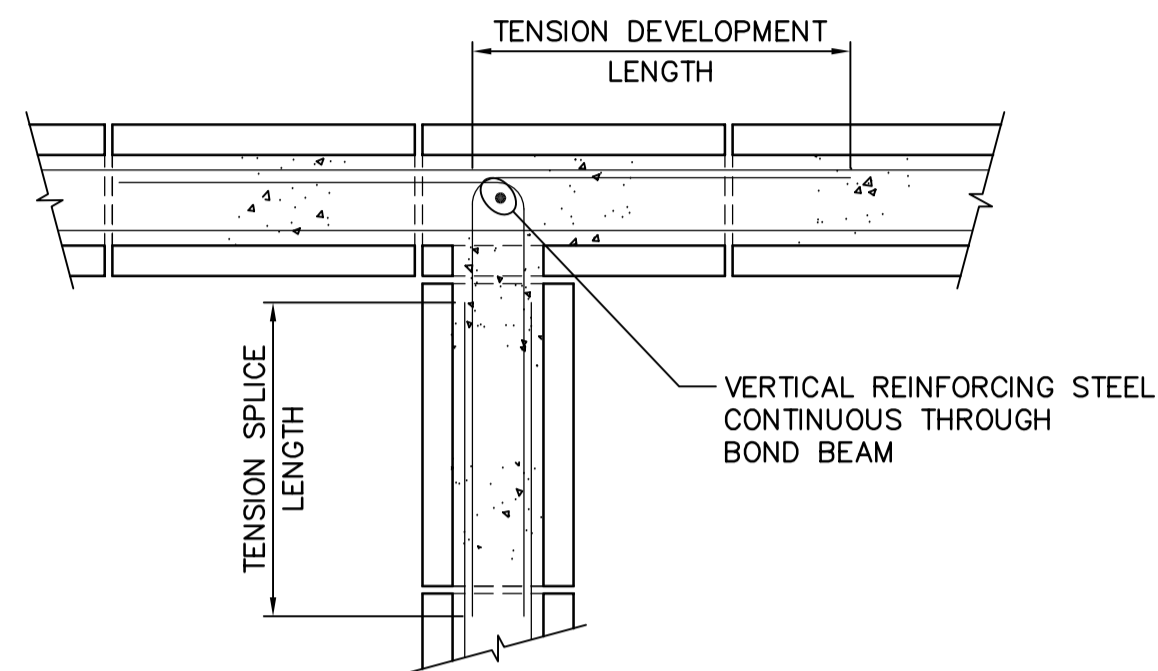


INTERSECTING BOND BEAMS

TYPICAL BOND BEAM DETAILS
SCALE N.T.S.

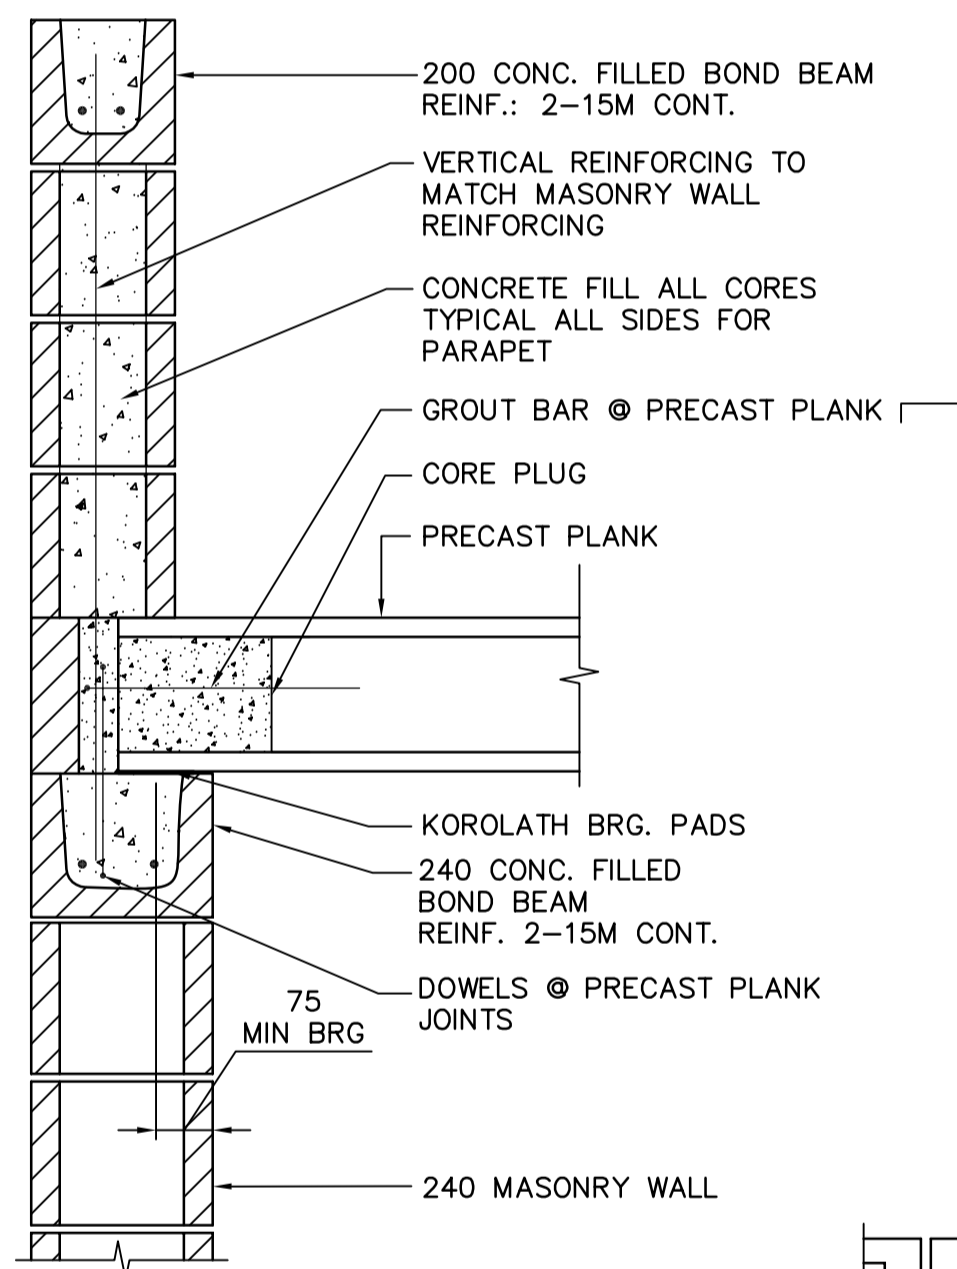


PRECAST PLANK BRG ON MASONRY WALL

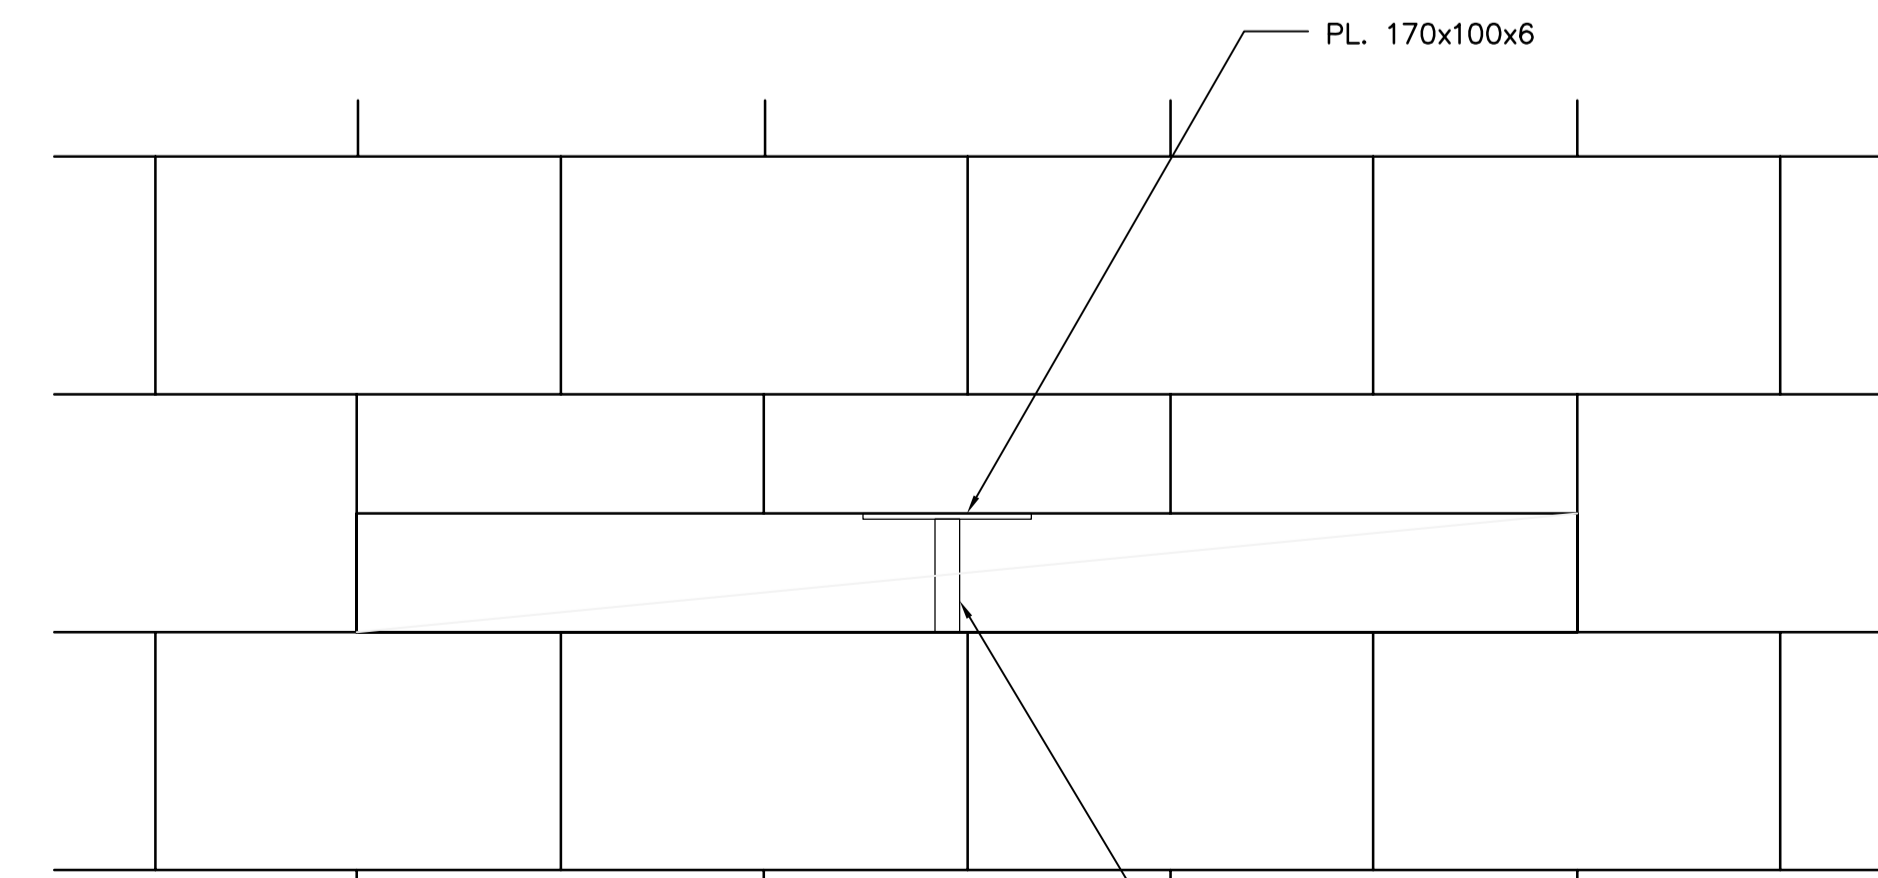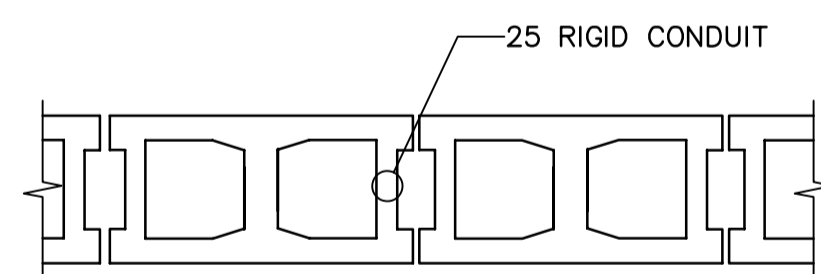

MASONRY SUPPORT AT CABLE TRAY OPENING
SCALE N.T.S.

PRE-CAST CONCRETE PILE SCHEDULE				
MARK	DIAMETER	CUT-OFF	REMARKS	COMMENT
1 to 259	400	222.685	PRECAST PILE PROJECTED INTO FOOTING 75mm	
260 to 352	400	222.985	PRECAST PILE PROJECTED INTO FOOTING 75mm	NOS. 305a & 305b ADDED
353 to 477	400	223.385	PRECAST PILE PROJECTED INTO SLAB 75mm	NOS. 379 NOT USED
478 to 481	400	223.035	PRECAST PILE PROJECTED INTO SLAB 75mm	
482 to 538	400	223.385	PRECAST PILE PROJECTED INTO SLAB 75mm	NOS. 539 NOT USED NOS. 508a & 508b ADDED
540 & 541	400	223.385	PRECAST PILE PROJECTED INTO SLAB 75mm	
542 to 544	400	223.035	PRECAST PILE PROJECTED INTO SLAB 75mm	
545 to 549	400	223.385	PRECAST PILE PROJECTED INTO SLAB 75mm	
550 to 619	400	223.385	PRECAST PILE PROJECTED INTO SLAB 75mm	
620, 621, 622, 624, 626, 627	400	229.045	PRECAST PILE PROJECTED INTO PILECAP 75mm PRE-BORE 10M	
623 & 625	400	229.745	PRECAST PILE PROJECTED INTO PILECAP 75mm PRE-BORE 10M	
628 & 629, 631, 633, 635, 638, 640, 642, 644, 646, 647	400	229.675	PRECAST PILE PROJECTED INTO PILECAP 75mm PRE-BORE 10M	
630, 632, 634, 636	400	230.375	PRECAST PILE PROJECTED INTO PILECAP 75mm PRE-BORE 10M	
637, 639, 641, 643, 645, 679, 680 to 683	400	231.575	PRECAST PILE PROJECTED INTO SLAB 75mm PRE-BORE 10M	
684 to 693	400	222.685	PRECAST PILE PROJECTED INTO FOOTING 75mm	
648	400	222.985	PRECAST PILE PROJECTED INTO FOOTING 75mm	
654 to 678	400	223.035	PRECAST PILE PROJECTED INTO SLAB 75mm	
684 to 693	400	222.685	PRECAST PILE PROJECTED INTO FOOTING 75mm	
694 to 699	400	223.035	PRECAST PILE PROJECTED INTO SLAB 75mm	
700 to 707	400	223.185	PRECAST PILE PROJECTED INTO SLAB 75mm	

NOTE:
K.O. TYPE BLOCKS MAY BE USED FOR LINTELS AT LOCATIONS WHERE UNDERSIDE OF BLOCK WILL NOT BE VISIBLE TO VIEW.

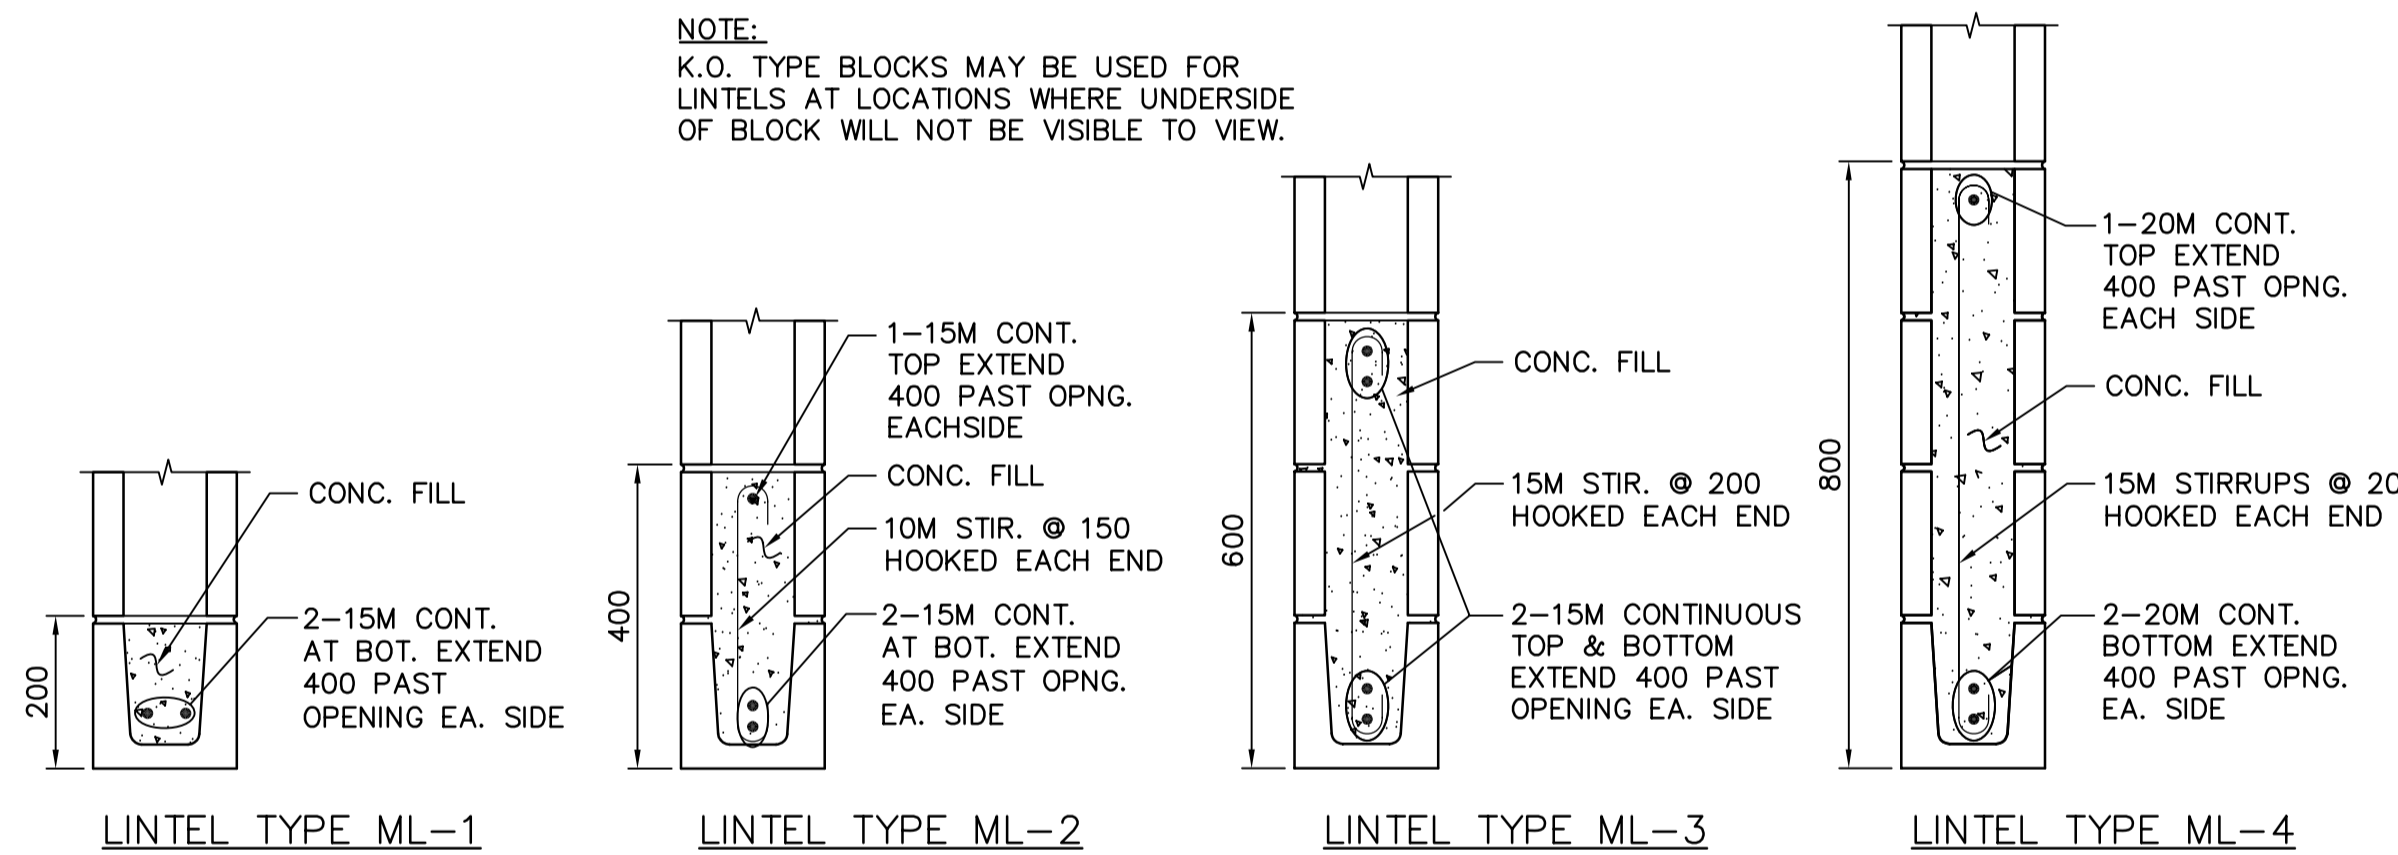


LINTEL TYPE ML-1

LINTEL TYPE ML-2

LINTEL TYPE ML-3

LINTEL TYPE ML-4

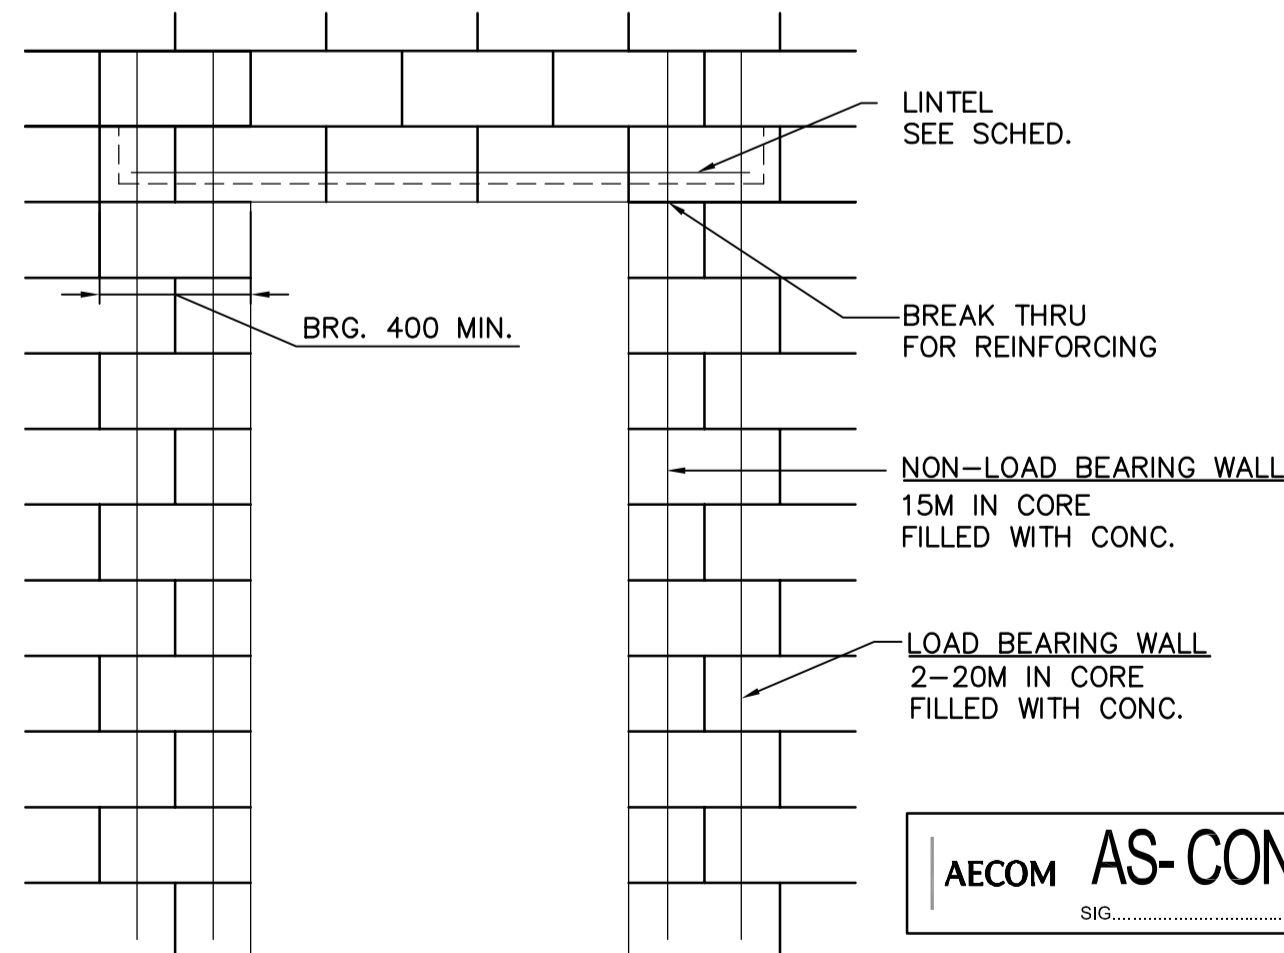

TYPICAL BEARING FOR CONCRETE BLOCK LINTELS
SCALE N.T.S.

TYPICAL BOND BEAM

AECOM

AECOM AS-CONSTRUCTED

As of January 3, 2009, EarthTech became AECOM Canada Ltd.



AECOM Canada Ltd. Original dated on: No. 4671 Date: 2006/05/15

B.M. ELEV.	NO.	REVISIONS	DATE	BY
	04	AS-CONSTRUCTED DRAWING	09/04/09	GLG
	03	ISSUED FOR FI-O-030	07/12/04	CMF
	02	ISSUED FOR CONSTRUCTION	06/08/00	GLG
	01	291-2006 ADDENDUM 6	06/07/26	CMF
	00	ISSUED FOR TENDER	06/05/15	WDB



A Tyco International Ltd. Company

DESIGNED BY	CHECKED BY	DRAWN BY	APPROVED BY	SCALE	RELEASED FOR CONSTRUCTION BY
LLR	GGP	WDB	JEH	N.T.S.	K. MARTENS

ENGINEER'S SEAL	ORIGINAL SIGNED BY	DATE
	L.L. RIDING	2006/05/15

THE CITY OF WINNIPEG
WATER AND WASTE DEPARTMENT
ENGINEERING DIVISION

DESIGNED BY	CHECKED BY	DRAWN BY	APPROVED BY	SCALE	RELEASED FOR CONSTRUCTION BY
LLR	GGP	WDB	JEH	N.T.S.	K. MARTENS


CONCRETE GRADE BEAM SCHEDULE							EQUALIZATION TANK, SBR 1, SBR 2, EXHAUST FAN BUILDING, BLOWER BUILDING	
MARK	WIDTH	DEPTH	REINFORCING			STIRRUPS	ADDITIONAL	REMARKS
			TOP	MIDDLE	BOTTOM			
GB-1	500	1500	6-25M	15M E.F. @ 300	6-25M	15M @ 175 o/c		300Wx500H UPSTAND CURB R/W 3-25M CONT. TOP, 1-15M MIDDLE E.F. c/w 10M U-BARS @ 175 o/c.
GB-2	500	1100	6-25M	15M E.F. @ 300	6-25M	15M @ 200 o/c		
GB-3	400	1100	4-25M	15M E.F. @ 300	4-25M	15M @ 200 o/c		
GB-4	500	1300	6-25M	15M E.F. @ 300	6-25M	15M @ 175 o/c		300Wx700H UPSTAND CURB R/W 3-25M CONT. TOP, 2-15M MIDDLE E.F. c/w 10M U-BARS @ 200 o/c.

CONCRETE BEAM SCHEDULE							EQUALIZATION TANK, SBR 1, SBR 2, EXHAUST FAN BUILDING, BLOWER BUILDING
MARK	WIDTH	DEPTH	REINFORCING			STIRRUPS	REMARKS
			TOP	MIDDLE	BOTTOM		
CB-1	600	1200	6-30M	15M E.F. @ 300	6-30M	15M @ 250 o/c	300Wx1500H UPSTAND CURB R/W 3-25M CONT. TOP, 15M @ 300 o/c MIDDLE E.F. c/w 15M STIRRUPS @ 250 o/c FULL HT. (2.7m)
CB-2	350	1200	3-30M	15M E.F. @ 300	3-30M	15M @ 250 o/c	
CB-3	500	2000	12-25M 6-IN 2 ROWS	6 ROWS 1-20M E.F. @ 300	12-25M 6 IN 2 ROWS	15M @ 125 o/c	
CB-4	500	900	5-25M	15M E.F. @ 300	5-25M	15M @ 300 o/c	300Wx900H UPSTAND CURB R/W 3-25M CONT. TOP, 15M @ 300 o/c MIDDLE E.F. c/w 15M STIRRUPS @ 300 o/c FULL HT. (1.8m)

CONCRETE WALL SCHEDULE						EQUALIZATION TANK, SBR 1, SBR 2, EXHAUST FAN BUILDING, BLOWER BUILDING
MARK	WIDTH	HEIGHT	REINFORCING			REMARKS
			VERTICAL	HORIZONTAL	ADDITIONAL	
CW-1	500/1400	VARIABLES	25M @ 300 o/c E.F.	20M @ 200 o/c E.F.	25M DLS @ 150 o/c	SEE SECTION FOR UPSTAND
CW-2	500/1000	VARIABLES	25M @ 300 o/c E.F.	20M @ 200 o/c E.F.	30M DLS @ 150 o/c	SEE SECTION FOR UPSTAND
CW-3	350	VARIABLES	20M @ 200 o/c E.F.	20M @ 200 o/c E.F.	20M DLS @ 200 o/c	
CW-4	500	VARIABLES	25M @ 200 o/c E.F.	20M @ 150 o/c E.F.	25M DLS @ 200 o/c	

CONCRETE SLAB SCHEDULE					EQUALIZATION TANK, SBR 1, SBR 2, EXHAUST FAN BUILDING, BLOWER BUILDING
MARK	DEPTH	REINFORCING		ADDITIONAL	REMARKS
		TOP	BOTTOM		
SL-1	600	20M @ 200 o/c E.W.	20M @ 200 o/c E.W.		
SL-2	300	20M @ 180 o/c E.W.	20M @ 180 o/c E.W.	20M DOWELS @ 180 o/c	
SL-3	300	20M @ 180 o/c E.W.	20M @ 180 o/c E.W.	20M DOWELS @ 180 o/c	
SL-4	300	20M @ 200 o/c E.W.	20M @ 200 o/c E.W.	20M DOWELS @ 200 o/c	
SL-5	300	20M @ 200 o/c E.W.	20M @ 200 o/c E.W.	20M DOWELS @ 200 o/c	
SL-6	500	20M @ 180 o/c E.W.	20M @ 180 o/c E.W.		
SL-7	400	20M @ 200 o/c E.W.	20M @ 200 o/c E.W.		



LEGEND:
TUL - TOP UPPER LAYER
TLL - TOP LOWER LAYER
BUL - BOTTOM UPPER LAYER
BLL - BOTTOM LOWER LAYER

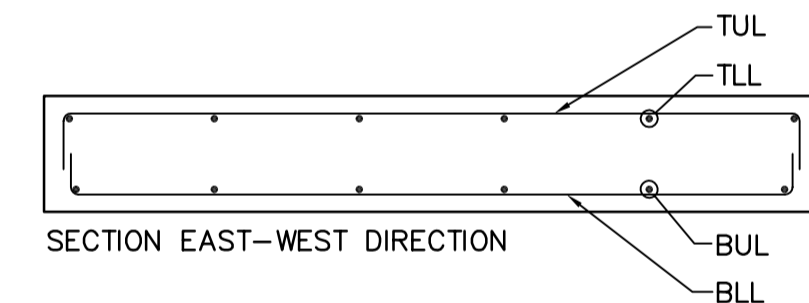


MASONRY WALL SCHEDULE					EQUALIZATION TANK, SBR 1, SBR 2, EXHAUST FAN BUILDING, BLOWER BUILDING
MARK	SIZE	REINFORCING	TYPE	CORE FILL	REMARKS
MW-1	240	20M VERT @ 800 o/c	CONCRETE	FILL ALL REINF CORES w/ 20MPA CONC	STRUCTURAL SOUND BLOCK
MW-2	190	15M VERT @ 800 o/c	CONCRETE	FILL ALL REINF CORES w/ 20MPA CONC	

CONCRETE COLUMN SCHEDULE					EQUALIZATION TANK, SBR 1, SBR 2, EXHAUST FAN BUILDING, BLOWER BUILDING
MARK	SIZE	REINFORCING			REMARKS
		VERT.	STIRRUPS	ADDITIONAL	
CC-1	1000x600	30-25M	10M @ 300 o/c QUAD	25M DOWELS	SEE DETAIL
CC-2	700x500	24-25M	10M @ 300 o/c TRIPLES	25M DOWELS	SEE DETAIL


CONCRETE EQUIPMENT PEDESTAL SCHEDULE					EQUALIZATION TANK, SBR 1, SBR 2, EXHAUST FAN BUILDING, BLOWER BUILDING
MARK	SIZE	REINFORCING			REMARKS
		VERT.	STIRRUPS	ADDITIONAL	
EP-1	900x900	32-25M	15M @ 300 o/c TRIPLES	25M DOWELS	
EP-2	900x900	32-25M	15M @ 300 o/c TRIPLES	25M DOWELS	

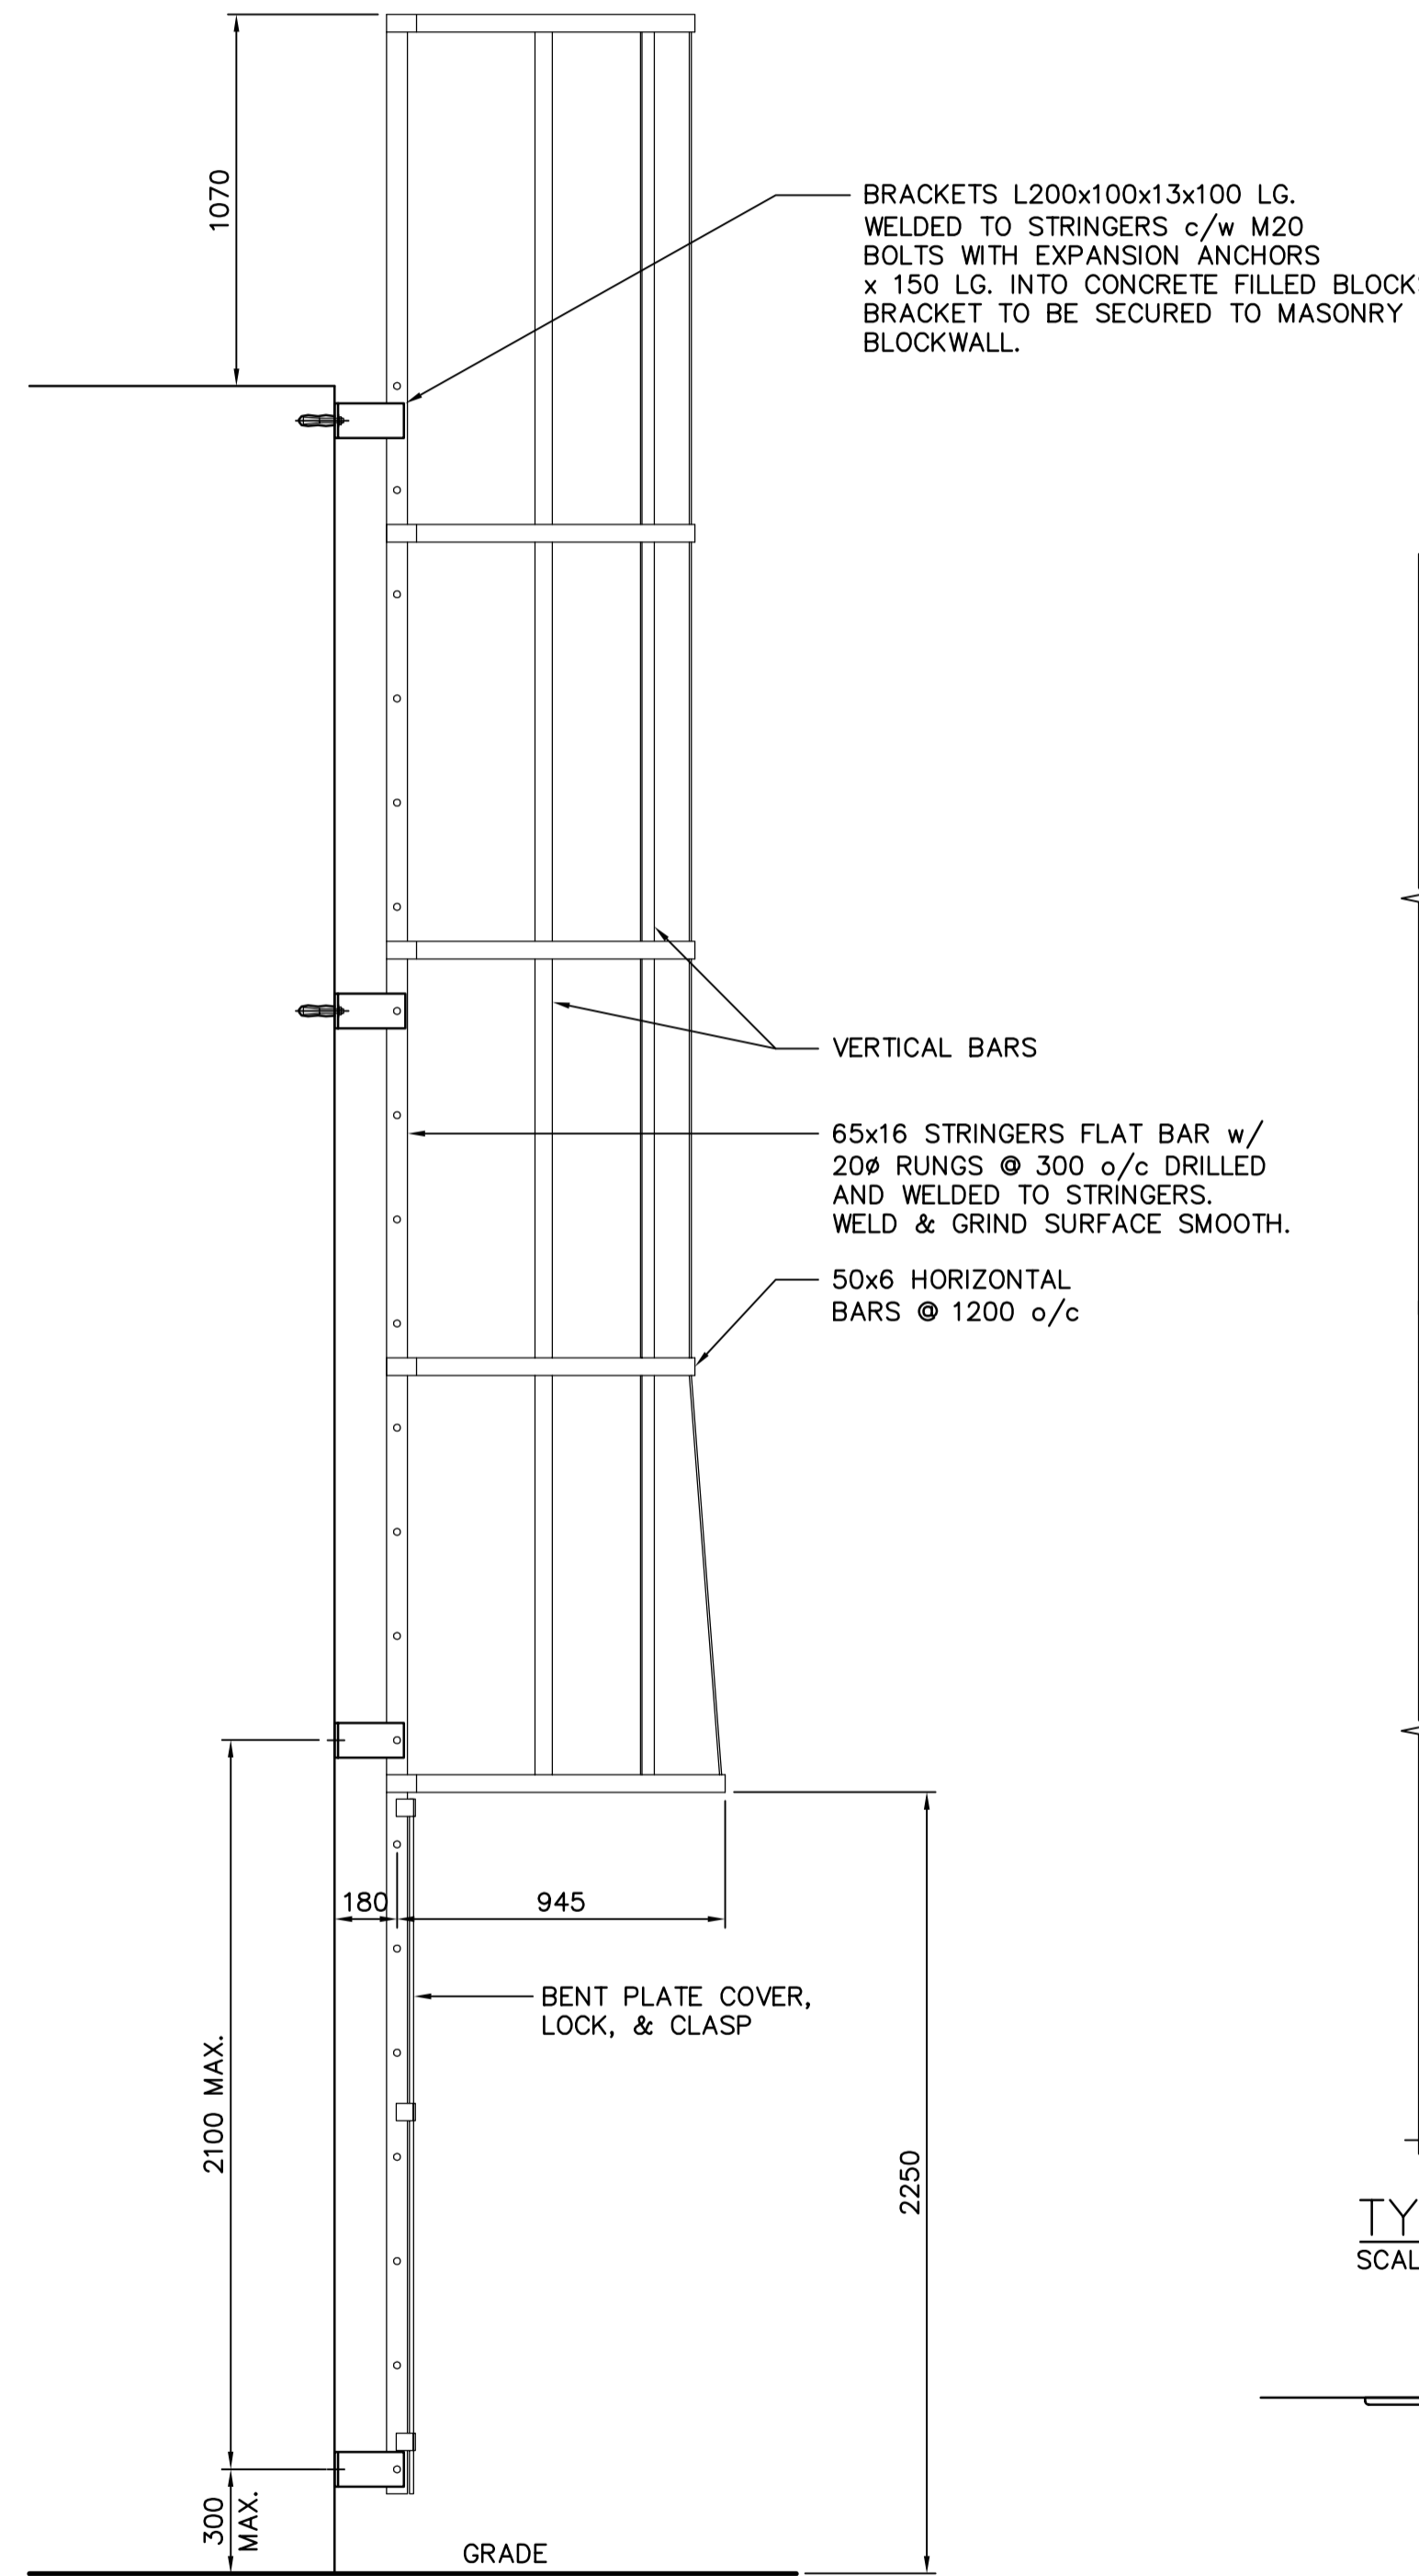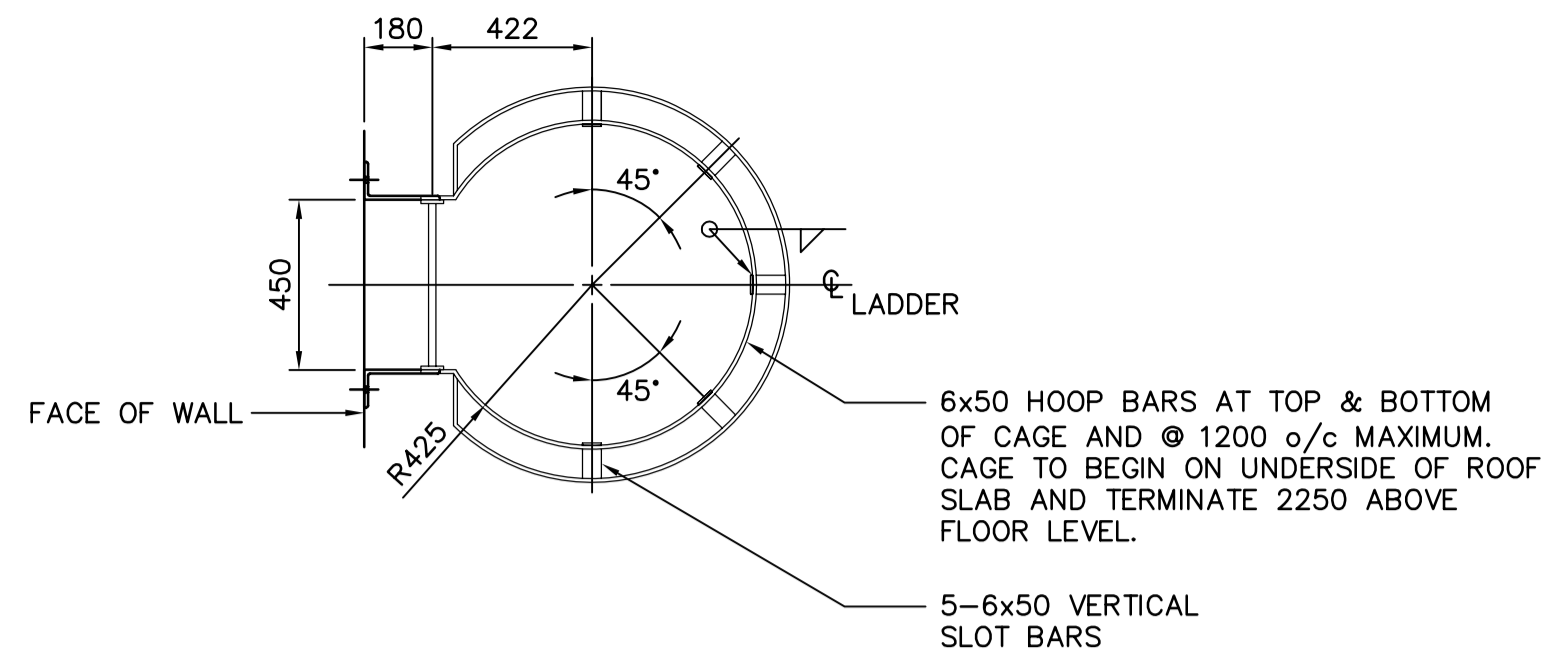


ALUMINUM LADDER AND CAGE DETAIL
SCALE N.T.S.

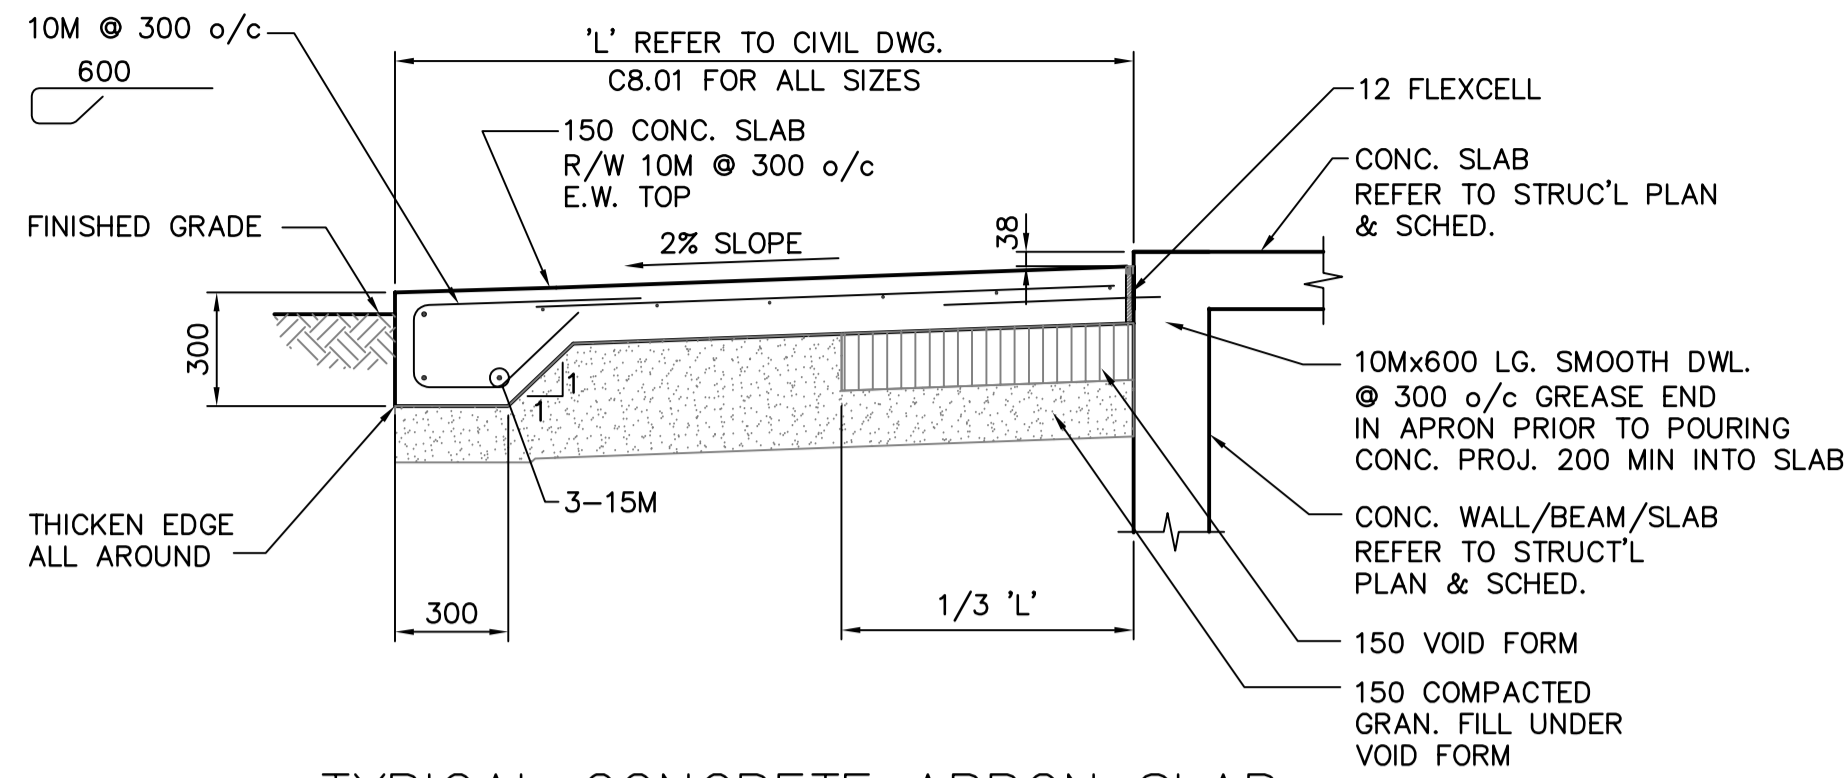


TYPICAL CONCRETE APRON SLAB
SCALE N.T.S.
SLAB & WALL/BEAM REINFORCING NOT SHOWN FOR CLARITY.

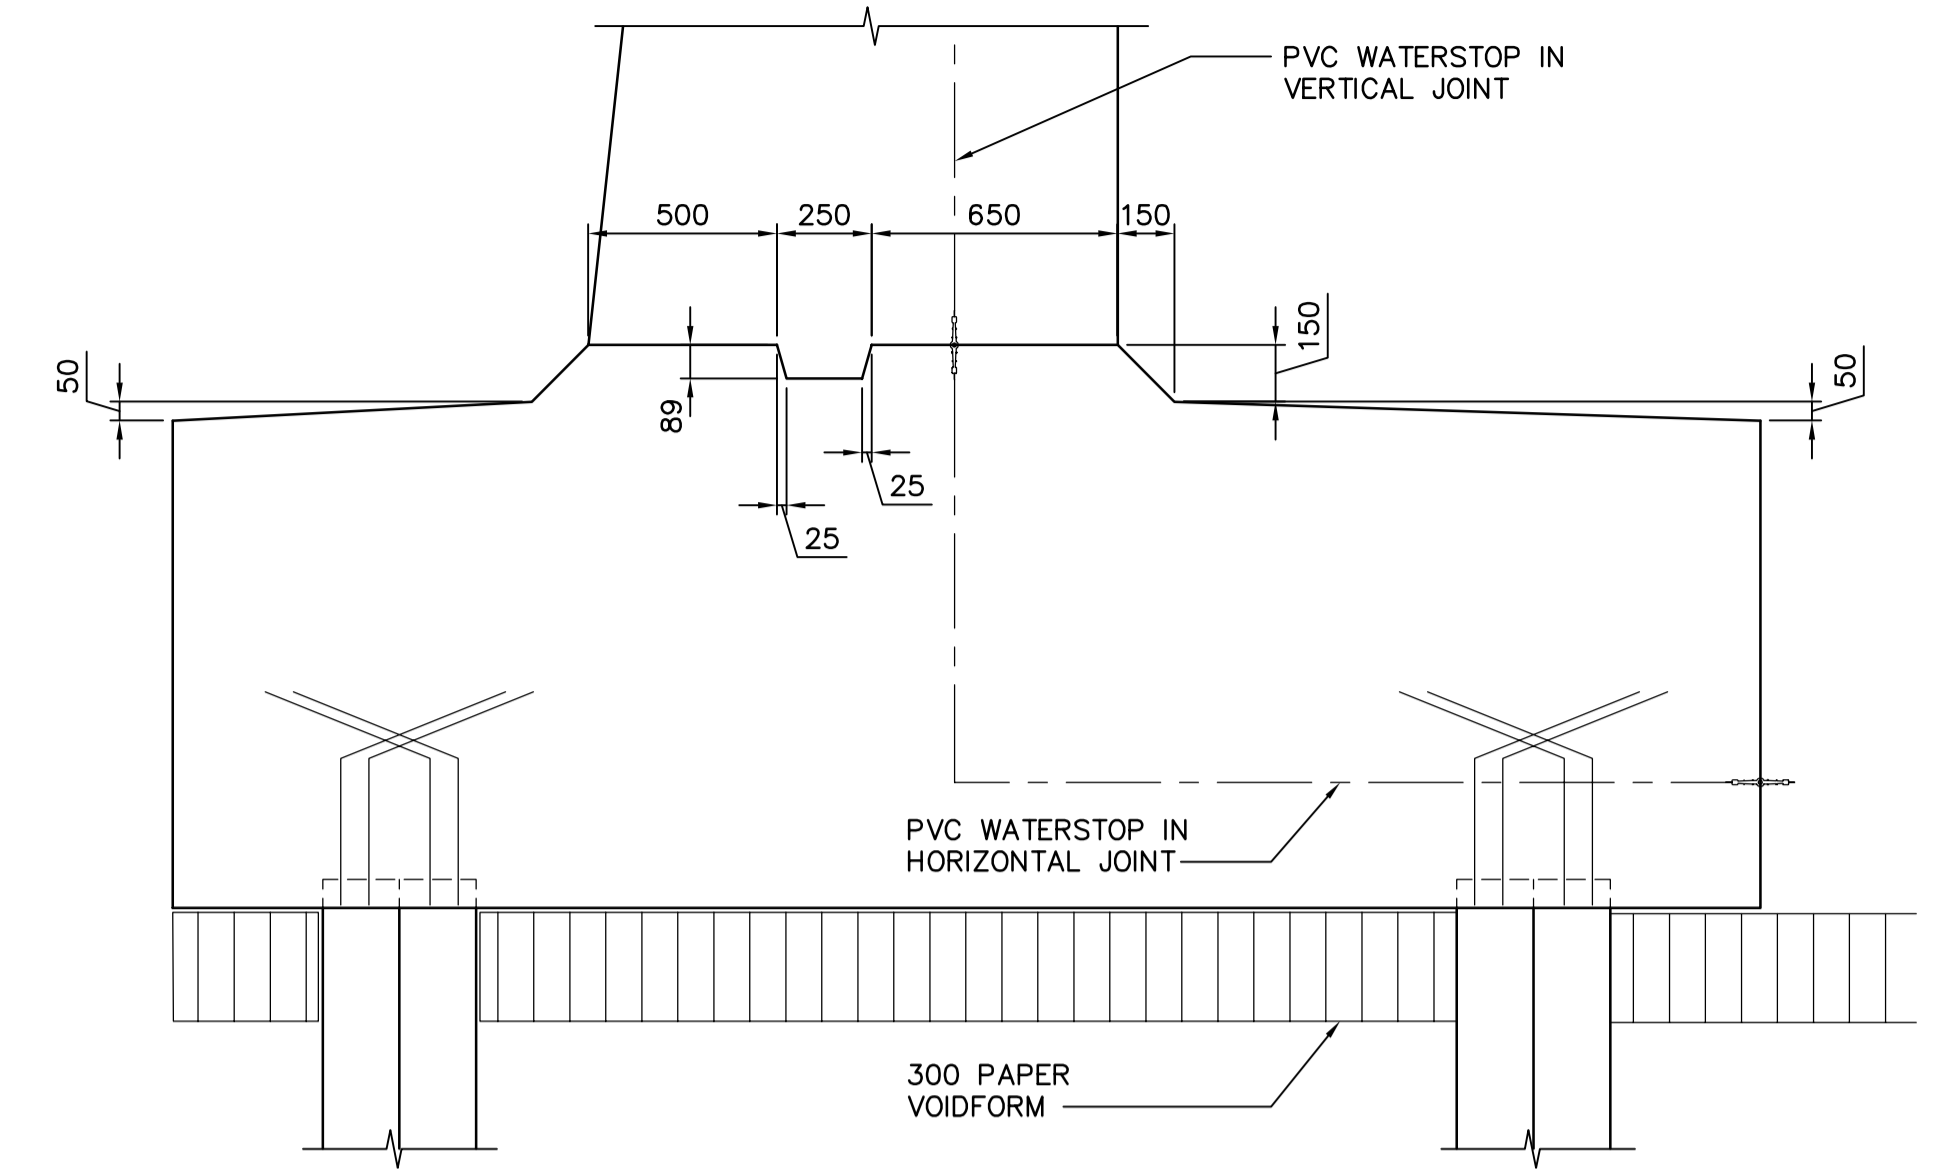


1 FOOTING TO WALL JOINT
S0.03 SCALE 1:20

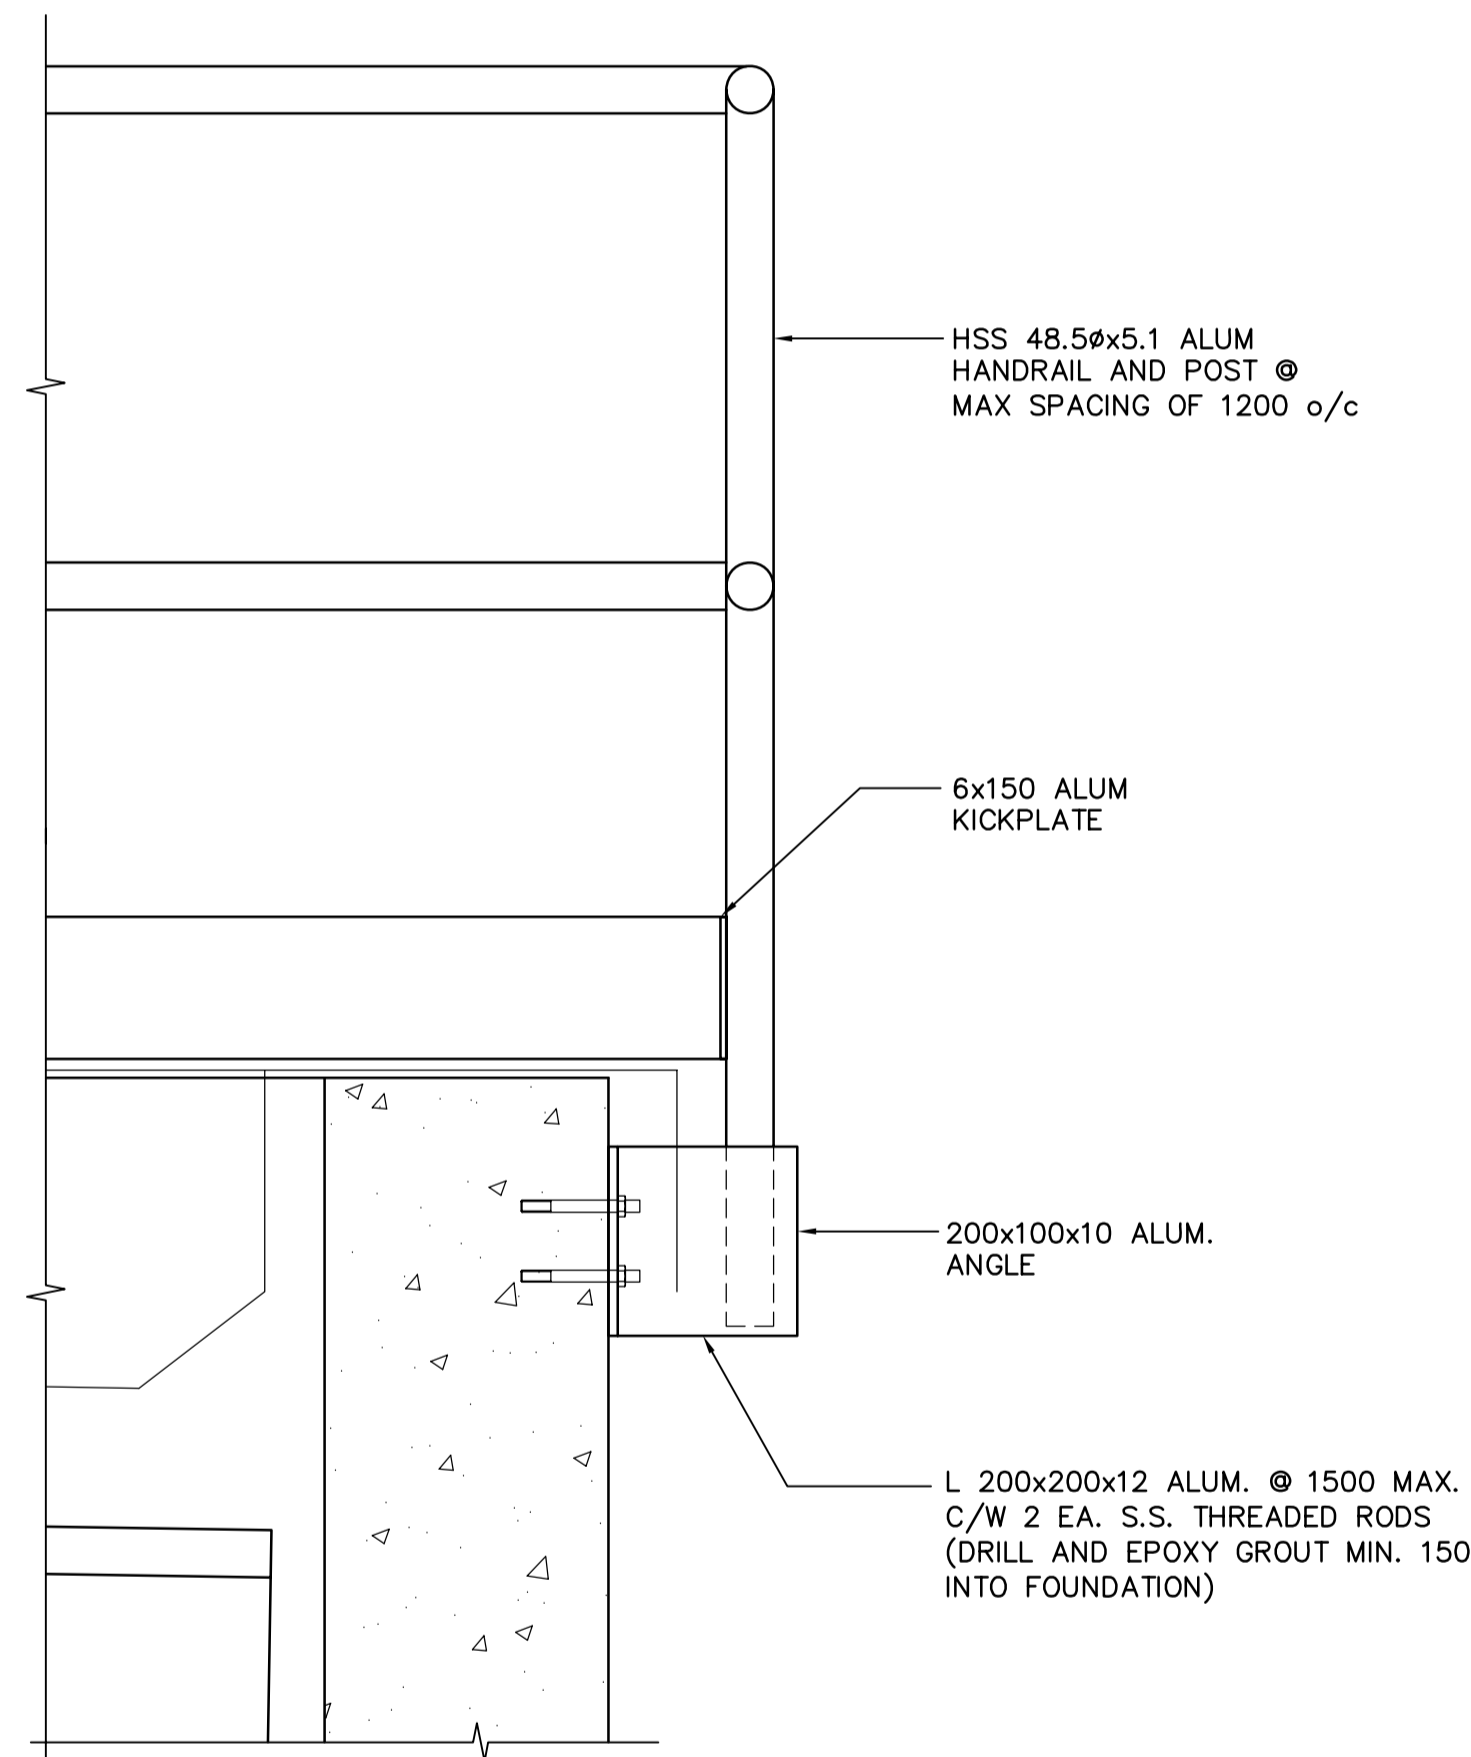

TYPICAL HANDRAIL POST CONNECTION
SCALE N.T.S.

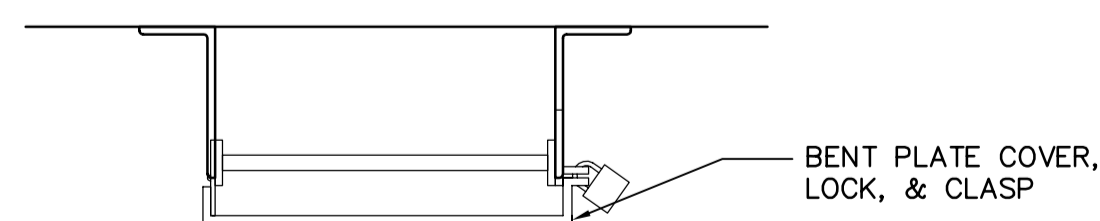


TYPICAL LOCKABLE LADDER COVER
SCALE N.T.S.

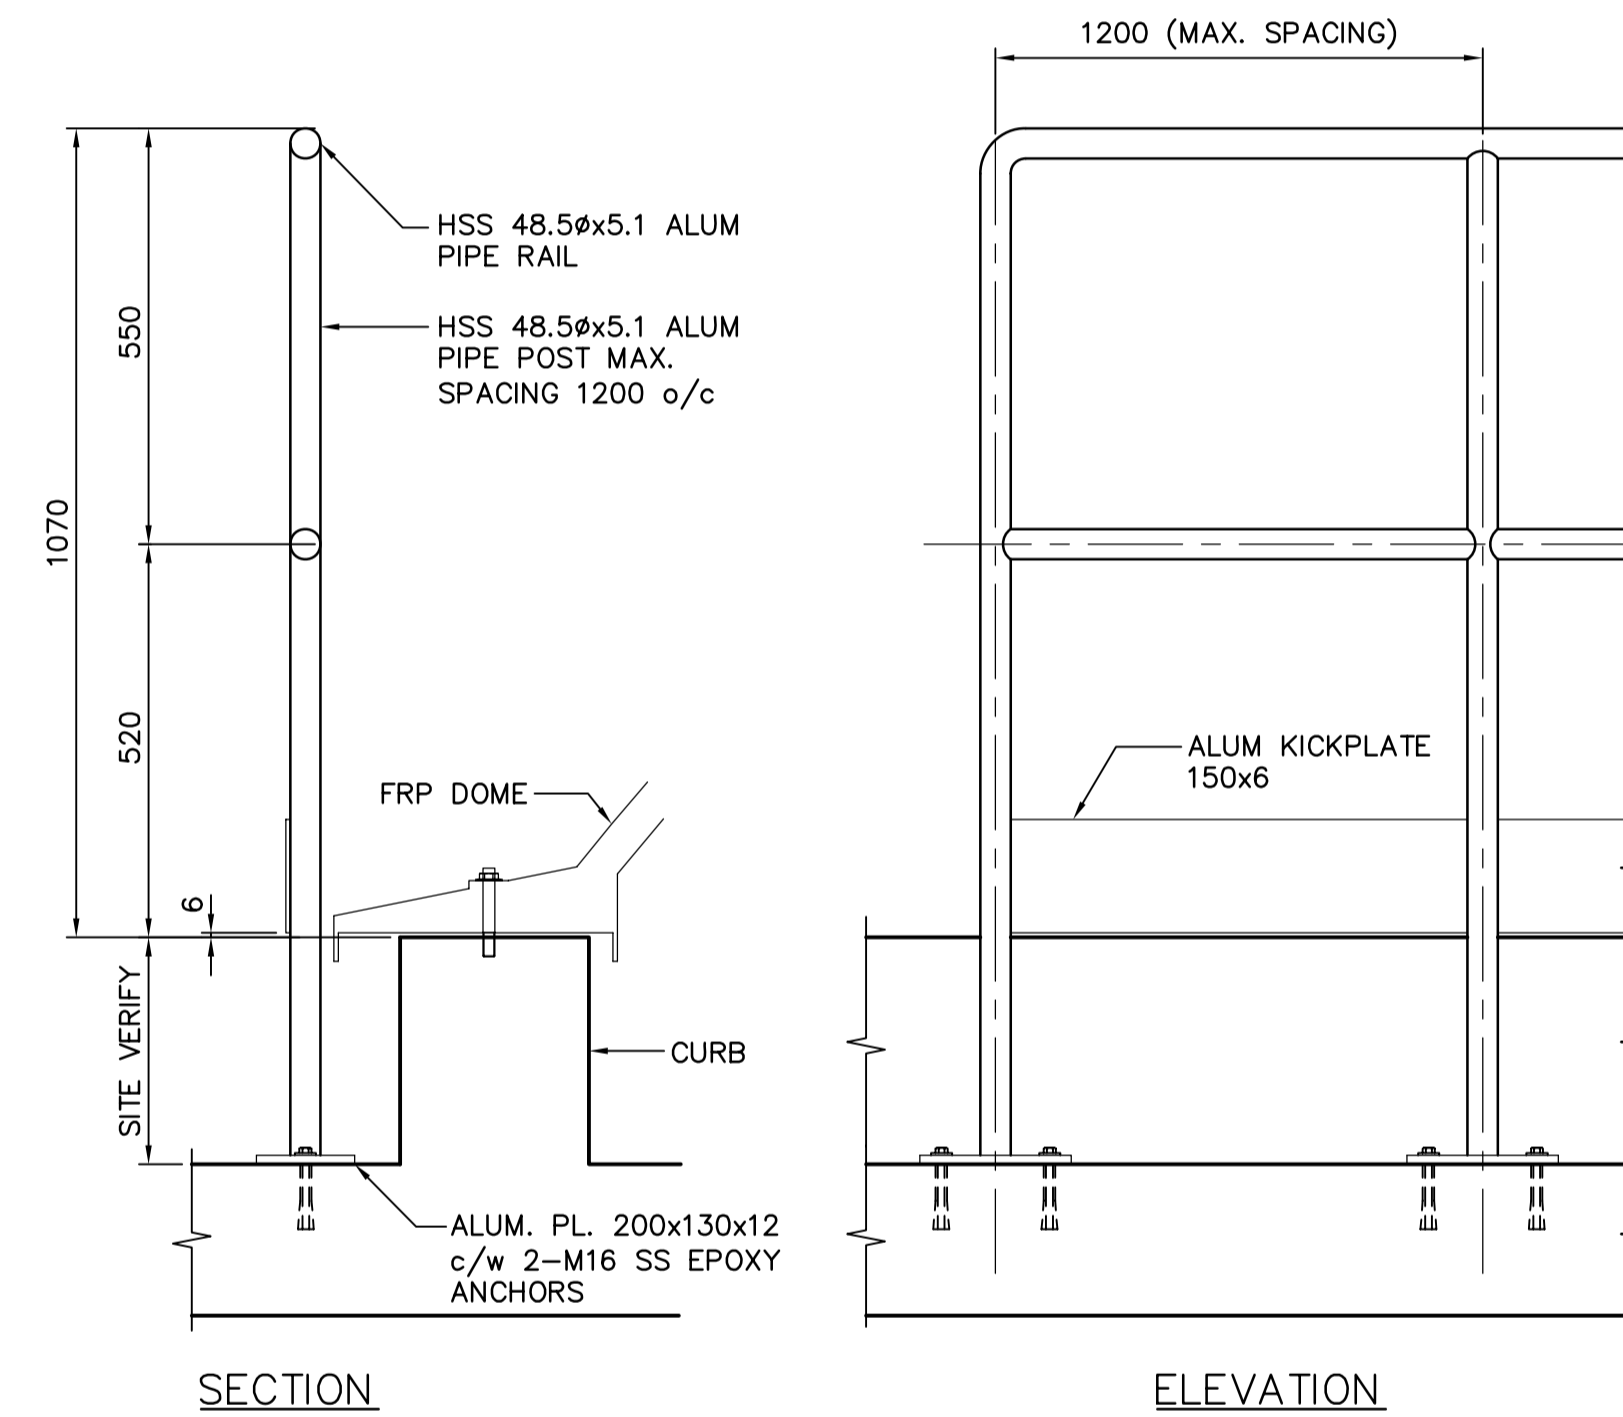


TYPICAL ALUMINUM HANDRAIL @ DECANTOR OPENING

SCALE N.T.S.
PAINT ALL ALUMINUM SURFACES IN CONTACT WITH CONCRETE WITH TWO COATS OF ALKALI-RESISTANT BITUMINOUS PAINT.
ALL MISCELLANEOUS METAL MATERIAL TO BE ALUMINUM UNLESS NOTED OTHERWISE.

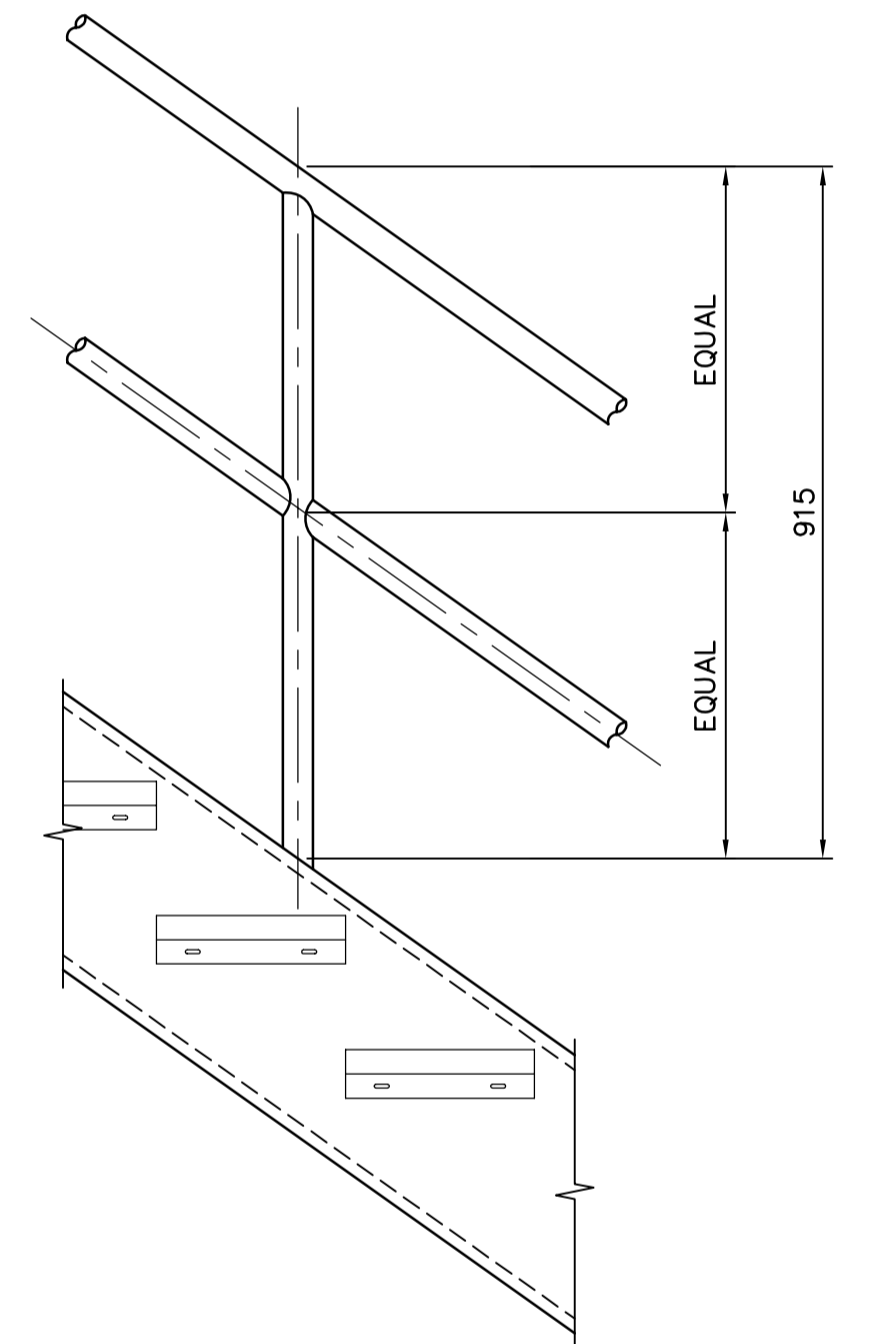

ALUMINUM STAIR RAILING
(SEE STAIR DETAIL DWG S3.07)


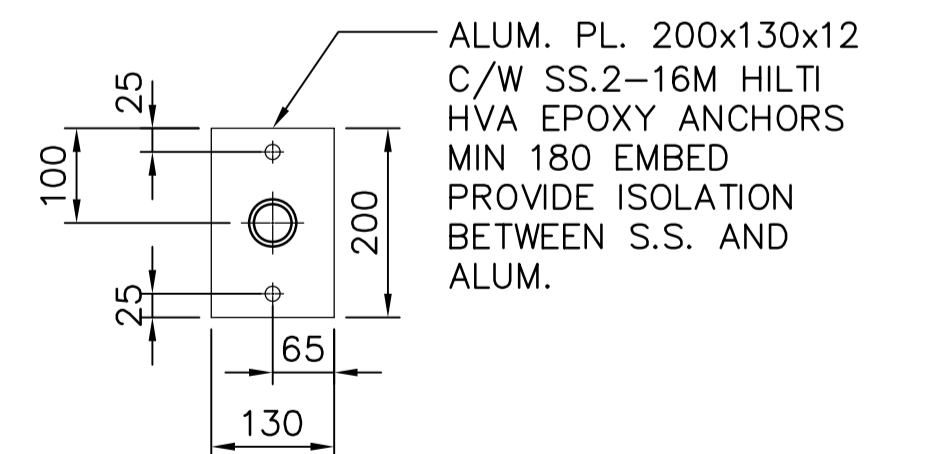


TYP. HANDRAIL ALUM. PLATE

AECOM
As of January 3, 2009, EarthTech became AECOM Canada Ltd.

AECOM AS-CONSTRUCTED
SIG..... DATE.....


 Certificate of Authorization AECOM Canada Ltd. Original dated on: No. 4671 Date: 2006/05/15	B.M. ELEV.	 A Tyco International Ltd. Company	ENGINEER'S SEAL	 THE CITY OF WINNIPEG WATER AND WASTE DEPARTMENT ENGINEERING DIVISION				
	DESIGNED BY: LLR		CHECKED BY: GGP		ORIGINAL SIGNED BY: L.L. RIDING			
	DRAWN BY: WDB		APPROVED BY: JEH		2006/05/15			
	SCALE: AS NOTED		RELEASED FOR CONSTRUCTION BY: K. MARTENS		CONSULTANT DRAWING NO. S0.04			
NO. REVISIONS	DATE	BY	DATE	2006/04/05	DATE	2006/05/23	NEWPCC CENTRATE NUTRIENT TREATMENT NITROGEN REMOVAL FACILITY STRUCTURAL SBR BUILDING STANDARD DETAILS SHEET 3	CITY FILE NUMBER SHEET OF CITY DRAWING NUMBER 1-0101C-S0002-003-02

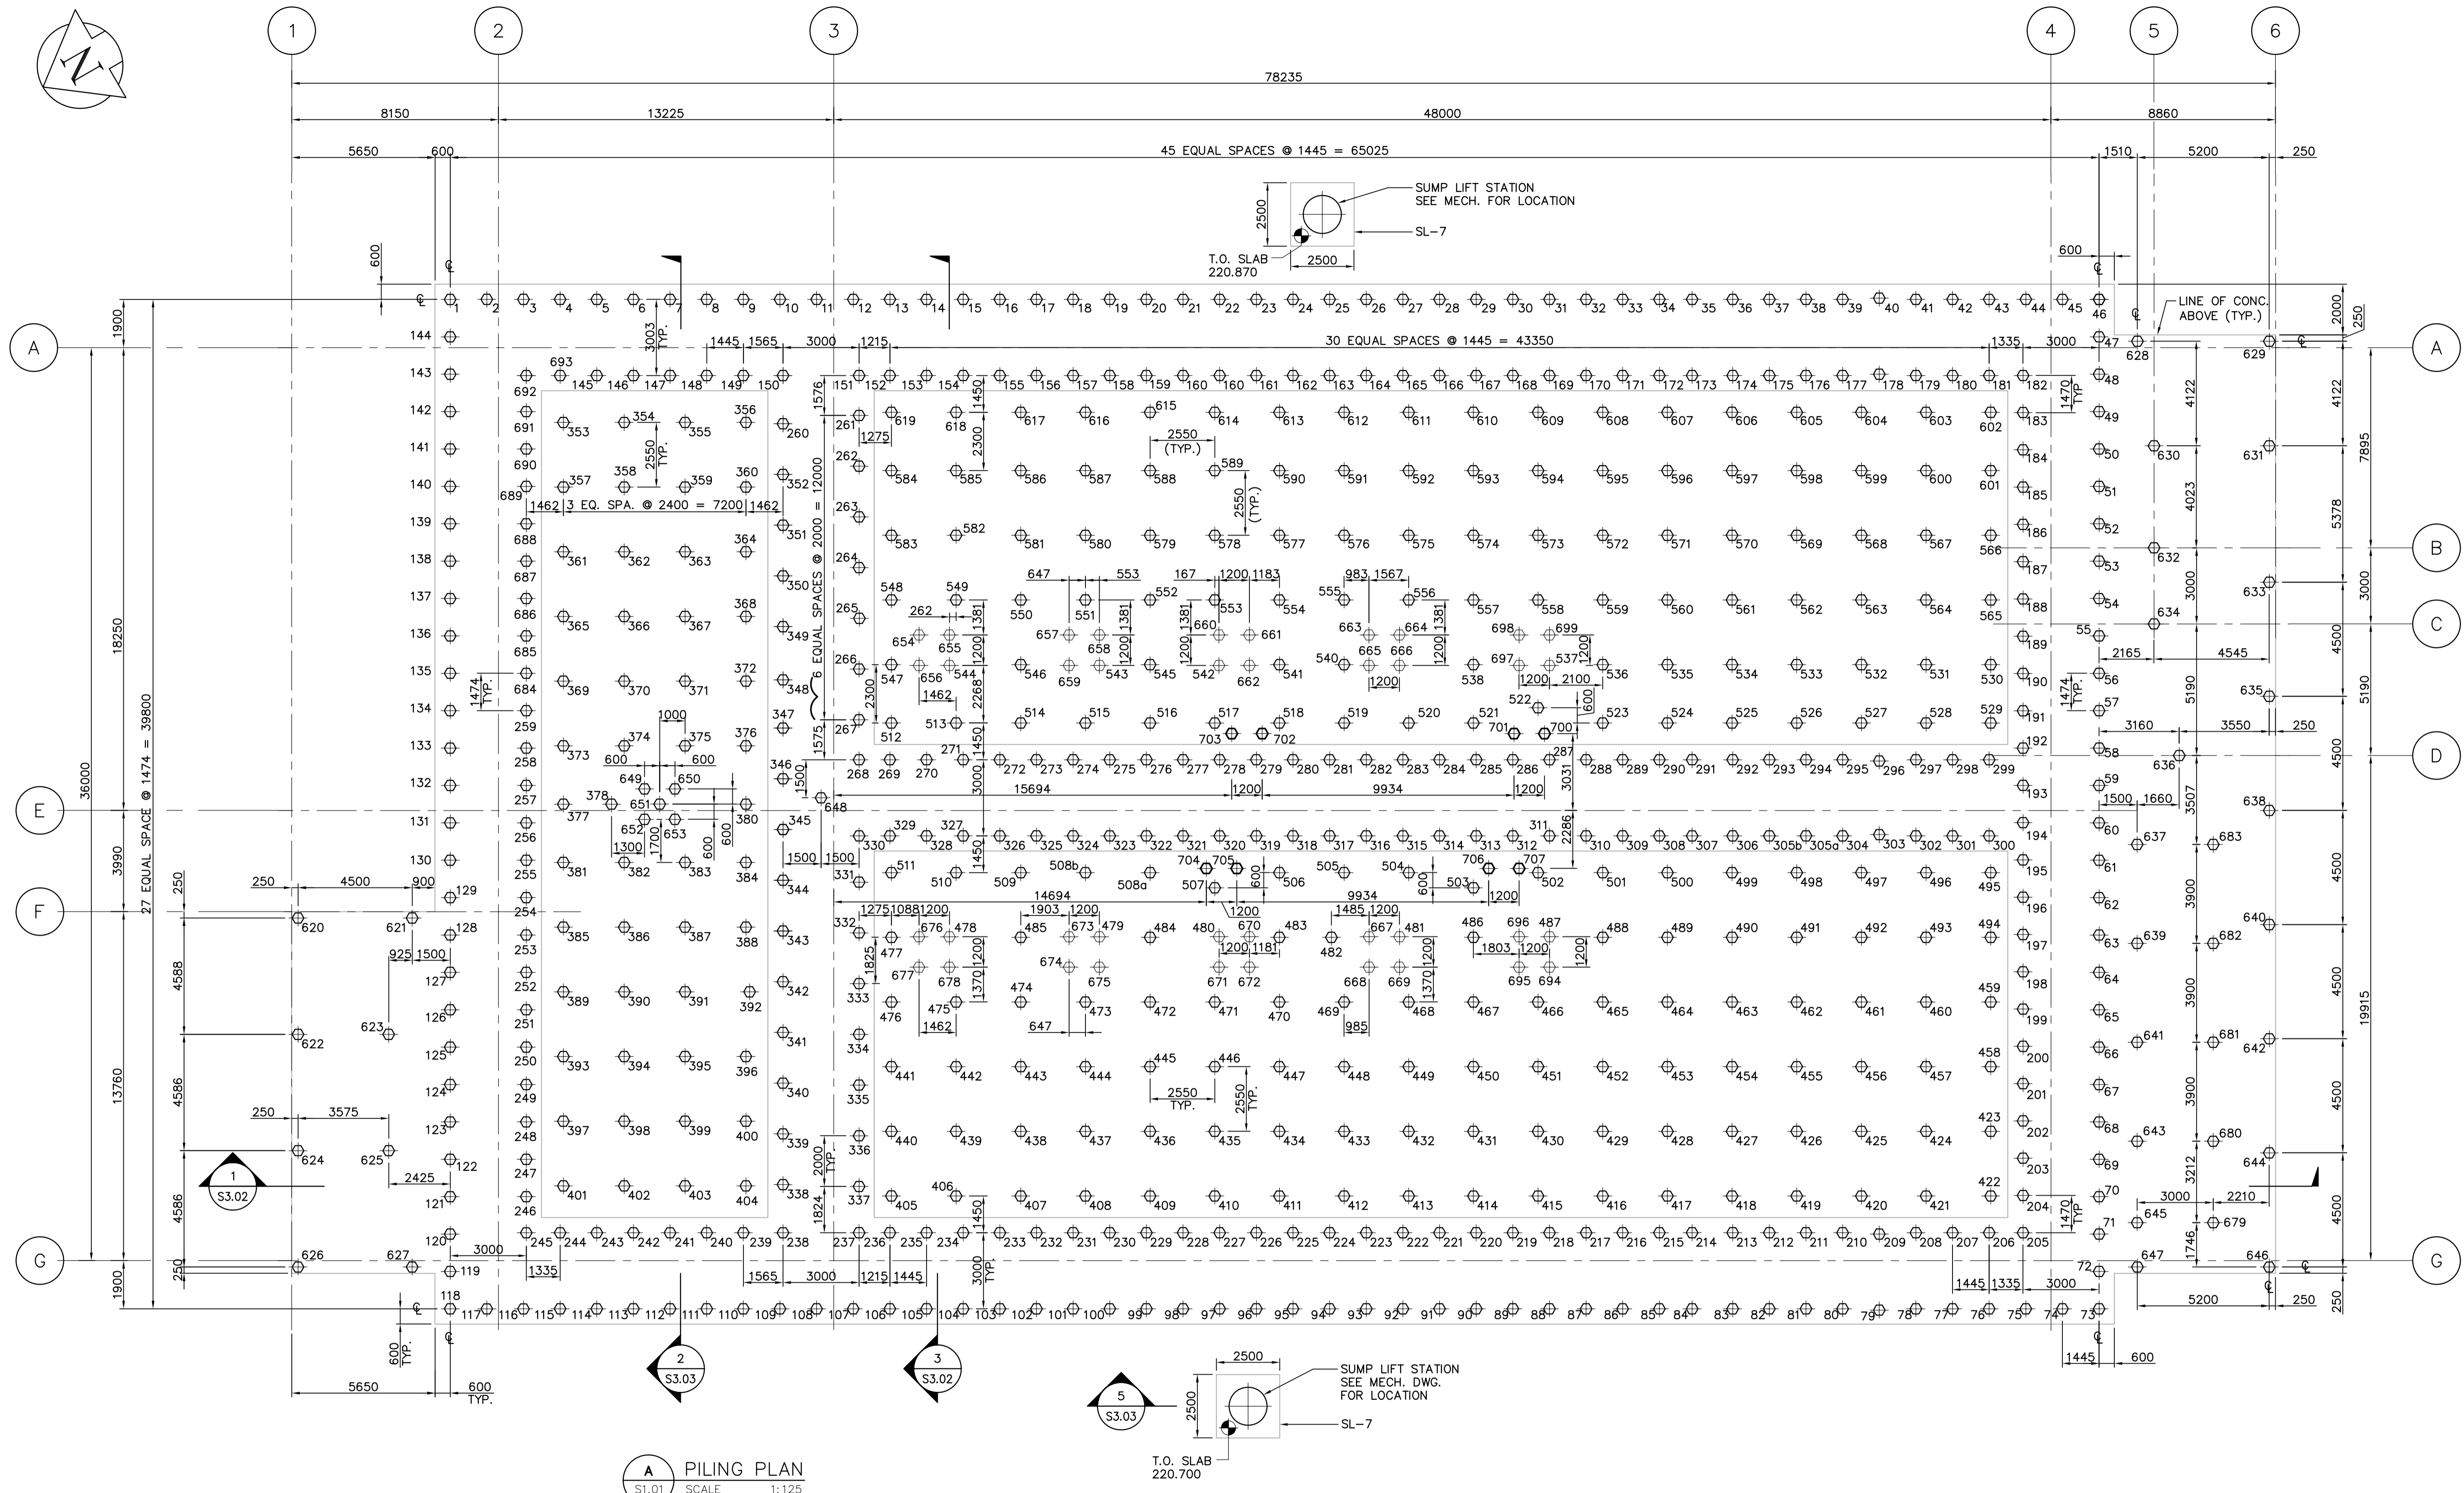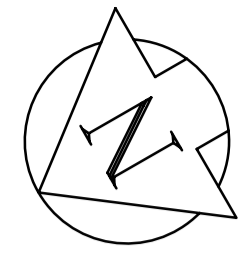

A PILING PLAN
S1.01 SCALE 1:125

NOTES :
1. ALL PILES TO BE PRECAST 400 HEX
2. PILE NUMBERS 379, 539 NOT USED

REFER TO
Subterranean (Monitoba) Ltd
SHORING AS-BUILT
DRAWINGS

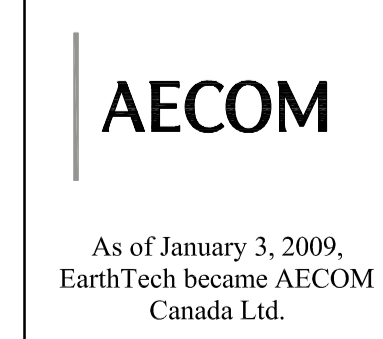

AECOM AS-CONSTRUCTED
SIG: DATE:



NO.	REVISIONS	DATE	BY
03	AS-CONSTRUCTED DRAWING	09/04/09	RJH
02	ISSUED FOR CONSTRUCTION	06/08/30	GLG
01	291-2006 ADDENDUM 6	06/07/26	CMF
00	ISSUED FOR TENDER	06/05/15	WDB

EarthTech A Tyco International Ltd. Company	
DESIGNED BY: LLR	CHECKED BY: GGP
DRAWN BY: WDB	APPROVED BY: JEH
SCALE: AS NOTED	RELEASED FOR CONSTRUCTION BY: K. MARTENS
DATE: 2005/11/23	DATE: 2006/05/15



ENGINEER'S SEAL
ORIGINAL SIGNED BY
L.L. RIDING
2006/05/15
CONSULTANT DRAWING NO.
S1.01

THE CITY OF WINNIPEG
WATER AND WASTE DEPARTMENT
ENGINEERING DIVISION

NEWPCC CENTRATE NUTRIENT TREATMENT
NITROGEN REMOVAL FACILITY

STRUCTURAL
SBR BUILDING
PILING PLAN

CITY FILE NUMBER
SHEET OF
CITY DRAWING NUMBER
1-0101C-S0005-001-03

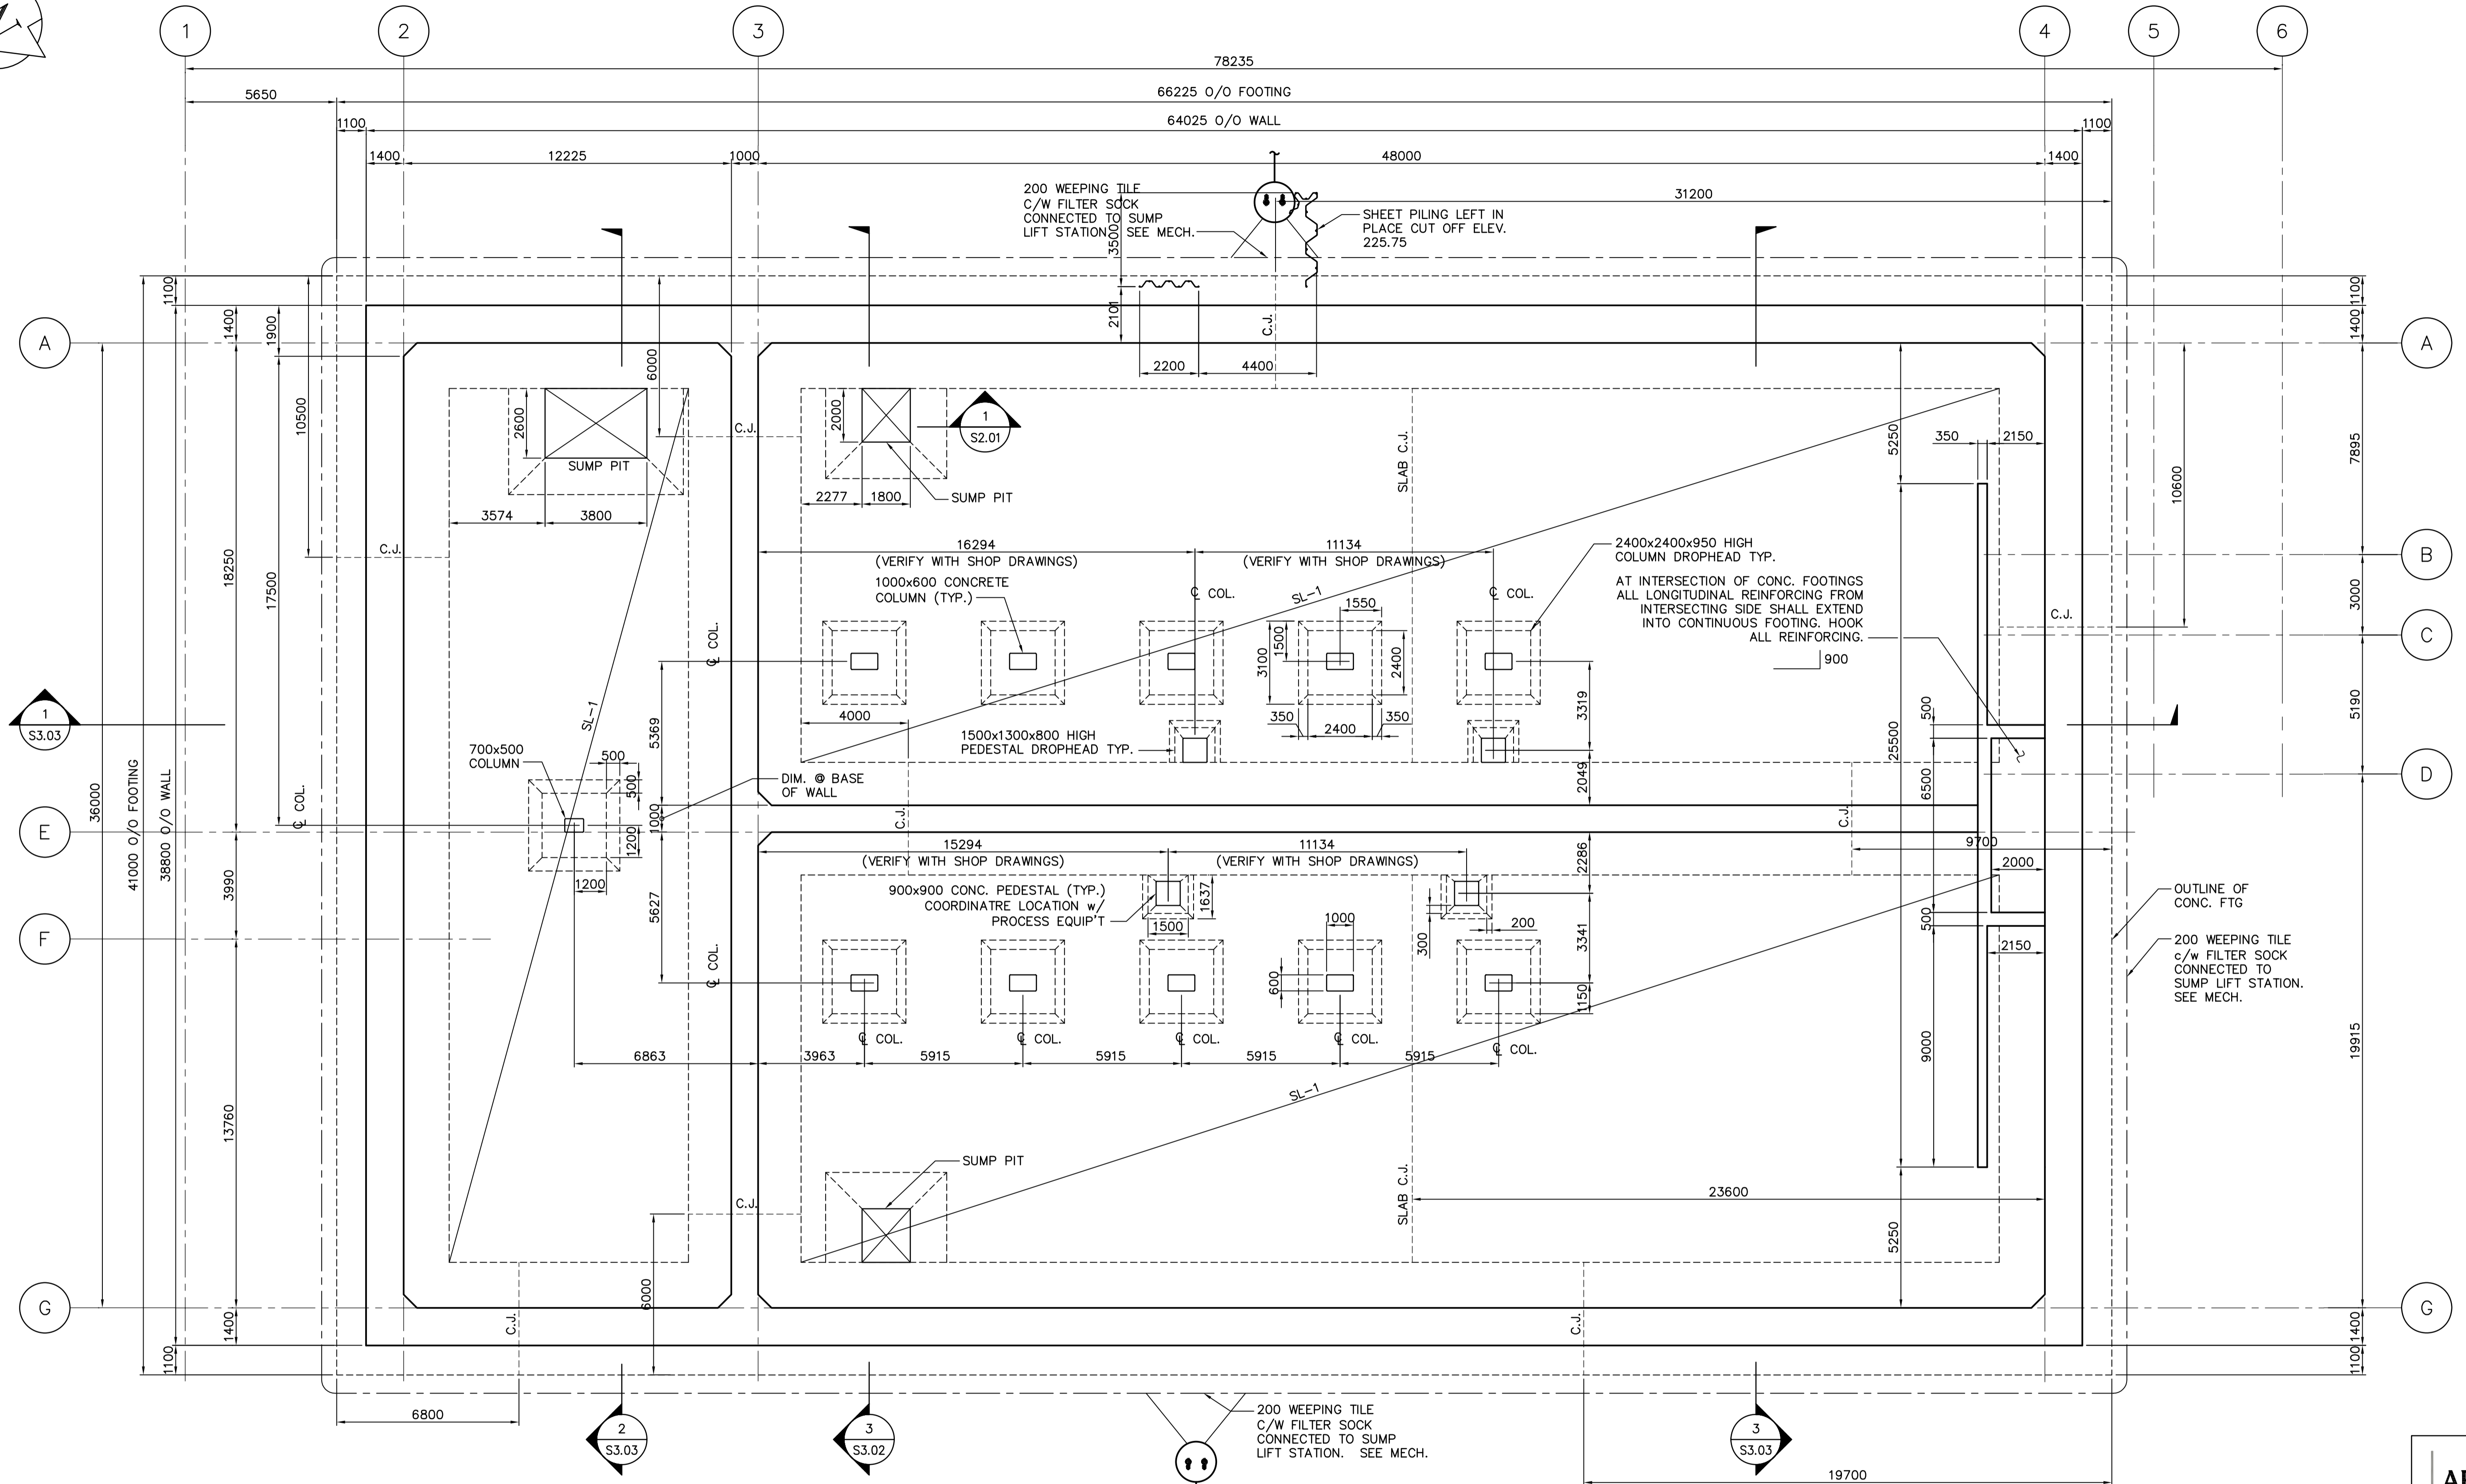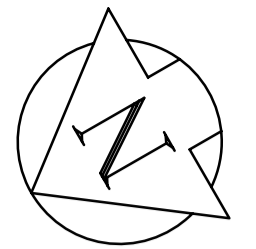

1 SUMP PIT
S2.01 SCALE 1:30

B FLOOR PLAN @ ELEV. 223.910
S2.01 SCALE 1:125

- NOTES:
- ON LIQUID SIDE OF CAST-IN-PLACE CONCRETE FOR EQUALIZATION TANK, SBR-1 AND SBR-2 COATING FORMULA 10.
 - ALL CONSTRUCTION JOINTS SHOWN ARE FOR CONCRETE FOOTING AND SLAB ONLY. REFER TO S2.02 FOR WALL CONSTRUCTION JOINTS.

AECOM AS-CONSTRUCTED
SIG. DATE.

AECOM
As of January 3, 2009, EarthTech became AECOM Canada Ltd.




AECOM
Certificate of Authorization
AECOM Canada Ltd.
No. 4671 Original dated on: 2006/05/15
Date: 2006/05/15

NO.	REVISIONS	DATE	BY
04	AS-CONSTRUCTED DRAWING	09/04/09	GLG
03	ISSUED FOR FI-001	06/12/07	WDB
02	ISSUED FOR CONSTRUCTION	06/08/03	GLG
01	291-2006 ADDENDUM 6	06/07/26	CMF
00	ISSUED FOR TENDER	06/05/15	WDB

DESIGNED BY	LLR	CHECKED BY	GGP
DRAWN BY	WDB	APPROVED BY	JEH
SCALE:	AS NOTED	RELEASED FOR CONSTRUCTION BY:	K. MARTENS
DATE	2005/11/23	DATE	2006/05/15


ENGINEER'S SEAL
ORIGINAL SIGNED BY
L.L. RIDING
2006/05/15
CONSULTANT DRAWING NO.
S2.01

THE CITY OF WINNIPEG
Winnipeg WATER AND WASTE DEPARTMENT
ENGINEERING DIVISION
NEWPCC CENTRATE NUTRIENT TREATMENT NITROGEN REMOVAL FACILITY
CITY FILE NUMBER
SHEET OF
CITY DRAWING NUMBER
1-0101C-S0006-001-04
STRUCTURAL
SBR BUILDING
FLOOR PLAN @ ELEV. 223.910

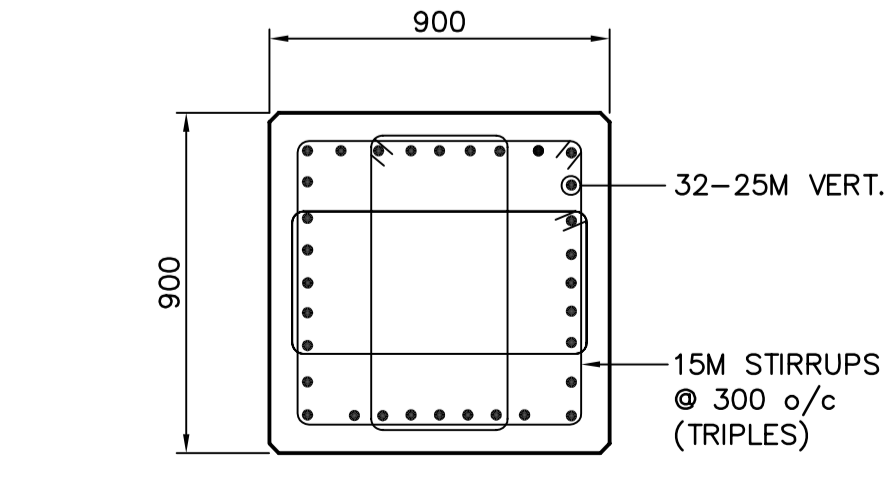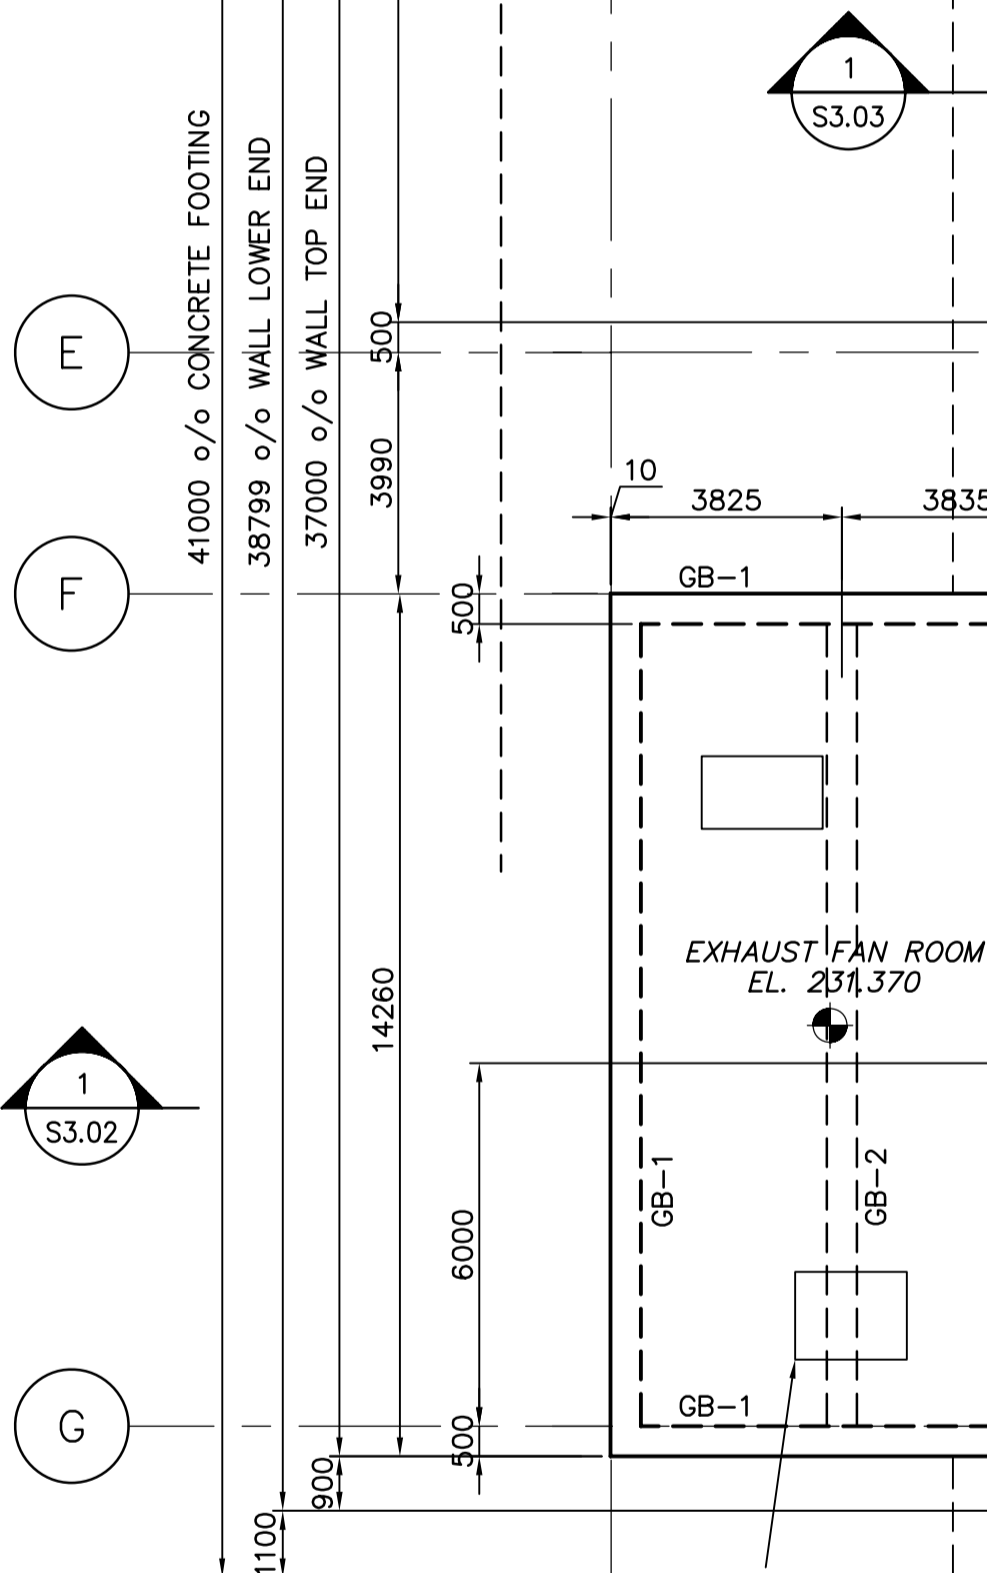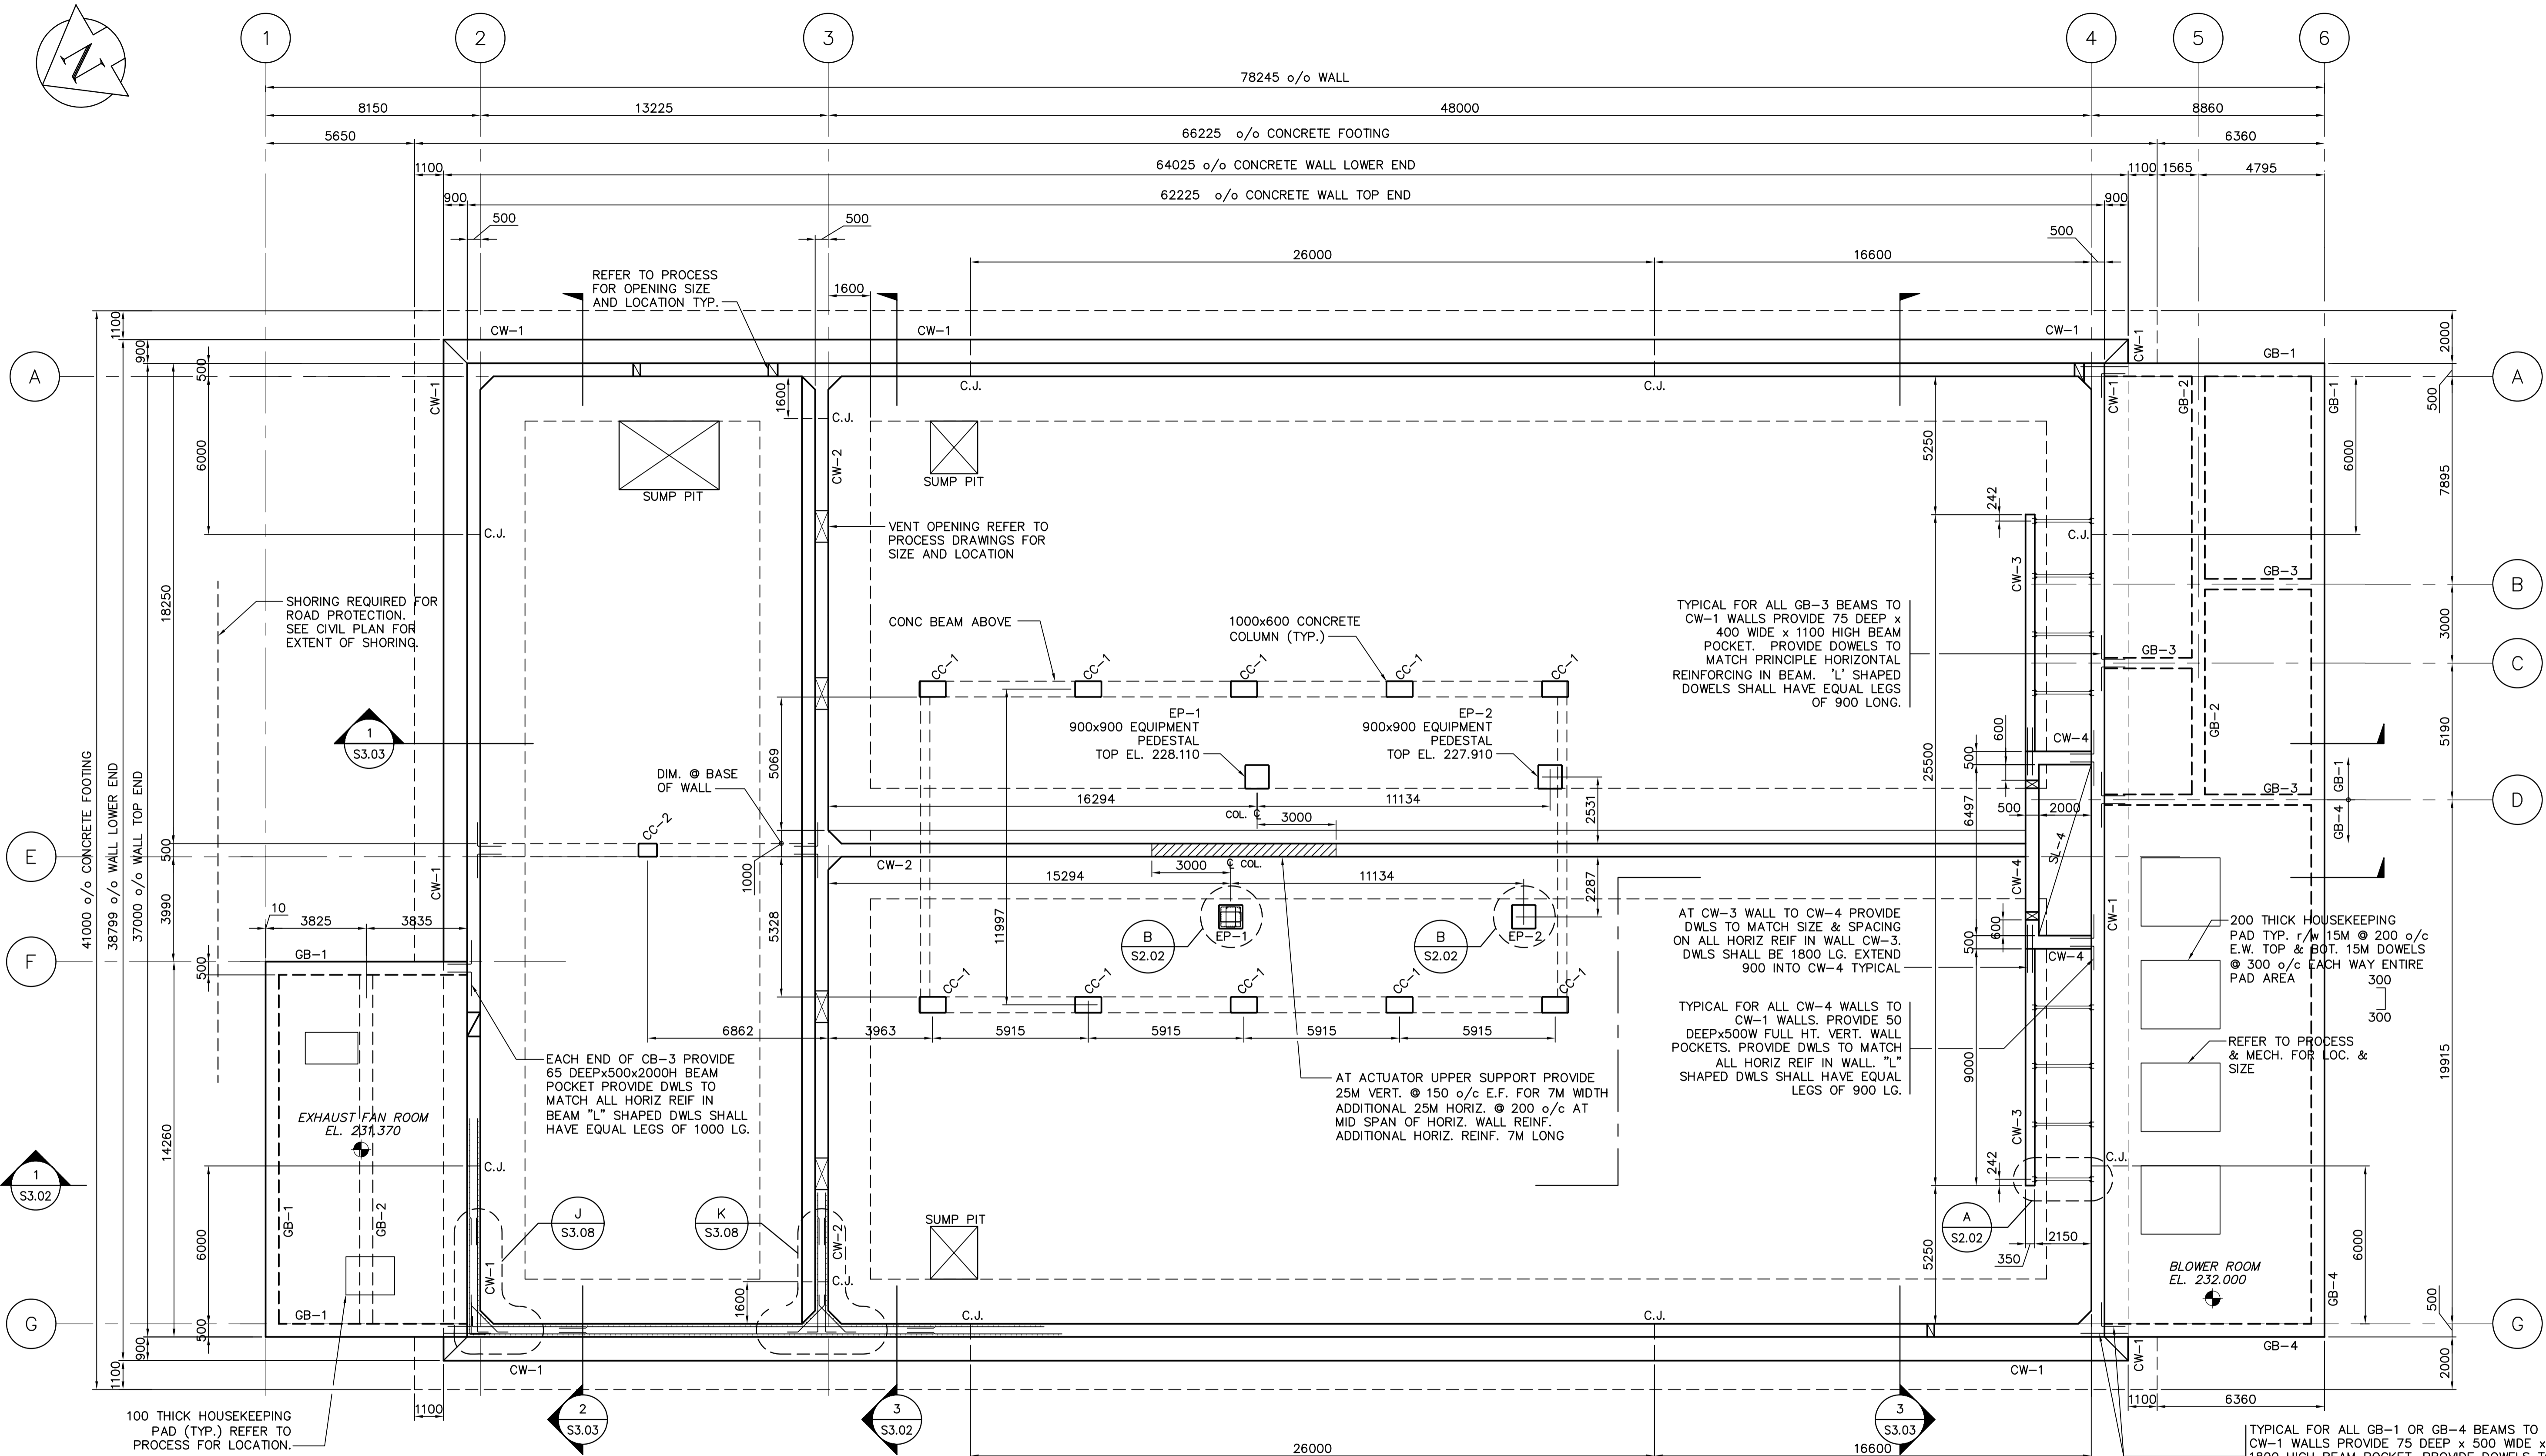


C FOUNDATION PLAN ABOVE EL. 230.000
 S2.02 SCALE 1:125

NOTE:
 1. ON LIQUID SIDE OF CAST-IN-PLACE CONCRETE FOR EQUALIZATION TANK, SBR-1 AND SBR-2 COATING FORMULA 10

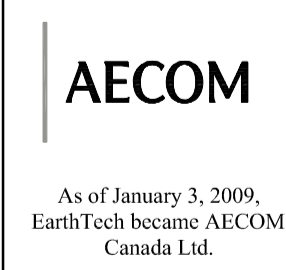

AECOM AS-CONSTRUCTED
 SIG: _____ DATE: _____

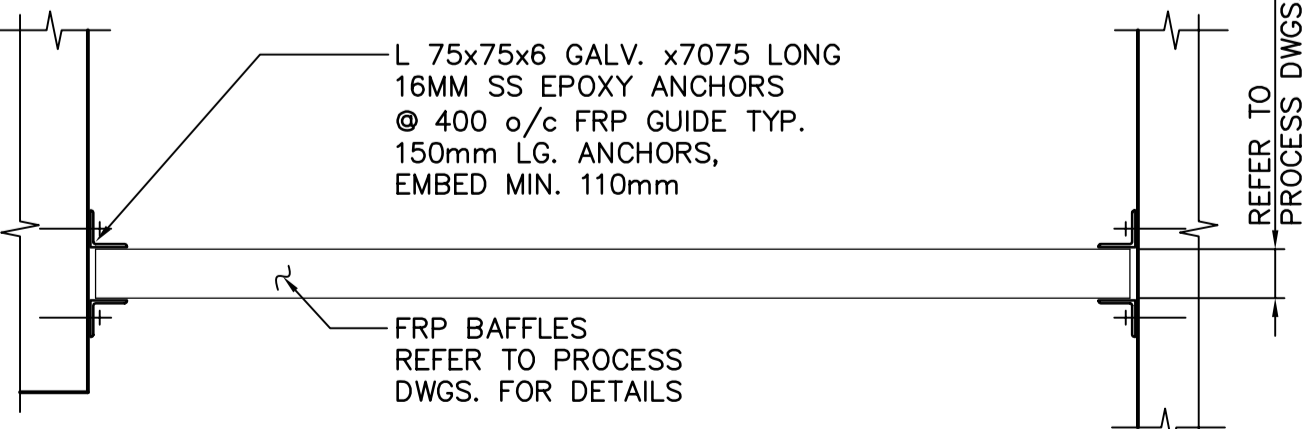

A PLAN DETAIL
 S2.02 SCALE NTS

B PLAN DETAIL EP-1 & EP-2
 S2.02 SCALE 1:20



NO.	REVISIONS	DATE	BY	DATE
04	AS-CONSTRUCTED DRAWING	09/04/09	RJH	
03	ISSUED FOR FI-001	06/12/07	WDB	
02	ISSUED FOR CONSTRUCTION	06/08/03	GLG	
01	291-2006 ADDENDUM 6	06/07/26	CMF	
00	ISSUED FOR TENDER	06/05/15	WDB	

DESIGNED BY	CHECKED BY	DATE
LLR	GGP	2005/11/23
DRAWN BY	APPROVED BY	DATE
WDB	JEH	2006/05/15

ENGINEER'S SEAL
ORIGINAL SIGNED BY L.L. RIDING 2006/05/15
CONSULTANT DRAWING NO. S2.02


THE CITY OF WINNIPEG
 WATER AND WASTE DEPARTMENT
 ENGINEERING DIVISION

Winnipeg

NEWPCC CENTRATE NUTRIENT TREATMENT
 NITROGEN REMOVAL FACILITY


STRUCTURAL
 SBR BUILDING
 FOUNDATION PLAN ABOVE EL. 230.000

CITY FILE NUMBER
 SHEET OF
 CITY DRAWING NUMBER
 1-0101C-S0007-001-04

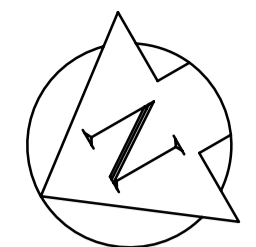

PRECAST DOUBLE TEE NOTES:

- 1). PRECAST DOUBLE TEE SUPPLIER TO PROVIDE CALCULATIONS AND SHOP DRAWINGS FOR REVIEW PRIOR TO FABRICATION, SHOP DRAWINGS SHALL INCLUDE DESIGN LOADS, OPENINGS, BEARING DETAILS AND SHALL BE SIGNED AND SEALED BY A PROFESSIONAL ENGINEER REGISTERED IN THE PROVINCE OF MANITOBA.
- 2). ALL OPENINGS IN THE PRECAST DOUBLE TEE'S SHALL BE SHOP FABRICATED.
- 3). PROVIDE A MINIMUM 40 COVER TO MAIN REINFORCING IN ALL STEMS.
- 4). ALL REINFORCING BARS AND MESH REINFORCING SHALL BE GALVANIZED.
- 5). PRECAST DOUBLE TEE SUPPLIER TO DESIGN & PROVIDE ALL CAST-IN PLATES, BEARING PLATES, SHOES AND WELD PLATES TO ENSURE PRECAST DBL TEE FIXITY AT BEARING ENDS AS NOTED ON DRAWINGS.
- 6). PRECAST DOUBLE TEE SUPPLIER TO PROVIDED AS CAST-IN-PLACE WELD PLATES ALONG EDGES OF FLANGES.

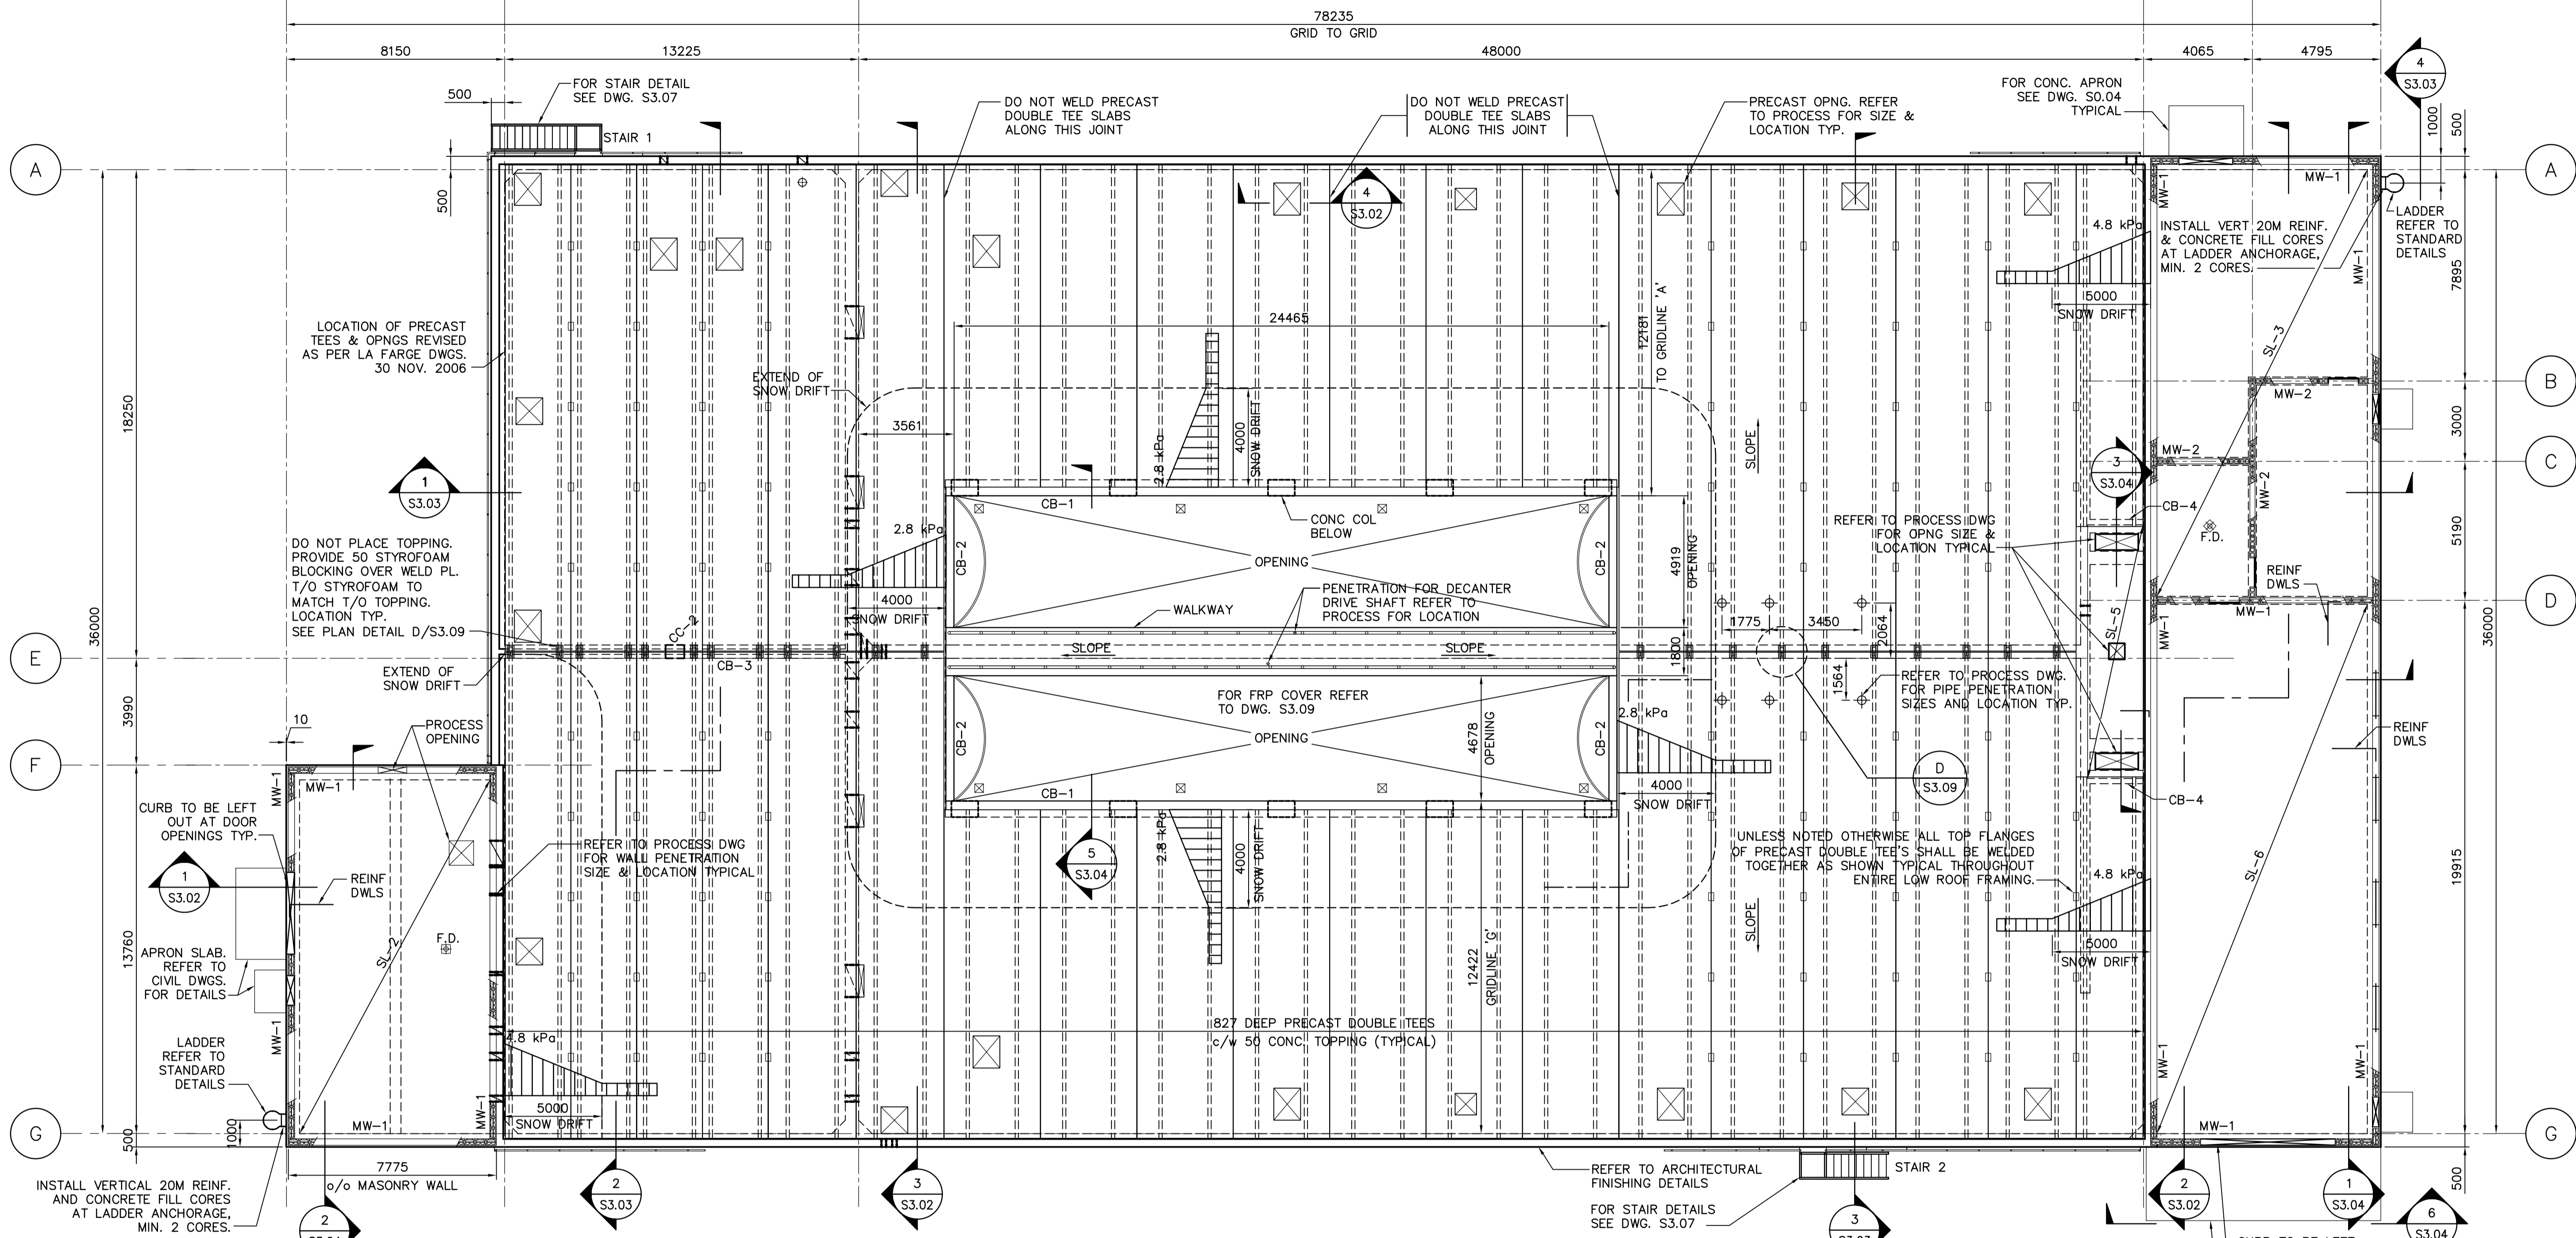

- DESIGN LOADS:**
EQUALIZATION TANK, SBR-1 & SBR-2
1. DEAD LOADS:
 - .1) STRUCTURE SELF WEIGHT 1.0 kPa
 - .2) ROOFING = 2.0 kPa
 - .3) MECHANICAL LOAD 2.0 kPa
 - .4) MAX. CONCENTRATED LOAD SUSPENDED 1.8 kN AT ANY STEM POINT U.O.N. ON STRUCT./MECH. DWG'S
 - .5) MAX. CONCENTRATED LOAD TOPSIDE 2.5 kN AT ANY STEM POINT U.O.N. ON (STRUCT./MECH.) DWG'S. SINGLE STEM MAY HAVE MORE THAN ONE POINT LOAD, POINT LOAD BASED ON MAX. SUPPORT SPACING OF 3.0 M
 - .6) CONC. TOPPING 1.2 kPa
 2. LIVE LOADS
 - .1) GROUND SNOW LOAD - $S_s = 1.7$ kPa
 $S_r = 0.2$ kPa
MODIFY FOR EXPOSURE AND DRIFT AS PER NBC 1995.
 - .2) RAIN LOAD: 0.0 kPa AT PARAPETS VARYING UNIFORMLY TO 0.5 kPa AT DRAINS
 - .3) WIND $q(1/30) = 0.42$ kPa
 - .4) OCCUPANCY 2.4 kPa
 - .5) MAX. NEGATIVE PRESSURE 0.65 kPa
 - .6) MAX. POSITIVE PRESSURE 0.05 kPa
 - .7) EARTH PRESSURE (DRAINED) 17.5 kPa
 - .8) SURCHARGE 10 kPa

REFER TO LAFARGE AS-BUILT SHOP DRAWINGS

- BLOWER BUILDING**
- A.) DEAD LOADS:
 - .1) STRUCTURE SELF WEIGHT 12.0 kPa
 - .2) SUPERIMPOSED = 4.8 kPa
 - B.) LIVE LOADS:
 - .1) OCCUPANCY (ELECT., SAMPLE & CONTROL RMS) 10.0 kPa
 - .2) OCCUPANCY (BLOWER RM.)
- EXHAUST FAN BUILDING**
- A.) DEAD LOADS:
 - .1) STRUCTURE SELF WEIGHT 12.0 kPa
 - .2) SUPERIMPOSED = 7.2 kPa
 - B.) LIVE LOADS:
 - .1) OCCUPANCY 7.2 kPa



D LOWER ROOF FRAMING PLAN
 S2.03 SCALE 1:125

DRAWING NOTES:

- 1). REFER TO CIVIL DRAWINGS FOR ALL APRON SLAB SIZES
- 2). CONCRETE BONDED TOPPING OVER PRECAST DOUBLE TEE'S SHALL BE REINFORCED WITH GALVANIZED WELDED WIRE 152x152 MW13.3xMW13.3
- 3). THE CONCRETE BONDED TOPPING OVER PRECAST DOUBLE TEE'S SHALL PROVIDE A CONTROL JOINT OVER JOINT INDICATED THAT SHALL NOT HAVE FLANGES WELDED TOGETHER.
- 4). THE BONDED CONCRETE TOPPING OVER THE PRECAST DOUBLE TEE'S SHALL STOP AT THE CENTRE BEARING OF THE TEES TO PROVIDE A 40 GAP THE FULL LENGTH OF THE COVER.
- 5). DURING INSTALLATION OF ALL PRECAST DOUBLE TEE'S AND HOLLOWCORE ROOF PLANKS ALL LIFTING EQUIPMENT, TRUCKS, ETC. SHALL STAY A MINIMUM OF 9.0m AWAY FROM THE PERIMETER TANK WALLS OF THE SBR'S AND EQUALIZATION TANK.
- 6). THE BONDED CONCRETE TOPPING SHALL EXTEND OVER SLAB SL-5

<p>Certificate of Authorization AECOM Canada Ltd. Original dated on: No. 4671 Date: 2006/05/15</p>	
B.M. ELEV.	
06 AS-CONSTRUCTED DRAWING	09/04/09 RJH
05 ISSUED FOR FI-0-014	07/07/31 AC
04 ISSUED FOR FI-001	06/12/07 WDB
03 ISSUED FOR CONSTRUCTION	06/08/30 GLG
02 291-2006 ADDENDUM 6	06/07/25 CMF
01 291-2006 ADDENDUM 4	06/07/19 WDB
00 ISSUED FOR TENDER	06/05/15 WDB
NO. REVISIONS	DATE BY
	2006/01/16 DATE 2006/05/15

<p>A Tyco International Ltd. Company</p>			
DESIGNED BY	LLR	CHECKED BY	GGP
DRAWN BY	WDB	APPROVED BY	JEH
SCALE:	AS NOTED	RELEASED FOR CONSTRUCTION BY:	K. MARTENS
DATE	2006/01/16	DATE	2006/05/15

ENGINEER'S SEAL	
ORIGINAL SIGNED BY	L.L. RIDING
	2006/05/15
CONSULTANT DRAWING NO.	S2.03



THE CITY OF WINNIPEG
 WATER AND WASTE DEPARTMENT
 ENGINEERING DIVISION

Winnipeg

NEPCC CENTRATE NUTRIENT TREATMENT NITROGEN REMOVAL FACILITY

STRUCTURAL SBR BUILDING LOWER ROOF FRAMING PLAN

CITY FILE NUMBER
 SHEET OF
 CITY DRAWING NUMBER
 1-0101C-S0008-001-06

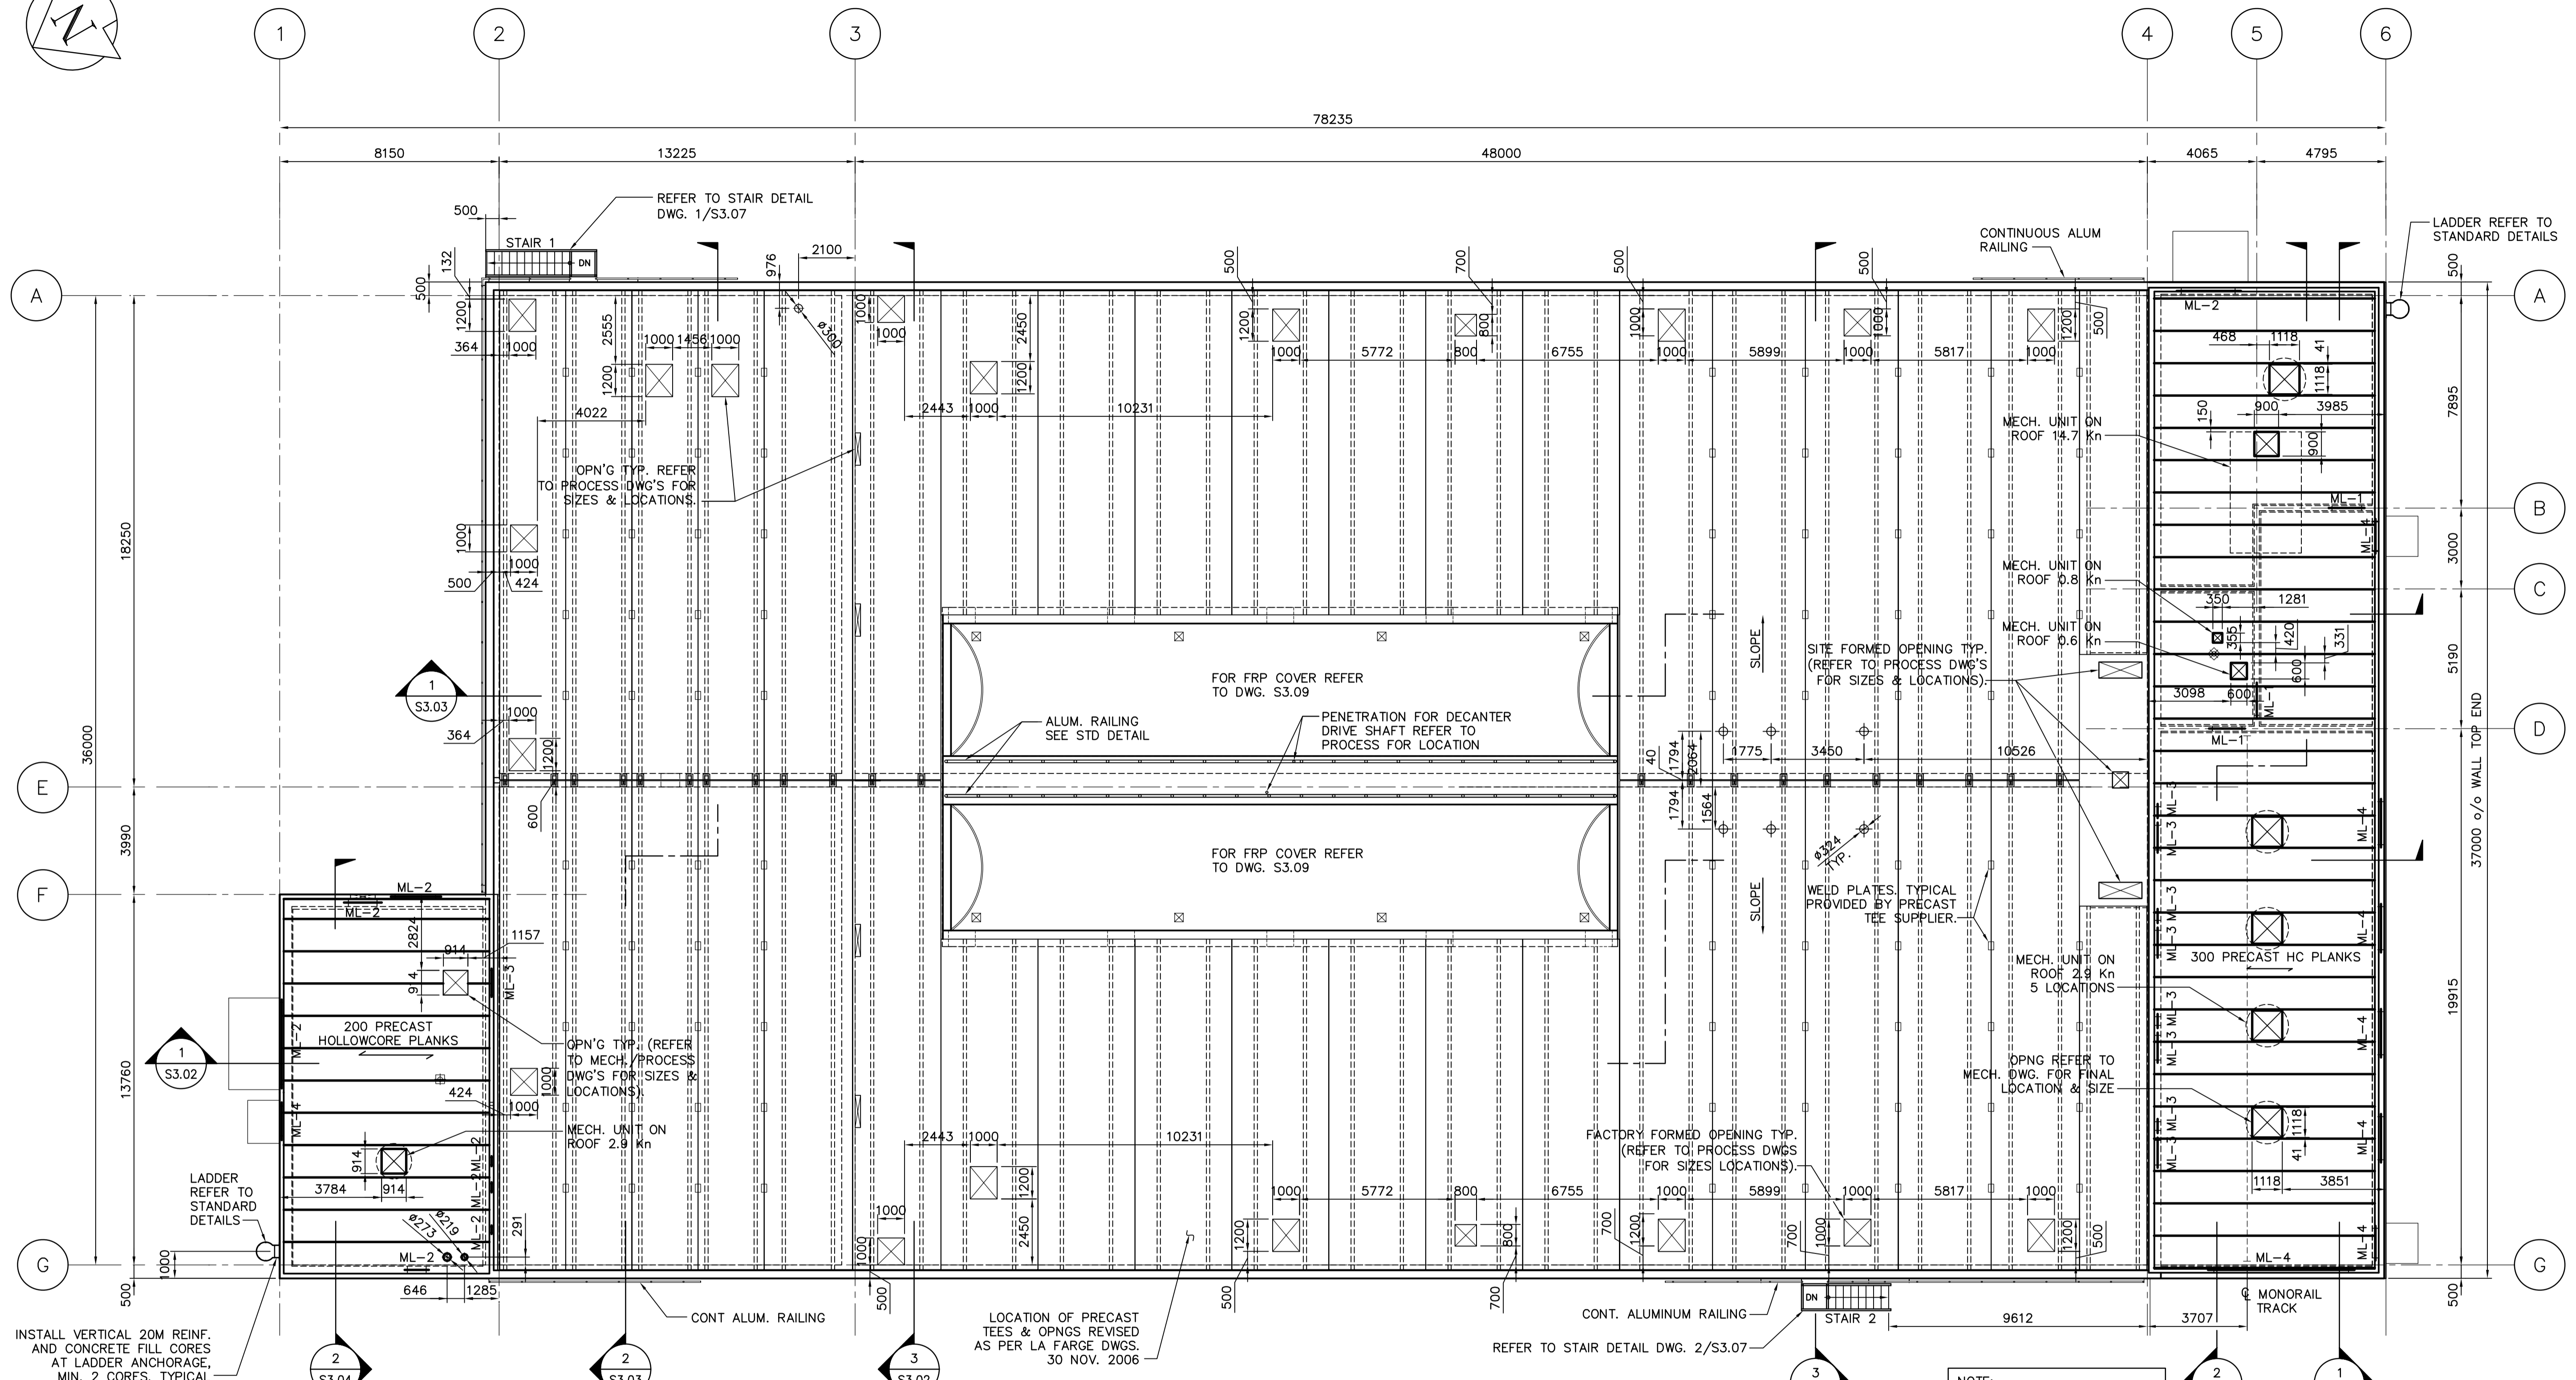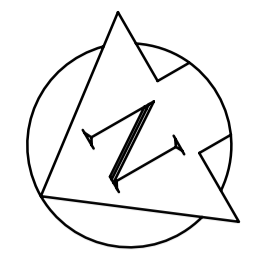

E UPPER ROOF FRAMING PLAN
 SCALE: 1:125

DESIGN LOADS: BLOWER BUILDING & EXHAUST FAN BUILDING

D.L. = STRUCTURE SELF WT.	L.L. SNOW = 1.6 kPa
D.L. MONO-RAIL = 12.0 kN	L.L. MONO RAIL = 26.7 kN
D.L. MECH./PIPING = 2.0 kPa	L.L. OCCUPANCY = 2.4 kPa
D.L. ROOF CONST. = 1.0 kPa	
D.L. MECH. UNITS = AS INDICATED	

- PRECAST HOLLOWCORE NOTES:**
- HOLLOWCORE PLANK SUPPLIER TO PROVIDE DESIGN CALCULATIONS AND SHOP DRAWINGS FOR REVIEW PRIOR TO FABRICATION. SHOP DRAWINGS SHALL INCLUDE DESIGN LOADS, OPENINGS, AND SHALL BE SIGNED AND SEALED BY A PROFESSIONAL ENGINEER REGISTERED IN THE PROVINCE OF MANITOBA.
 - ALL OPENINGS IN HOLLOWCORE PLANKS SHALL BE SHOP FABRICATED. DESIGN AND SUPPLY OF ALL HANGERS AT OPENINGS ARE THE RESPONSIBILITY OF PRECAST HOLLOWCORE PLANK SUPPLIER.
 - ALL NOTCHED OUT AREAS FOR GROUT BARS SHALL BE PROVIDED. ALL REQUIRED GROUT BARS & DOWELS TO BOND BEAMS SHALL BE PROVIDED BY PRECAST HOLLOWCORE PLANK SUPPLIER.
 - PROVIDE ALL BEARING PADS AS REQUIRED.

REFER TO LAFARGE SHOP DRAWINGS KGS MASONRY REPAIR AS-BUILTS



- NOTE:**
- FOR SCHEDULE OF MASONRY LINTELS SEE DWG S0.03
 - ALL OPENINGS INDICATED IN PRECAST DOUBLE TEES SHALL BE FACTORY FORMED.
 - DURING INSTALLATION OF ALL PRECAST DOUBLE TEE'S AND HOLLOWCORE ROOF PLANKS ALL LIFTING EQUIPMENT, TRUCKS, ETC. SHALL STAY A MINIMUM OF 9.0m AWAY FROM THE PERIMETER TANK WALLS OF THE SBR'S AND EQUALIZATION TANK.

NOTE: MONO RAIL TO BE SUSPENDED FROM HOLLOWCORE PLANKS ABOVE.

AECOM AS-CONSTRUCTED
 SIG..... DATE.....

AECOM
 As of January 3, 2009, EarthTech became AECOM Canada Ltd.

B.M. ELEV.	DATE	BY	DATE	BY
	09/04/13	LLR	06/12/07	WDB
	06/12/07	WDB	06/08/30	GLG
	06/08/30	GLG	06/07/25	CMF
	06/07/25	CMF	06/05/15	WDB
	06/05/15	WDB		

EarthTech
 A Tyco International Ltd. Company

DESIGNED BY: LLR	CHECKED BY: GGP
DRAWN BY: WDB	APPROVED BY: JEH
SCALE: AS NOTED	RELEASED FOR CONSTRUCTION BY: K. MARTENS
DATE: 2005/11/23	DATE: 2006/05/15

ENGINEER'S SEAL
 ORIGINAL SIGNED BY: L.L. RIDING
 DATE: 2006/05/15
 CONSULTANT DRAWING NO. S3.01


THE CITY OF WINNIPEG
 WATER AND WASTE DEPARTMENT
 ENGINEERING DIVISION

Winnipeg


NEWPCC CENTRATE NUTRIENT TREATMENT NITROGEN REMOVAL FACILITY

STRUCTURAL SBR BUILDING UPPER ROOF FRAMING PLAN


CITY FILE NUMBER: 1-0101C-S0009-001-04
 SHEET OF: 1-0101C-S0009-001-04
 CITY DRAWING NUMBER: 1-0101C-S0009-001-04

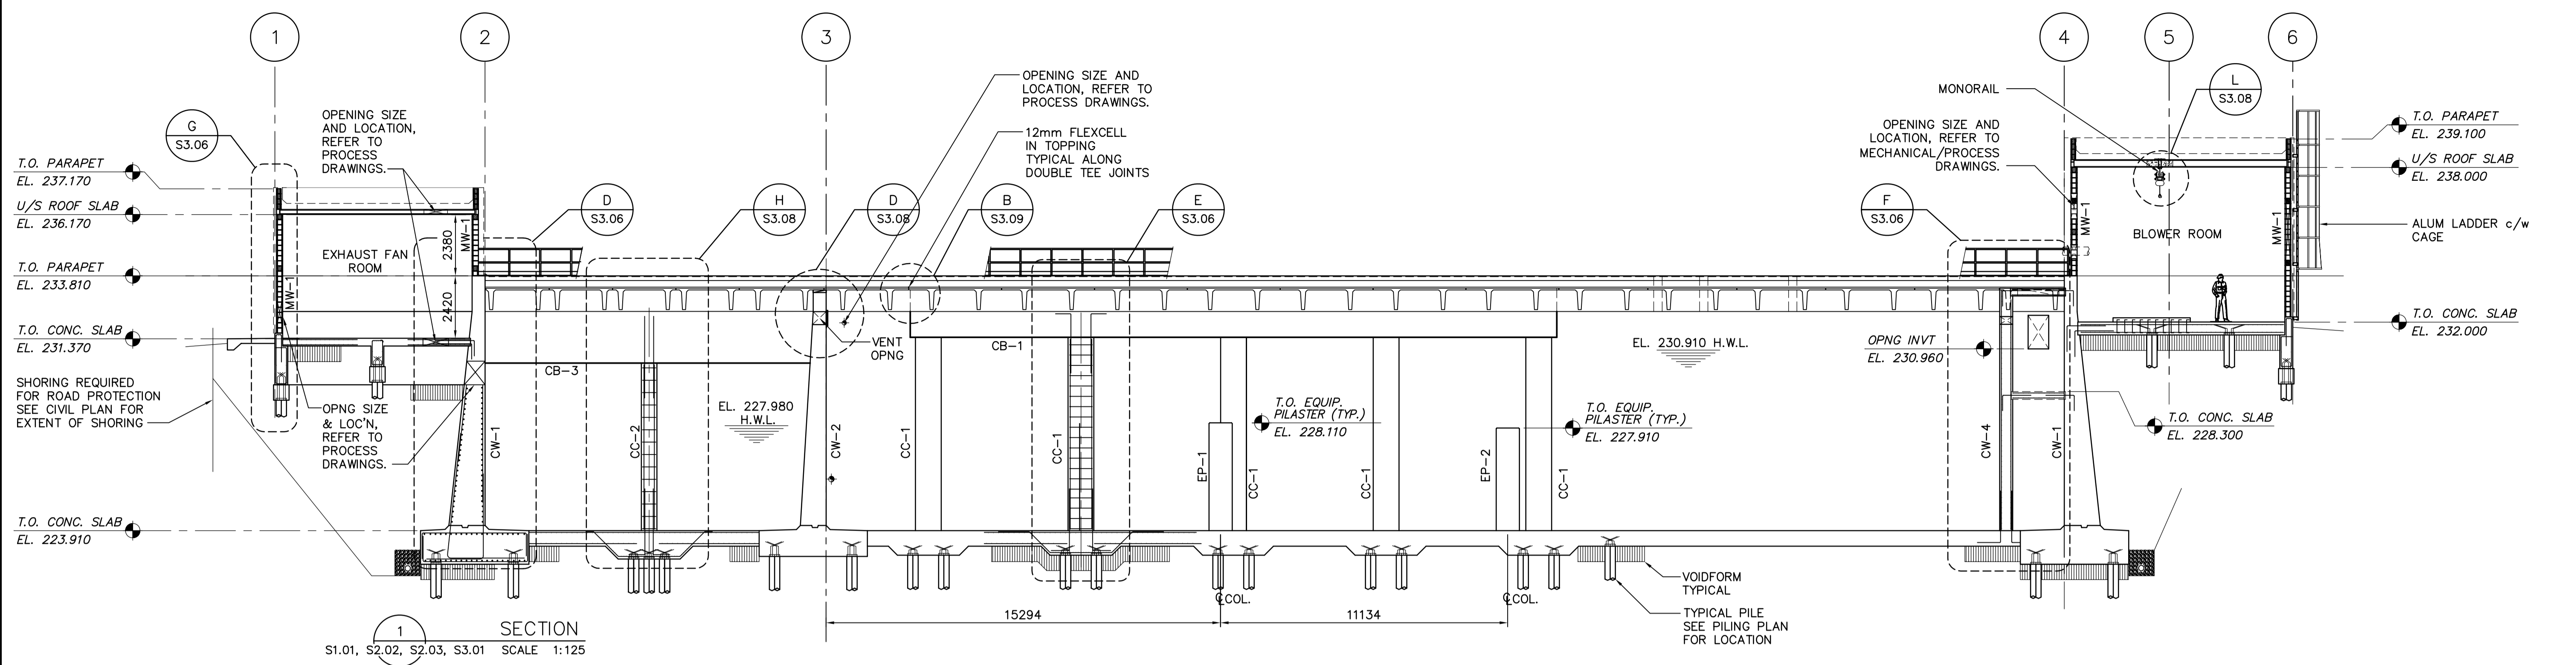


SECTION 1
S1.01, S2.02, S2.03, S3.01 SCALE 1:125

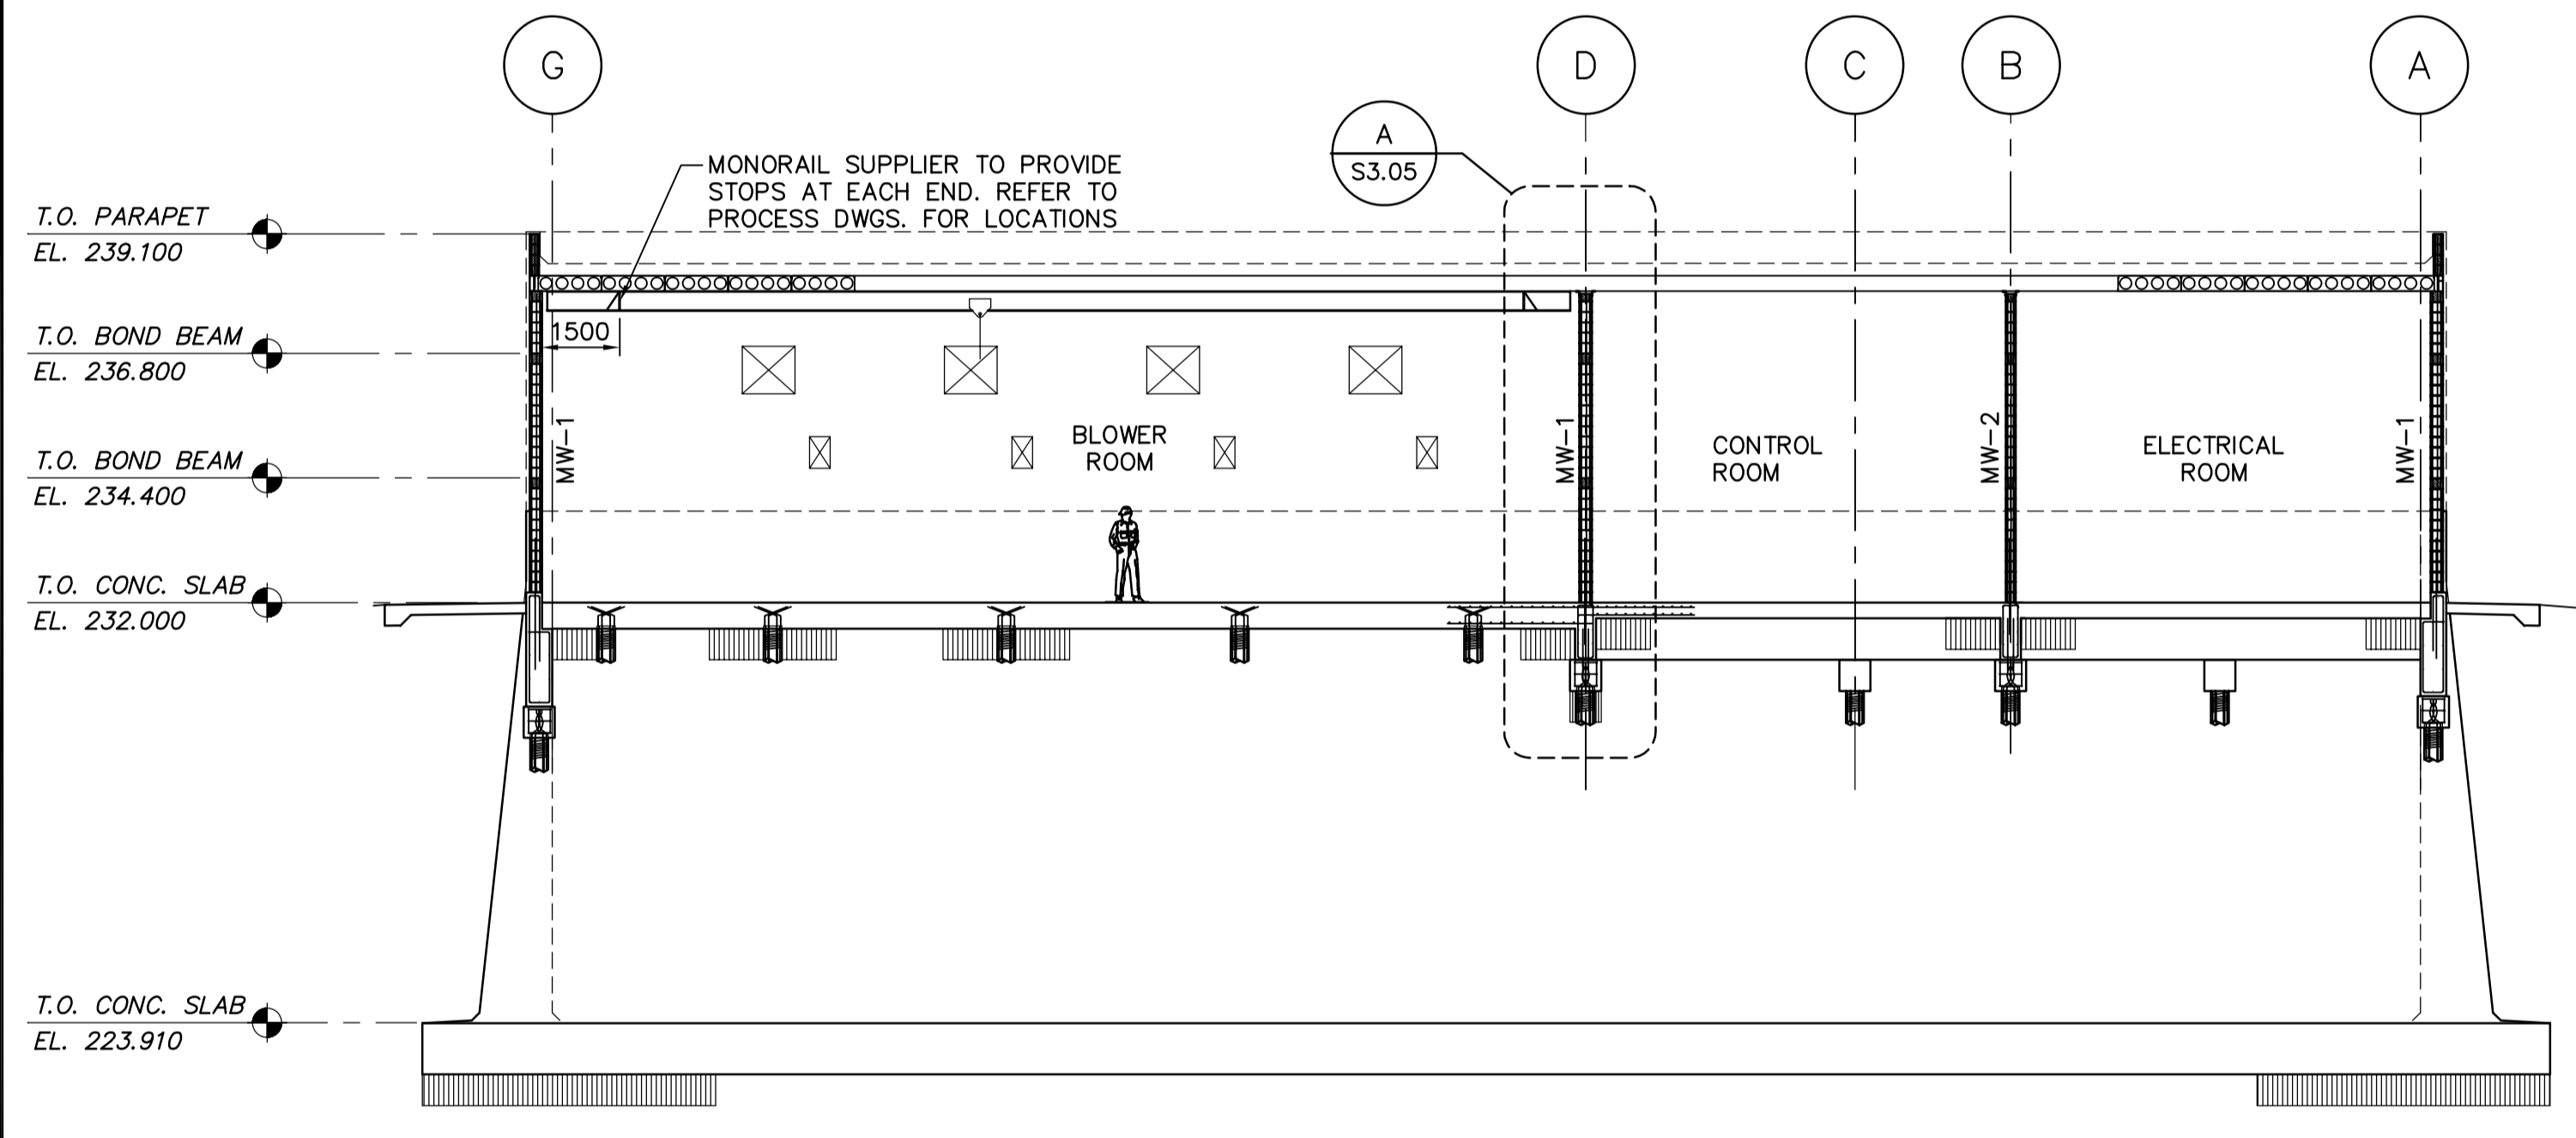


SECTION 2
S2.03, S3.01 SCALE 1:125

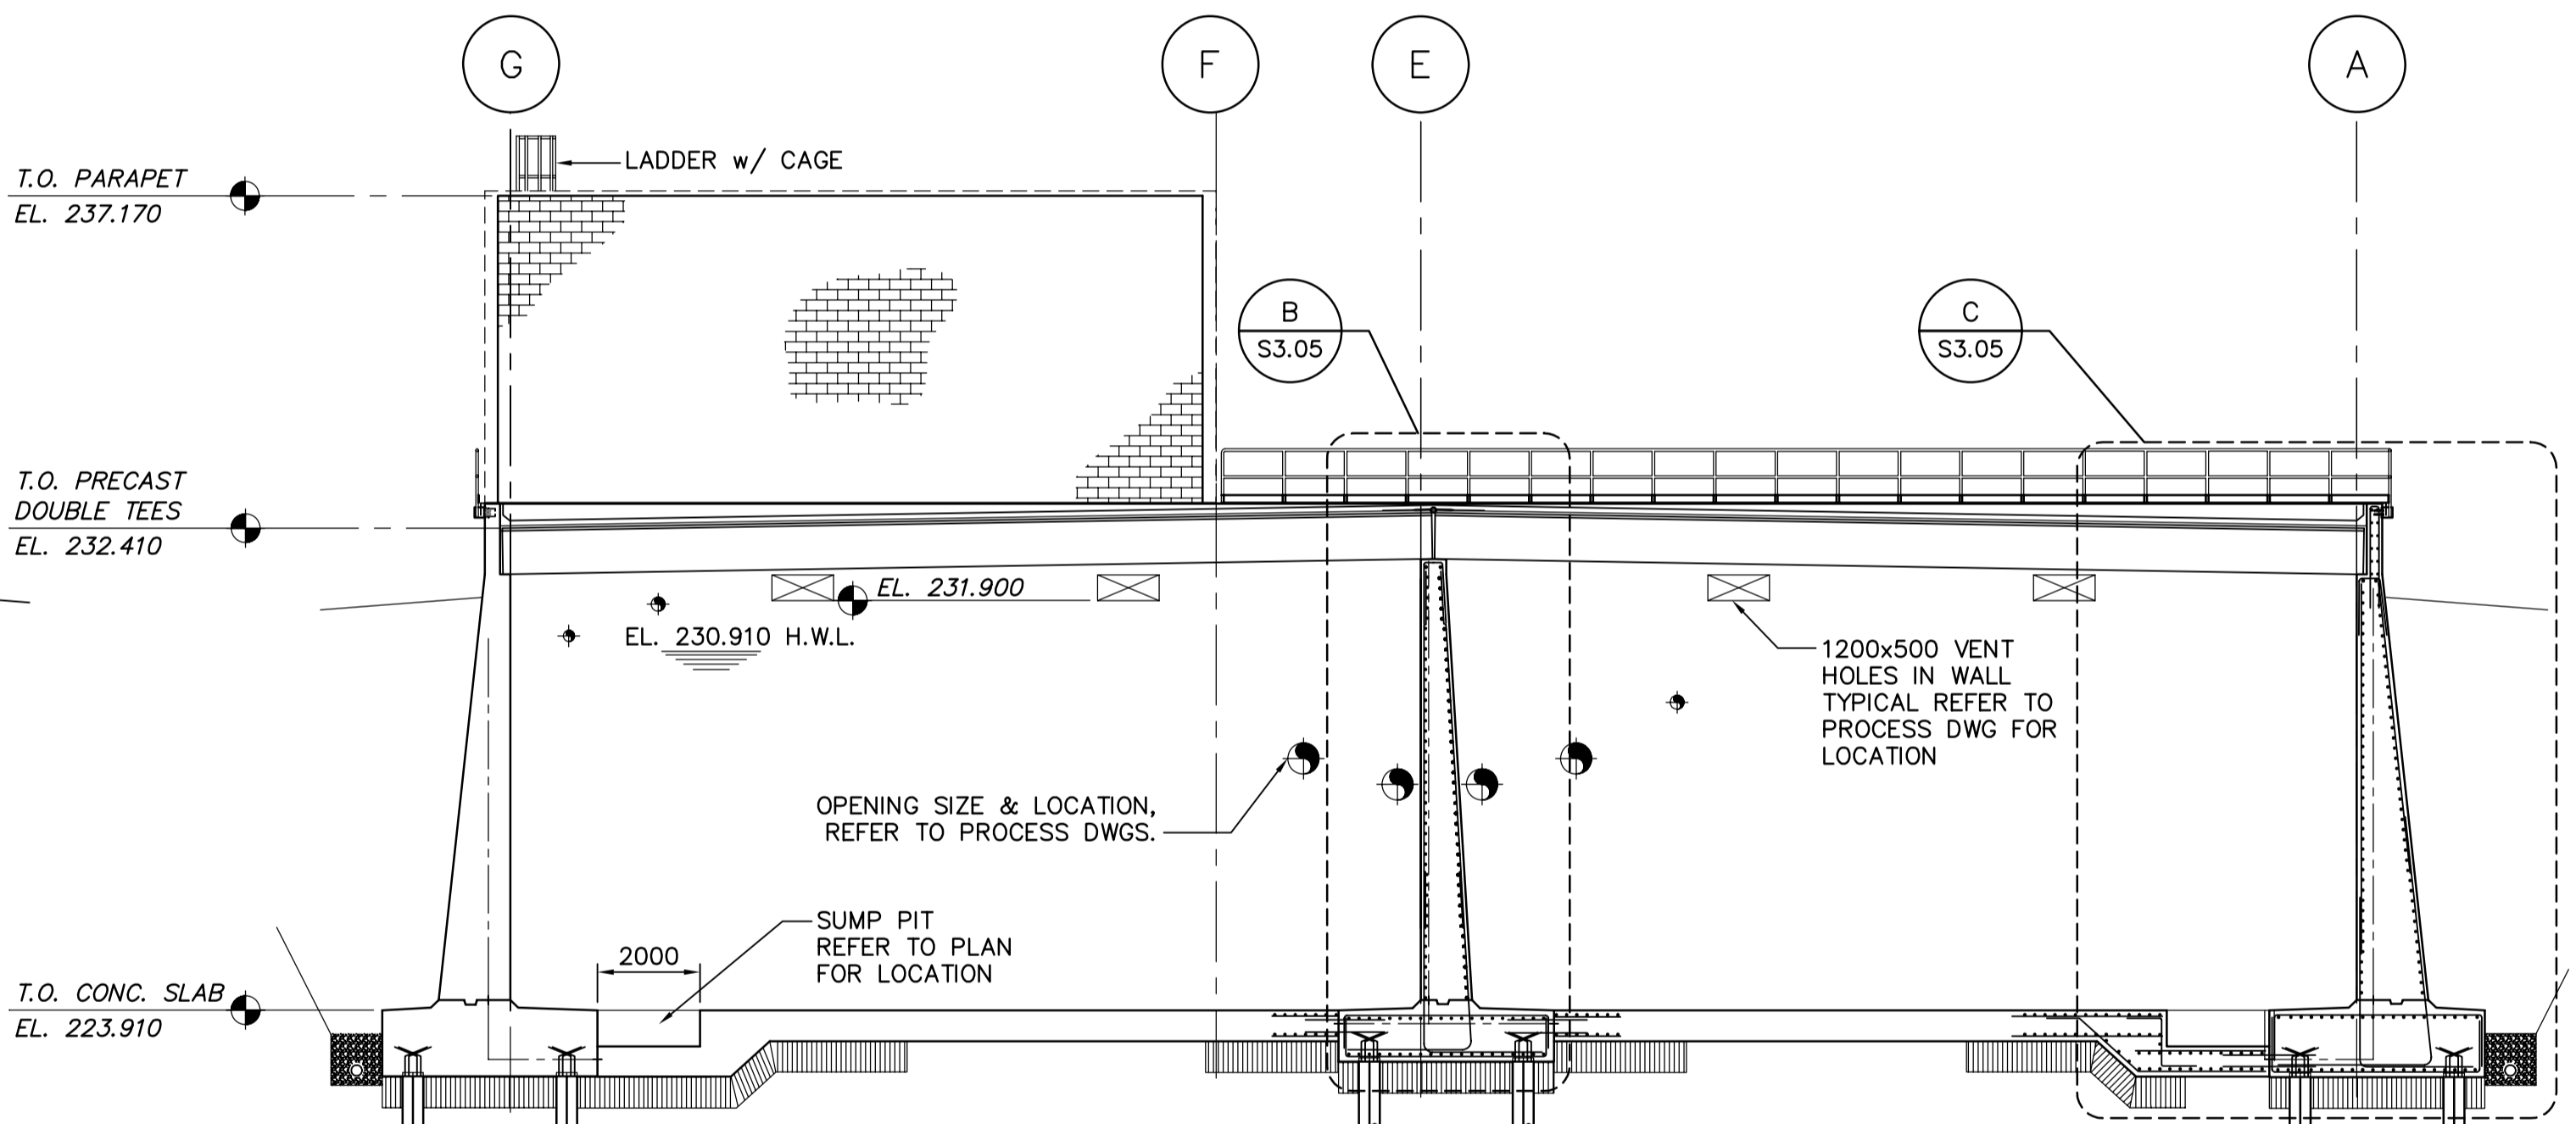


SECTION 3
S1.01, S2.01, S2.02, S2.03, S3.01 SCALE 1:125

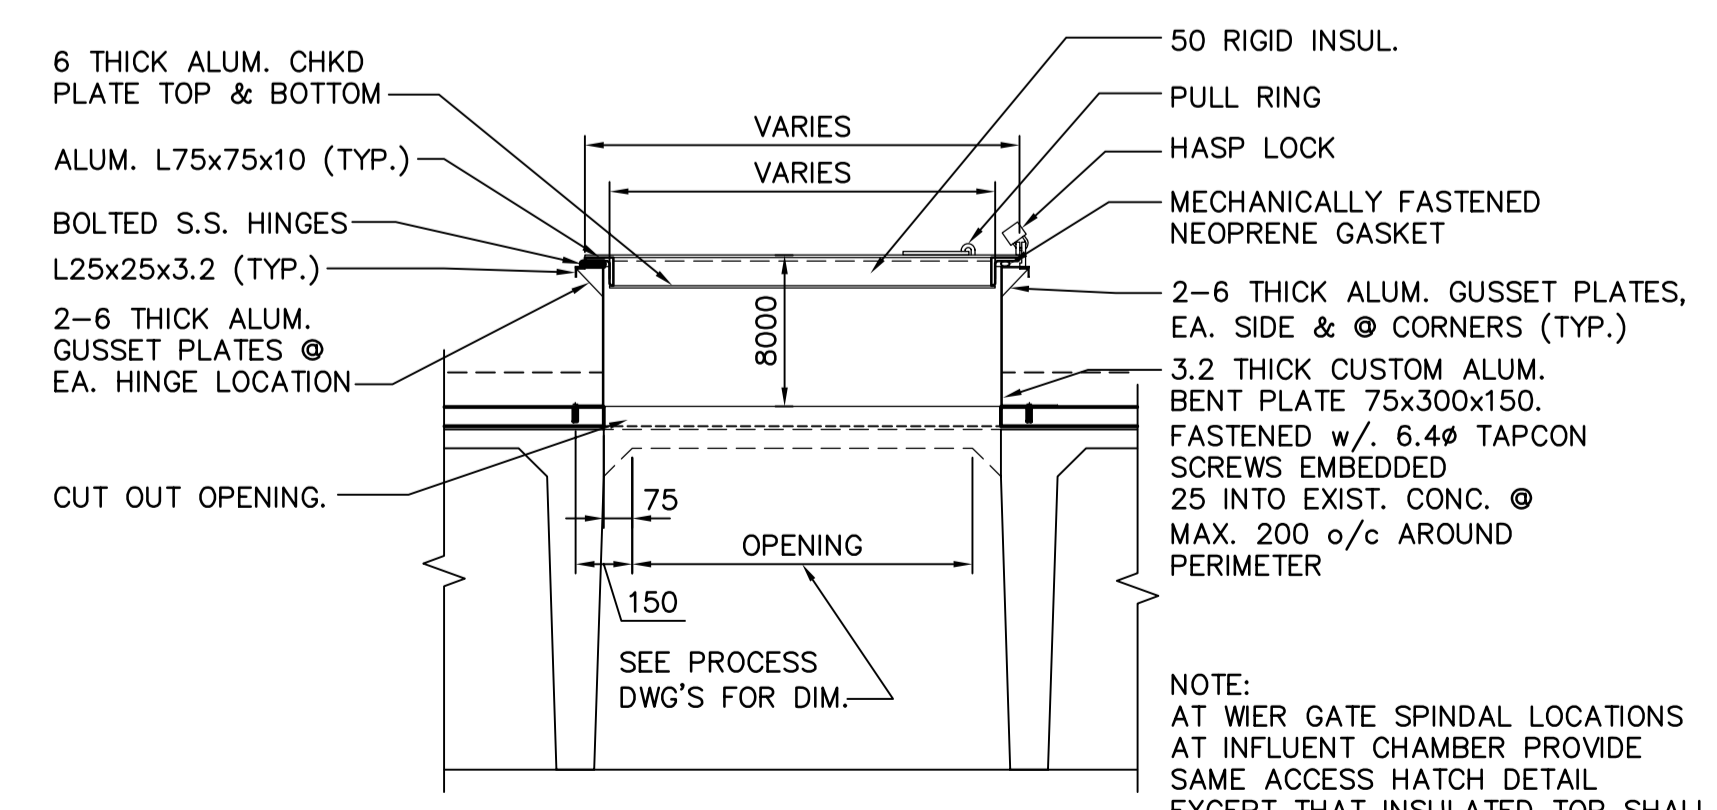

SECTION 4
S2.03 SCALE 1:20

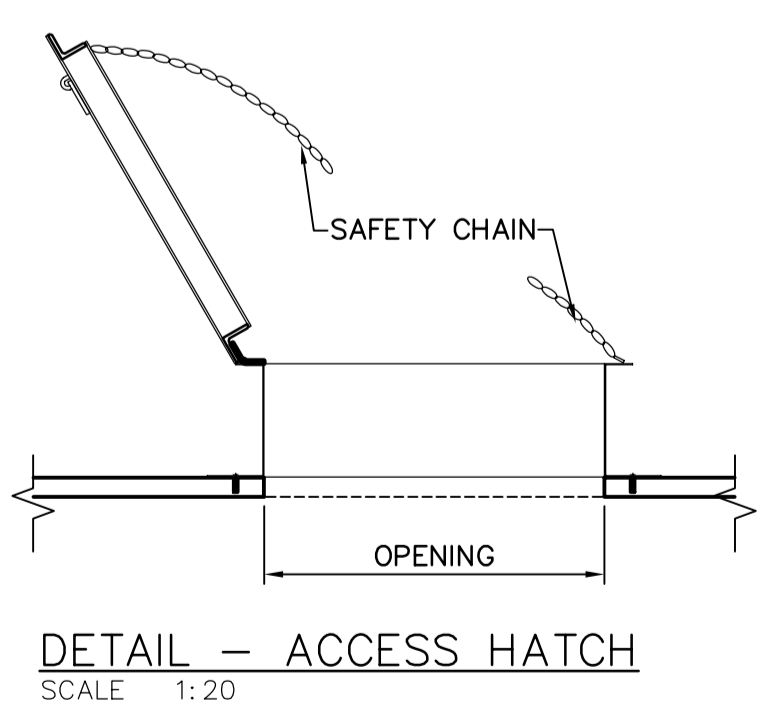

DETAIL - ACCESS HATCH
SCALE 1:20

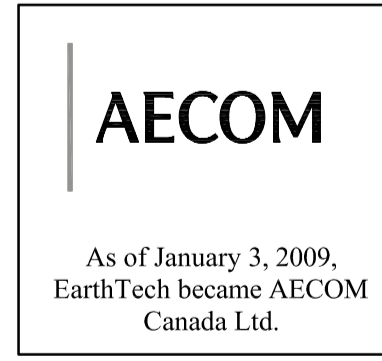


Certificate of Authorization	
AECOM Canada Ltd.	
Original dated on: No. 4671 Date: 2006/05/15	

NO.	REVISIONS	DATE	BY	DATE	2005/11/23
05	AS-CONSTRUCTED DRAWING	09/04/13	GLG		
04	ISSUED FOR FI-0-014	07/07/31	AC		
03	ISSUED FOR FI-001	06/12/07	WDB		
02	ISSUED FOR CONSTRUCTION	06/08/30	GLG		
01	291-2006 ADDENDUM 6	06/07/26	CMF		
00	ISSUED FOR TENDER	06/05/15	WDB		


A Tyco International Ltd. Company	
DESIGNED BY: LLR	CHECKED BY: GGP
DRAWN BY: WDB	APPROVED BY: JEH
SCALE: AS NOTED	RELEASED FOR CONSTRUCTION BY: K. MARTENS
DATE: 2005/11/23	DATE: 2006/05/15

ENGINEER'S SEAL
ORIGINAL SIGNED BY: L.L. RIDING
DATE: 2006/05/15
CONSULTANT DRAWING NO. S3.02


THE CITY OF WINNIPEG WATER AND WASTE DEPARTMENT ENGINEERING DIVISION	
NEWPCC CENTRATE NUTRIENT TREATMENT NITROGEN REMOVAL FACILITY	
CITY FILE NUMBER	
SHEET OF	
CITY DRAWING NUMBER	1-0101C-S0010-001-05
STRUCTURAL SBR BUILDING BUILDING SECTIONS	

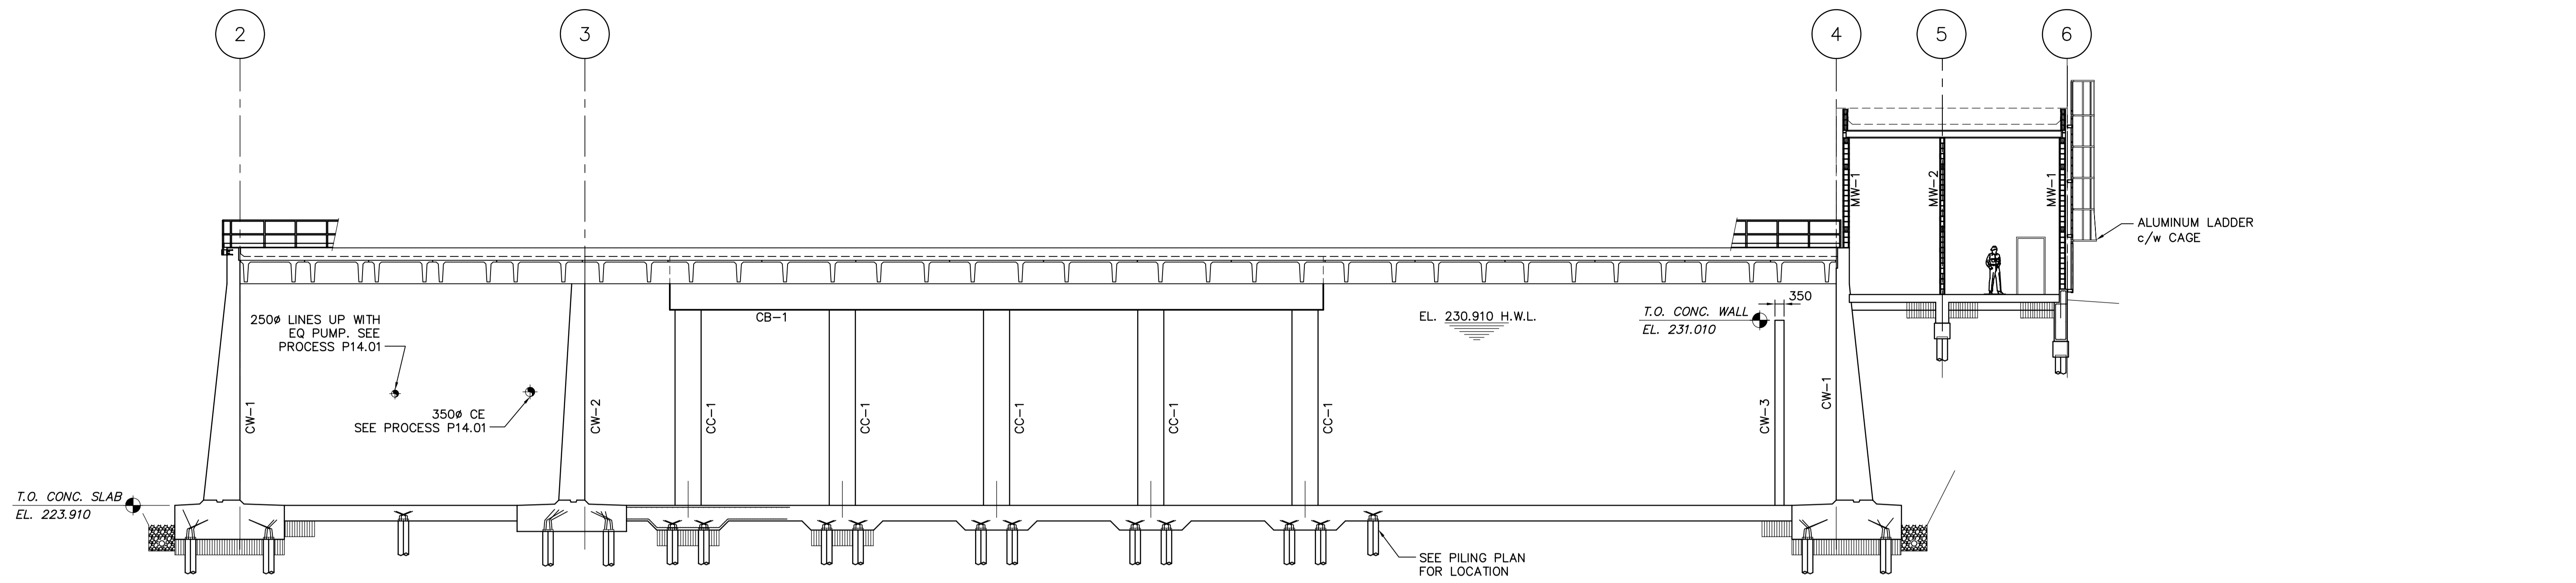


1 SECTION
S2.01, S2.02, S2.03, S3.01 SCALE 1:125

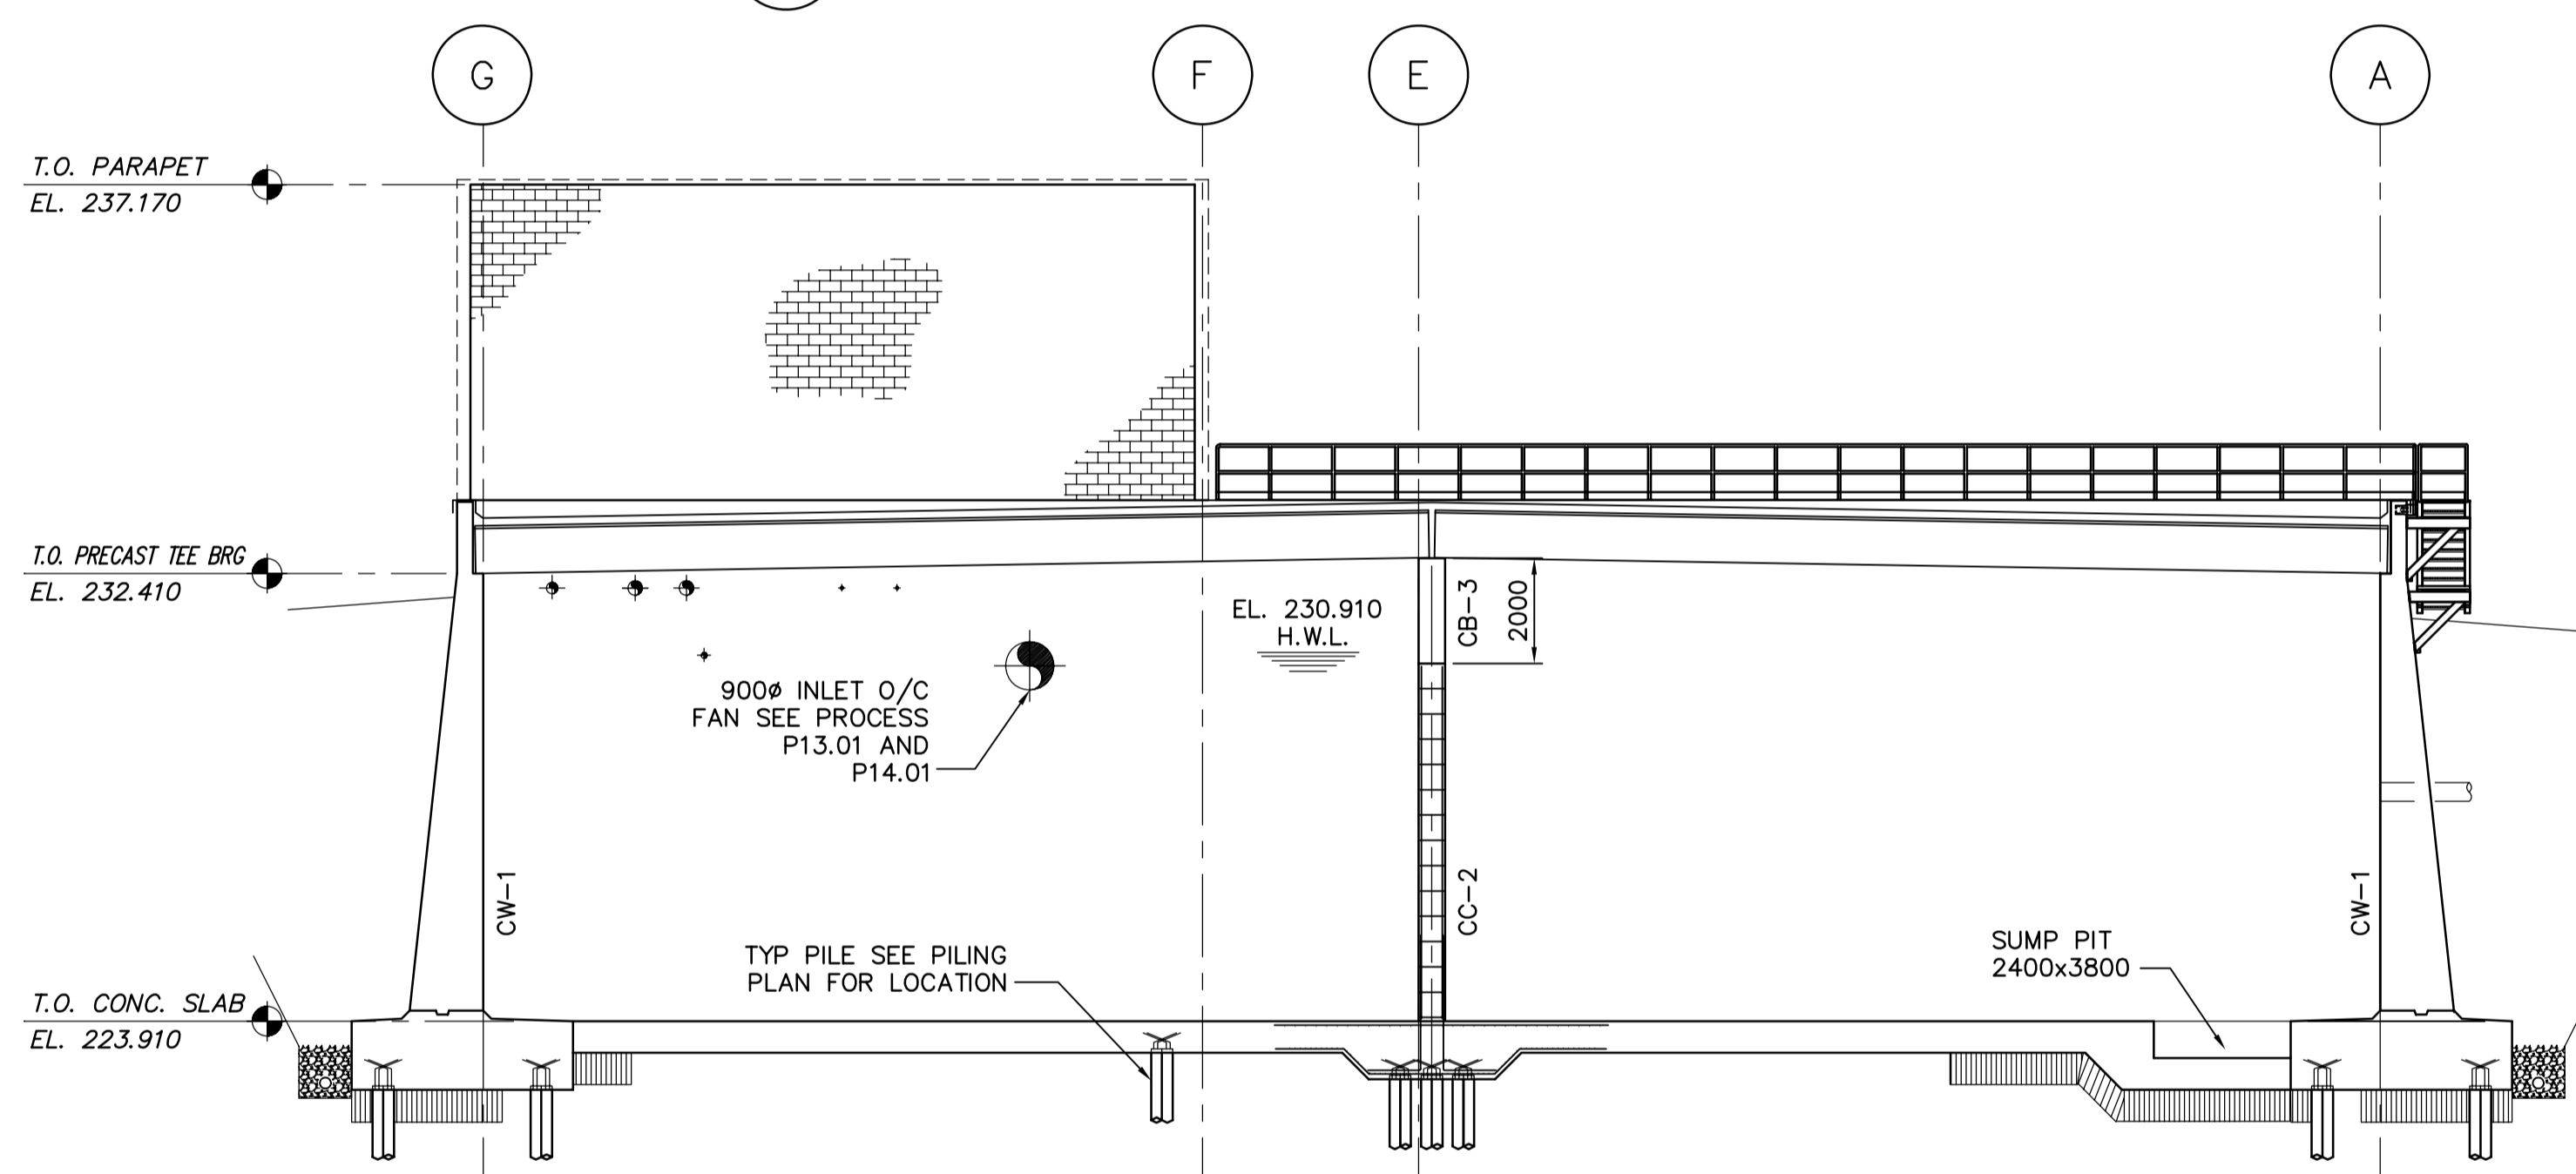


2 SECTION
S2.01, S2.02, S2.03, S3.01 SCALE 1:125

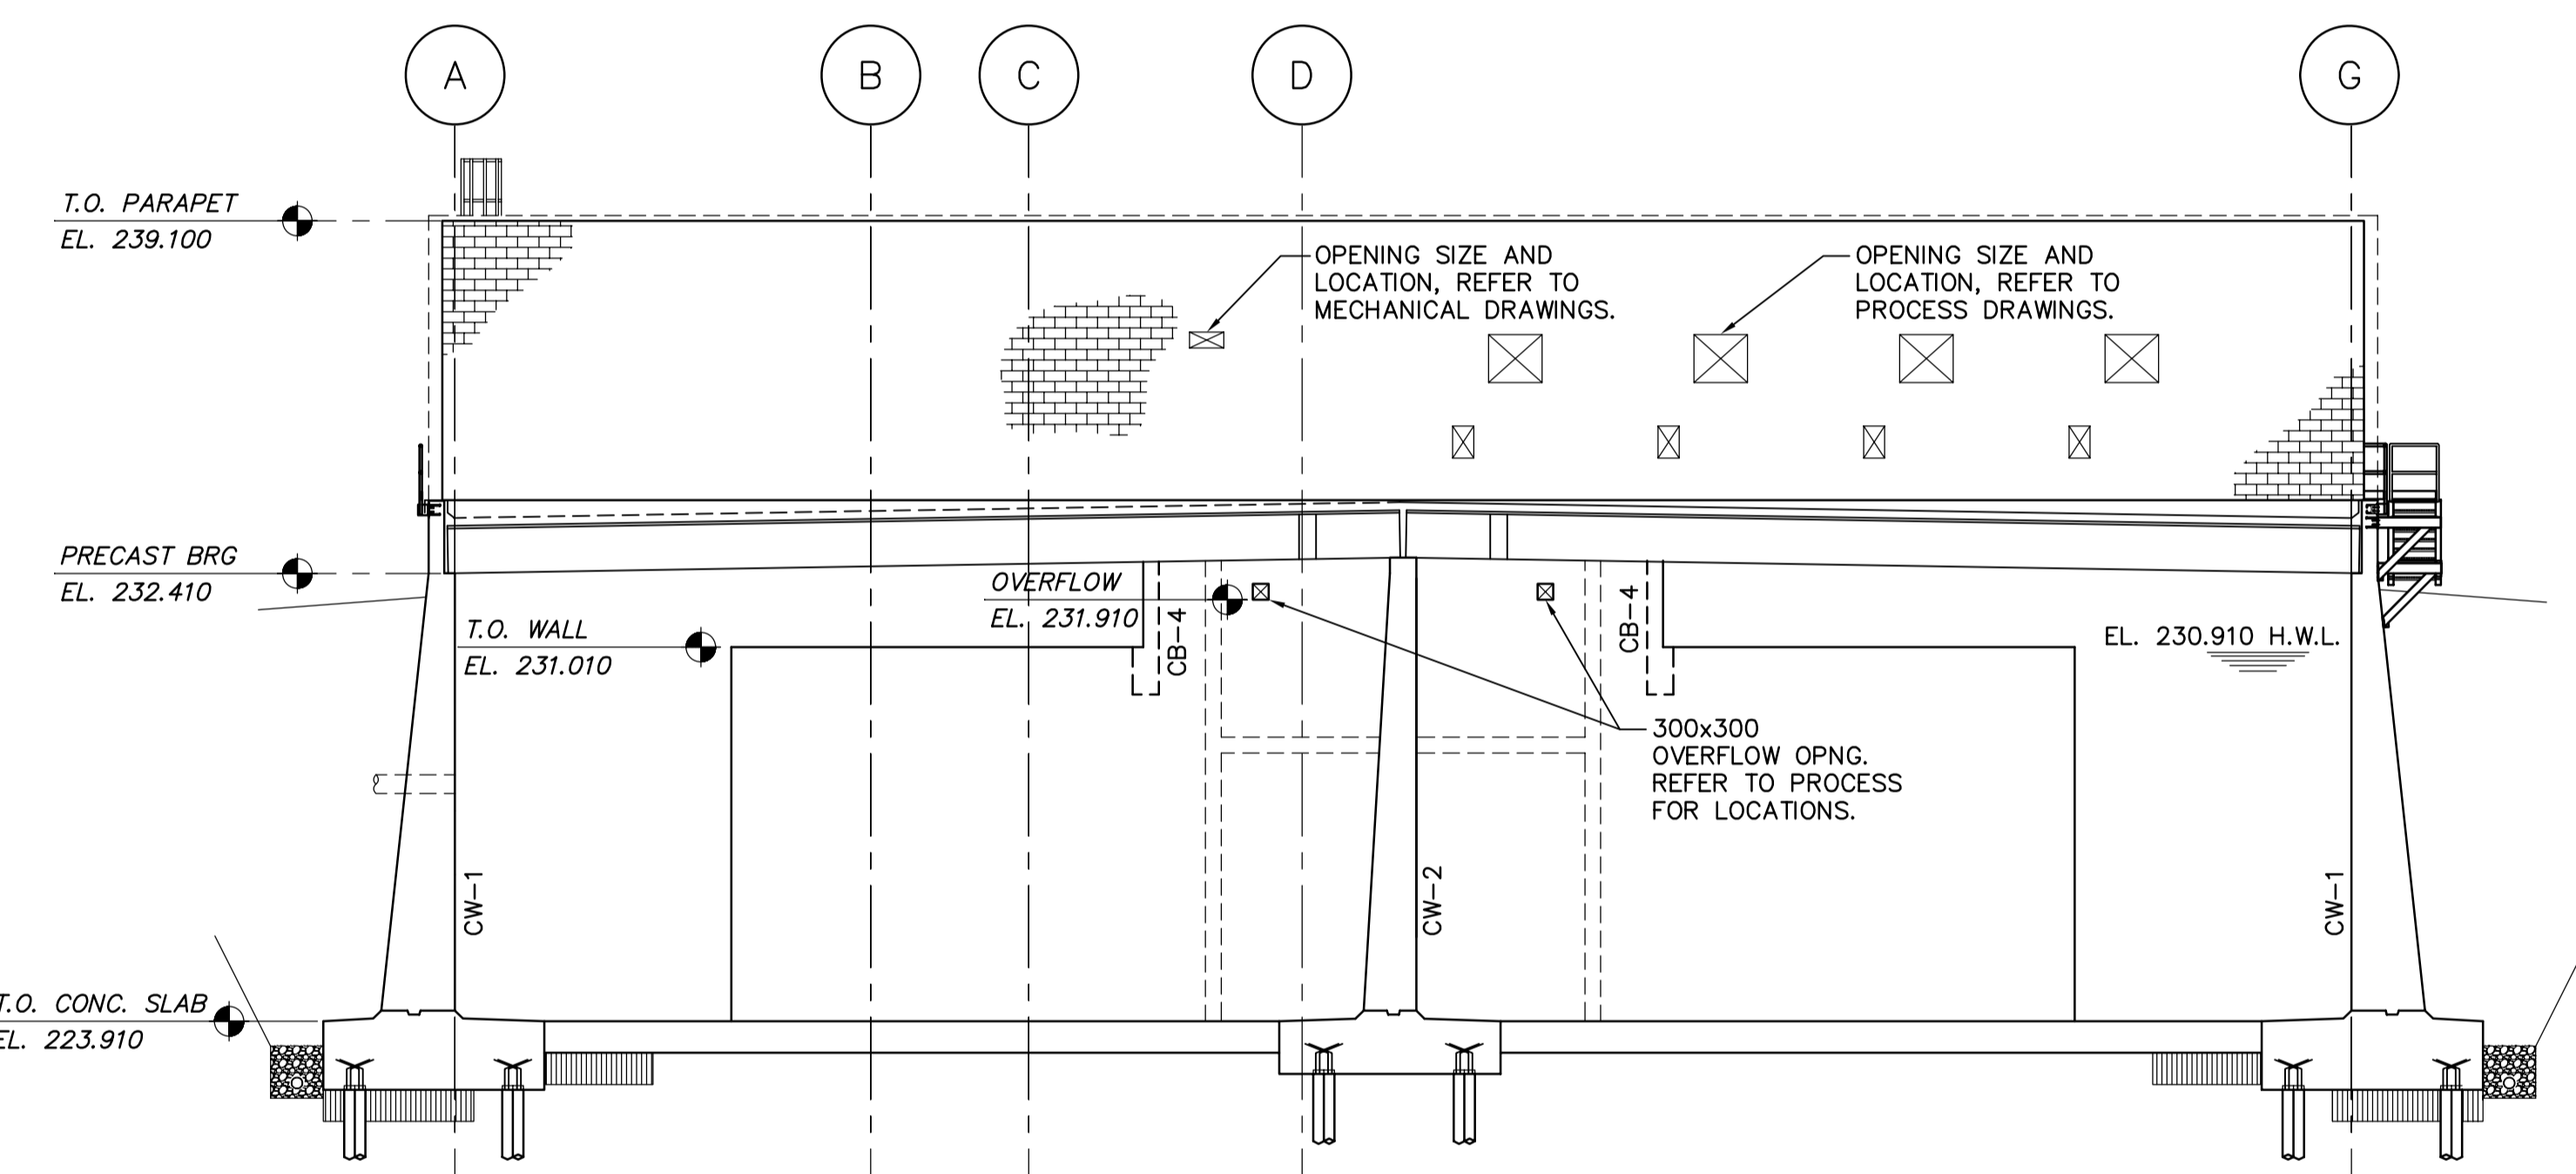

3 SECTION
S2.01, S2.02, S3.01 SCALE 1:125

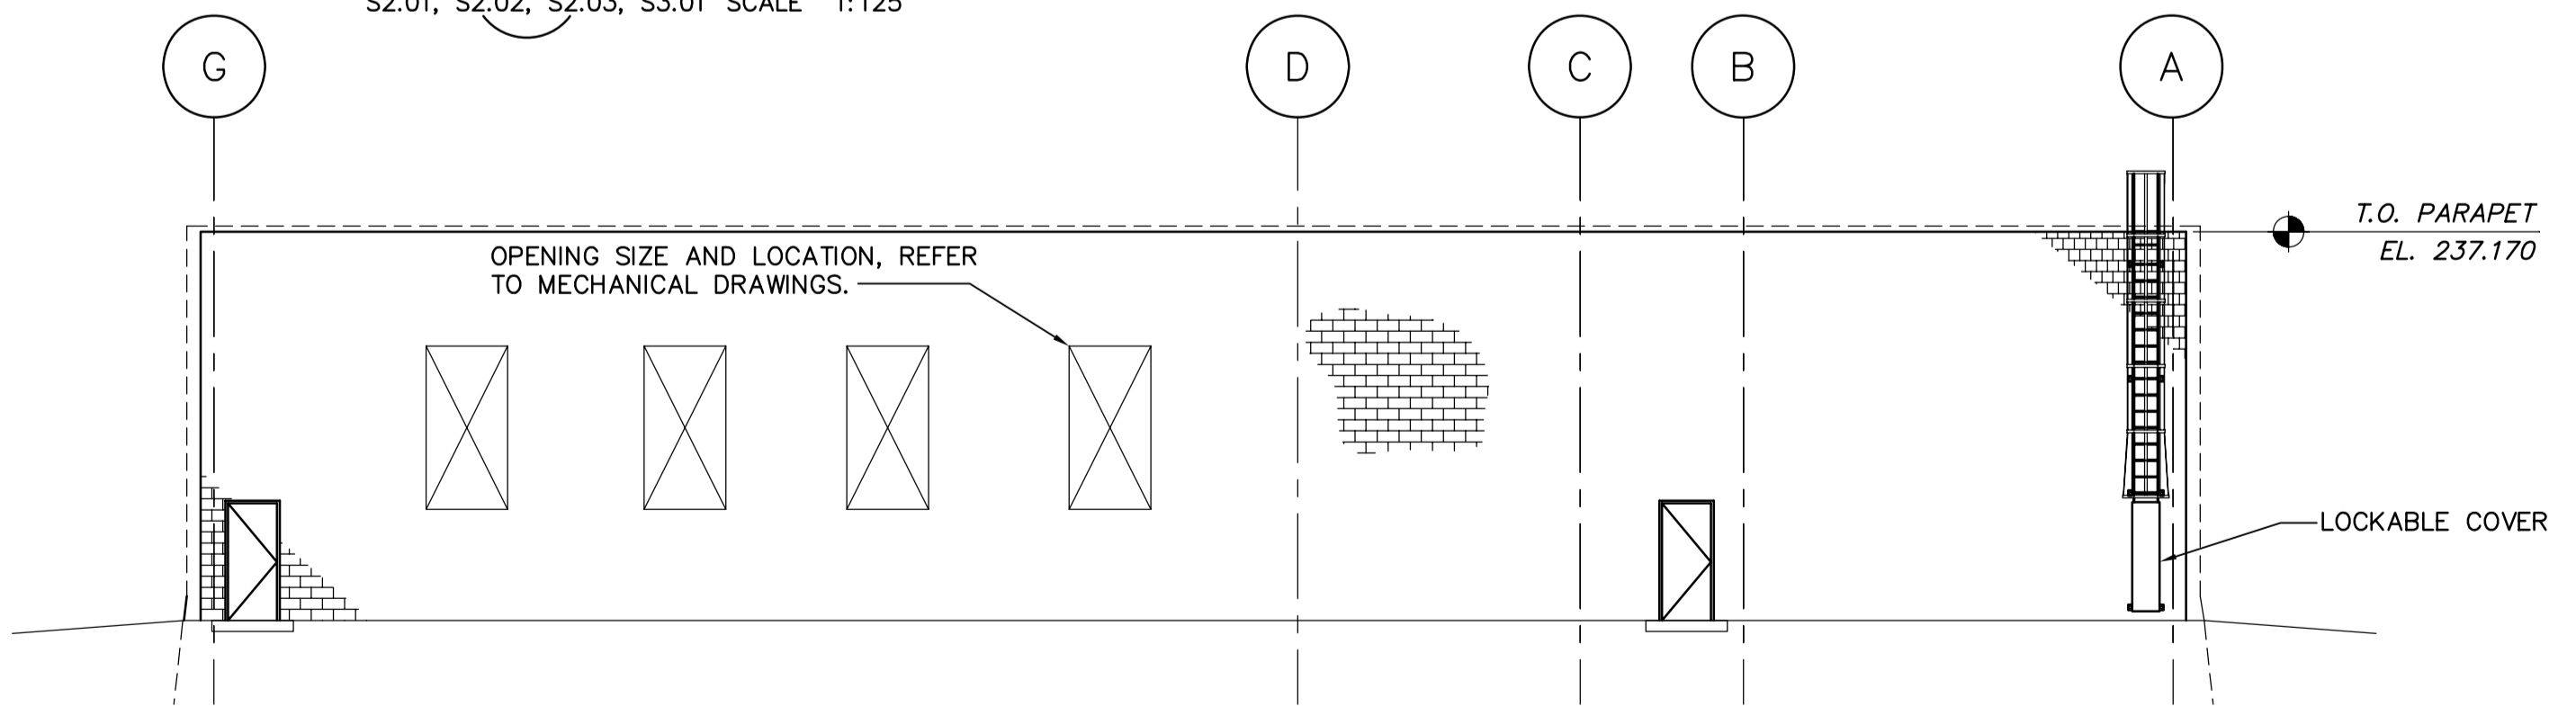

4 WALL ELEVATION
S2.03 SCALE 1:125

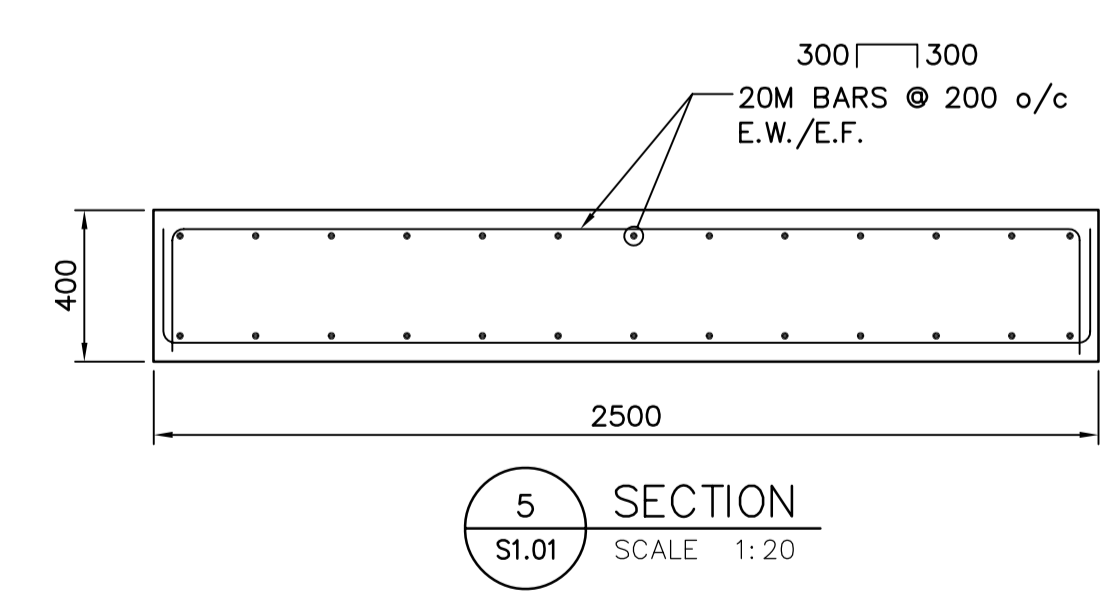

5 SECTION
S1.01 SCALE 1:20



AECOM AS-CONSTRUCTED
SIG..... DATE.....

APECM
Certificate of Authorization
AECOM Canada Ltd.
Original dated on:
No. 4671 Date: 2006/05/15

NO.	REVISIONS	DATE	BY
03	AS-CONSTRUCTED DRAWING	09/04/13	GLG
02	ISSUED FOR FI-001	06/12/07	WDB
01	ISSUED FOR CONSTRUCTION	06/08/30	GLG
00	ISSUED FOR TENDER	06/05/15	WDB

EarthTech A Tyco International Ltd. Company	
DESIGNED BY: LLR	CHECKED BY: GGP
DRAWN BY: WDB	APPROVED BY: JEH
SCALE: AS NOTED	RELEASED FOR CONSTRUCTION BY: K. MARTENS
DATE: 2005/11/24	DATE: 2006/05/15








ENGINEER'S SEAL
ORIGINAL SIGNED BY
L.L. RIDING
2006/05/15
CONSULTANT DRAWING NO.
S3.03

THE CITY OF WINNIPEG
Winnipeg WATER AND WASTE DEPARTMENT
ENGINEERING DIVISION

NEWPCC CENTRATE NUTRIENT TREATMENT NITROGEN REMOVAL FACILITY

STRUCTURAL
SBR BUILDING
BUILDING SECTIONS & ELEVATION SHEET 1

CITY FILE NUMBER
SHEET OF
CITY DRAWING NUMBER
1-0101C-S0011-001-03

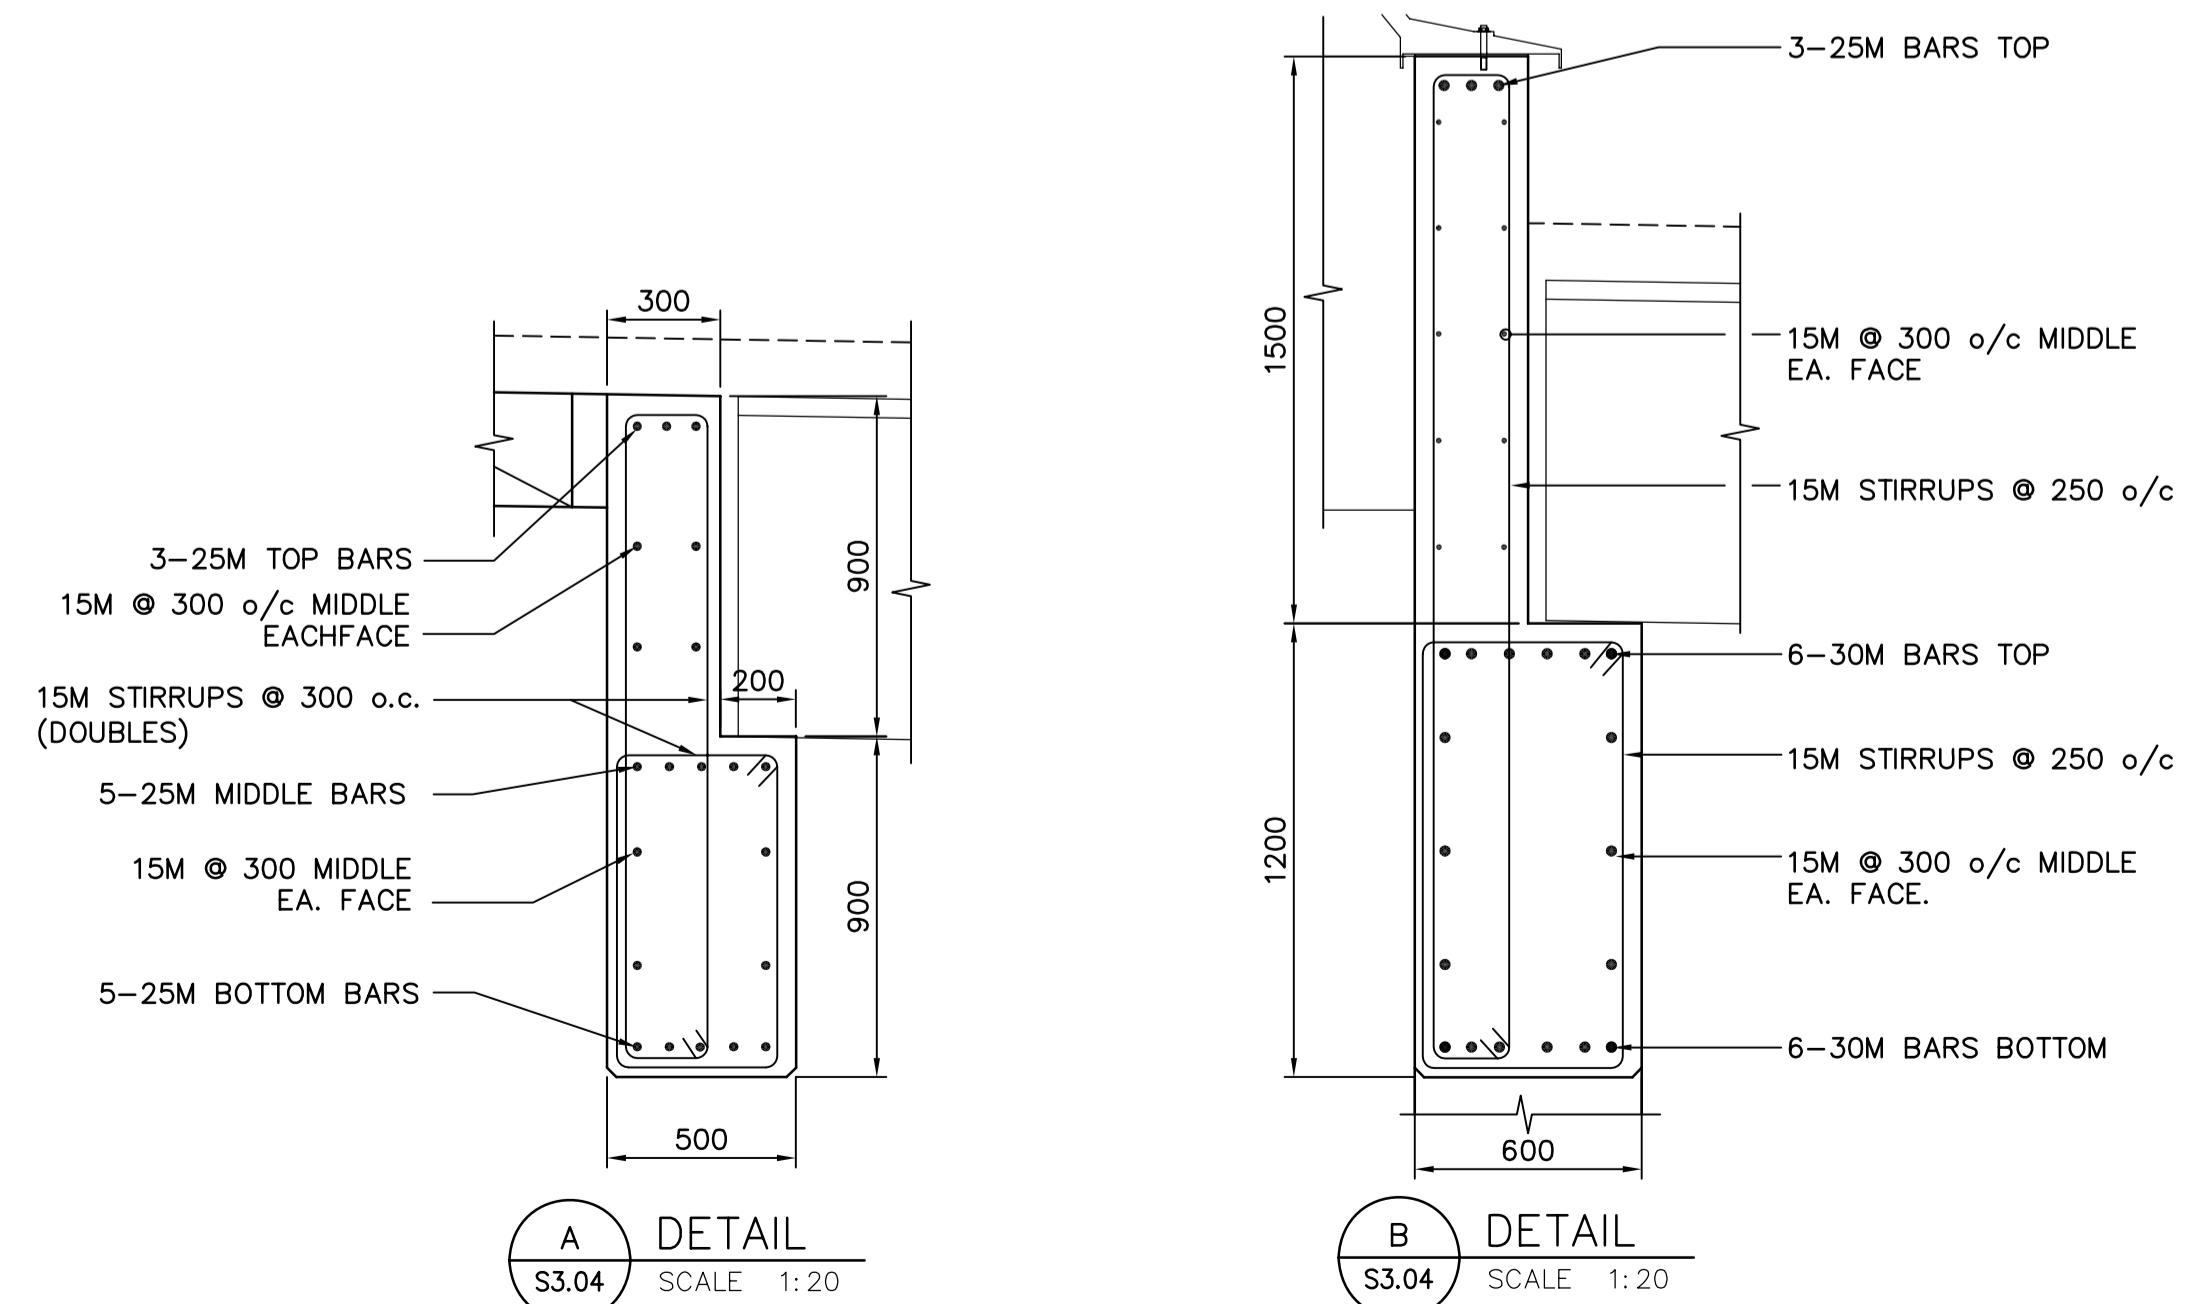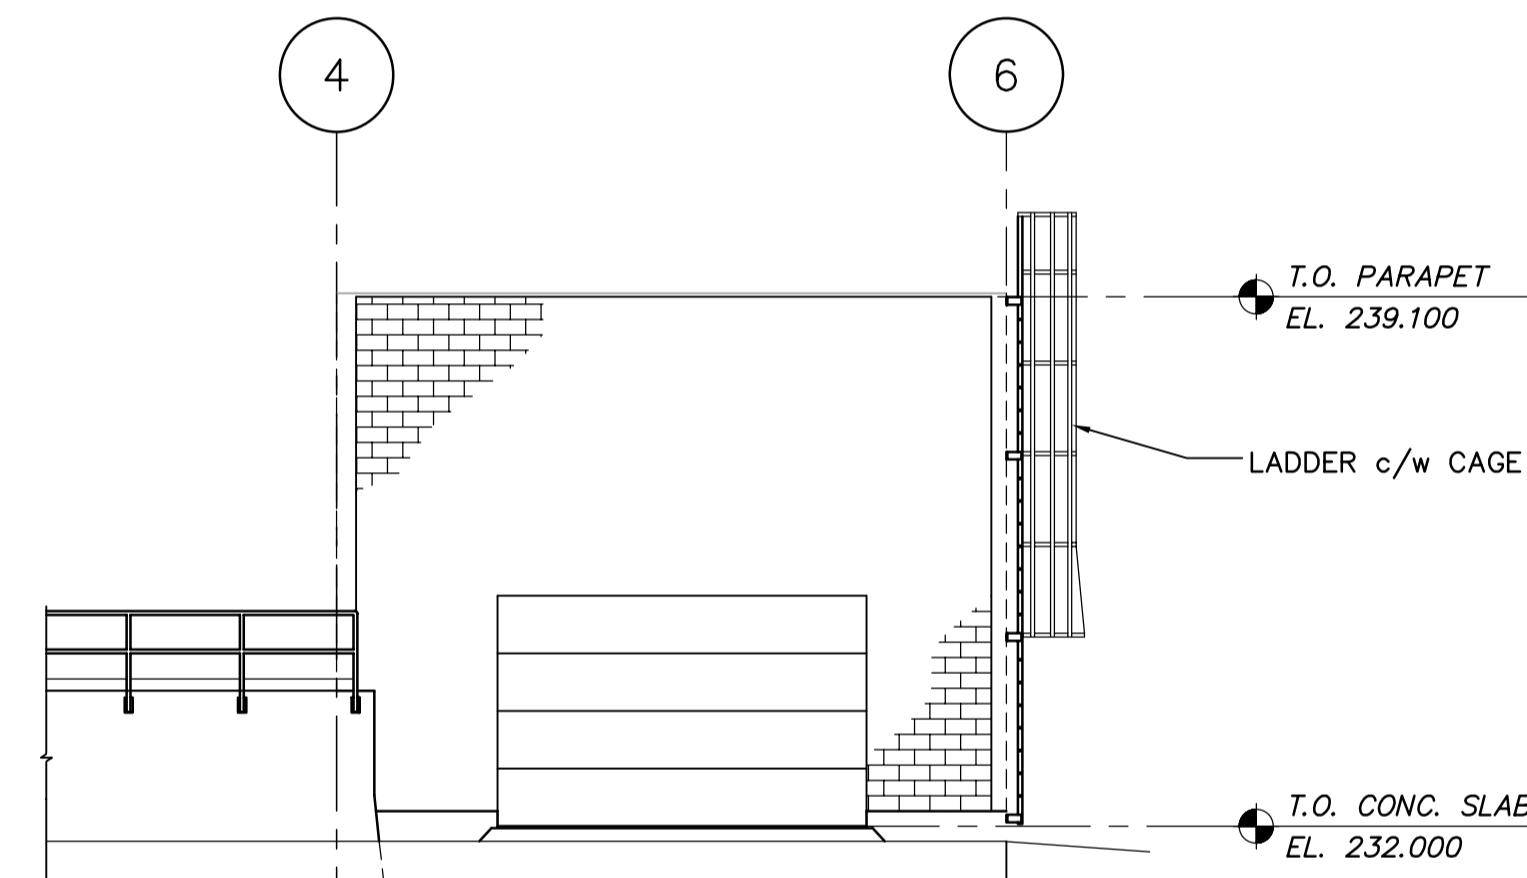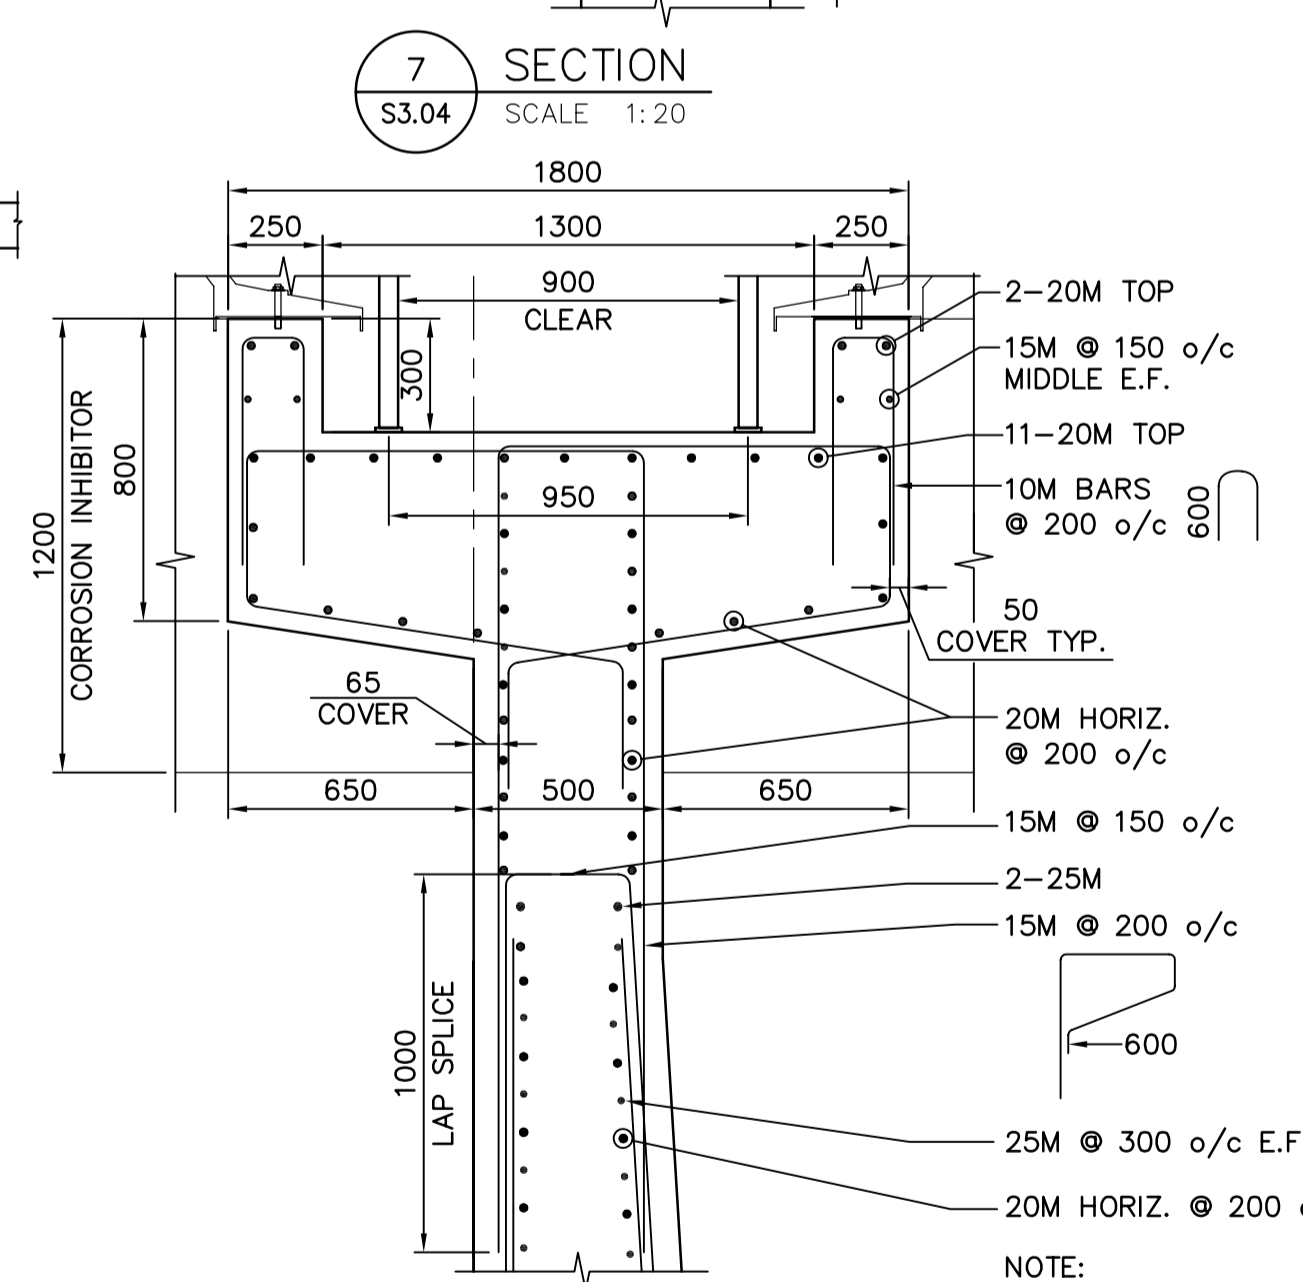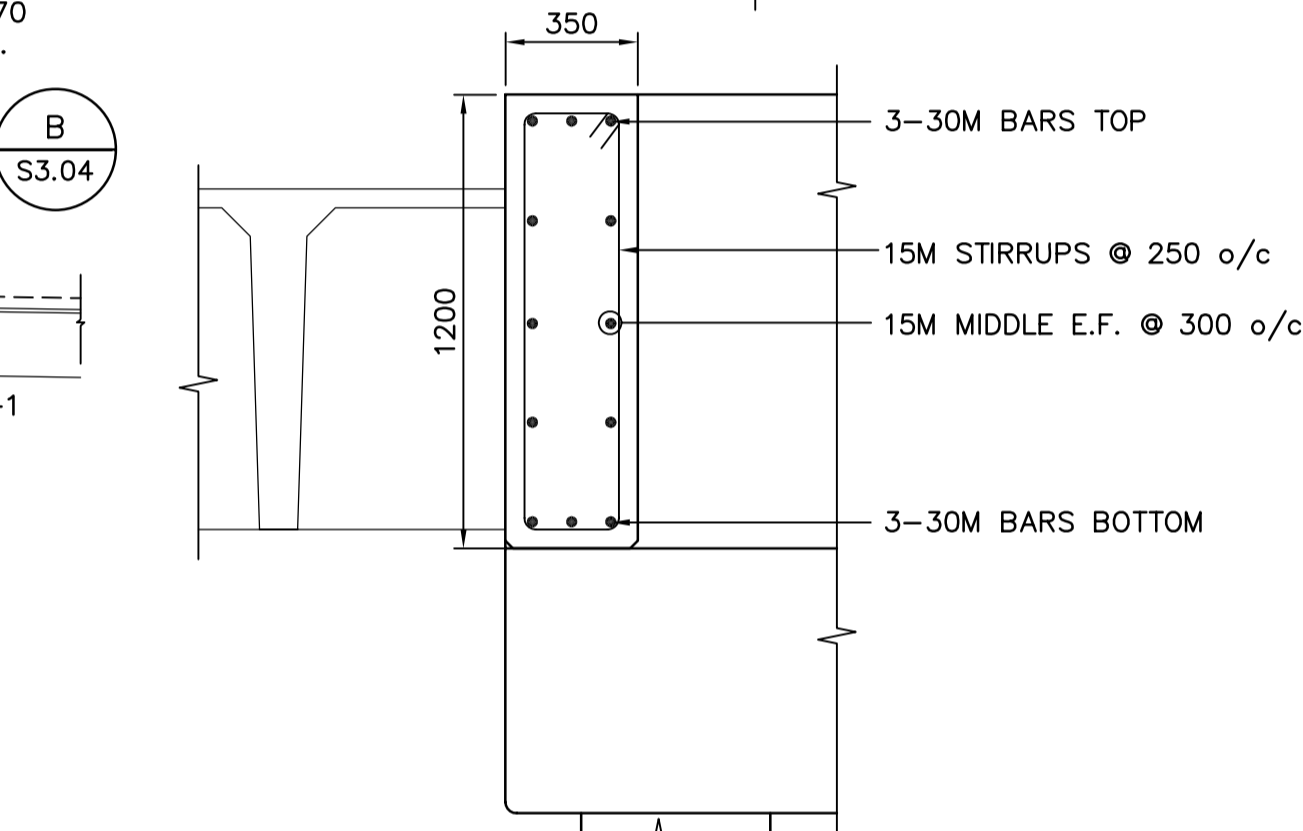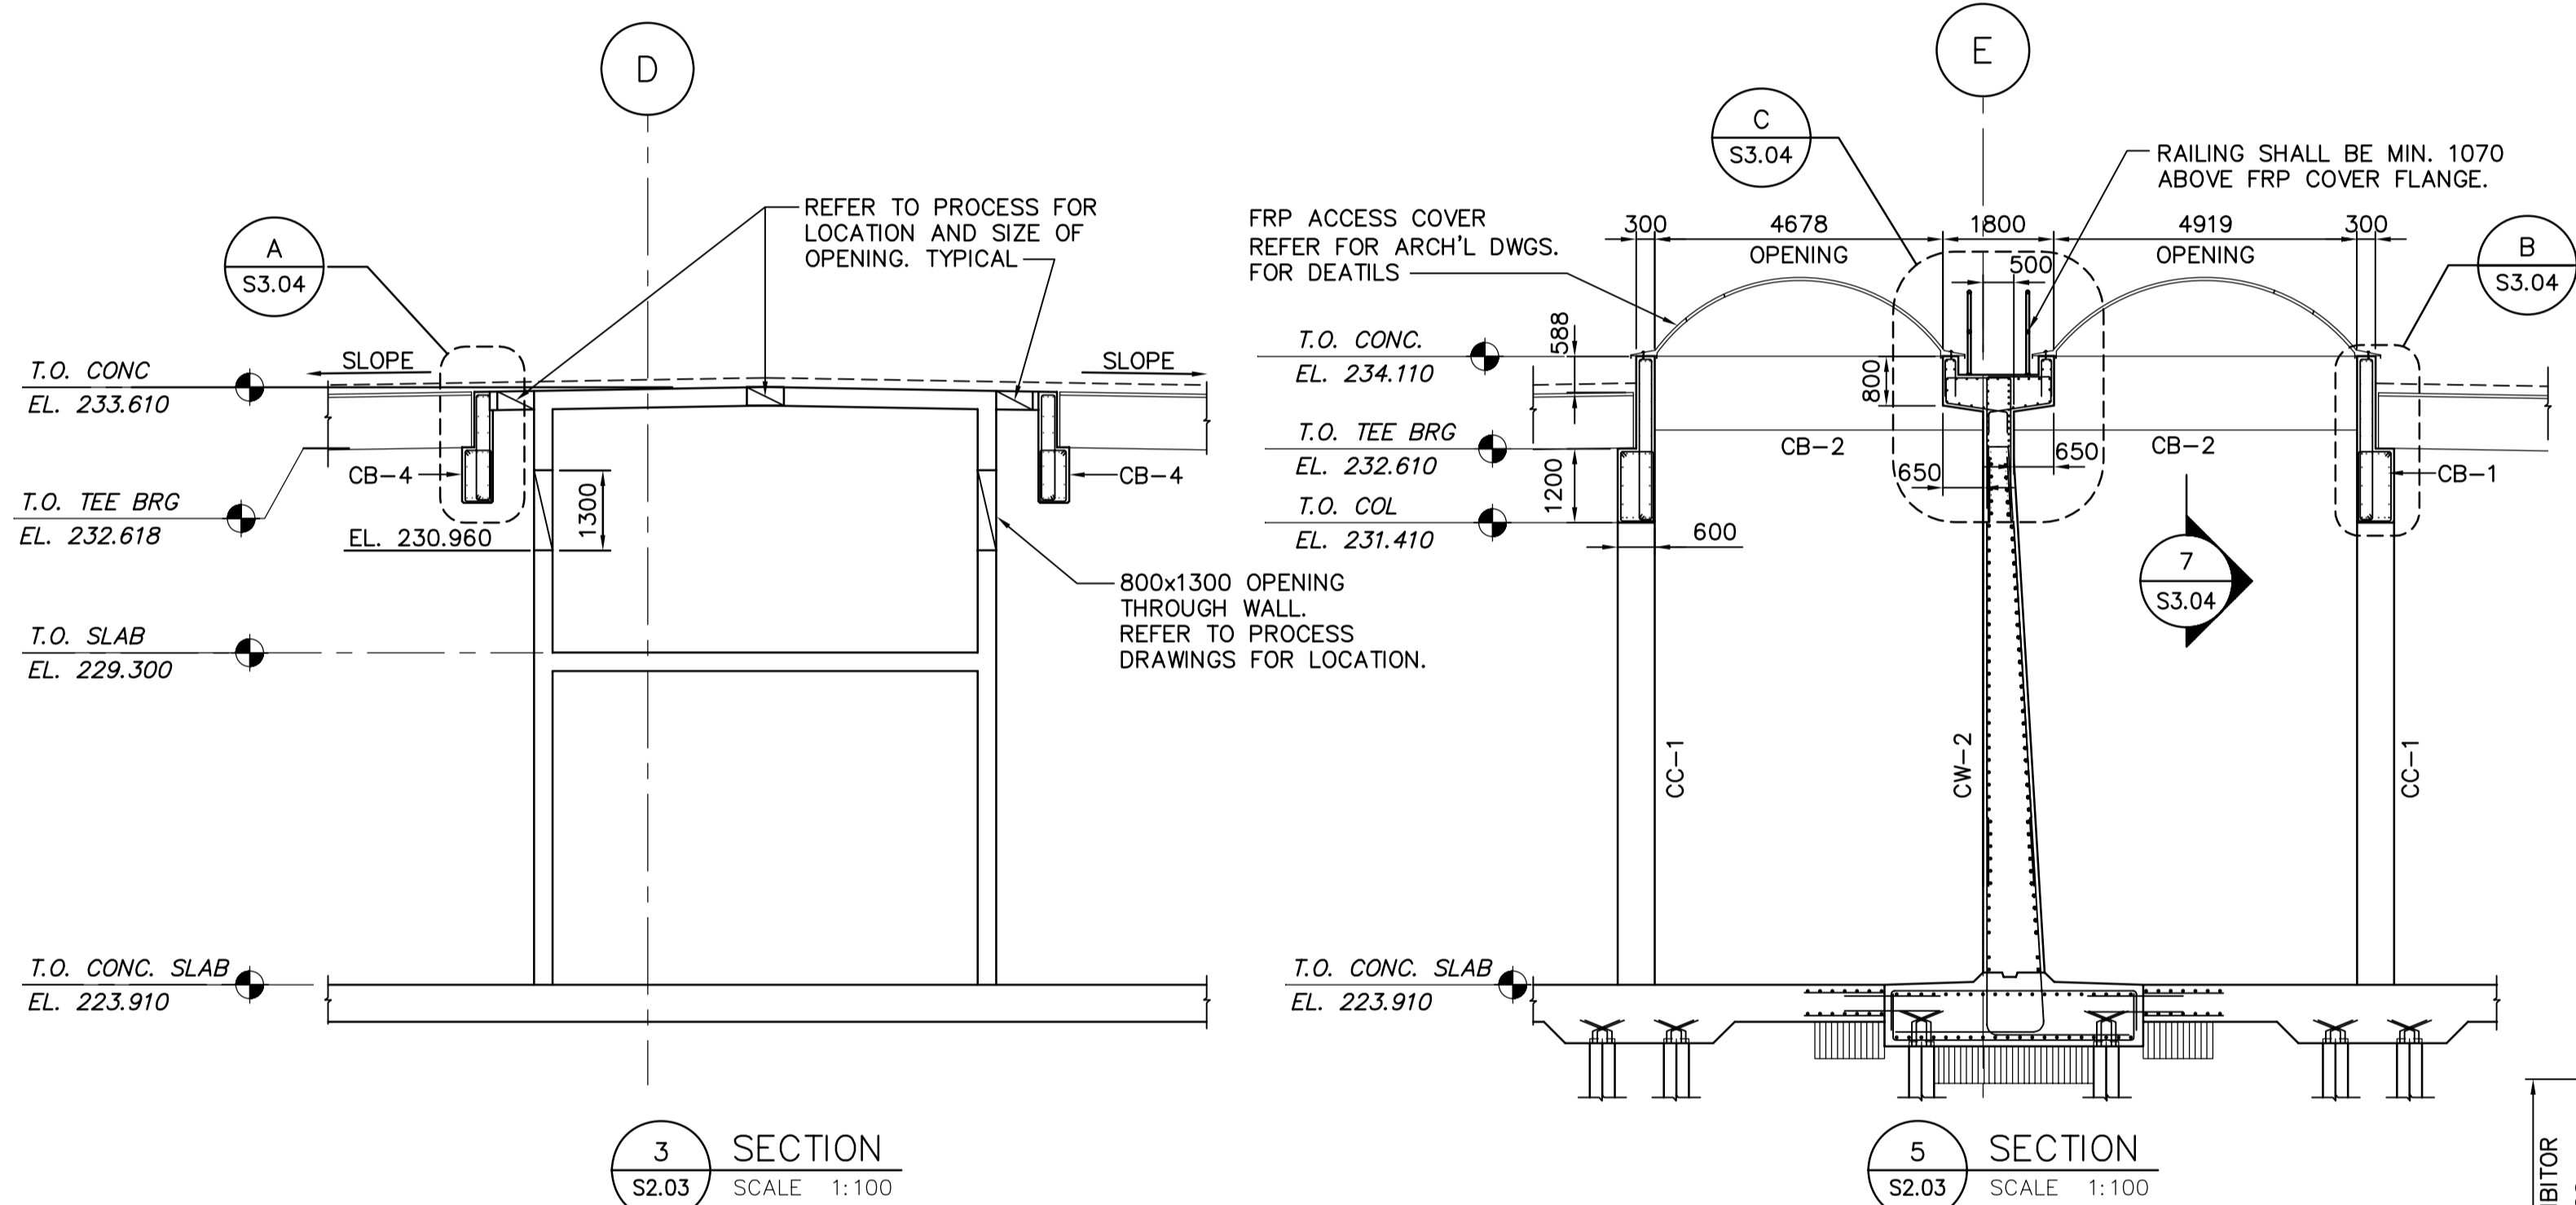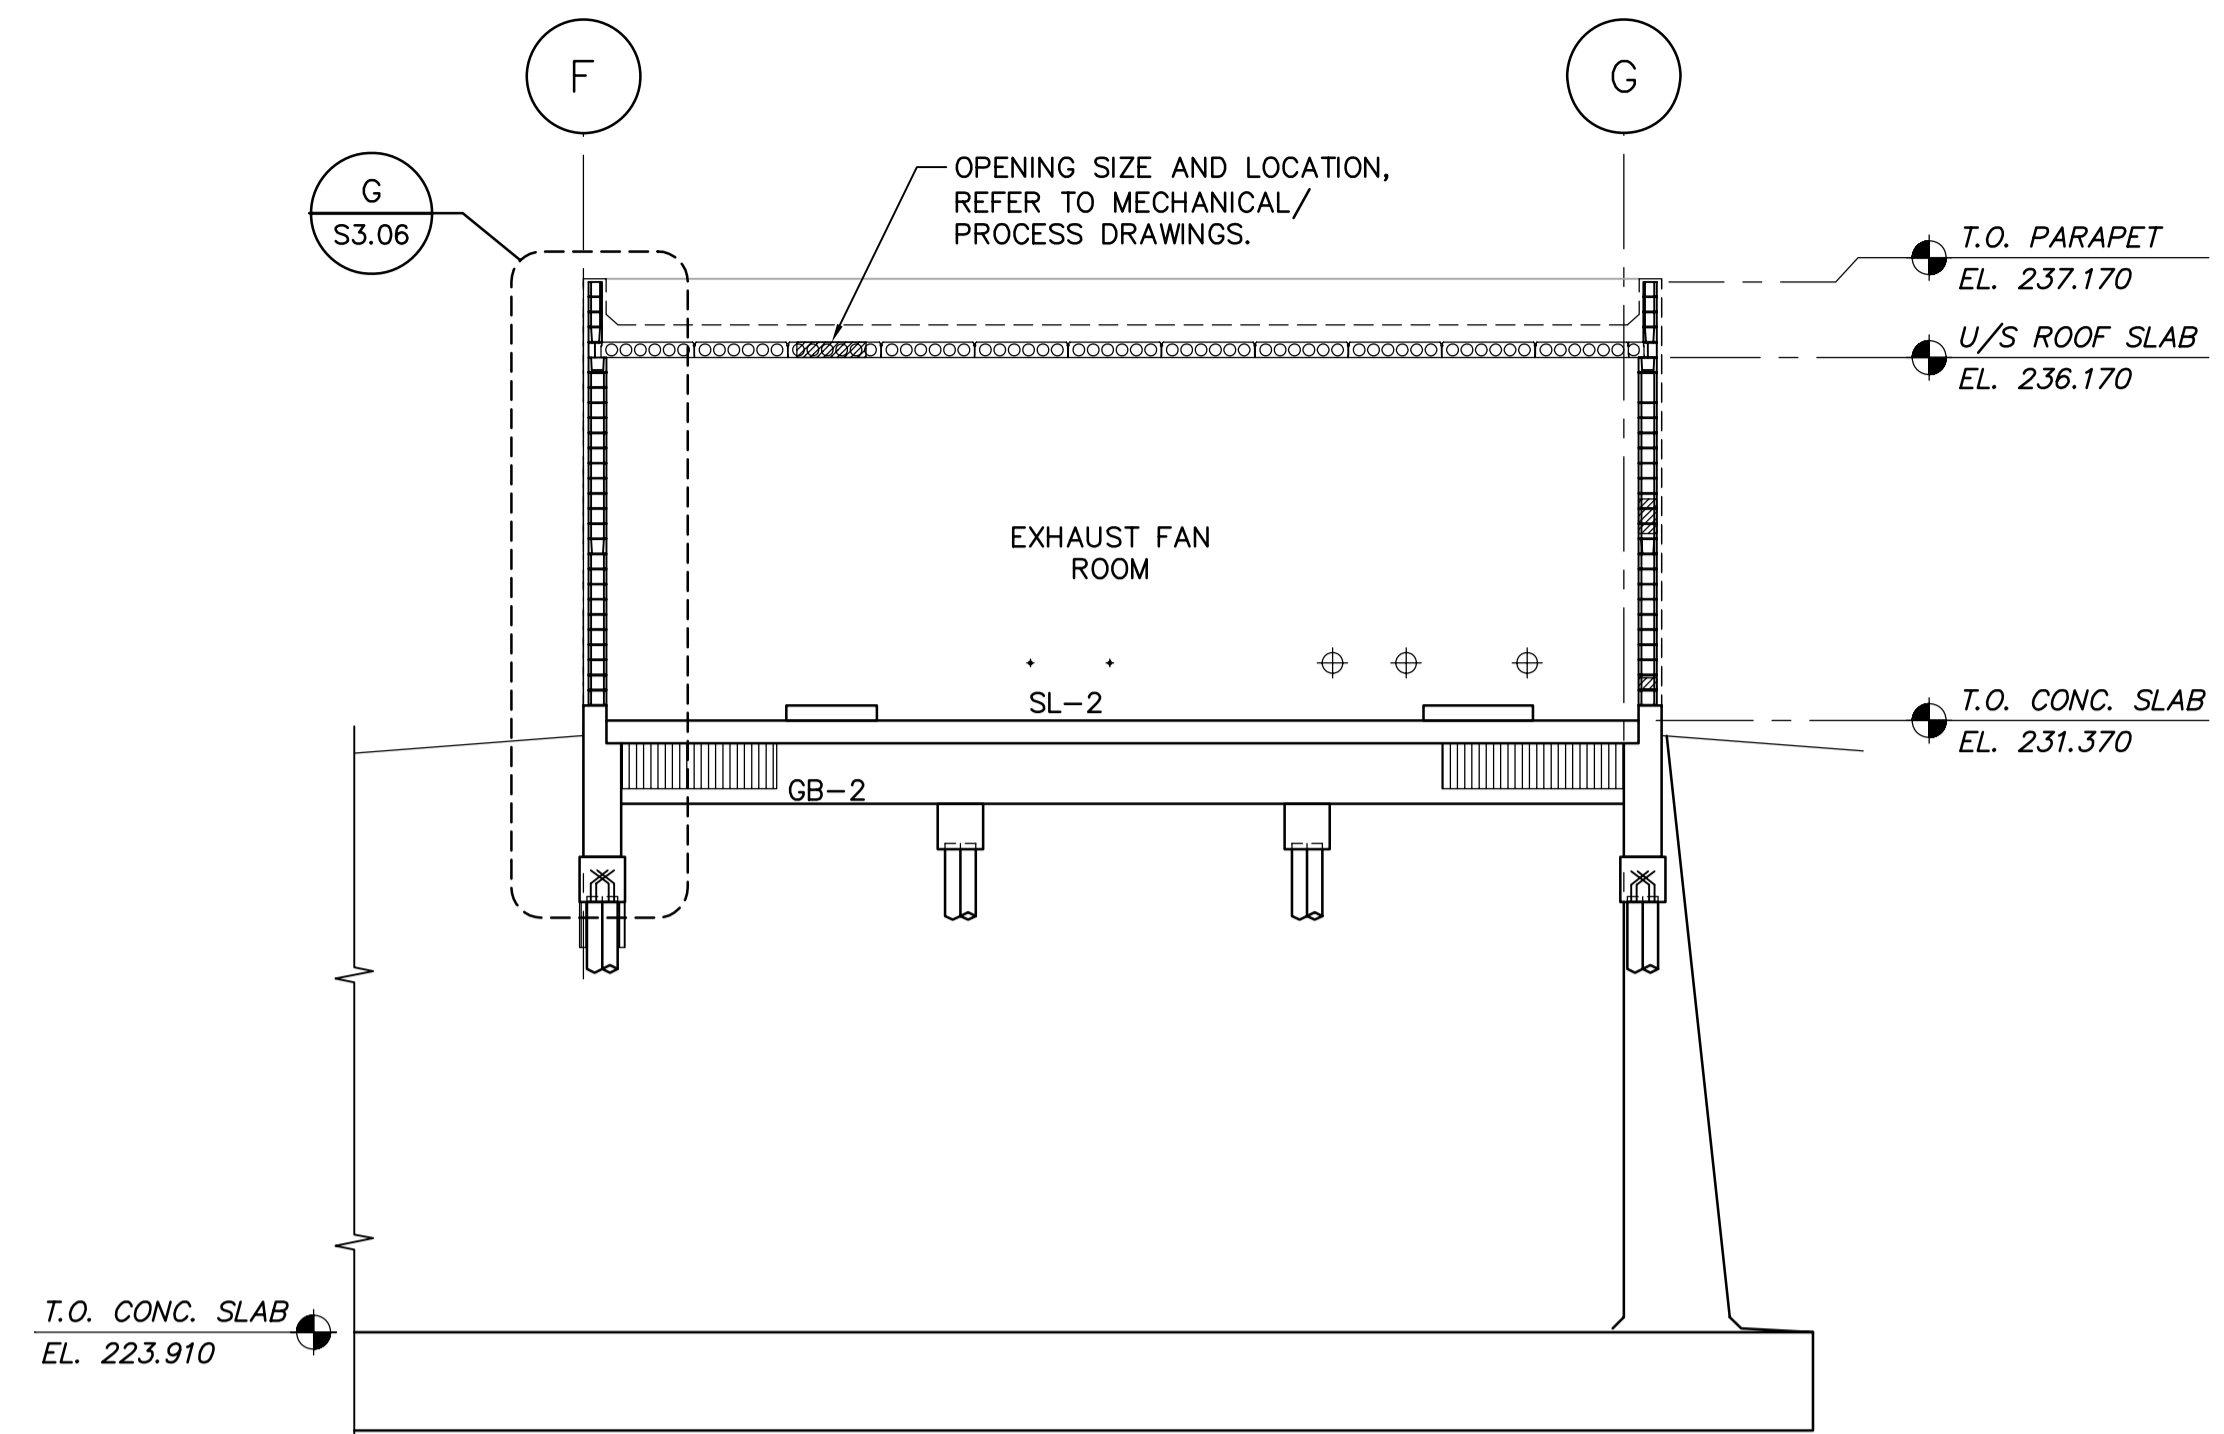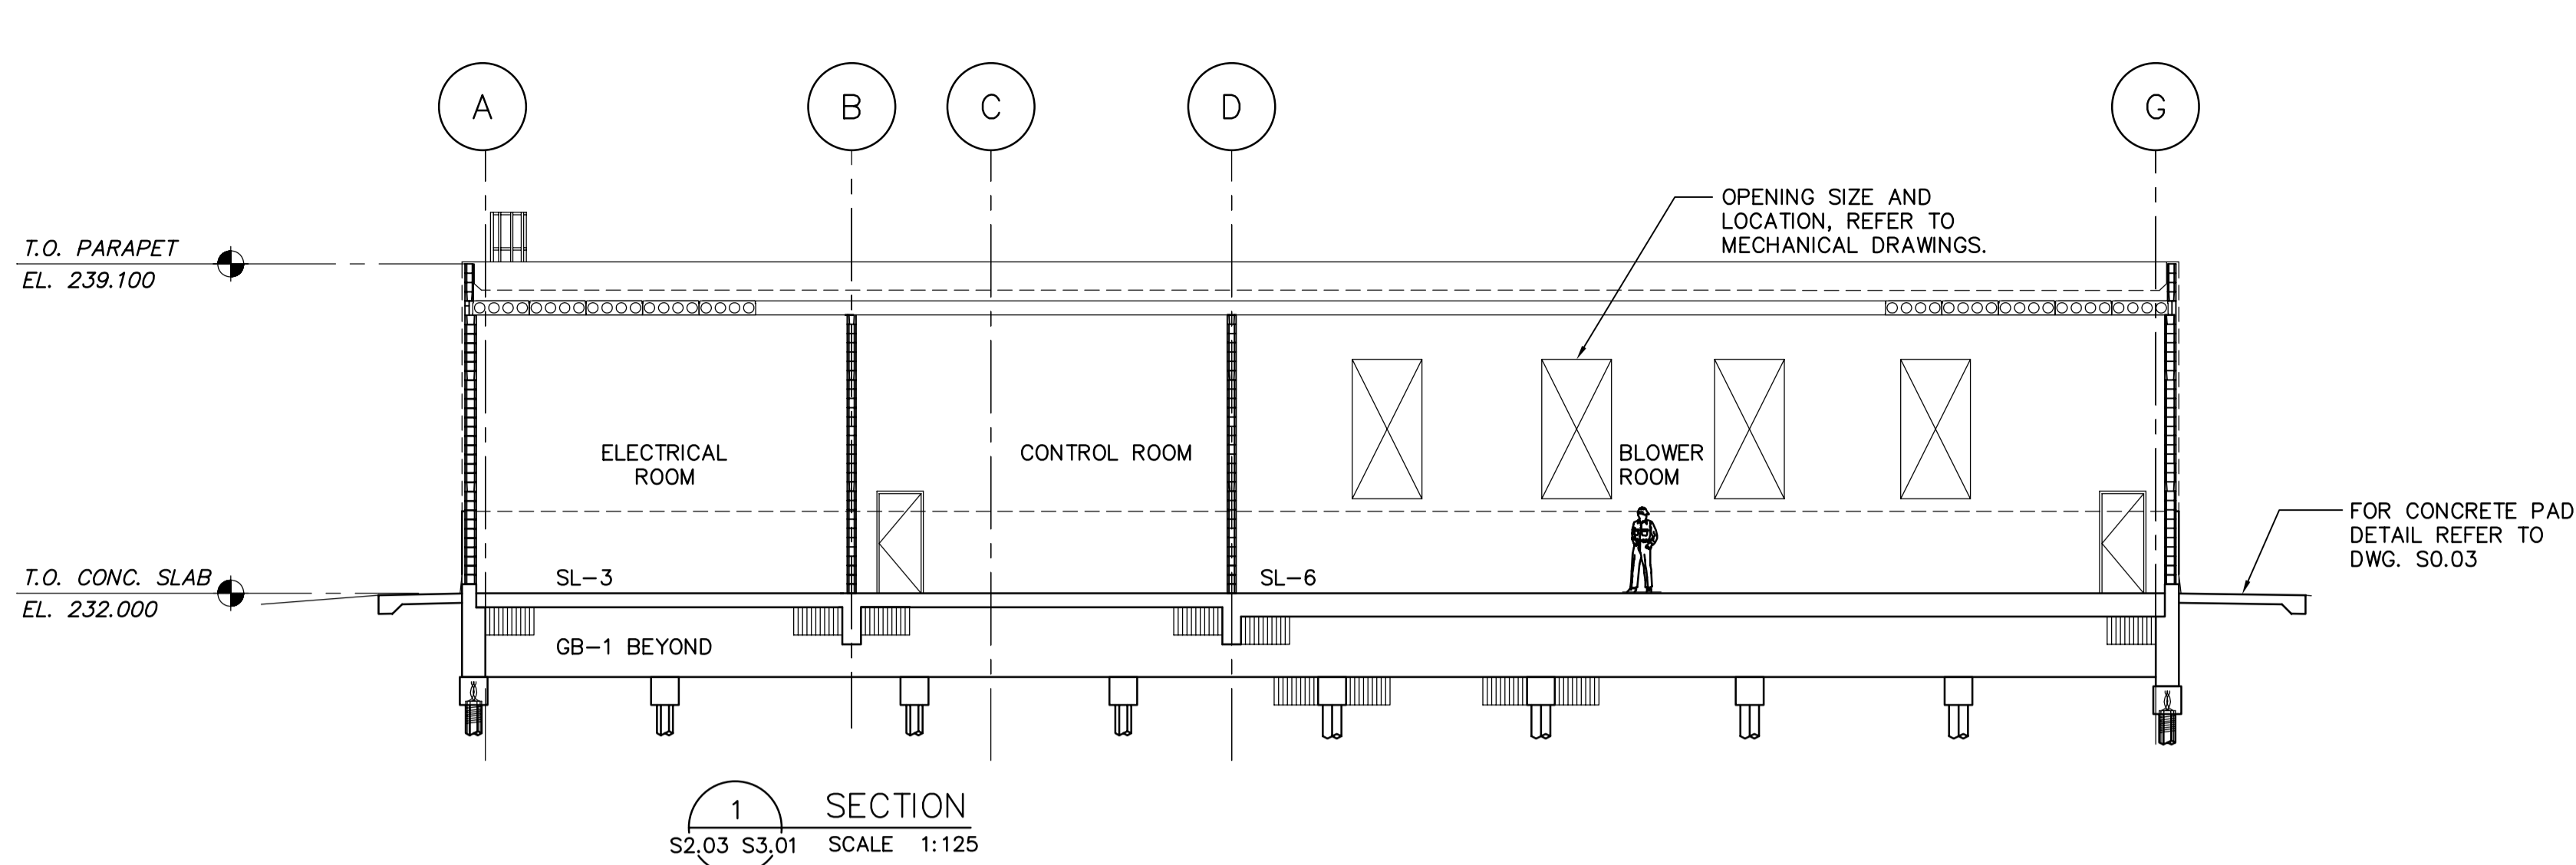


NOTE:
AT ACTUATOR UPPER SUPPORT PROVIDE
25M VERT. @ 150 o/c E.F. FOR 7M WIDTH
ADDITIONAL 25M HORIZ. @ 200 o/c AT
MID SPAN OF HORIZ. WALL REINF.
ADDITIONAL HORIZ. REINF. 7M LONG

AECOM AS-CONSTRUCTED
SIG. DATE.


AECOM
As of January 3, 2009,
EarthTech became AECOM
Canada Ltd.

 Certificate of Authorization AECOM Canada Ltd. Original dated on: No. 4671 Date: 2006/05/15	 A Tyco International Ltd. Company		ENGINEER'S SEAL ORIGINAL SIGNED BY L.L. RIDING 2006/05/15	 THE CITY OF WINNIPEG WATER AND WASTE DEPARTMENT ENGINEERING DIVISION NEWPCC CENTRATE NUTRIENT TREATMENT NITROGEN REMOVAL FACILITY CITY FILE NUMBER SHEET OF CITY DRAWING NUMBER 1-0101C-S0011-002-03
	DESIGNED BY LLR	CHECKED BY GGP	CONSULTANT DRAWING NO. S3.04	
	DRAWN BY WDB	APPROVED BY JEH		
	SCALE: AS NOTED	RELEASED FOR CONSTRUCTION BY: K. MARTENS DATE: 2006/05/15		
NO. REVISIONS DATE BY	DATE 2006/02/01	DATE 2006/05/15	STRUCTURAL SBR BUILDING BUILDING SECTIONS & ELEVATION SHEET 2	

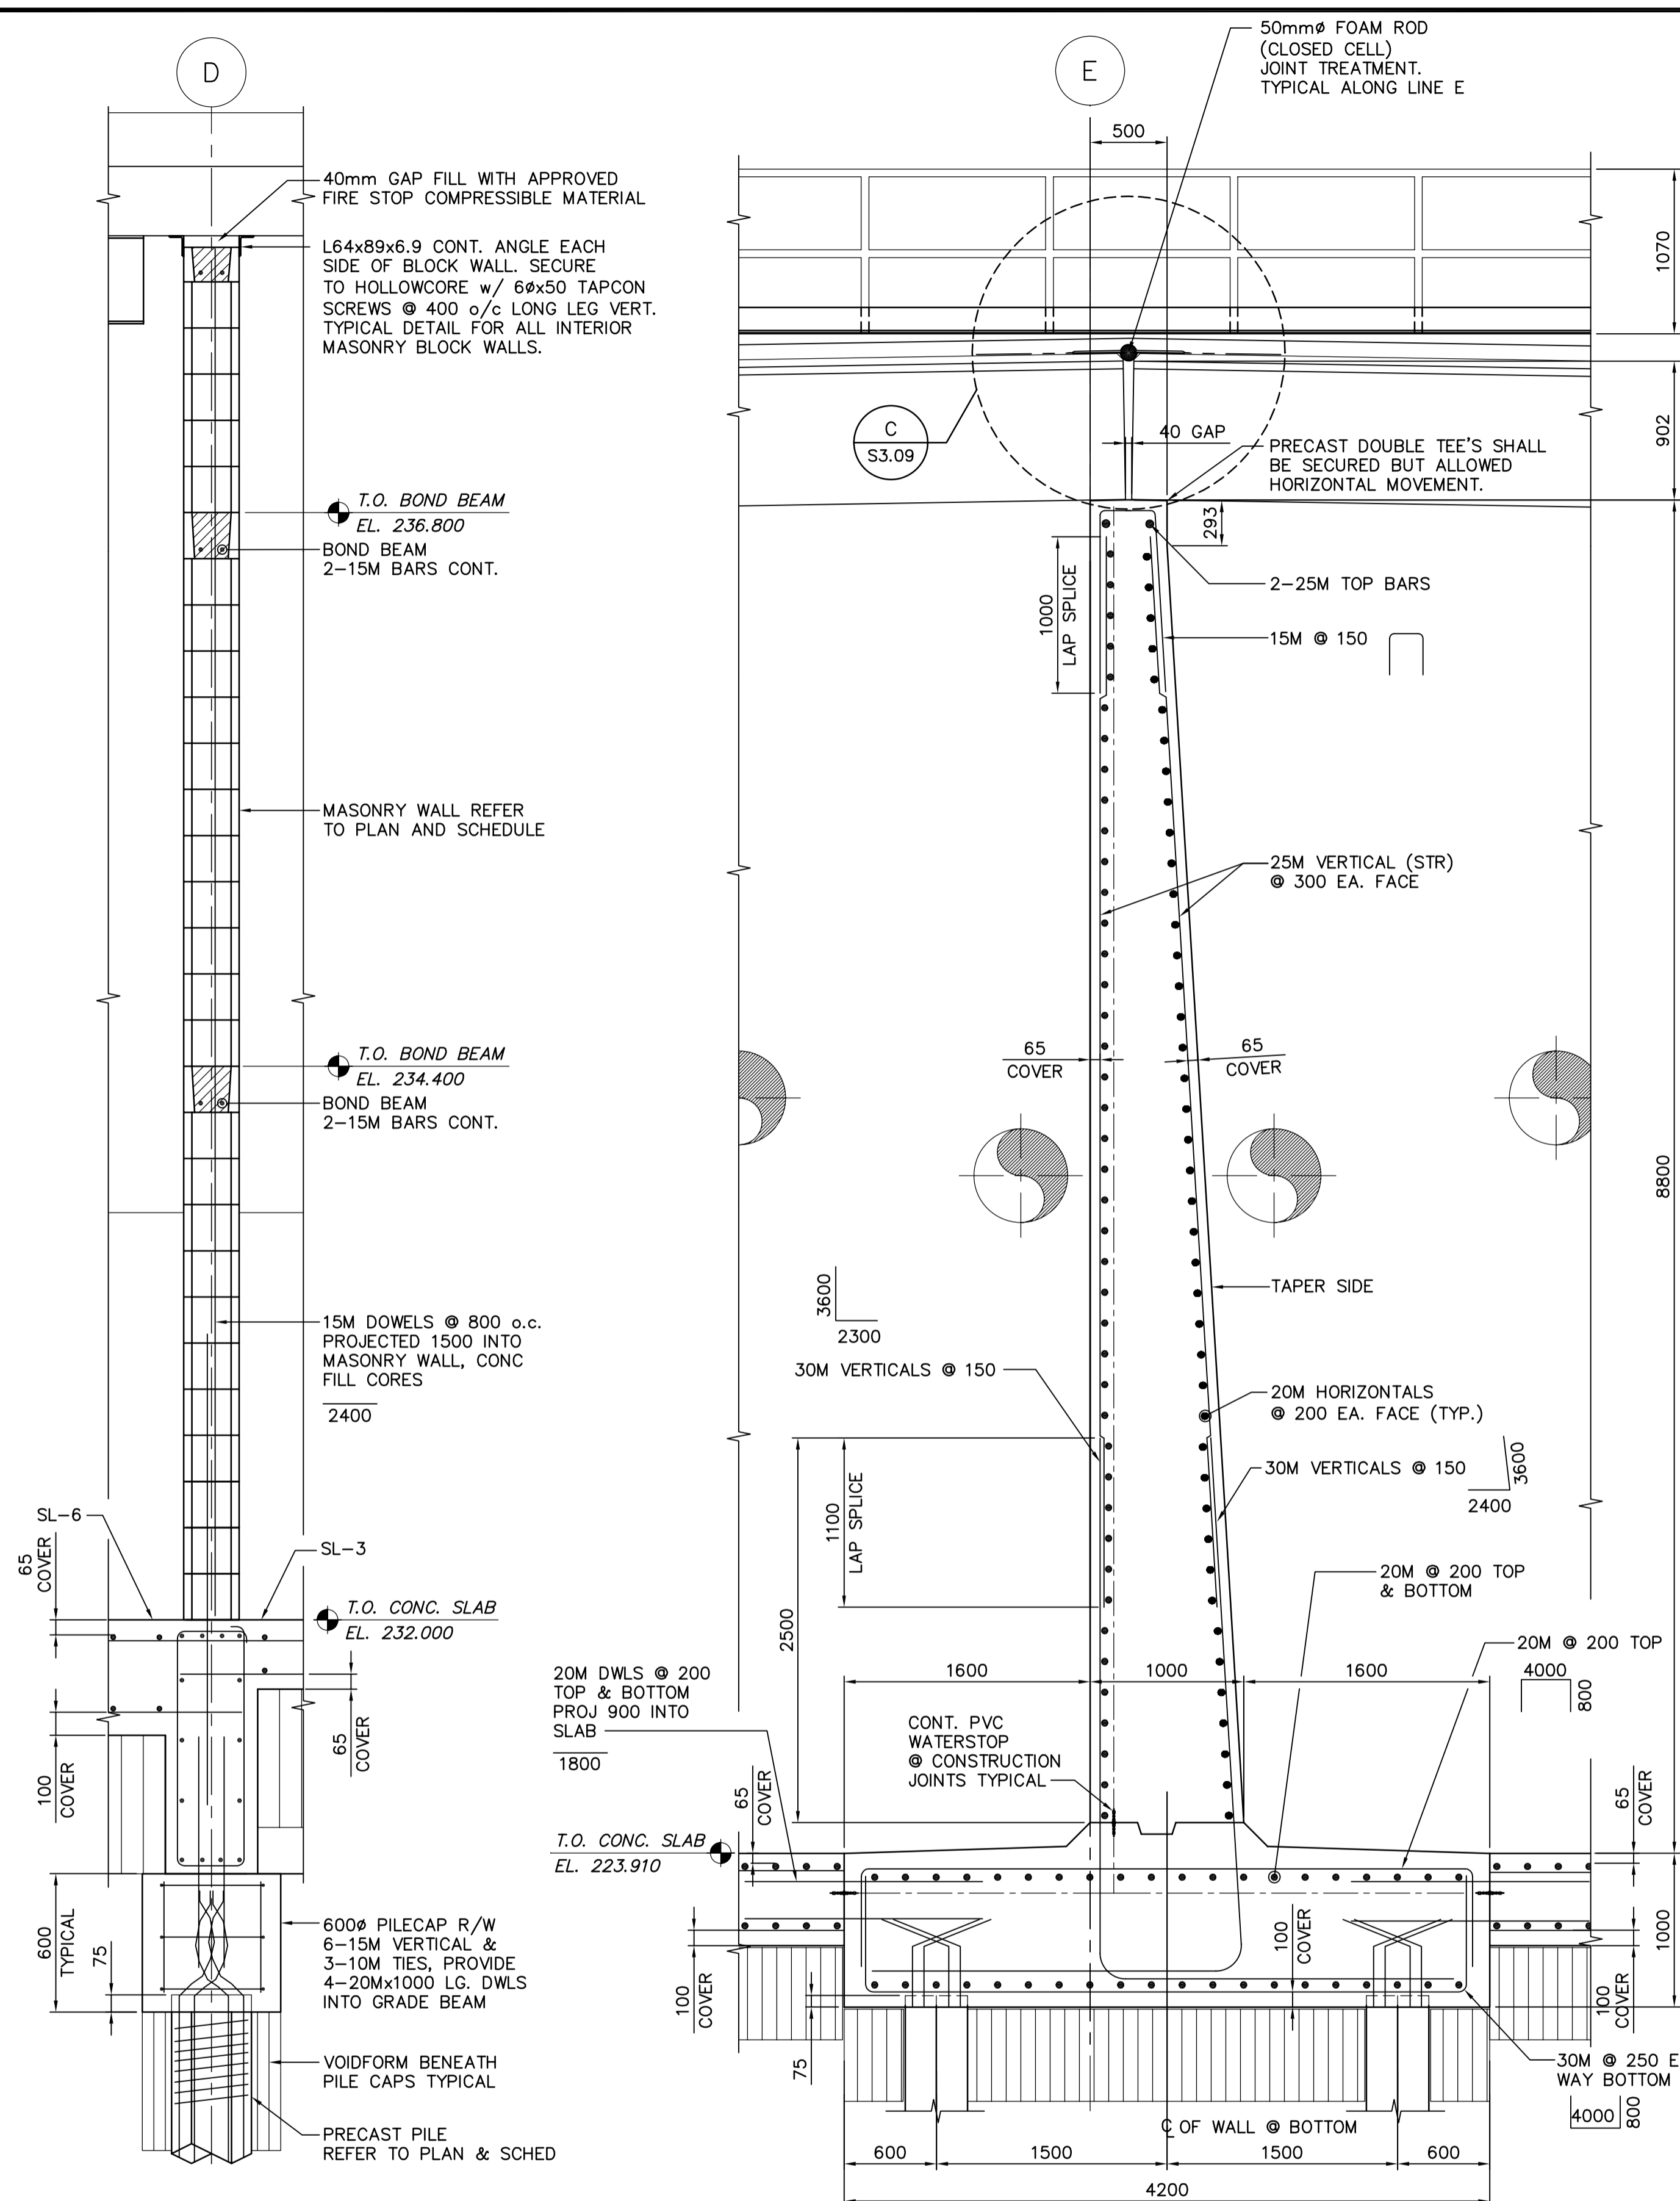

A DETAIL
S3.02 SCALE 1:20

B TYPICAL DIVIDING WALL REINFORCING
S3.02 SCALE 1:30

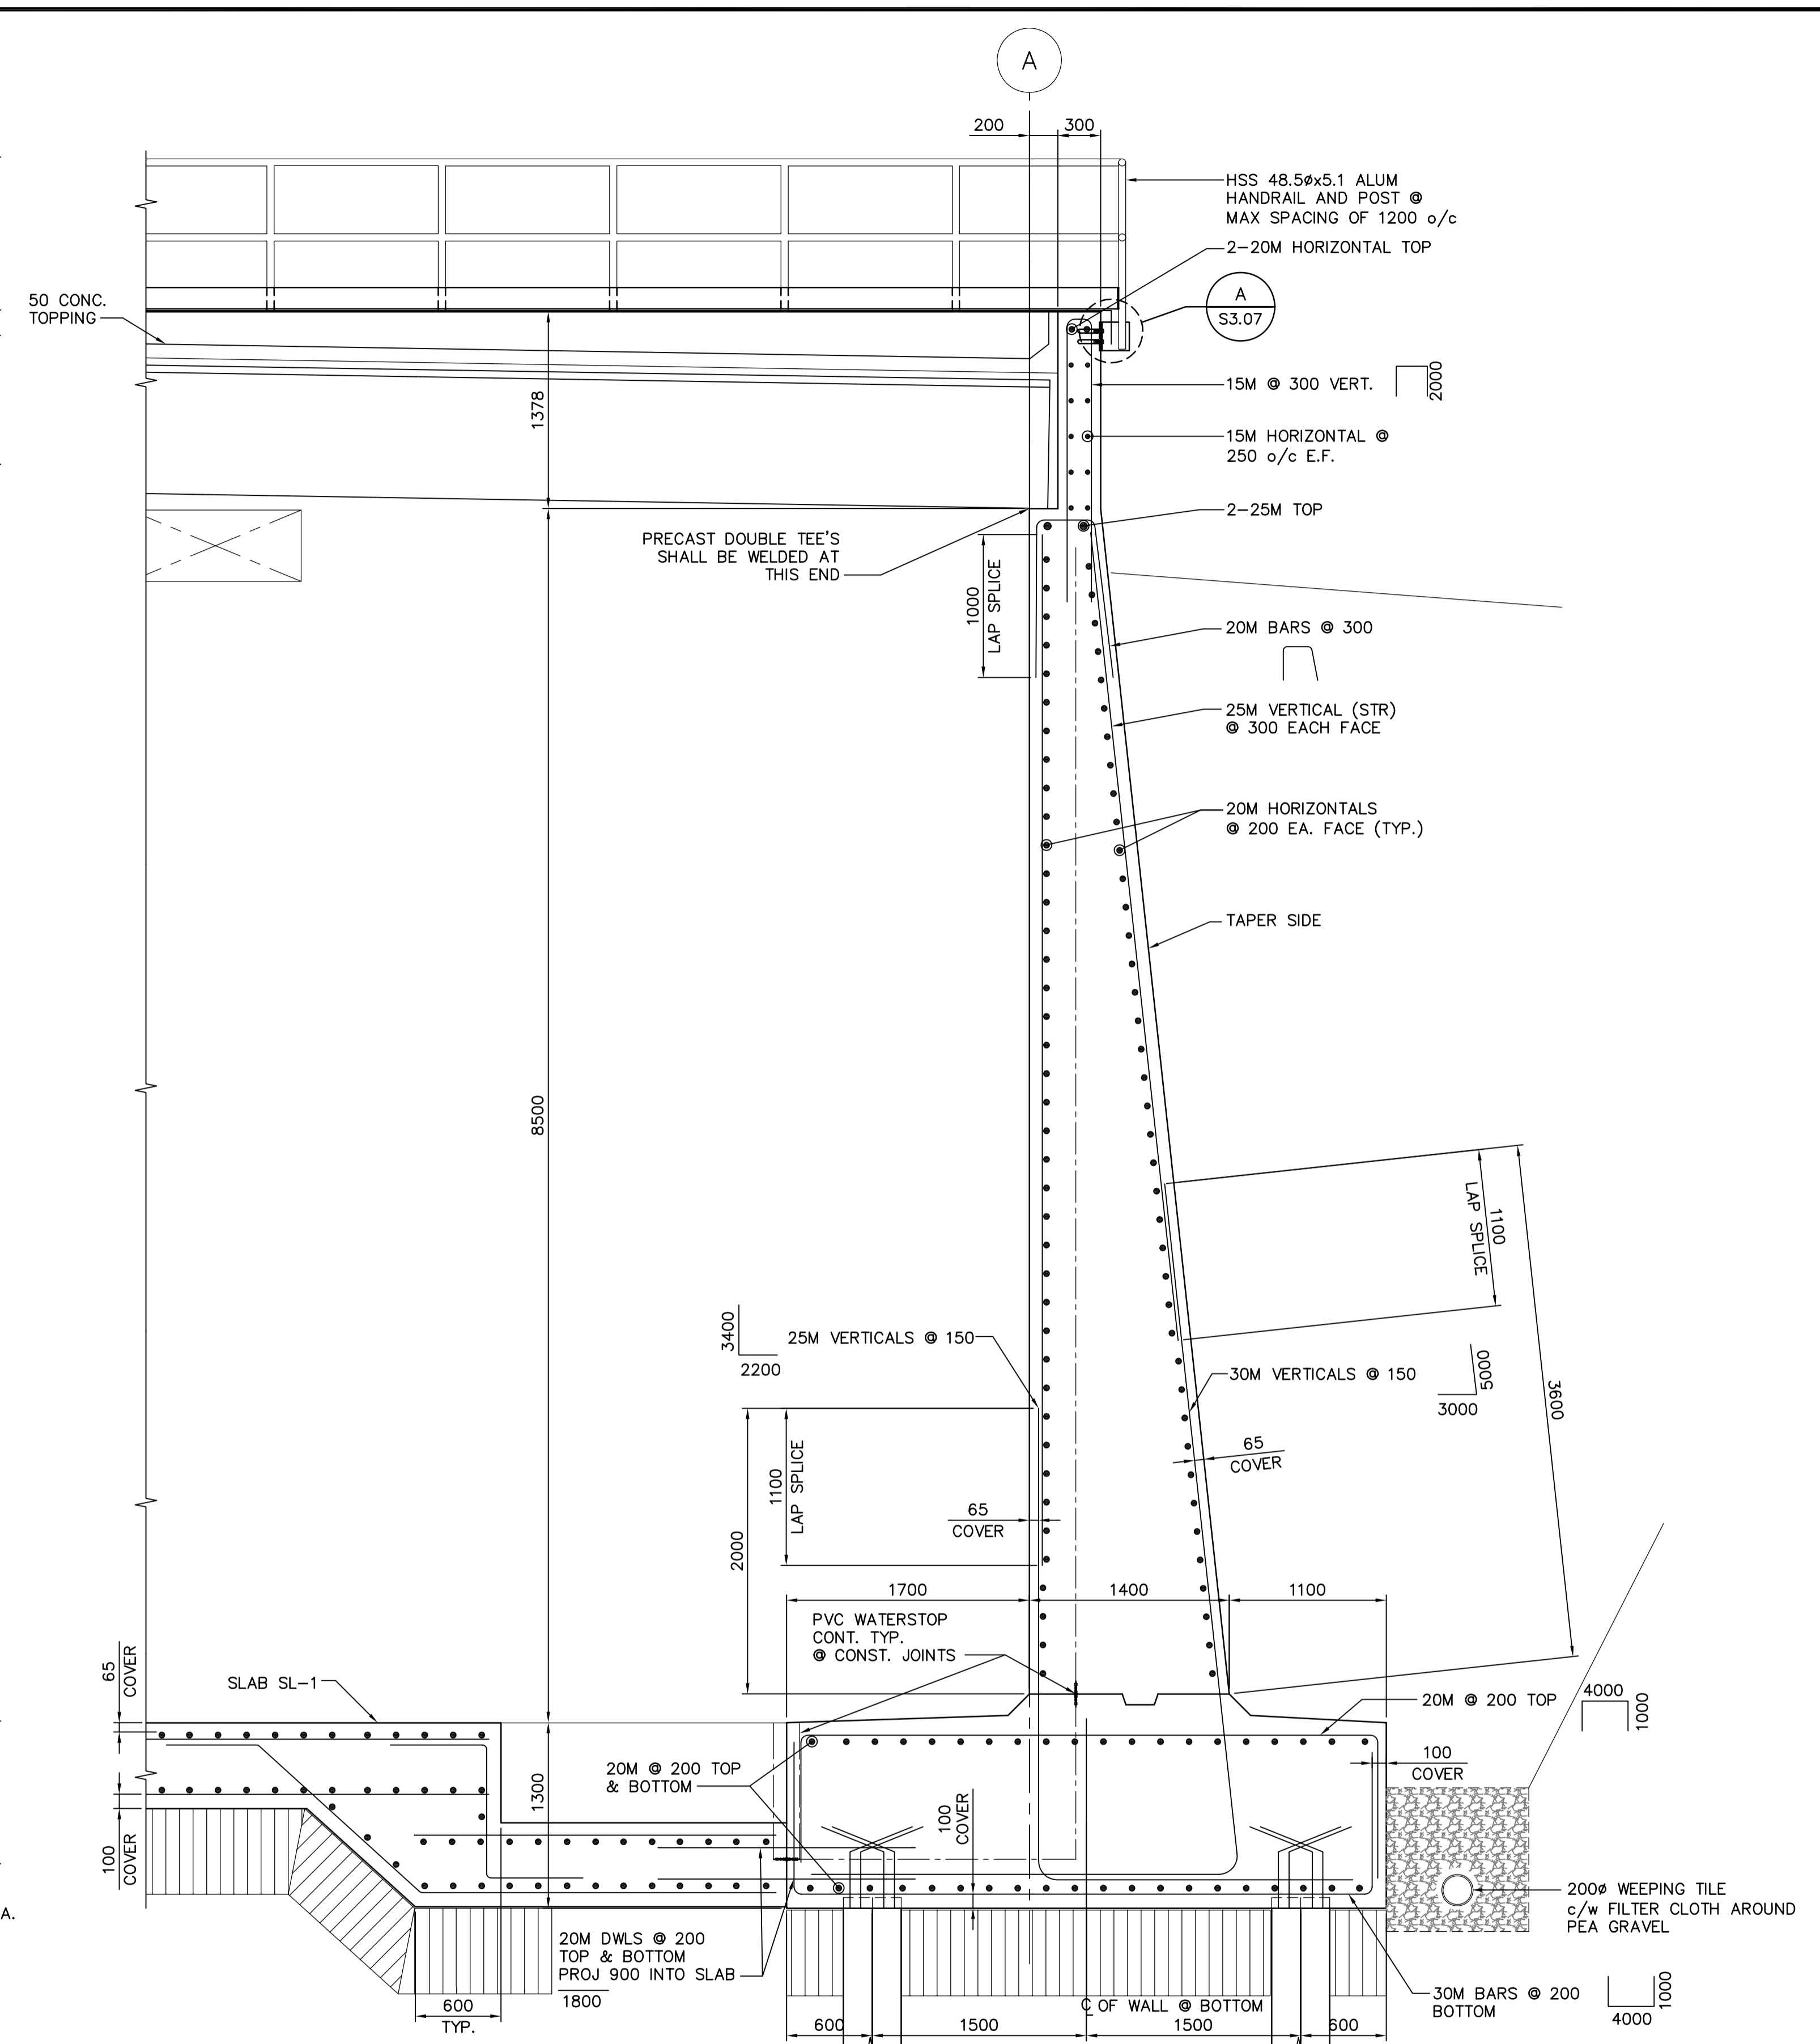

C TYPICAL EXTERIOR WALL REINFORCING
S3.02 SCALE 1:30

AECOM
As of January 3, 2009, EarthTech became AECOM Canada Ltd.

AECOM AS-CONSTRUCTED
SIG..... DATE.....

APEGM
Certificate of Authorization
AECOM Canada Ltd.
Original dated on: No. 4671 Date: 2006/05/15

B.M. ELEV.					
DESIGNED BY	LLR	CHECKED BY	GGP		
DRAWN BY	WDB	APPROVED BY	JEH		
SCALE:	AS NOTED	RELEASED FOR CONSTRUCTION BY:	K. MARTENS		
NO. REVISIONS	DATE	BY	DATE	2006/04/10	2006/05/15


ENGINEER'S SEAL
ORIGINAL SIGNED BY
L.L. RIDING
2006/05/15
CONSULTANT DRAWING NO.
S3.05

THE CITY OF WINNIPEG
WATER AND WASTE DEPARTMENT
ENGINEERING DIVISION

NEWPCC CENTRATE NUTRIENT TREATMENT NITROGEN REMOVAL FACILITY

STRUCTURAL
SBR BUILDING
BUILDING DETAILS SHEET 1

CITY FILE NUMBER
SHEET OF
CITY DRAWING NUMBER
1-0101C-S0012-001-03

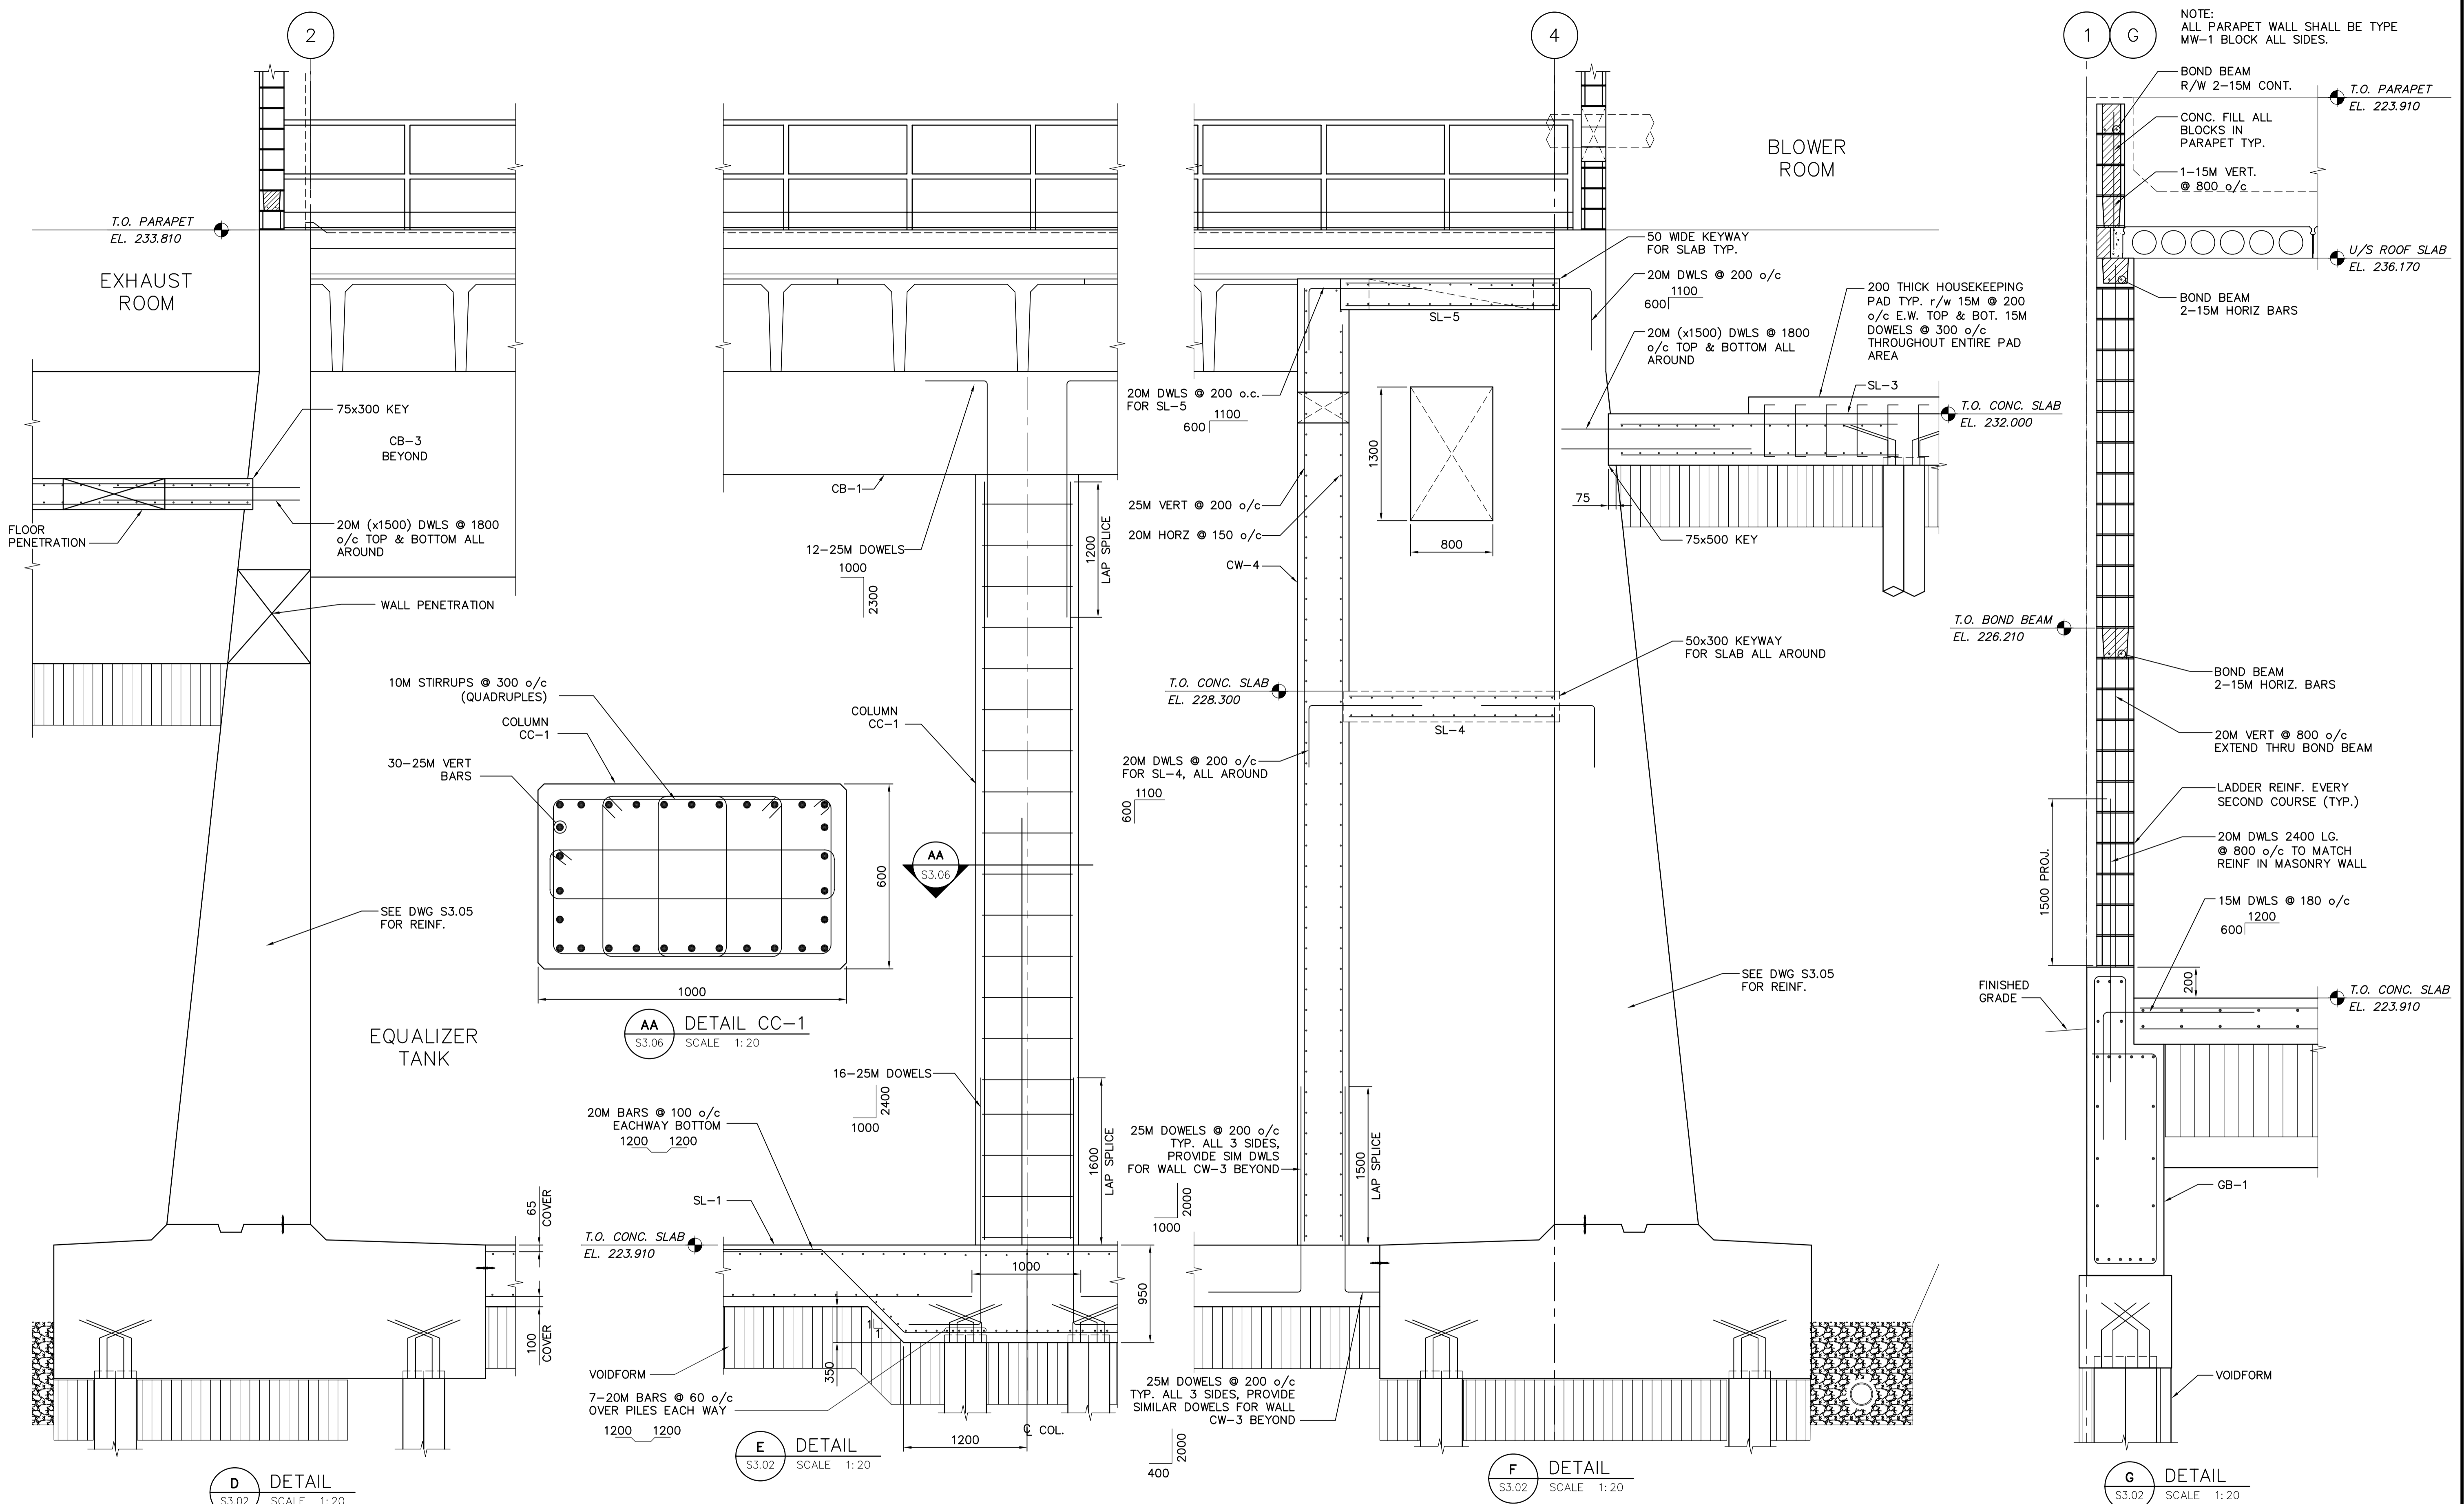

AECOM AS-CONSTRUCTED
SIG..... DATE.....


REFER TO KGS MASONRY REPAIR AS-BUILTS




B.M. ELEV.					
DESIGNED BY	LLR	CHECKED BY	GGP		
DRAWN BY	WDB	APPROVED BY	JEH		
SCALE:	AS NOTED	RELEASED FOR CONSTRUCTION BY:	K. MARTENS		
NO. REVISIONS	DATE	BY	DATE	2006/04/10	2006/05/15

ENGINEER'S SEAL
ORIGINAL SIGNED BY
L.L. RIDING
2006/05/15
CONSULTANT DRAWING NO.
S3.06


THE CITY OF WINNIPEG
WATER AND WASTE DEPARTMENT
ENGINEERING DIVISION
NEWPCC CENTRATE NUTRIENT TREATMENT NITROGEN REMOVAL FACILITY
STRUCTURAL SBR BUILDING BUILDING DETAILS SHEET 2
CITY FILE NUMBER
SHEET OF
CITY DRAWING NUMBER
1-0101C-S0012-002-03

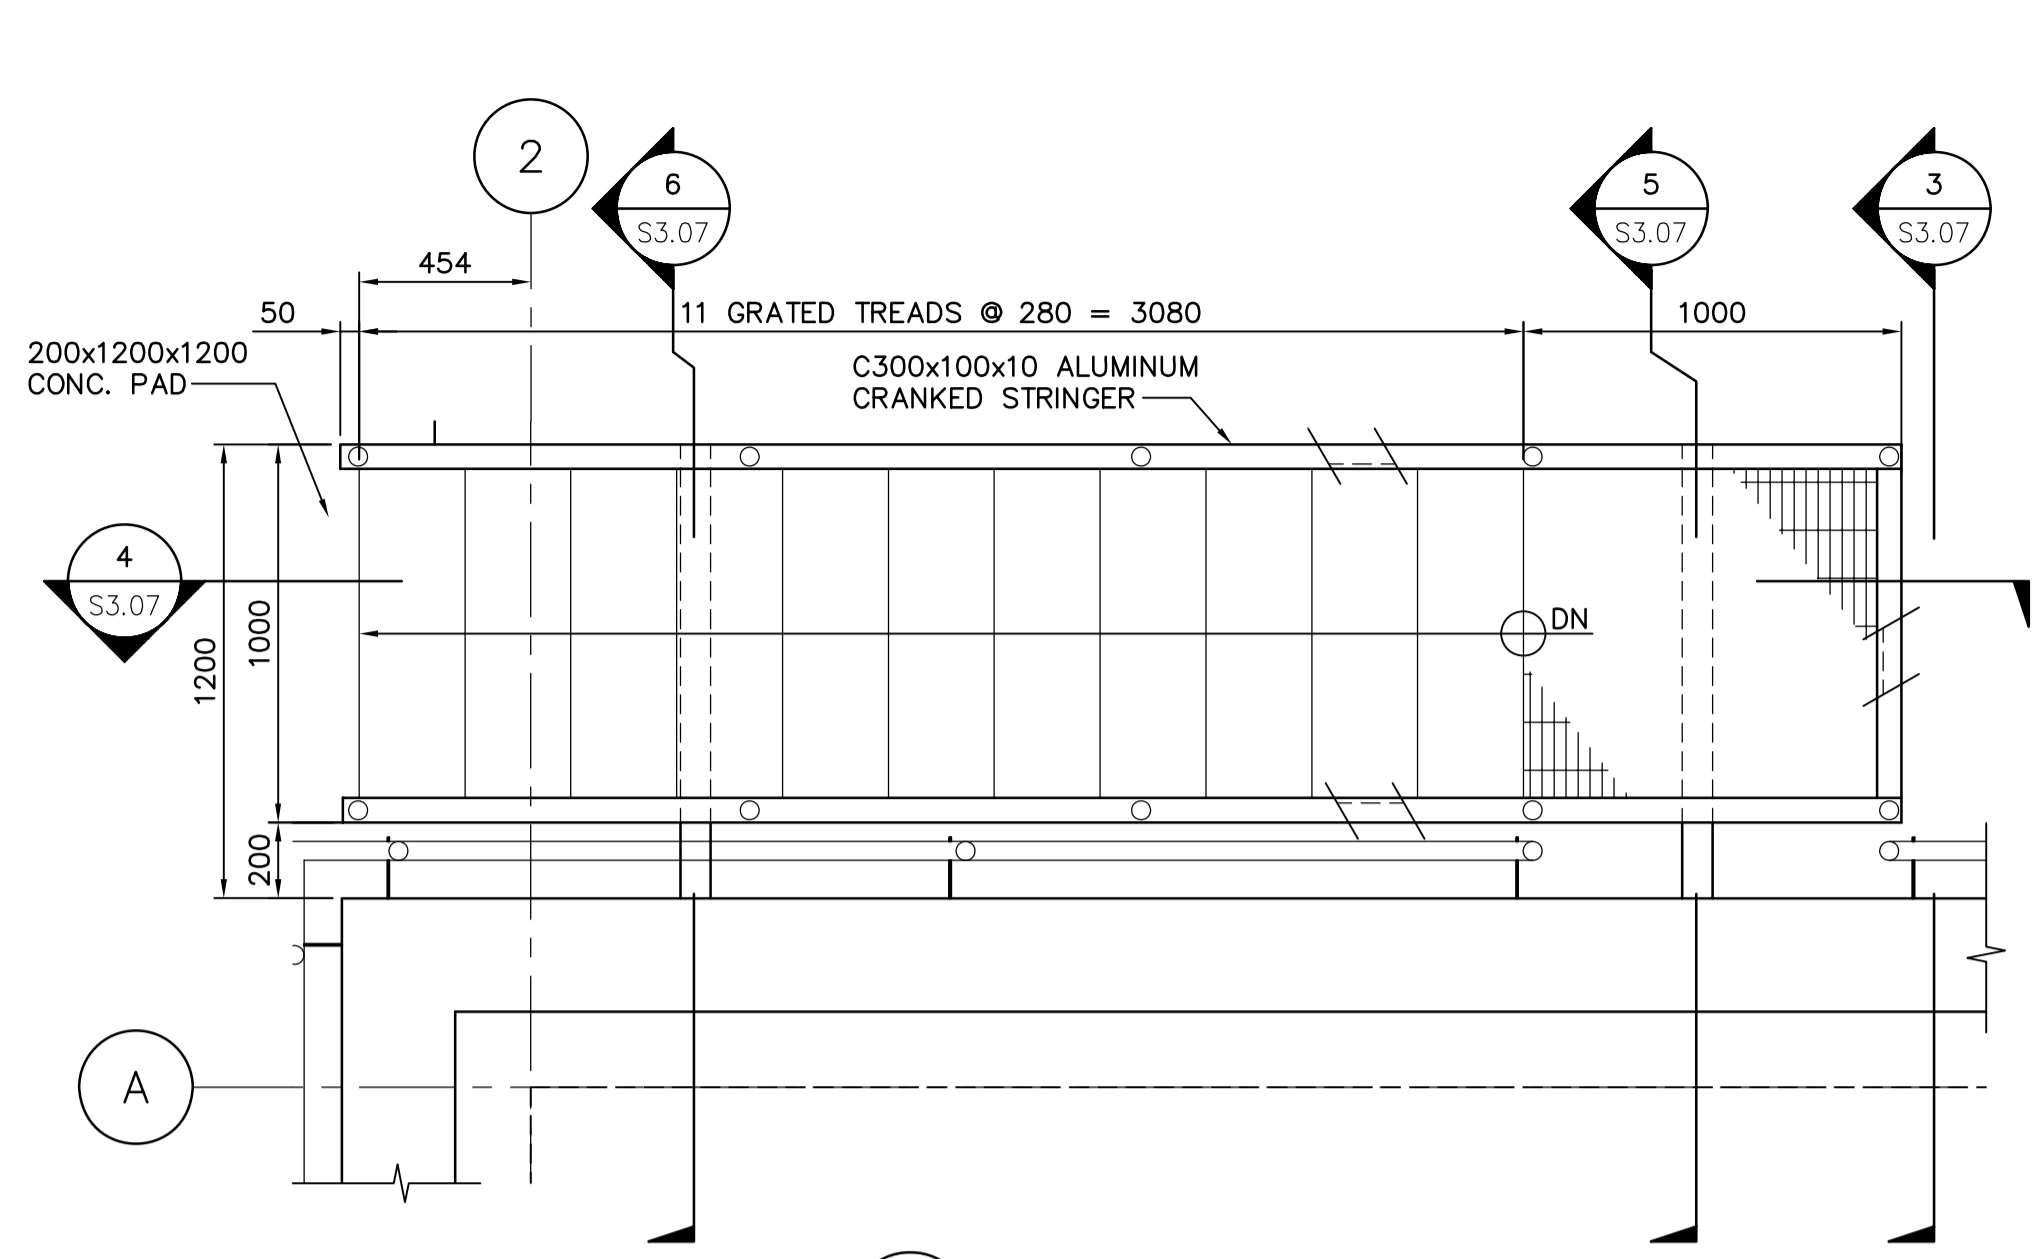


1 STAIR #1 PLAN
S2.03 S3.01 SCALE 1:125

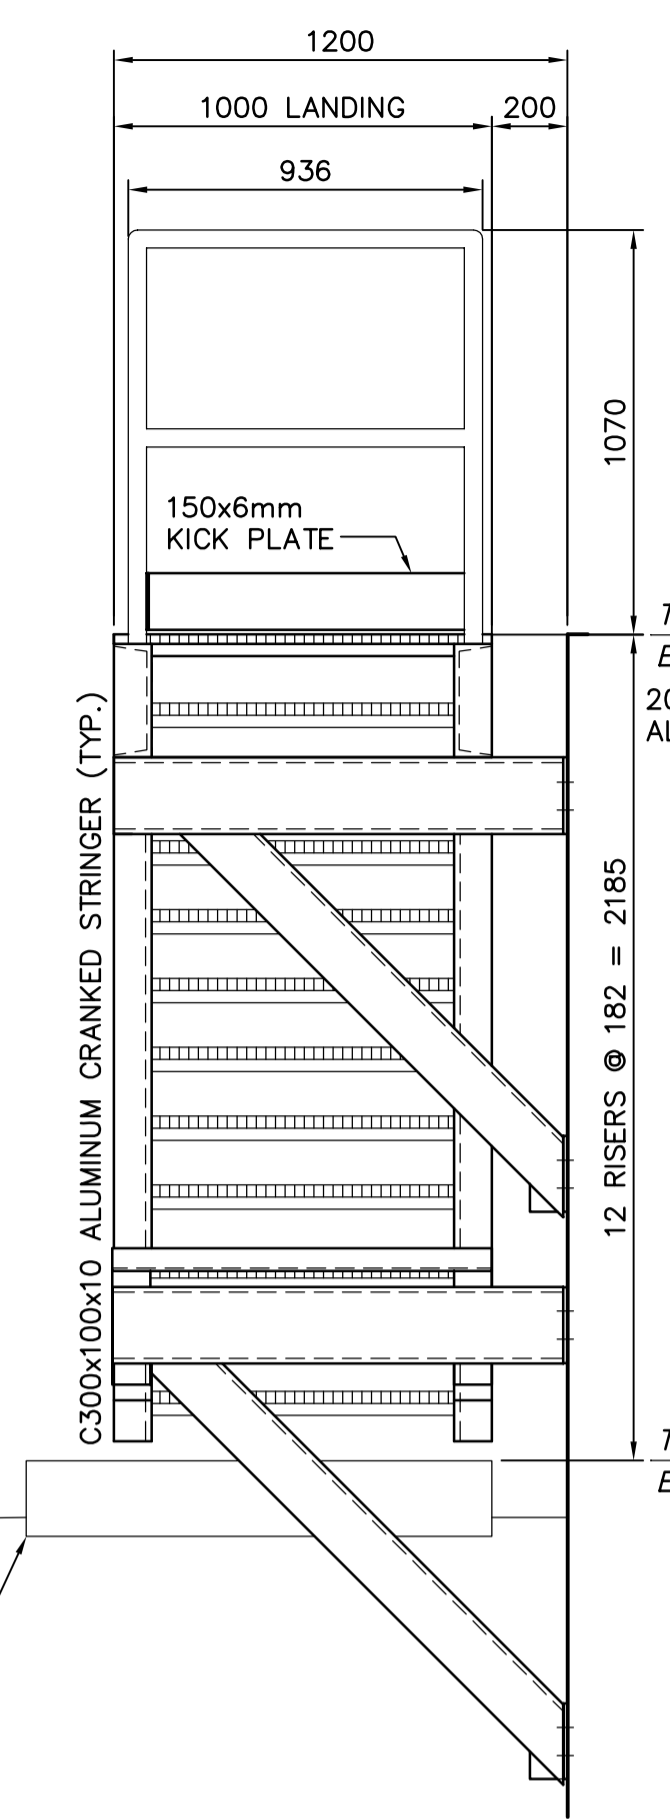


3 STAIR #1 ELEVATION
S3.07 SCALE 1:20

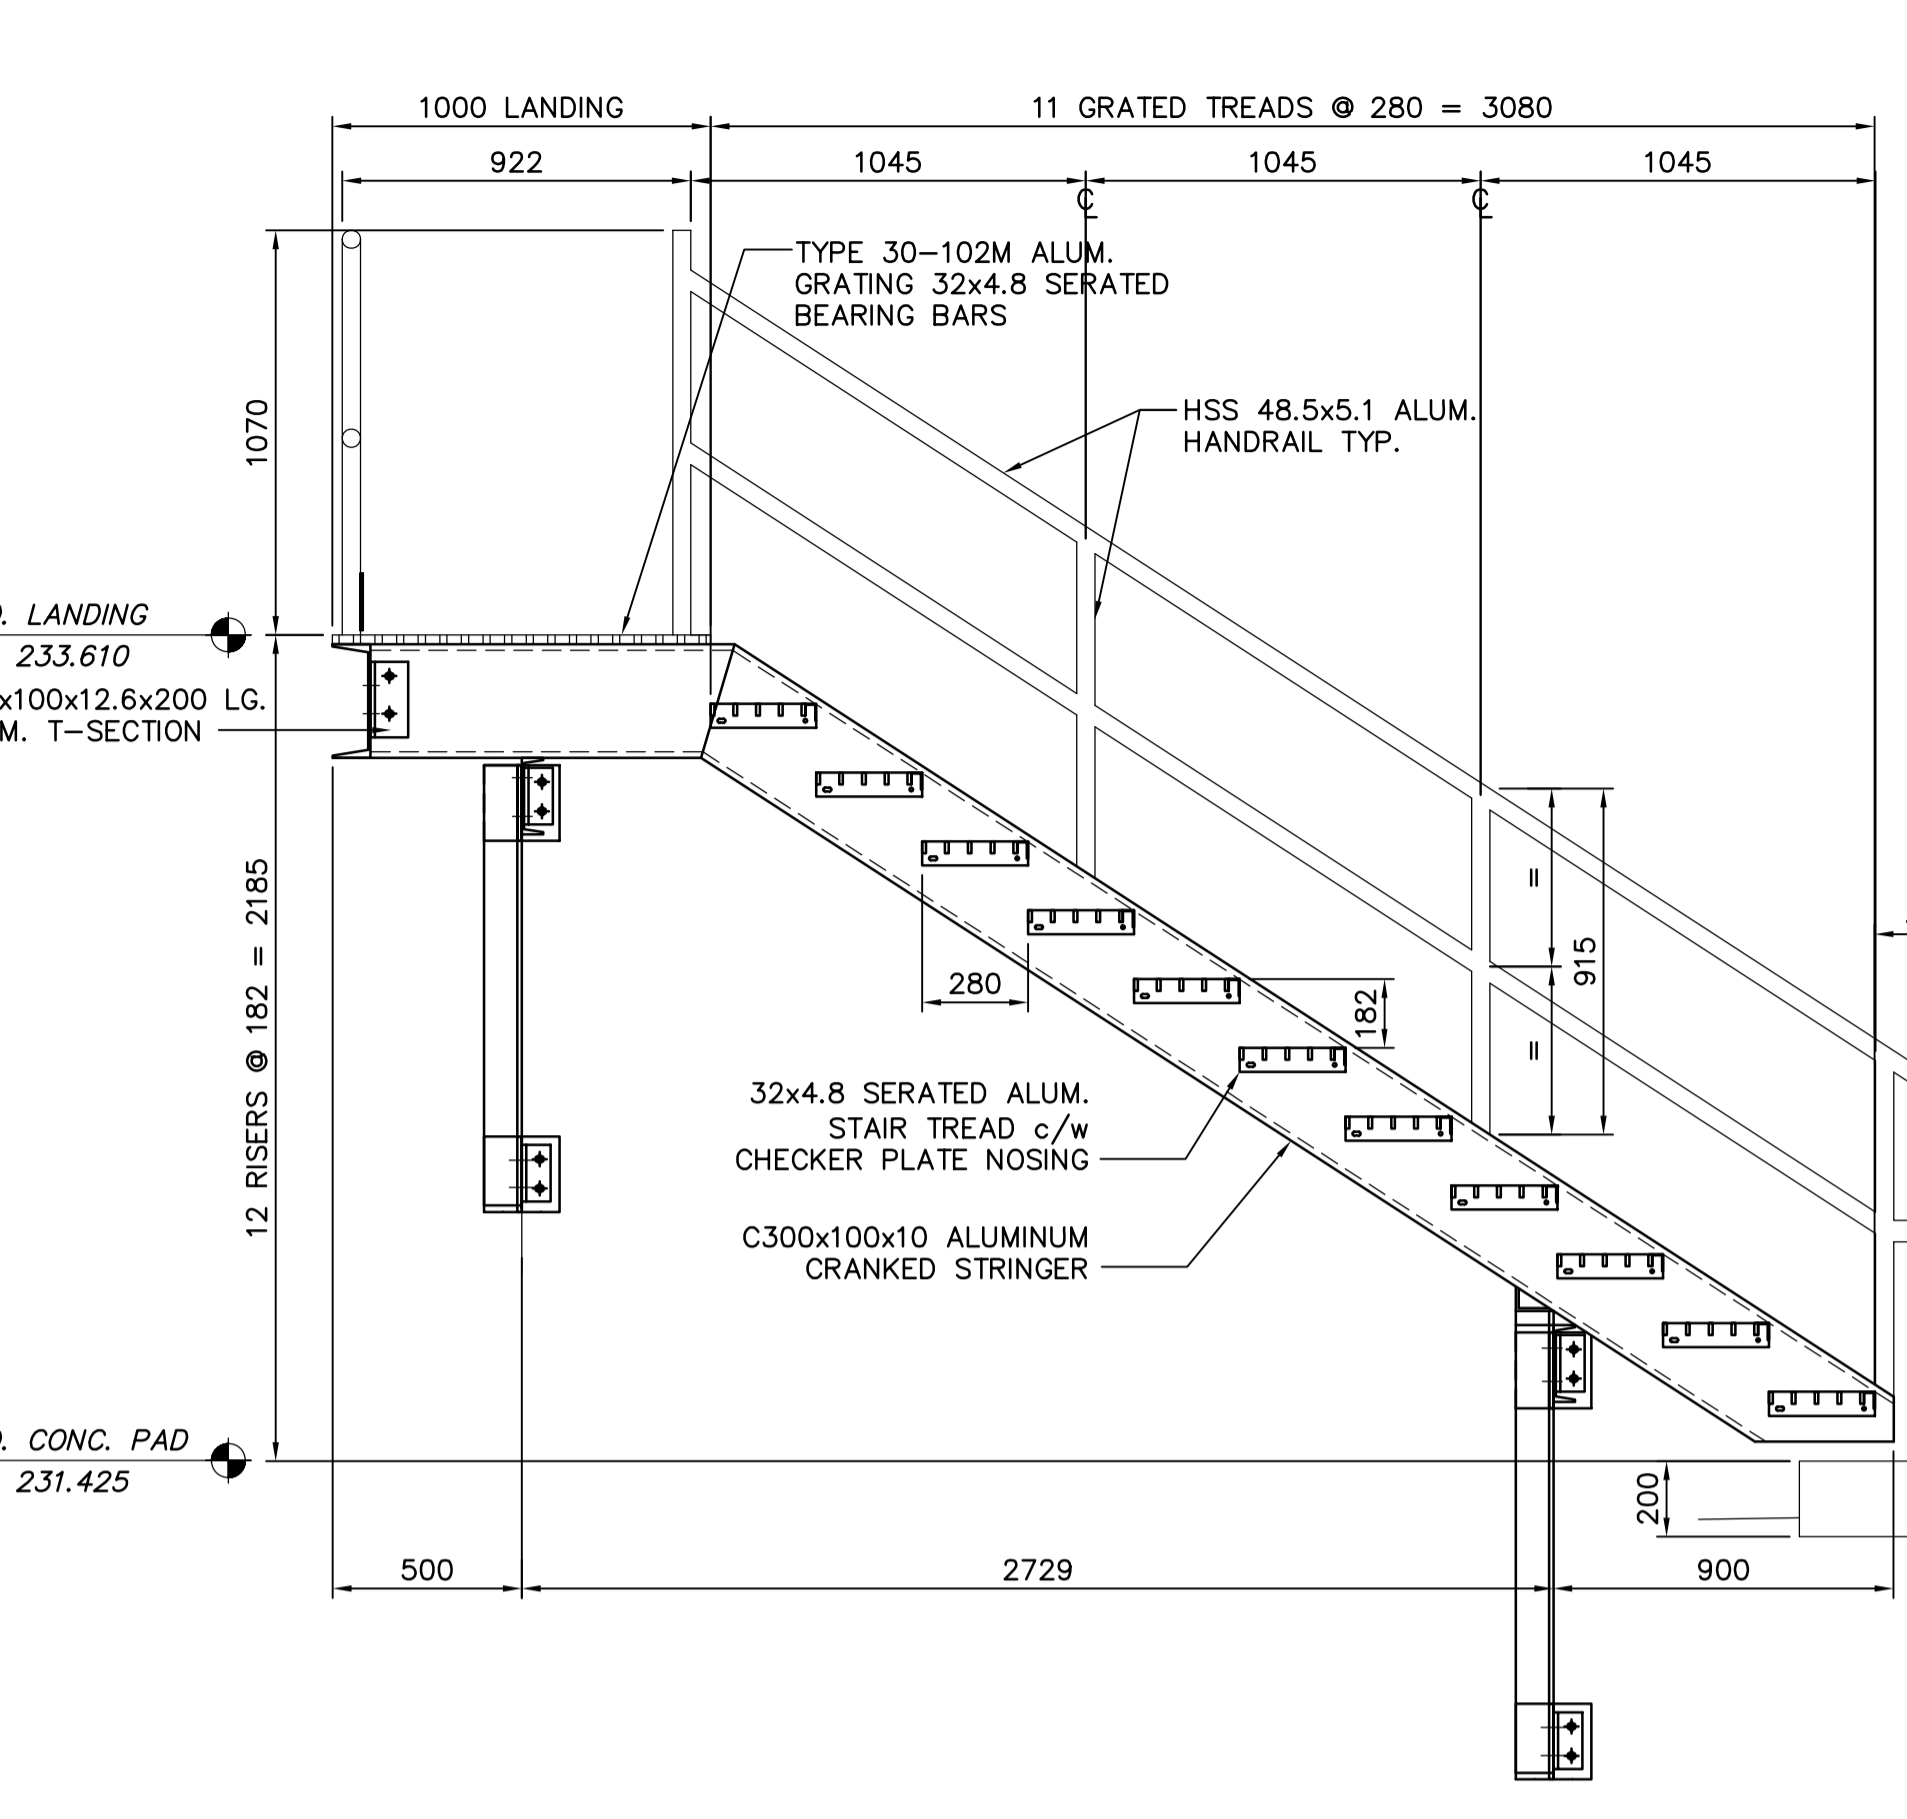


4 STAIR #1 SECTION
S3.07 SCALE 1:20

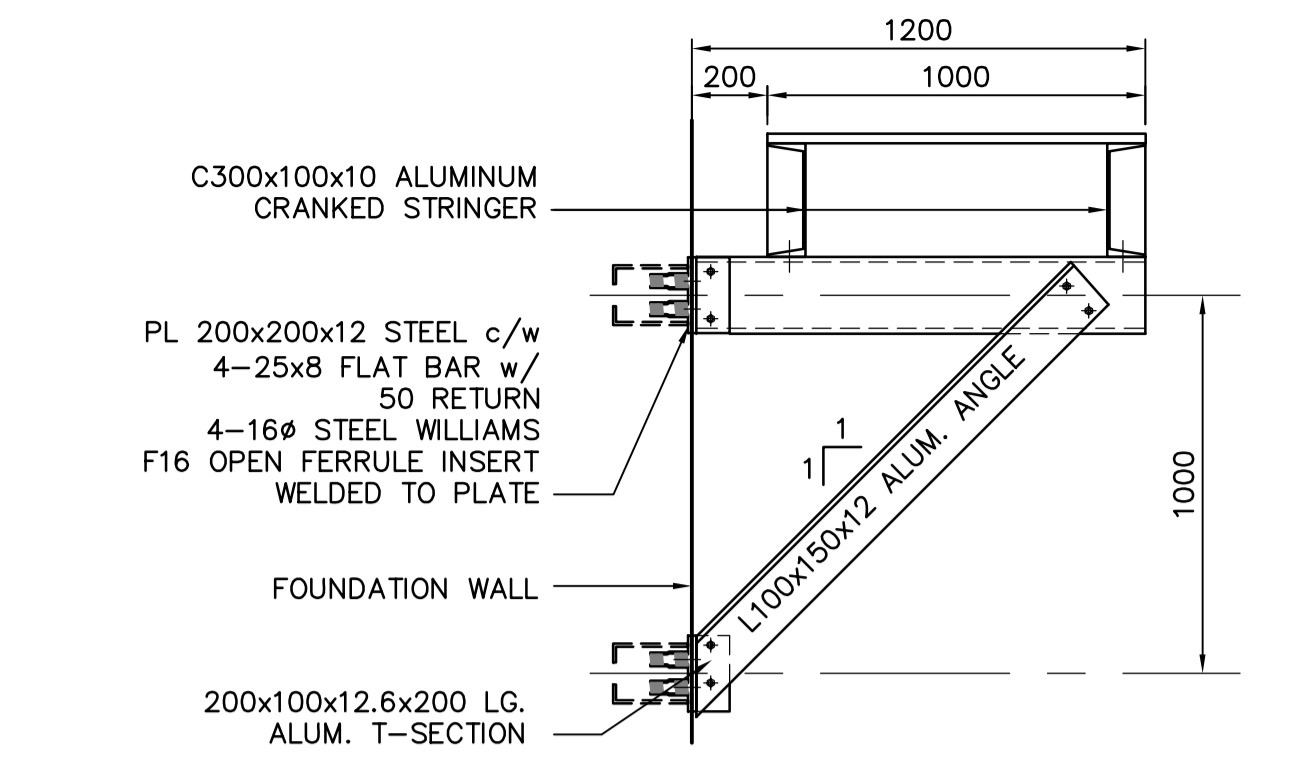


5 TYP. UPPER SUPPORT SECTION
S3.07 SCALE 1:20

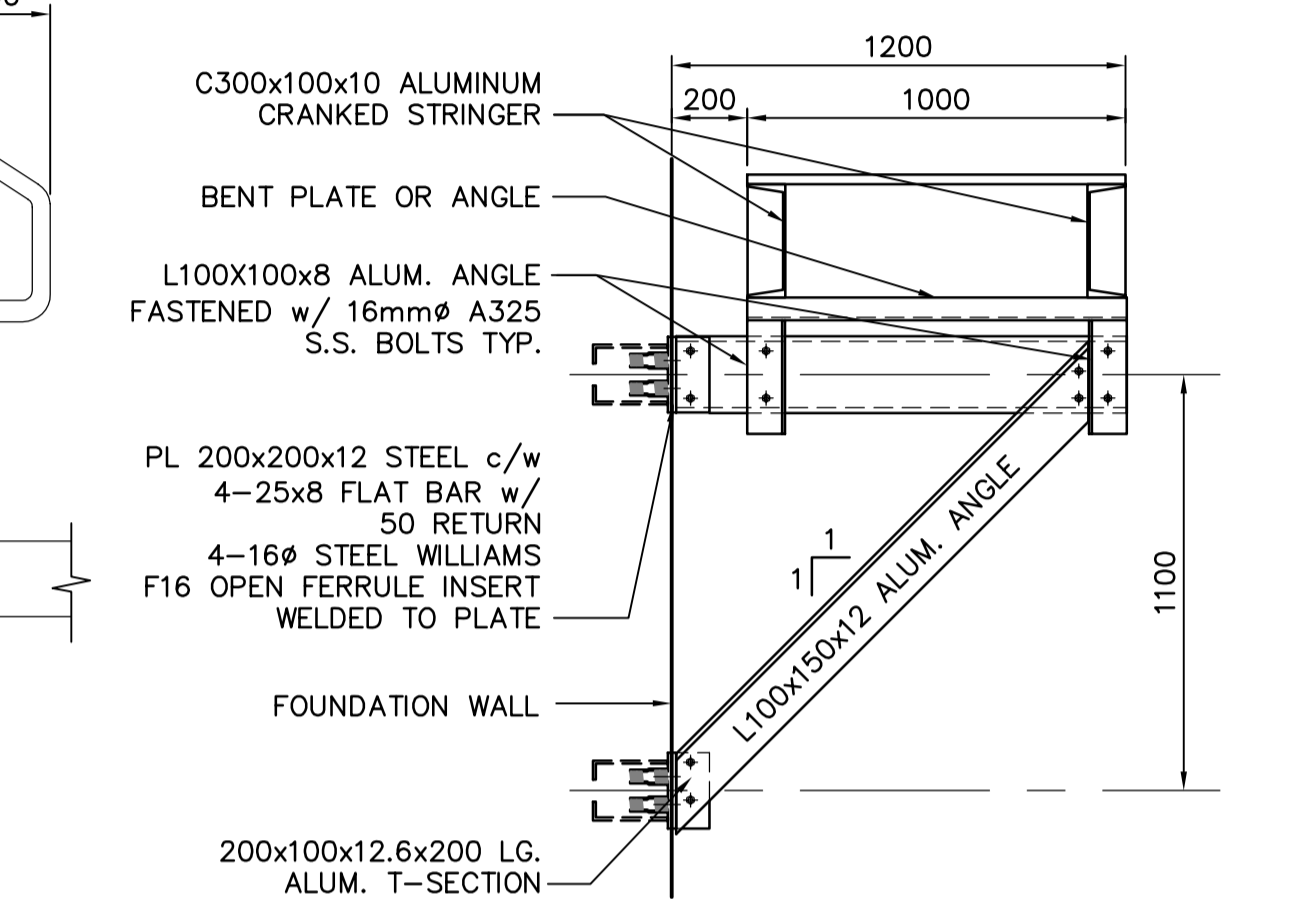


6 TYP. LOWER SUPPORT SECTION
S3.07 SCALE 1:20

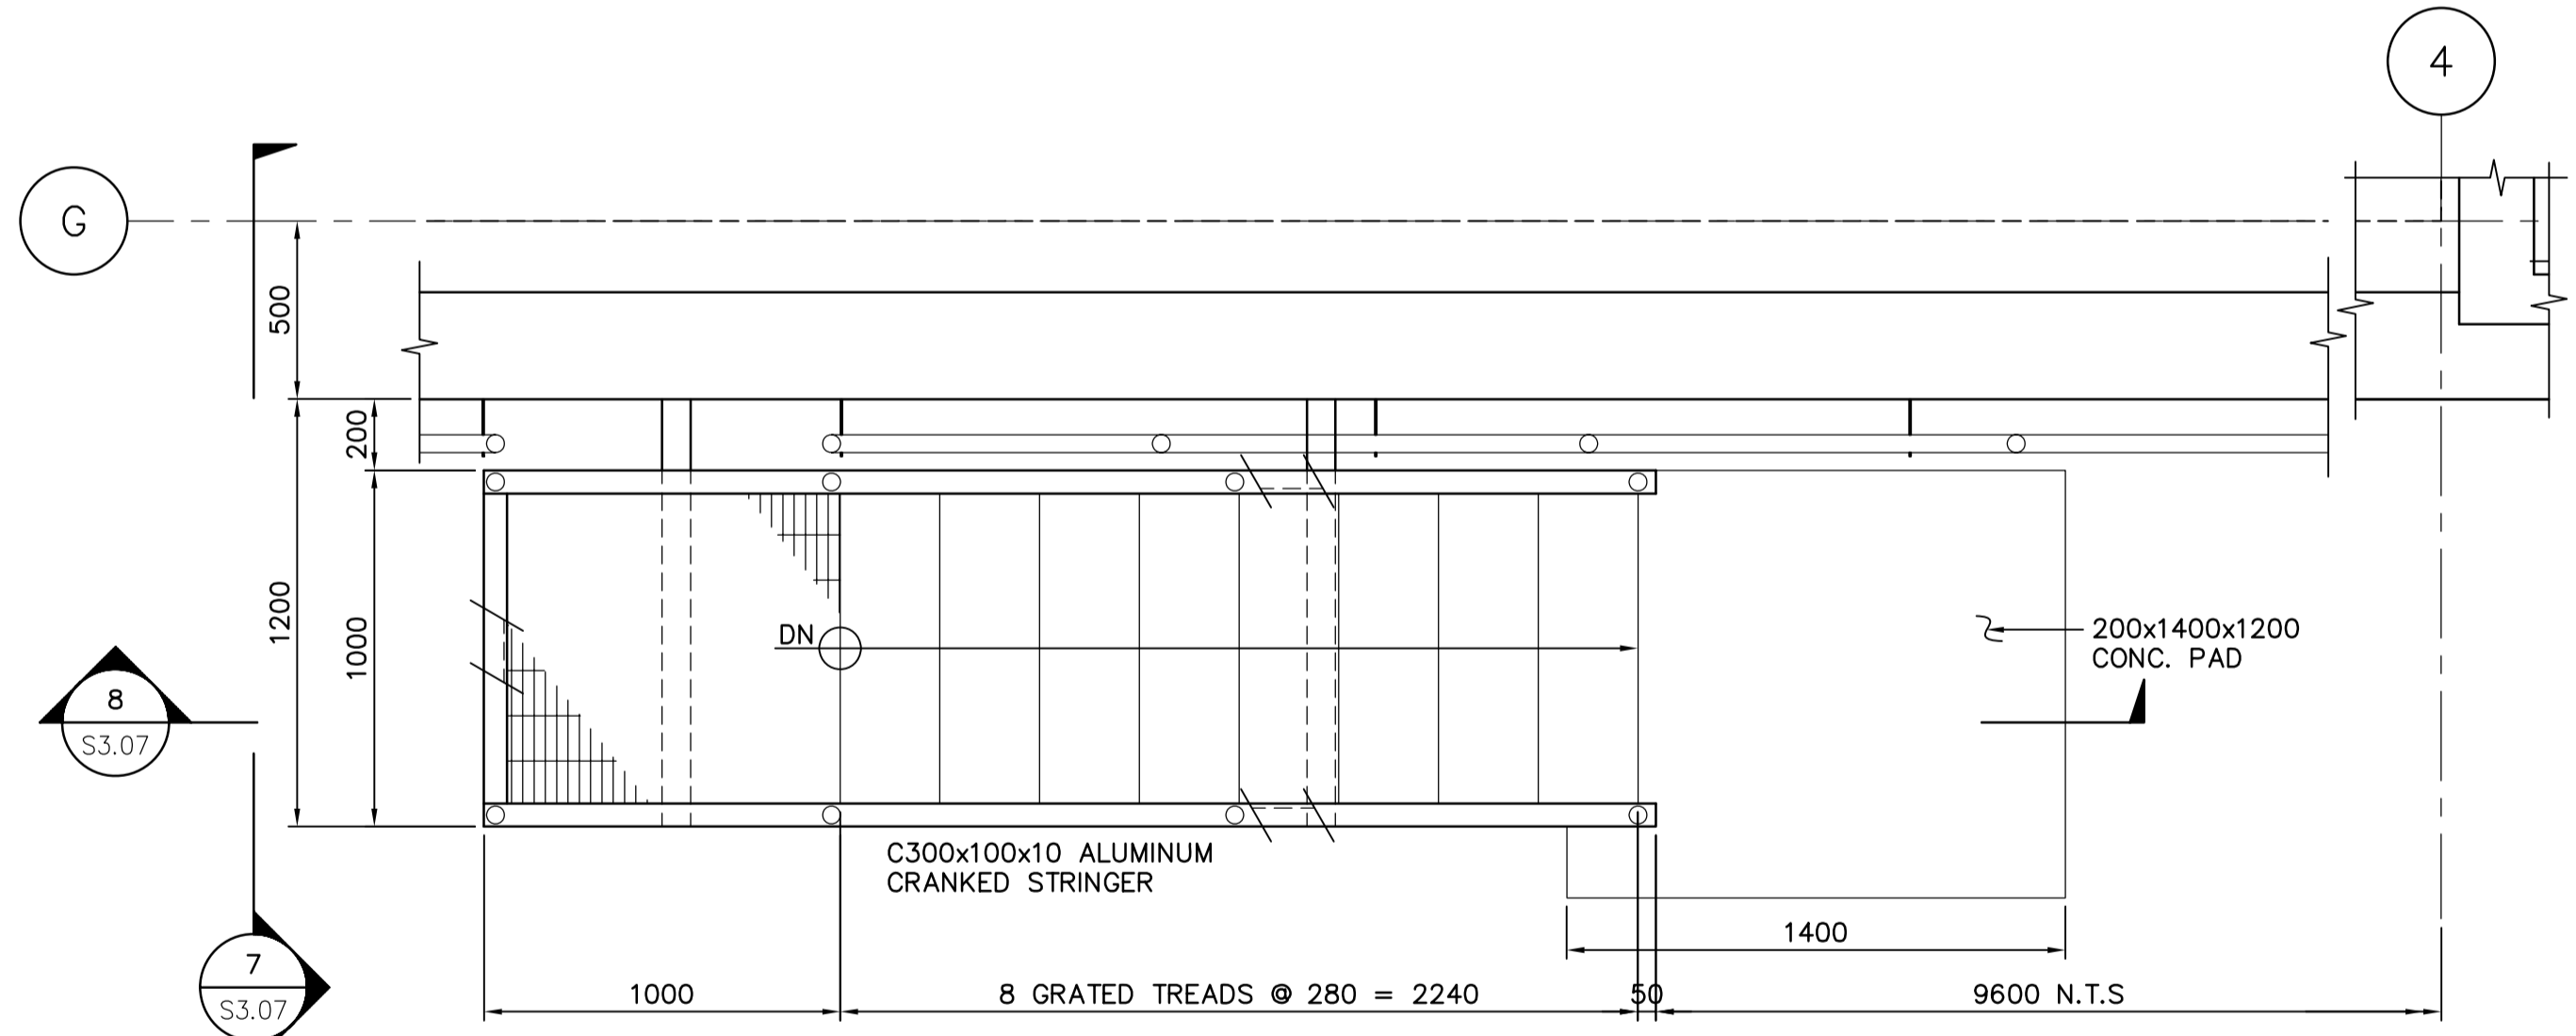


2 STAIR #2 PLAN
S3.01 SCALE 1:20

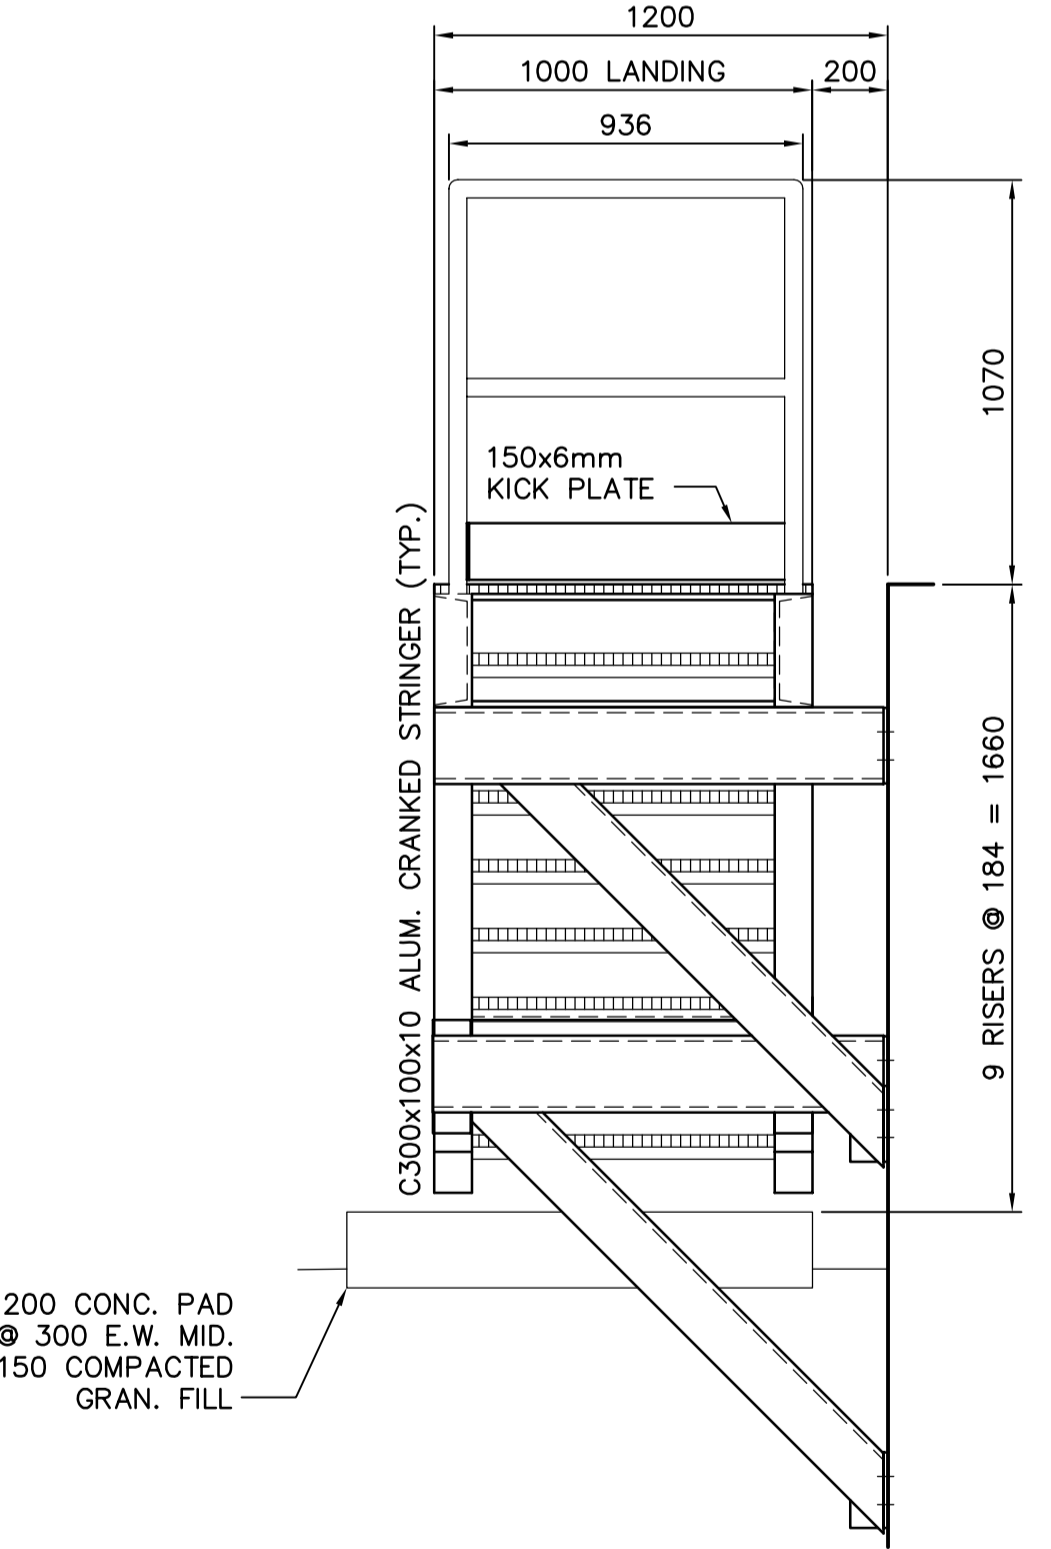


7 STAIR #2 ELEVATION
S3.07 SCALE 1:20

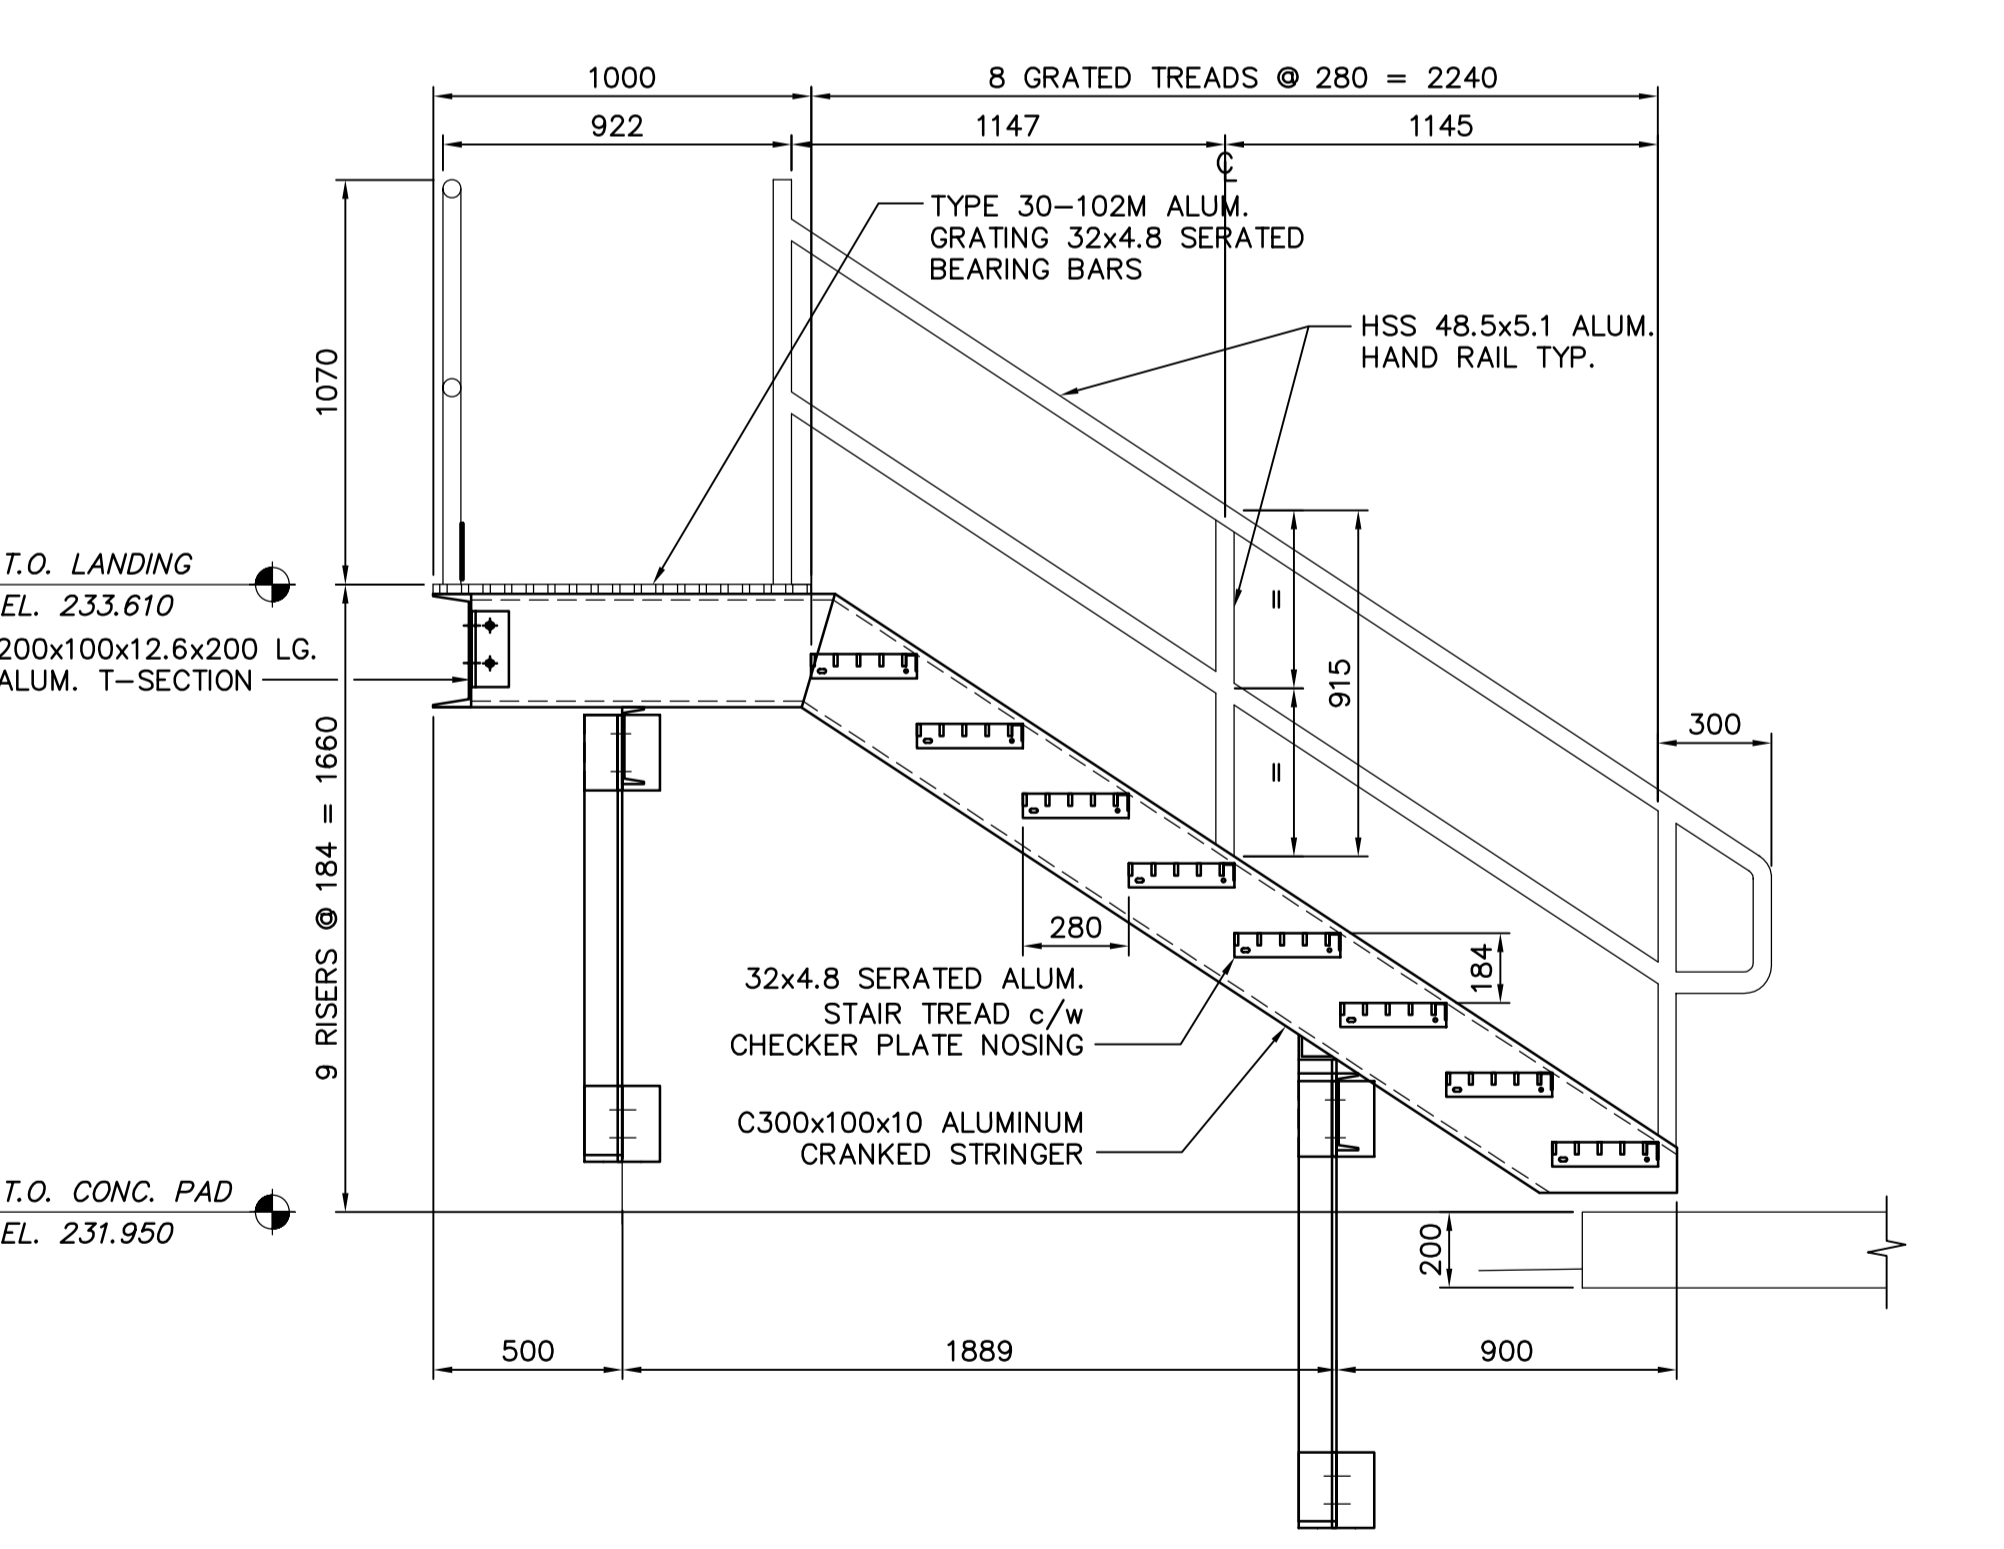


8 STAIR #2 SECTION
S3.07 SCALE 1:20

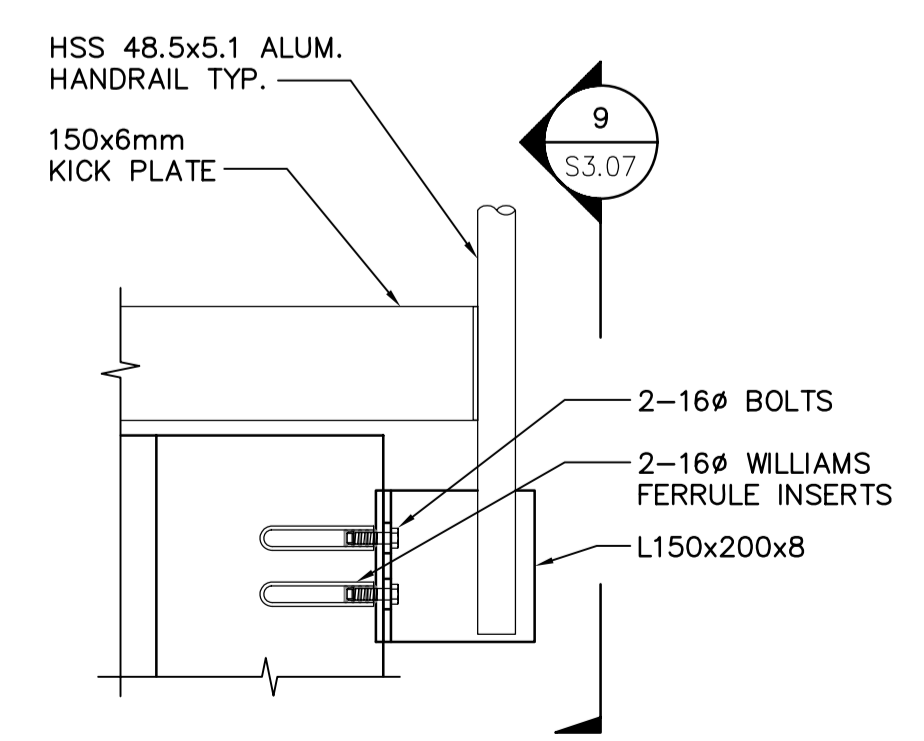

A DETAIL
S3.05 SCALE 1:10

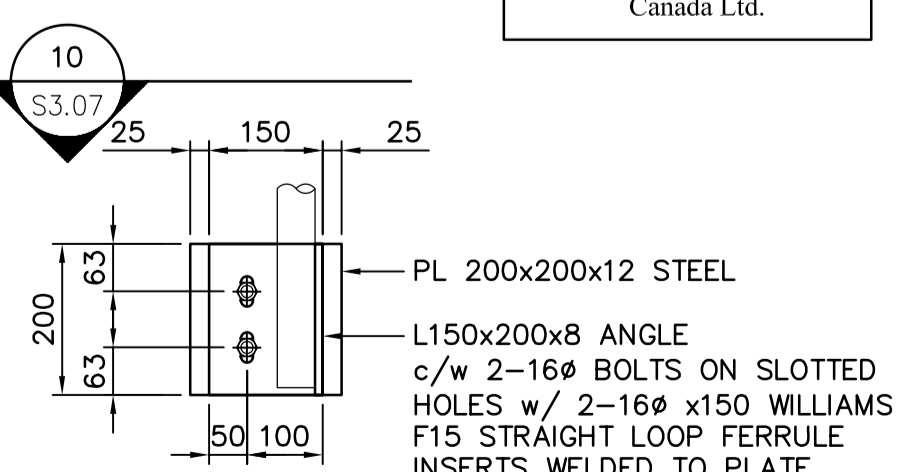

9 SECTION
S3.07 SCALE 1:10

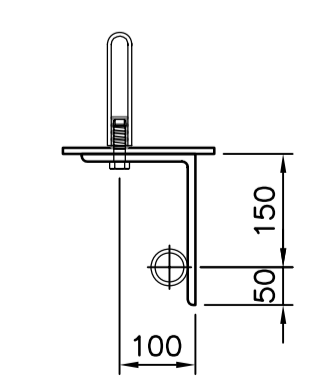












10 PLAN
S3.07 SCALE 1:10

AECOM
As of January 3, 2009, EarthTech became AECOM Canada Ltd.


AECOM AS-CONSTRUCTED
SIG..... DATE.....

200x1200x1200 CONC. PAD REINF.: 10M @ 300 E.W. MID. ON MIN. 150 COMPACTED GRAN. FILL

 Certificate of Authorization AECOM Canada Ltd. Original dated on: No. 4671 Date: 2006/05/15	B.M. ELEV.	 A Tyco International Ltd. Company	ENGINEER'S SEAL	 THE CITY OF WINNIPEG WATER AND WASTE DEPARTMENT ENGINEERING DIVISION NEWPCC CENTRATE NUTRIENT TREATMENT NITROGEN REMOVAL FACILITY STRUCTURAL SBR BUILDING STAIR PLANS, SECTIONS & DETAILS	CITY FILE NUMBER		
			DESIGNED BY LLR		CHECKED BY GGP	ORIGINAL SIGNED BY L.L. RIDING	SHEET OF
			DRAWN BY WDB/GGP		APPROVED BY JEH	2006/05/15	CITY DRAWING NUMBER
			SCALE: AS NOTED		RELEASED FOR CONSTRUCTION BY: K. MARTENS	CONSULTANT DRAWING NO. S3.07	1-0101C-S0013-001-03
	NO. REVISIONS	DATE	DATE				

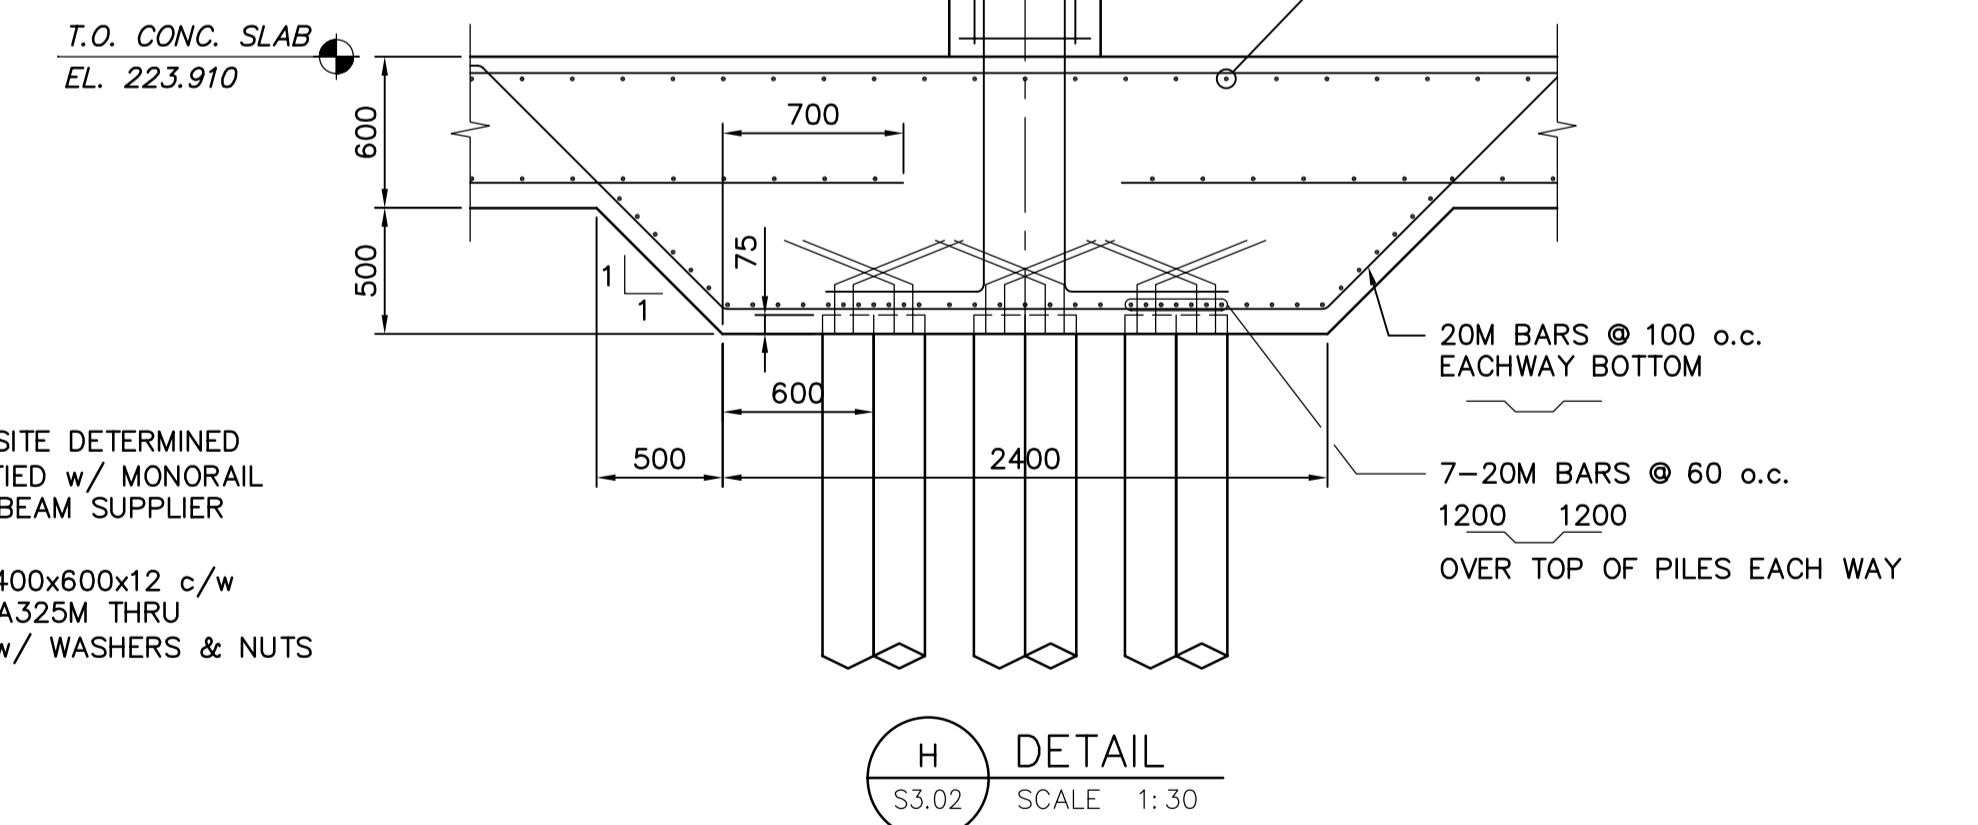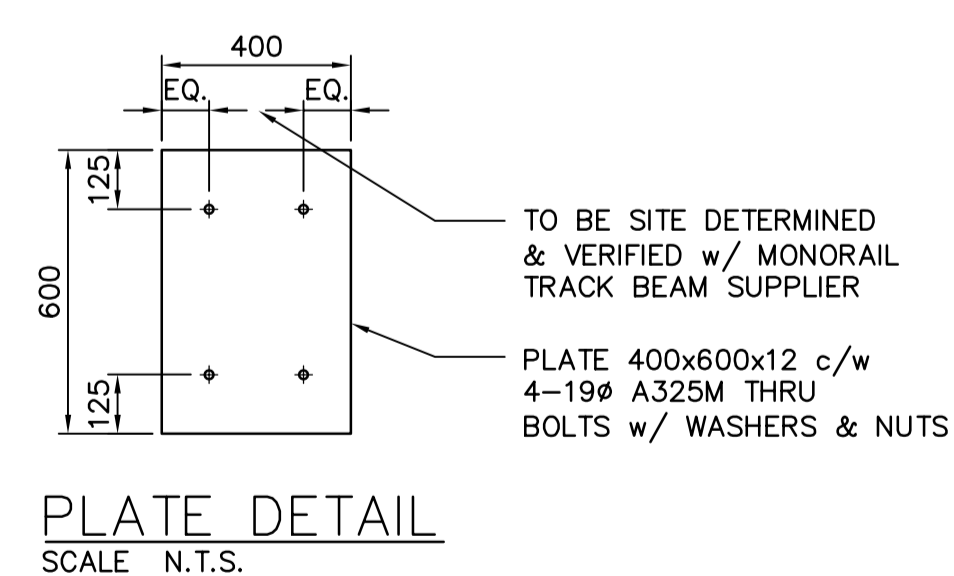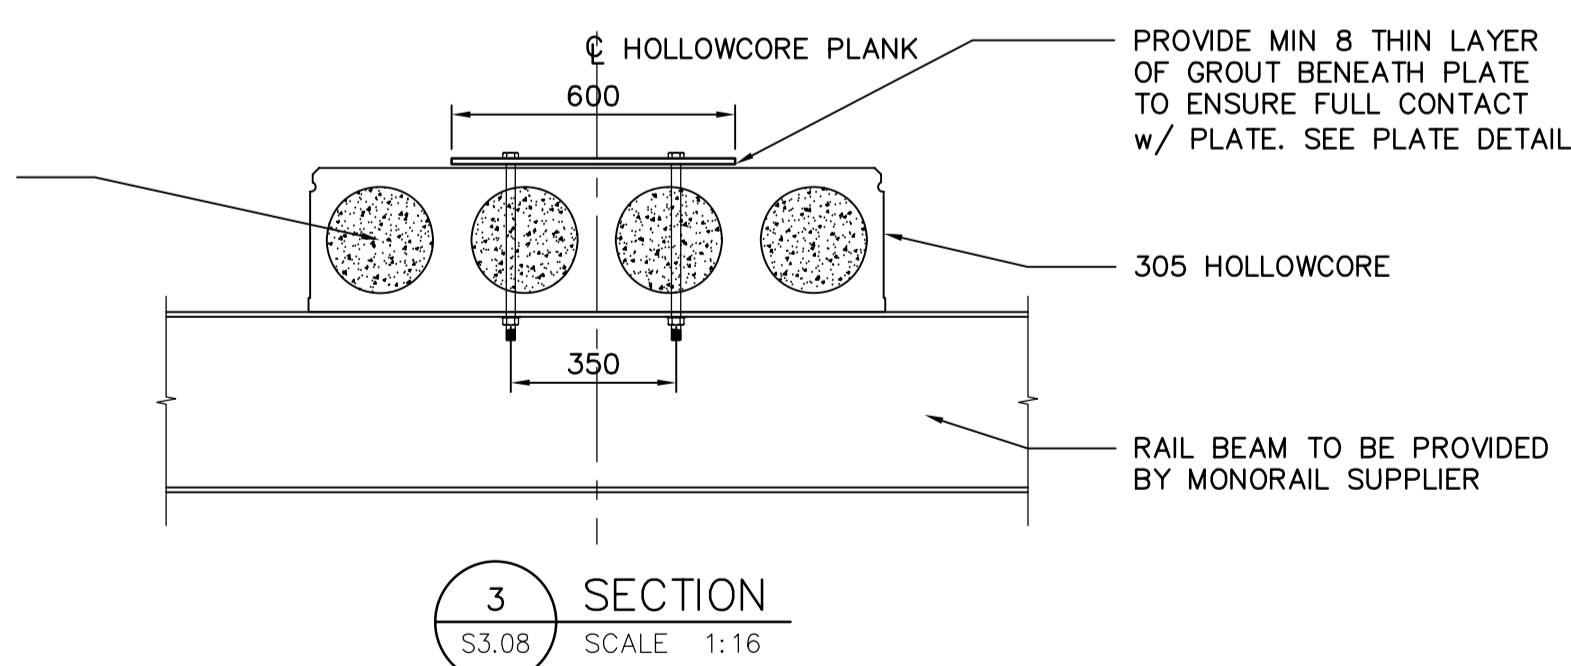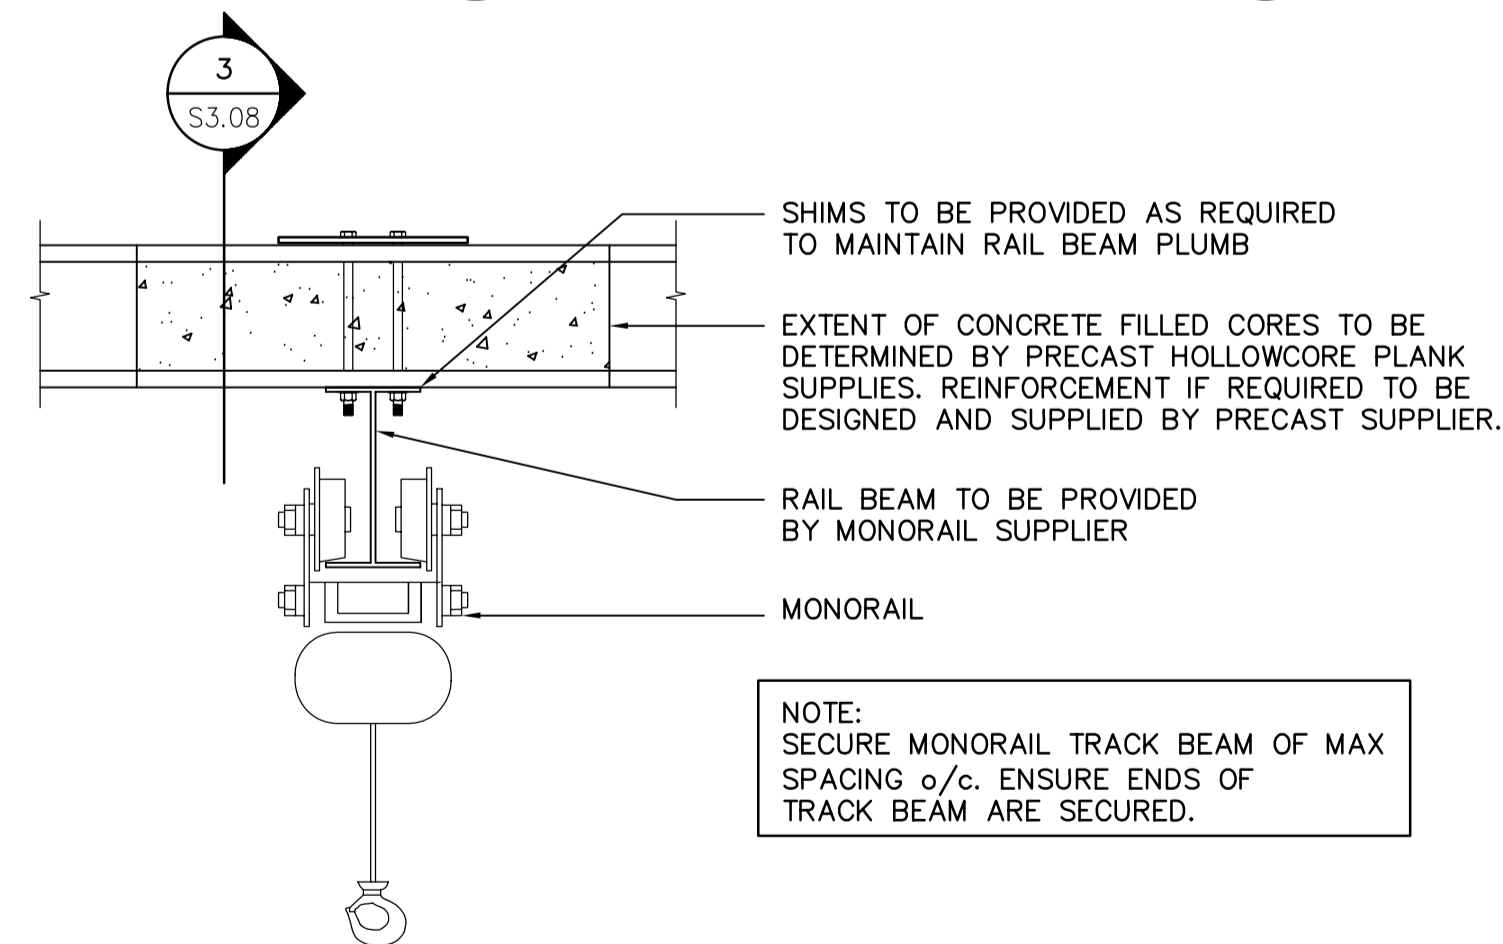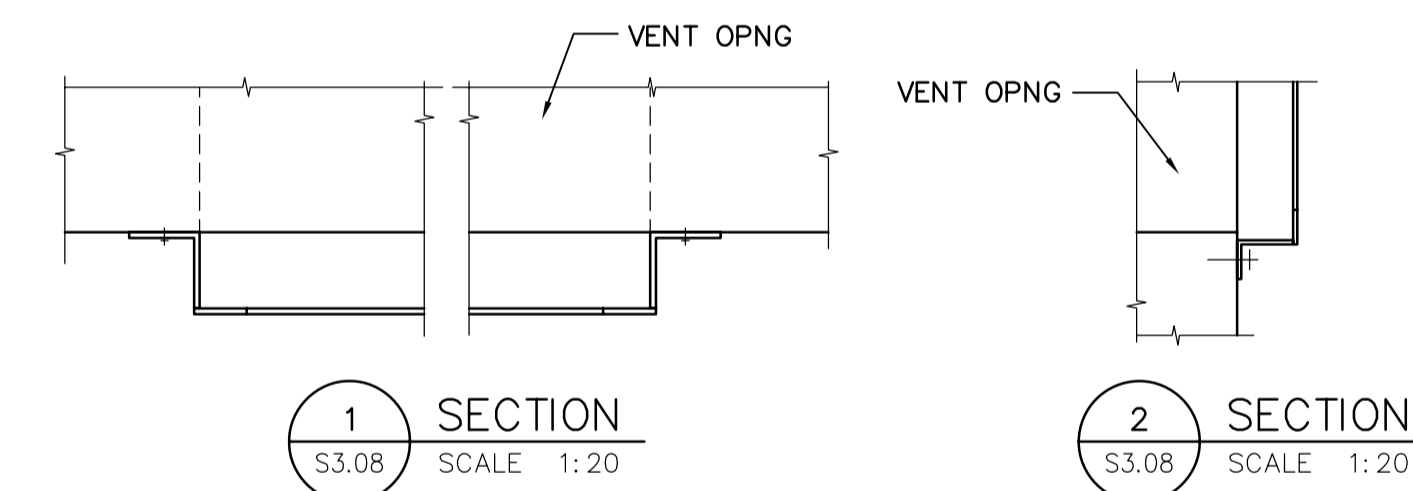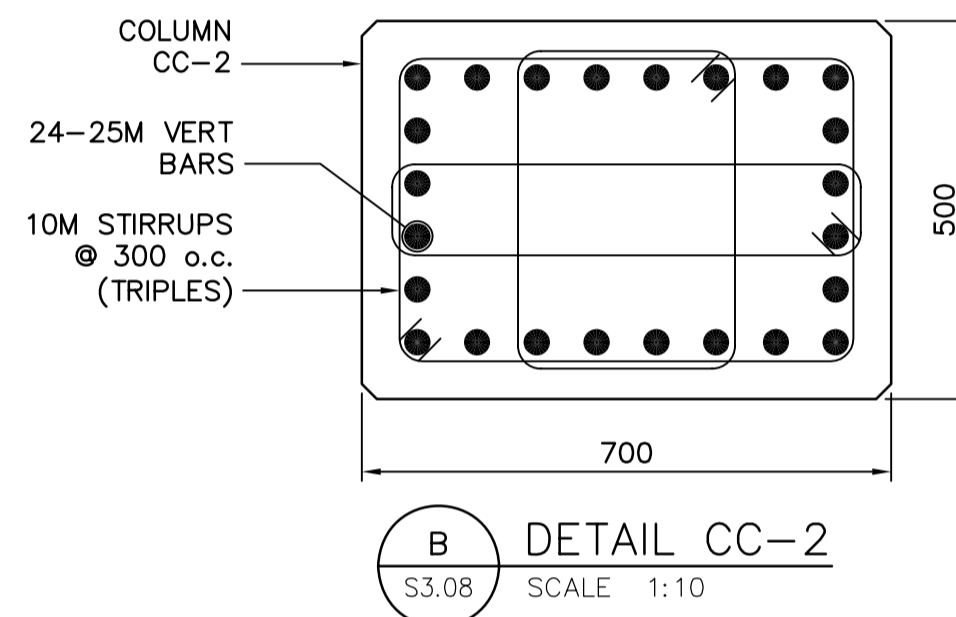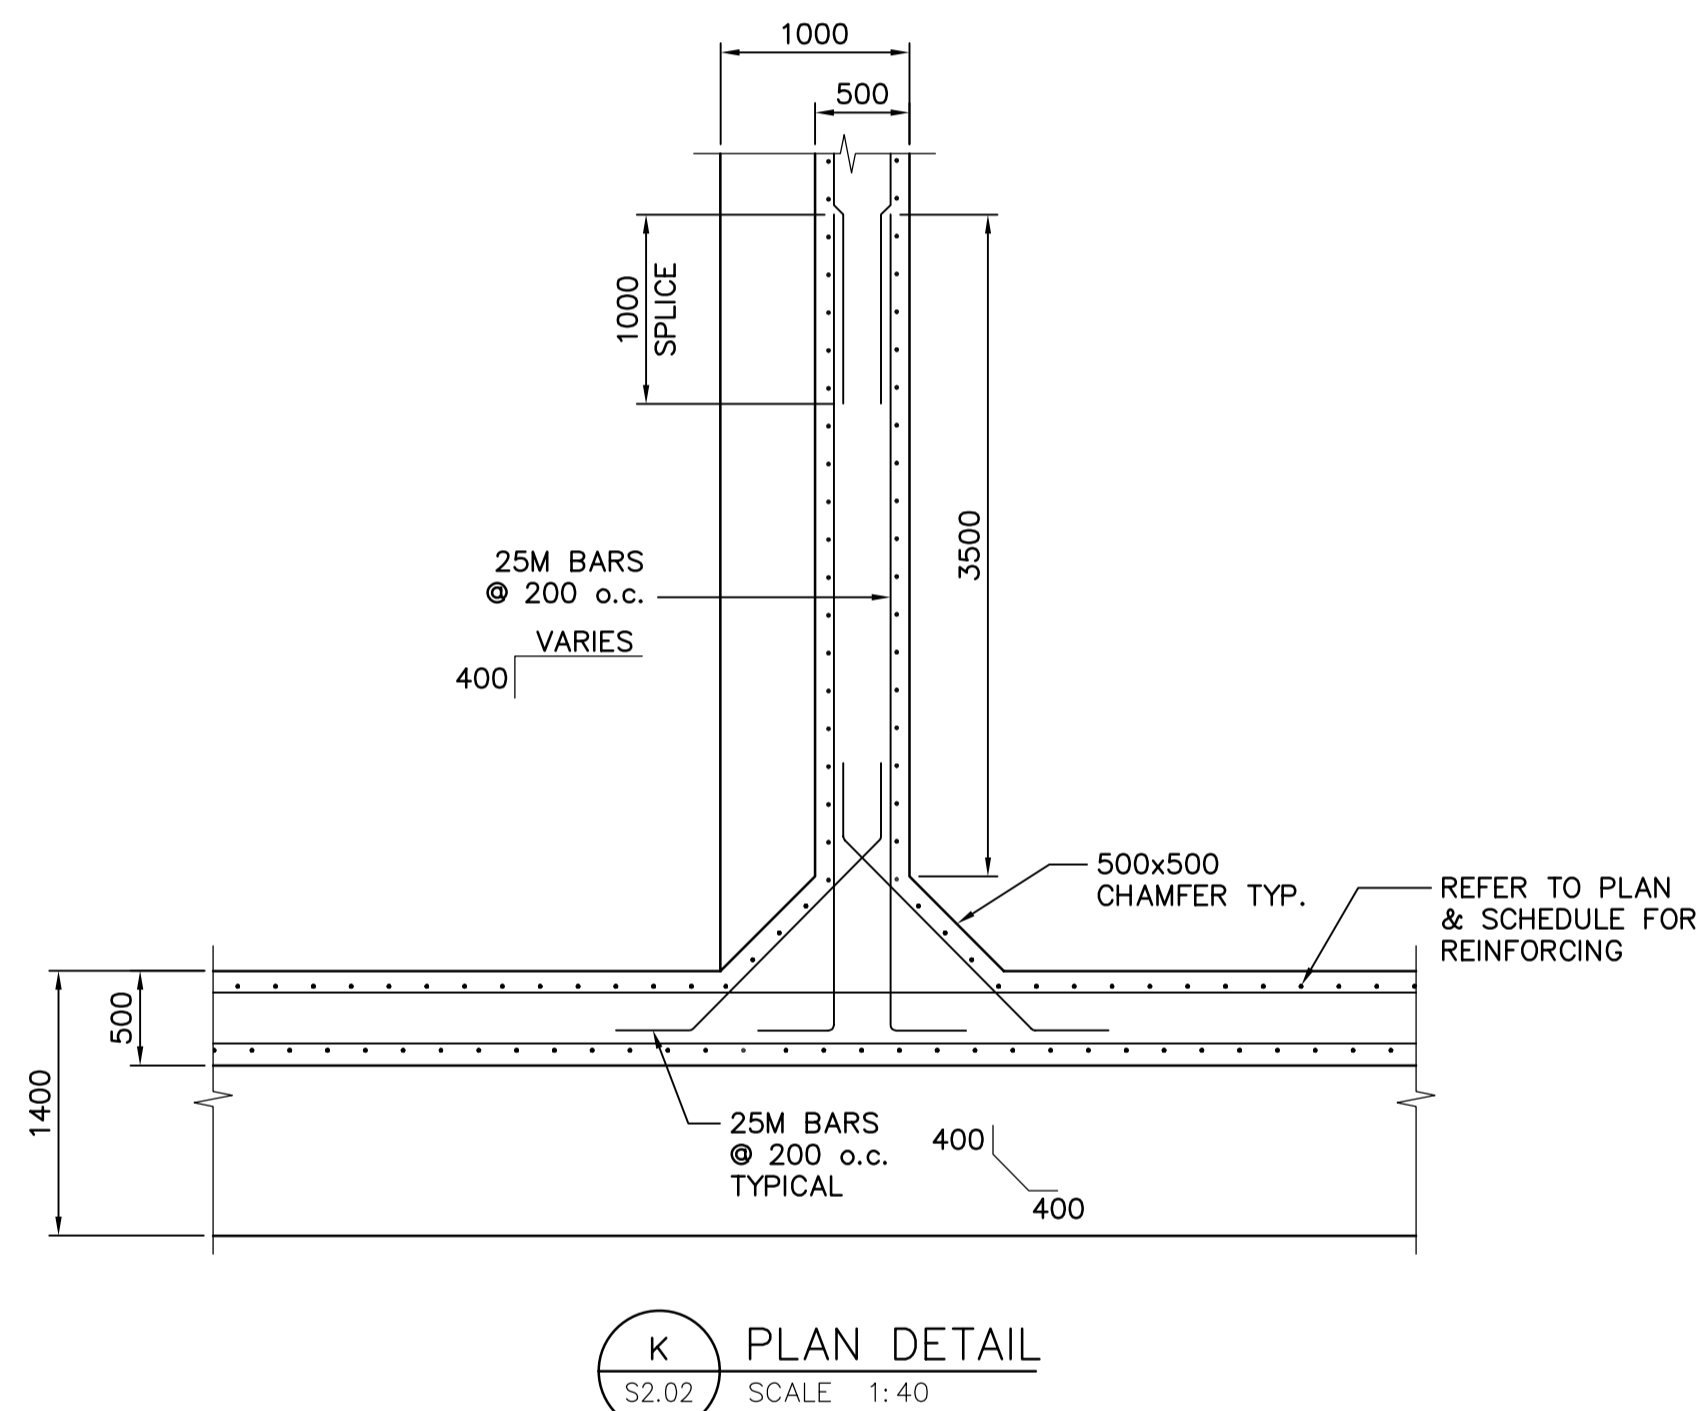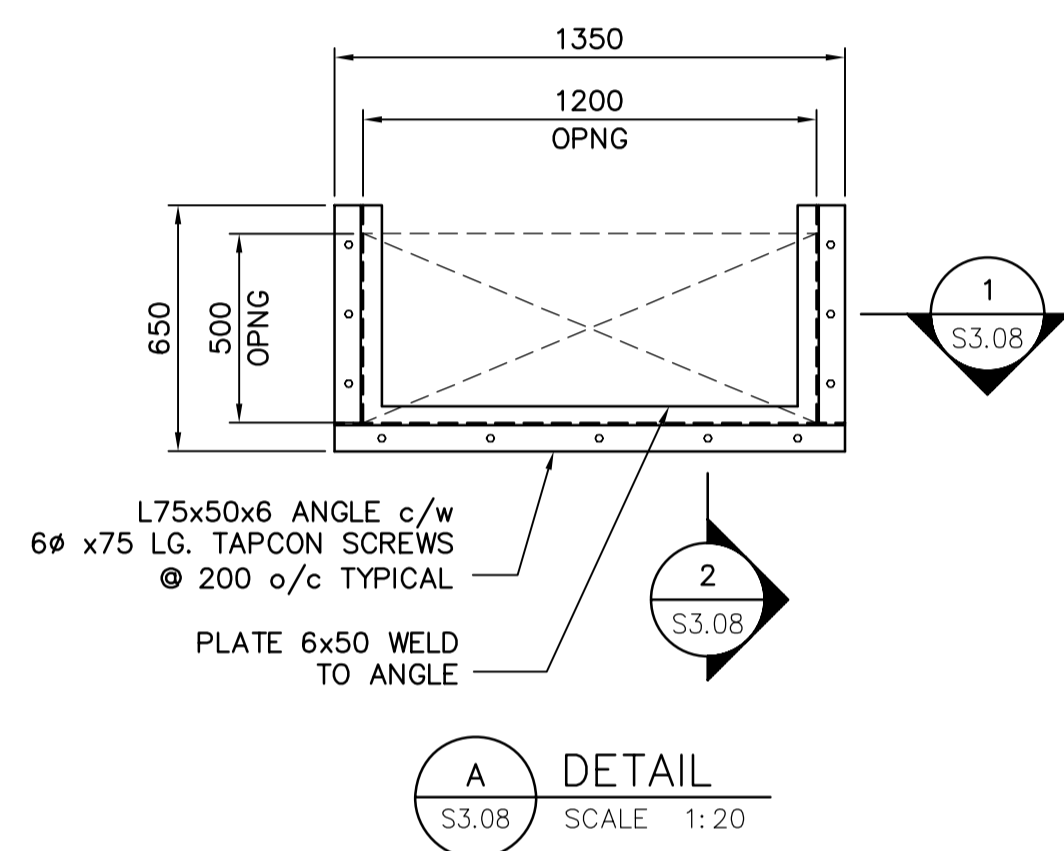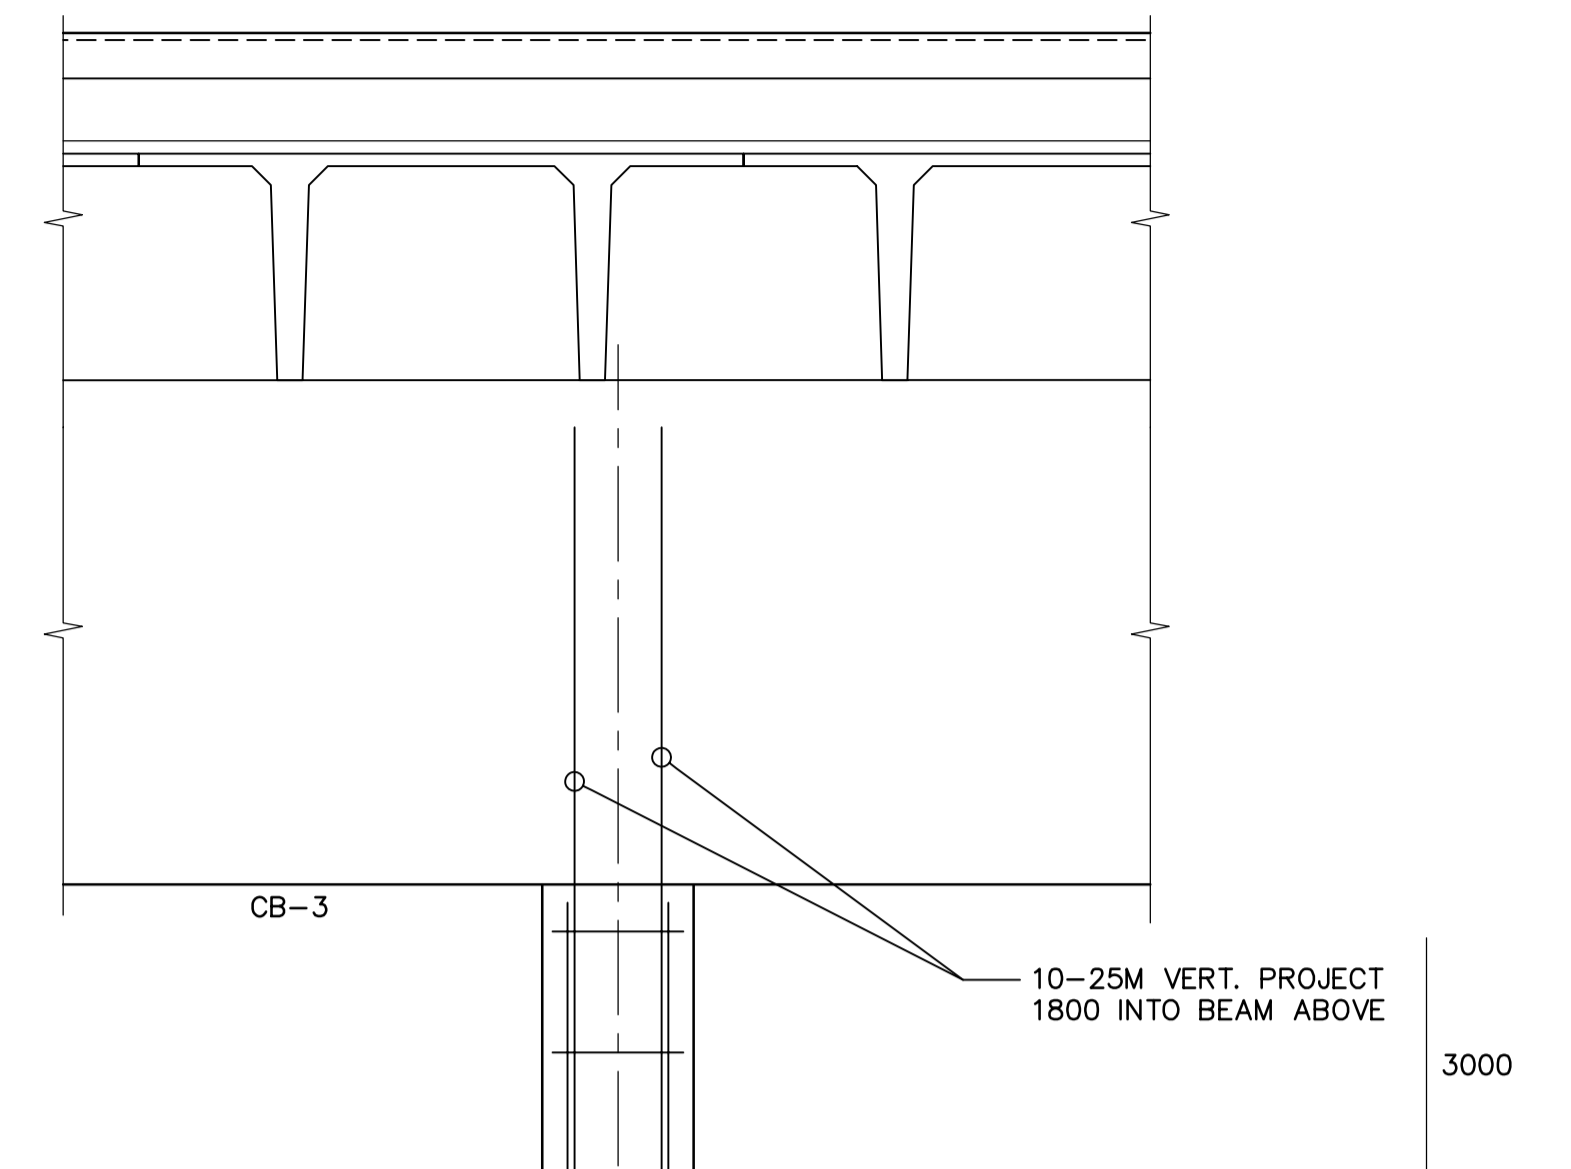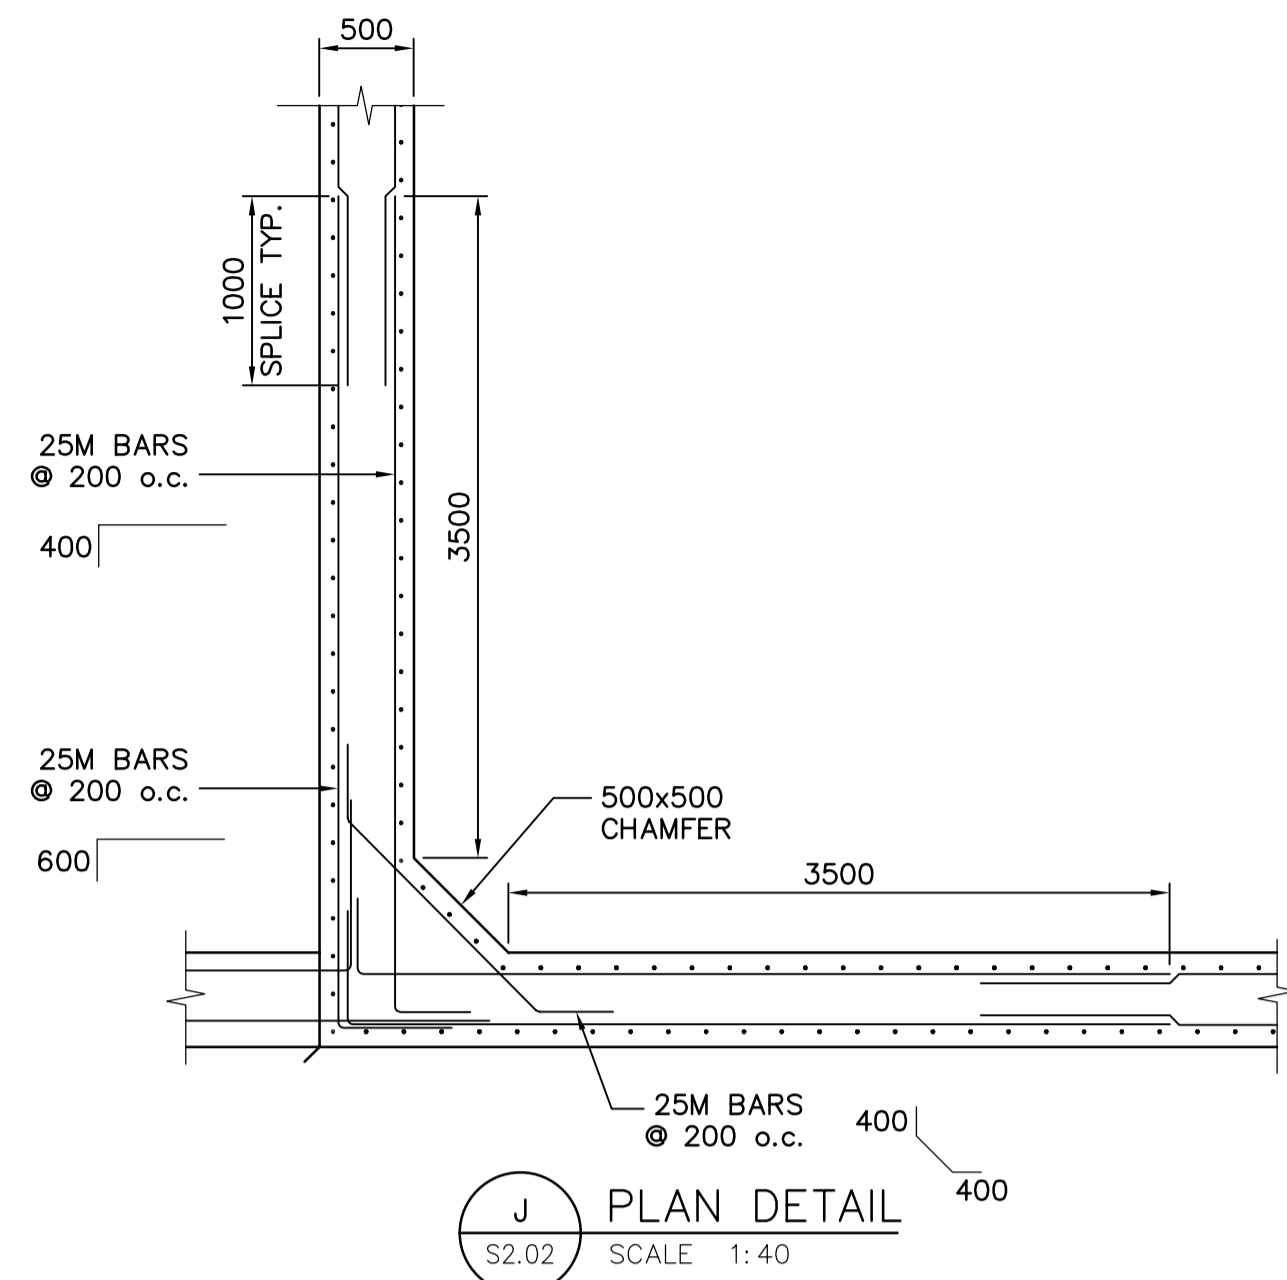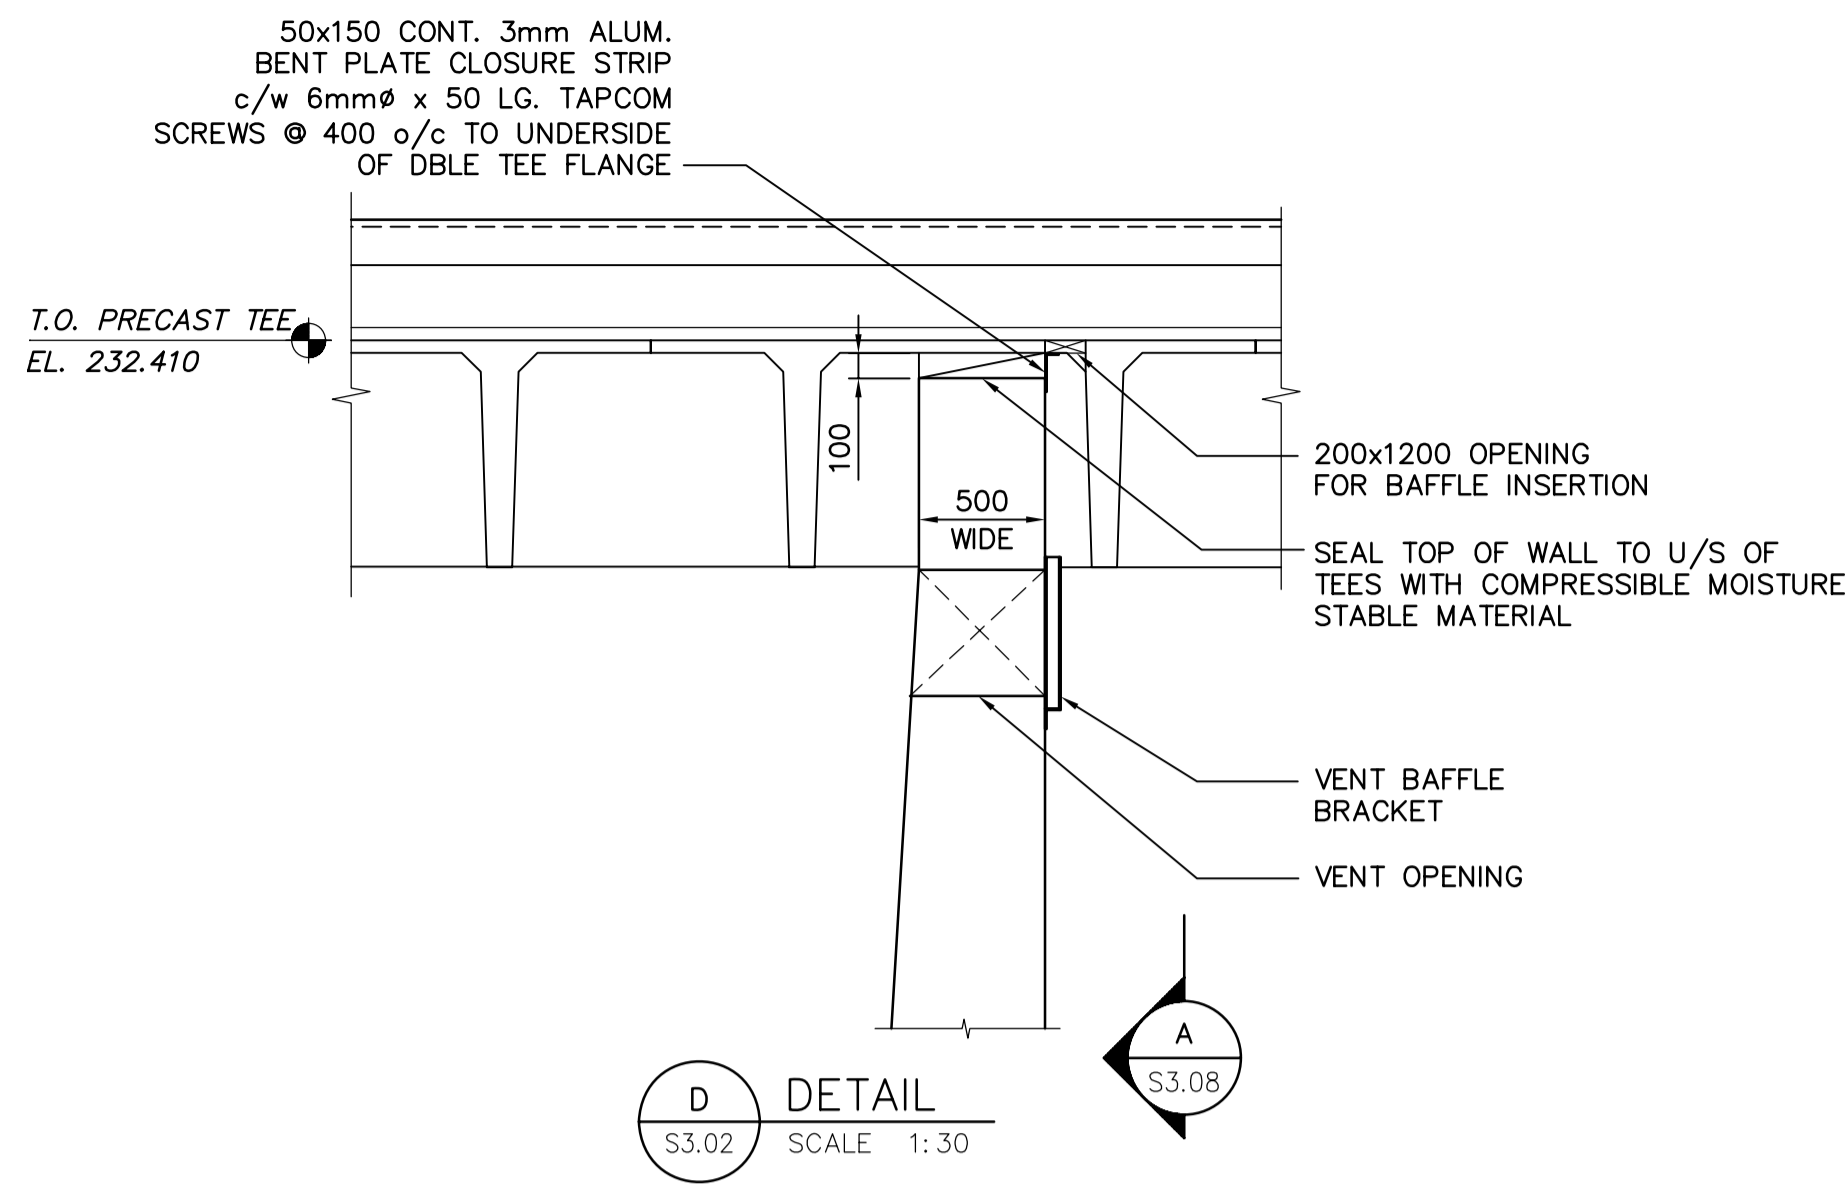

L DETAIL
S3.02 SCALE N.T.S.

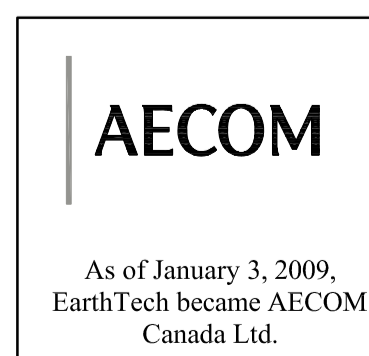

AECOM AS-CONSTRUCTED
SIG..... DATE.....



NO.	REVISIONS	DATE	BY
02	AS-CONSTRUCTED DRAWING	09/04/09	RJH
01	ISSUED FOR CONSTRUCTION	06/08/30	GLG
00	ISSUED FOR TENDER	06/05/15	WDB

EarthTech A Tyco International Ltd. Company	
DESIGNED BY: LLR	CHECKED BY: GGP
DRAWN BY: WDB	APPROVED BY: JEH
SCALE: AS NOTED	RELEASED FOR CONSTRUCTION BY: K. MARTENS
DATE: 2006/04/22	DATE: 2006/05/15






ENGINEER'S SEAL
ORIGINAL SIGNED BY: L.L. RIDING
DATE: 2006/05/15
CONSULTANT DRAWING NO. S3.08

THE CITY OF WINNIPEG
Winnipeg WATER AND WASTE DEPARTMENT
ENGINEERING DIVISION




NEWPCC CENTRATE NUTRIENT TREATMENT NITROGEN REMOVAL FACILITY

STRUCTURAL
SBR BUILDING
BUILDING DETAILS & SECTIONS


CITY FILE NUMBER
SHEET OF
CITY DRAWING NUMBER
1-0101C-S0014-001-02

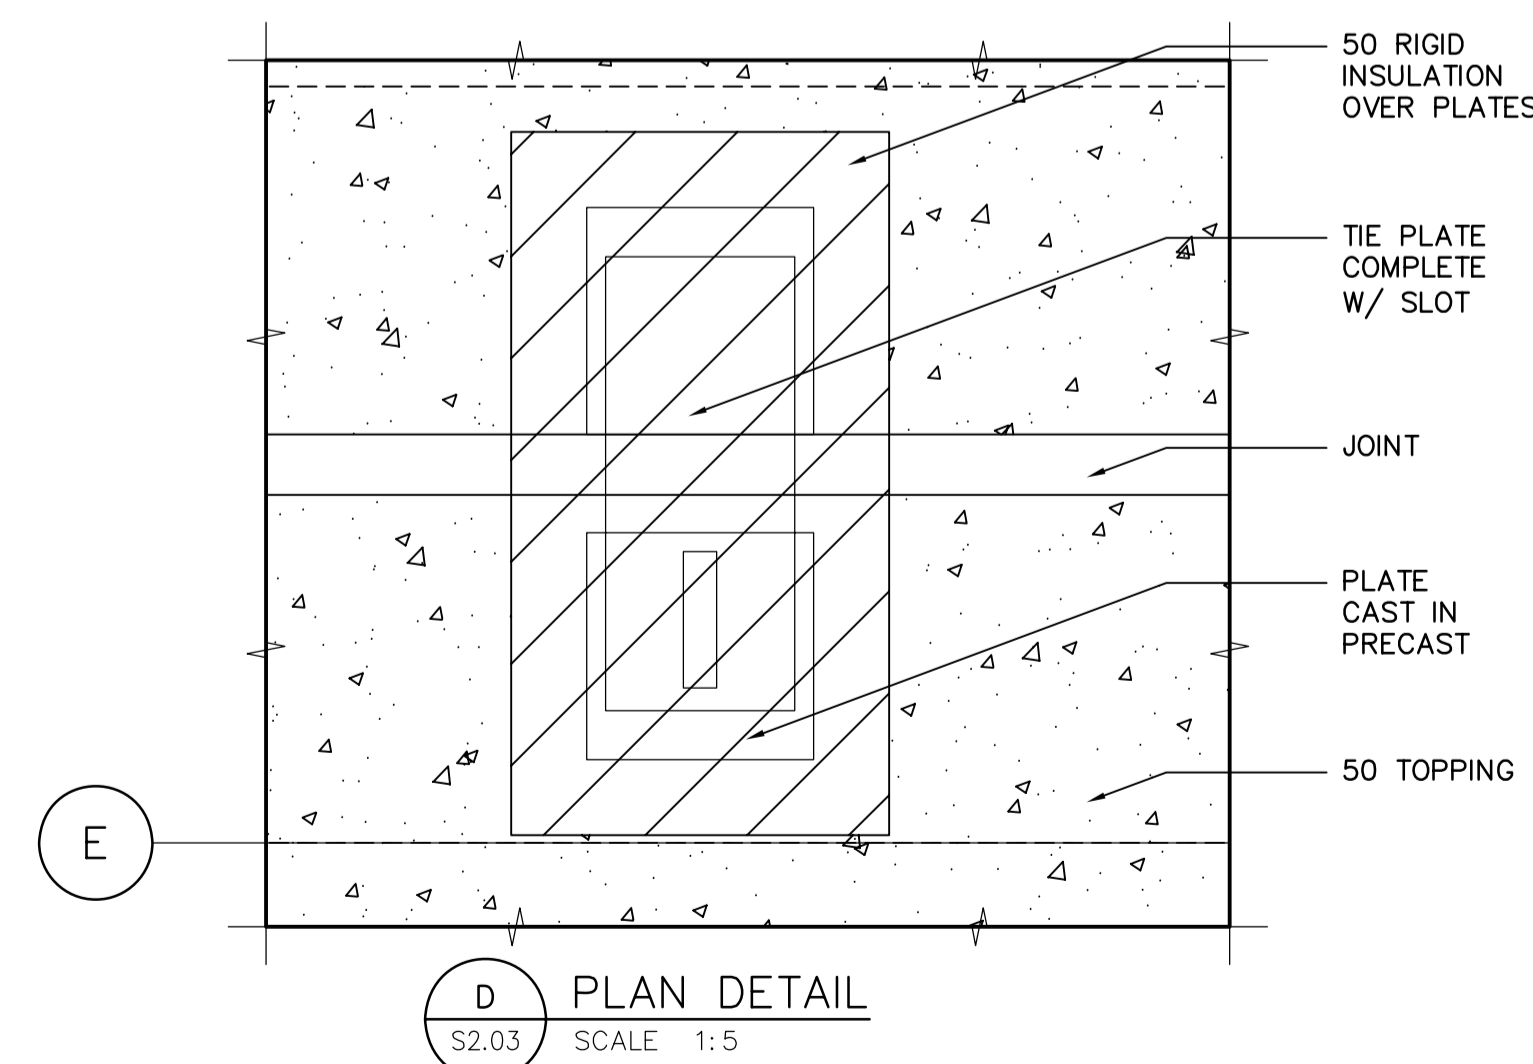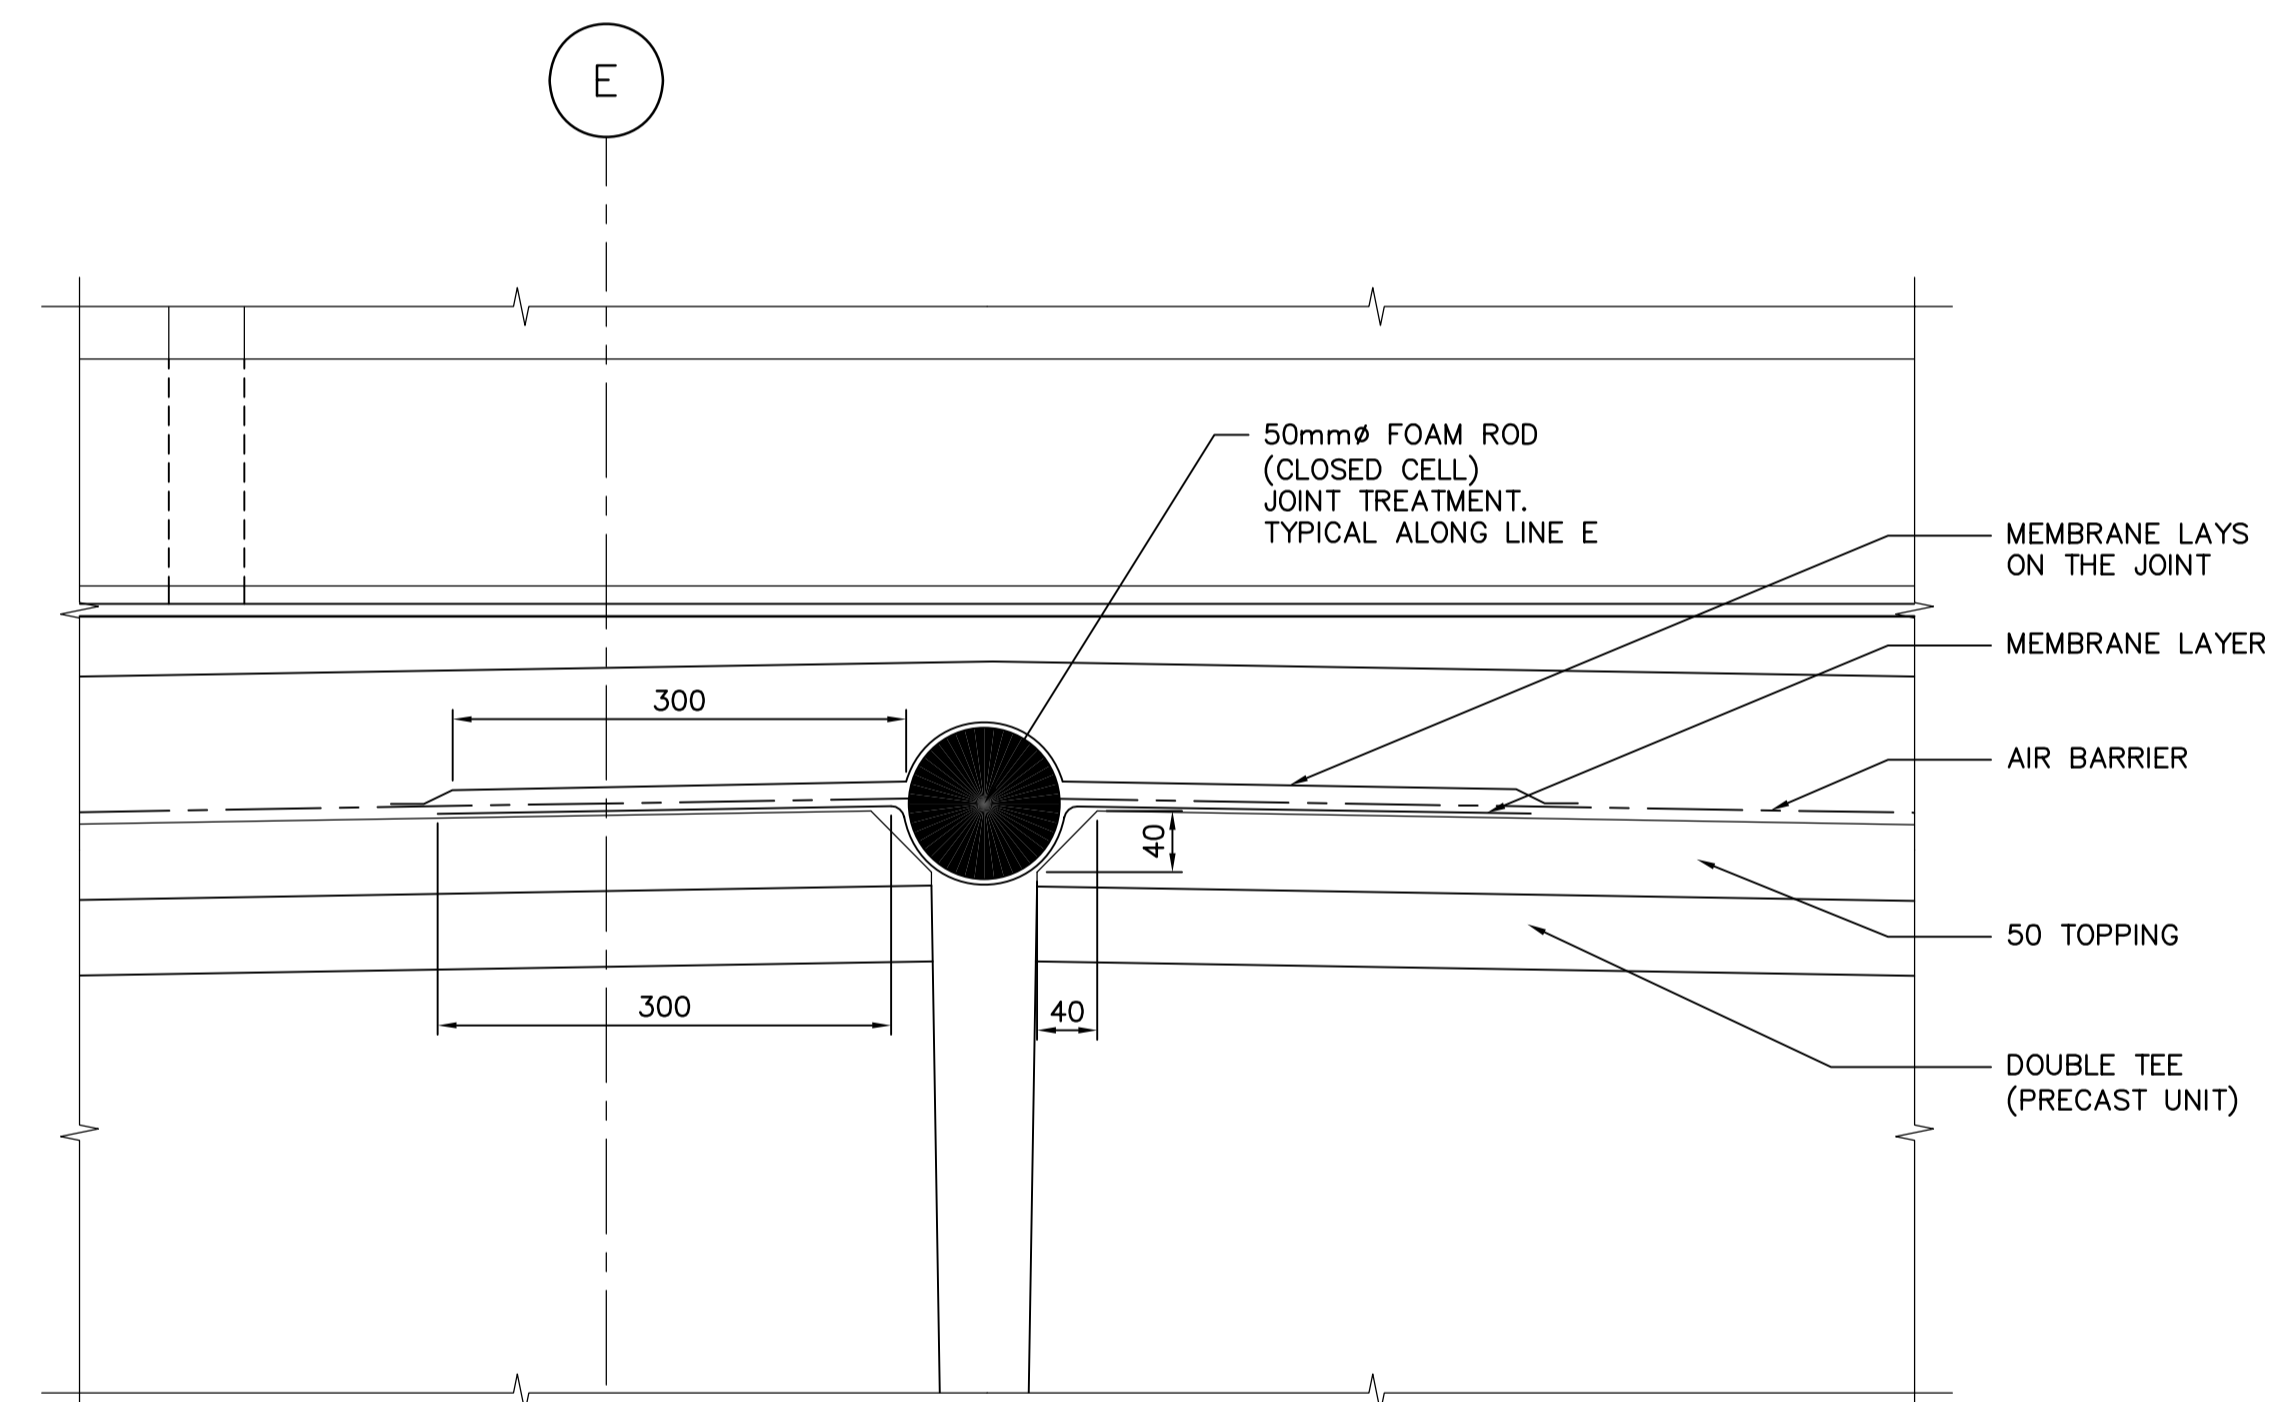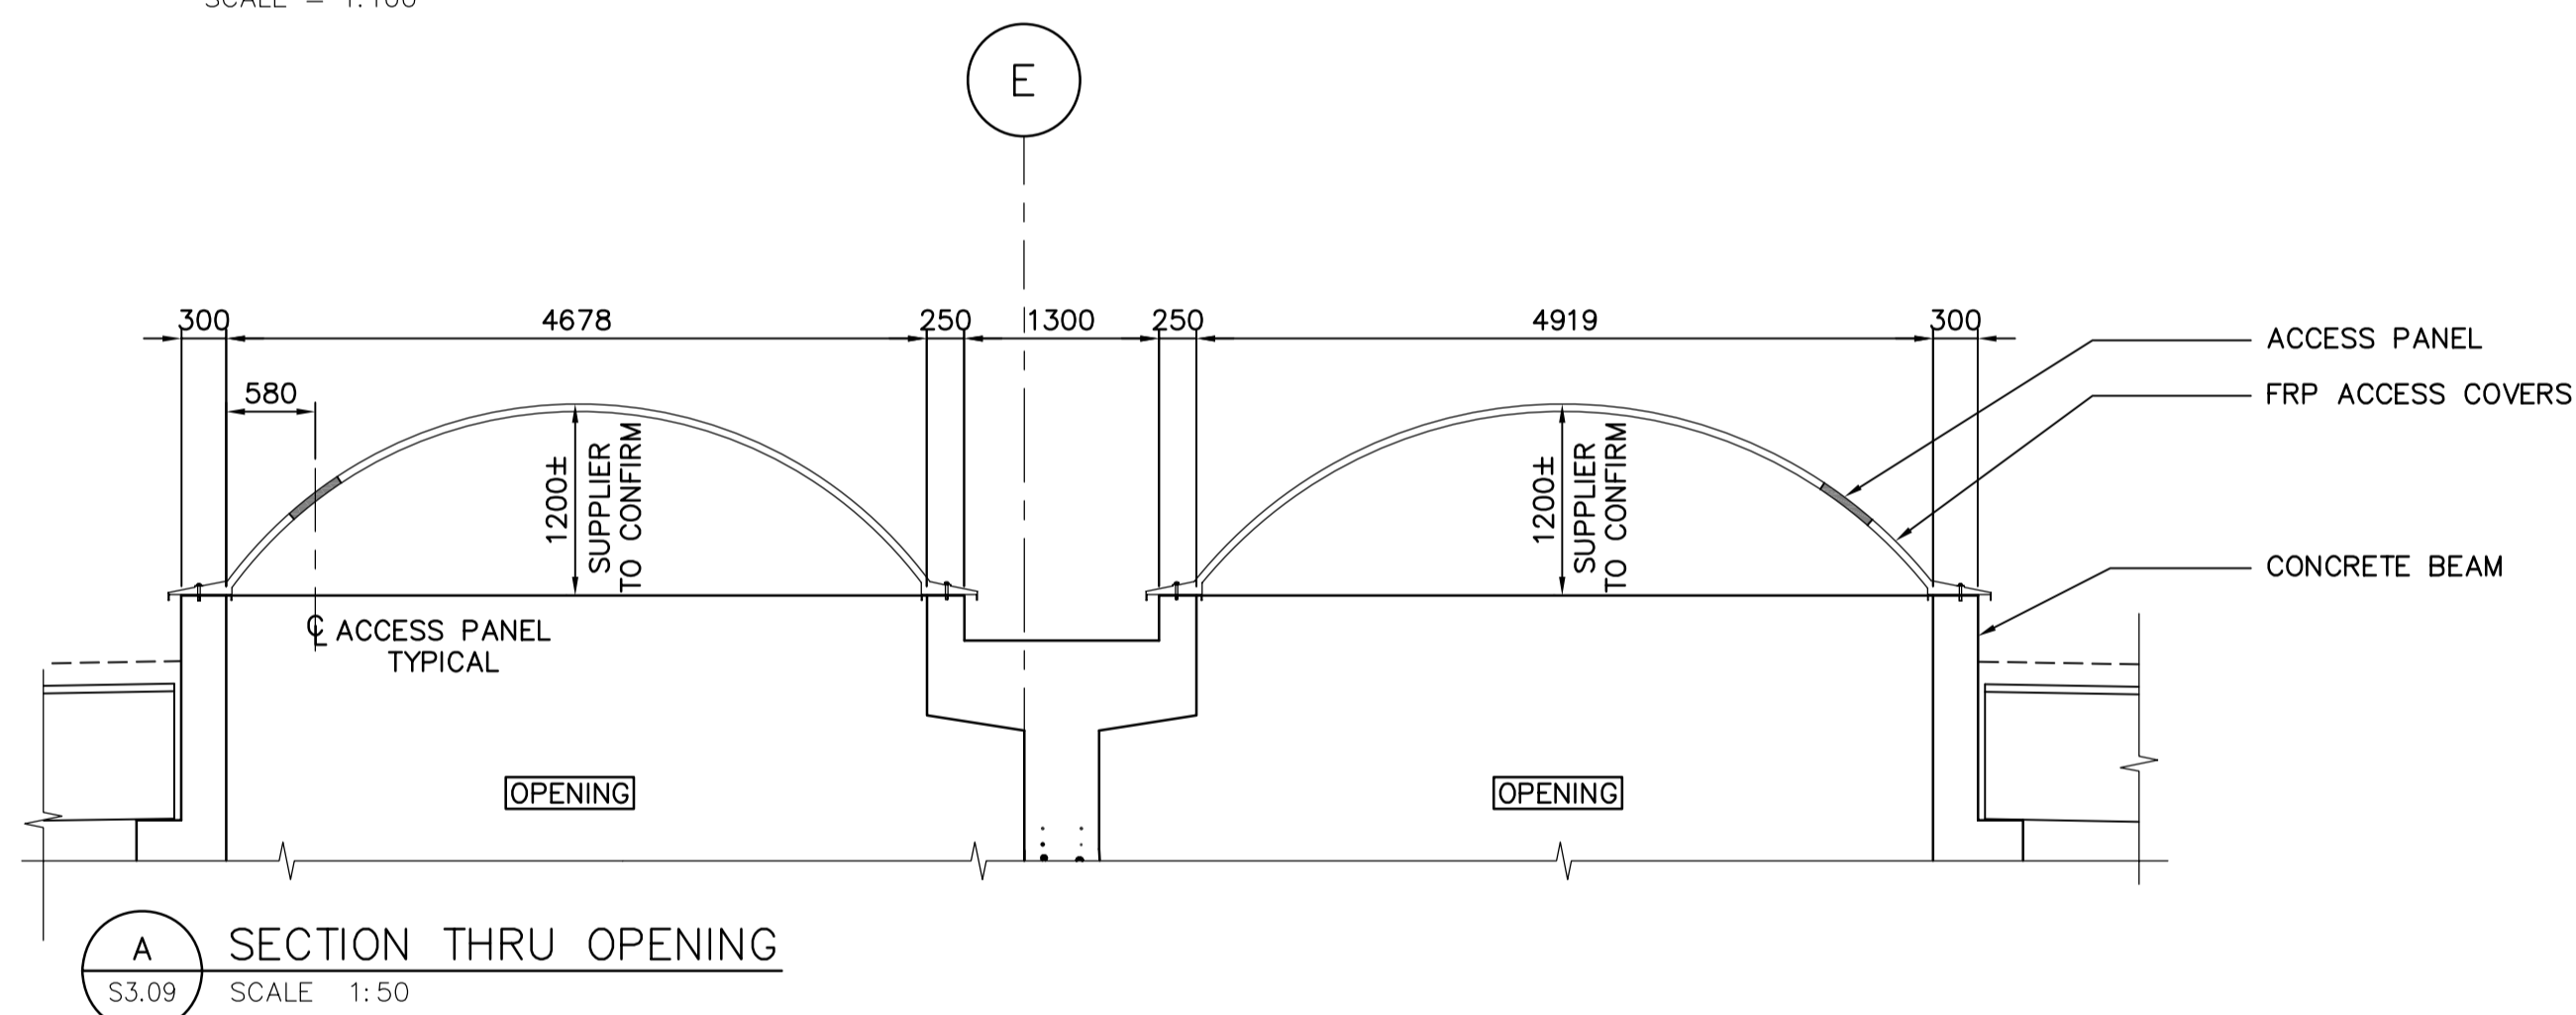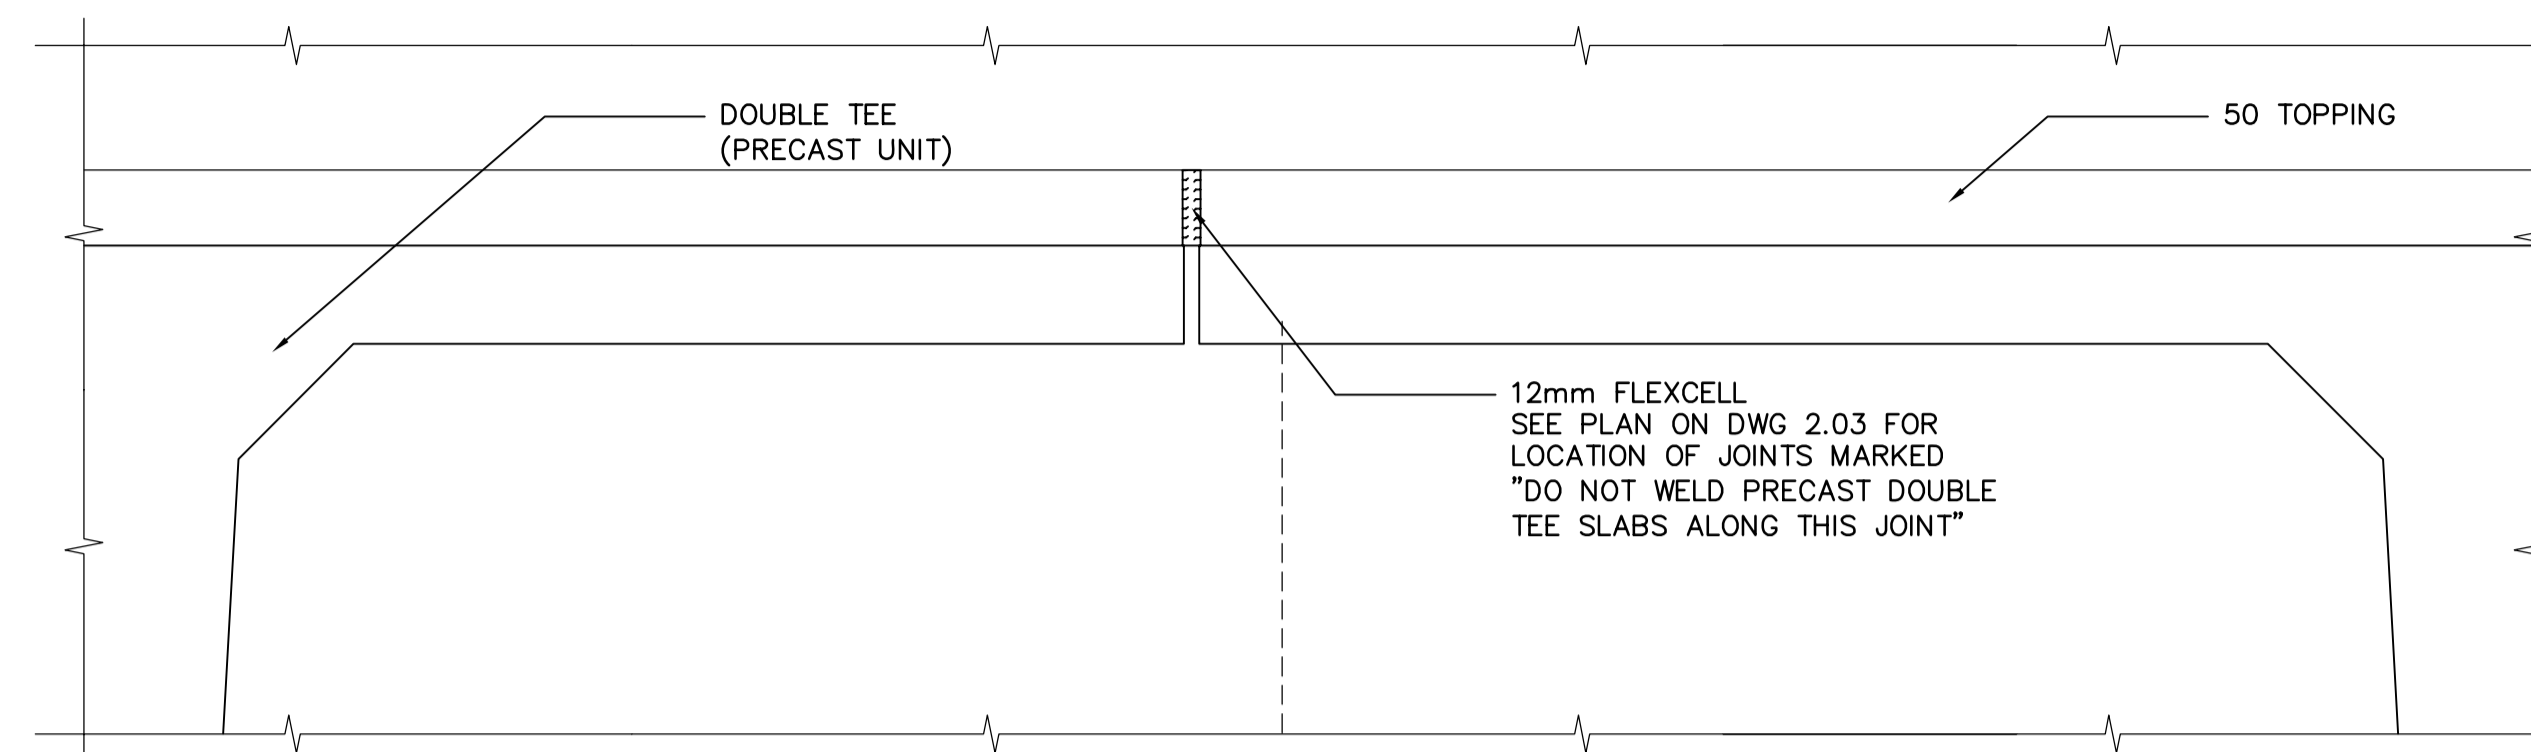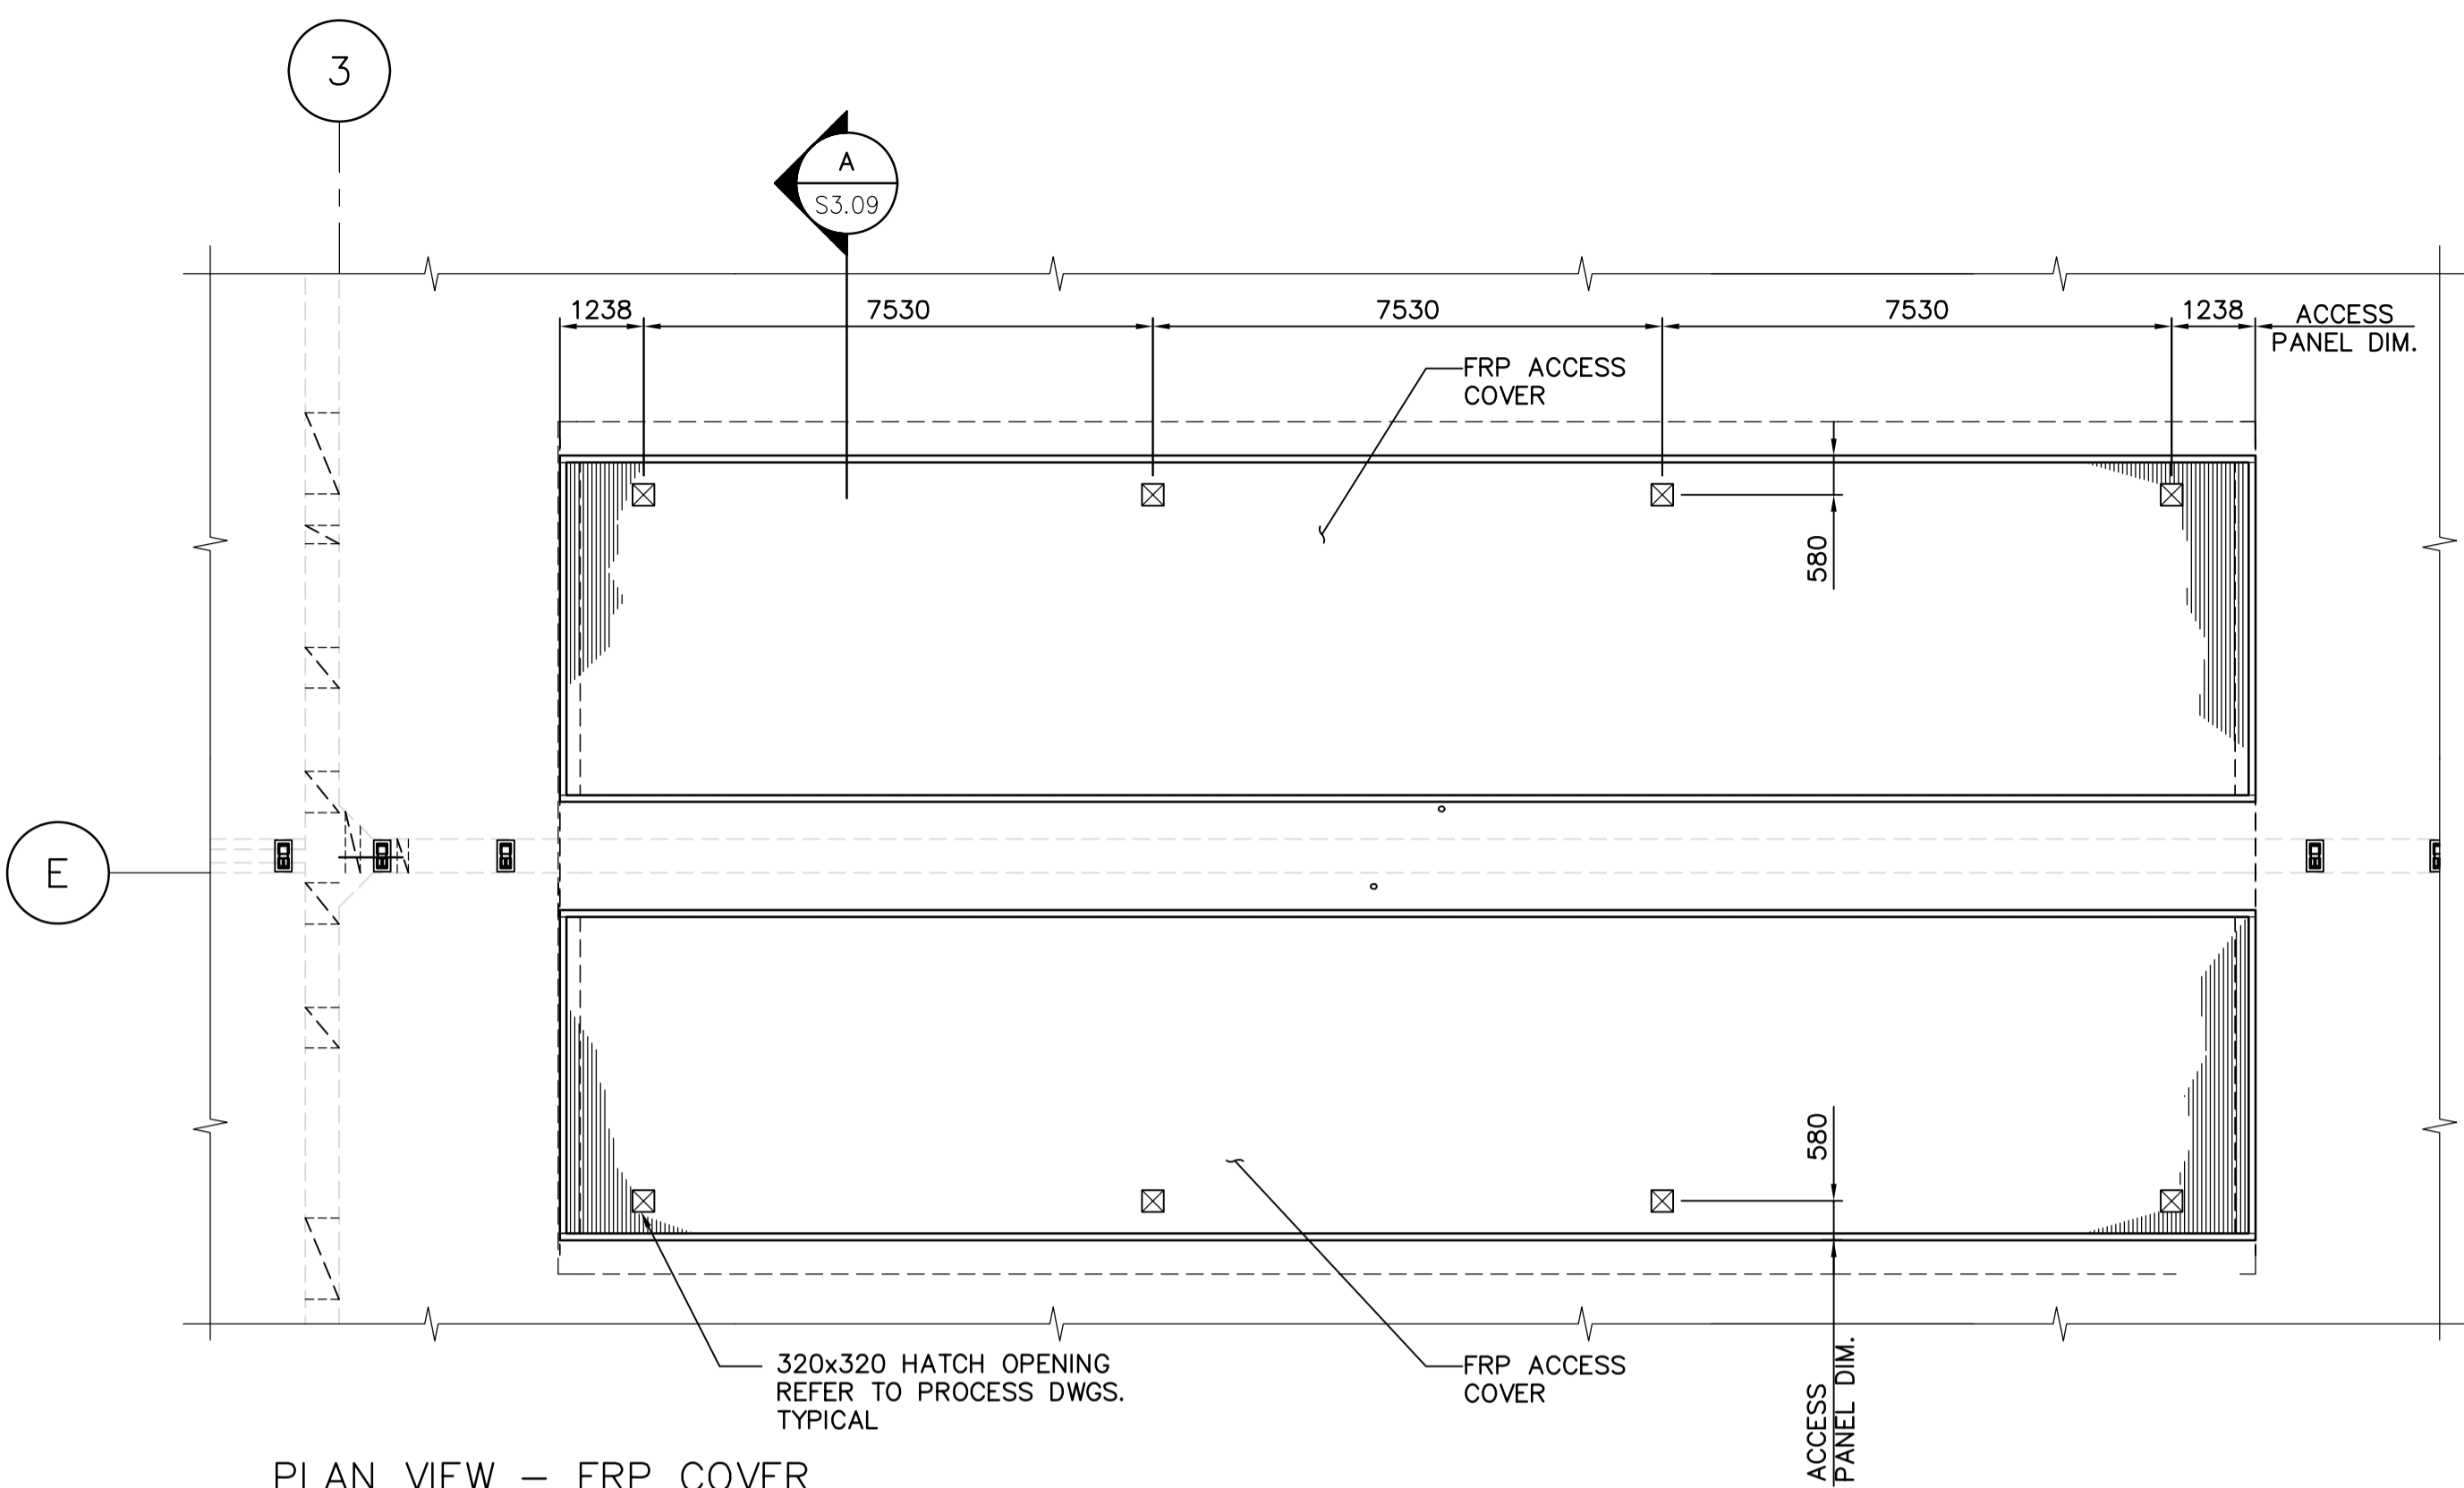


<p>As of January 3, 2009, EarthTech became AECOM Canada Ltd.</p>	<p>SIG..... DATE.....</p>	<p>Certificate of Authorization AECOM Canada Ltd. Original dated on: No. 4671 Date: 2006/05/15</p>	<p>A Tyco International Ltd. Company</p>		ENGINEER'S SEAL ORIGINAL SIGNED BY L.L. RIDING 2006/05/15	<p>THE CITY OF WINNIPEG WATER AND WASTE DEPARTMENT ENGINEERING DIVISION NEWPCC CENTRATE NUTRIENT TREATMENT NITROGEN REMOVAL FACILITY STRUCTURAL SBR BUILDING FRP COVER PLAN, SECTIONS & DETAILS</p>	CITY FILE NUMBER SHEET OF
			DESIGNED BY: LLR CHECKED BY: GGP DRAWN BY: K.K. APPROVED BY: JEH SCALE: AS NOTED RELEASED FOR CONSTRUCTION BY: K. MARTENS	CONSULTANT DRAWING NO. S3.09	CITY DRAWING NUMBER 1-0101C-S0015-001-04		
NO. REVISIONS DATE BY			DATE: 2006/04/22	DATE: 2006/05/15			

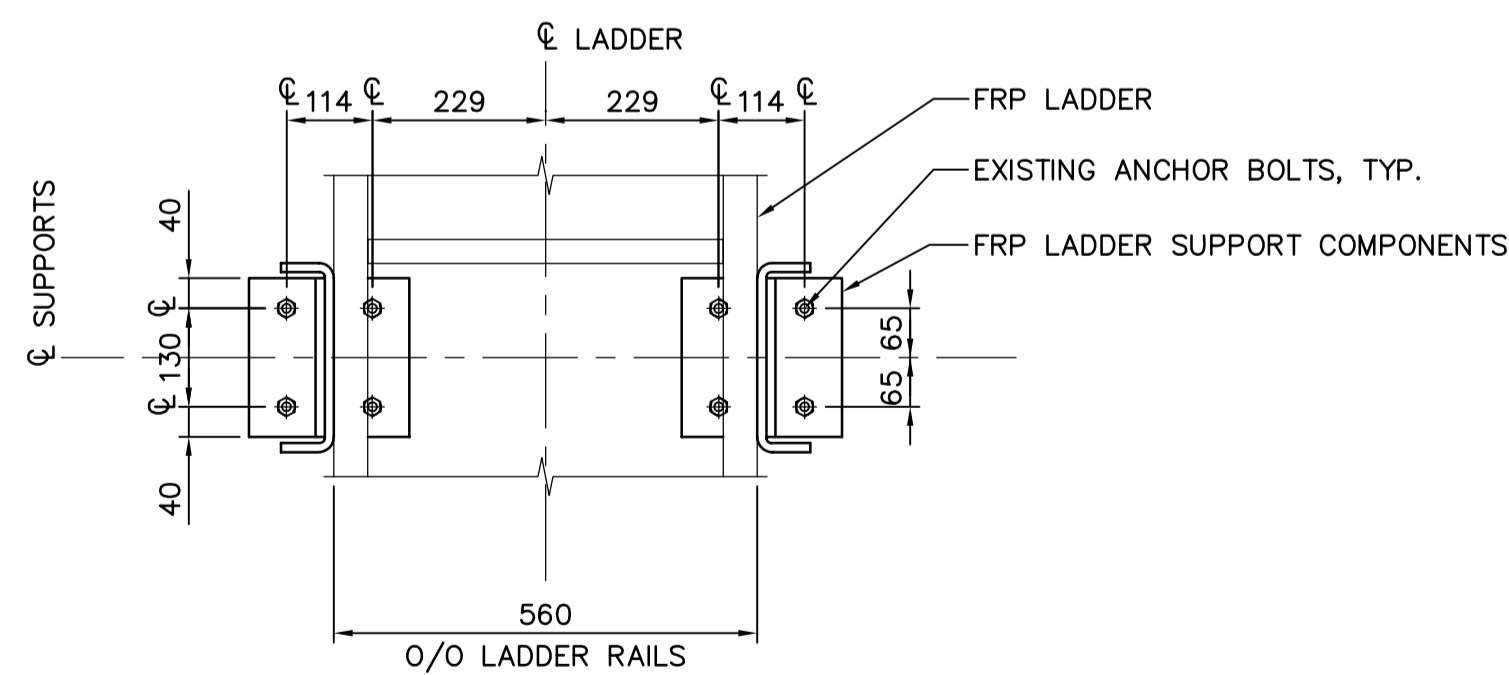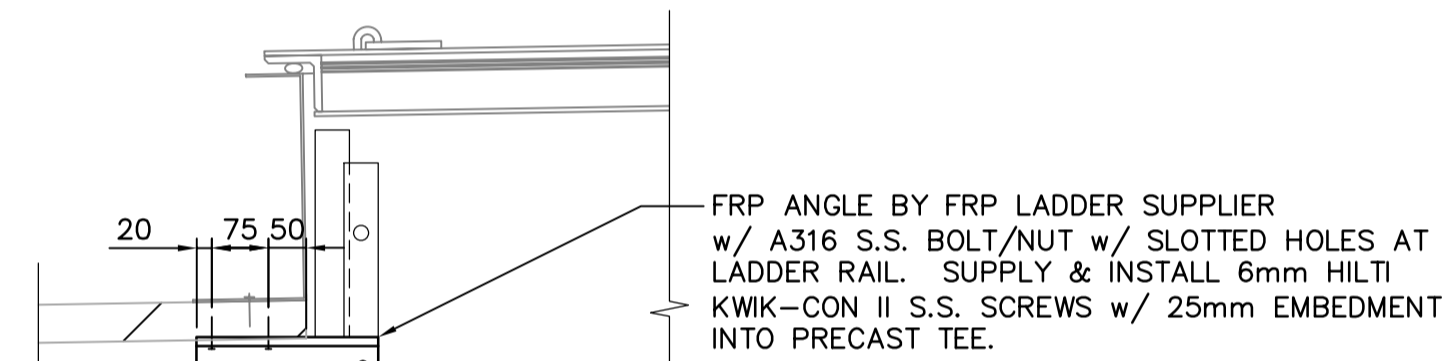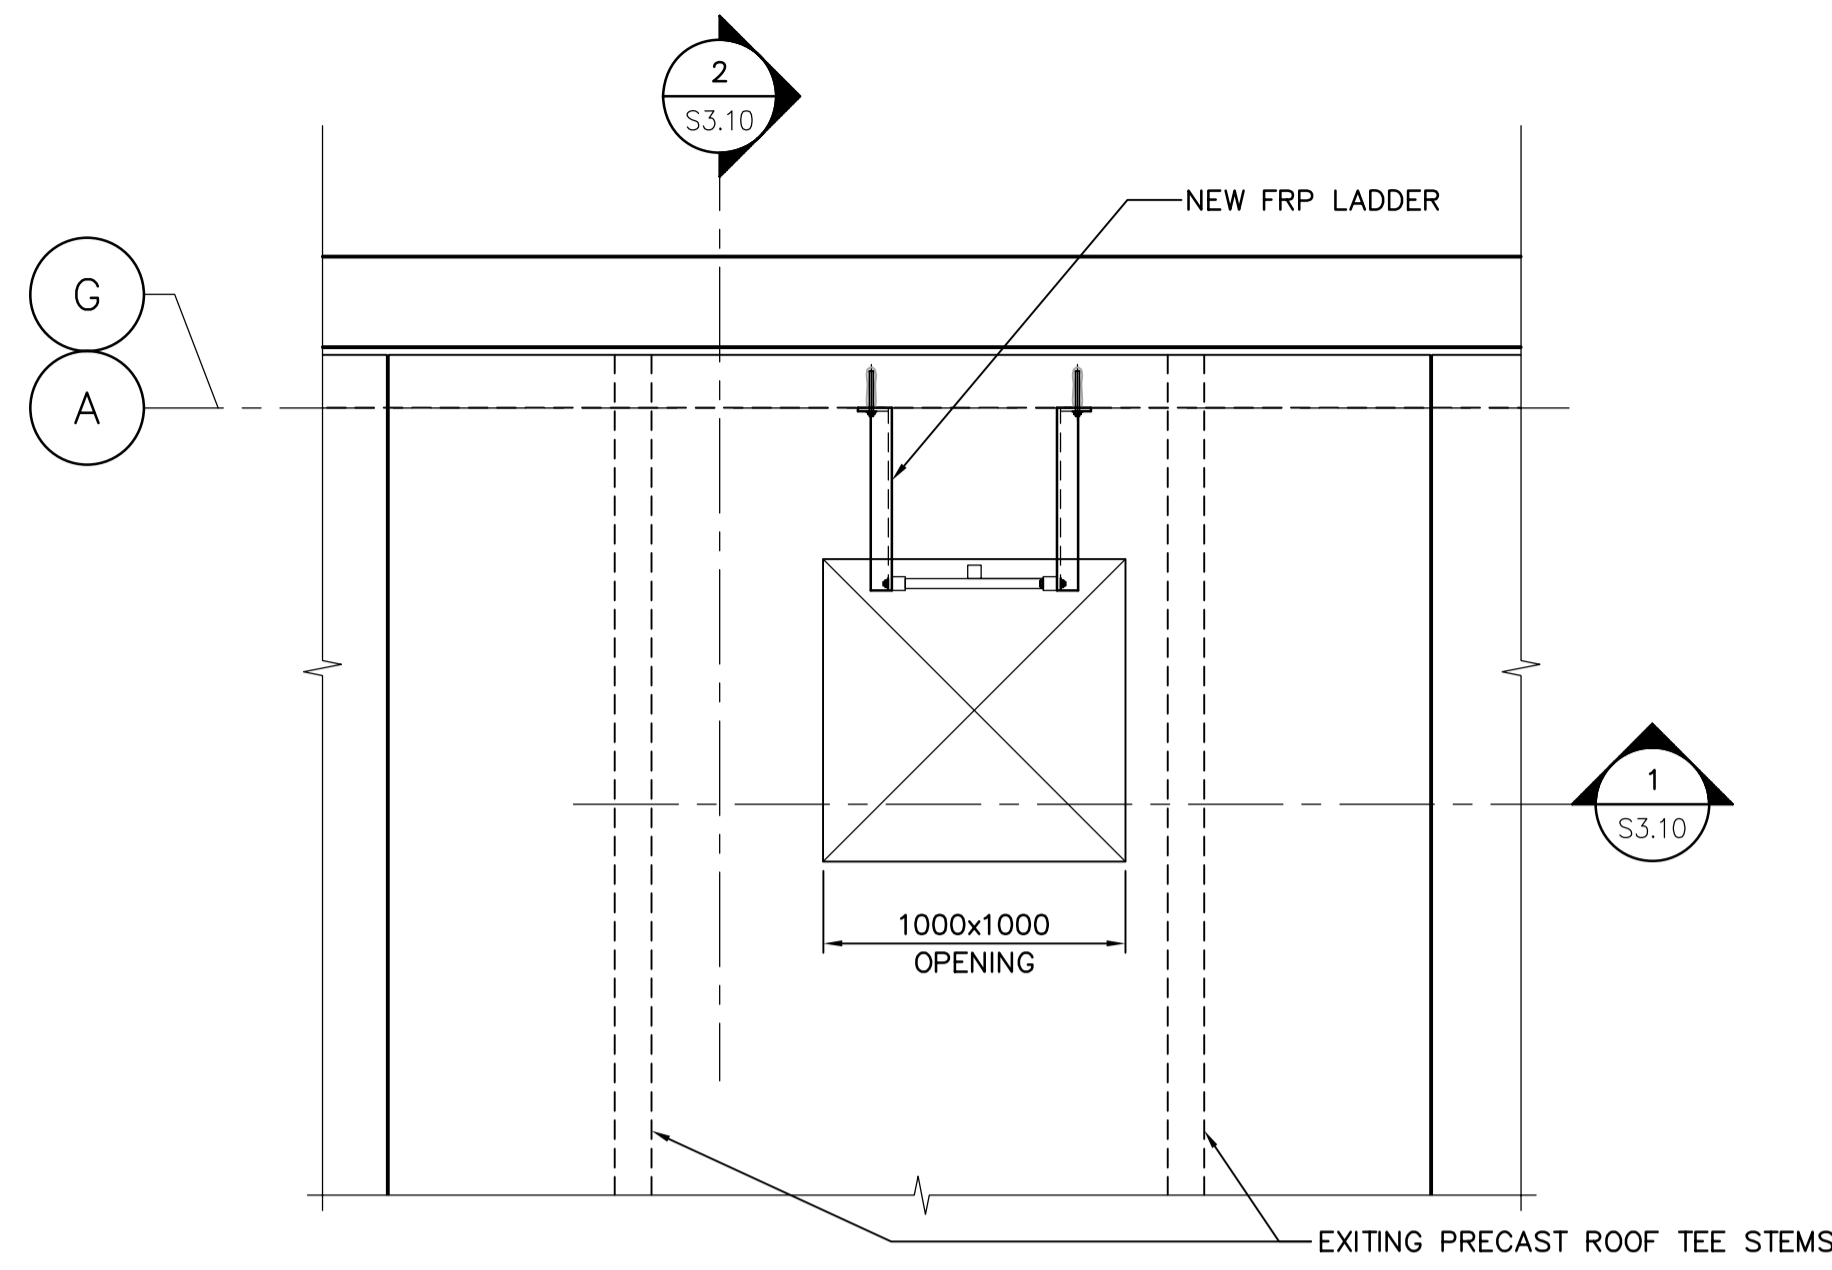

NOTE: SITE CONFIRM DIMENSIONS PRIOR TO FABRICATION

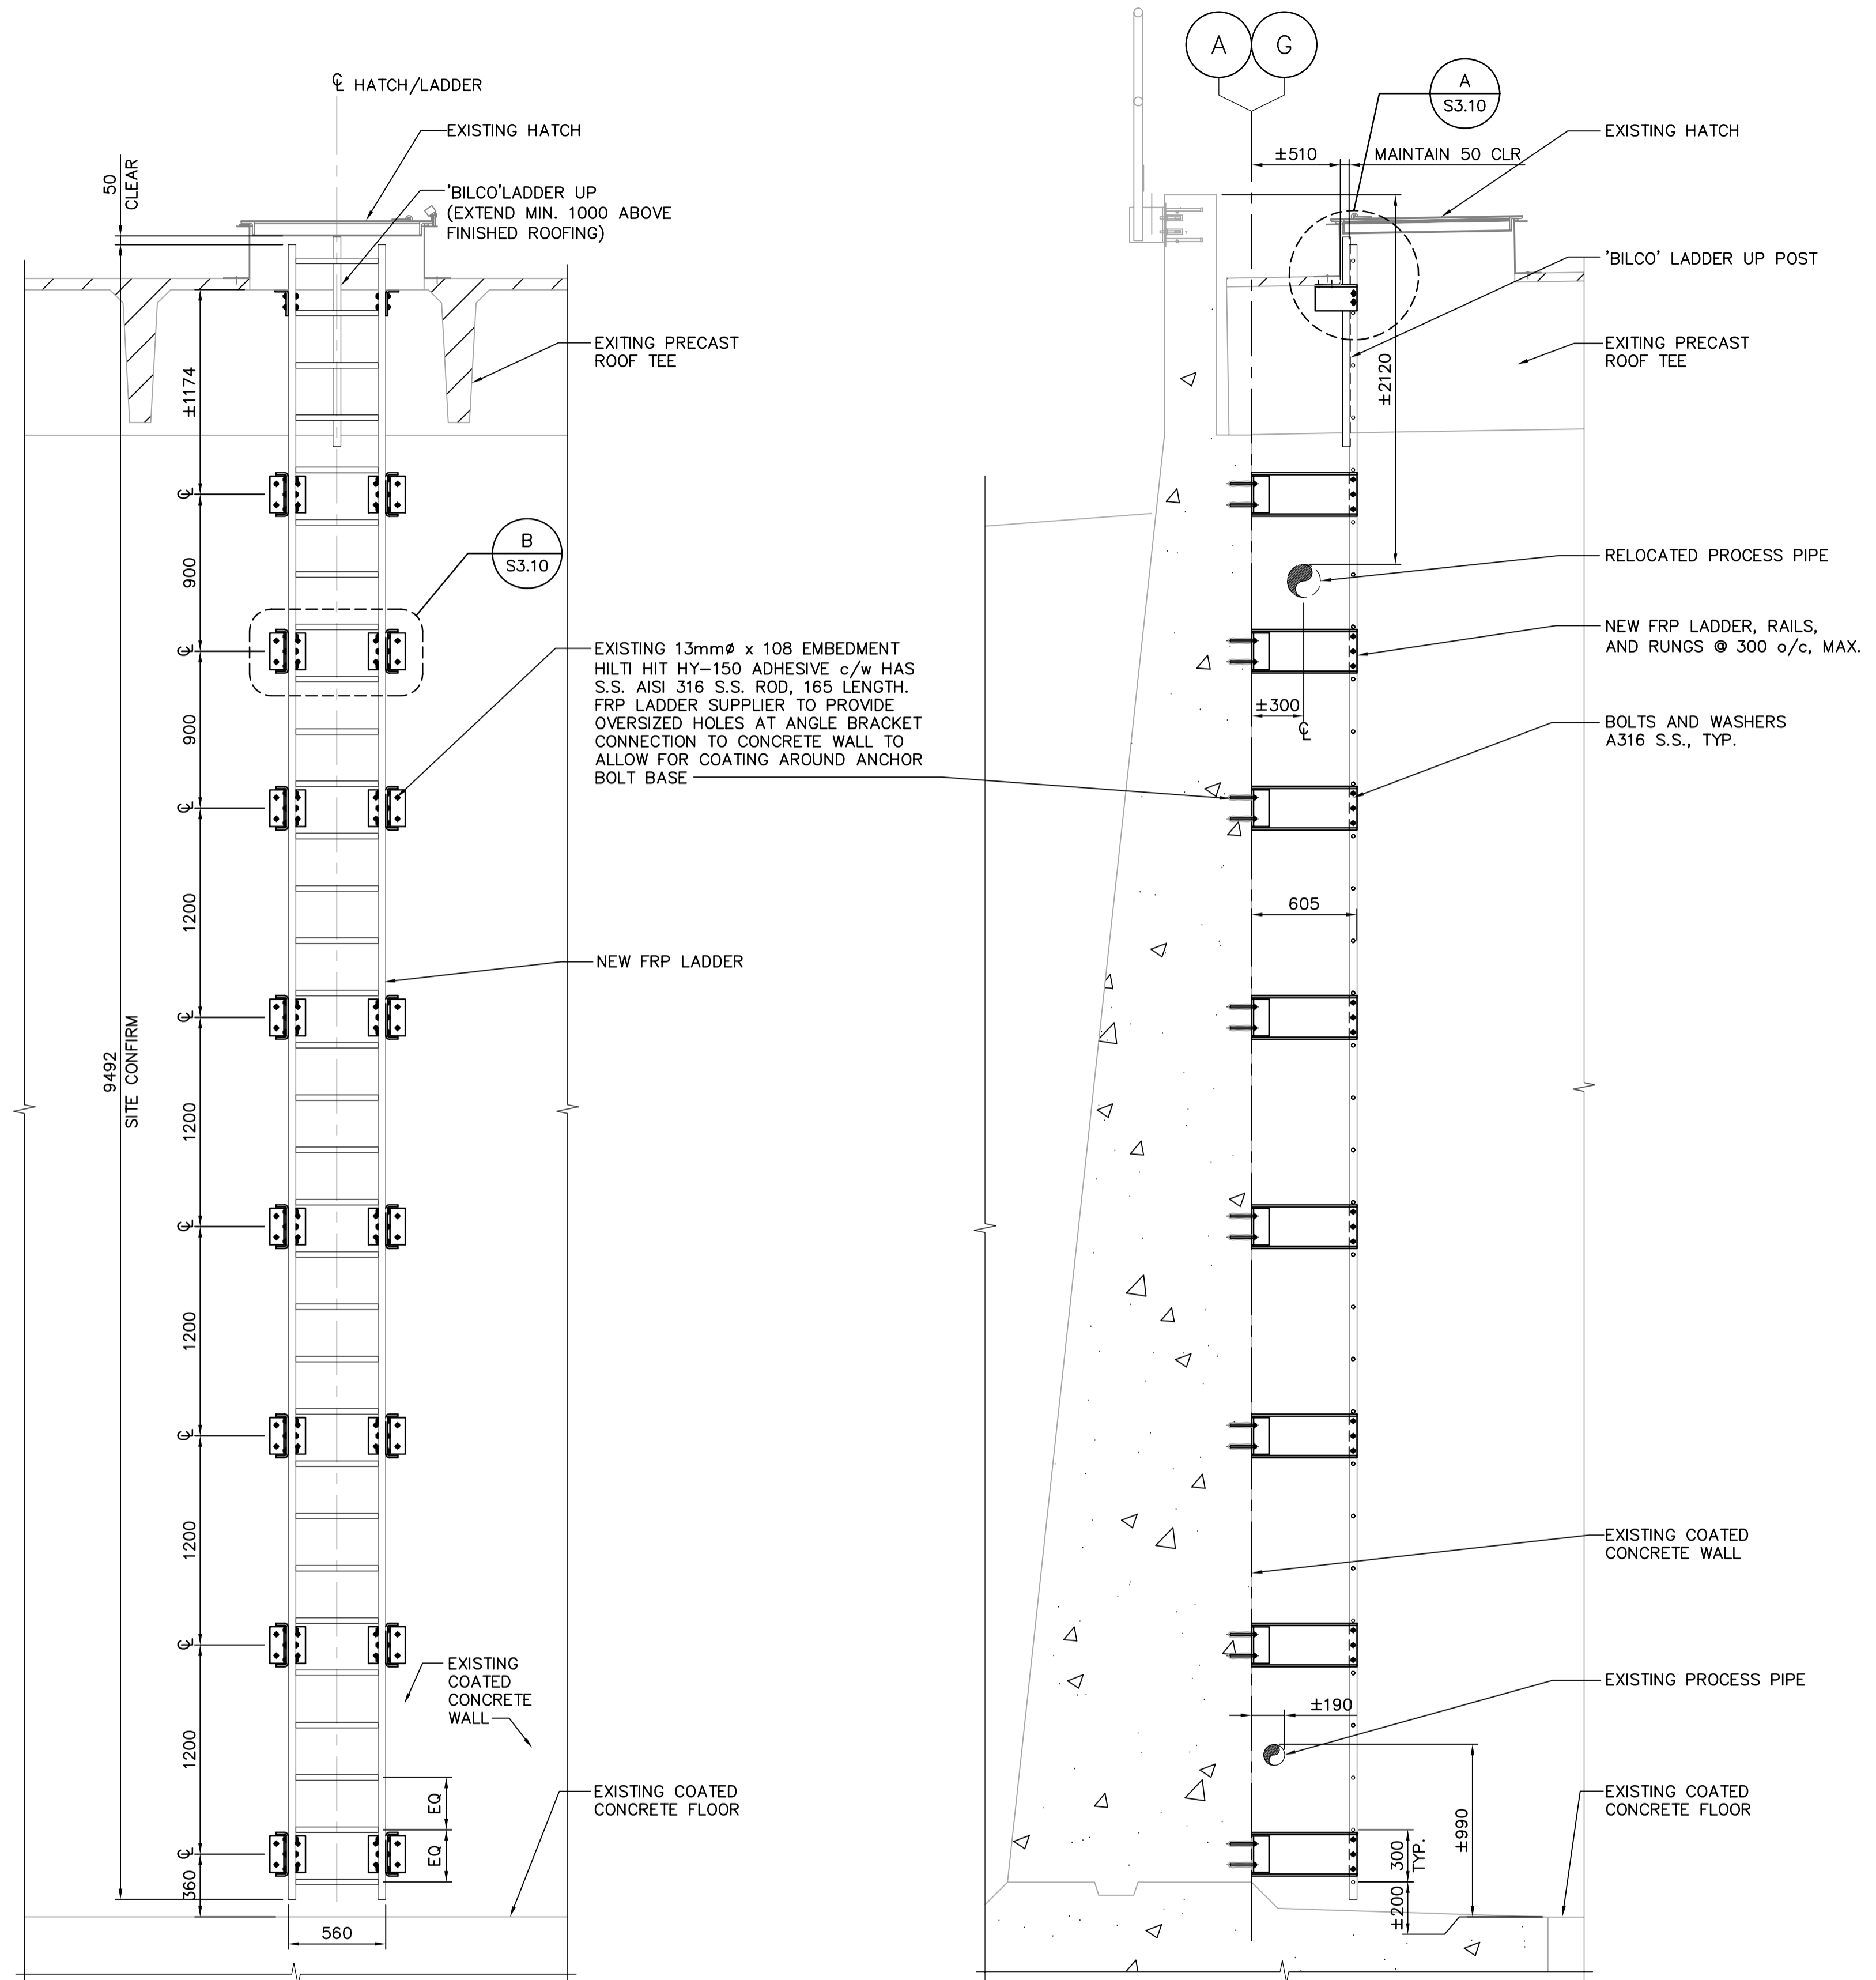

NOTE: SITE CONFIRM DIMENSIONS PRIOR TO FABRICATION

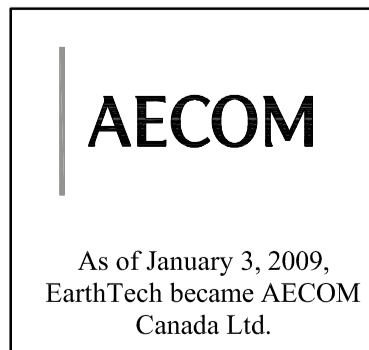

AECOM AS-CONSTRUCTED
SIG..... DATE.....



B.M. ELEV.			
DESIGNED BY	ARA	CHECKED BY	MK
DRAWN BY	KK	APPROVED BY	DJT
SCALE:	AS NOTED	RELEASED FOR CONSTRUCTION BY:	
NO. REVISIONS	DATE	BY	DATE
02	AS-CONSTRUCTED DRAWING	09/04/13	GLG
01	CCN 024	08/07/24	KK
00	F.O. #5	08/07/23	KK





DATE	2008/07/22	DATE	2008/07/23
------	------------	------	------------

ENGINEER'S SEAL
ORIGINAL SIGNED BY
M. KLASSEN
2008/07/23
CONSULTANT DRAWING NO.
S3.10



NEWPCC CENTRATE NUTRIENT TREATMENT NITROGEN REMOVAL FACILITY
STRUCTURAL SBR BUILDING FRP LADDER SECTIONS & DETAILS
CITY FILE NUMBER
SHEET OF
CITY DRAWING NUMBER
1-0101C-S0015-002-02

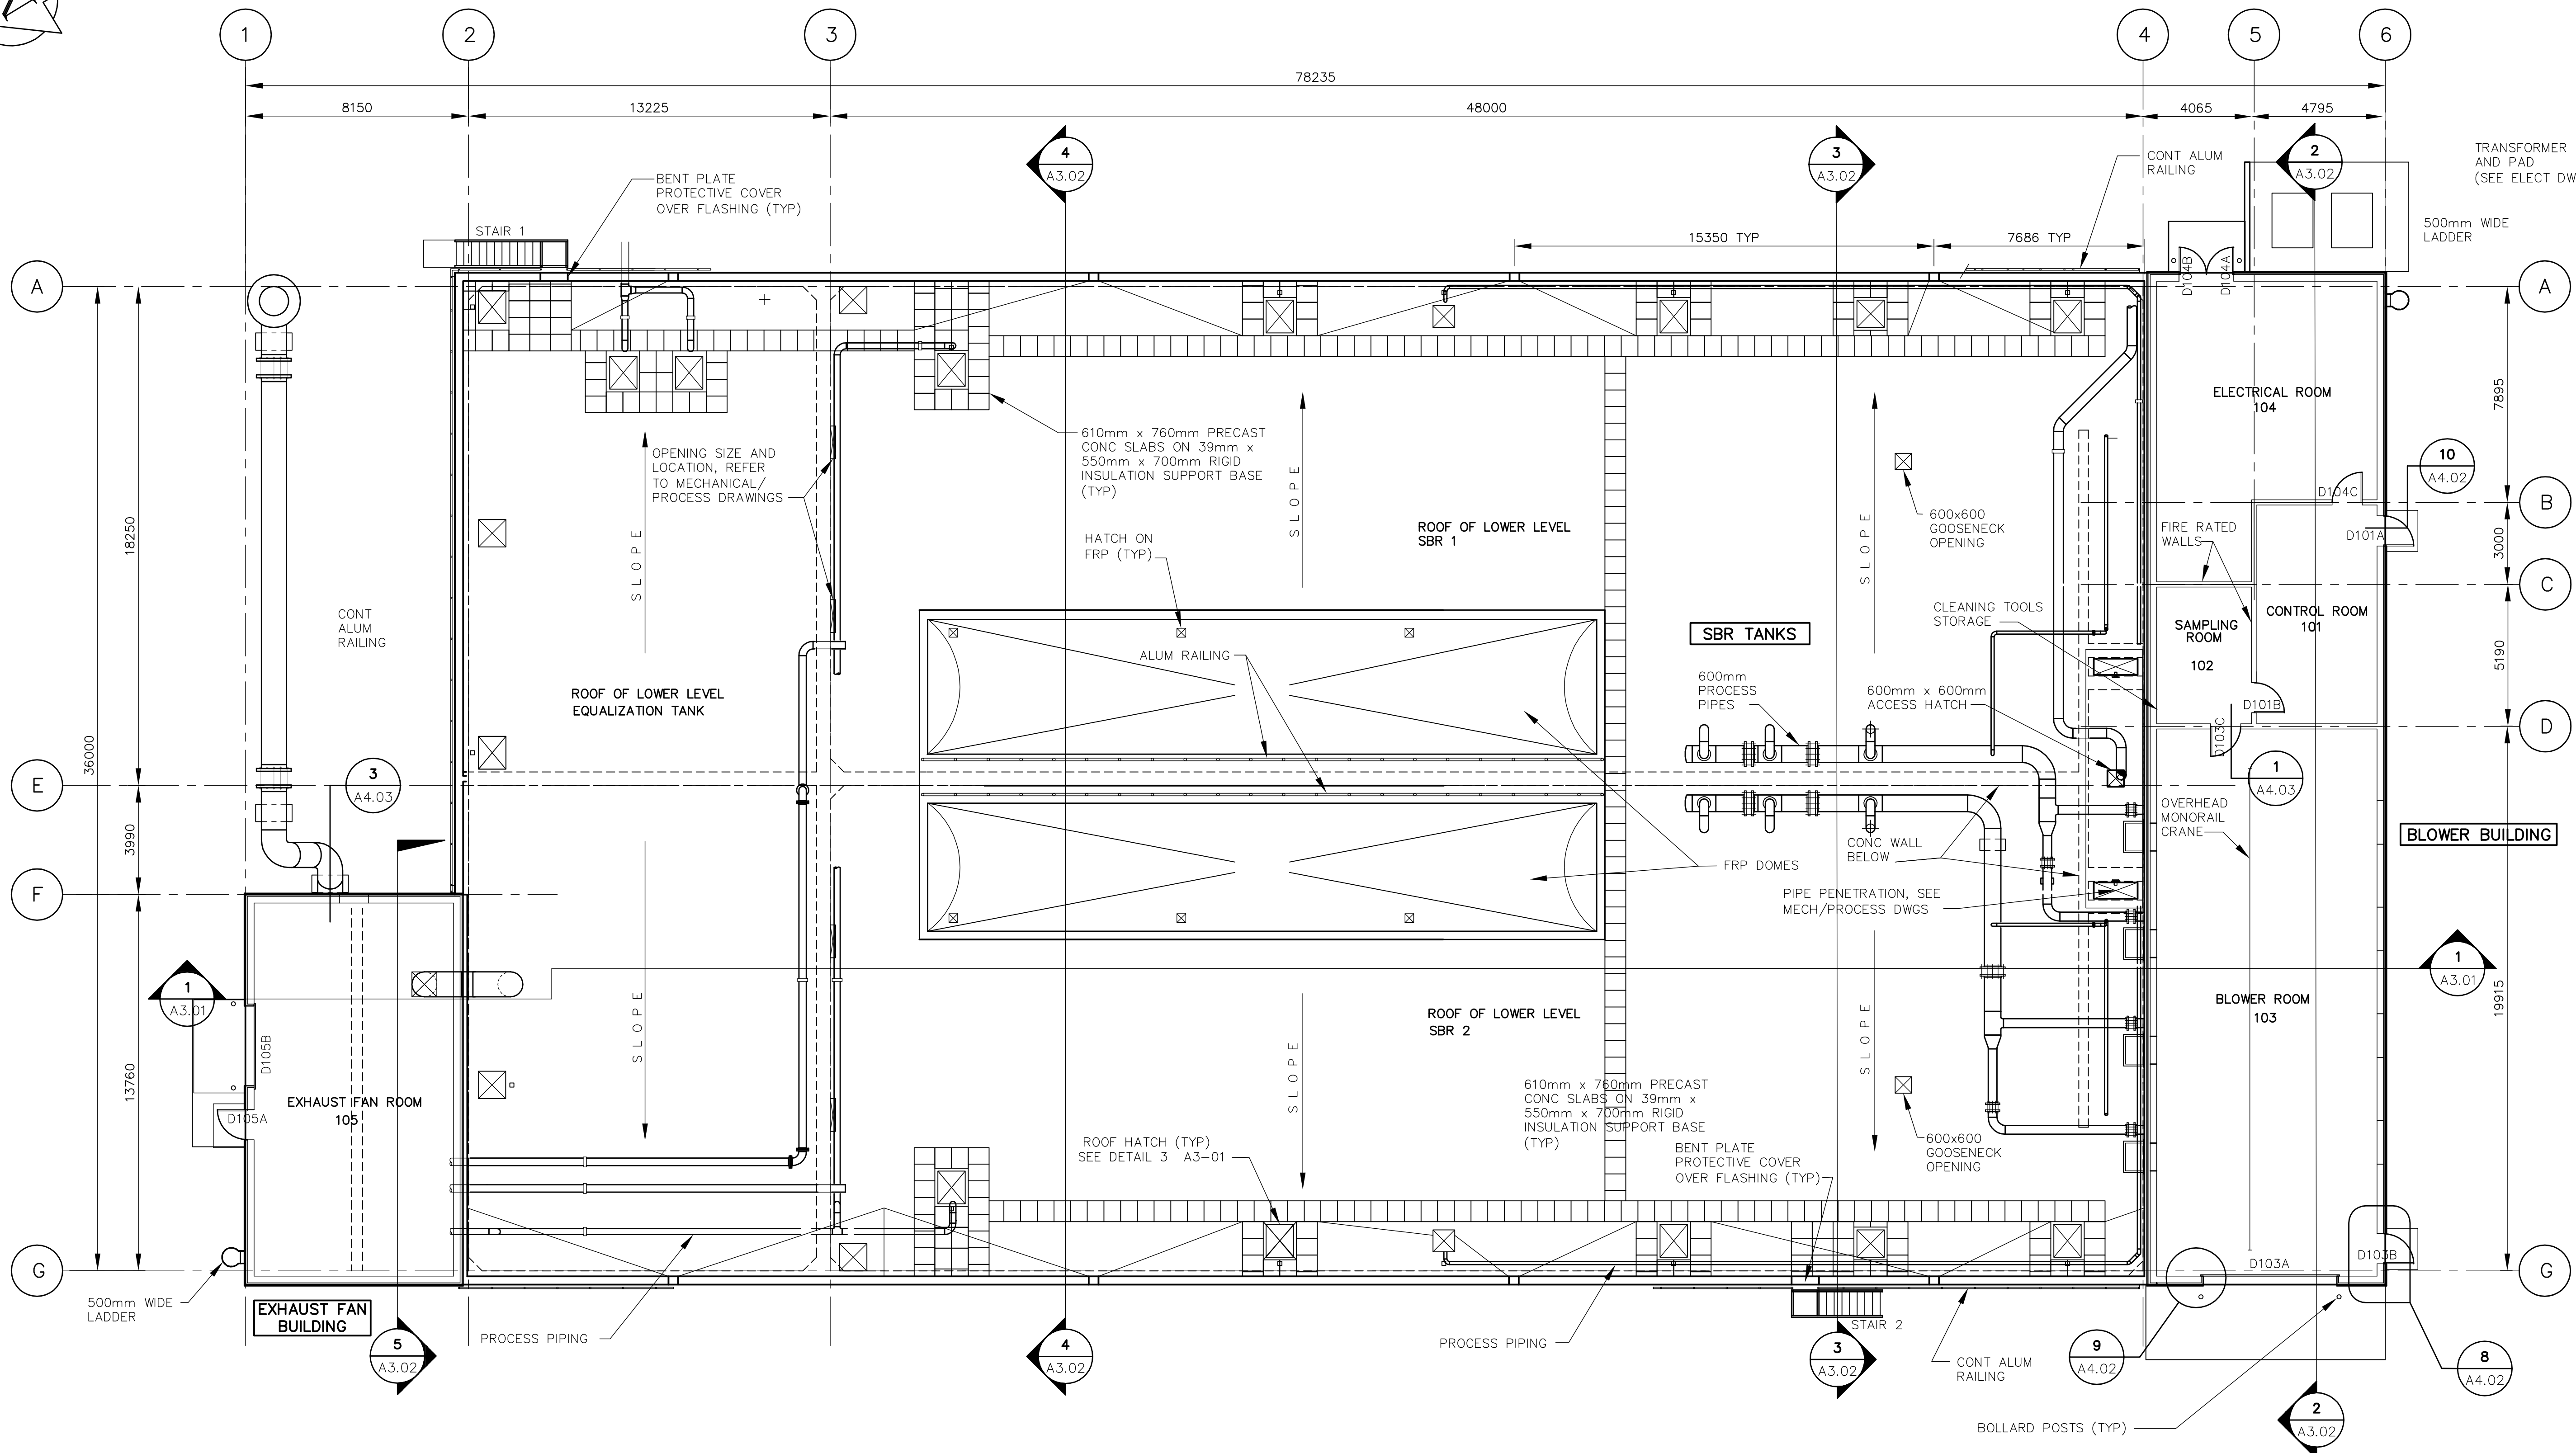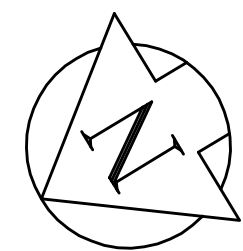

1 UPPER LEVEL PLAN
A1.02 1:125

AECOM WINNIPEG
AS-CONSTRUCTED



NO.	REVISIONS	DATE	BY	DATE	2006/03/21	DATE	2006/05/15
03	AS-CONSTRUCTED DRAWING	09/04/08	AL				
02	ISSUED FOR CONSTRUCTION	06/08/29	AL				
01	291-2006 ADDENDUM 6	06/07/26	AL				
00	ISSUED FOR TENDER	06/05/15	AL				

EarthTech
A Tyco International Ltd. Company

DESIGNED BY: NC	CHECKED BY: LK
DRAWN BY: AL	APPROVED BY: JEH
HOR. SCALE: AS NOTED	RELEASED FOR CONSTRUCTION BY: K. MARTENS
VERTICAL SCALE:	







ENGINEER'S SEAL
ORIGINAL SIGNED BY: N. COOPER
2006/05/15
CONSULTANT DRAWING NO. A1.02

THE CITY OF WINNIPEG
WATER AND WASTE DEPARTMENT
ENGINEERING DIVISION

NEWPCC CENTRATE NUTRIENT TREATMENT NITROGEN REMOVAL FACILITY

ARCHITECTURAL UPPER LEVEL PLAN


CITY FILE NUMBER
SHEET OF
CITY DRAWING NUMBER
1-010C-B0002-001-03

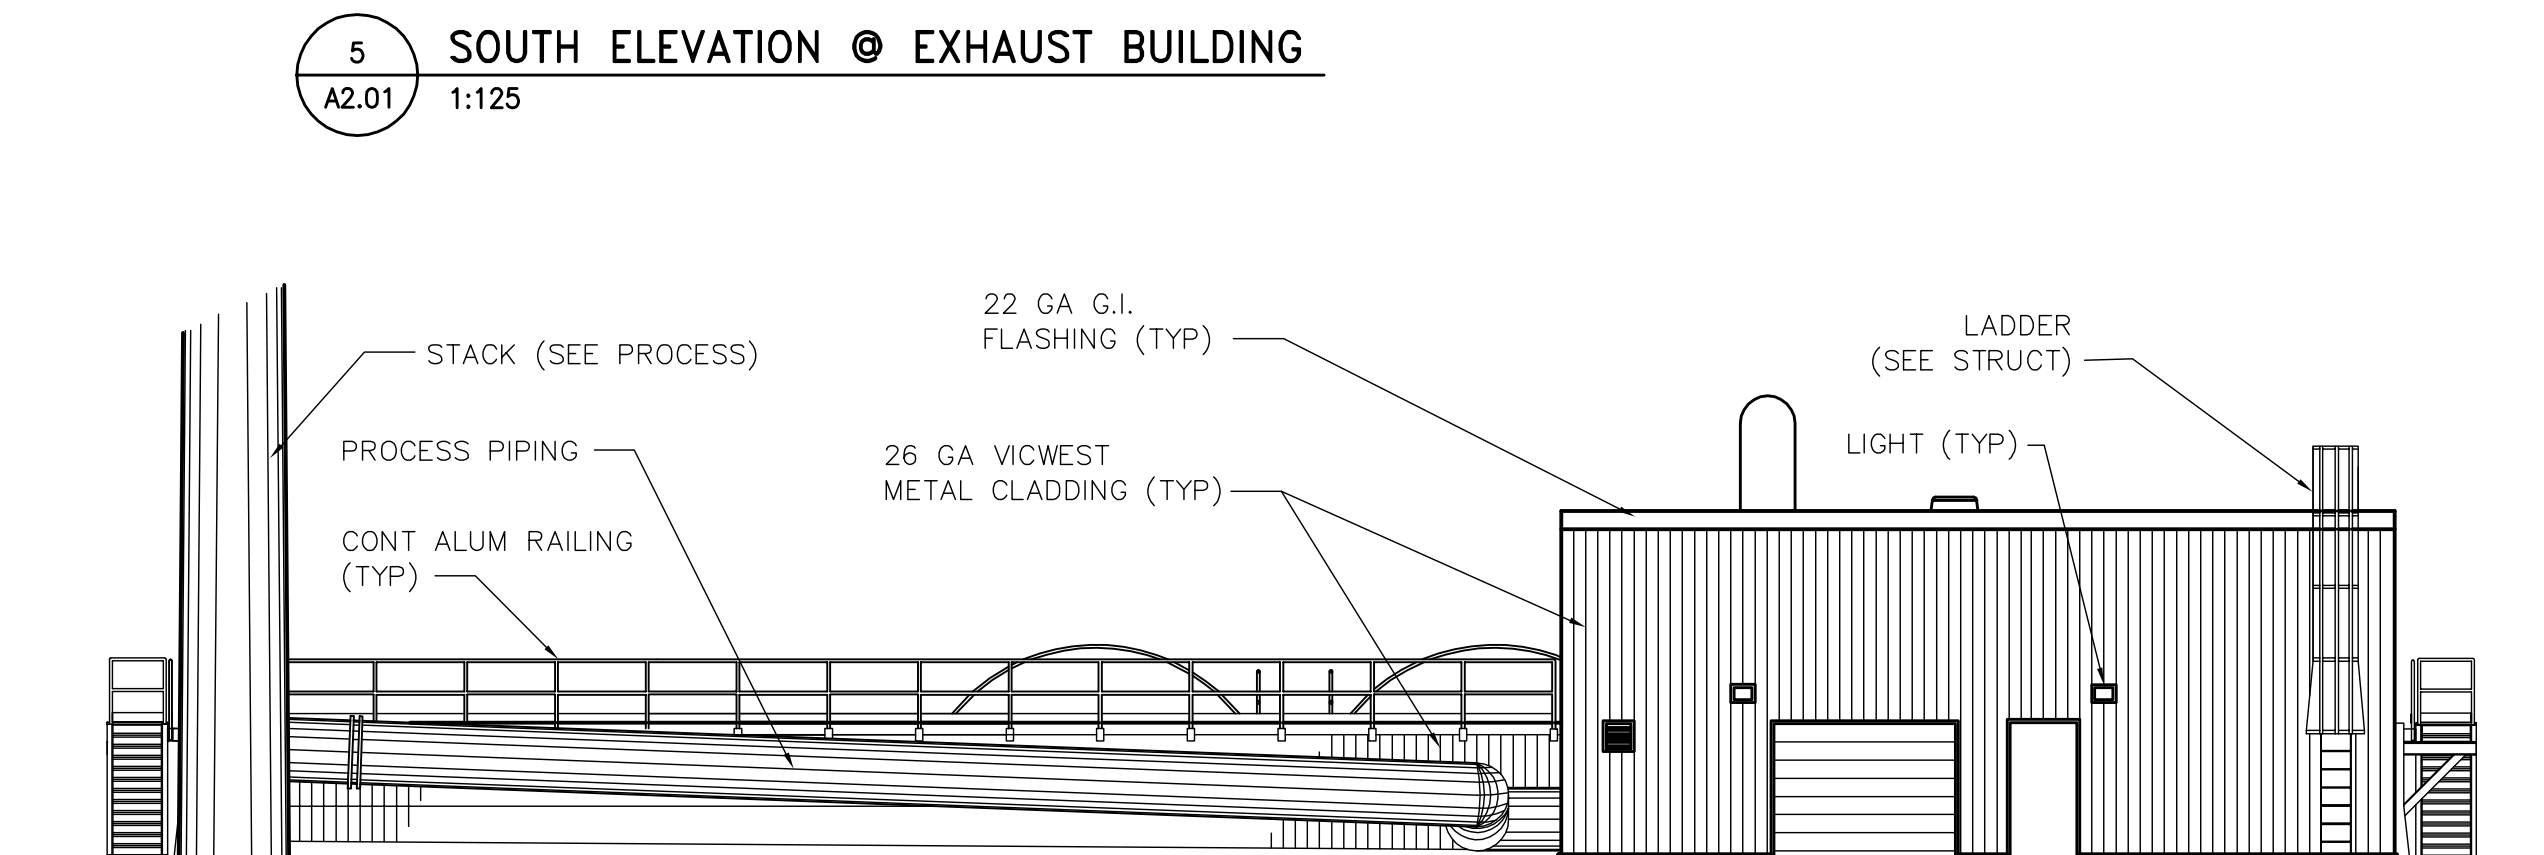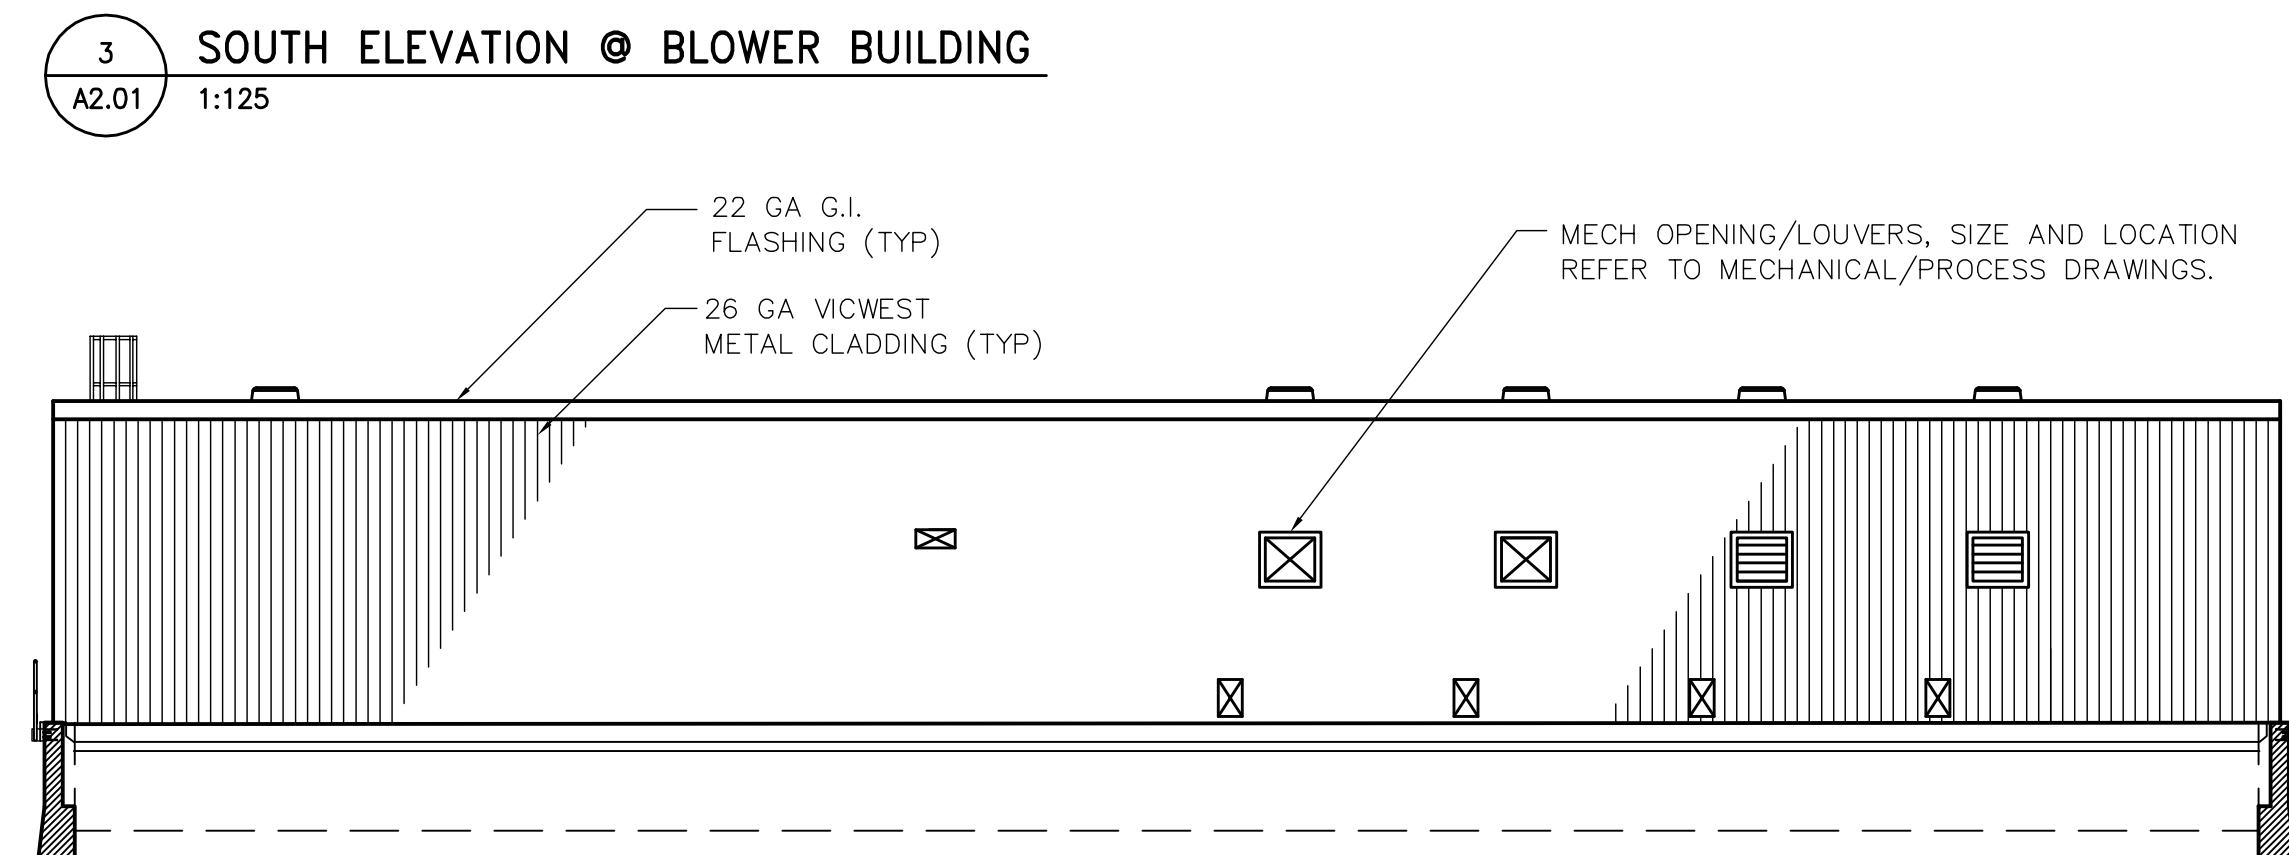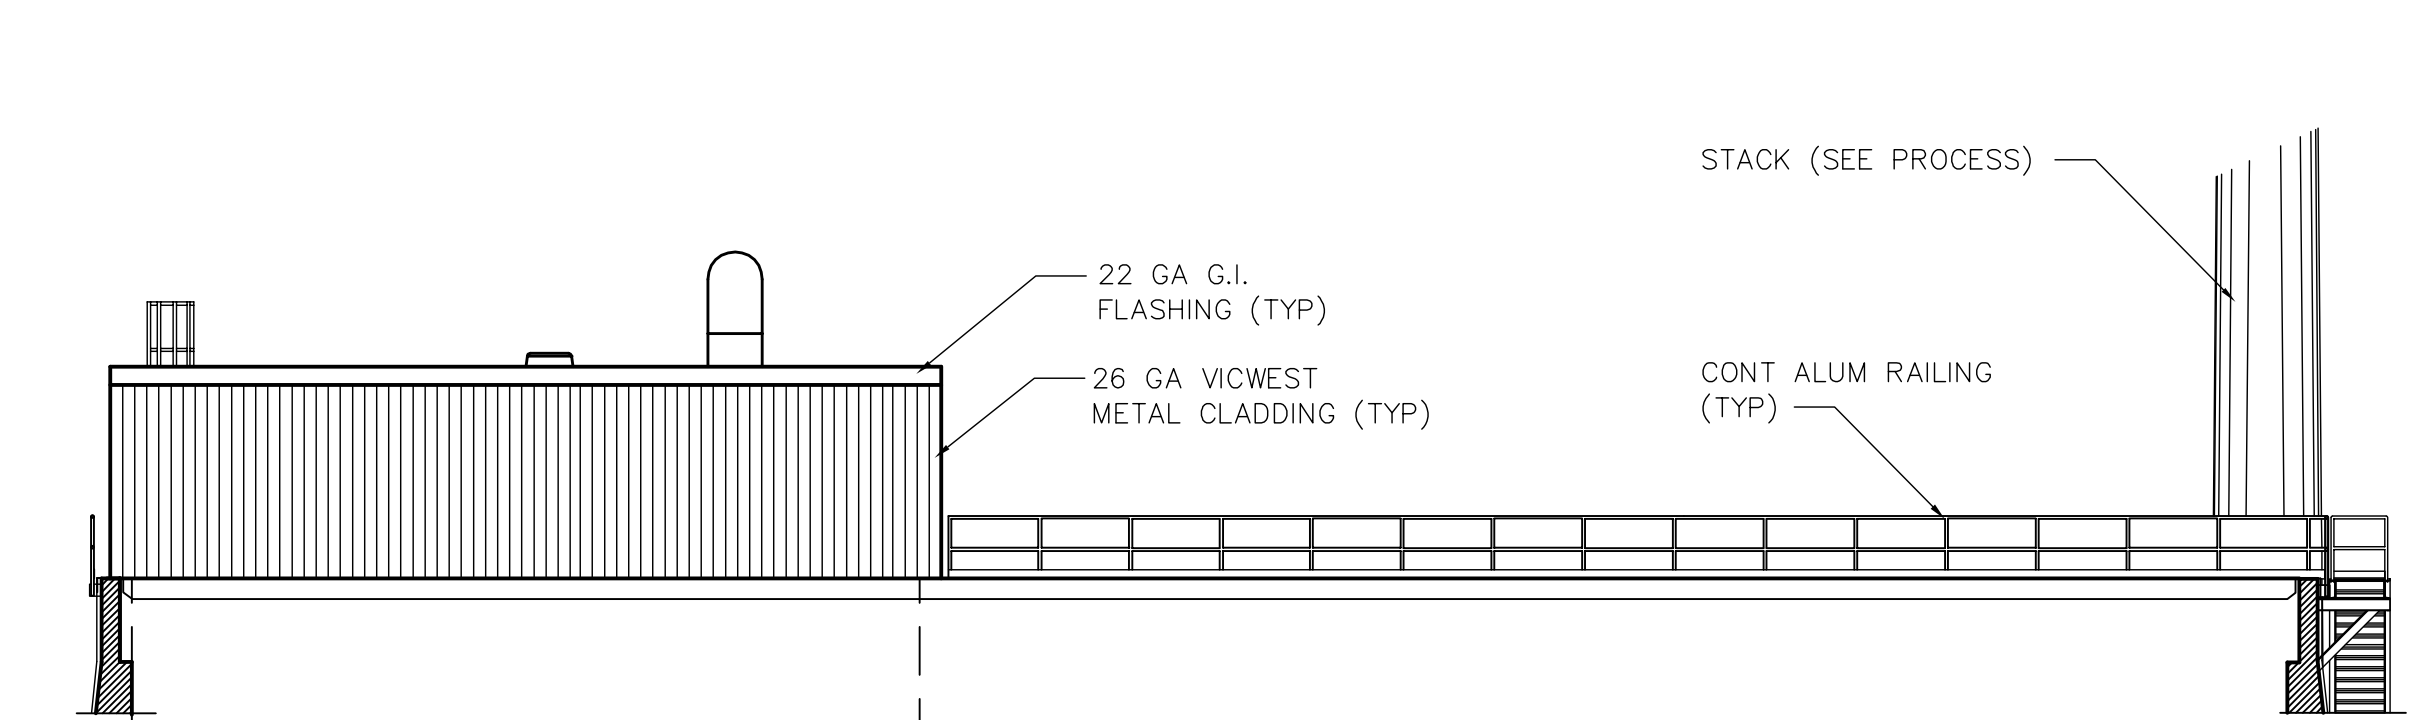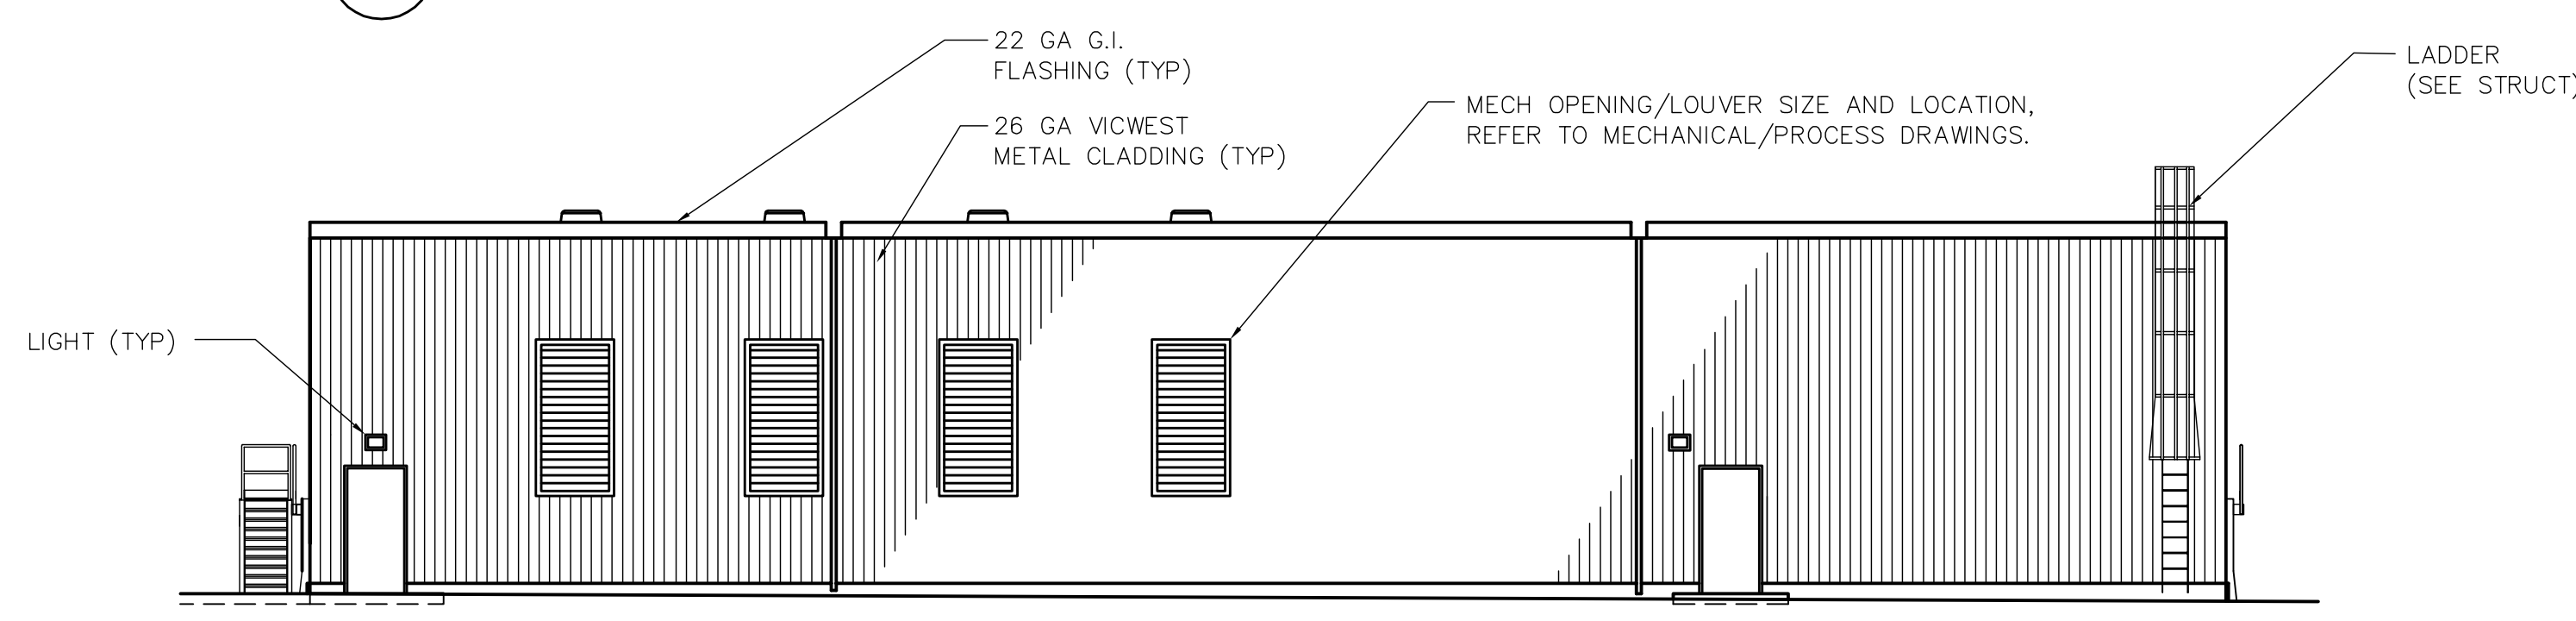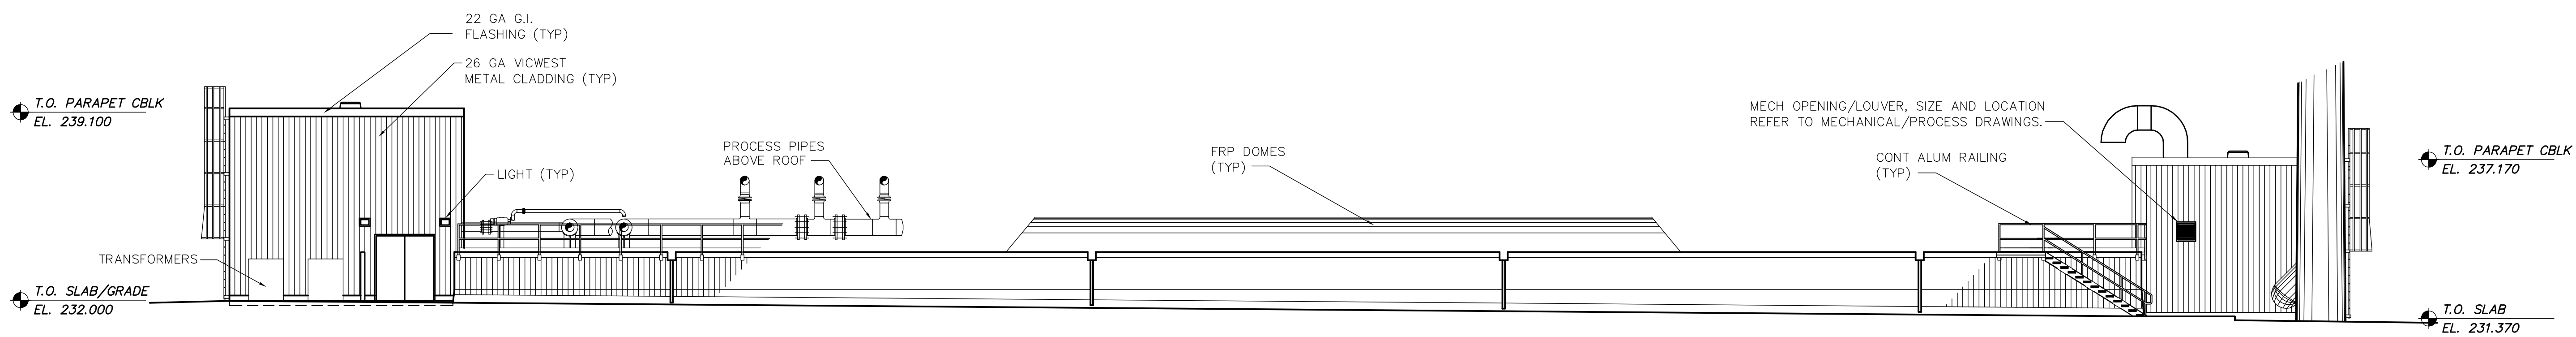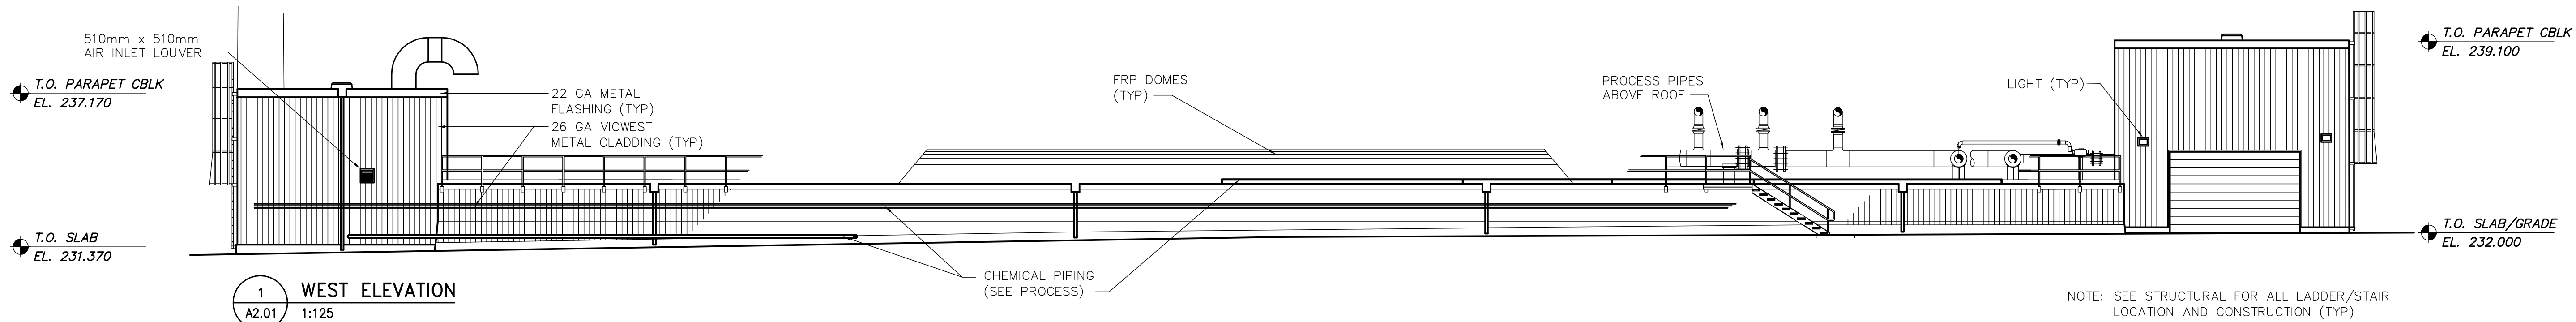


AECOM WINNIPEG
AS-CONSTRUCTED




B.M. ELEV.		 A Tyco International Ltd. Company		ENGINEER'S SEAL		 THE CITY OF WINNIPEG WATER AND WASTE DEPARTMENT ENGINEERING DIVISION	
				ORIGINAL SIGNED BY N. COOPER 2006/05/15			
04	AS-CONSTRUCTED DRAWING	09/04/08	AL	DESIGNED BY NC	CHECKED BY LK	SHEET OF	
03	ISSUED FOR CONSTRUCTION	06/08/29	AL	DRAWN BY AL	APPROVED BY JEH	CITY DRAWING NUMBER	
02	291-2006 ADDENDUM 6	06/07/26	AL	HOR. SCALE: AS NOTED		ARCHITECTURAL EXTERIOR ELEVATIONS	
01	291-2006 ADDENDUM 3	06/07/12	AL	VERTICAL SCALE:		1-010C-B0005-001-04	
00	ISSUED FOR TENDER	06/05/15	AL	RELEASED FOR CONSTRUCTION BY: K. MARTENS		CONSULTANT DRAWING NO. A2.01	
NO.	REVISIONS	DATE	BY	DATE	DATE		
				2006/03/21	2006/05/15		

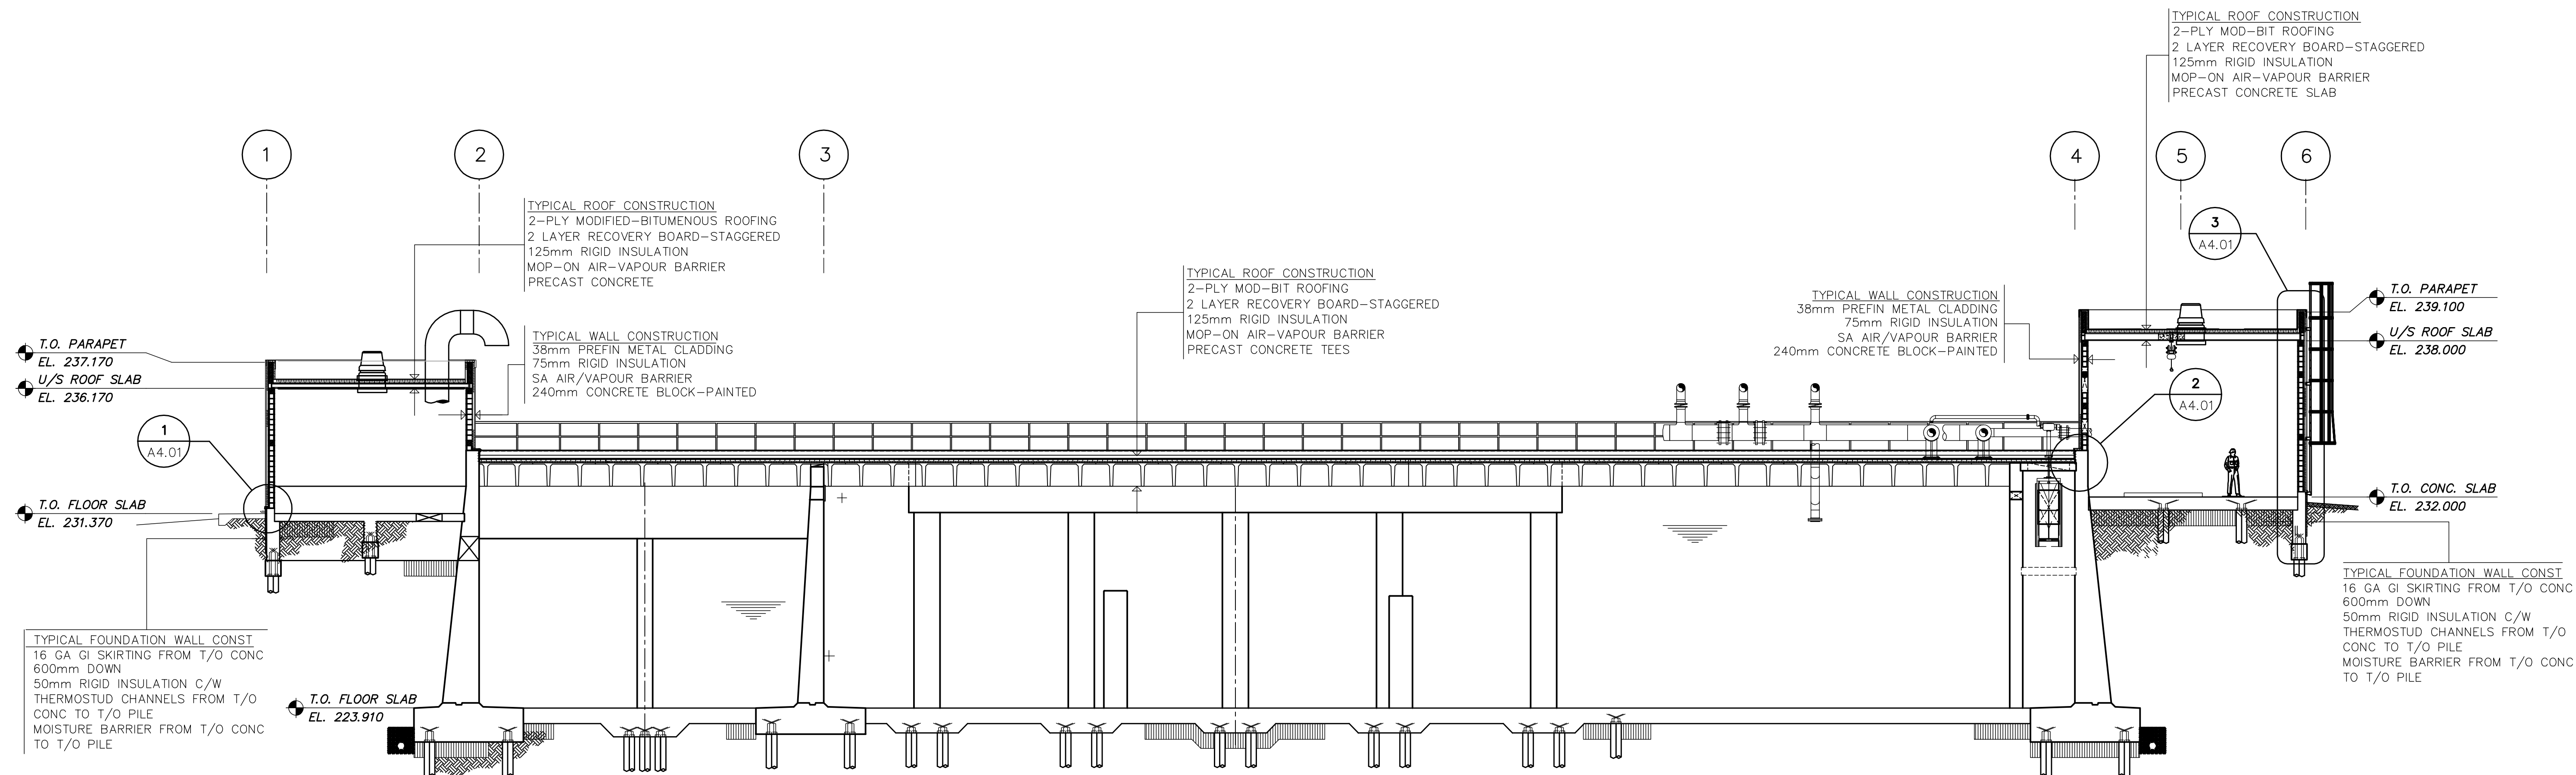


1 BUILDING SECTION
A1.01 1:125

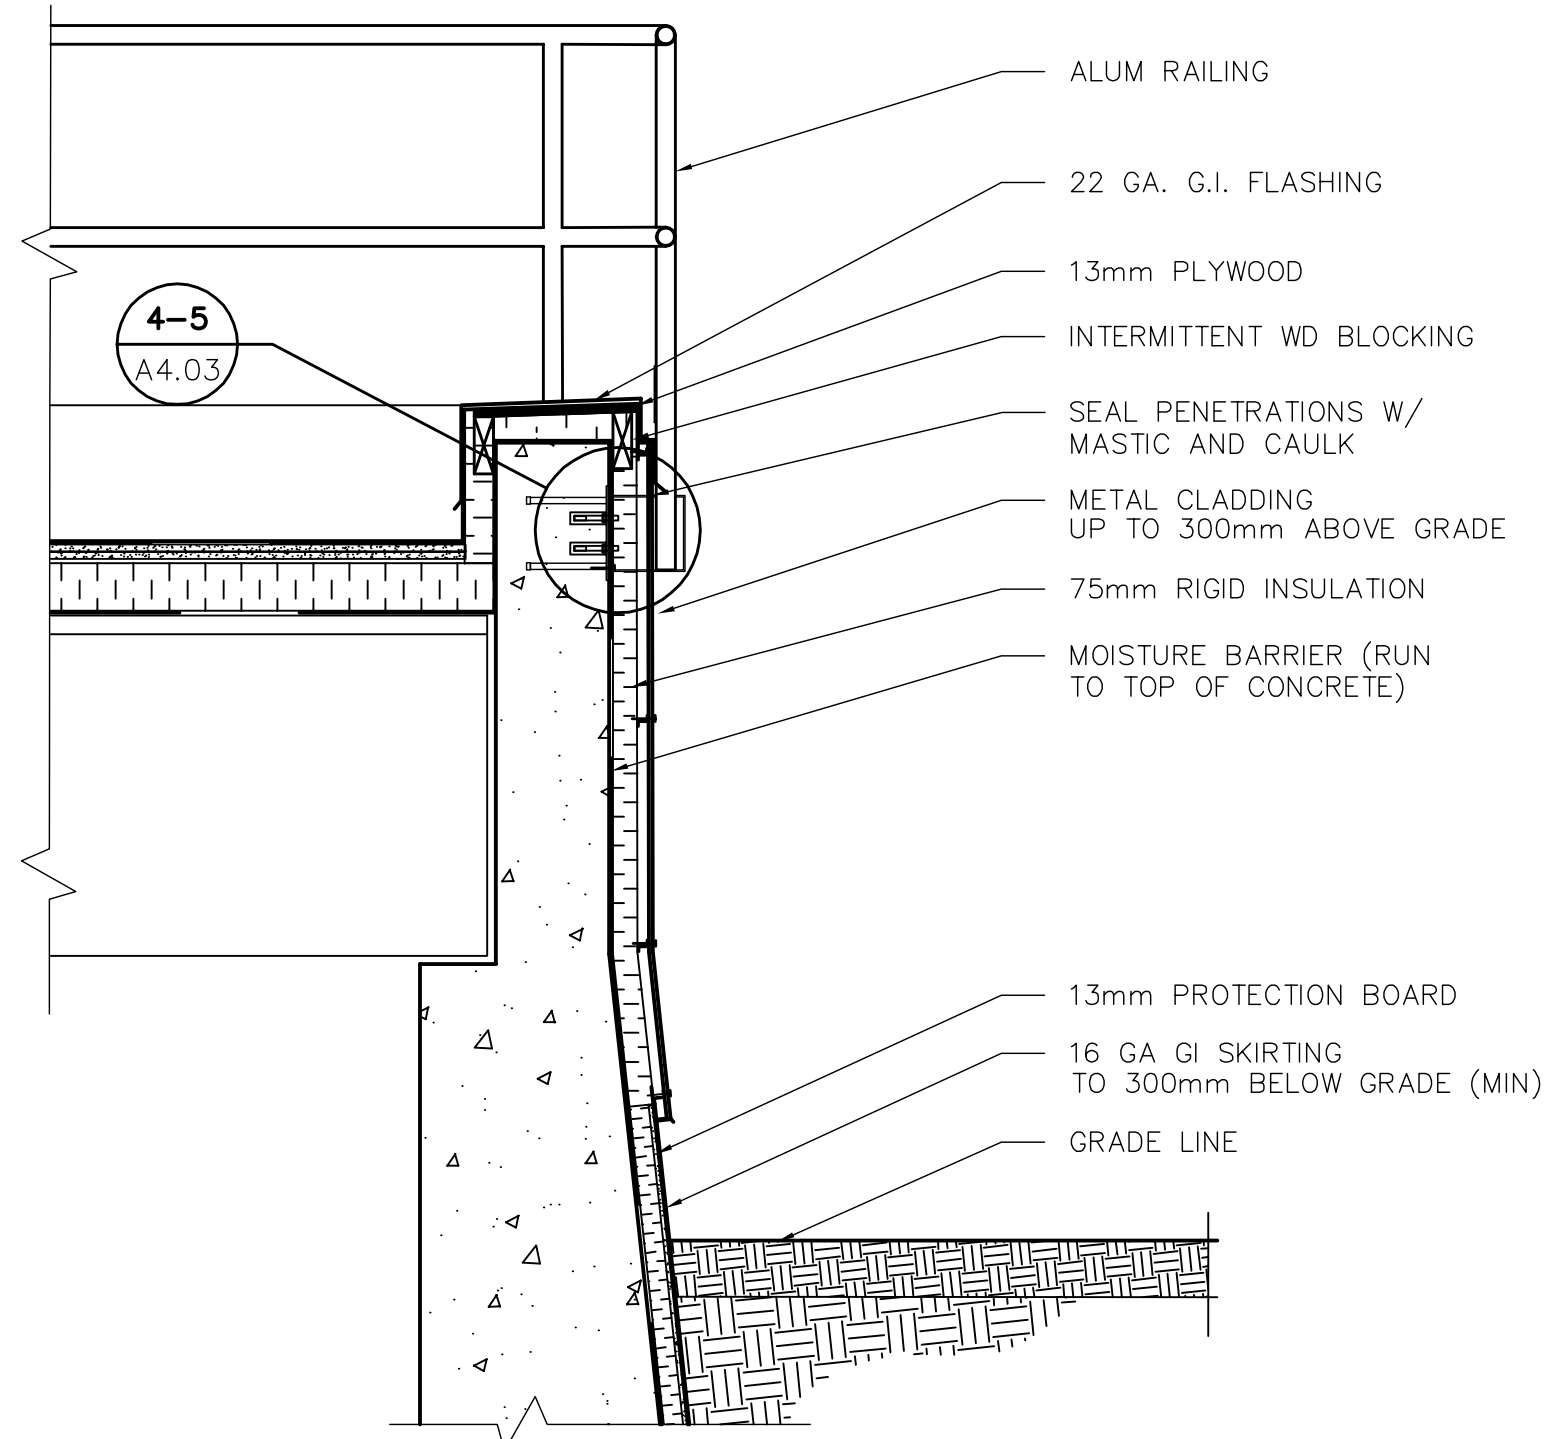

4 SBR WALL DETAIL SECTION
A3-02 1:20

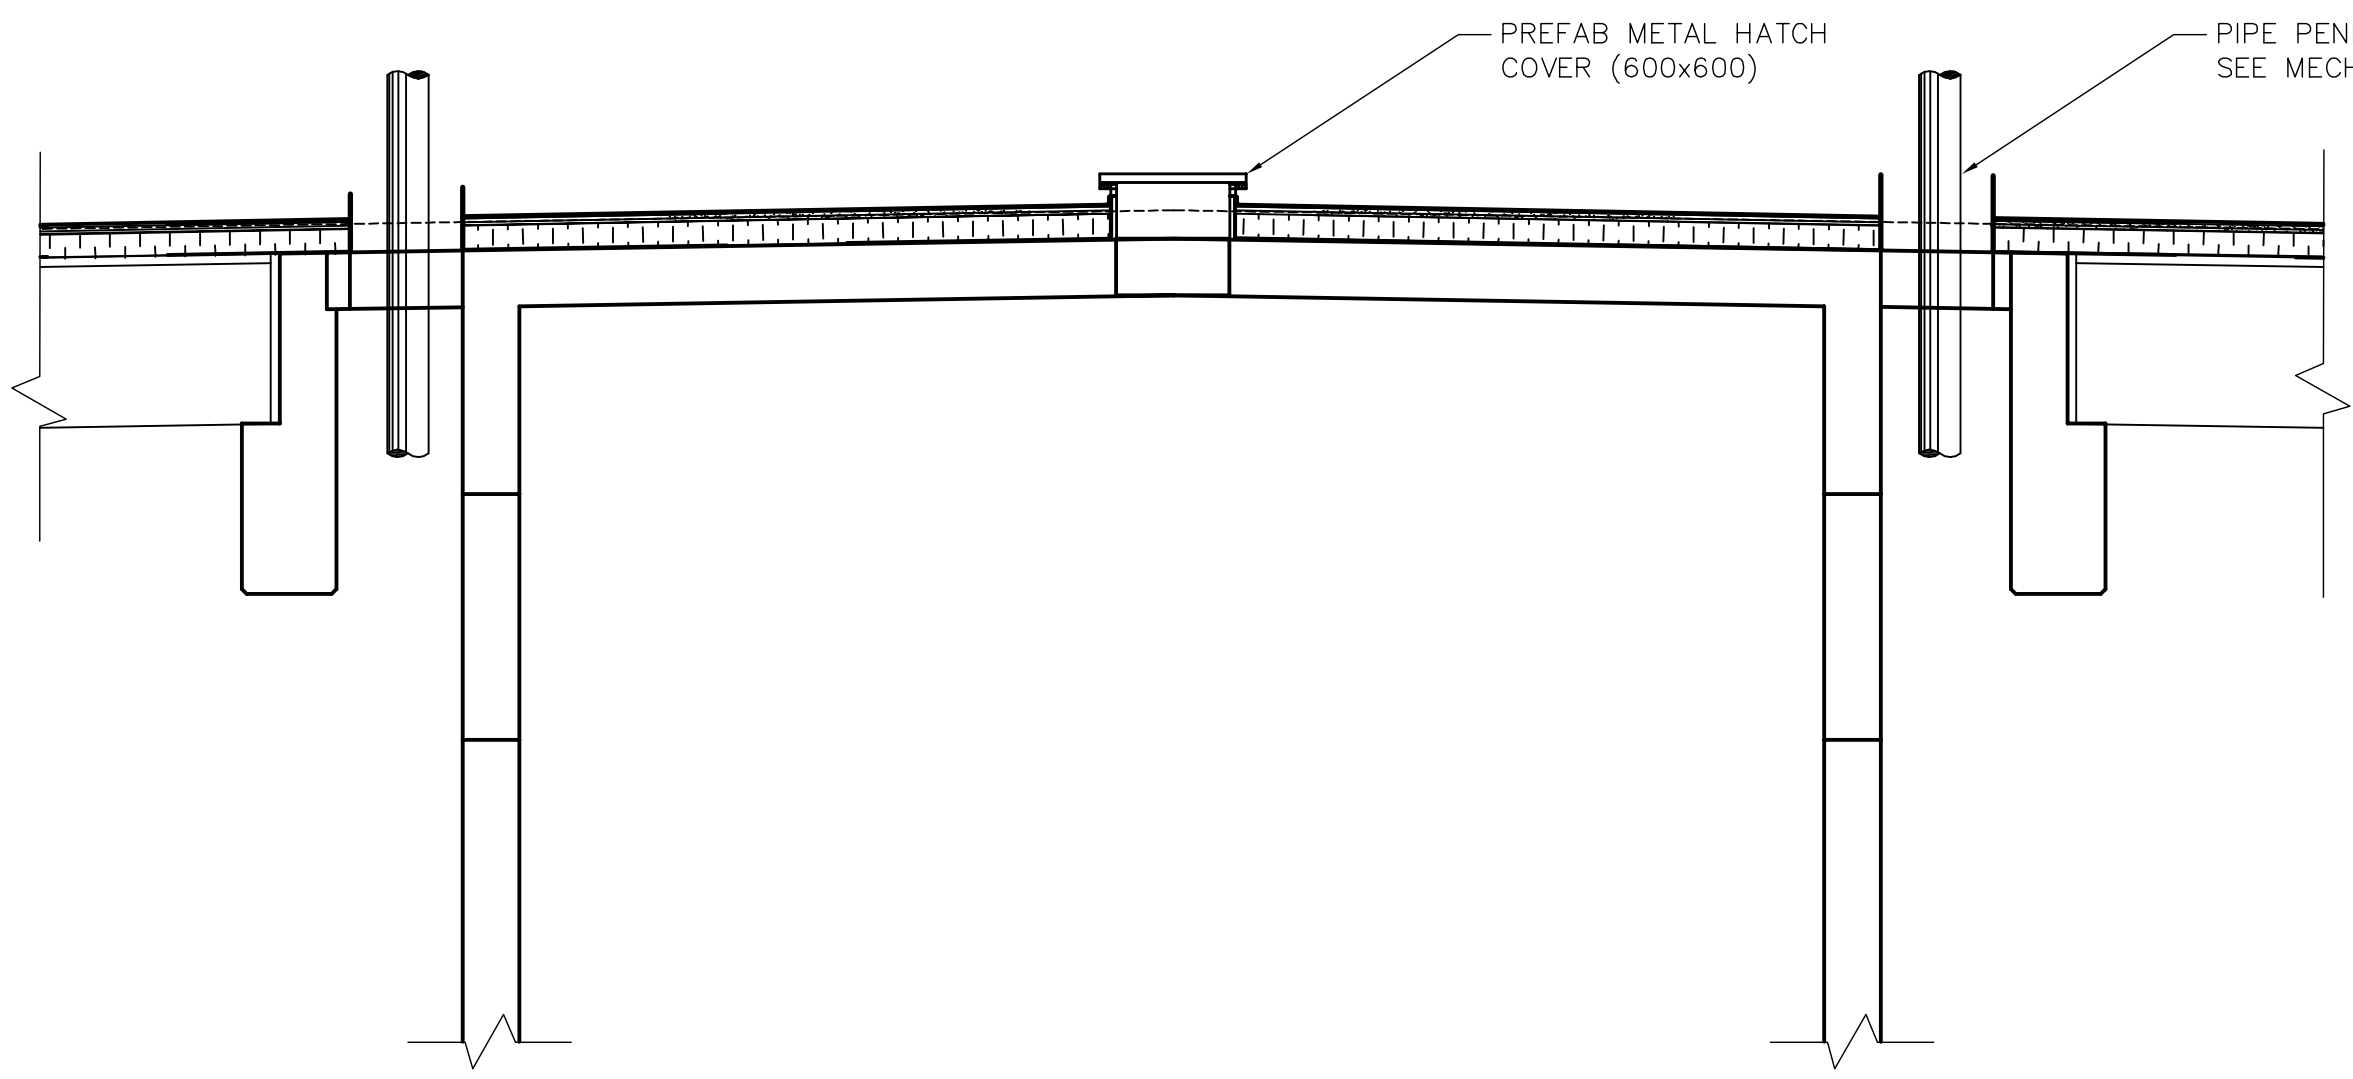

2 DETAIL SECTION
A3.02 1:40

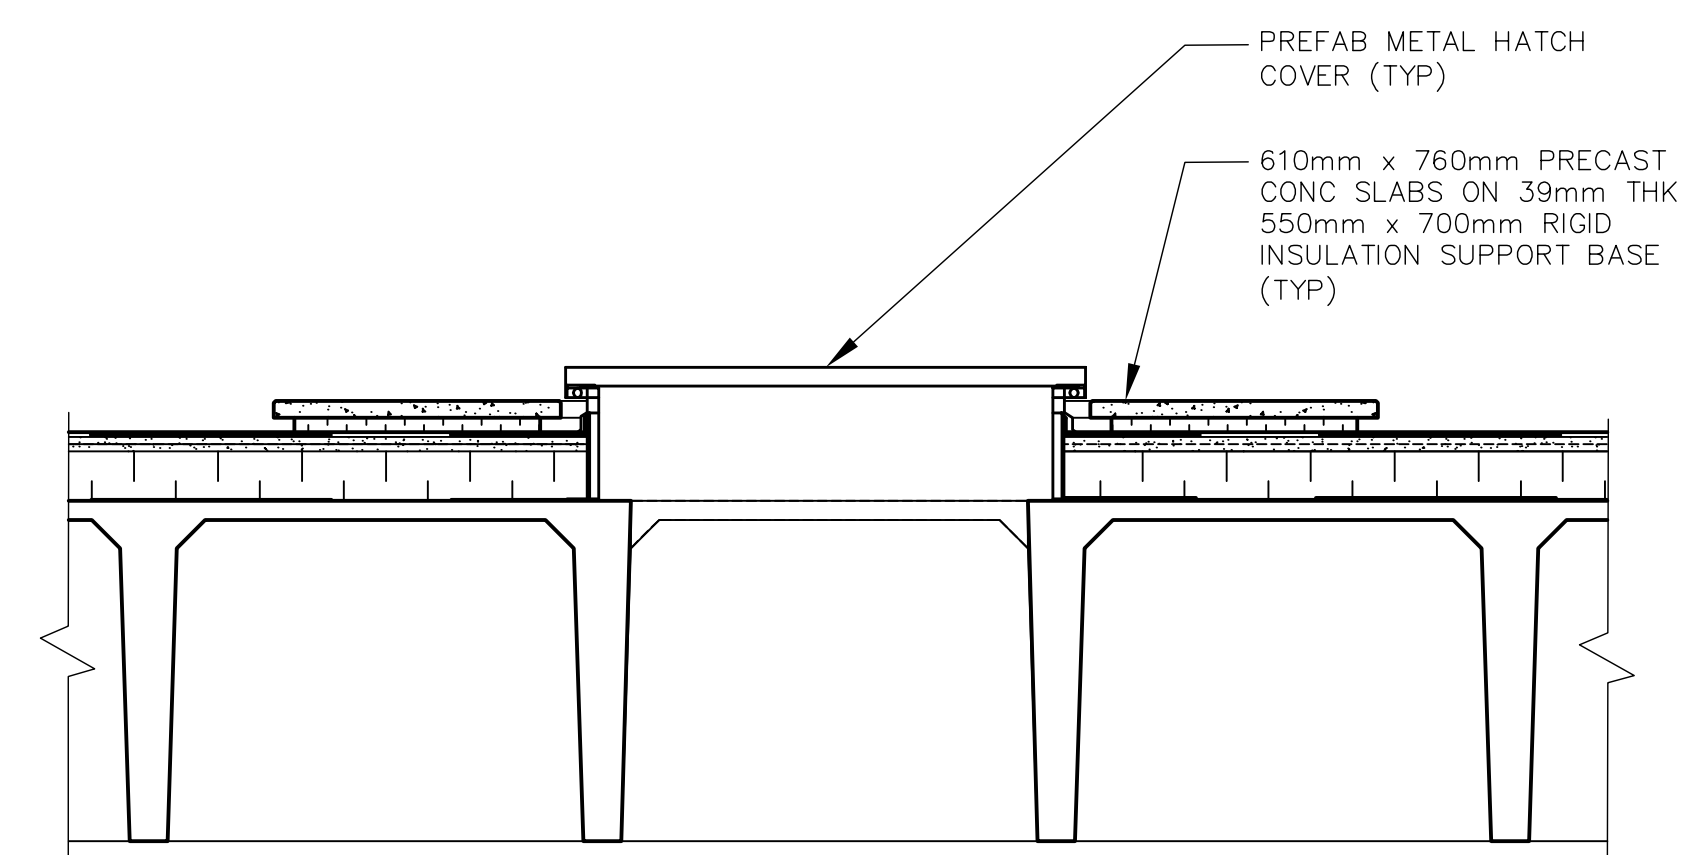

3 ROOF HATCH DETAIL (TYP)
A1.02 1:20

AECOM WINNIPEG
AS-CONSTRUCTED



NO.	REVISIONS	DATE	BY	DATE	BY
05	AS-CONSTRUCTED DRAWING	09/04/08	AL		
04	ISSUED FOR CONSTRUCTION	06/08/29	AL		
03	291-2006 ADDENDUM 7	06/08/02	LK		
02	291-2006 ADDENDUM 6	06/07/26	AL		
01	291-2006 ADDENDUM 3	06/07/12	AL		
00	ISSUED FOR TENDER	06/05/15	AL		

EarthTech
A Tyco International Ltd. Company

DESIGNED BY: NC	CHECKED BY: LK
DRAWN BY: AL	APPROVED BY: JEH
HOR. SCALE: AS NOTED	RELEASED FOR CONSTRUCTION BY: K. MARTENS
VERTICAL SCALE:	DATE: 2006/03/21
	DATE: 2006/05/15

ENGINEER'S SEAL
ORIGINAL SIGNED BY
N. COOPER
2006/05/15
CONSULTANT DRAWING NO.
A3.01


THE CITY OF WINNIPEG
WATER AND WASTE DEPARTMENT
ENGINEERING DIVISION

Winnipeg


NEWPCC CENTRATE NUTRIENT TREATMENT NITROGEN REMOVAL FACILITY

ARCHITECTURAL BUILDING SECTION & DETAILS


CITY FILE NUMBER
SHEET OF
CITY DRAWING NUMBER
1-0101C-B0006-001-05

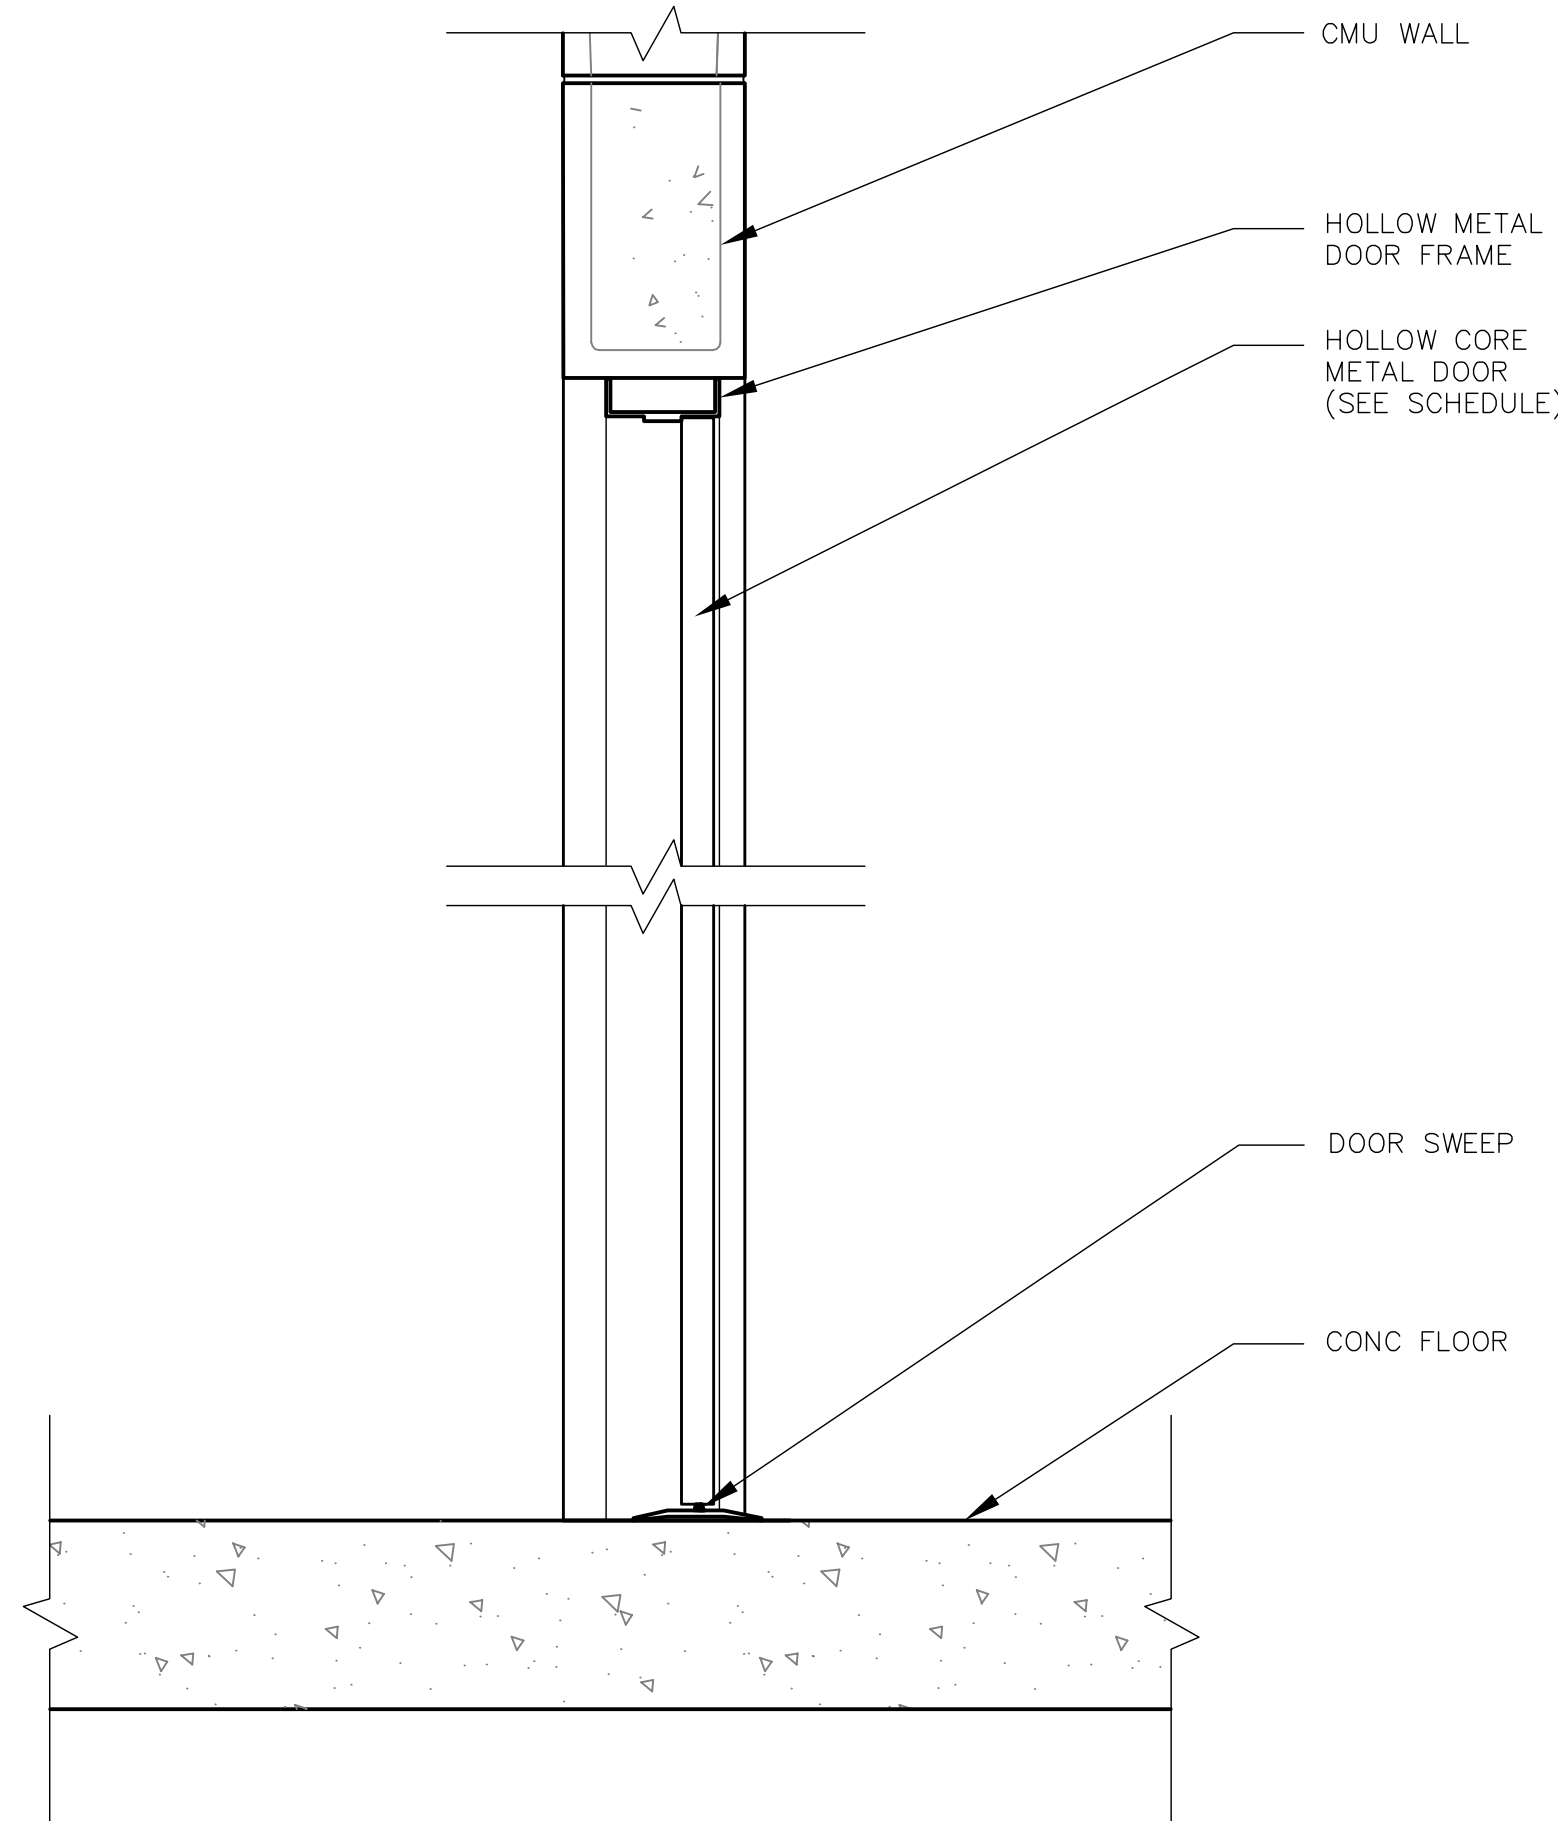


1 INTERIOR DOOR SECTION DETAIL
A1.02 1:10

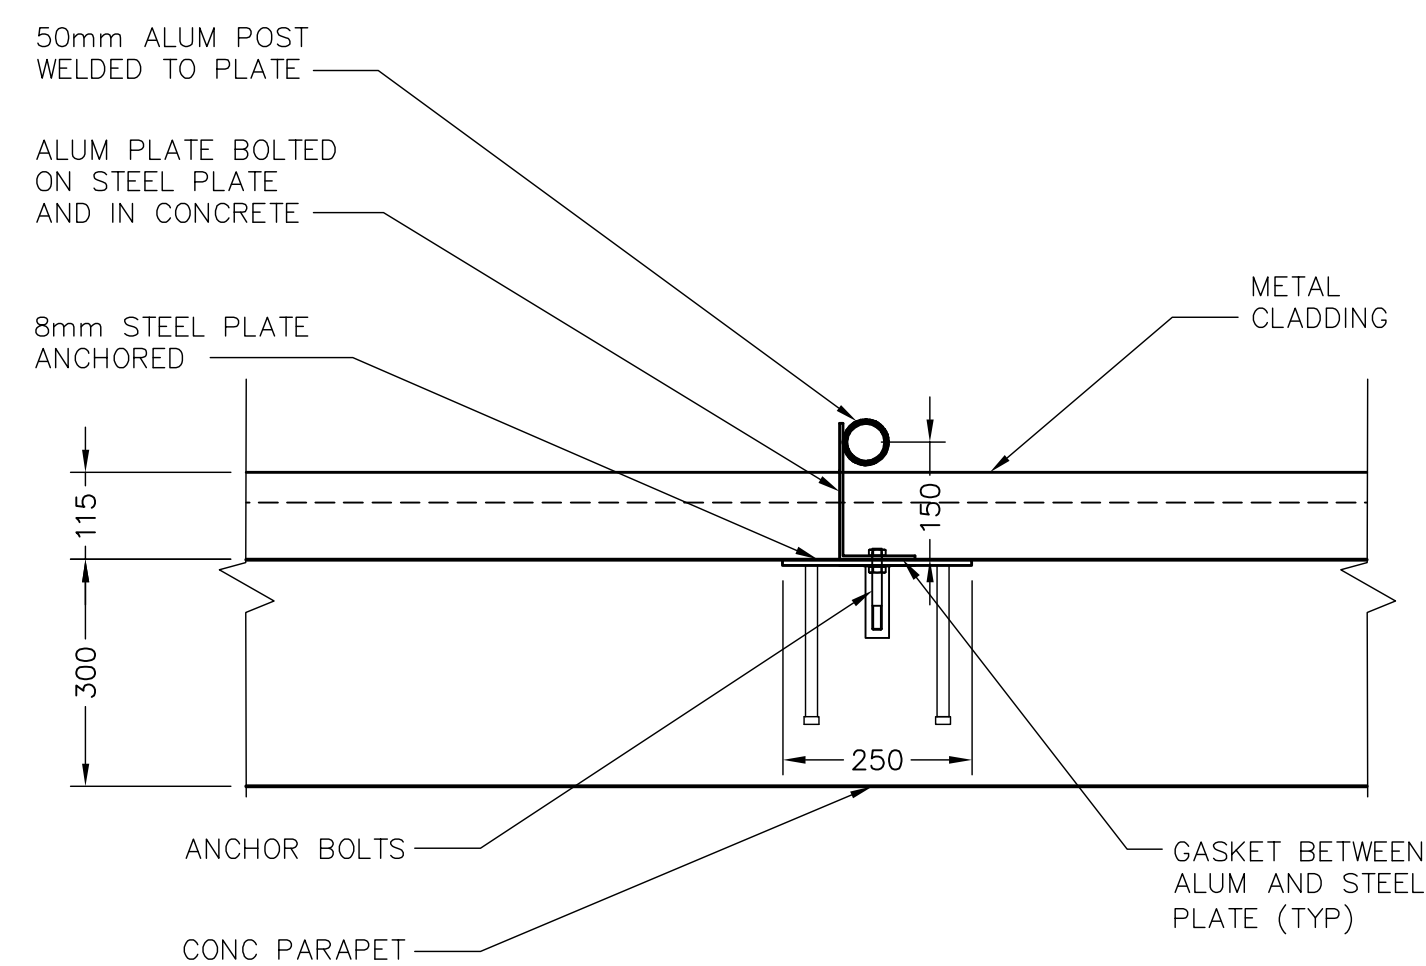


4 ALUM RAILING CONNECTION DETAIL-PLAN
A3.01 1:10

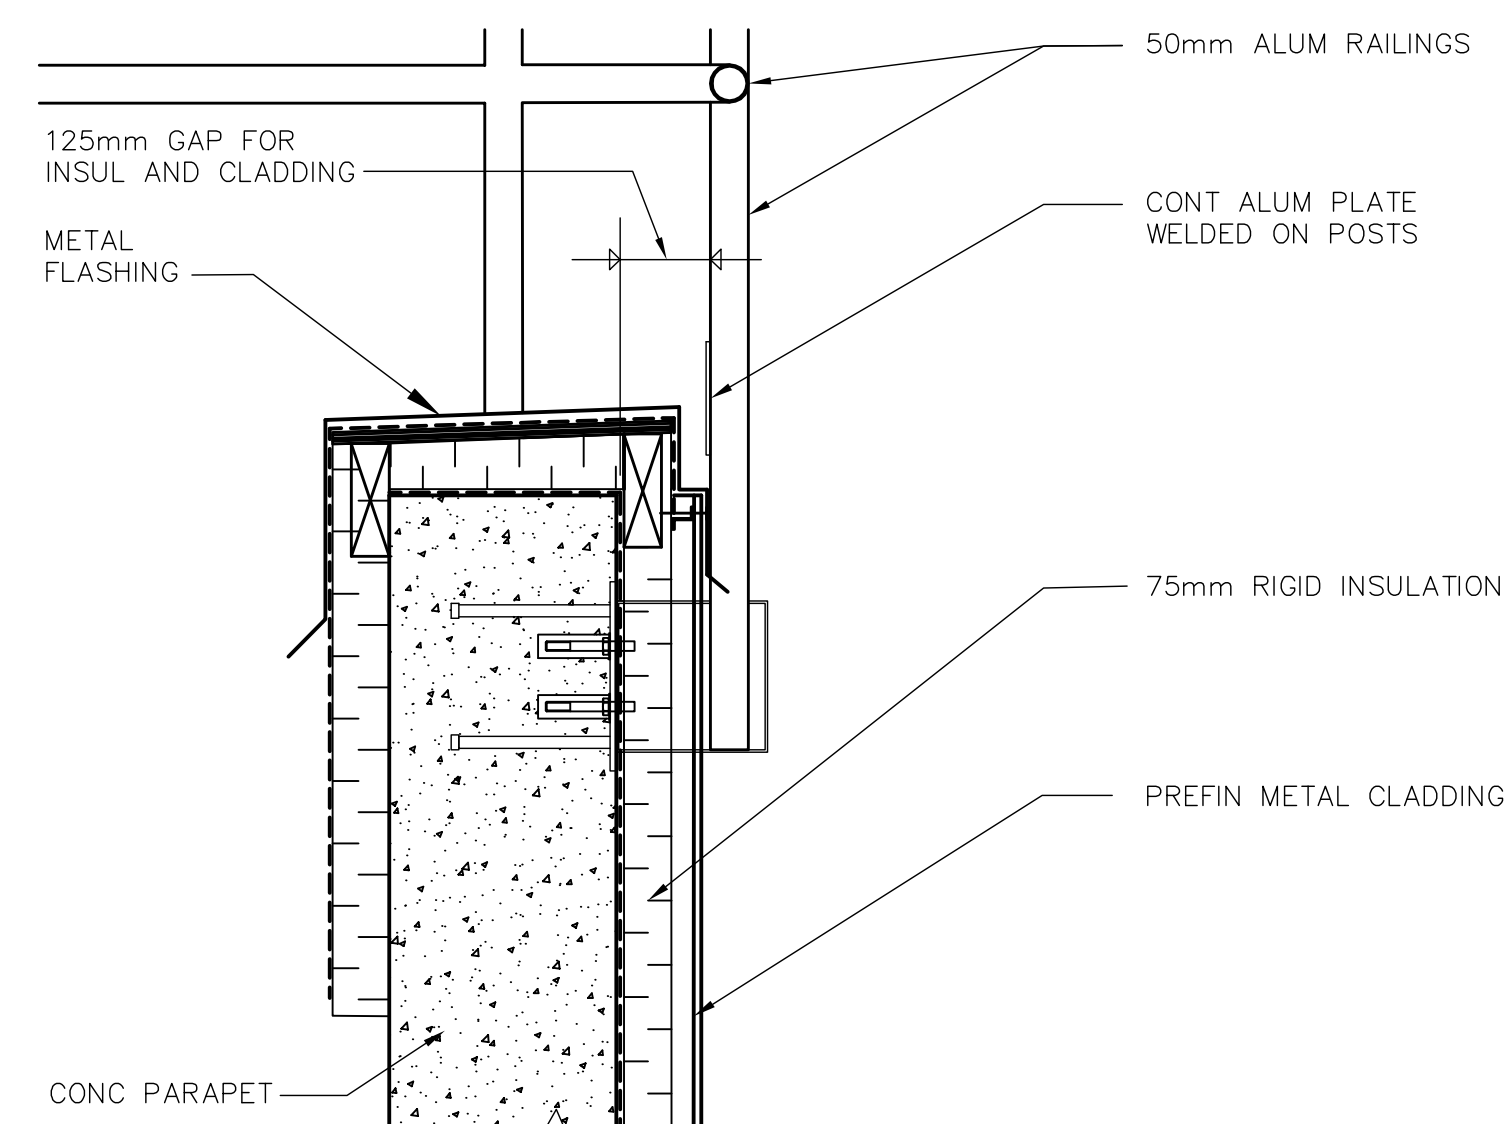


5 ALUM RAILING CONNECTION DETAIL-SECTION
A3.01 1:10

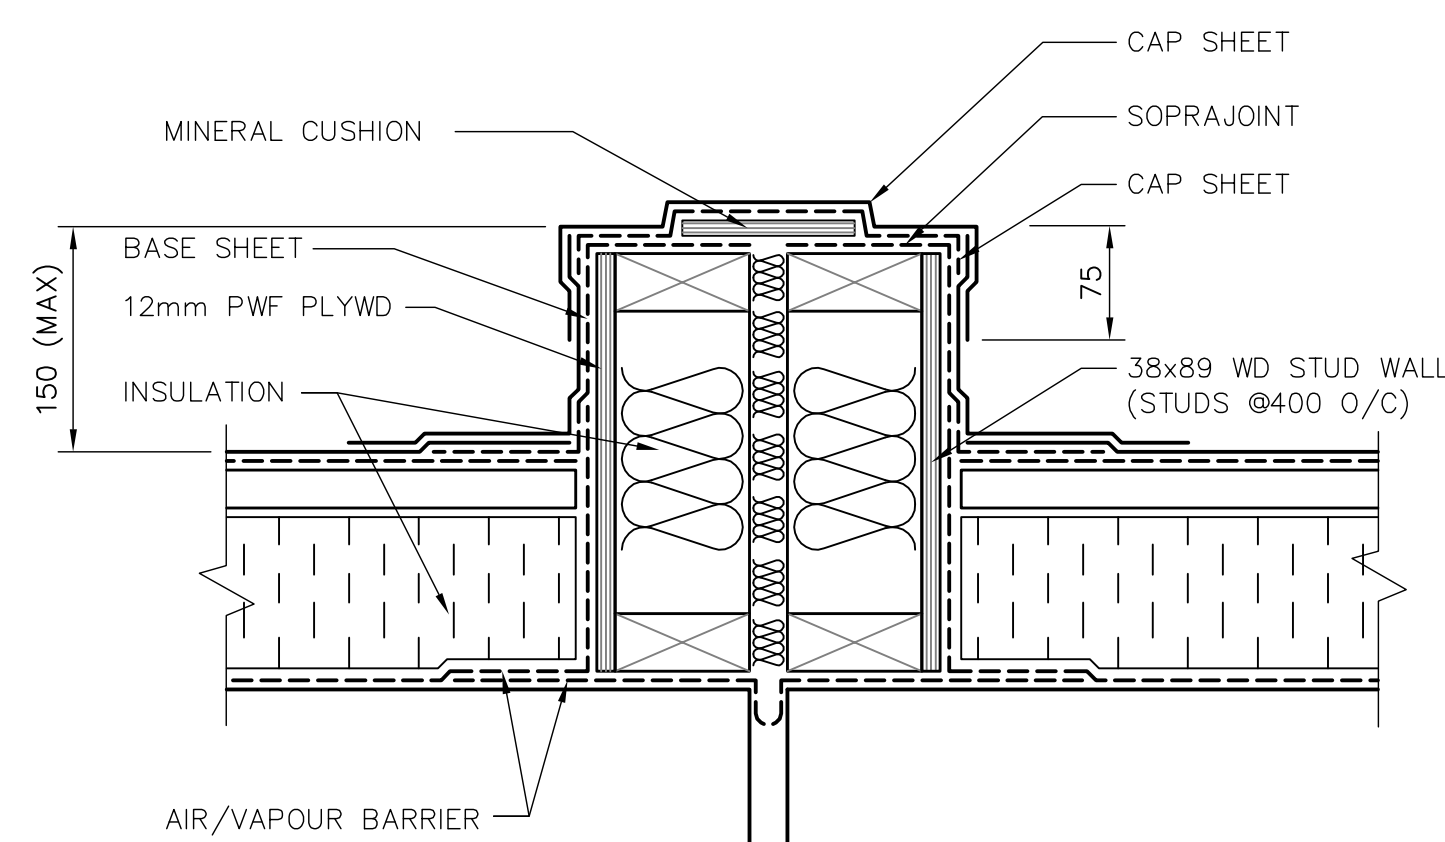


7 ROOF EXPANSION JOINT
A1.01 1:5

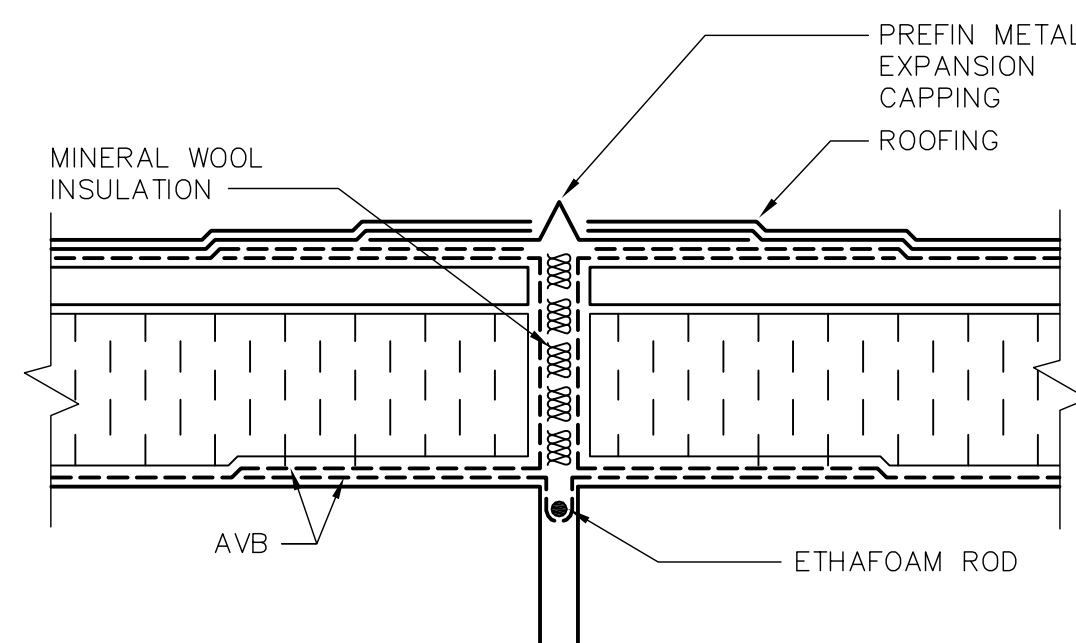

8 ROOF EXPANSION JOINT
A1.01 1:5

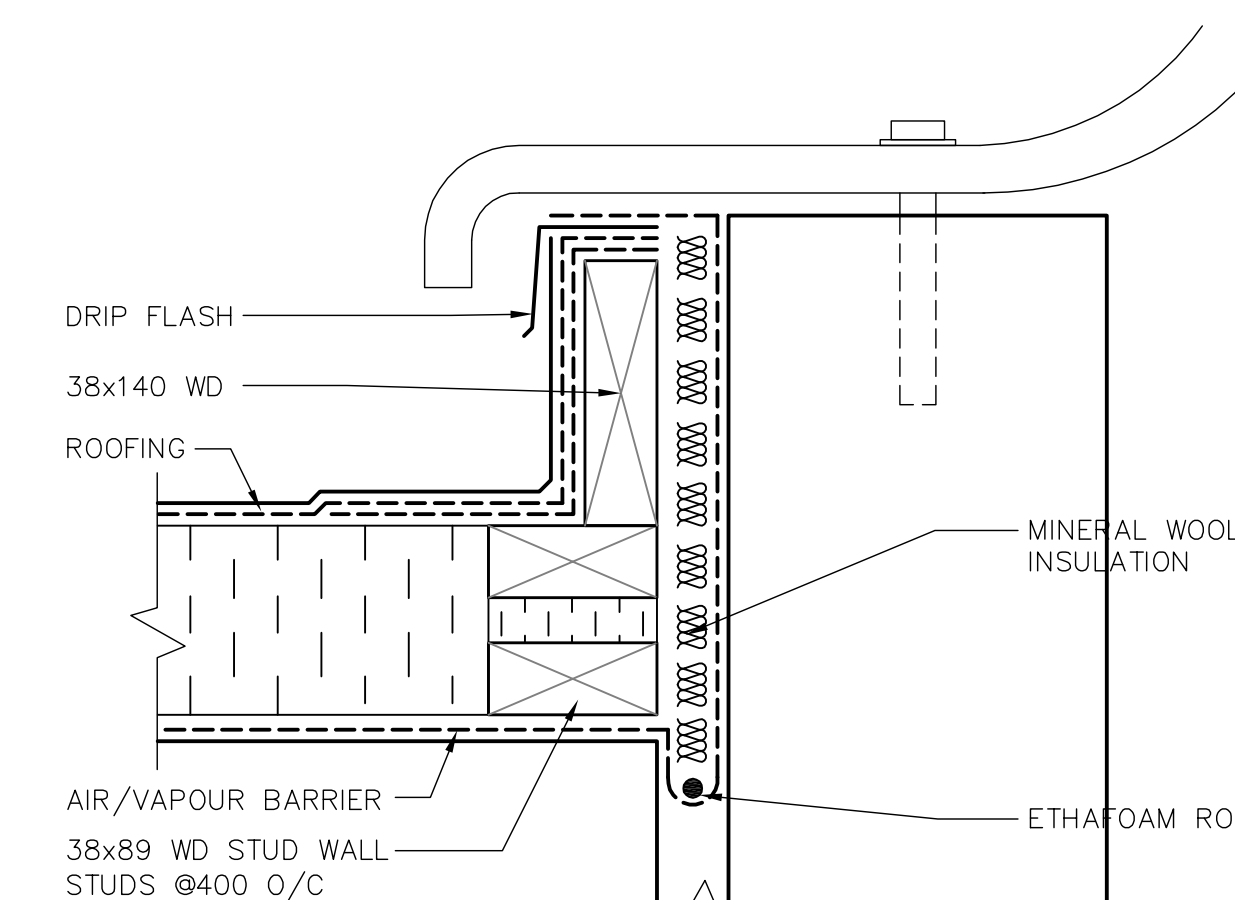


9 ROOF CURB
A1.01 1:5

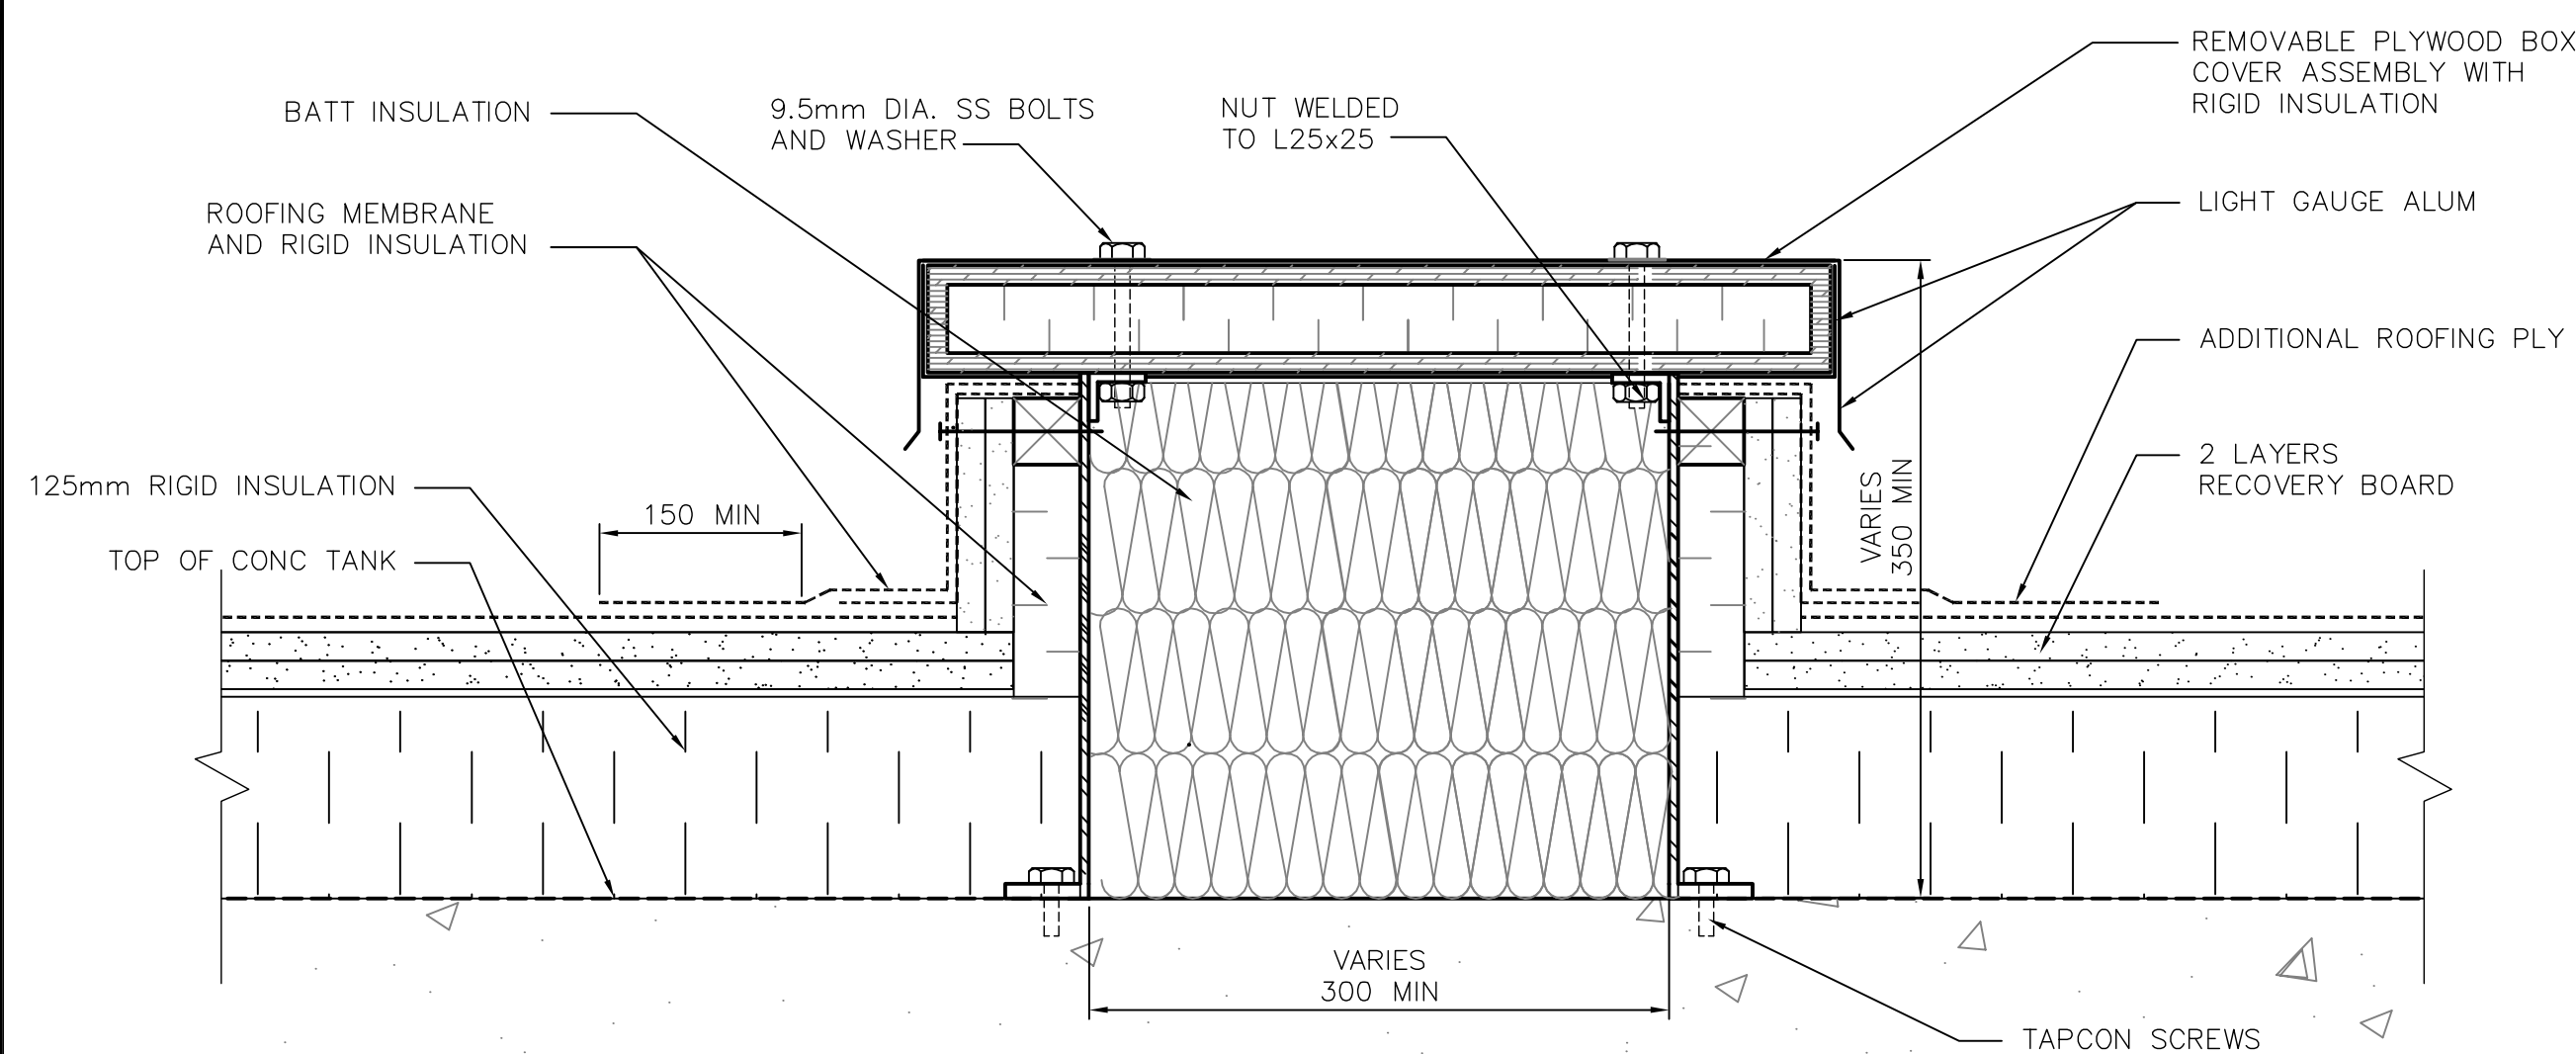


6 TYPICAL DAVIT CRANE SLEEVE SECTION
SCALE 1:5

NOTE: SEE PROCESS DRAWINGS FOR LOCATIONS AND DIMENSIONS REQUIRED FOR DAVIT CRANE SLEEVE

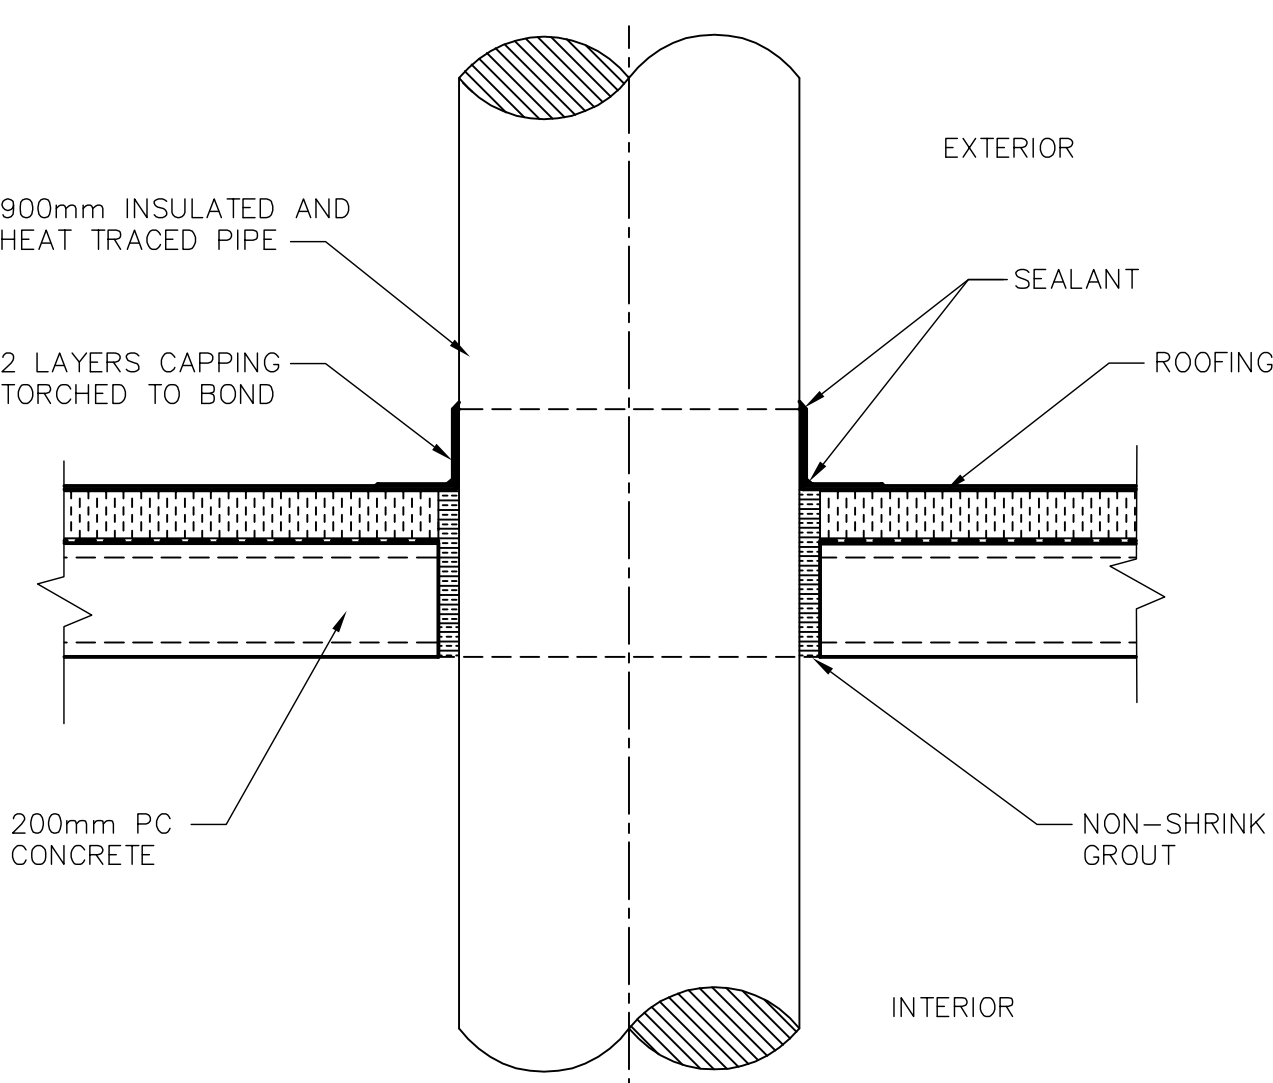

2 ROOF PIPE PENETRATION DETAIL (TYP)
A3.02 1:20

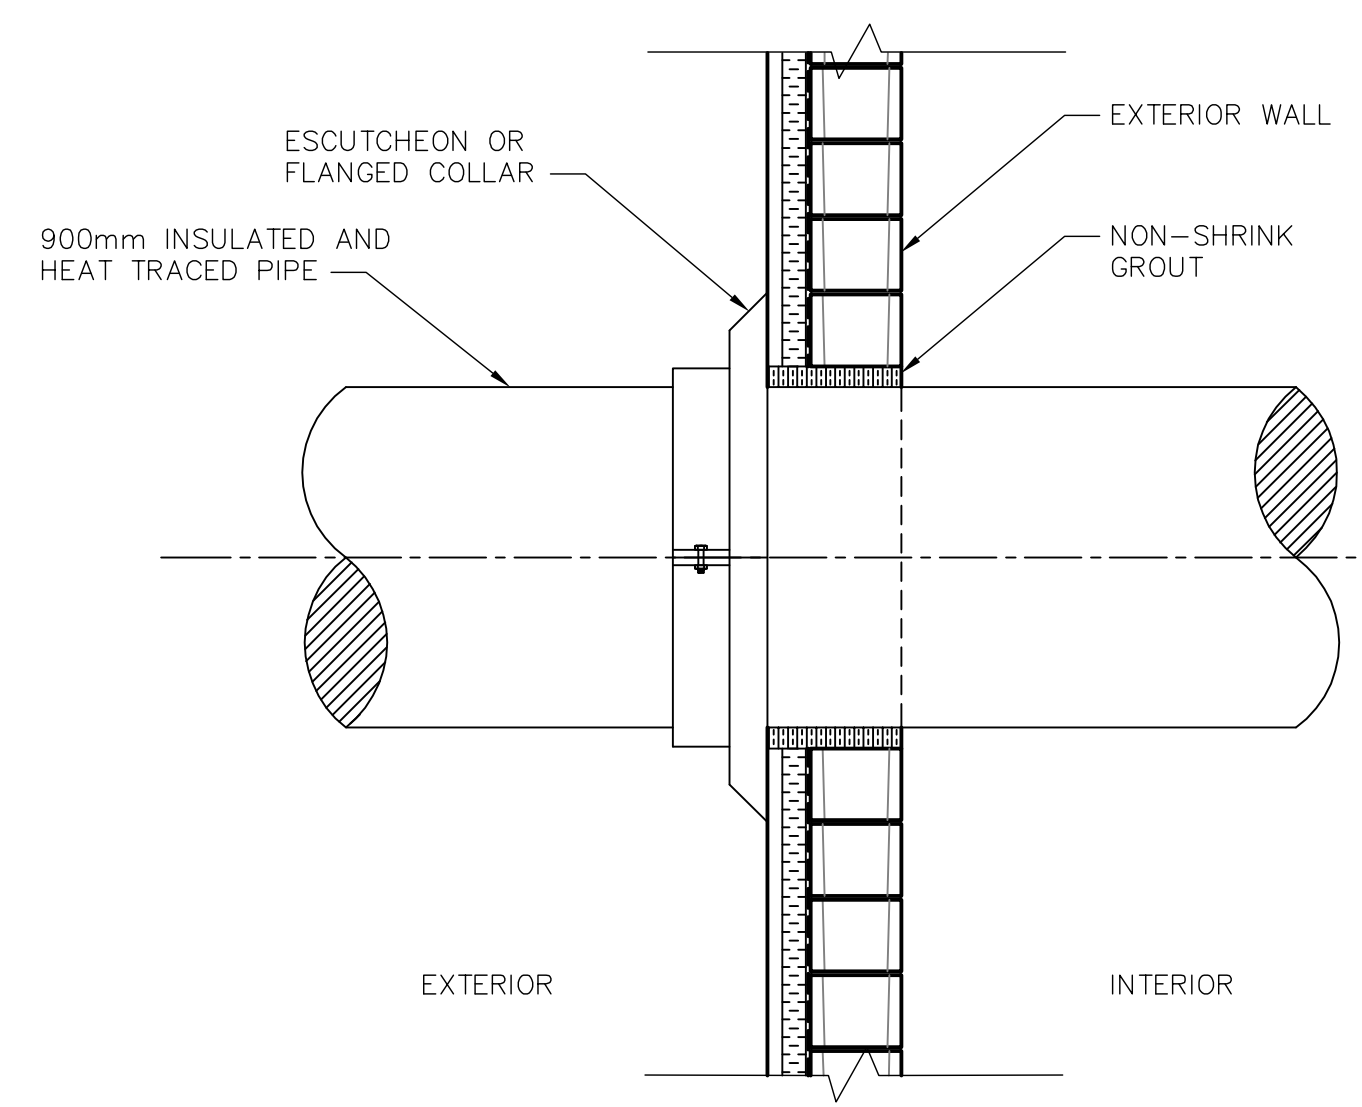

3 WALL PIPE PENETRATION DETAIL (TYP)
A1.01 1:20

AECOM

AECOM WINNIPEG
AS-CONSTRUCTED





NO.	REVISIONS	DATE	BY
03	AS-CONSTRUCTED DRAWING	09/04/16	AL
02	ISSUED FOR CONSTRUCTION	06/08/29	AL
01	291-2006 ADDENDUM 6	06/07/26	AL
00	ISSUED FOR TENDER	06/05/15	AL

<p>A Tyco International Ltd. Company</p>	
DESIGNED BY: NC	CHECKED BY: LK
DRAWN BY: AL	APPROVED BY: JEH
HOR. SCALE: AS NOTED	RELEASED FOR CONSTRUCTION BY: K. MARTENS
VERTICAL SCALE: AS NOTED	DATE: 2006/05/15
DATE: 2006/03/21	

ENGINEER'S SEAL
ORIGINAL SIGNED BY: N. COOPER
DATE: 2006/05/15
CONSULTANT DRAWING NO. A4.03


<p>THE CITY OF WINNIPEG WATER AND WASTE DEPARTMENT ENGINEERING DIVISION</p>	
NEWPCC CENTRATE NUTRIENT TREATMENT NITROGEN REMOVAL FACILITY	CITY FILE NUMBER
ARCHITECTURAL MISCELLANEOUS DETAILS	SHEET OF
	CITY DRAWING NUMBER
	1-0101C-B0009-001-03

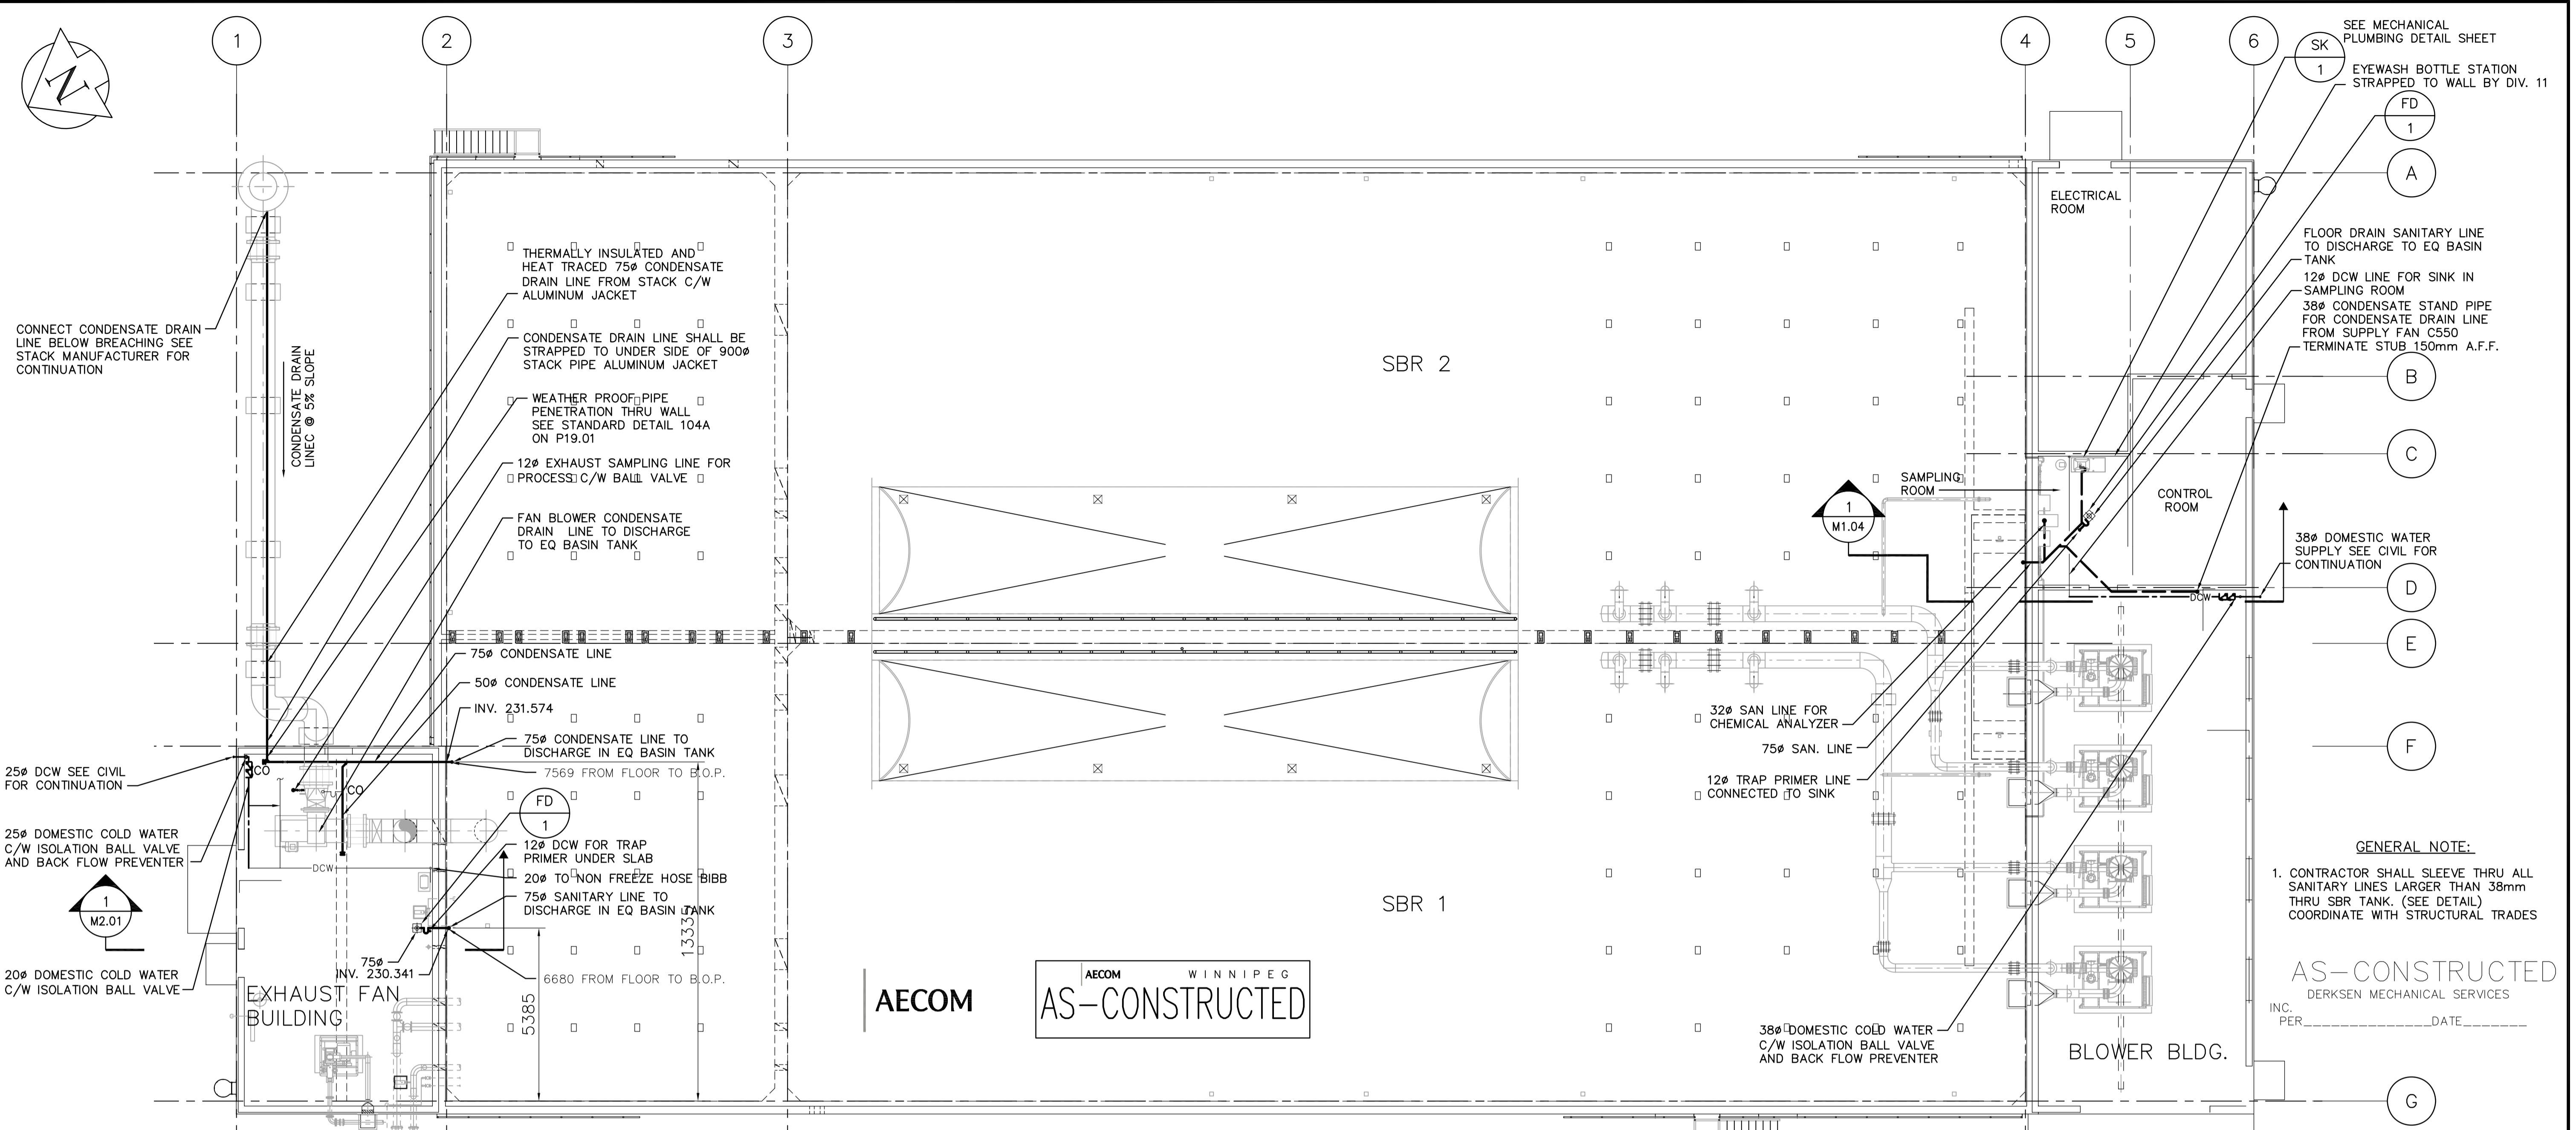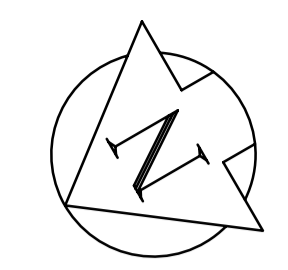


- SEE MECHANICAL PLUMBING DETAIL SHEET
- EYEWASH BOTTLE STATION STRAPPED TO WALL BY DIV. 11
- FLOOR DRAIN SANITARY LINE TO DISCHARGE TO EQ BASIN TANK
- 12ø DCW LINE FOR SINK IN SAMPLING ROOM
- 38ø CONDENSATE STAND PIPE FOR CONDENSATE DRAIN LINE FROM SUPPLY FAN C550 TERMINATE STUB 150mm A.F.F.
- 38ø DOMESTIC WATER SUPPLY SEE CIVIL FOR CONTINUATION
- GENERAL NOTE:**
1. CONTRACTOR SHALL SLEEVE THRU ALL SANITARY LINES LARGER THAN 38mm THRU SBR TANK. (SEE DETAIL) COORDINATE WITH STRUCTURAL TRADES

AS-CONSTRUCTED
DERKSEN MECHANICAL SERVICES
INC. PER _____ DATE _____

1 SBR, BLOWER BLDG & EXHAUST BLDG - PLUMBING PLAN
M1.01 SCALE 1:100


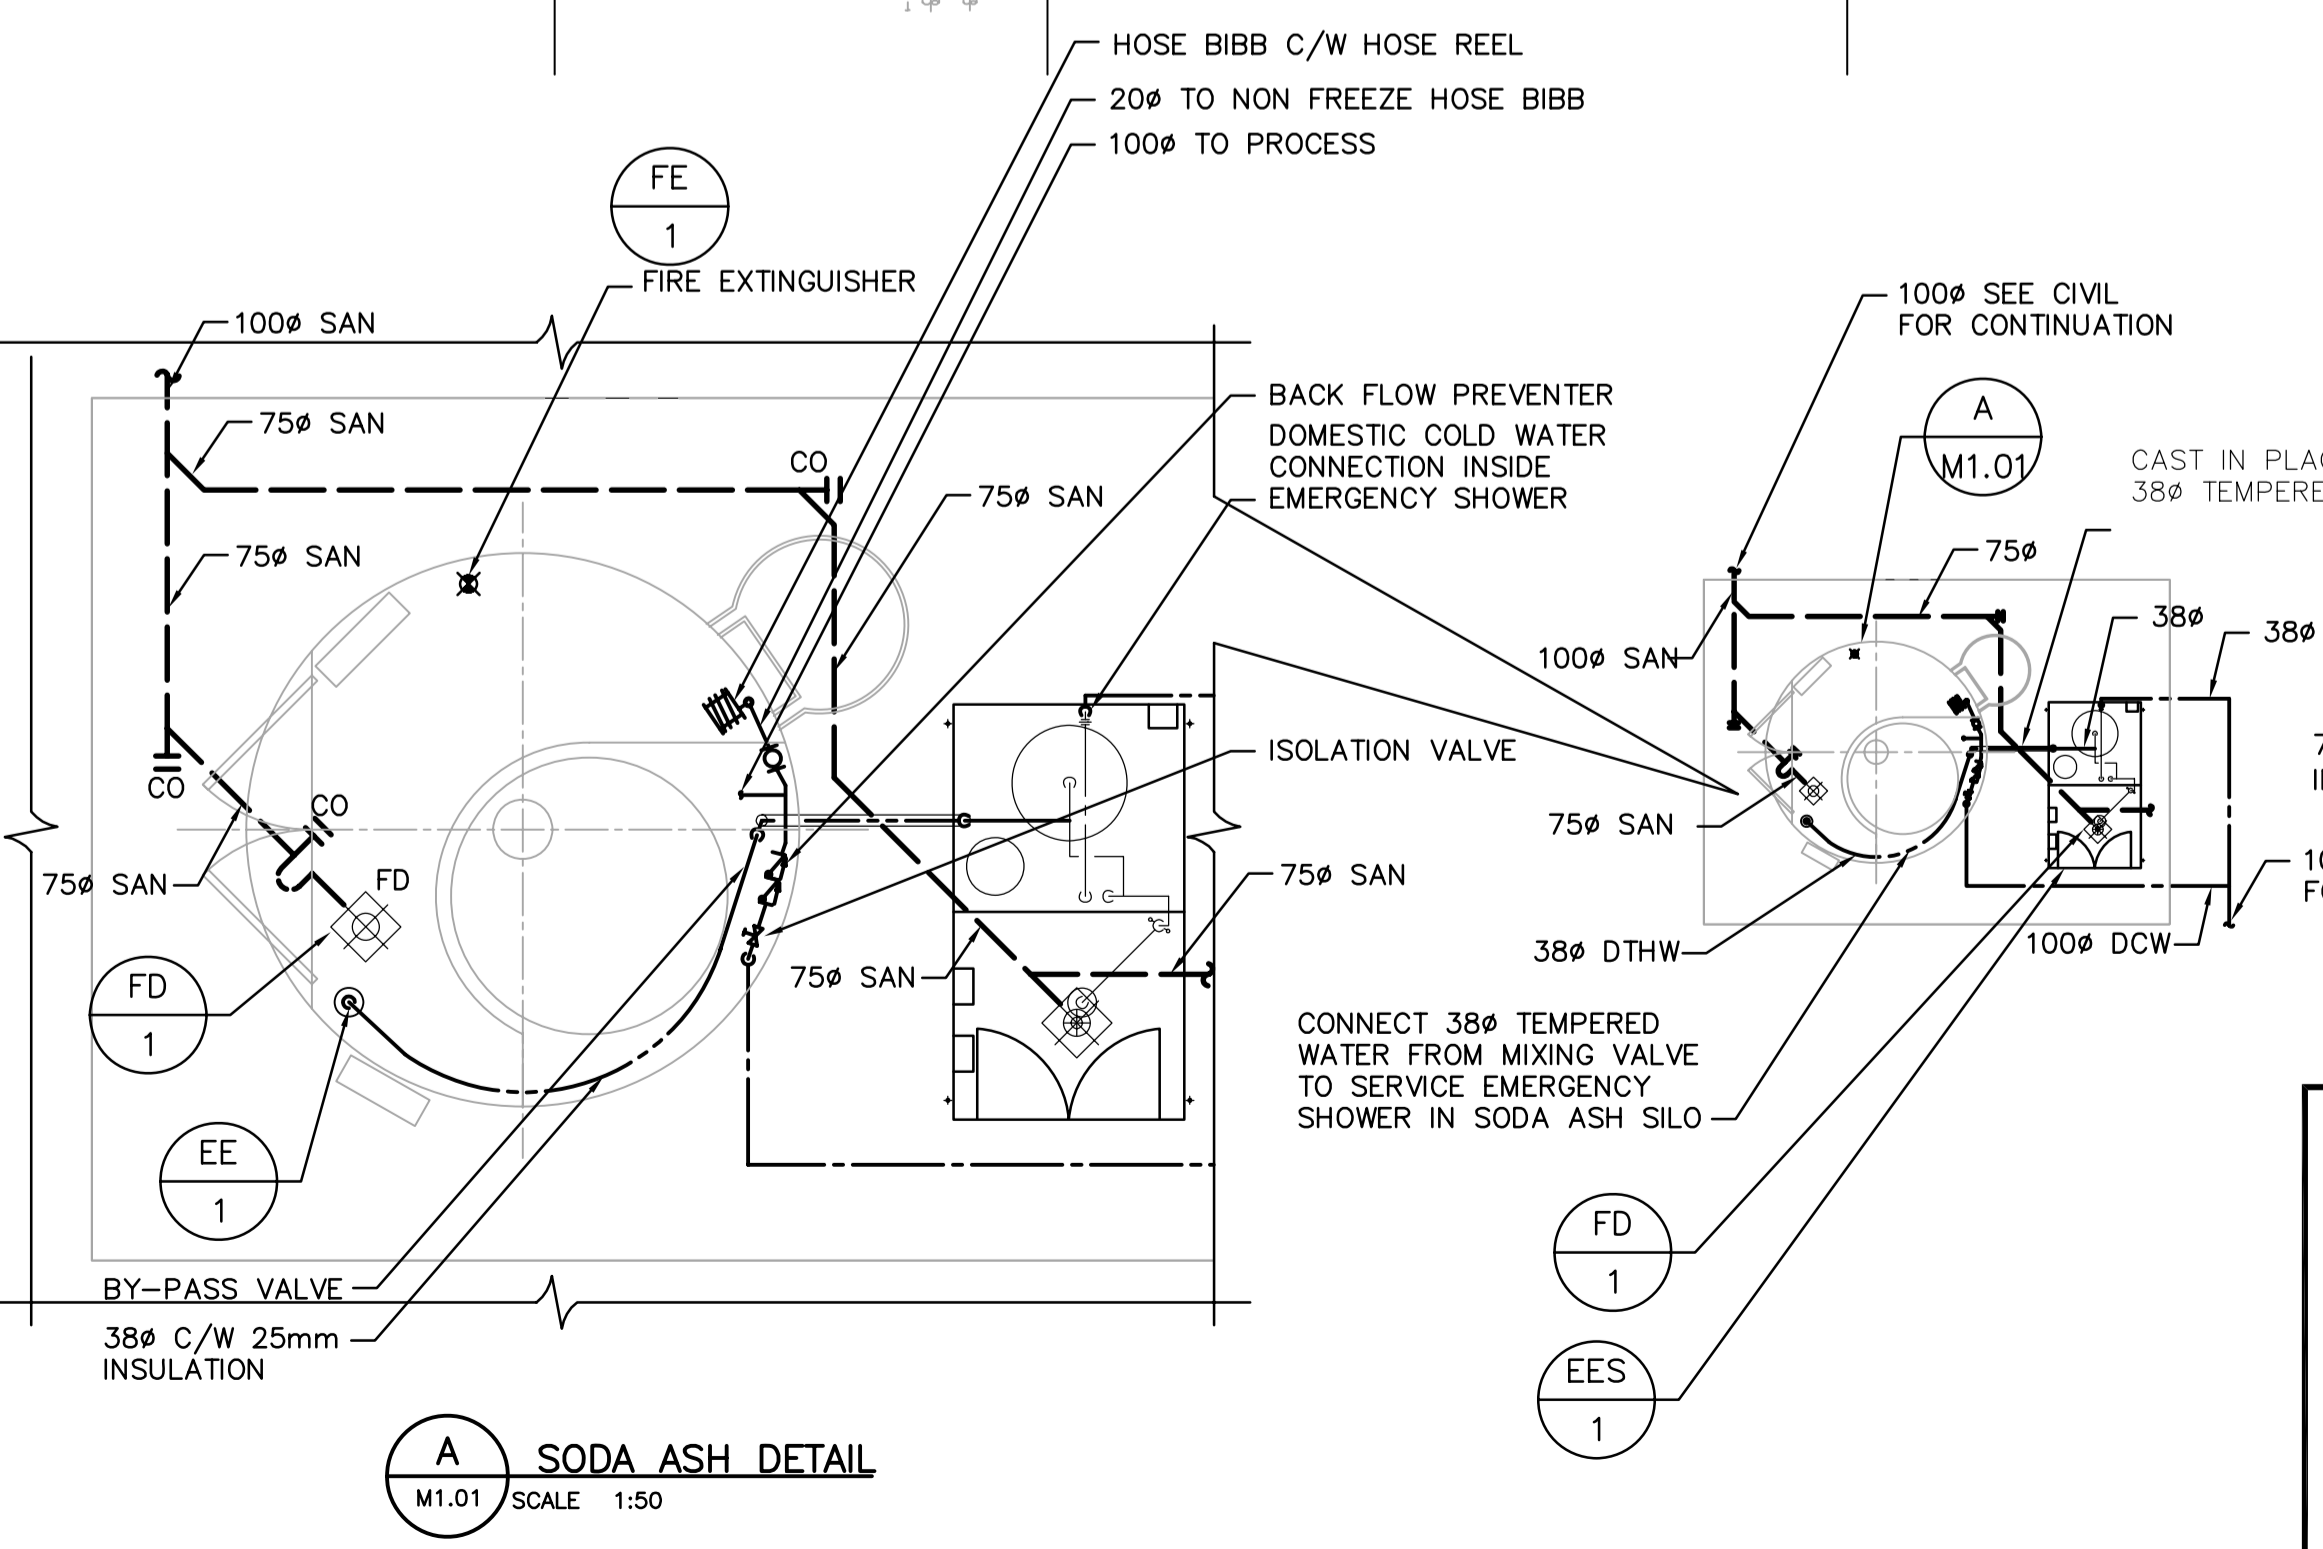


A SODA ASH DETAIL
M1.01 SCALE 1:50

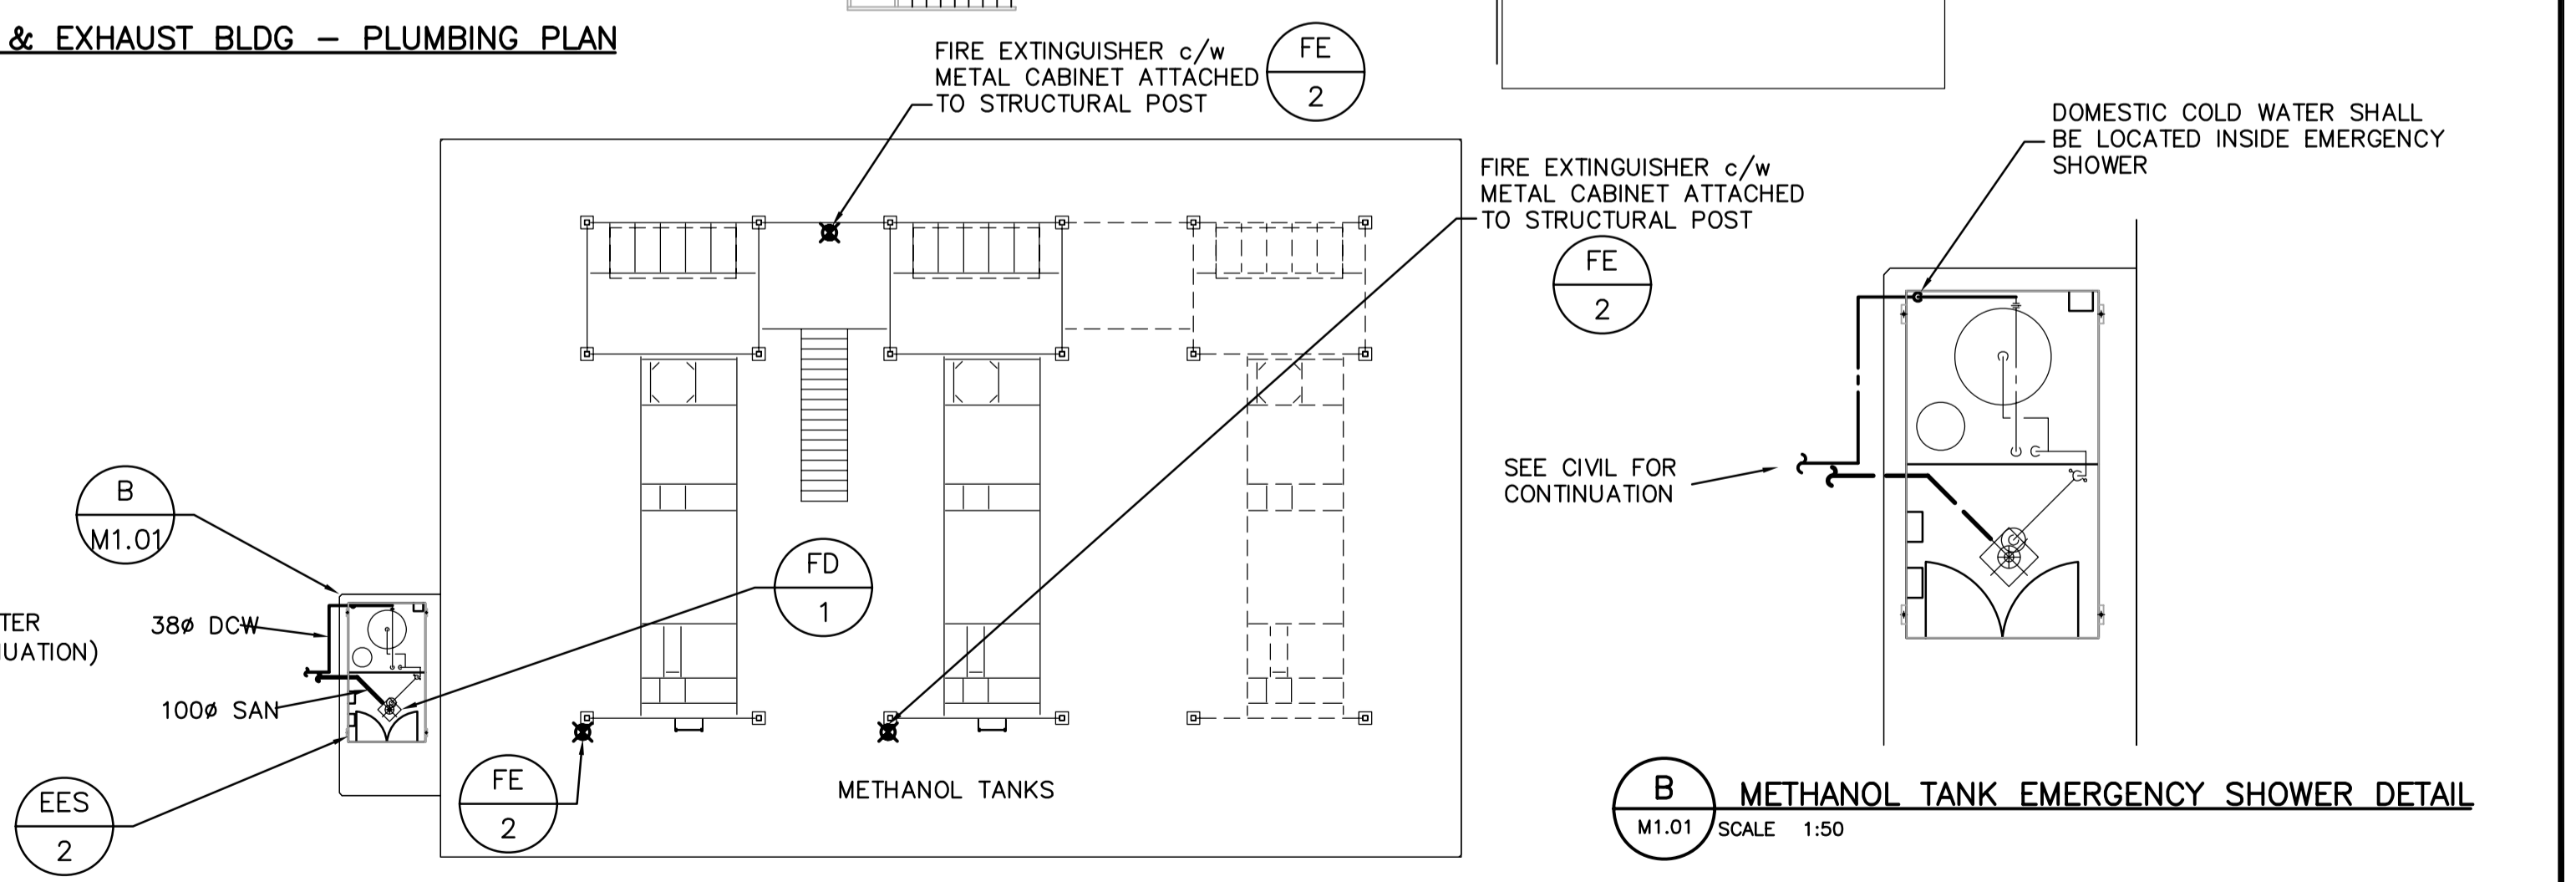

B METHANOL TANK EMERGENCY SHOWER DETAIL
M1.01 SCALE 1:50

 Certificate of Authorization AECOM Canada Ltd. Original dated on: No. 4671 Date: 2006/05/15	 A Tyco International Ltd. Company		ENGINEER'S SEAL ORIGINAL SIGNED BY A. BURACHYNSKY 2006/05/15		 WATER AND WASTE DEPARTMENT ENGINEERING DIVISION NEWPCC CENTRATE NUTRIENT TREATMENT NITROGEN REMOVAL FACILITY CITY FILE NUMBER SHEET OF CITY DRAWING NUMBER 1-0101C-M0002-001-06
	DESIGNED BY: AB	CHECKED BY: AB	CONSULTANT DRAWING NO. M1.01		
	DRAWN BY: DJP	APPROVED BY: JEH			
	SCALE: AS NOTED	RELEASED FOR CONSTRUCTION BY: K. MARTENS			
	DATE: 2006/05/15	DATE: 2006/05/23			

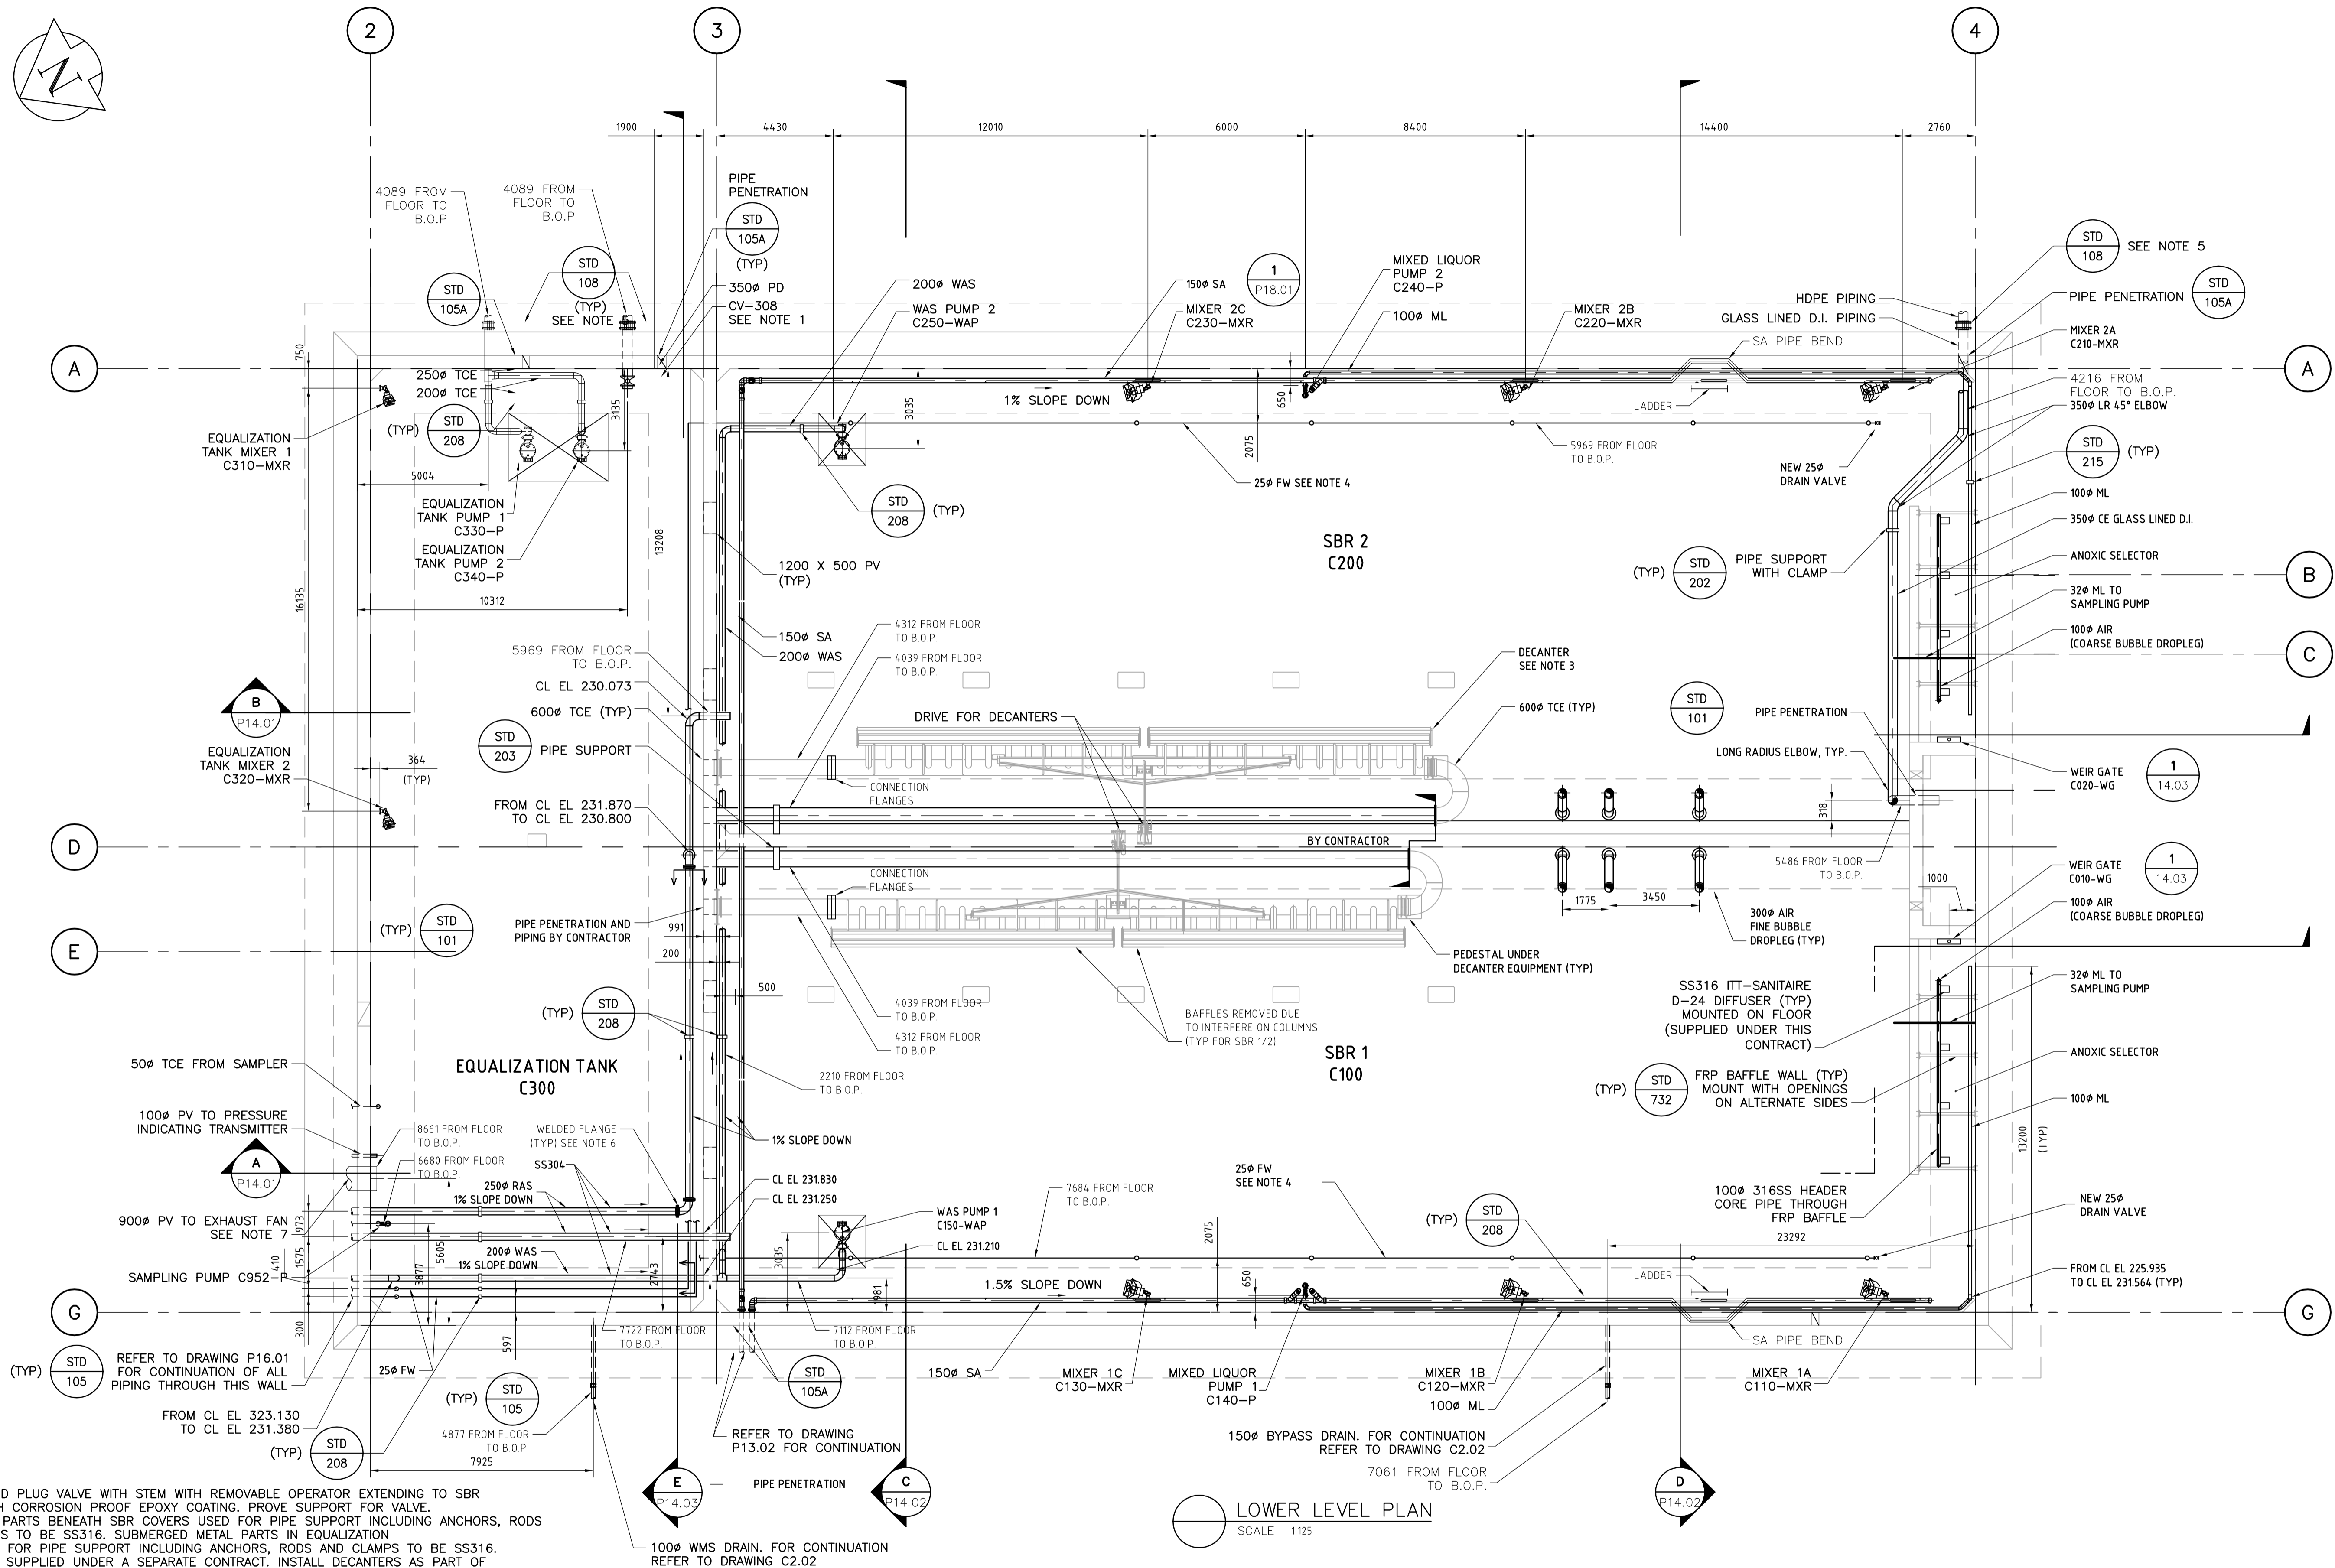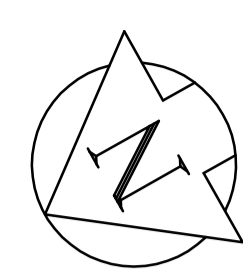

- NOTES:**
- GLASS LINED PLUG VALVE WITH STEM WITH REMOVABLE OPERATOR EXTENDING TO SBR COVER WITH CORROSION PROOF EPOXY COATING. PROVIDE SUPPORT FOR VALVE.
 - ALL METAL PARTS BENEATH SBR COVERS USED FOR PIPE SUPPORT INCLUDING ANCHORS, RODS AND CLAMPS TO BE SS316. SUBMERGED METAL PARTS IN EQUALIZATION TANK USED FOR PIPE SUPPORT INCLUDING ANCHORS, RODS AND CLAMPS TO BE SS316.
 - DECANTERS SUPPLIED UNDER A SEPARATE CONTRACT. INSTALL DECANTERS AS PART OF THIS CONTRACT. COORDINATE EXACT DIMENSIONS WITH DECANTER SUPPLIER.
 - PROVIDE SIX WATER SPRINKLERS, EQUALLY SPACED. SPRINKLERS TO BE RAIN-BIRD 2045-PJ MAX BIRD 25 PSI.
 - FOR PIPING CONTINUATION OUTSIDE OF STRUCTURE REFER TO CIVIL DRAWINGS.
 - PROVIDE VICTAULIC FLANGES ON PIPES LOCATED ABOVE THE HIGH WATER LEVEL.
 - REFER TO DRAWING P14.03 FOR ELEVATIONS OF ALL PIPE PENETRATIONS THROUGH THIS WALL.

LOWER LEVEL PLAN
SCALE 1:125

AECOM
As of January 3, 2009, EarthTech became AECOM Canada Ltd.

AS-CONSTRUCTED

AS-CONSTRUCTED
DERKSEN MECHANICAL SERVICES INC.
PER _____ DATE _____

APEGM
Certificate of Authorization
AECOM Canada Ltd.
Original dated on: No. 4671 Date: 2006/05/15

NO.	REVISIONS	DATE	BY
05	AS-CONSTRUCTED DRAWING	09/02/18	CD
04	ISSUED FOR FI-0-21	07/10/10	LAE
03	ISSUED FOR CONSTRUCTION	06/08/30	GLG
02	291-2006 ADDENDUM 6	06/07/26	SRP
01	291-2006 ADDENDUM 3	06/07/12	LAE
00	ISSUED FOR TENDER	06/05/15	GLG

EarthTech
A Tyco International Ltd. Company

DESIGNED BY: YL	CHECKED BY: SB
DRAWN BY: SRP	APPROVED BY: JEH
SCALE: 1:125	RELEASED FOR CONSTRUCTION BY: K. MARTENS
DATE: 2006/01/16	DATE: 2006/05/15


ENGINEER'S SEAL
ORIGINAL SIGNED BY: J.E. HUTCHISON
2006/05/15
CONSULTANT DRAWING NO. P13.01

THE CITY OF WINNIPEG
WATER AND WASTE DEPARTMENT
ENGINEERING DIVISION

NEWPCC CENTRATE NUTRIENT TREATMENT NITROGEN REMOVAL FACILITY

PROCESS PROCESS TANKS LOWER LEVEL PLAN

CITY FILE NUMBER
SHEET OF
CITY DRAWING NUMBER
1-0101C-P0033-001-05

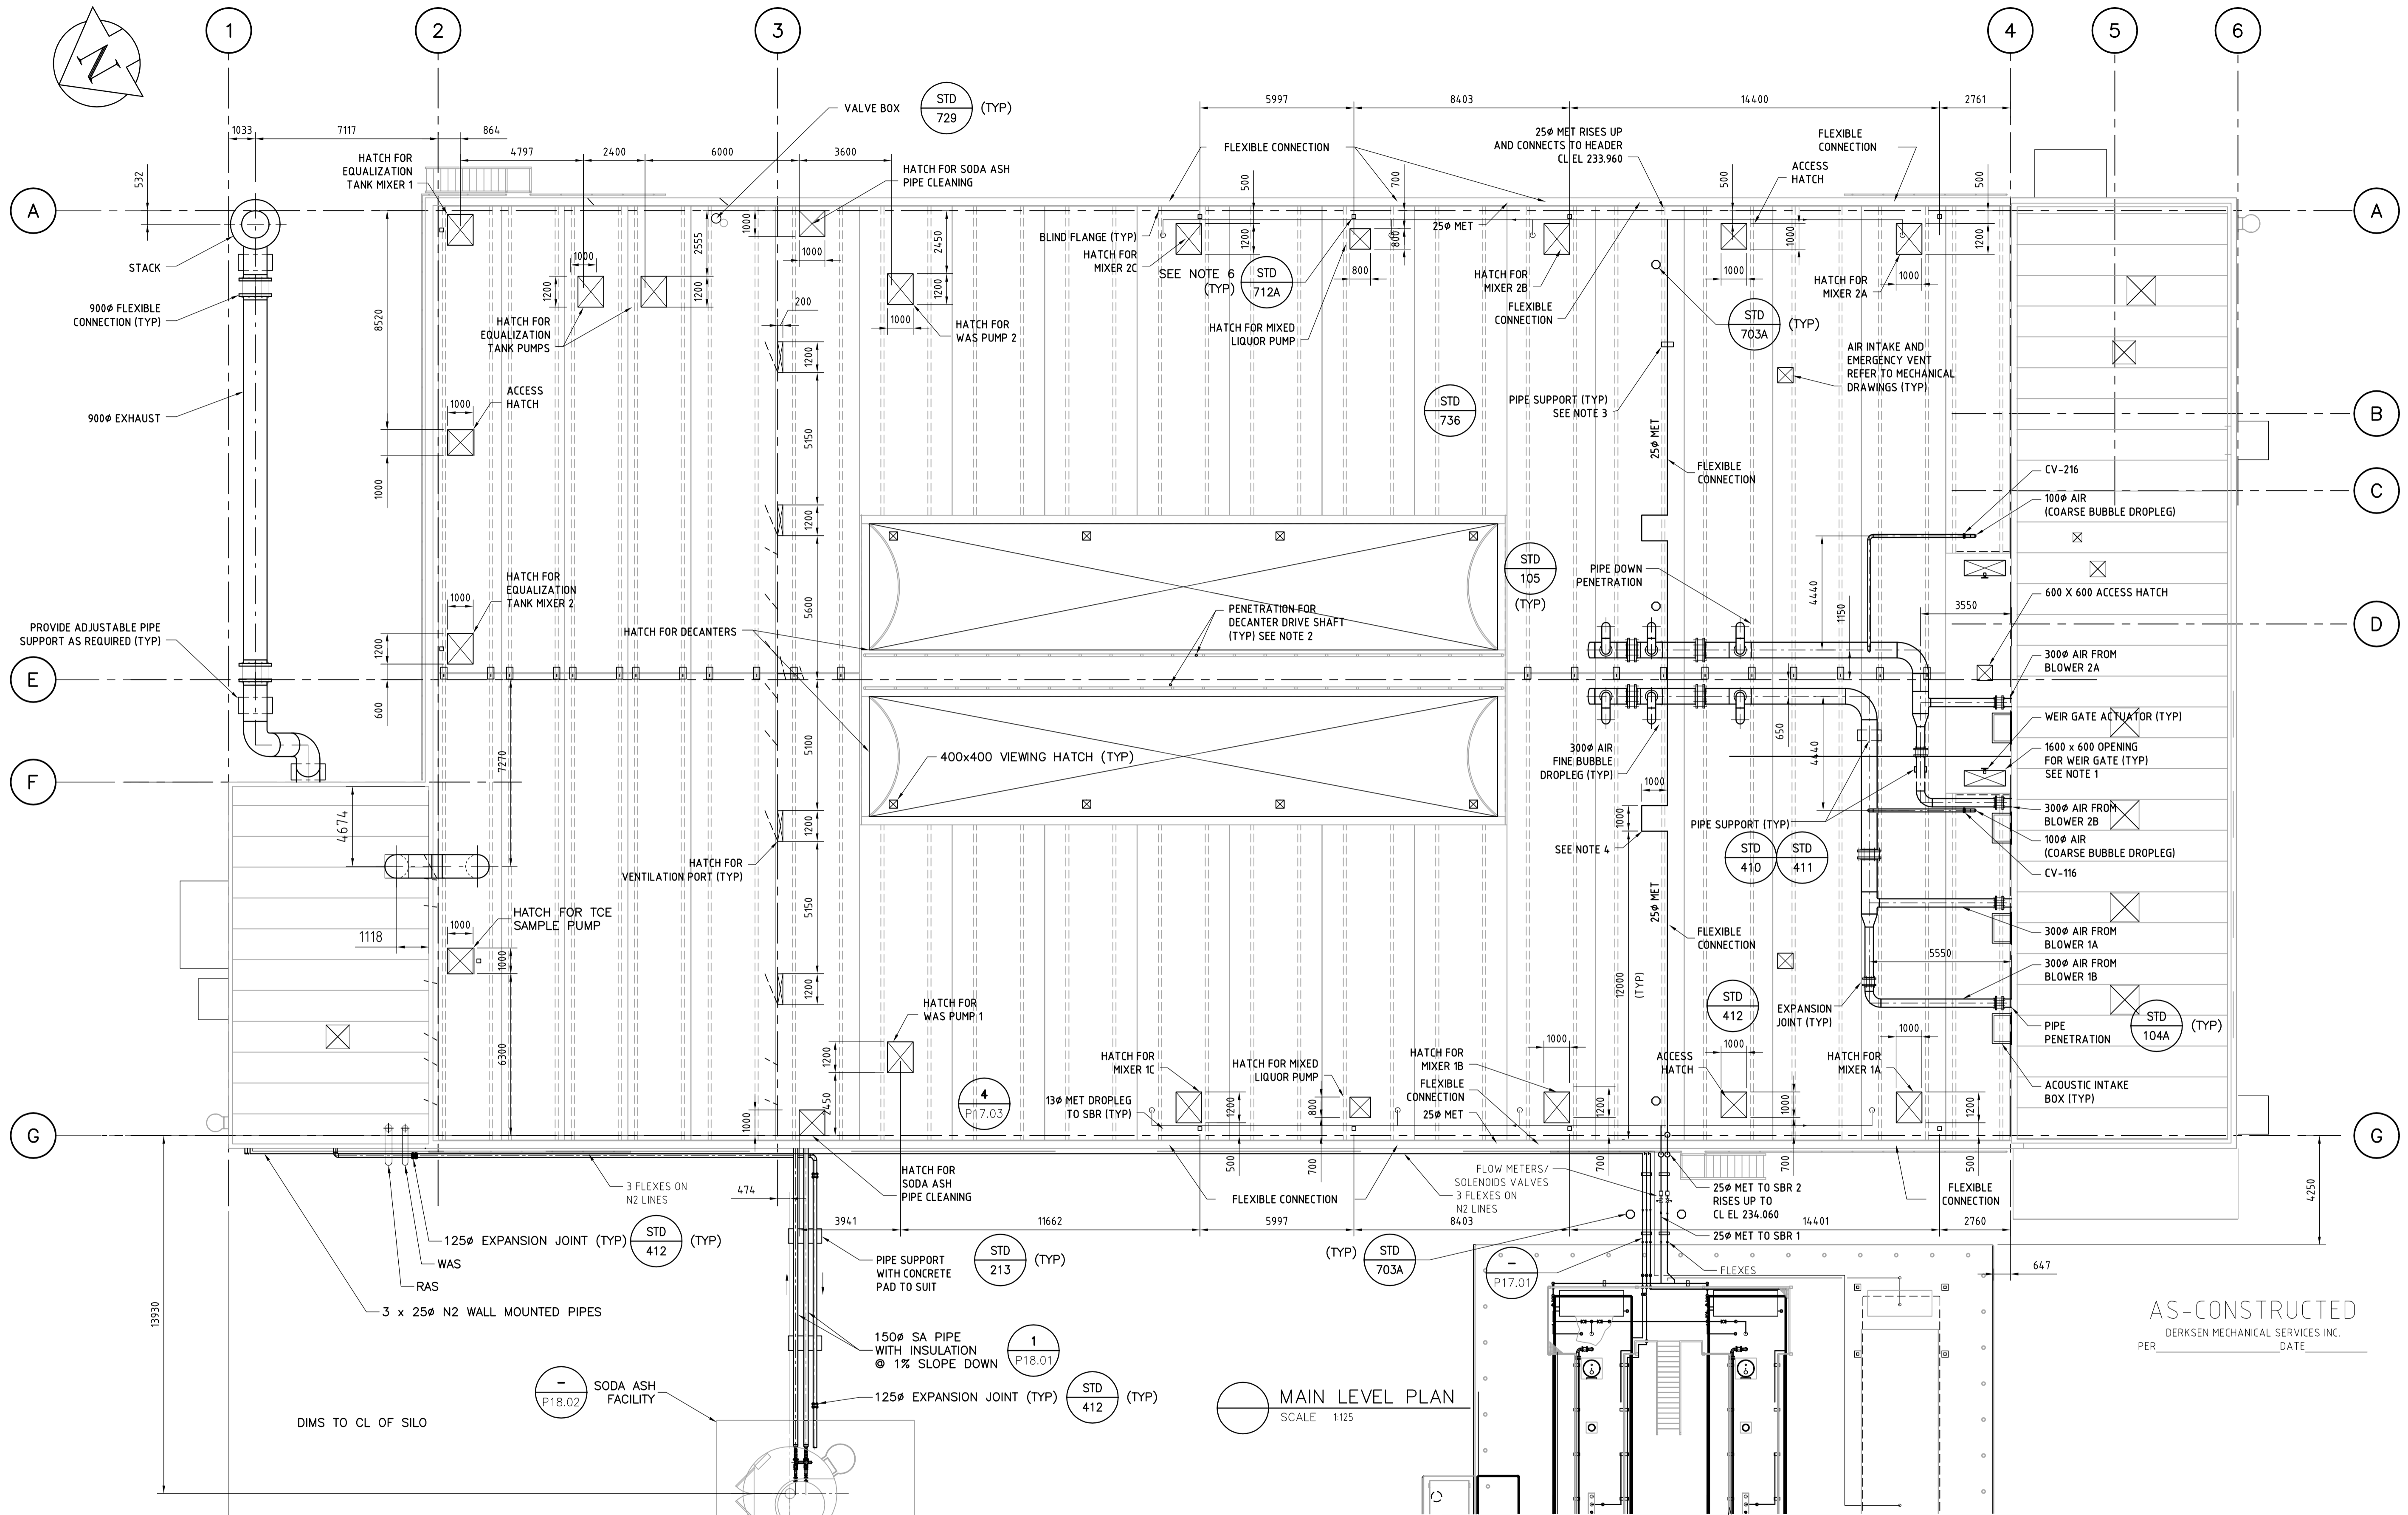

AS-CONSTRUCTED
 DERKSEN MECHANICAL SERVICES INC.
 PER _____ DATE _____

- NOTES:**
- COORDINATE EXACT OPENING SIZE WITH SUPPLIER OF WEIR GATE. REFER TO DETAIL 1 ON DRAWING P14.03.
 - COORDINATE EXACT PENETRATION SIZE AND LOCATION WITH SUPPLIER OF DECATERS. (PROVIDE SEAL TO SUIT)
 - ADJUST SUPPORT TO PROVIDE 100 TO 150 mm CLEAR SPACE BETWEEN MET PIPE AND FINISHED SBR ROOF.
 - PROVIDE FLEXIBLE CONNECTION ON EACH ELBOW.
 - REFER TO STRUCTURAL DRAWINGS FOR HATCH DETAILS.
 - COORDINATE EXACT LOCATION OF PEDESTAL IN THE FIELD.
 - COORDINATE LOCATION OF HATCHES WITH SUPPLIER AND CONTRACT ADMINISTRATOR.

AECOM
 Original dated on: _____
 As of January 3, 2009, EarthTech became AECOM Canada Ltd.
AS-CONSTRUCTED

APEGM
 Certificate of Authorization
 AECOM Canada Ltd.
 Original dated on: _____
 No. 4671 Date: 2006/05/15

NO.	REVISIONS	DATE	BY
05	AS-CONSTRUCTED DRAWING	09/02/18	CD
04	ISSUED FOR CLARIFICATION	06/11/08	JBC
03	ISSUED FOR RFI NO. HO-4	06/10/25	LW
02	ISSUED FOR CONSTRUCTION	06/08/30	GLG
01	291-2006 ADDEDNDUM 6	06/07/26	SRP
00	ISSUED FOR TENDER	06/05/15	GLG

EarthTech
 A Tyco International Ltd. Company

DESIGNED BY: YL	CHECKED BY: SB
DRAWN BY: SRP	APPROVED BY: JEH
SCALE: 1:125	RELEASED FOR CONSTRUCTION BY: K. MARTENS
DATE: 2006/01/16	DATE: 2006/05/15


ENGINEER'S SEAL
 ORIGINAL SIGNED BY: J.E. HUTCHISON
 DATE: 2006/05/15
 CONSULTANT DRAWING NO. P13.02

THE CITY OF WINNIPEG
 WATER AND WASTE DEPARTMENT
ENGINEERING DIVISION


NEWPCC CENTRATE NUTRIENT TREATMENT NITROGEN REMOVAL FACILITY

PROCESS PROCESS TANKS MAIN LEVEL PLAN

CITY FILE NUMBER _____
 SHEET _____ OF _____
 CITY DRAWING NUMBER 1-0101C-P0034-001-05

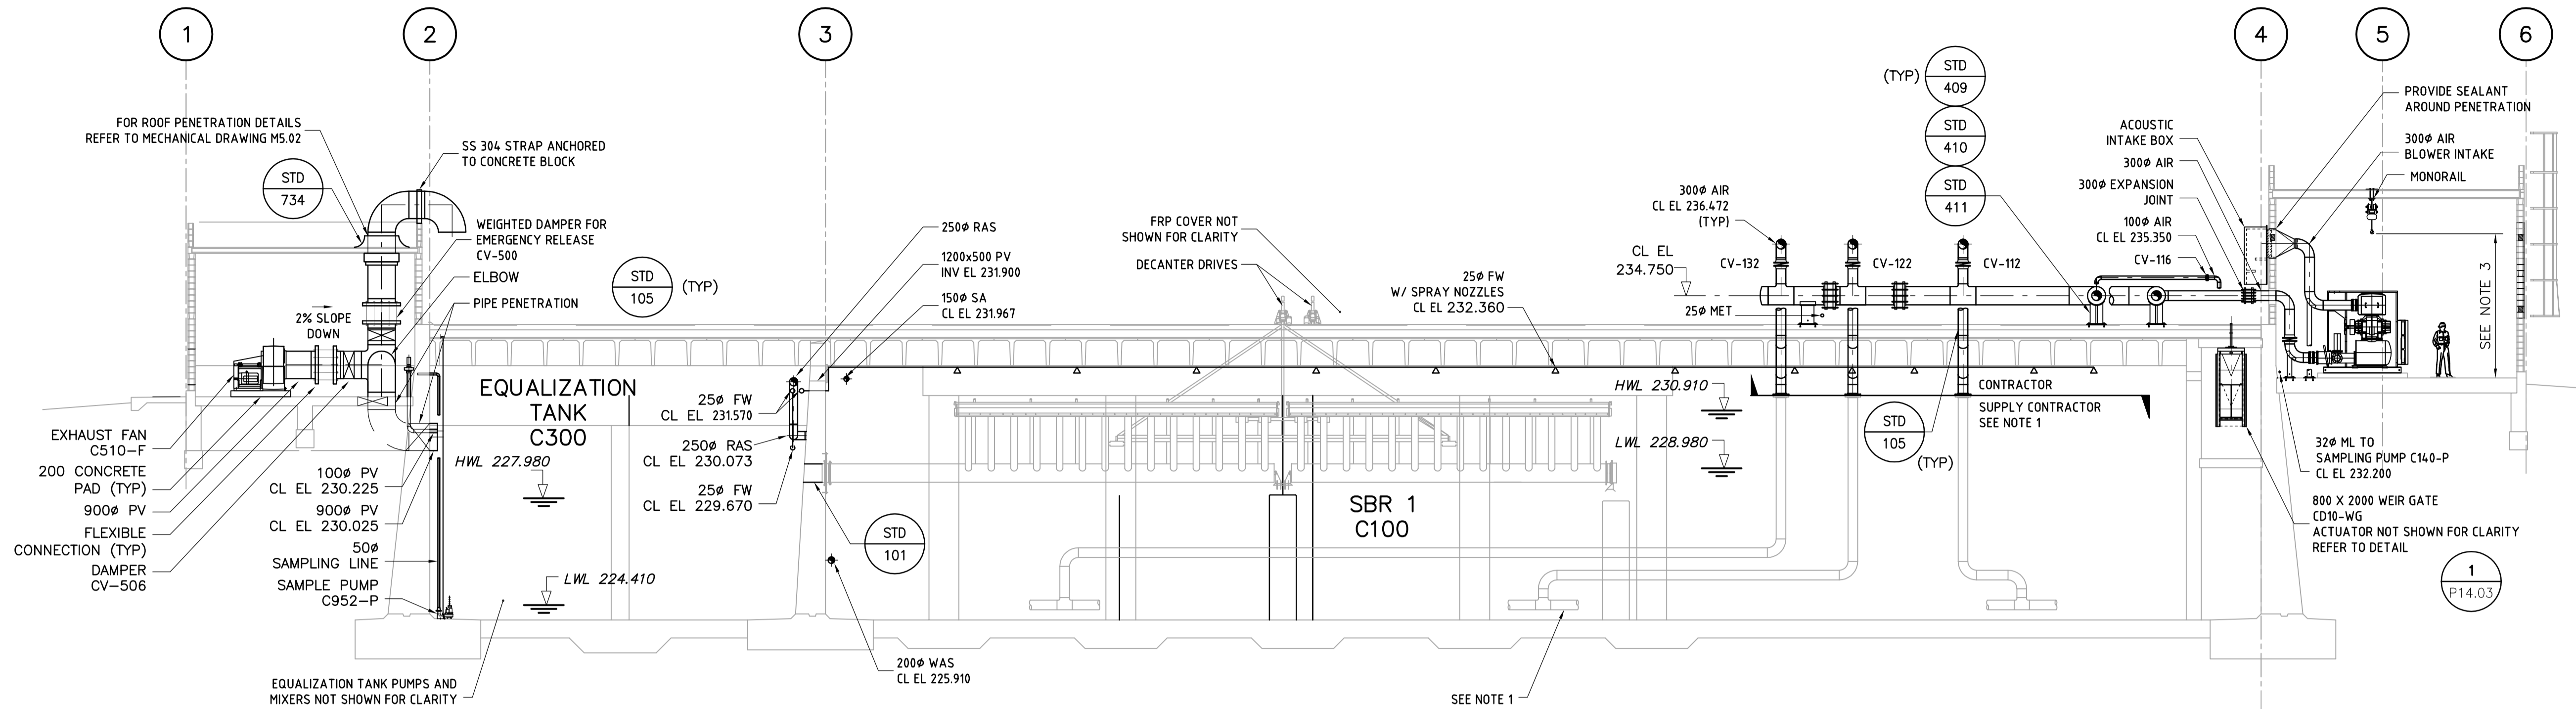

A SECTION
P13.01 SCALE 1:125

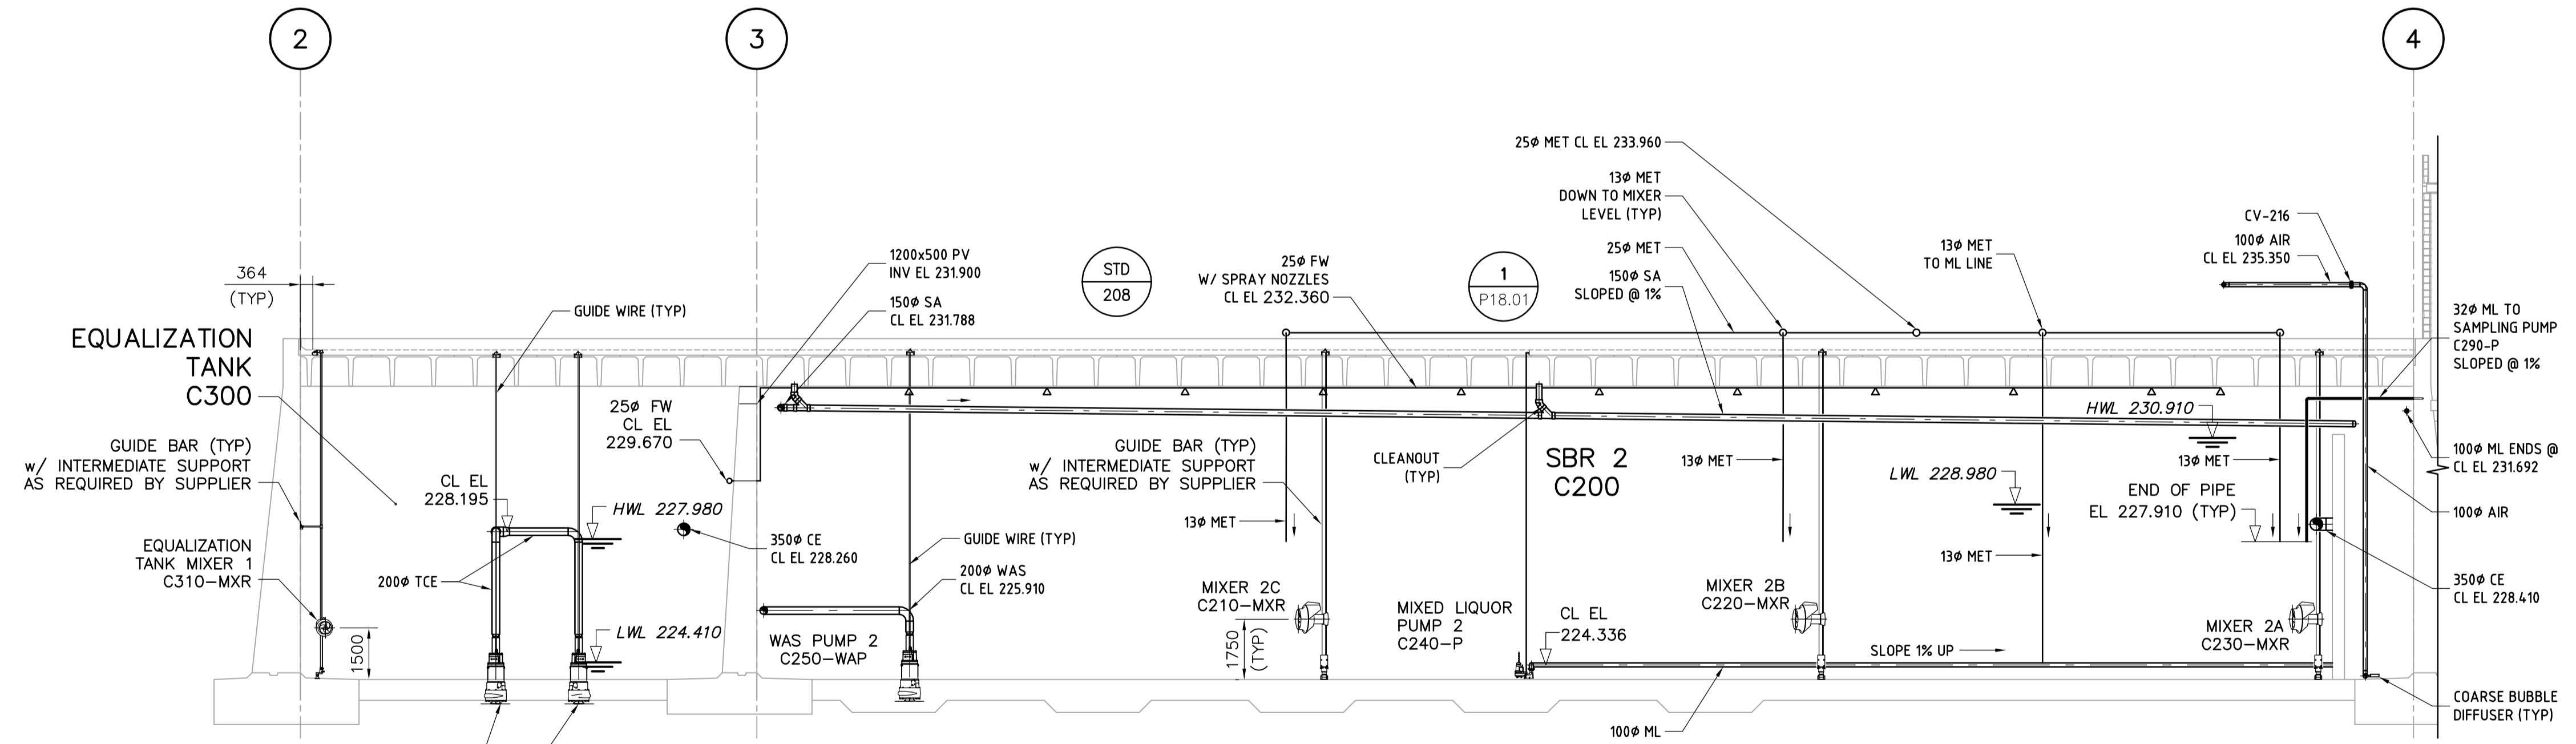

B SECTION
P13.01 SCALE 1:125

- NOTES:**
1. AERATION EQUIPMENT SUPPLIED UNDER SEPARATE CONTRACT. INSTALL AERATION EQUIPMENT AS PART OF THIS CONTRACT.
 2. ALL METAL PARTS BENEATH SBR COVERS USED FOR PIPE SUPPORT INCLUDING ANCHORS, RODS AND CLAMPS TO BE SS316. SUBMERGED METAL PARTS IN EQUALIZATION TANK USED FOR PIPE SUPPORT INCLUDING ANCHORS, RODS AND CLAMPS TO BE SS316.
 3. COORDINATE EXACT HEIGHT WITH SUPPLIER OF BLOWERS.

AECOM WINNIPEG
AS-CONSTRUCTED

AS-CONSTRUCTED
PER DERKSEN MECHANICAL SERVICES INC. DATE

APEGM
Certificate of Authorization
AECOM Canada Ltd.
Original dated on: No. 4671 Date: 2006/05/15


NO.	REVISIONS	DATE	BY	DATE
03	AS-CONSTRUCTED DRAWING	09/02/18	CD	
02	ISSUED FOR CONSTRUCTION	06/08/30	GLG	
01	291-2006 ADDENDUM 6	06/07/26	SRP	
00	ISSUED FOR TENDER	06/05/15	GLG	

EarthTech
A Tyco International Ltd. Company

DESIGNED BY	YL	CHECKED BY	SB
DRAWN BY	SRP	APPROVED BY	JEH
SCALE:	1:125		
RELEASED FOR CONSTRUCTION BY:	K. MARTENS		
DATE	2006/01/16	DATE	2006/05/15


ENGINEER'S SEAL
ORIGINAL SIGNED BY
J.E. HUTCHISON
2006/05/15
CONSULTANT DRAWING NO.
P14.01

THE CITY OF WINNIPEG
WATER AND WASTE DEPARTMENT
ENGINEERING DIVISION
WINNIPEG
NEWPCC CENTRATE NUTRIENT TREATMENT
NITROGEN REMOVAL FACILITY
PROCESS
PROCESS TANK SECTIONS
SHEET 1
CITY FILE NUMBER
SHEET OF
CITY DRAWING NUMBER
1-0101C-P0035-001-03

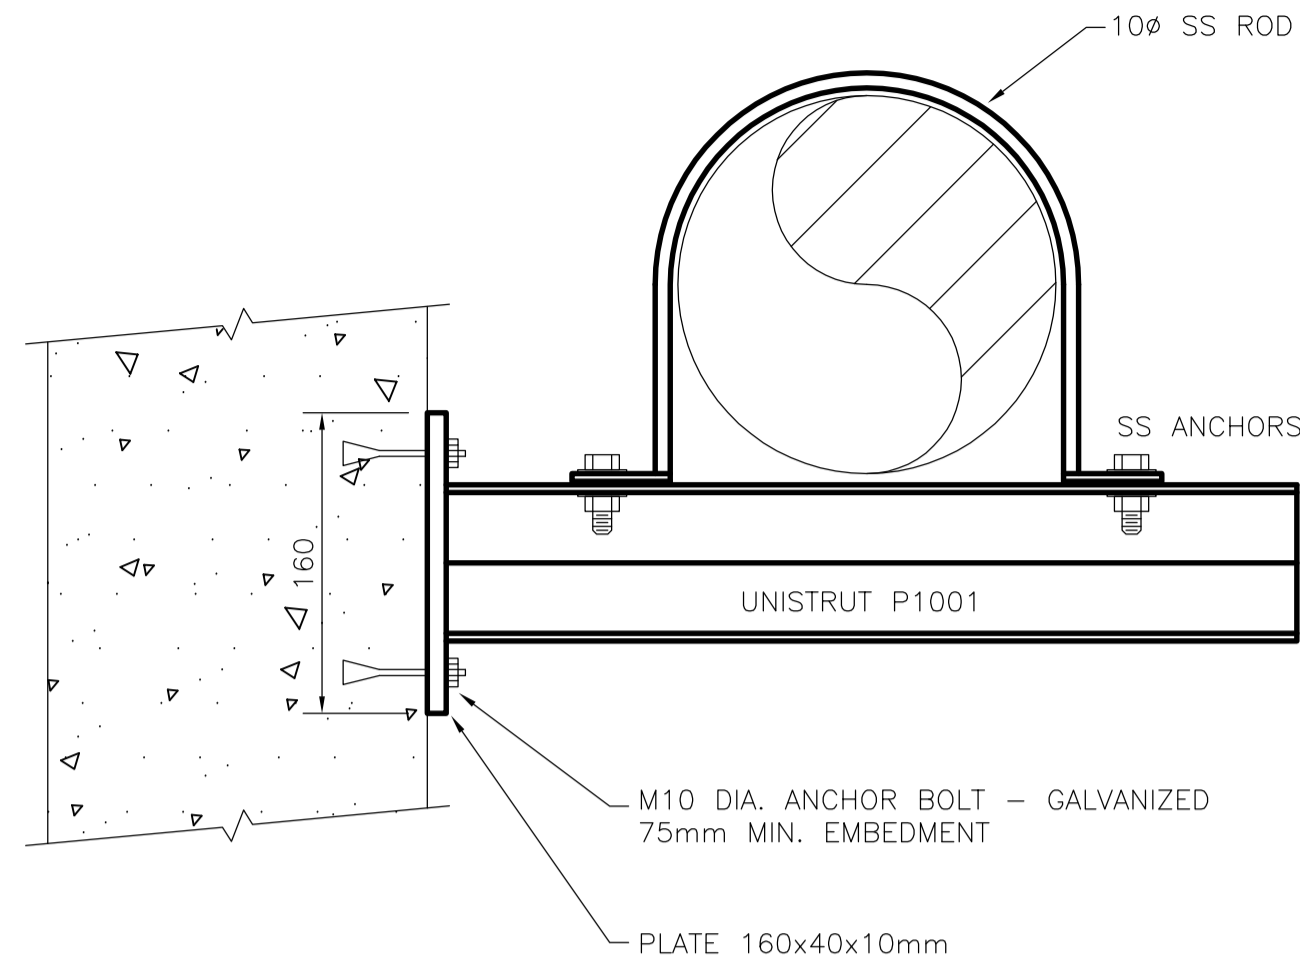


MAXIMUM LOAD OF BEAM LOADED @ CENTER (kg)	LENGTH OF SUPPORT L (mm)
440	760
740	450
1120	300

STD 201 TYPE 1 WALL MOUNTED PIPE SUPPORT

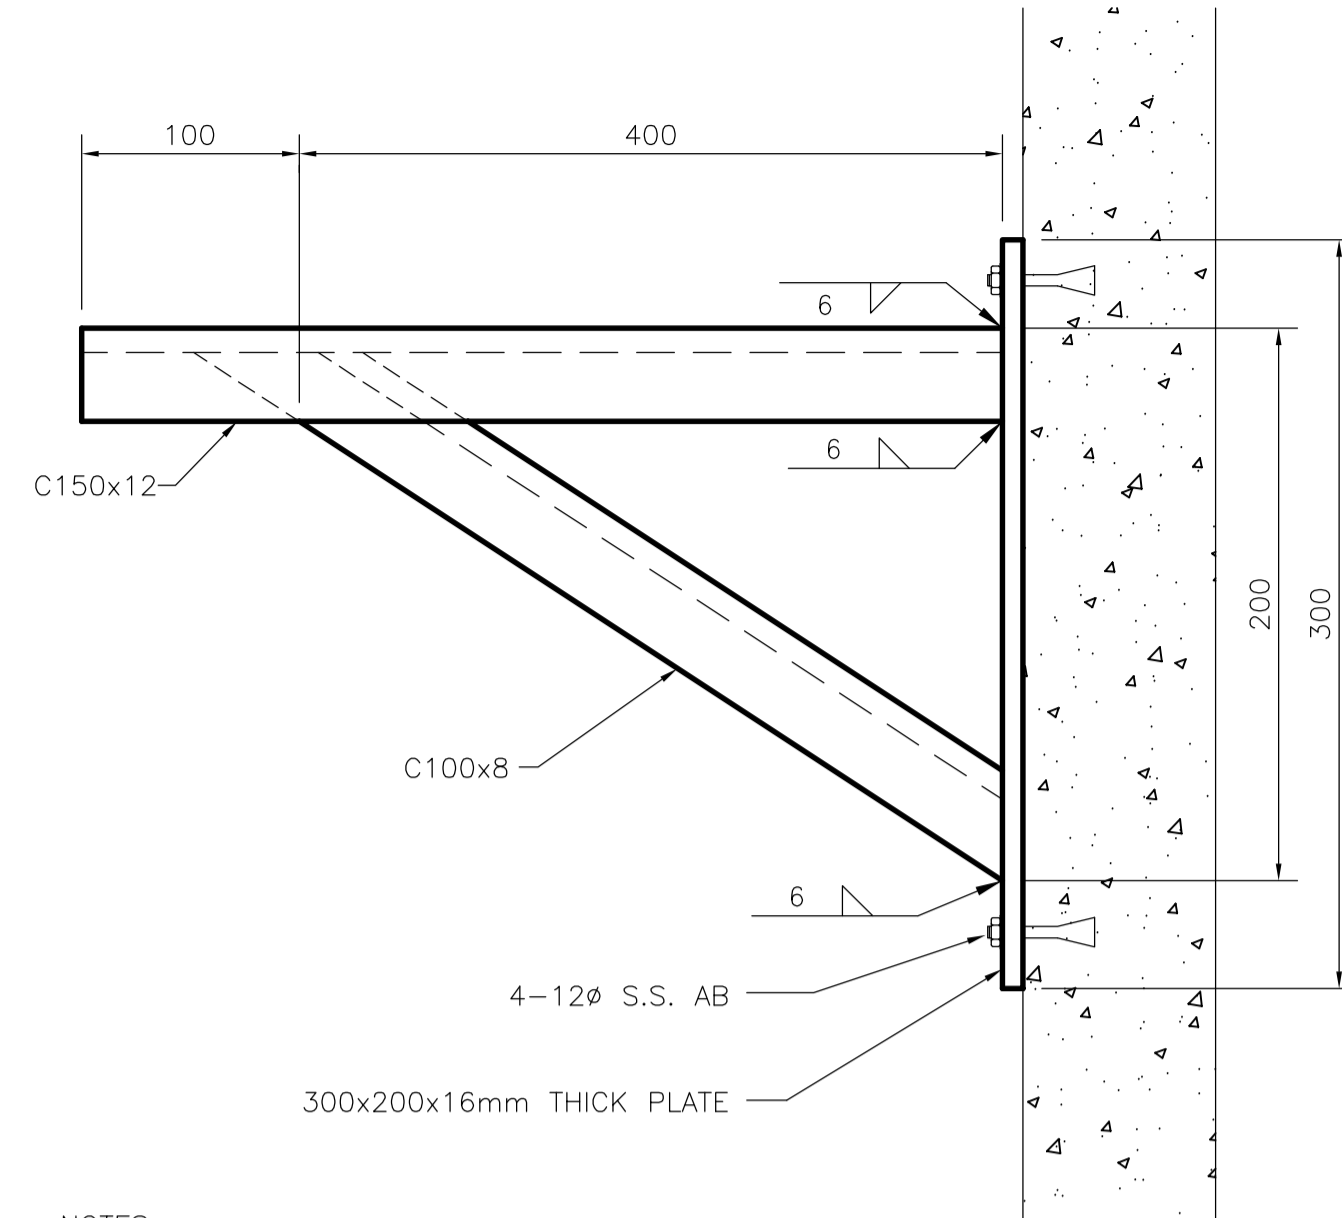


- NOTES:
1. GALVANIZE EXTERIOR STEEL SUPPORTS.
 2. PROVIDE SS 316 SUPPORTS FOR SUBMERGED APPLICATIONS.
 3. PROVIDE 10 ϕ SS 316 ROD FOR STRAP AND SS 316 ANCHORS.

STD 202 TYPE 2 WALL MOUNTED PIPE SUPPORT

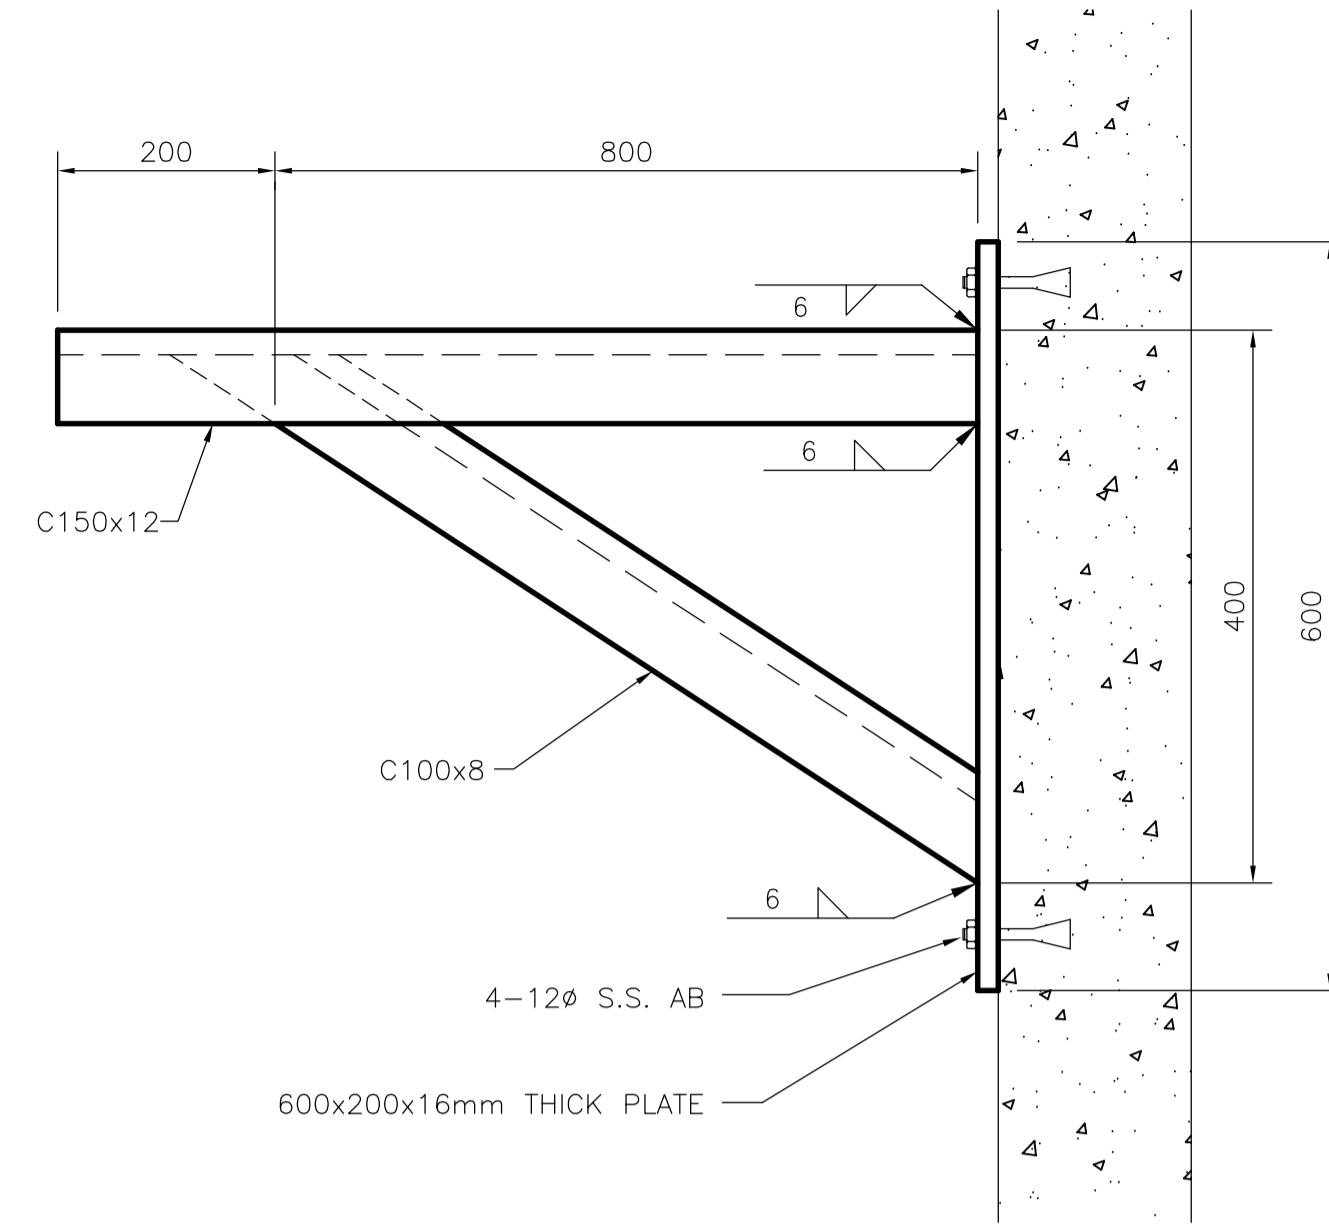


- NOTES:
1. GALVANIZE EXTERIOR STEEL SUPPORTS.
 2. PROVIDE SS 316 SUPPORTS FOR SUBMERGED APPLICATIONS.
 3. PROVIDE 10 ϕ SS 316 ROD FOR STRAP AND SS 316 ANCHORS.

STD 203 TYPE 3 WALL MOUNTED PIPE SUPPORT

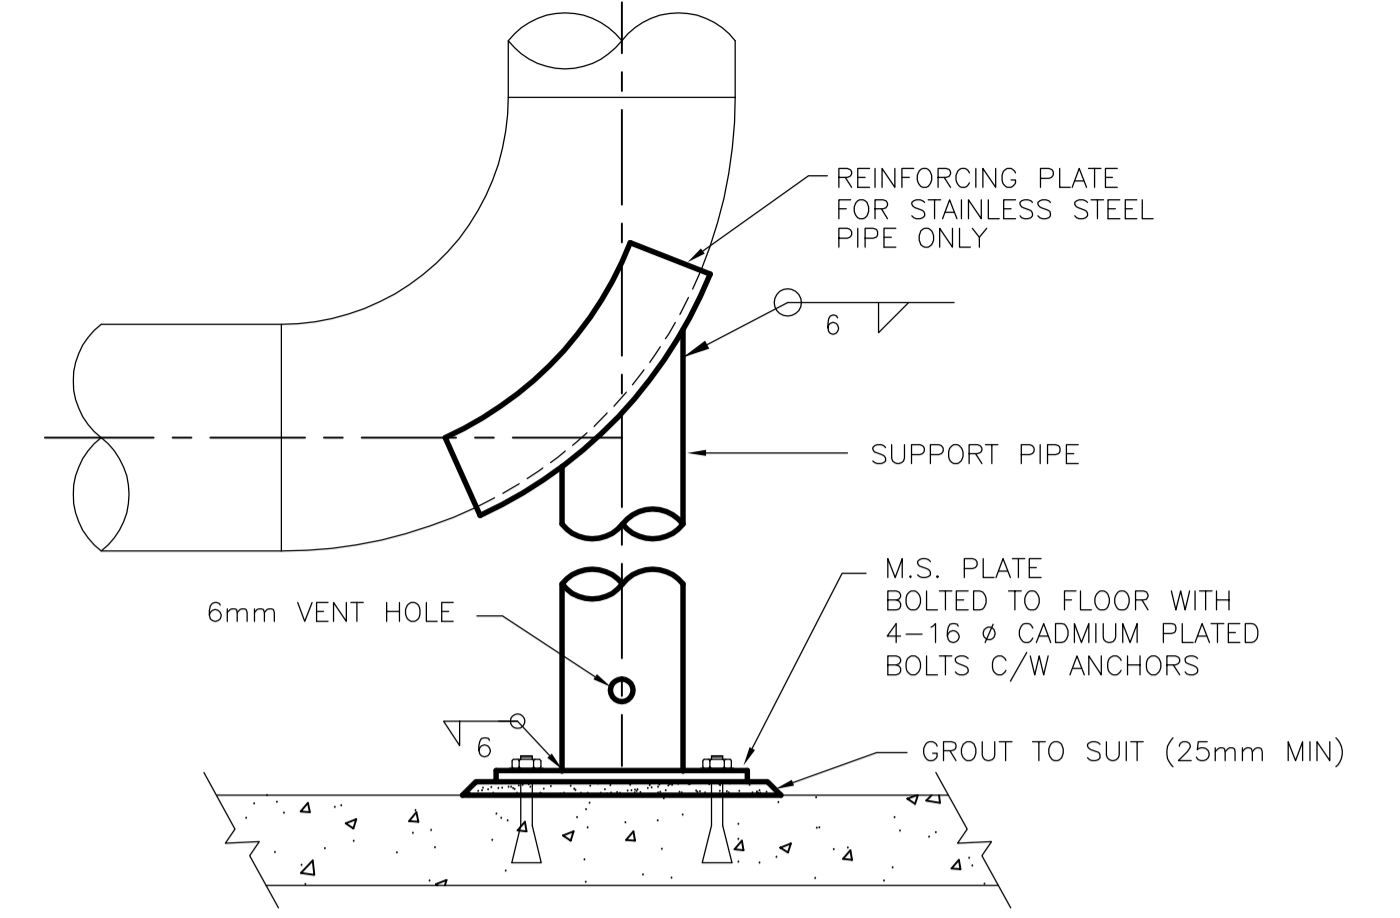


PIPE SIZE (mm)	SUPPORT PIPE (mm)	PLATE SIZE (mm)	MAXIMUM SUPPORT PIPE LENGTH (mm)
100	50 SCH 40	200 X 200 X 6	1525
150	50 SCH 40	200 X 200 X 6	1525
200	100 SCH 40	250 X 250 X 6	1625
250	100 SCH 40	250 X 250 X 6	1625
300	150 SCH 40	300 X 300 X 10	1830
350	200 SCH 40	350 X 350 X 10	1830
400	200 SCH 40	350 X 350 X 10	1830
500	200 SCH 40	350 X 350 X 10	1830
600	250 SCH 40	400 X 400 X 10	1830
750	300 SCH 40	450 X 450 X 10	1830
900	300 SCH 40	450 X 450 X 10	1830

STD 205 TYPE 1 BASE ELBOW SUPPORT FOR STEEL PIPE

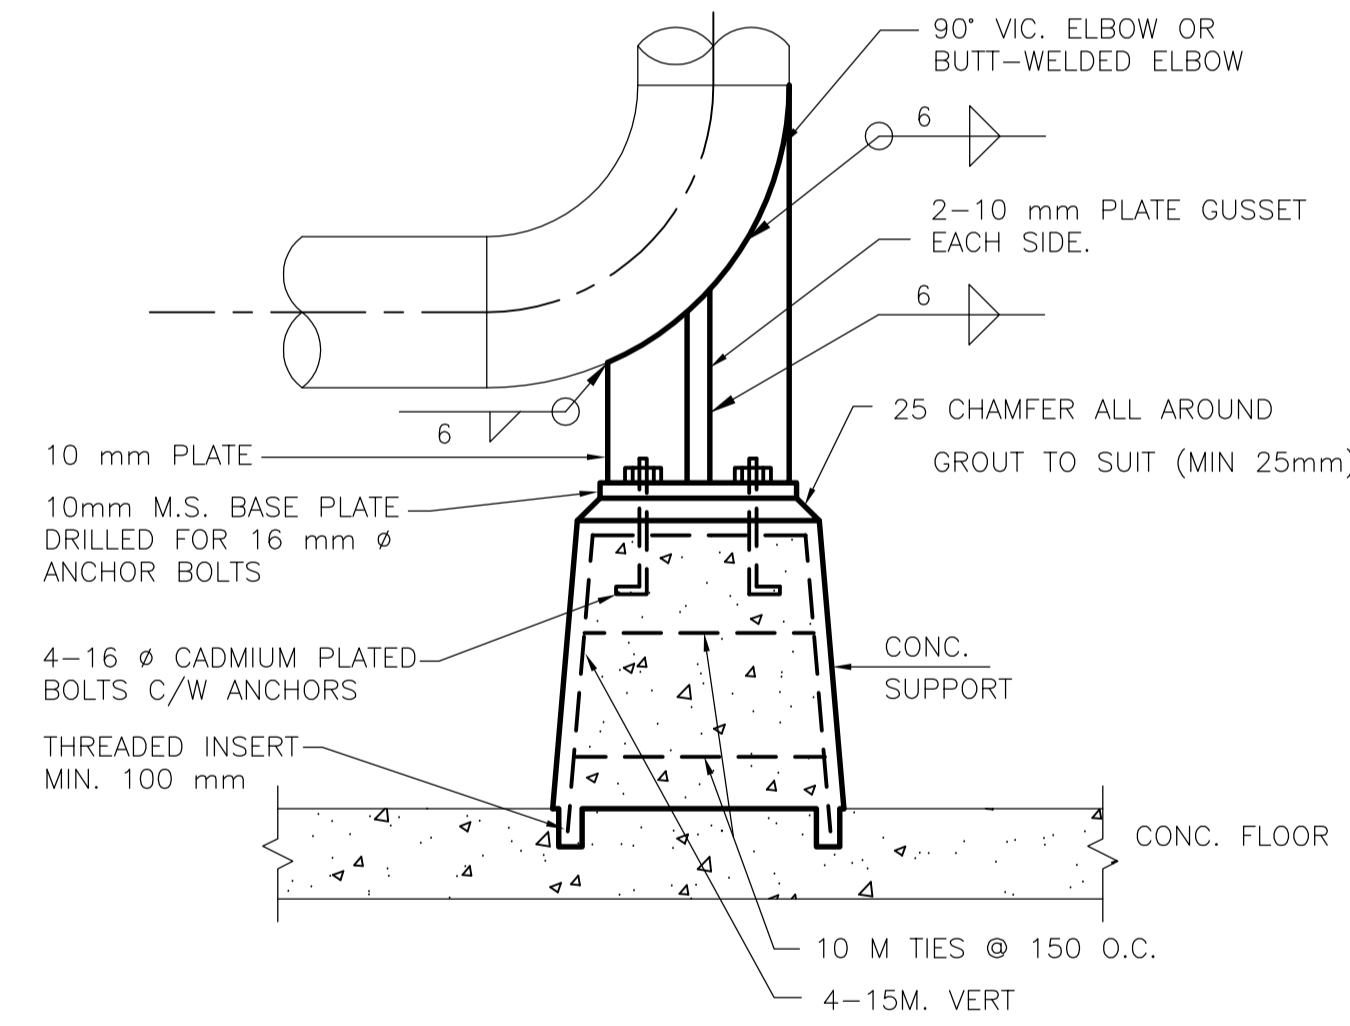


PIPE SIZE (mm)	PLATE SIZE (mm)
100	100 X 100 X 6
150	125 X 125 X 6
200	150 X 150 X 6
250	150 X 150 X 6
300	200 X 200 X 10
350	250 X 250 X 10
400	250 X 250 X 10
500	300 X 300 X 10
600	350 X 350 X 10

STD 206 TYPE 2 BASE ELBOW SUPPORT FOR STEEL PIPE

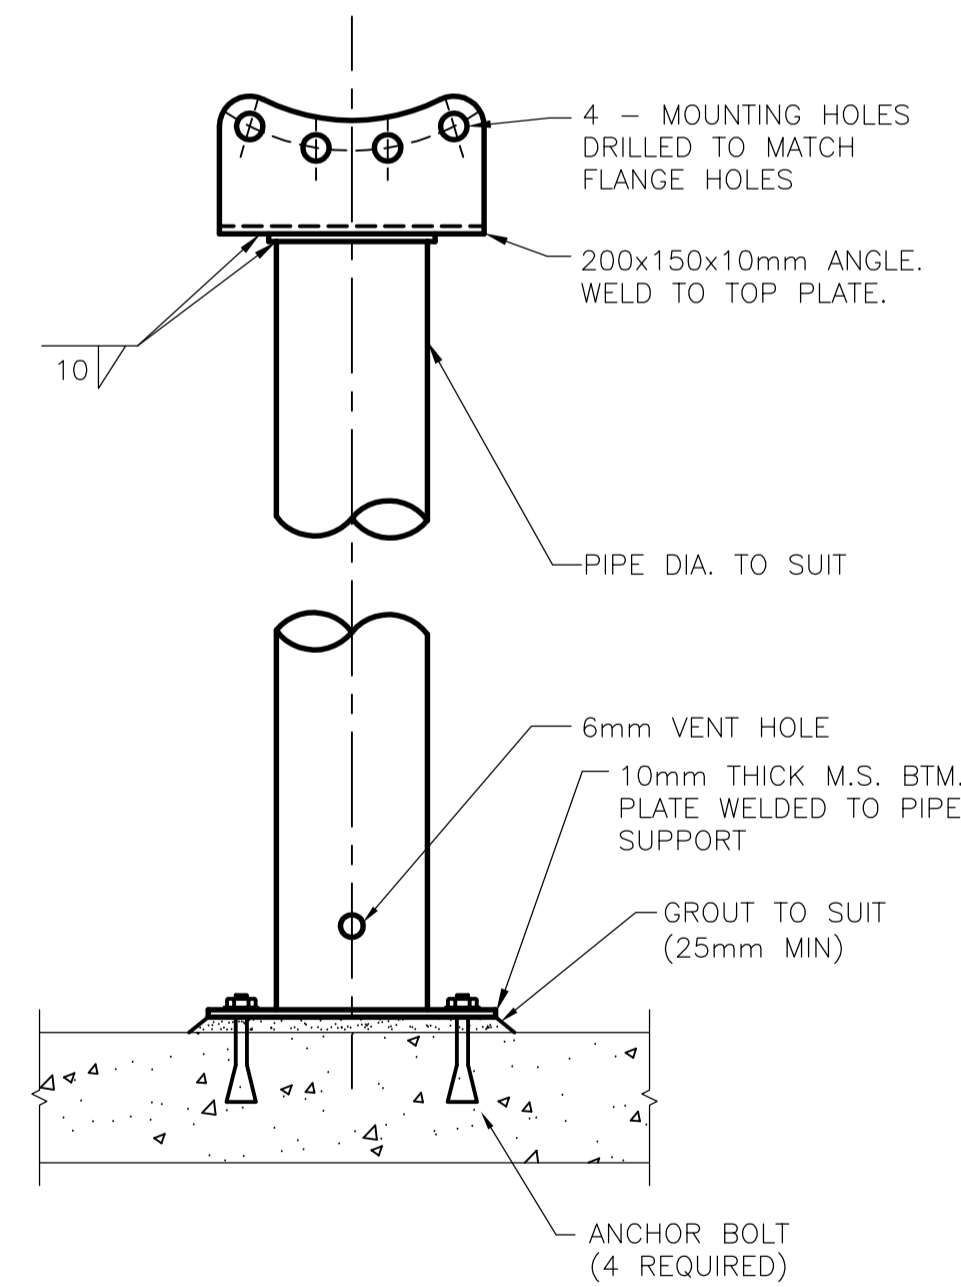


STD 207 FLANGED PIPE SUPPORT

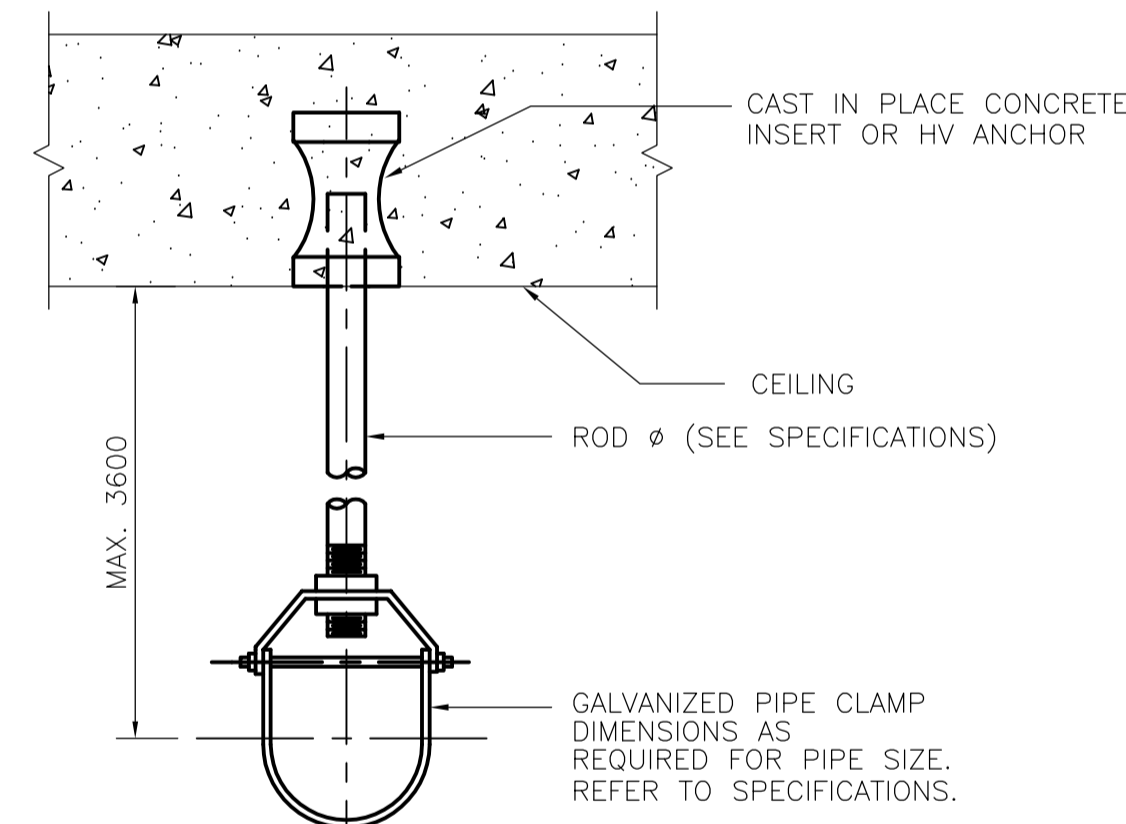

PIPE SIZE (mm)	ROD SIZE (mm)	MAX LOAD (kg)
25	9.4	280
50	9.4	280
75	12.0	510
100	16.0	800
150	20.0	1230
200	22.0	1710
250	25.0	2250
300	25.0	2250
350	25.0	2250
400	25.0	2250
450	25.0	2250
500	32.0	3630
600	32.0	3630

SAFETY FACTOR = 5

STD 208 SINGLE PIPE HANGER

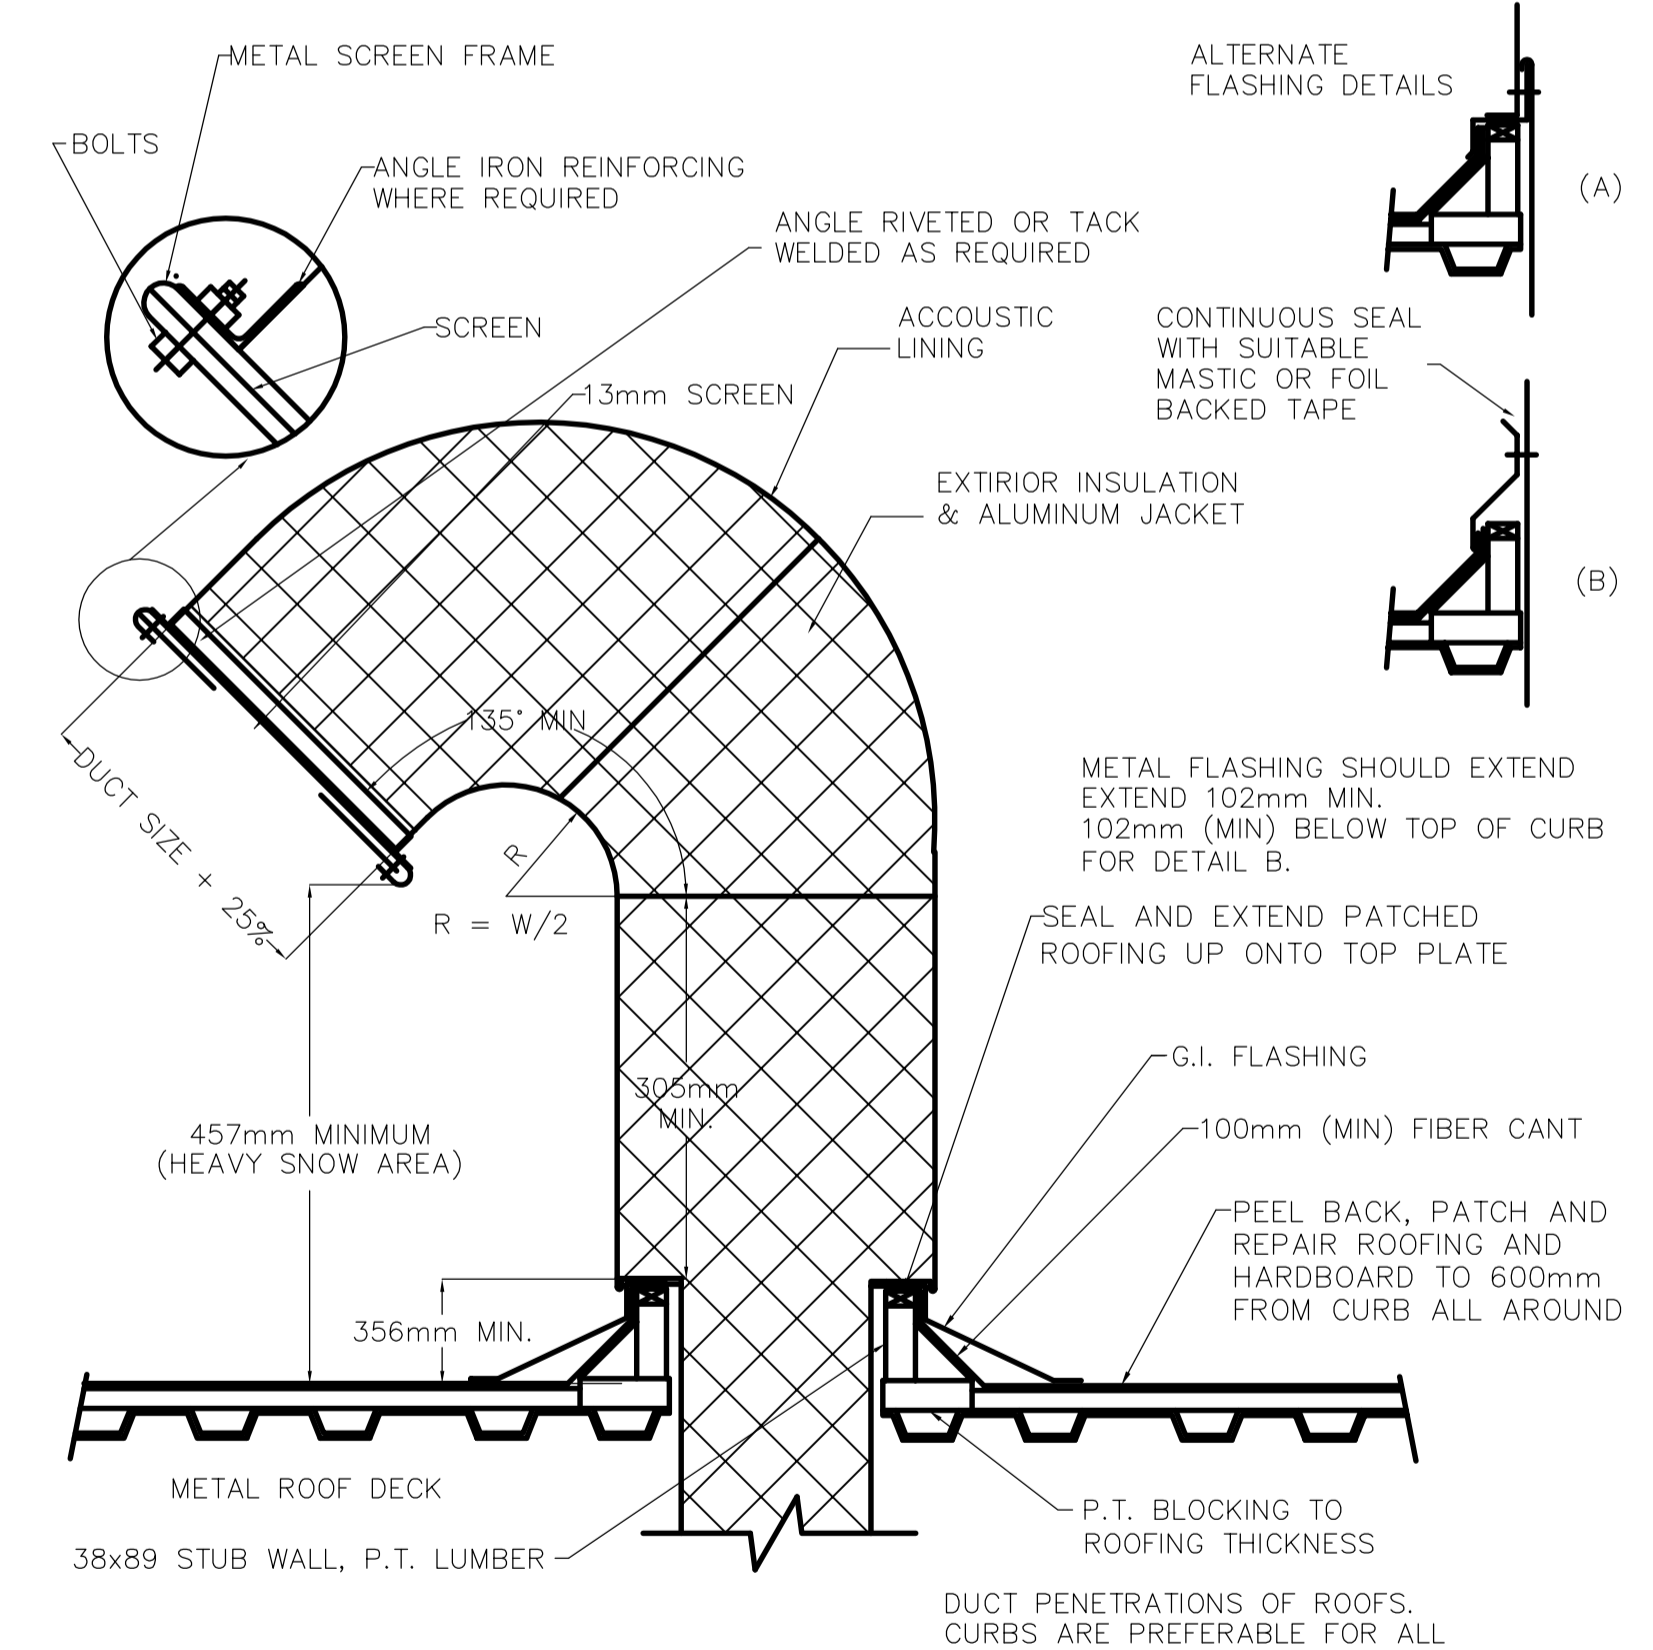

STD 211 TYPICAL GOOSENECK ROOF PENETRATION DETAIL

AECOM WINNIPEG
AS-CONSTRUCTED

APEGM
Certificate of Authorization
AECOM Canada Ltd.
Original dated on: No. 4671 Date: 2006/05/15


NO.	REVISIONS	DATE	BY
02	AS-CONSTRUCTED DRAWING	09/02/19	DEP
01	ISSUED FOR CONSTRUCTION	06/08/30	GLG
00	ISSUED FOR TENDER	06/05/15	GLG

EarthTech
A Tyco International Ltd. Company

DESIGNED BY	LW	CHECKED BY	SB
DRAWN BY	GLG	APPROVED BY	JEH
SCALE:	NONE	RELEASED FOR CONSTRUCTION BY:	K. MARTENS
DATE	2006/01/16	DATE	2006/05/23


ENGINEER'S SEAL	ORIGINAL SIGNED BY	J.E. HUTCHISON
	DATE	2006/05/15
CONSULTANT DRAWING NO.	P19.02	

THE CITY OF WINNIPEG
WATER AND WASTE DEPARTMENT
ENGINEERING DIVISION
NEWPCC CENTRATE NUTRIENT TREATMENT NITROGEN REMOVAL FACILITY
PROCESS STANDARD DETAILS SHEET 2
CITY FILE NUMBER
SHEET OF
CITY DRAWING NUMBER
1-0101C-P0042-002-02

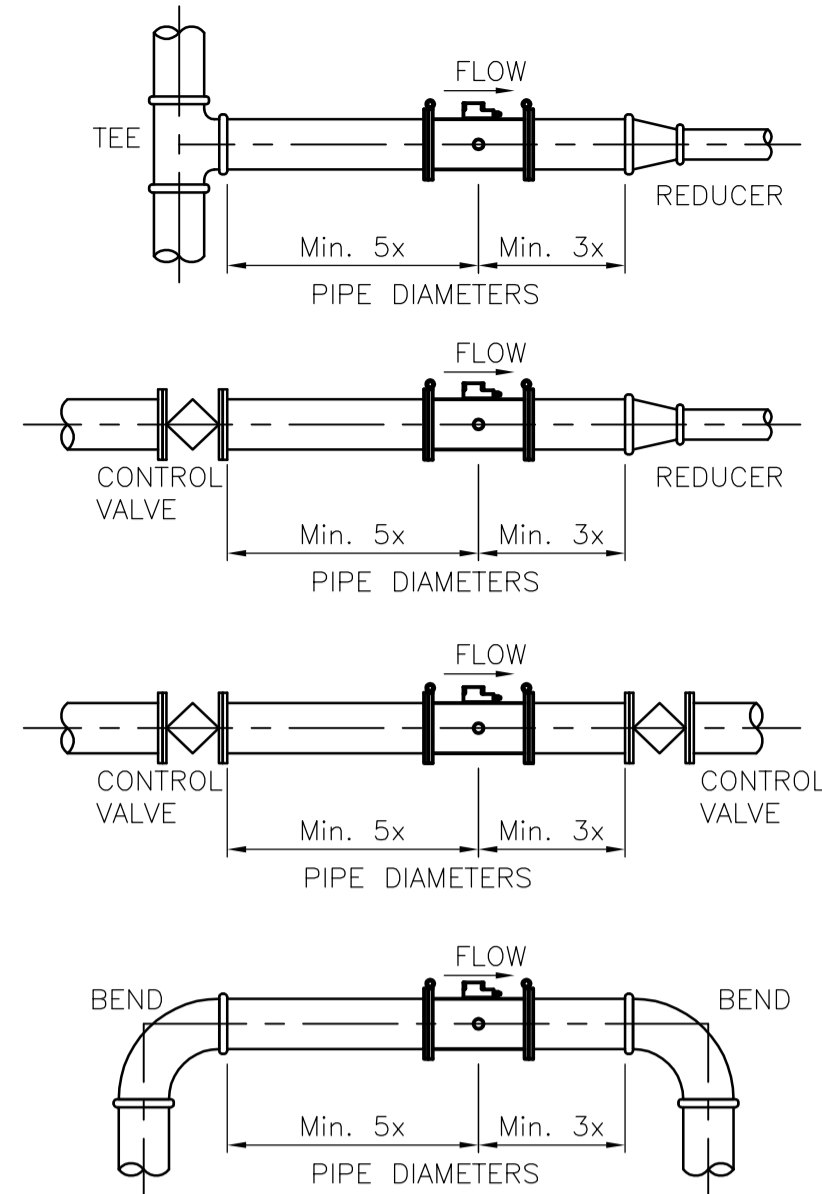


- NOTES:
- REFER TO THE MANUFACTURER'S INSTALLATION INSTRUCTIONS IN CONJUNCTION WITH THESE INSTALLATION RECOMMENDATIONS.
 - WHERE SPECIFIC INSTALLATION CONFLICTS ARISE THAT MIGHT PREVENT THESE INSTALLATION RECOMMENDATIONS FROM BEING COMPLIED WITH, CONSULT THE CONTRACT ADMINISTRATOR BEFORE PROCEEDING WITH THE INSTALLATION.
 - WHERE THE DRAWINGS INDICATE DIMENSIONS THAT DIFFER FROM THESE DETAILS, THE DRAWINGS SHALL TAKE PRIORITY.


STD 707 MAGNETIC FLOWMETER INSTALLATION CONFIGURATIONS

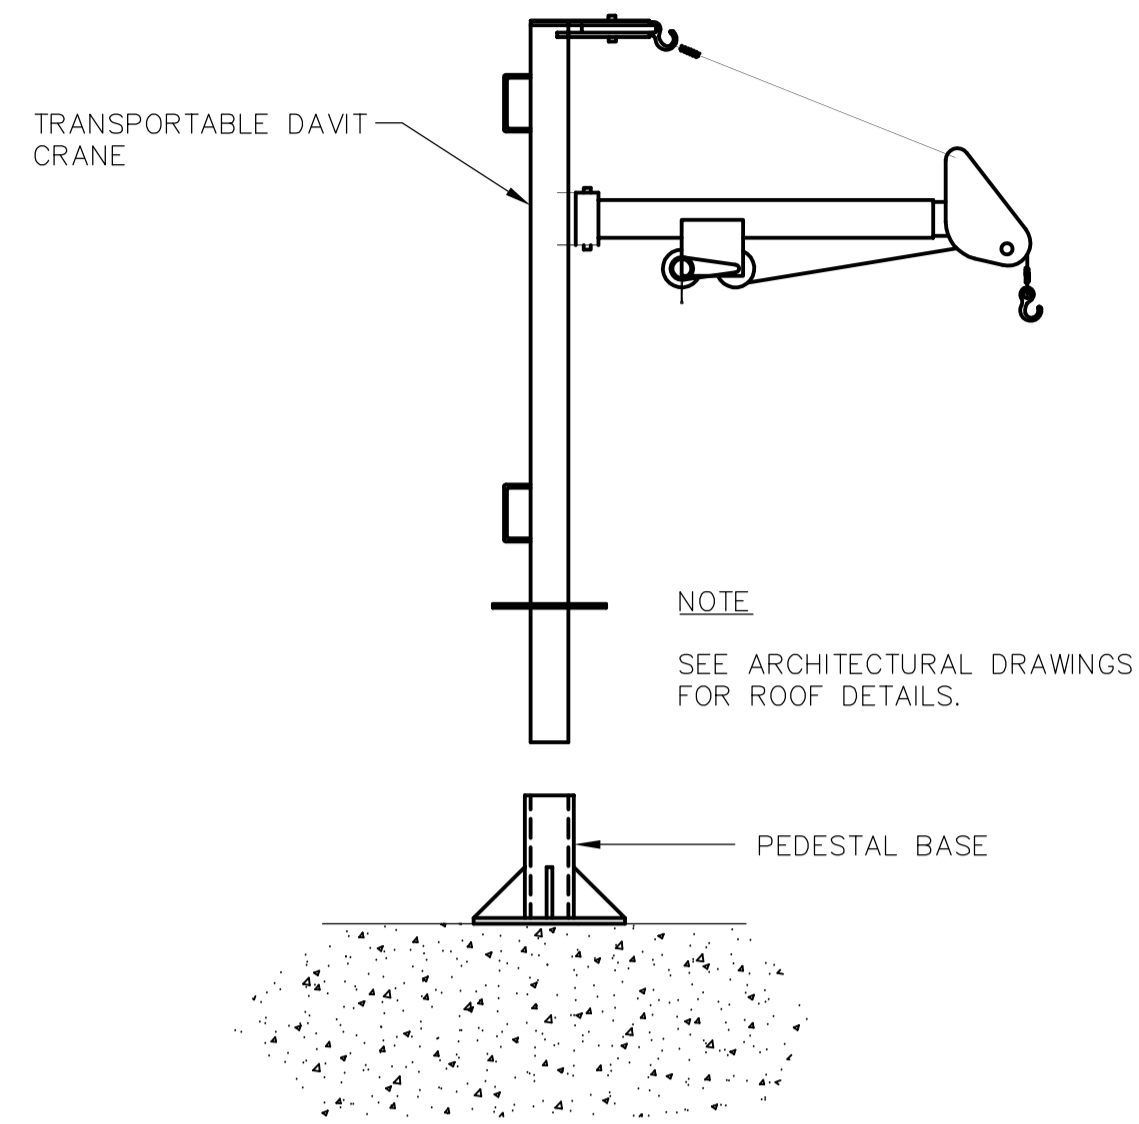

STD 712A WINCH BASE AND SUPPORT DETAIL

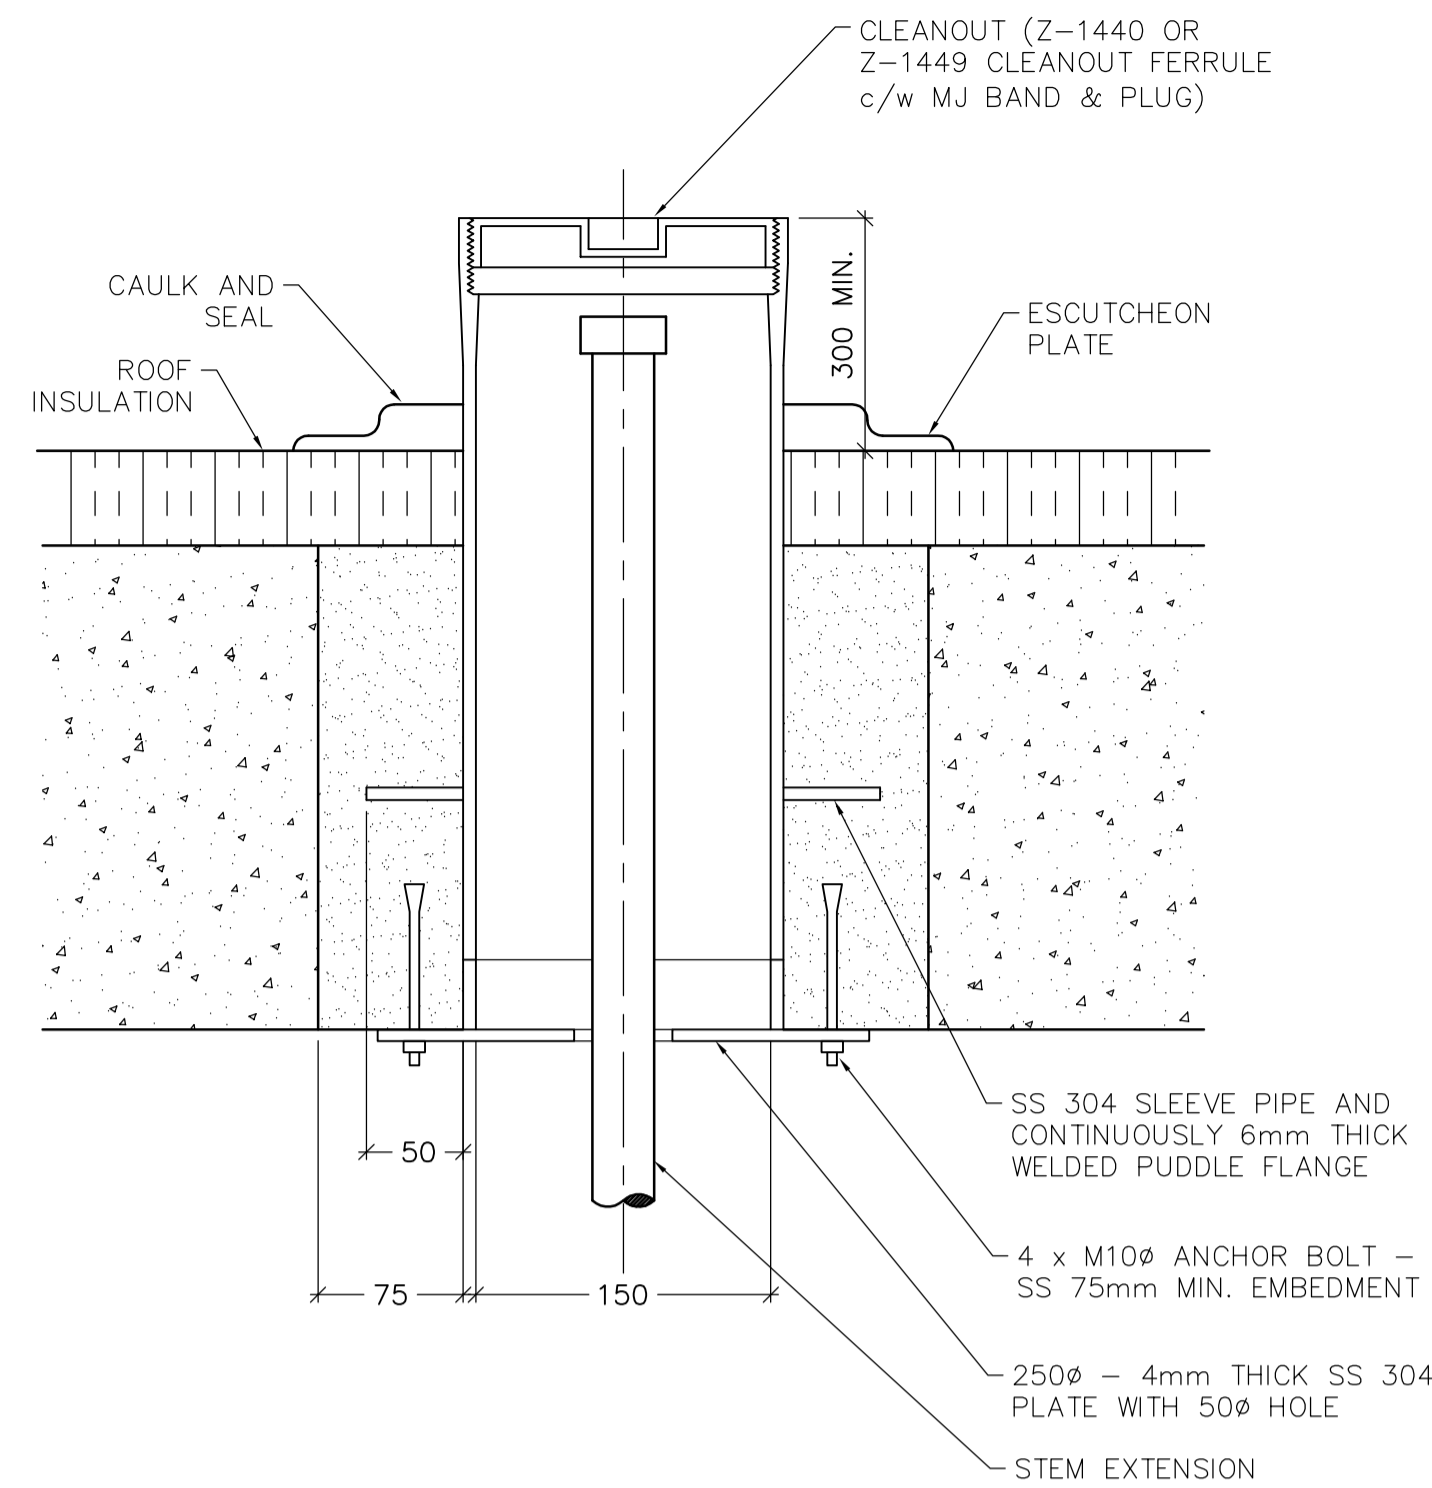


STD 729 VALVE BOX

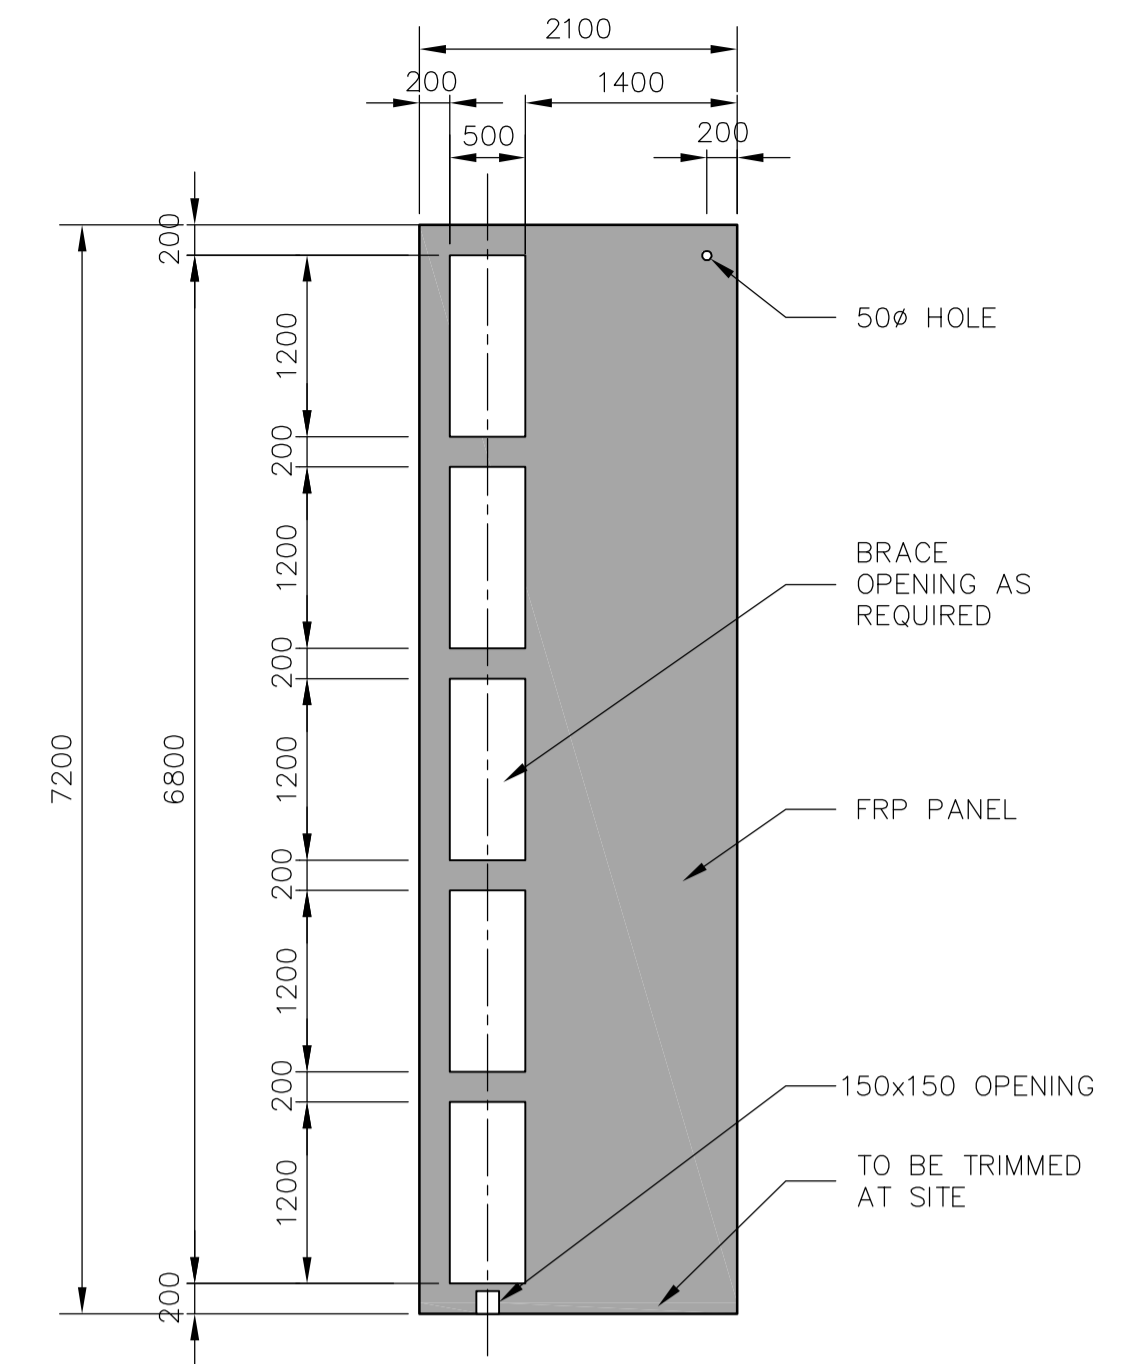


STD 732 FRP BAFFLE - SECTION


- NOTES:
- BAFFLE SHOWN IS ILLUSTRATIVE ONLY; SUBMIT SHOP DRAWINGS AND CALCULATIONS CONFIRMING BAFFLE IS SUITABLE FOR SERVICE CONDITIONS:
 - BAFFLE TO BE 7200 MM X 2100 MM (TRIM TO FIT ANOXIC SELECTOR)
 - BAFFLE TO HAVE OPEN AREA EQUIVALENT TO 3.00m² ALONG THE FULL HEIGHT OF THE BAFFLE.
 - OPENINGS TO OCCUPY ONLY THE LAST ONE-THIRD OF THE BAFFLE WIDTH, THE FIRST TWO-THIRDS OF THE BAFFLE WIDTH MUST BE SOLID AS SHOWN
 - REINFORCE OPENINGS AS NECESSARY
 - PROVIDE 150x150 OPENING AT BOTTOM OF BAFFLE TO FACILITATE TANK DRAINAGE
 - WATER DEPTH IN ANOXIC SELECTOR RANGES FROM 5.0m TO 7.0m
 - WATER LEVEL ON EACH SIDE OF THE BAFFLE WILL BE EQUAL UNDER ALL CONDITIONS. THE BAFFLES DO NOT HAVE TO WITHSTAND DIFFERENTIAL WATER LEVELS

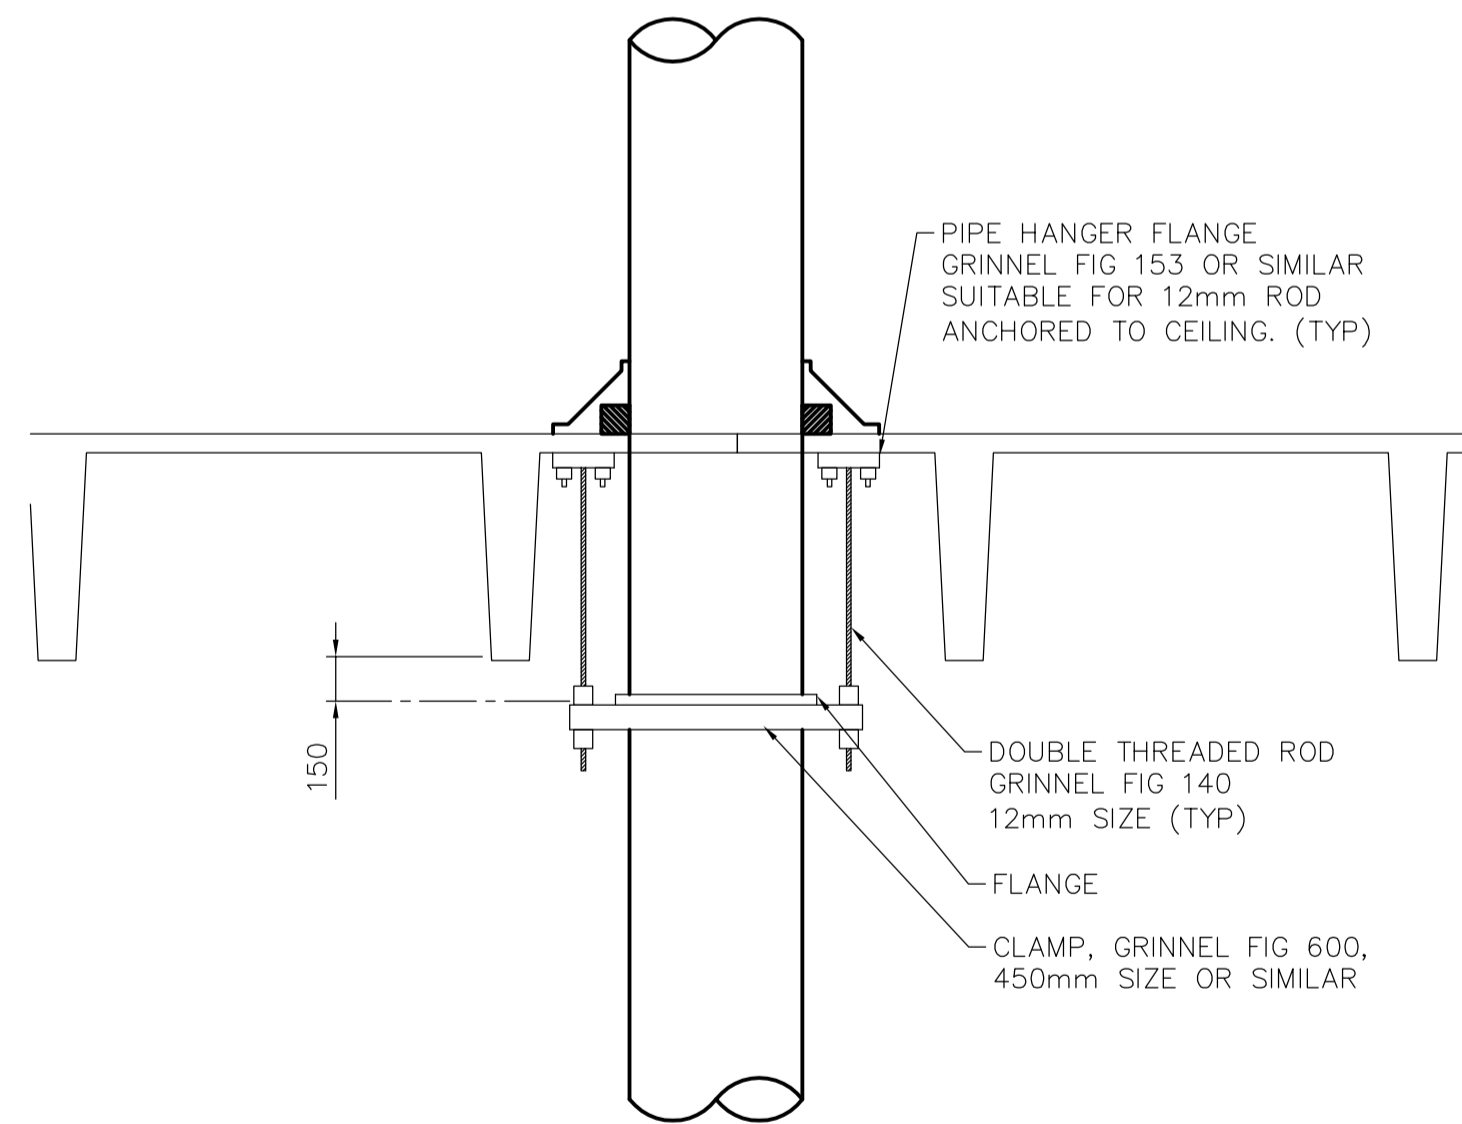

STD 734 ROOF PENETRATION HANGER DETAIL

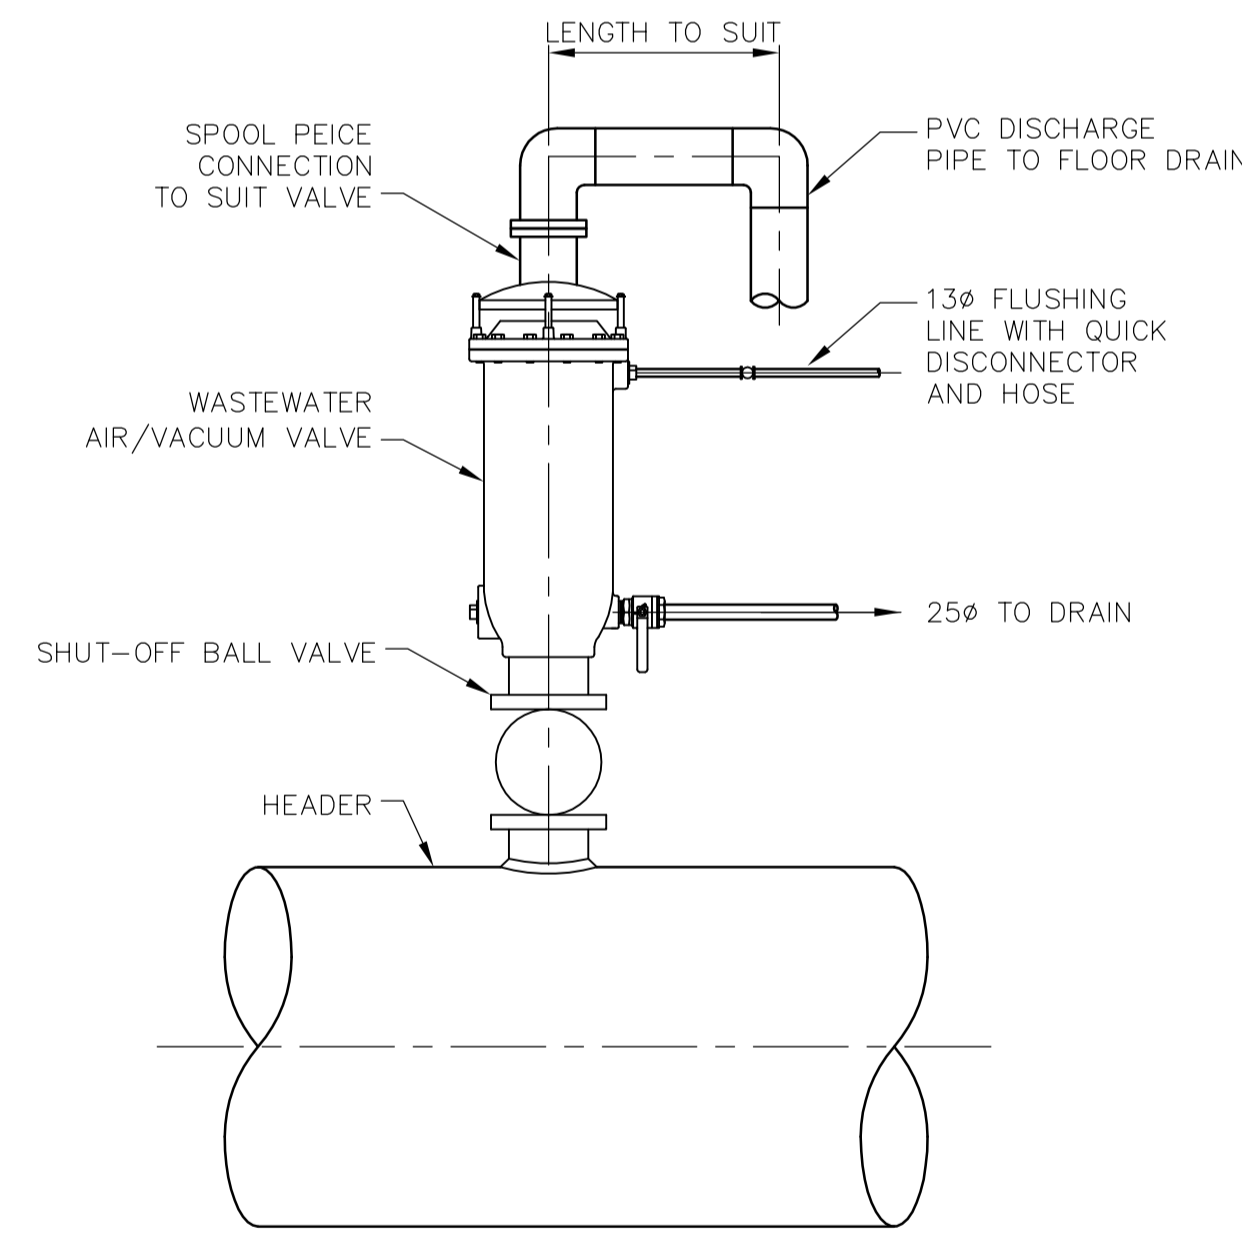


STD 735A AIR VALVE - DETAIL

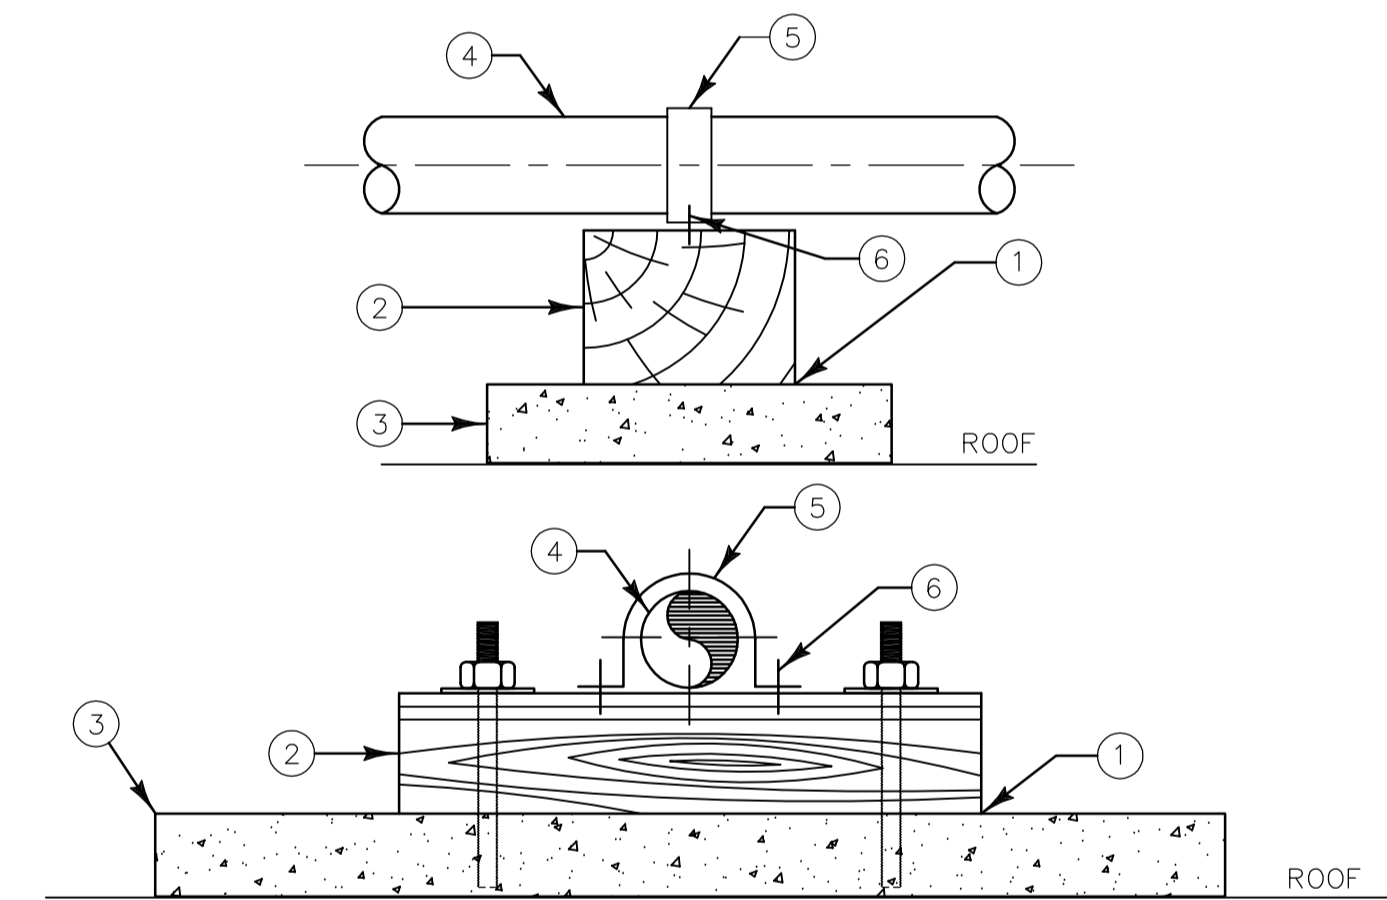

- SHIMWOOD BLOCKING AS REQUIRED TO COMPENSATE FOR ROOF SLOPE.
- 4"x4"x10"LONG(100mmx100mmx250mm) PRESSURE TREATED WOOD BOLTED TO CONCRETE SLAB
- 610mmx760mm PRECAST CONCRETE SLAB, SAME AS USED FOR PATHWAY
- STEEL PIPE.
- SS 304 STRAPS GRINNELL FIG.2L2 (OR EQUAL) OVERSIZE (2 SIZES) TO ALLOW FOR PIPE MOVEMENT. PAINT PIPING WITH COLOUR AS PER SPECIFICATION.
- STAINLESS STEEL NO.12 2"(50mm) LONG WOOD SCREWS.

STD 736 PIPE SUPPORT DETAIL

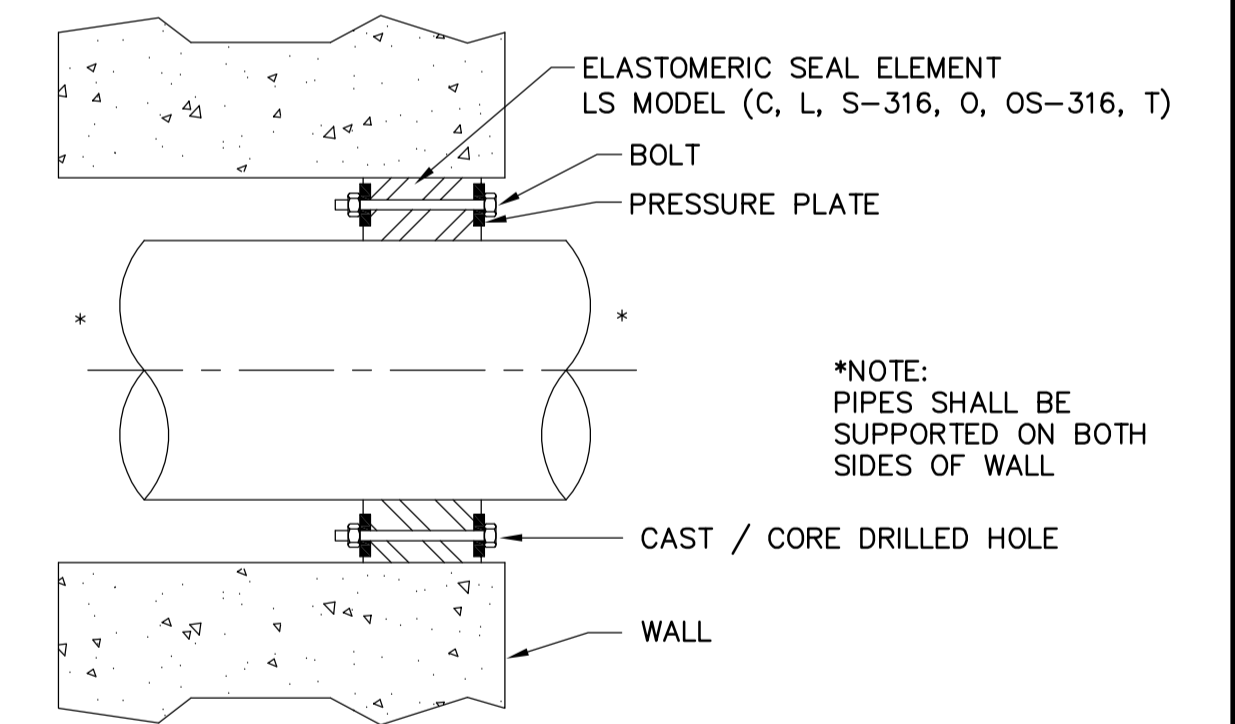

- APPLICATION NOTES:
- CONCRETE WALL
 - PIPE MATERIAL: STEEL, STAINLESS STEEL, DUCTILE IRON, PVC OR FRP PIPE; NON-INSULATED.
 - CONDITION:
 - DRY TO DRY
 - WET TO DRY
 - HORIZONTAL OR VERTICAL
 - INTERIOR TO UNDERGROUND
- *NOTE: PIPES SHALL BE SUPPORTED ON BOTH SIDES OF WALL

LS Model	Seal Element	Bolts/Nuts	Pressure Plate
C	EPDM (Black)	Zinc Dichromate/Organic Coated Carbon Steel Bolt	Reinforced Nylon Polymer
L	EPDM (Blue)	Zinc Dichromate/Organic Coated Carbon Steel Bolt	Reinforced Nylon Polymer
O	Nitrile	Zinc Dichromate/Organic Coated Carbon Steel Bolt	Reinforced Nylon Polymer
T	Silicone	Zinc Dichromate/Organic Coated Carbon Steel Bolt	Steel Zinc Dichromate
(C,L,O)+S-316	(see model options)	316 Stainless Steel	Reinforced Nylon Polymer

Sleeve Model	Description	Material
CS	Century-Line Sleeve	HDPE
WS	Steel Wall Sleeve	Steel

STD 737 LINK-SEAL MODULAR SEAL CORED WALL PENETRATION

AECOM WINNIPEG
AS-CONSTRUCTED

As of January 3, 2009, EarthTech became AECOM Canada Ltd.

APEGM
 Certificate of Authorization
 AECOM Canada Ltd.
 Original dated on: No. 4671 Date: 2006/05/15

NO.	REVISIONS	DATE	BY
04	AS-CONSTRUCTED DRAWING	09/02/19	DEP
03	ISSUED FOR CONSTRUCTION	06/08/30	GLG
02	291-2006 ADDENDUM 6	06/07/26	SRP
01	291-2006 ADDENDUM 3	06/07/12	LAE
00	ISSUED FOR TENDER	06/05/15	GLG

EarthTech
 A Tyco International Ltd. Company

DESIGNED BY: LW
 CHECKED BY: SB
 DRAWN BY: GLG
 APPROVED BY: JEH
 SCALE: NONE
 RELEASED FOR CONSTRUCTION BY: K. MARTENS
 DATE: 2006/01/16
 DATE: 2006/05/23


ENGINEER'S SEAL
 ORIGINAL SIGNED BY: J.E. HUTCHISON
 2006/05/15
 CONSULTANT DRAWING NO. P19.06

THE CITY OF WINNIPEG
 WATER AND WASTE DEPARTMENT
 ENGINEERING DIVISION

NEWPC CENTRATE NUTRIENT TREATMENT NITROGEN REMOVAL FACILITY

CITY FILE NUMBER
 SHEET OF
 CITY DRAWING NUMBER
 1-0101C-P0042-006-04

PROCESS STANDARD DETAILS SHEET 6

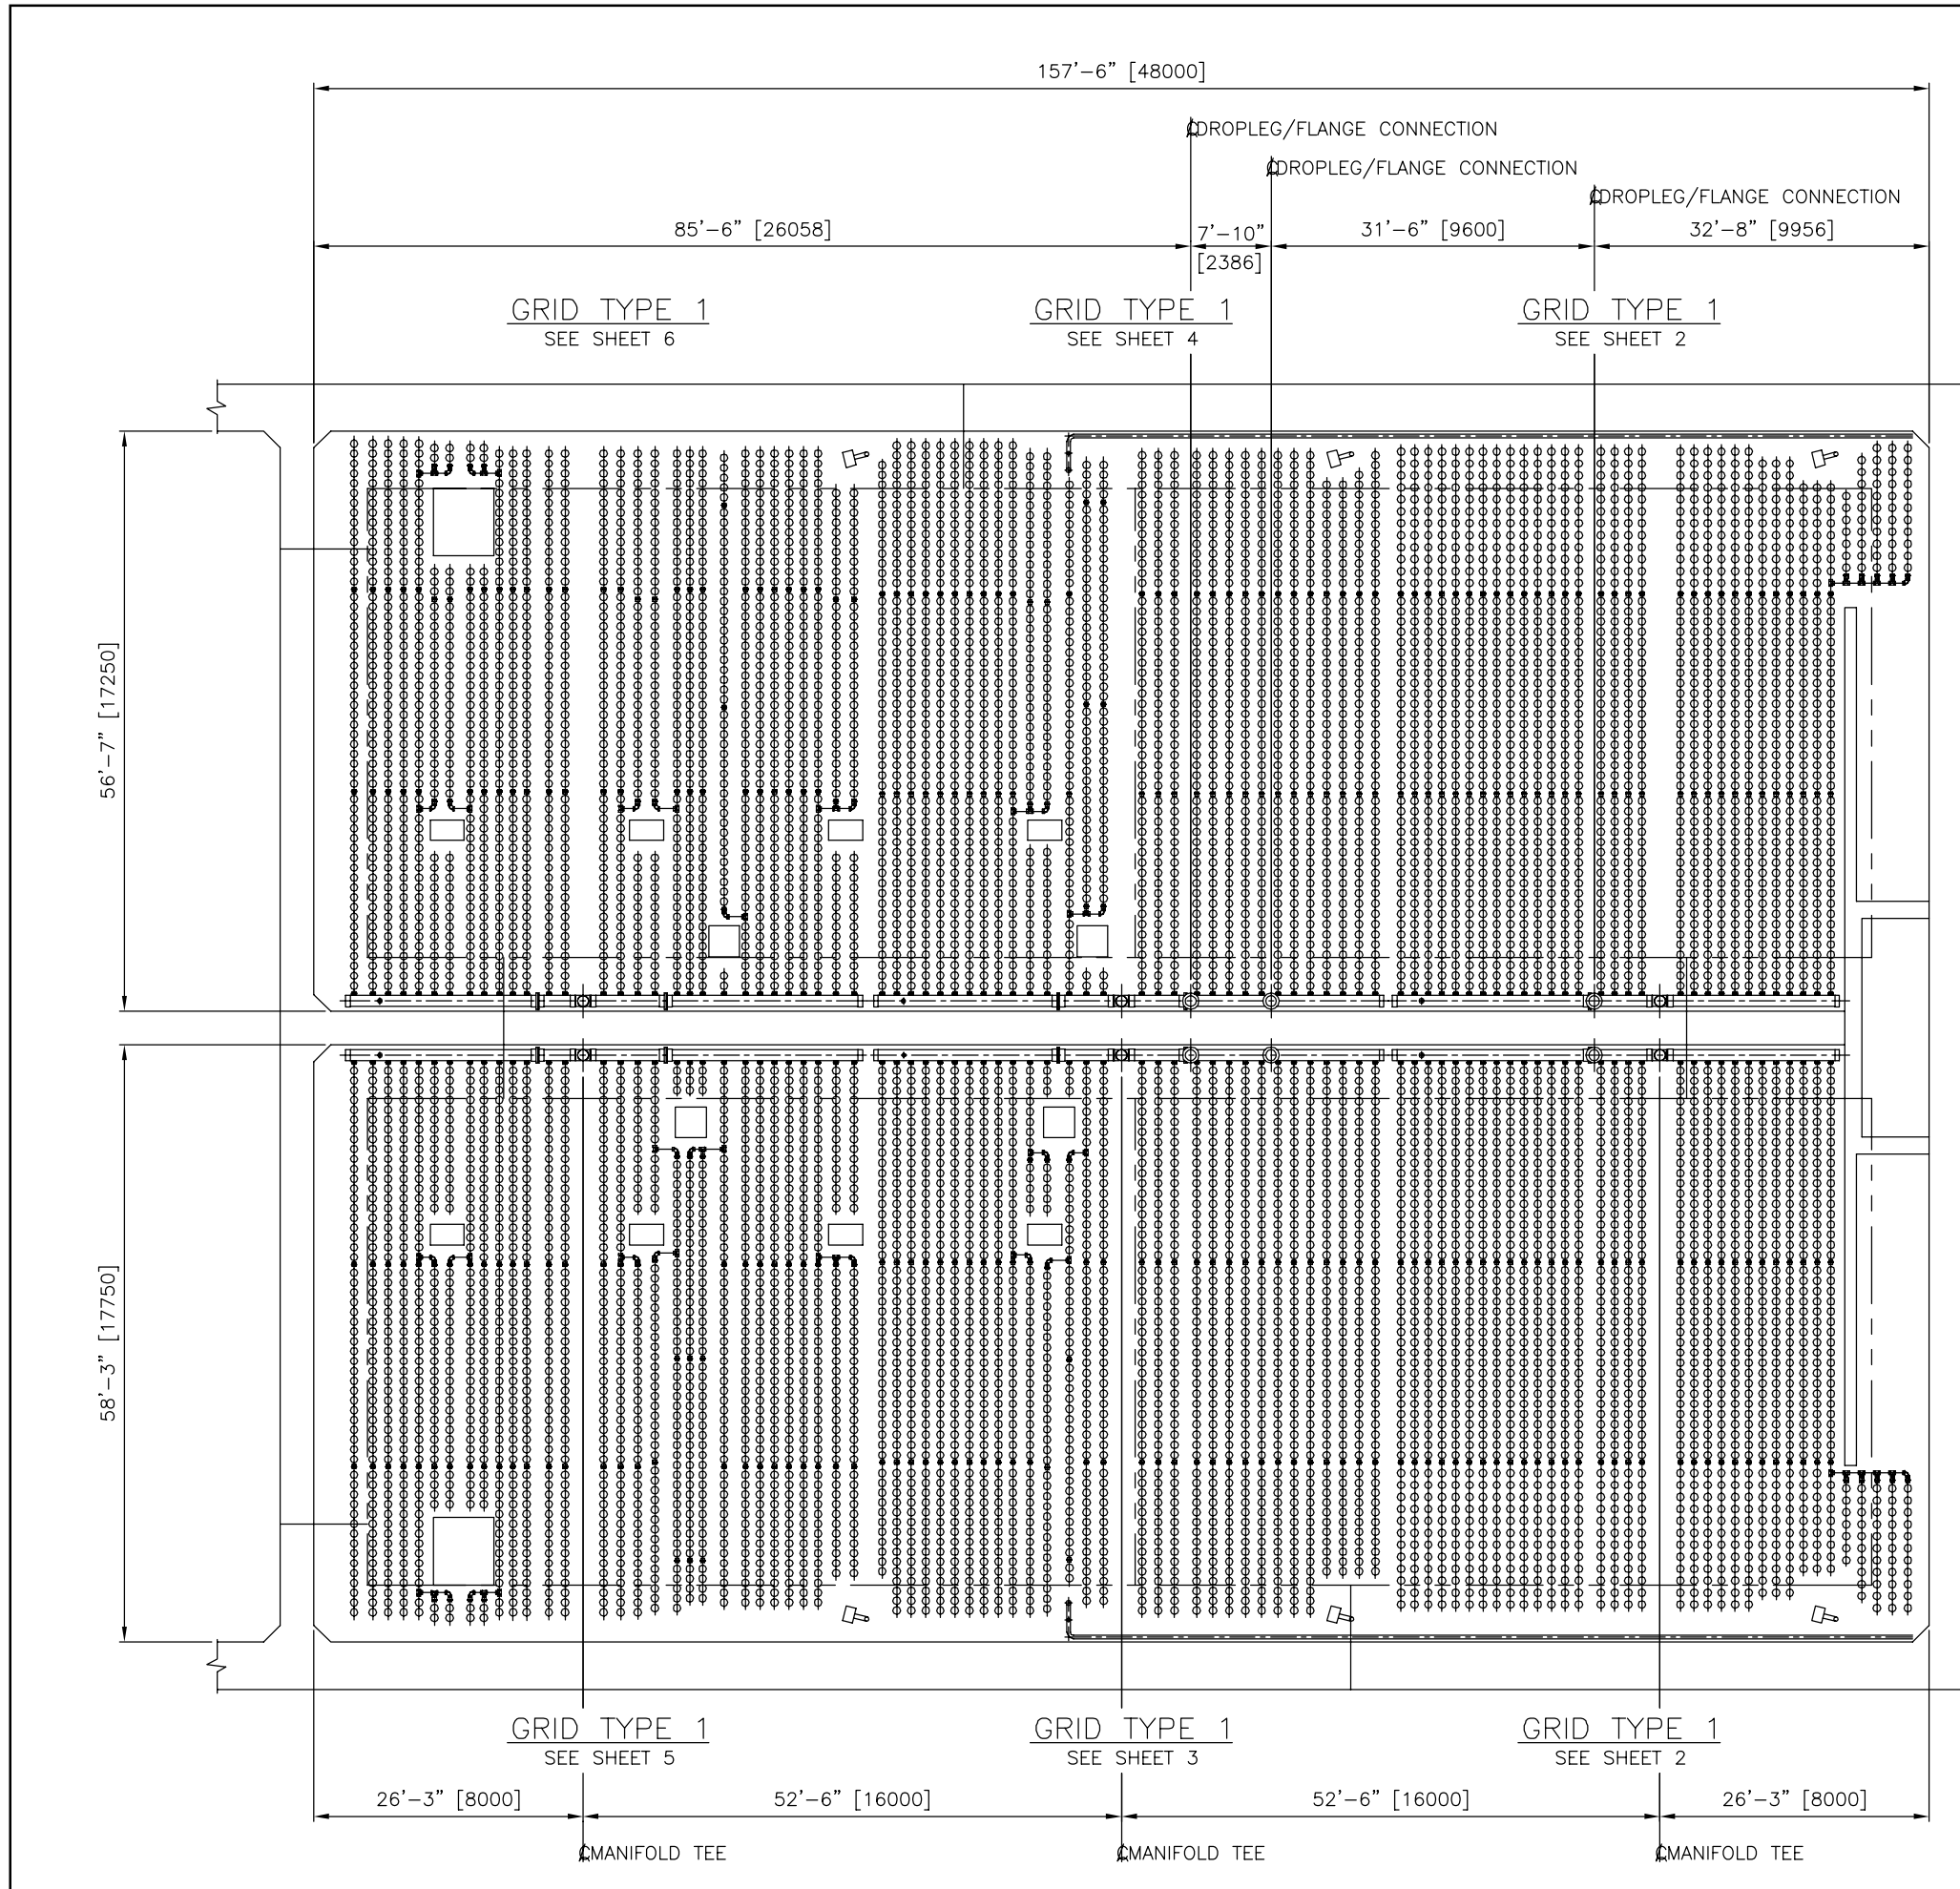

4/24 MEMBRANE DISC AERATION SYSTEM MATERIAL AND MANUFACTURING SPECIFICATIONS (316L PVC)

ITEM	MATERIAL SPECIFICATION	MANUFACTURING SPECIFICATION	NOTES
DROPLEG	316L STAINLESS STEEL ASTM A240	FITTINGS: ASTM A774 TUBULAR PRODUCTS: ASTM A778 ASTM A554	150# DRILLING FOR TERMINATION FLANGE CONNECTION. 12 GAUGE PIPE (0.109") WALL THICKNESS ON DROPLEG. *SEE BELOW
SUPPORTS	316 STAINLESS ST SLOTS & PILES PER ASTM A276 THREADED ROSS PER ASTM A276		*L GRADE NOT REQUIRED FOR NON-WELDED PARTS
BOLTS, NUTS, WASHERS	316 STAINLESS STL		
FIXED JOINT O-RING	NATURAL RUBBER/SBR		45 ± 5 DUROMETER SHORE A COMPRESSION SET 1% MAX.
EXPANSION JOINT O-RING	NATURAL RUBBER/SBR		40 ± 5 DUROMETER SHORE A 0.45 COEFFICIENT OF FRICTION MAX.
LOWER DROPLEG & MANIFOLD	PVC, ASTM D1784 COMPOUND 12454-B	PIPE: FITTINGS: ASTM D1785 ASTM D2486	
AIR DISTRIBUTORS	PVC, ASTM D3915 COMPOUND 124524	PIPE: FITTINGS: ASTM D3934 ASTM D3934	MINIMUM 2% TITANIUM DIOXIDE
DIFFUSER HOLDER SUBPLATE, RETAINING RING	PVC, ASTM D3915 COMPOUND 124524		MINIMUM 2% TITANIUM DIOXIDE
DIFFUSER ELEMENT	EPDM		
PVC SOLVENT WELDING	ASTM D2564	ASTM D2855	

*STAINLESS STEEL DROPLEG FABRICATION
FACTORY WELD ONLY WITH MIG, TIG, OR PLASMA-ARC WELDING INERT GAS PROCESSES, FULL PENETRATION BUTT WELDS, ER 316L FILLER WIRE. AFTER FABRICATION FINISH CLEAN ALL WELDED STAINLESS STEEL ASSEMBLIES BY FULL IMMERSION CLEANING TECHNIQUES IN ACCORDANCE TO 6.2.11 OF ASTM A380-88. THE ACID FOR USE DEFINED BY TABLE A2.1 OF ANNEX A2 OF ASTM A380. FINAL RINSE AND DRY IN ACCORDANCE TO SECTION 8.3 OF ASTM A380. ALL WELDED SURFACES TO CONFORM TO AISI NO. 2D FINISH.

SBR BASIN 2


SBR BASINS 1 & 2
(1) REQ'D AS SHOWN
KEY PLAN (1)



VIEW, SECTION OR
DETAIL NUMBER
2/3
SHEET NUMBER ON WHICH
VIEW, SECTION OR
DETAIL IS FOUND

SBR BASIN 1

4			
3			
2			
1			
NO.	DATE	REVISION	BY
WINNIPEG, MB NORTH END WPCC			
THIS DRAWING IS THE PROPERTY OF SANTARE AND IS SUBMITTED IN CONFIDENCE. IT IS NOT TO BE DISCLOSED, USED OR DUPLICATED WITHOUT PERMISSION OF SANTARE.			
SBR BASINS 1 & 2 KEY PLAN			
ITT ADVANCED WATER TREATMENT			
DRWN BY CK	DATE 11-27-06	EQUIP. MEM	JOB 06-6371S
CHWD BY RH	DATE 11-29-06	STD.	1 OF 13
APPVD BY	DATE	SIZE D	REV. A DWG E-1

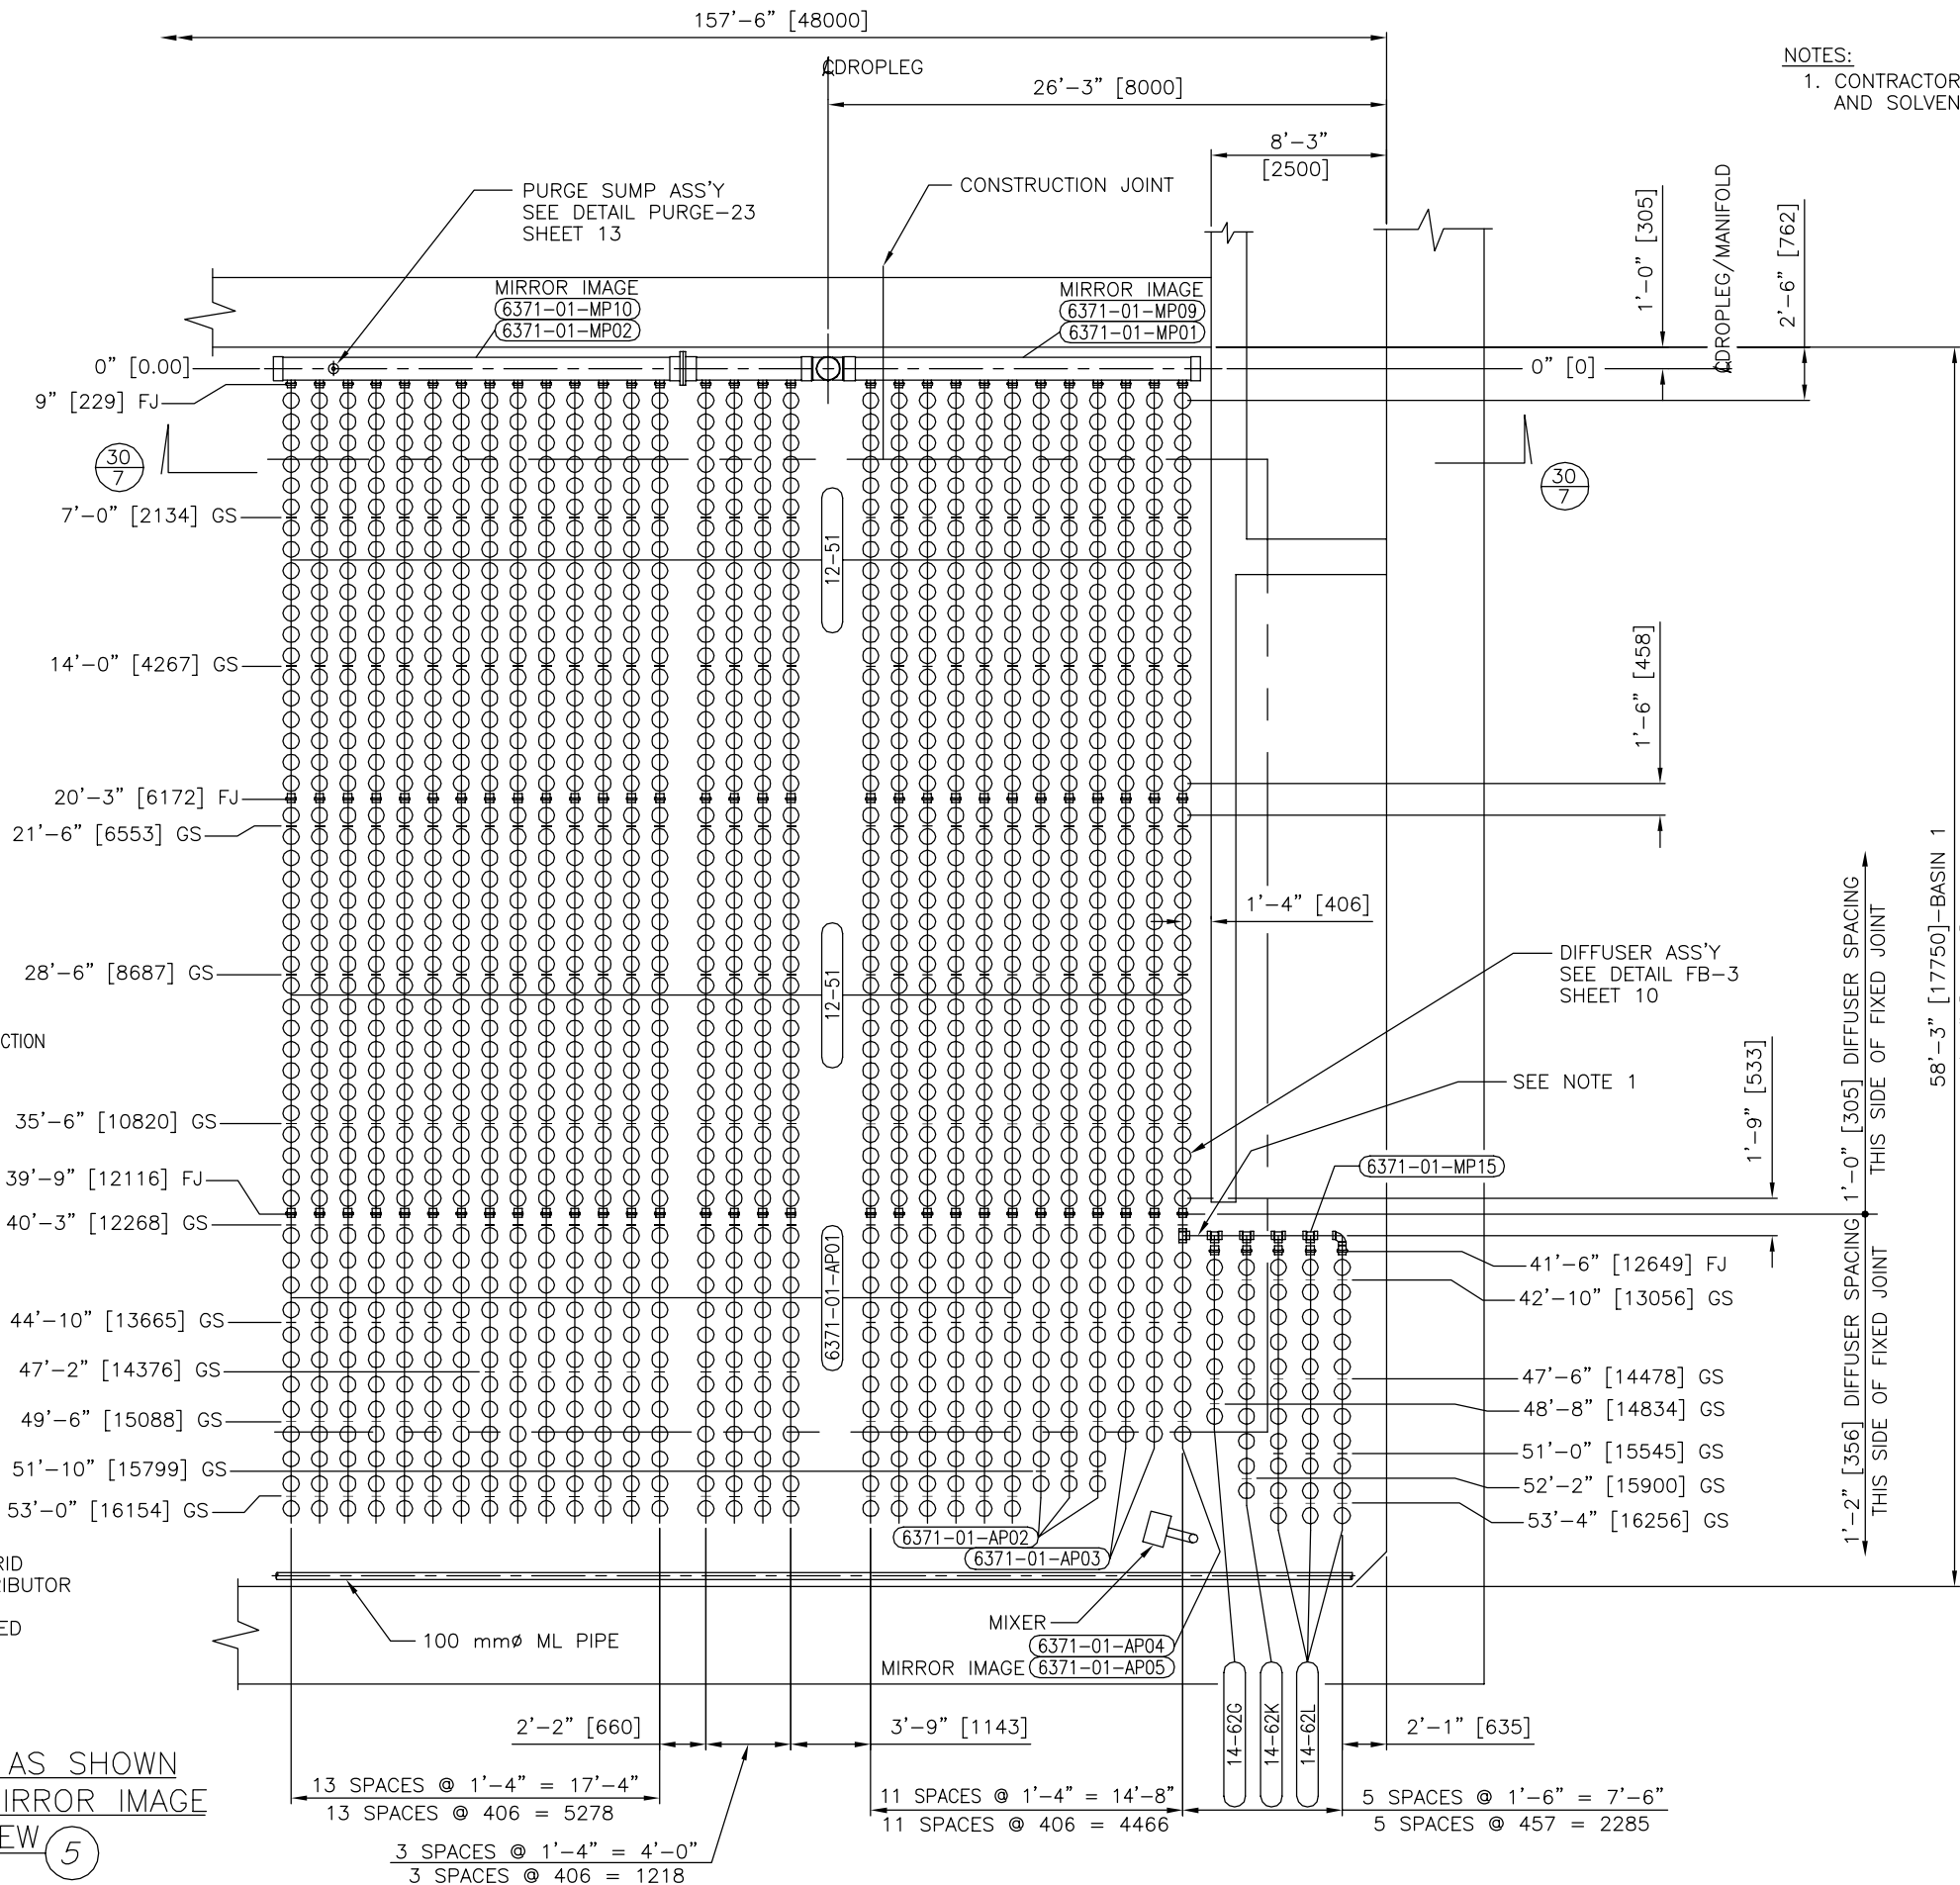

NOTES:
 1. CONTRACTOR TO CUT PIPE TO SUIT
 AND SOLVENT WELD AS REQ'D IN THE FIELD.

NOTE: SUPPORT SPACING
 Every attempt has been made to insure locational dimensions of the supports are correct. However, after one line of air distributor anchors for any grid type have been installed, the locations must be checked for proper clearances by installing the supplied air headers. Spacing between lines must be checked for fit with the cross manifold and drain line. Any discrepancies or interferences must be brought to the attention of SANITAIRE prior to further installation.
 The actual support anchor locations must be indexed from the centerline of the manifold. The actual accumulative dimensional error from the manifold to the anchor bolt must not exceed $\pm 3/4"$.

LEGEND
 FJ - FIXED JOINT
 SEE DETAIL FB-10A
 SHEET- 10
 GS - GUIDE SUPPORT (2354-13S)
 SEE DETAIL SUP-2
 SHEET- 12
 - FOR TYPICAL AIR DISTRIBUTOR SECTION
 SEE DETAIL FB-22C
 SHEET- 10

GRID TYPE '1'
 2 -TANK(S)
 1-GRID(S) PER TANK
 30-AIR DISTRIBUTORS PER GRID
 VARIES -DIFFUSERS PER AIR DISTRIBUTOR
 1537-DIFFUSERS PER GRID
 3074-TOTAL DIFFUSERS INSTALLED
 FOR THIS GRID TYPE

SBR BASIN 1 AS SHOWN
 SBR BASIN 2 MIRROR IMAGE
 PLAN VIEW (5)

4			
3			
2			
1			
NO.	DATE	REVISION	BY
WINNIPEG, MB NORTH END WPCC			
SBR BASINS 1 & 2 GRID TYPE 1 PLAN VIEW			
ITT ADVANCED WATER TREATMENT			
DRWN BY	DATE 11-27-06	EQUIP. MEM	JOB 06-6371S
CHKD BY	DATE 11-29-06	STD.	SHT. 2 OF 13
APPVD BY	DATE	SIZE D	REV. A DWG E-2



157'-6" [48000]

78'-9" [24000]
(TO INSIDE FACE OF WALL)

78'-9" [24000]
(TO INSIDE FACE OF WALL)

NOTES:


- CONTRACTOR TO CUT PIPE TO SUIT AND SOLVENT WELD AS REQ'D IN THE FIELD.
- 1'-0" TYP DIFFUSER SPACING ALONG ENTIRE LENGTH OF THIS DISTRIBUTOR.

PURGE SUMP ASS'Y
SEE DETAIL PURGE-23
SHEET 13

SEE NOTE 1
(4) PLACES

1'-0" [305]

2'-6" [762]

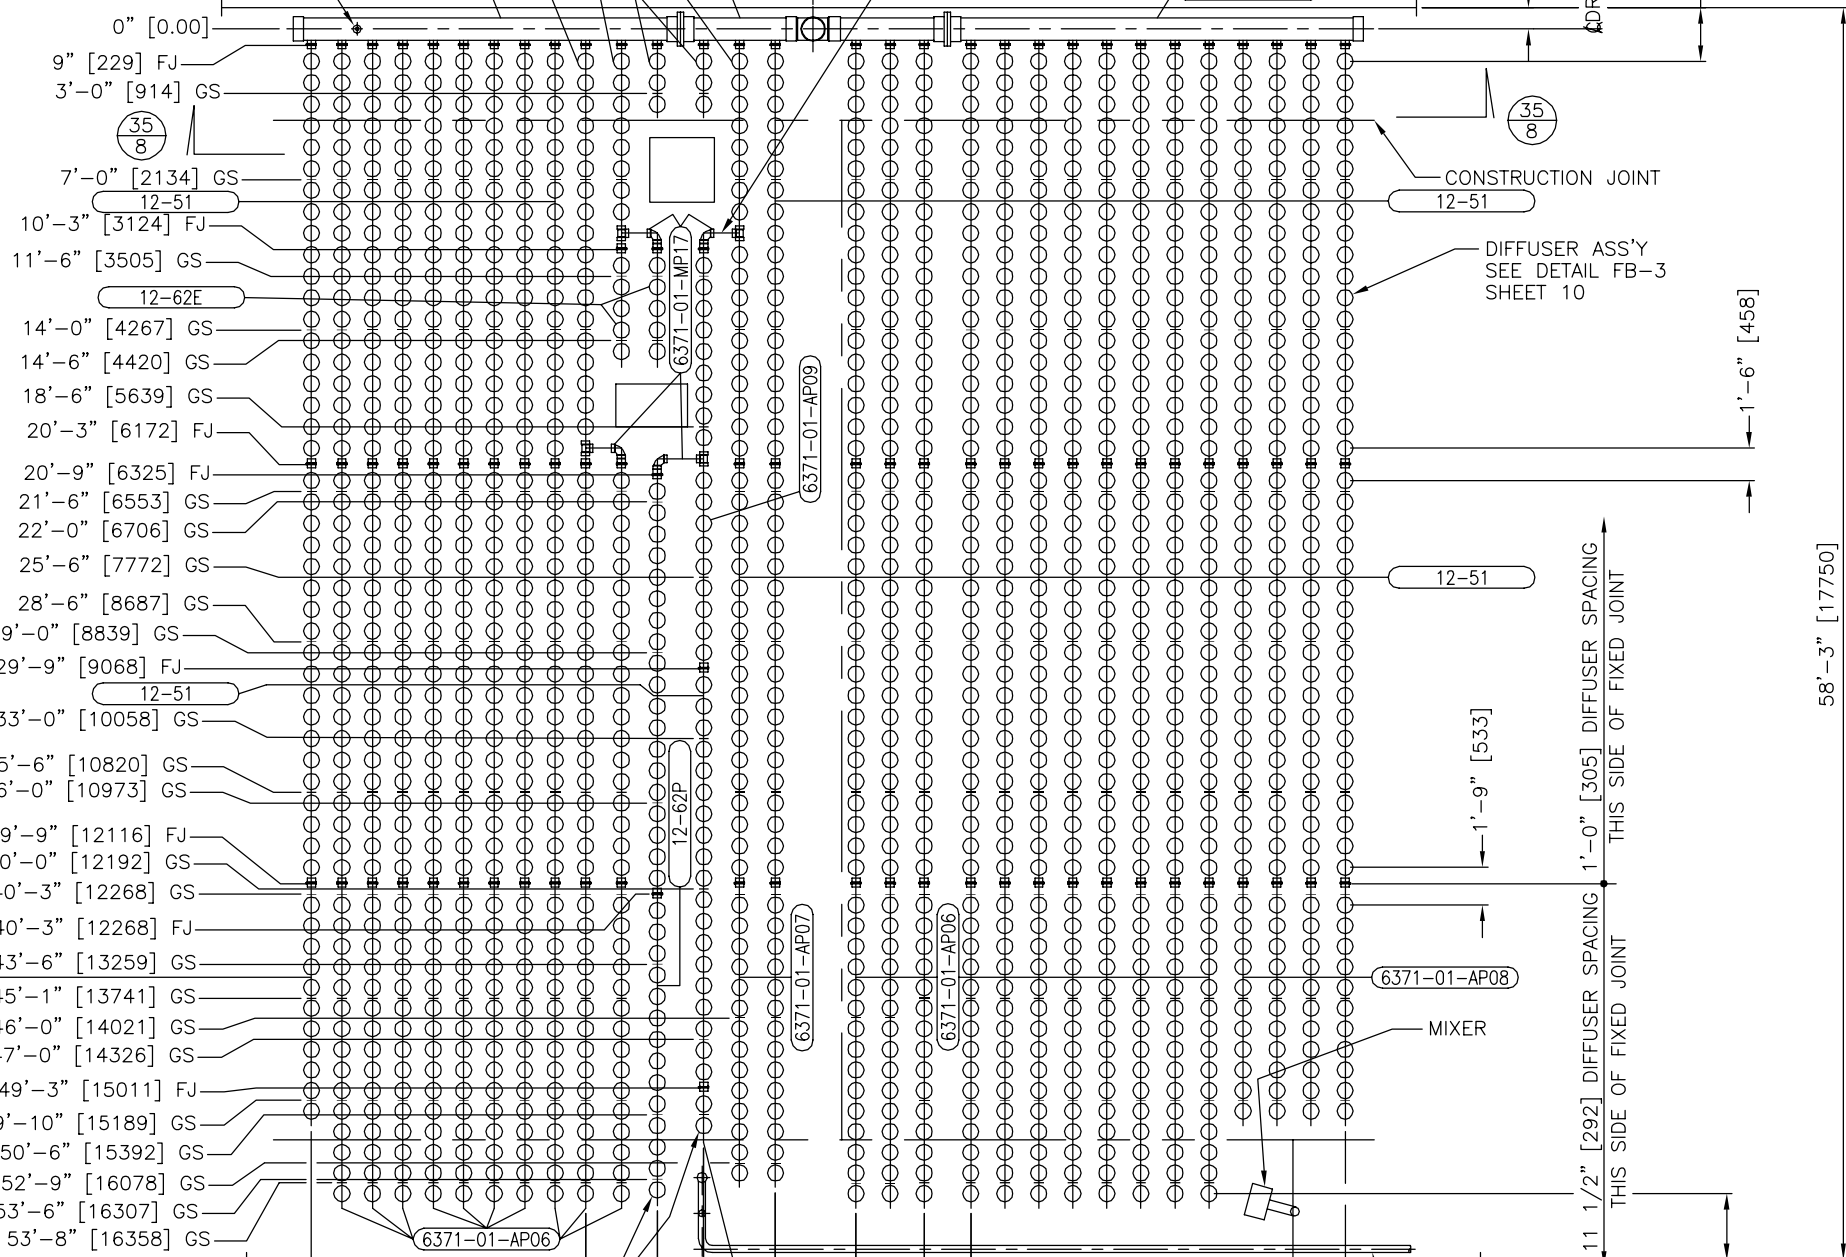

NOTE: SUPPORT SPACING

Every attempt has been made to insure locational dimensions of the supports are correct. However, after one line of air distributor anchors for any grid type have been installed, the locations must be checked for proper clearances by installing the supplied air headers. Spacing between lines must be checked for fit with the cross manifold and drain line. Any discrepancies or interferences must be brought to the attention of SANITAIRE prior to further installation.

The actual support anchor locations must be indexed from the centerline of the manifold. The actual accumulative dimensional error from the manifold to the anchor bolt must not exceed $\pm 3/4"$.

58'-3" [17750]

LEGEND

- FJ - FIXED JOINT
SEE DETAIL FB-10A
SHEET- 10
- GS - GUIDE SUPPORT (2354-13S)
SEE DETAIL SUP-2
SHEET- 12
- FOR TYPICAL AIR DISTRIBUTOR SECTION
SEE DETAIL FB-22C
SHEET- 10

GRID TYPE '1'

- 1-TANK(S)
- 1-GRID(S) PER TANK
- 30-AIR DISTRIBUTORS PER GRID
- VARIABLES-DIFFUSERS PER AIR DISTRIBUTOR
- 1537-DIFFUSERS PER GRID
- 1537-TOTAL DIFFUSERS INSTALLED FOR THIS GRID TYPE

SBR BASIN 1 AS SHOWN
PLAN VIEW 10


9 SPACES @ 1'-5" = 12'-9"
9 SPACES @ 432 = 3888

2 SPACES @ 1'-8" = 3'-4"
2 SPACES @ 508 = 1016

11 SPACES @ 1'-7" = 17'-5"
11 SPACES @ 483 = 5313

2 SPACES @ 1'-7" = 3'-2"
2 SPACES @ 483 = 966

4				
3				
2				
1				
NO.	DATE	REVISION	BY	
WINNIPEG, MB NORTH END WPCC				
SBR BASIN 1 GRID TYPE 1 PLAN VIEW				
ITT ADVANCED WATER TREATMENT				
DRWN BY	DATE 11-27-06	EQUIP. MEM	JOB 06-6371S	SHT. 3
CHKD BY	DATE 11-29-06	STD.		OF 13
APPVD BY	DATE	SIZE D	REV. A	ENC-E-3

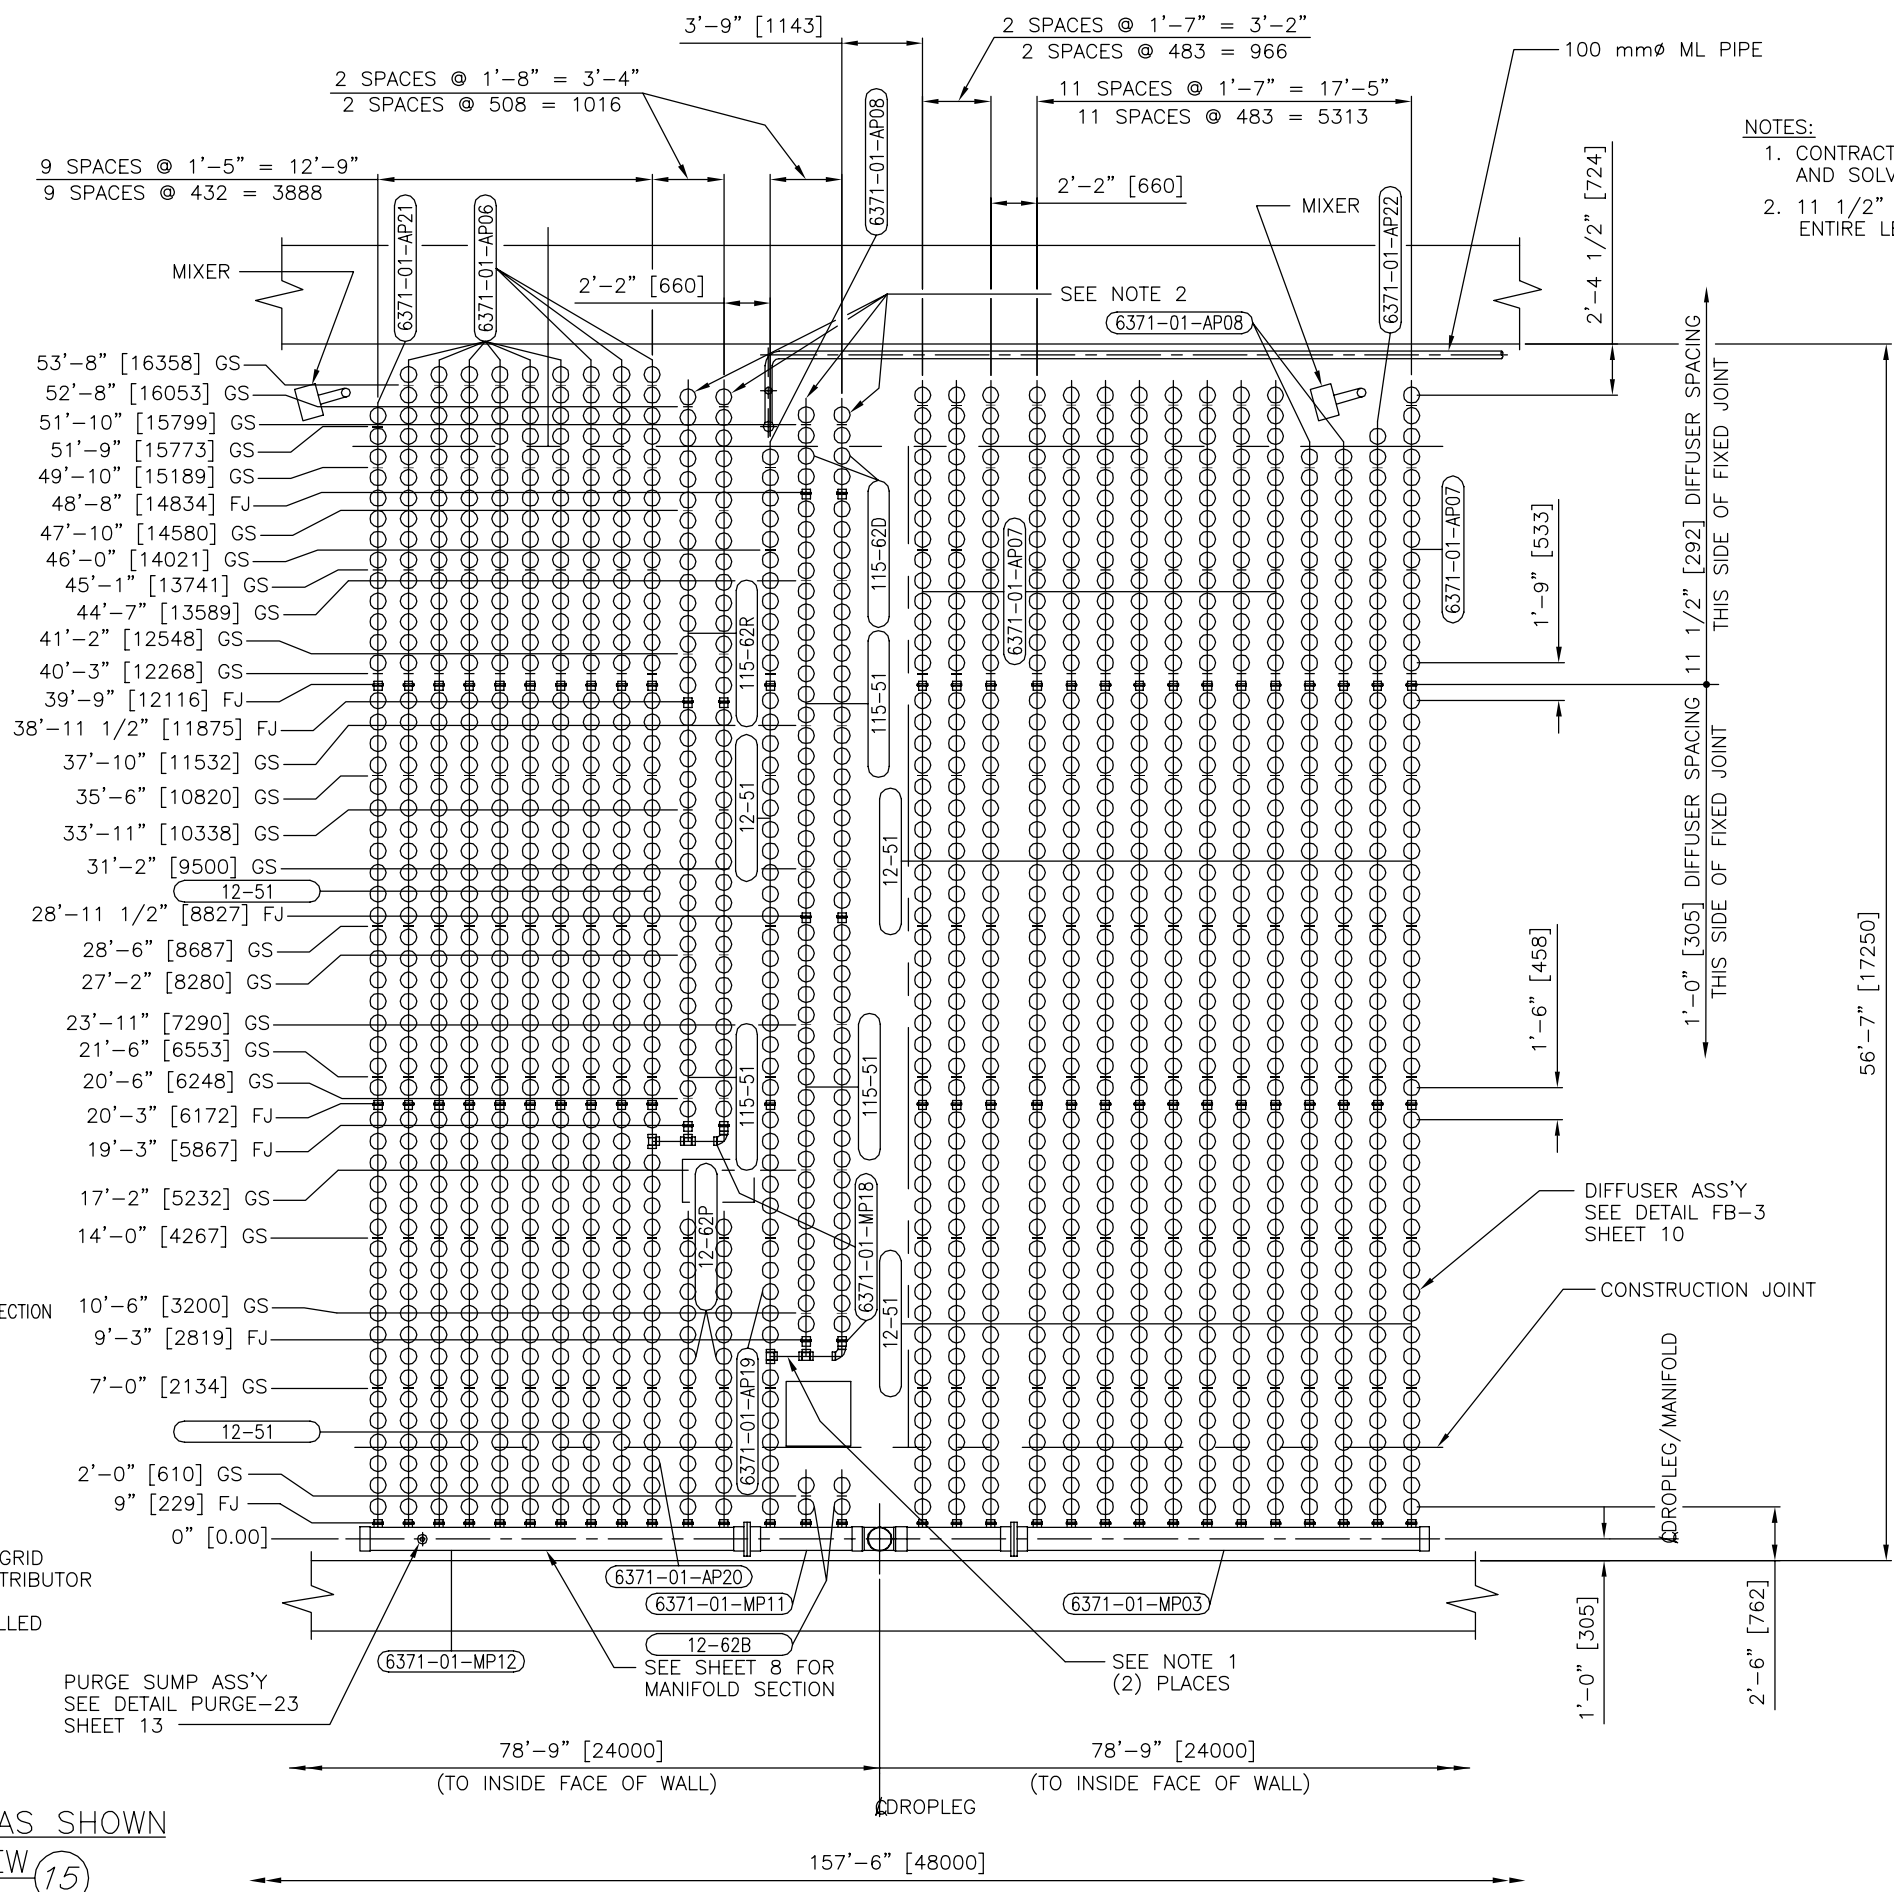

- NOTES:**
1. CONTRACTOR TO CUT PIPE TO SUIT AND SOLVENT WELD AS REQ'D IN THE FIELD.
 2. 11 1/2" TYP DIFFUSER SPACING ALONG ENTIRE LENGTH OF THIS DISTRIBUTOR.

NOTE: SUPPORT SPACING

Every attempt has been made to insure locational dimensions of the supports are correct. However, after one line of air distributor anchors for any grid type have been installed, the locations must be checked for proper clearances by installing the supplied air headers. Spacing between lines must be checked for fit with the cross manifold and drain line. Any discrepancies or interferences must be brought to the attention of SANITAIRE prior to further installation.

The actual support anchor locations must be indexed from the centerline of the manifold. The actual accumulative dimensional error from the manifold to the anchor bolt must not exceed $\pm 3/4"$.

- LEGEND**
- FJ - FIXED JOINT
SEE DETAIL FB-10A SHEET-10
 - GS - GUIDE SUPPORT (2354-13S)
SEE DETAIL SUP-2 SHEET-12
 - FOR TYPICAL AIR DISTRIBUTOR SECTION
SEE DETAIL FB-22C SHEET-10

GRID TYPE '1'

- 1-TANK(S)
- 1-GRID(S) PER TANK
- 30-AIR DISTRIBUTORS PER GRID
- VARIABLES-DIFFUSERS PER AIR DISTRIBUTOR
- 1537-DIFFUSERS PER GRID
- 1537-TOTAL DIFFUSERS INSTALLED FOR THIS GRID TYPE


PURGE SUMP ASS'Y
SEE DETAIL PURGE-23 SHEET 13

SEE SHEET 8 FOR MANIFOLD SECTION


SEE NOTE 1 (2) PLACES

SBR BASIN 2 AS SHOWN
PLAN VIEW (15)

4				
3				
2				
1				
NO.	DATE	REVISION	BY	
WINNIPEG, MB NORTH END WPCC				
SBR BASIN 2 GRID TYPE 1 PLAN VIEW				
ITT ADVANCED WATER TREATMENT				
DRWN BY	CK	DATE 11-27-06	EQUIP. MEM	JOB 06-6371S
CHWD BY	RH	DATE 11-29-06	STD.	4
APPRD BY		DATE	SIZE D	REV. A
				13

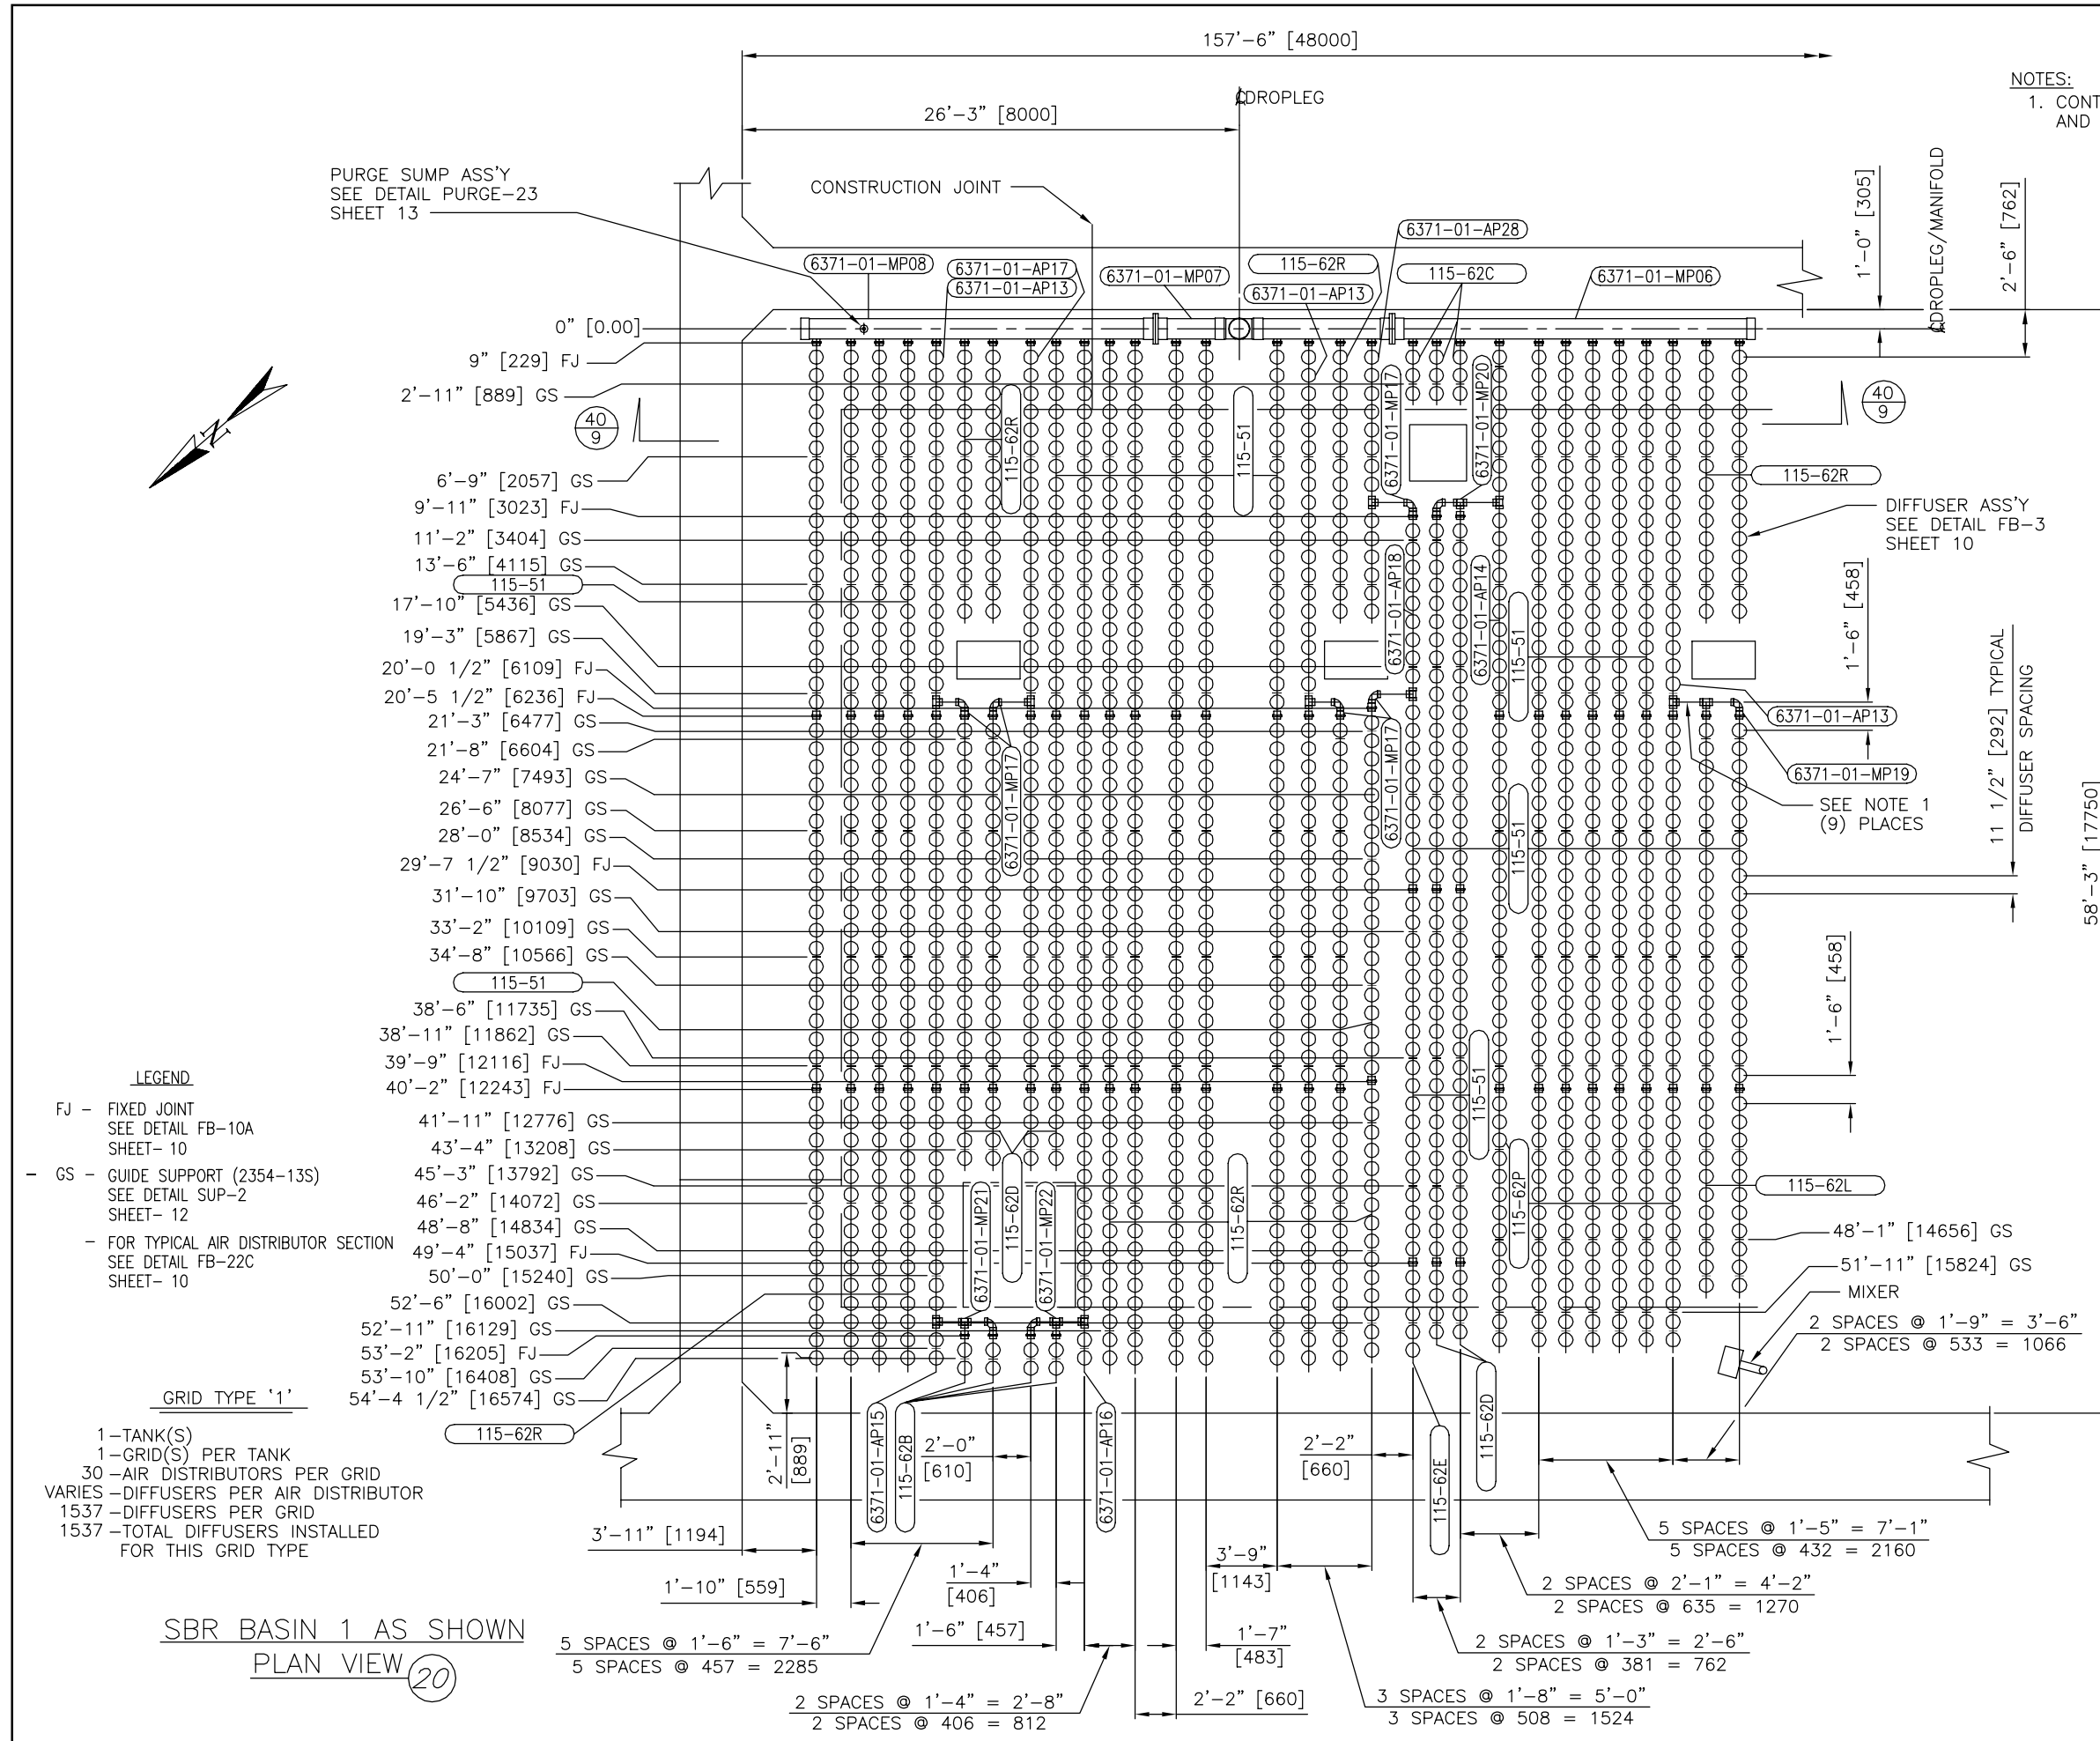

4				
3				
2				
1				
NO.	DATE	REVISION	BY	
WINNIPEG, MB NORTH END WPCC				
SBR BASIN 1 GRID TYPE 1 PLAN VIEW				
 ITT ADVANCED WATER TREATMENT				
DRWN BY	DATE 11-27-06	EQUIP. MEM	JOB 06-6371S	SHT. 5
CHKD BY	DATE 11-29-06	STD.		OF 13
APPVD BY	DATE	SIZE D	REV. A	DWG E-5

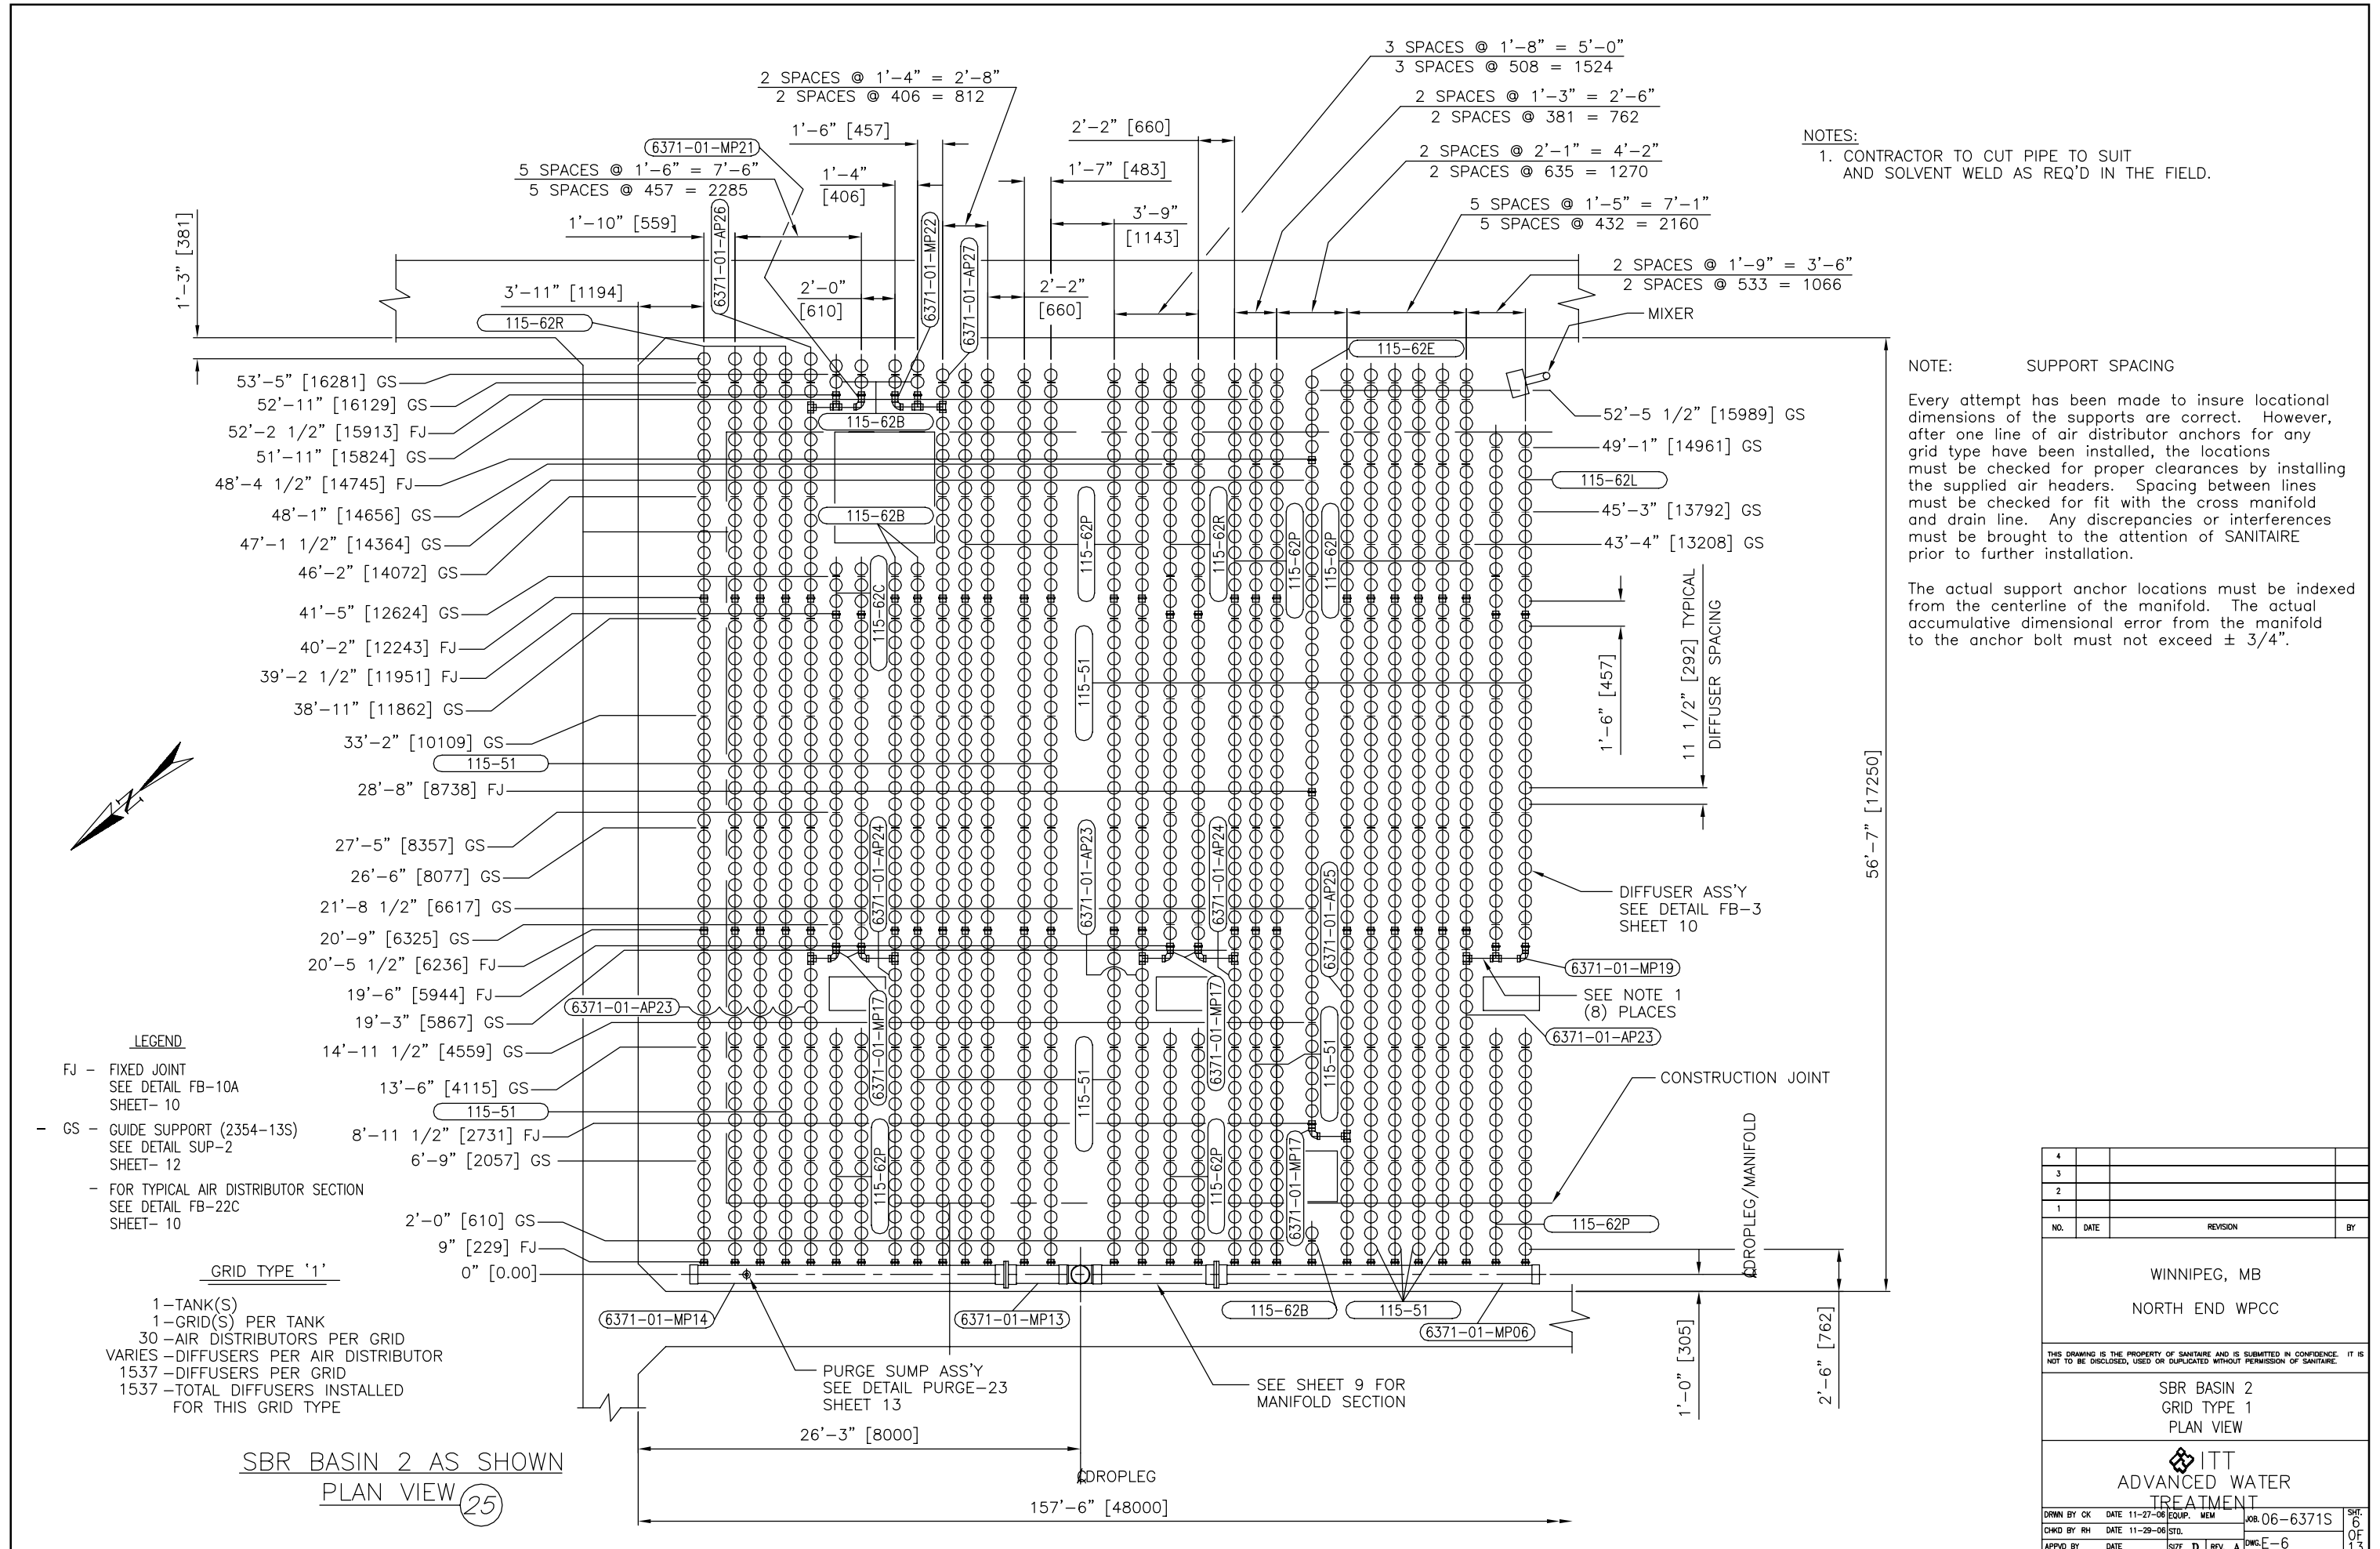

NOTES:
 1. CONTRACTOR TO CUT PIPE TO SUIT AND SOLVENT WELD AS REQ'D IN THE FIELD.

NOTE: SUPPORT SPACING
 Every attempt has been made to insure locational dimensions of the supports are correct. However, after one line of air distributor anchors for any grid type have been installed, the locations must be checked for proper clearances by installing the supplied air headers. Spacing between lines must be checked for fit with the cross manifold and drain line. Any discrepancies or interferences must be brought to the attention of SANITAIRE prior to further installation.


The actual support anchor locations must be indexed from the centerline of the manifold. The actual accumulative dimensional error from the manifold to the anchor bolt must not exceed $\pm 3/4"$.

LEGEND
 FJ - FIXED JOINT
 SEE DETAIL FB-10A SHEET- 10
 GS - GUIDE SUPPORT (2354-13S)
 SEE DETAIL SUP-2 SHEET- 12
 - FOR TYPICAL AIR DISTRIBUTOR SECTION
 SEE DETAIL FB-22C SHEET- 10

GRID TYPE '1'
 1-TANK(S)
 1-GRID(S) PER TANK
 30-AIR DISTRIBUTORS PER GRID
 VARIES-DIFFUSERS PER AIR DISTRIBUTOR
 1537-DIFFUSERS PER GRID
 1537-TOTAL DIFFUSERS INSTALLED FOR THIS GRID TYPE

SBR BASIN 2 AS SHOWN
 PLAN VIEW (25)

4			
3			
2			
1			
NO.	DATE	REVISION	BY
WINNIPEG, MB NORTH END WPCC			
SBR BASIN 2 GRID TYPE 1 PLAN VIEW			
ITT ADVANCED WATER TREATMENT			
DRWN BY CK	DATE 11-27-06	EQUIP. MEM	JOB 06-6371S
CHWD BY RH	DATE 11-29-06	STD.	SIZE D REV. A
APPVD BY	DATE	REV.	6 OF 13

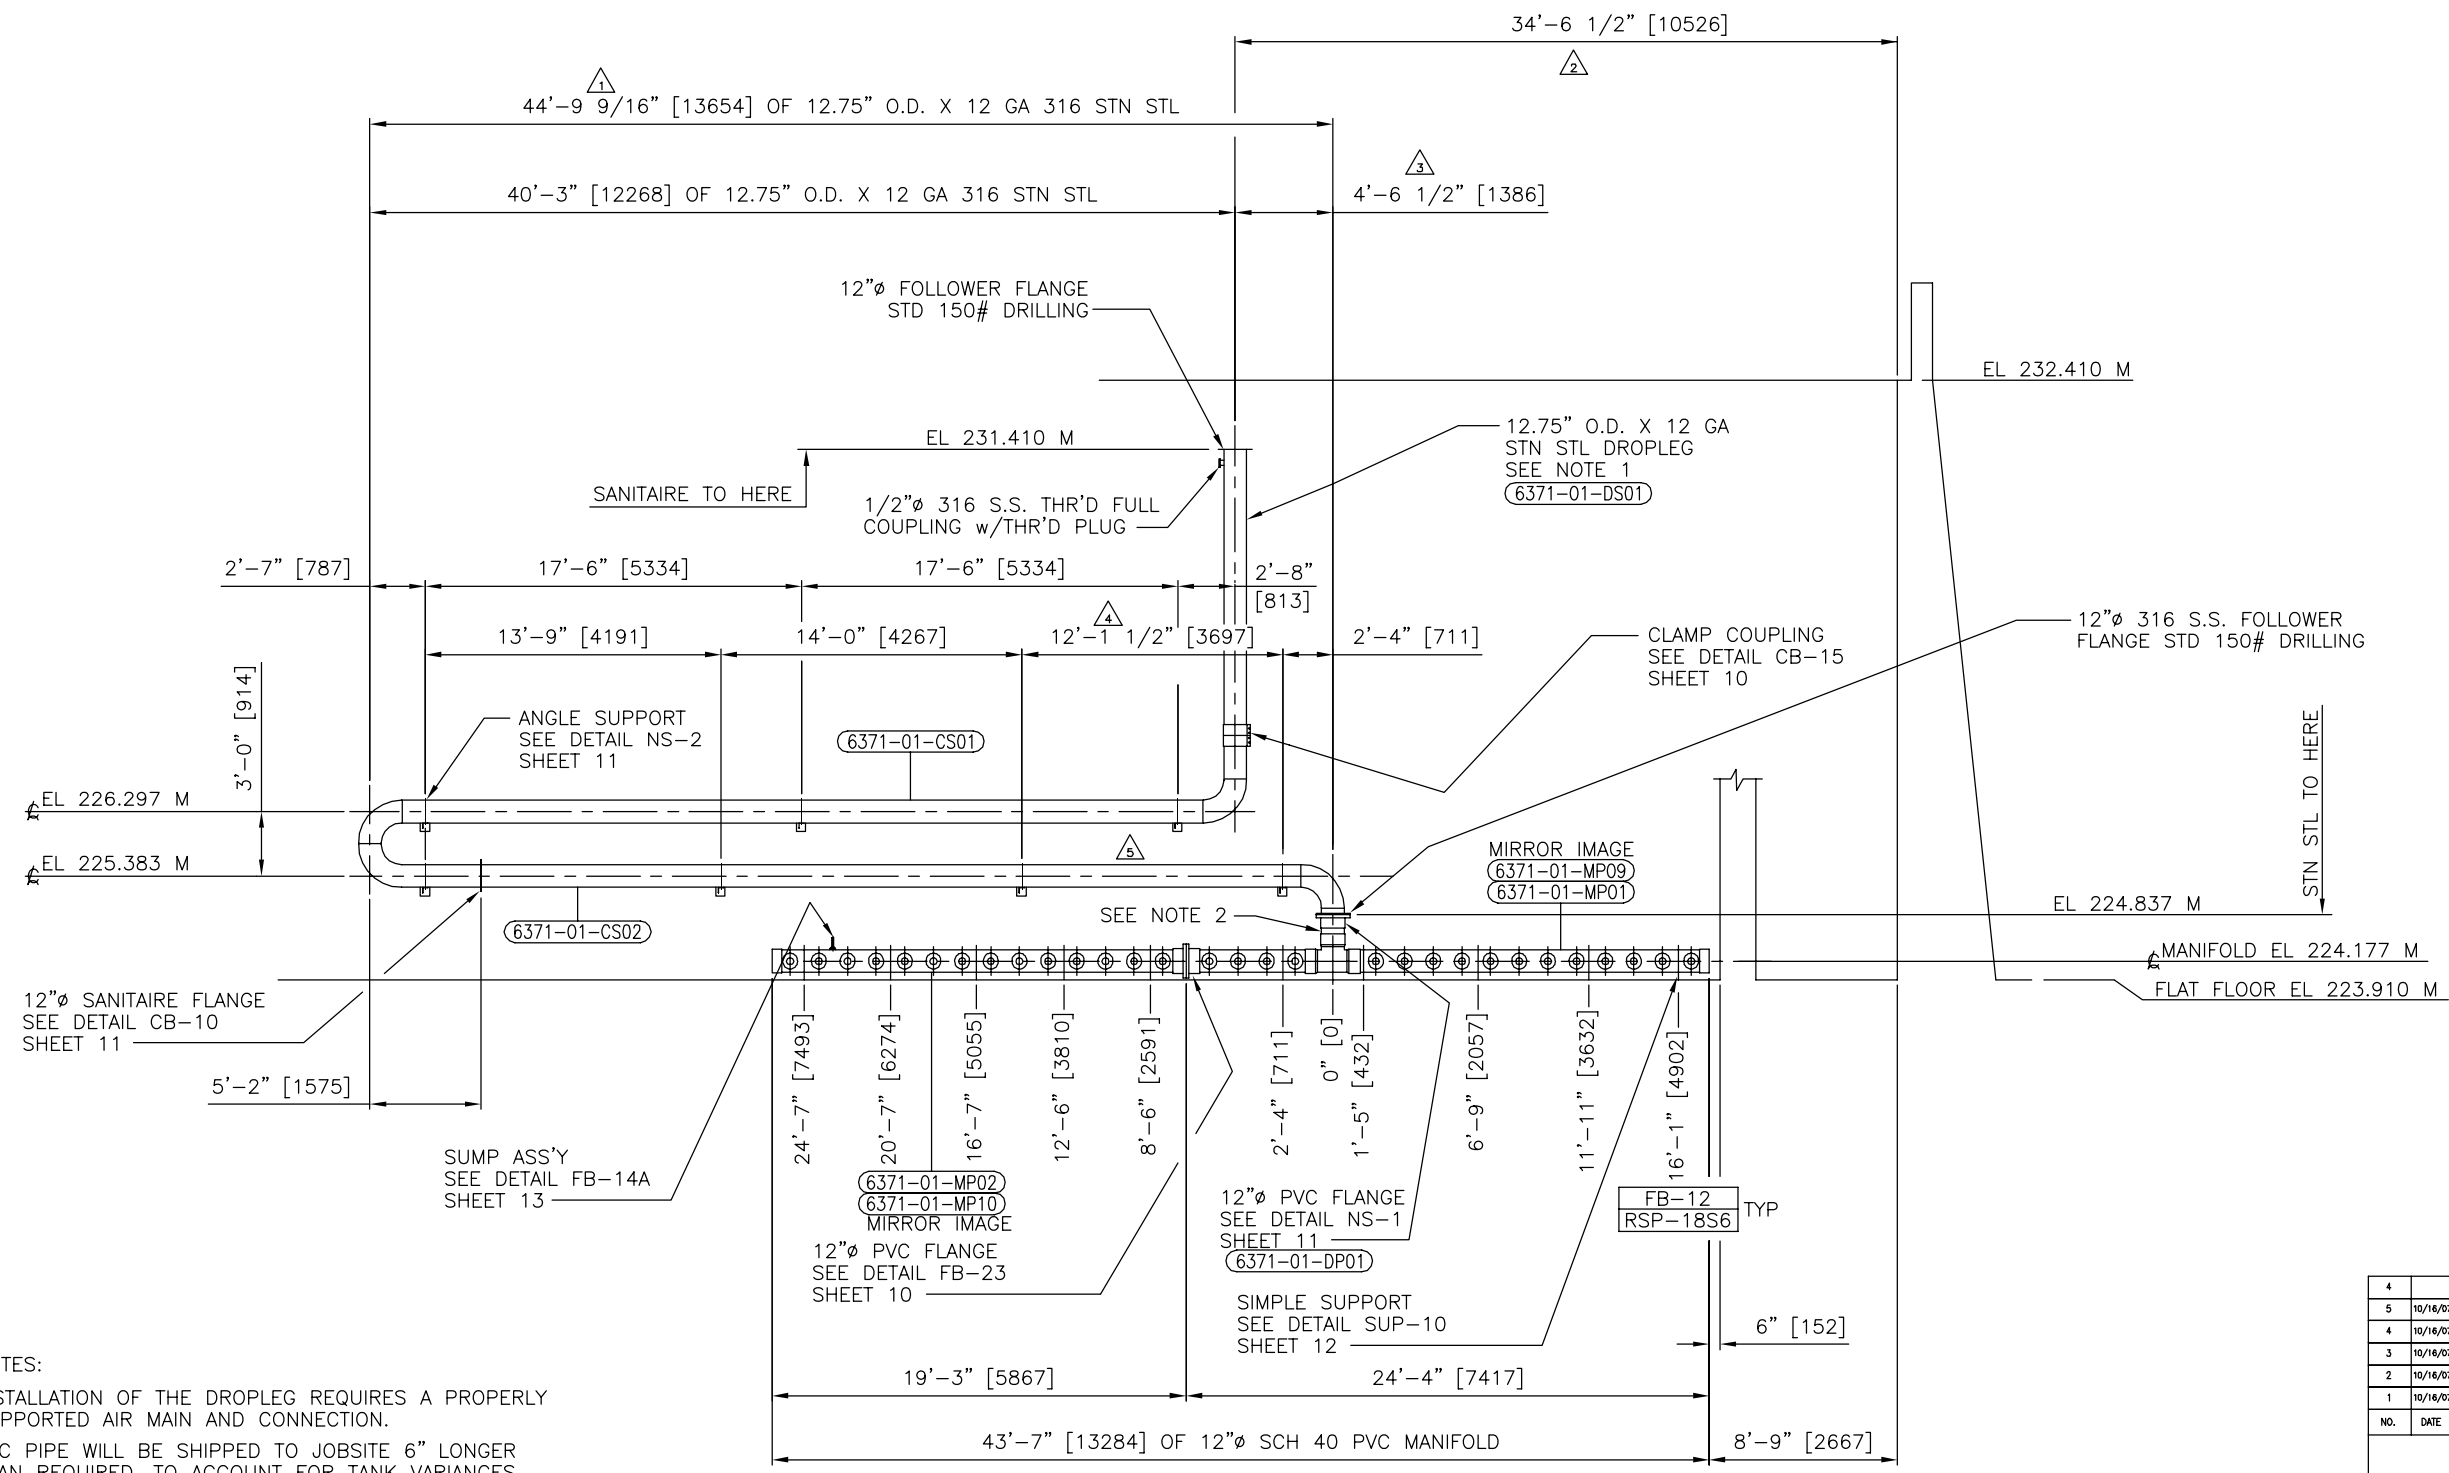

NOTES:

1. INSTALLATION OF THE DROPLEG REQUIRES A PROPERLY SUPPORTED AIR MAIN AND CONNECTION.
2. PVC PIPE WILL BE SHIPPED TO JOBSITE 6" LONGER THAN REQUIRED, TO ACCOUNT FOR TANK VARIANCES. CONTRACTOR TO CUT TO SUIT AND SOLVENT WELD INTO MANIFOLD AS REQ'D IN THE FIELD.
3. **FB-12** REFERS TO THE MANIFOLD SUPPORT SIZE AND CORRESPONDS TO THE TABLE SHOWN WITH THE SUPPORT DETAIL.
RSP-18S6 INDICATES THE SUPPORT STAND PART NUMBER.

DROPLEG/COOLING LOOP/MANIFOLD
SBR BASIN 1 AS SHOWN
SBR BASIN 2 MIRROR IMAGE
SECTION 30


4			
5	10/16/07	REMOVED 570 mm FROM LOWER RUNG OF COOLING LOOP	AM
4	10/16/07	DIMENSION WAS 14'-0" (4267)	AM
3	10/16/07	DIMENSION WAS 6'-5" (1956)	AM
2	10/16/07	DIMENSION WAS 32'-8" (9956)	AM
1	10/16/07	DIMENSION WAS 46'-8" (14224)	AM
NO.	DATE	REVISION	BY

WINNIPEG, MB
NORTH END WPCC

SBR BASINS 1 & 2
GRID TYPE 1
DROPLEG/COOLING LOOP/MANIFOLD SECTION

ITT
ADVANCED WATER
TREATMENT

DRWN BY	DATE	11-27-06	EQUIP. MEM	JOB	06-6371S	SHT.	7
CHKD BY	DATE	11-29-06	STD.			OF	13
APPVD BY	DATE		SIZE	D	REV.	A	ENC-E-7

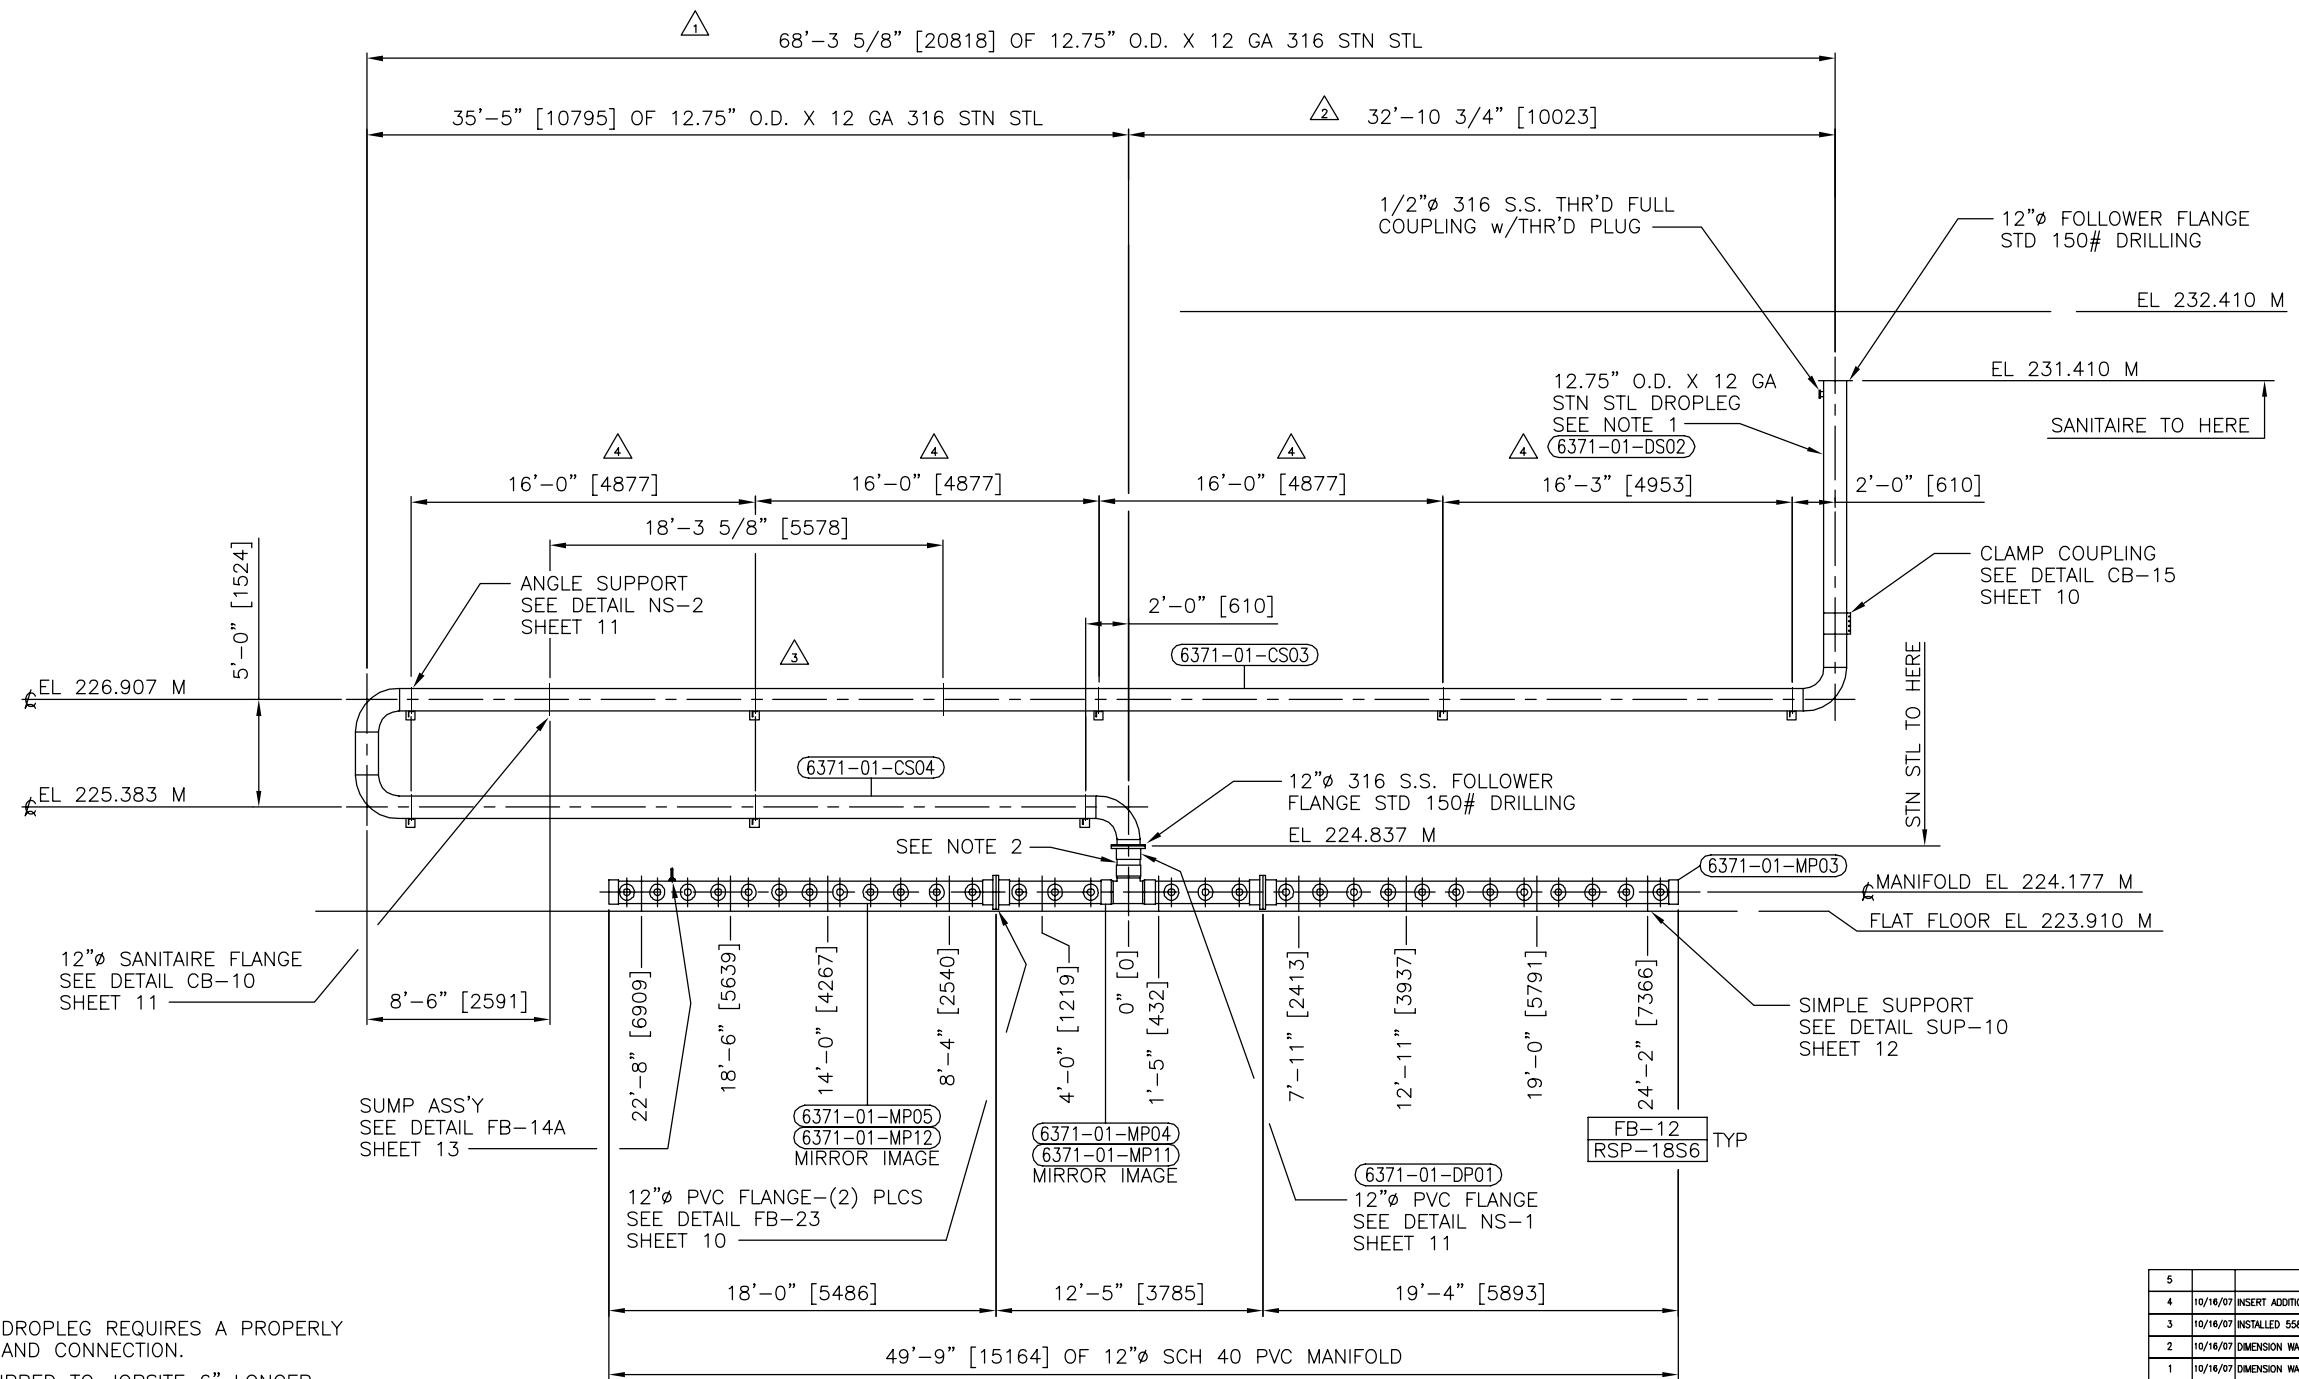

NOTES:

- INSTALLATION OF THE DROPLEG REQUIRES A PROPERLY SUPPORTED AIR MAIN AND CONNECTION.
- PVC PIPE WILL BE SHIPPED TO JOBSITE 6" LONGER THAN REQUIRED, TO ACCOUNT FOR TANK VARIANCES. CONTRACTOR TO CUT TO SUIT AND SOLVENT WELD INTO MANIFOLD AS REQ'D IN THE FIELD.
- | | |
|----------|---|
| FB-12 | REFERS TO THE MANIFOLD SUPPORT SIZE AND CORRESPONDS TO THE TABLE SHOWN WITH THE SUPPORT DETAIL. |
| RSP-18S6 | |

 INDICATES THE SUPPORT STAND PART NUMBER.

DROPLEG/COOLING LOOP/MANIFOLD
SBR BASIN 1 AS SHOWN
SBR BASIN 2 MIRROR IMAGE
SECTION 35


5			
4	10/16/07	INSERT ADDITIONAL KNEE BRACE; RESPACED OTHER KNEE BRACES	AM
3	10/16/07	INSTALLED 5588mm FLANGED SPOOL PIECE	AM
2	10/16/07	DIMENSION WAS 14'-7" (4445)	AM
1	10/16/07	DIMENSION WAS 50'-0" (15240)	AM
NO.	DATE	REVISION	BY

WINNIPEG, MB
NORTH END WPCC

THIS DRAWING IS THE PROPERTY OF SANITAIRE AND IS SUBMITTED IN CONFIDENCE. IT IS NOT TO BE DISCLOSED, USED OR DUPLICATED WITHOUT PERMISSION OF SANITAIRE.

SBR BASINS 1 & 2
GRID TYPE 1
DROPLEG/COOLING LOOP/MANIFOLD SECTION

ITT ADVANCED WATER TREATMENT			
DRWN BY CK	DATE 11-27-06	EQUIP. MEM	JOB 06-6371S
CHWD BY RH	DATE 11-29-06	STD.	JOB 06-6371S
APPRD BY	DATE	SIZE D REV. A	DWG E-8
			SHEET 8 OF 13

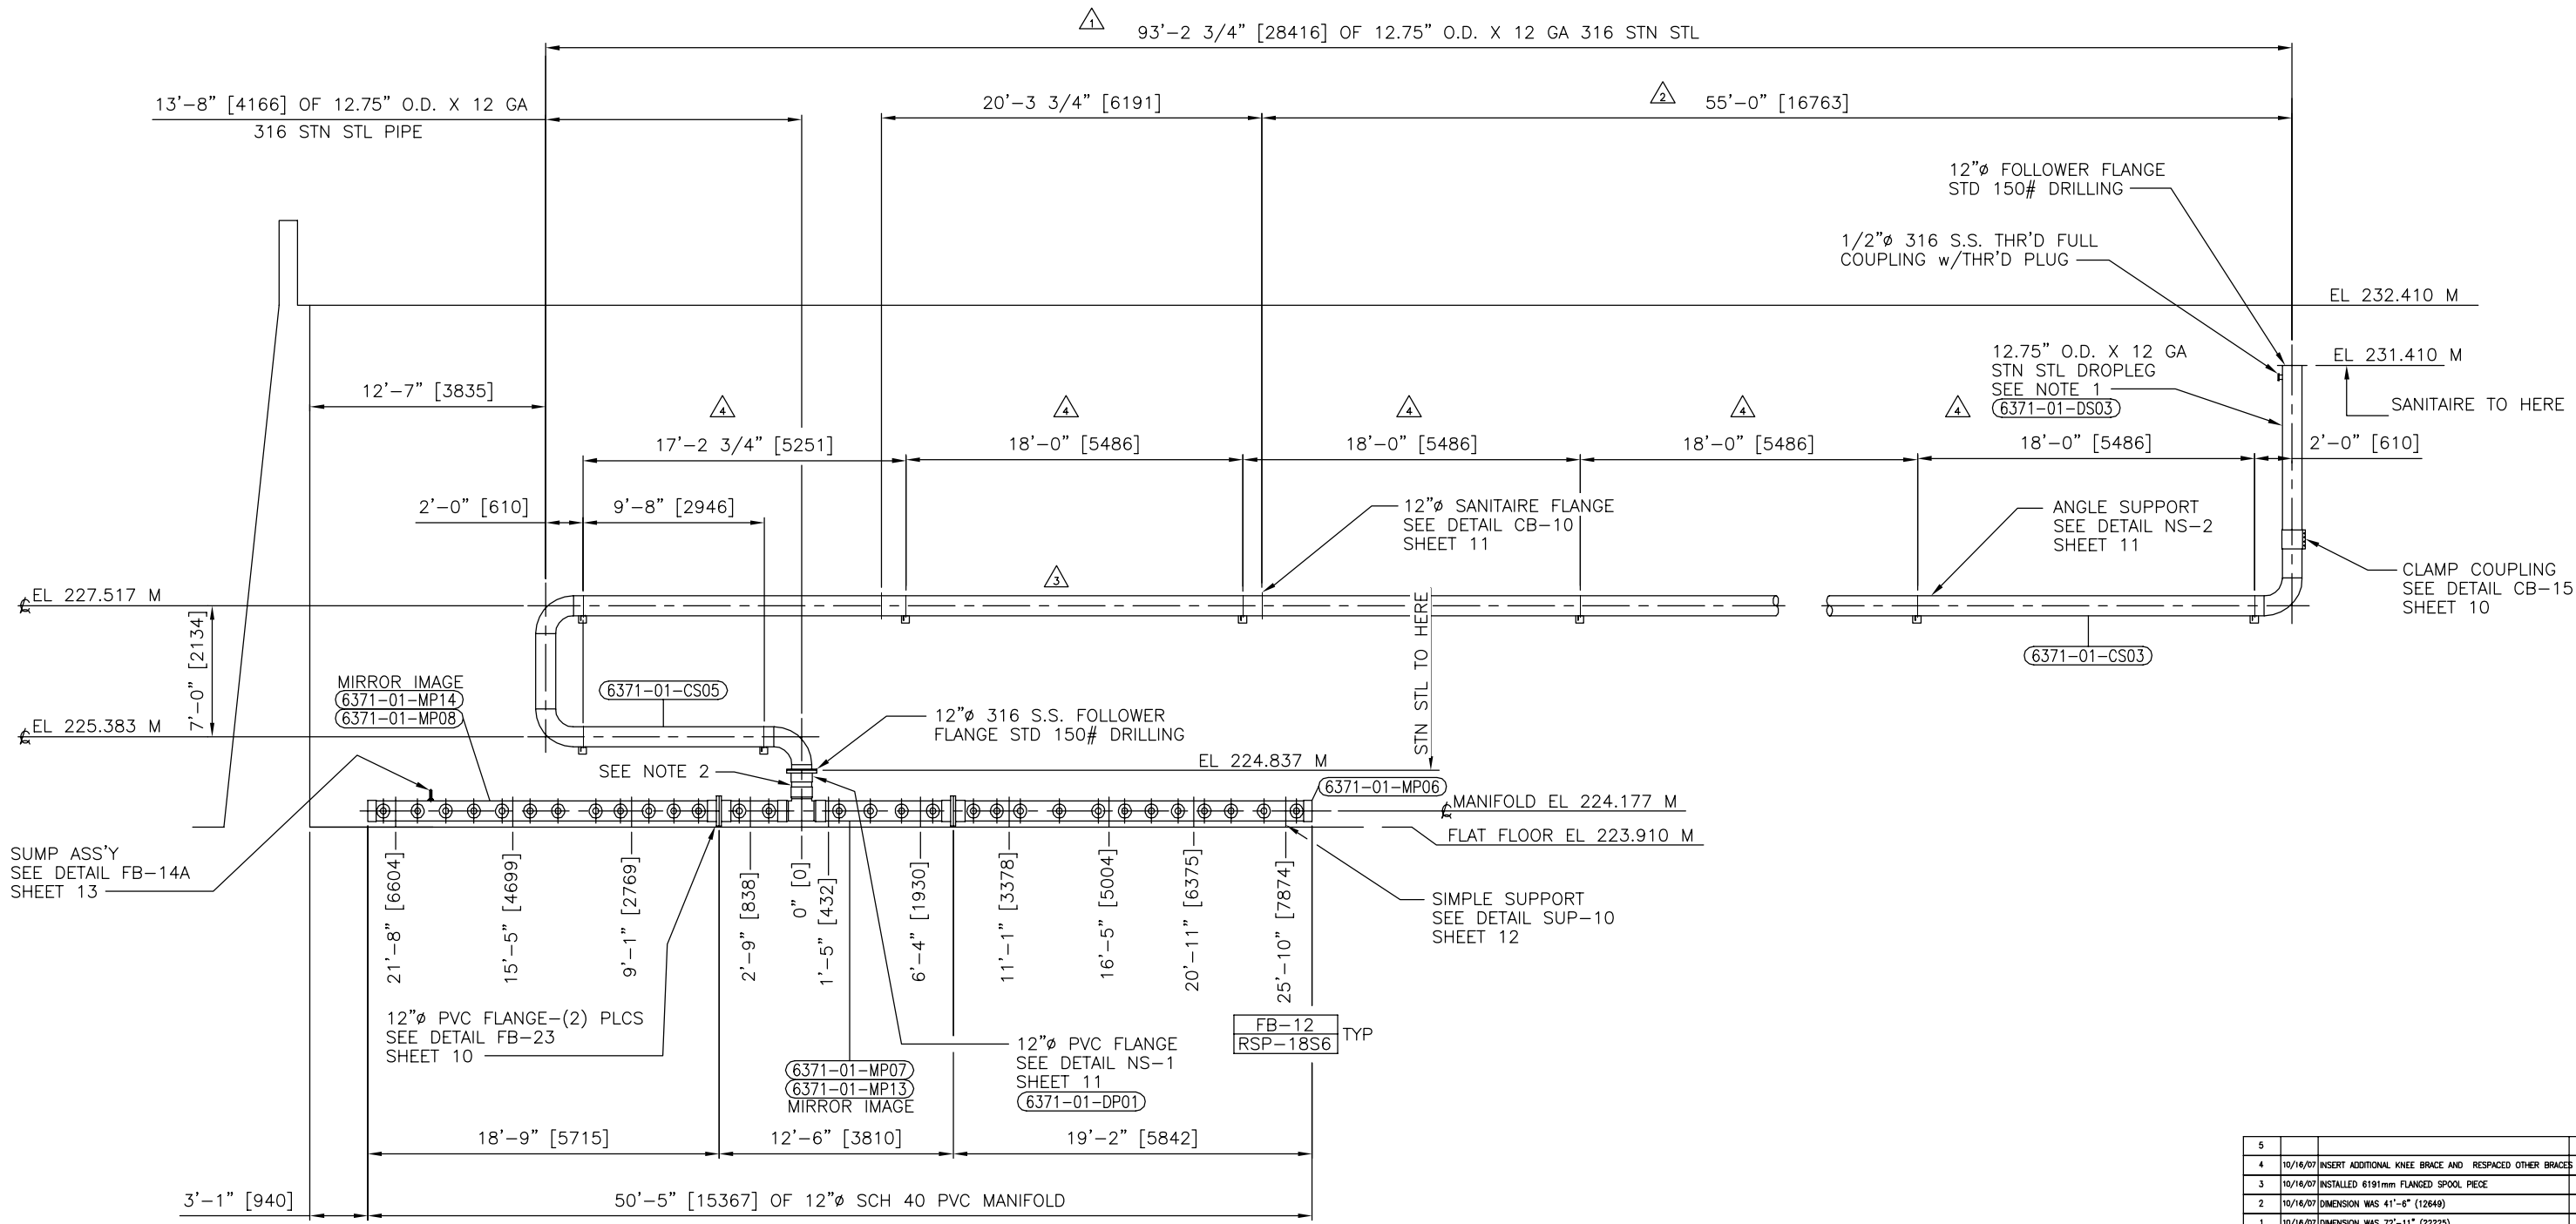

- NOTES:
- INSTALLATION OF THE DROPLEG REQUIRES A PROPERLY SUPPORTED AIR MAIN AND CONNECTION.
 - PVC PIPE WILL BE SHIPPED TO JOBSITE 6" LONGER THAN REQUIRED, TO ACCOUNT FOR TANK VARIANCES. CONTRACTOR TO CUT TO SUIT AND SOLVENT WELD INTO MANIFOLD AS REQ'D IN THE FIELD.
 - FB-12 RSP-18S6 REFERS TO THE MANIFOLD SUPPORT SIZE AND CORRESPONDS TO THE TABLE SHOWN WITH THE SUPPORT DETAIL. INDICATES THE SUPPORT STAND PART NUMBER.

DROPLEG/COOLING LOOP/MANIFOLD
 SBR BASIN 1 AS SHOWN
 SBR BASIN 2 MIRROR IMAGE
 SECTION 40

5			
4	10/16/07	INSERT ADDITIONAL KNEE BRACE AND RESPACED OTHER BRACES	AM
3	10/16/07	INSTALLED 6191mm FLANGED SPOOL PIECE	AM
2	10/16/07	DIMENSION WAS 41'-6" (12649)	AM
1	10/16/07	DIMENSION WAS 72'-11" (22225)	AM
NO.	DATE	REVISION	BY


WINNIPEG, MB
 NORTH END WPCC

THIS DRAWING IS THE PROPERTY OF SANITAIRE AND IS SUBMITTED IN CONFIDENCE. IT IS NOT TO BE DISCLOSED, USED OR DUPLICATED WITHOUT PERMISSION OF SANITAIRE.


SBR BASINS 1 & 2
 GRID TYPE 1
 DROPLEG/COOLING LOOP/MANIFOLD SECTION

ITT
 ADVANCED WATER
 TREATMENT


DRWN BY	CK	DATE	11-27-06	EQUIP.	MEM	JOB	06-6371S	SHT.	9
CHKD BY	RH	DATE	11-29-06	STD.				OF	13
APPVD BY		DATE		SIZE	D	REV.	A		

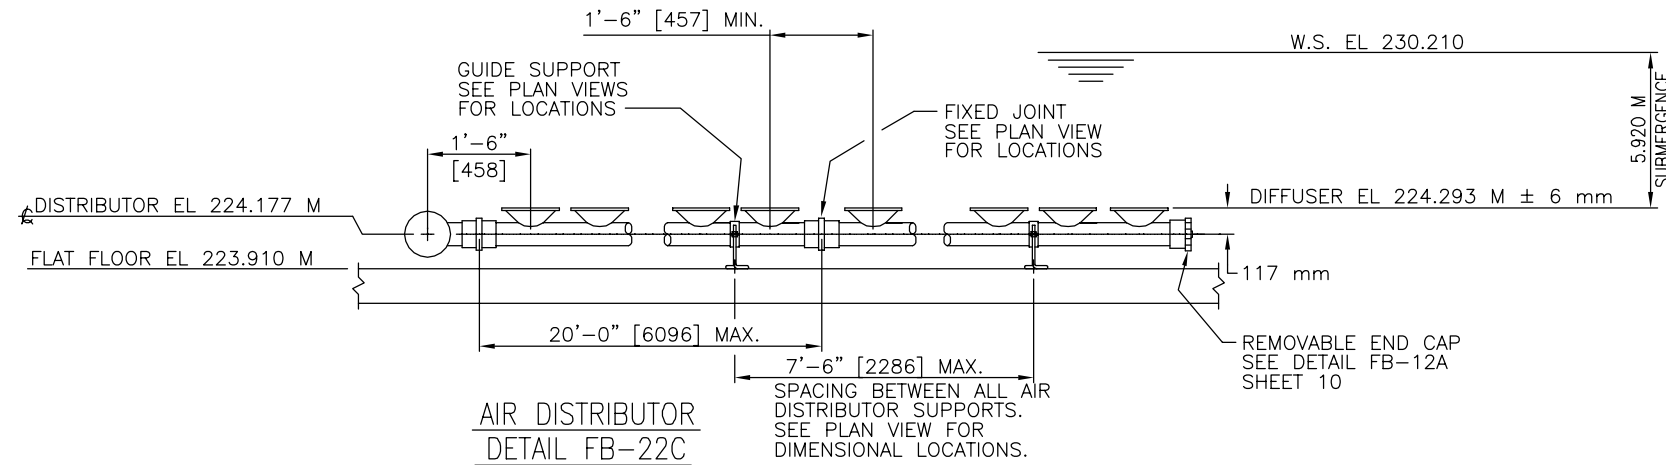

AIR DISTRIBUTOR
DETAIL FB-22C

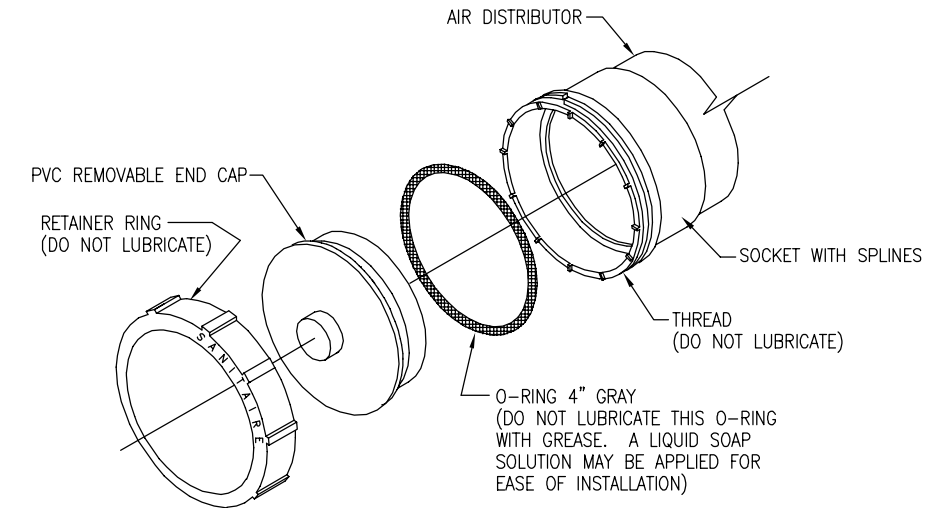


PVC REMOVABLE END CAP
DETAIL FB-12A

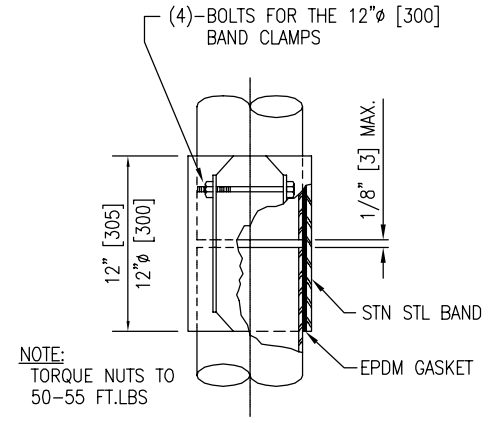

NOTE:
TORQUE NUTS TO
50-55 FT.LBS


CLAMP COUPLING
DETAIL CB-15

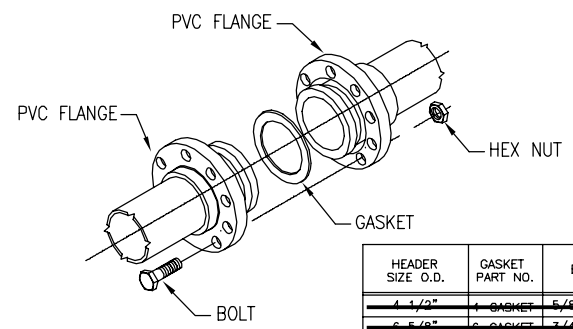


PVC FLANGE
DETAIL FB-23

HEADER SIZE O.D.	GASKET PART NO.	BOLT SIZE	QUAN. REQ'D PER FLANGE
4 1/2"	4-GASKET	5/8" X 1 1/2"	8
6 5/8"	6-GASKET	3/4" X 4"	8
8 5/8"	8-GASKET	3/4" X 1 1/2"	8
10 3/4"	10-GASKET	7/8" X 6"	12
12 3/4" [324]	12-GASKET	7/8" X 5"	12


NOTE:
ALL HARDWARE TO BE
316 STN STL

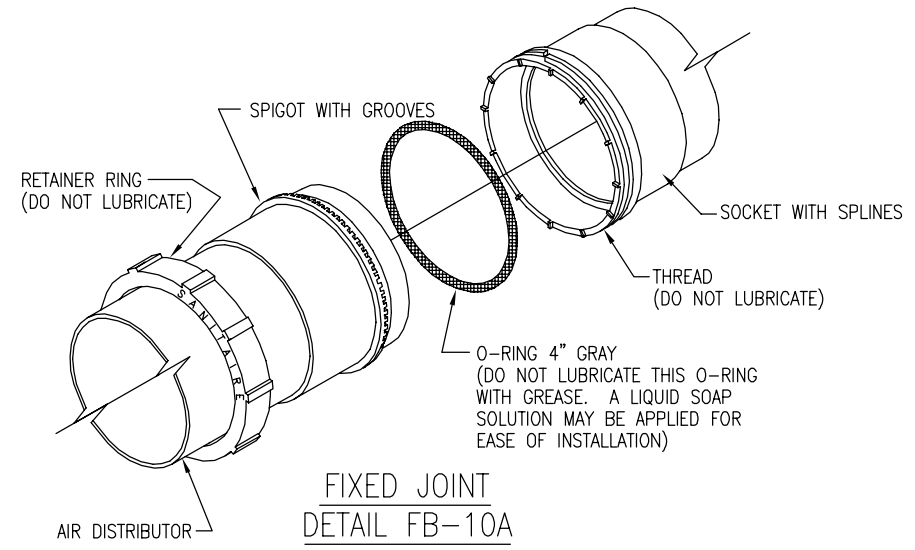

FIXED JOINT
DETAIL FB-10A

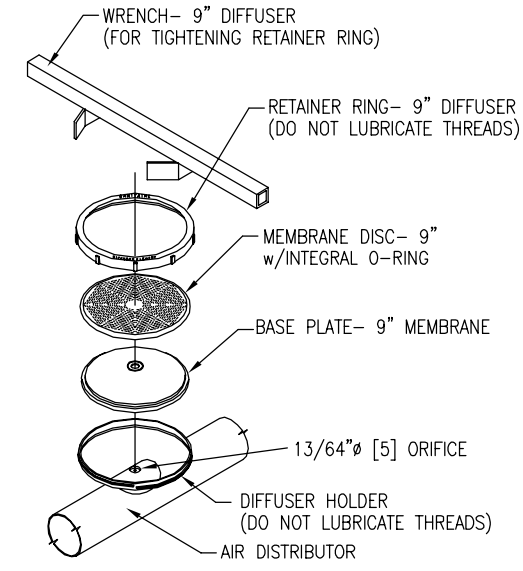


APPLY A VERY LIGHT COATING OF SILICONE BASED GREASE (SUPPLIED BY SANITAIRE) TO THE UNDERSIDE OF THE TOP SEALING SURFACE OF THE RETAINING RING.

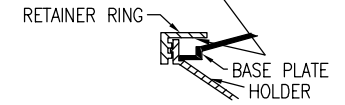

LUBRICATION DETAIL


9"Ø EPDM DIFFUSER ASSEMBLY
DETAIL FB-3

4			
3			
2			
1			
NO.	DATE	REVISION	BY
WINNIPEG, MB NORTH END WPCC			
THIS DRAWING IS THE PROPERTY OF SANITAIRE AND IS SUBMITTED IN CONFIDENCE. IT IS NOT TO BE DISCLOSED, USED OR DUPLICATED WITHOUT PERMISSION OF SANITAIRE.			
TYPICAL DISTRIBUTOR DETAIL & DETAILS			
ITT ADVANCED WATER TREATMENT			
DRWN BY CK	DATE 11-27-06	EQUIP. MEM	JOB 06-6371S
CHWD BY RH	DATE 11-29-06	STD.	SH. 10
APPVD BY	DATE	SIZE D REV. A	OF 13
			DWG-E-10

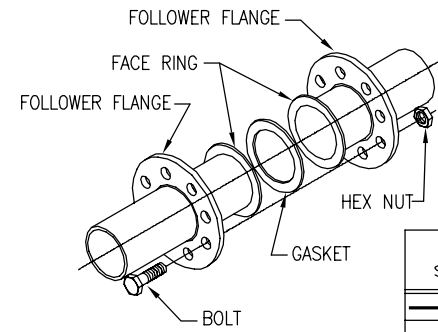


SANITAIRE FLANGE
DETAIL CB-10

HEADER SIZE O.D.	GASKET PART NO.	BOLT SIZE	QUAN REQ'D PER FLANGE
3 1/2"	2234-1	1/2"φ X 1 1/2"	4
4 1/2"	2234-2	1/2"φ X 1 1/2"	8
6 5/8"	2234-3	1/2"φ X 1 1/2"	8
8 5/8"	2234-4	1/2"φ X 1 1/2"	8
10 3/4"	2234-5	1/2"φ X 2"	12
12 3/4" [324]	2234-6	1/2"φ X 2"	12

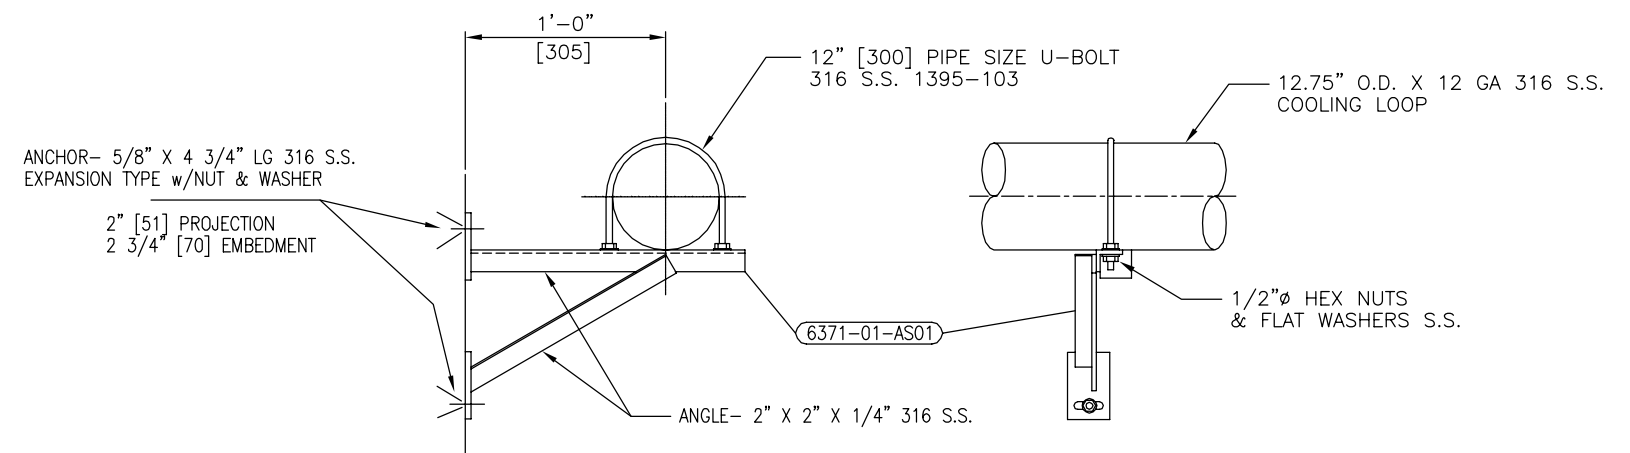


DROPLEG SUPPORT
DETAIL NS-2

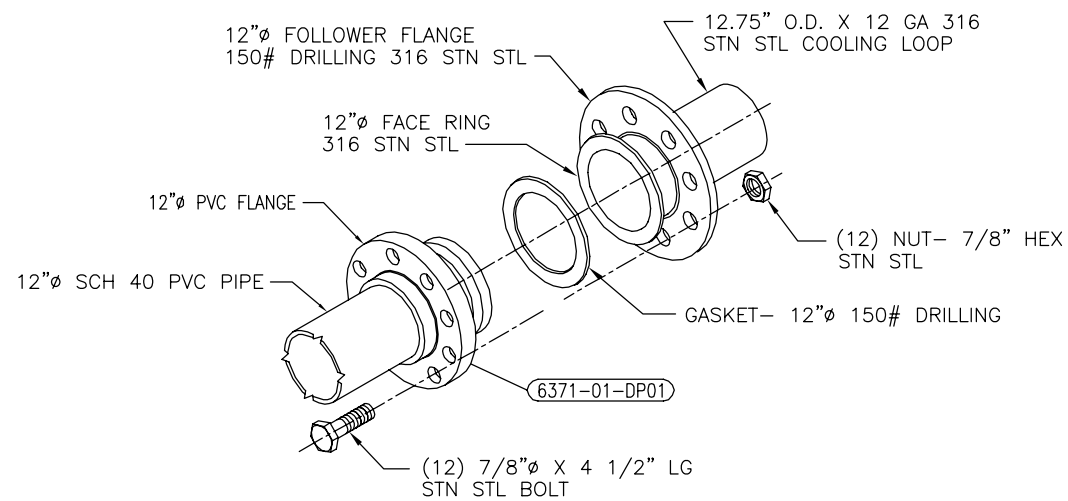

PVC TO STN STL FLANGE CONN
DETAIL NS-1

NOTE:
ALL HARDWARE TO BE
316 STN STL

4			
3			
2			
1			
NO.	DATE	REVISION	BY
WINNIPEG, MB NORTH END WPCC			
DETAILS			
ITT ADVANCED WATER TREATMENT			
DRWN BY	DATE 11-27-06	EQUIP. MEM	JOB 06-6371S
CHKD BY	DATE 11-29-06	STD.	11
APPRD BY	DATE	SIZE D REV. A	OF 13
			13

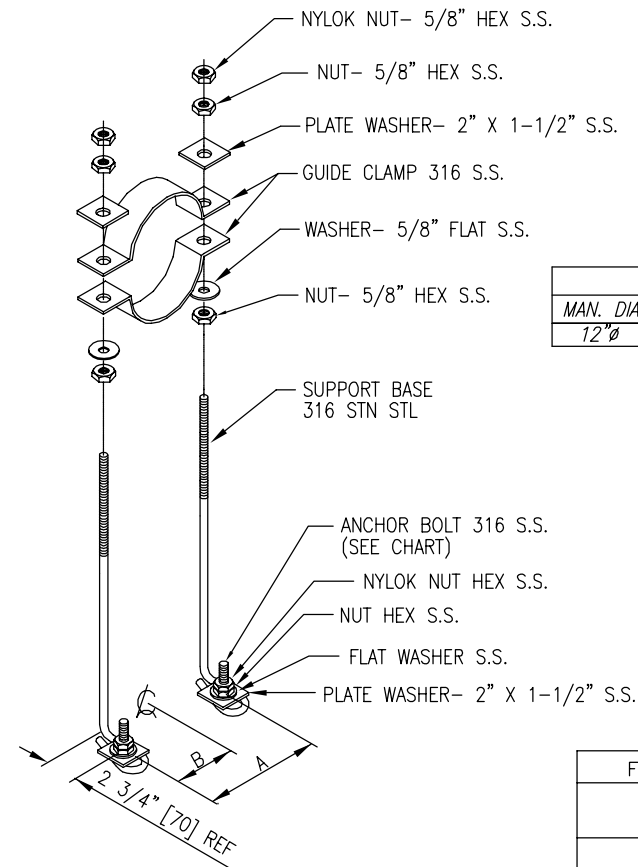


ANCHOR SPACING		
MAN. DIA.	A	B
12"Ø	14 7/8" [378]	7 7/16" [189]

MAN. IDENT	MAN. DIA.	SUPPORT BASE	GUIDE STRAP		PLATE WASHER	
			304	316	304	316
FB-4	4"	SEE DRAWINGS	CG1500-4	CG1500-6	2270-1W4	2270-1W6
FB-6	6"		CG6625-4	CG6625-6	2278-1W4	2278-1W6
FB-8	8"		CG8625-4	CG8625-6	2278-1W4	2278-1W6
FB-10	10"		CG1075-4	CG1075-6	2278-1W4	2278-1W6
FB-12	12" [300]		CG1275-4	CG1275-6	2278-1W4	2278-1W6

FINE BUBBLE AERATION SYSTEM ADHESIVE ANCHOR CHART			
MANIFOLD OR DROPLEG DIA.	ANCHOR BOLT	PROJECTION HOLD	EMBEDMENT
12"Ø (300)	5/8"Ø X 7 1/2"	2 1/2" (64)	5" (127)

NOTE:
ALL HARDWARE TO BE
316 STN STL



SIMPLE SUPPORT
DETAIL SUP-10

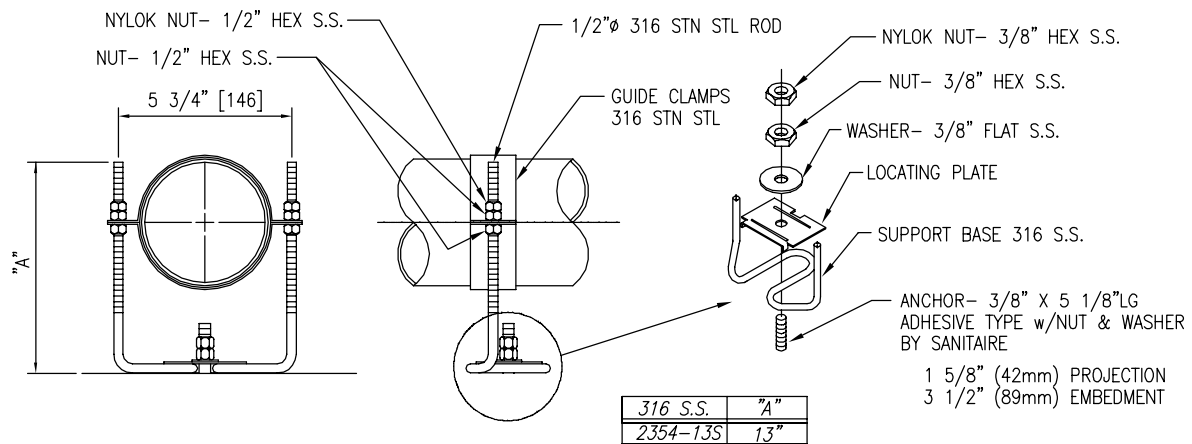

316 S.S.	"A"
2354-13S	13"

GUIDE SUPPORT
DETAIL SUP-2

4			
3			
2			
1			
NO.	DATE	REVISION	BY
WINNIPEG, MB NORTH END WPCC			
DETAILS			
 ITT ADVANCED WATER TREATMENT			
DRWN BY CK	DATE 11-27-06	EQUIP. MEM	JOB 06-6371S
CHWD BY RH	DATE 11-29-06	STD.	SHF 12
APPRD BY	DATE	SIZE D REV. A	DWG E-12
			OF 13

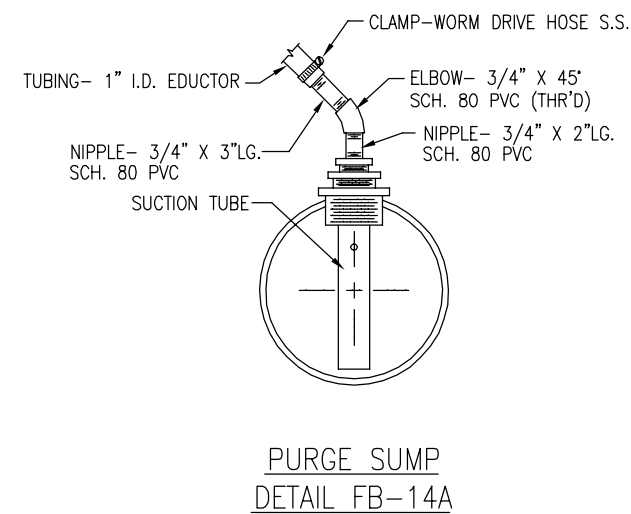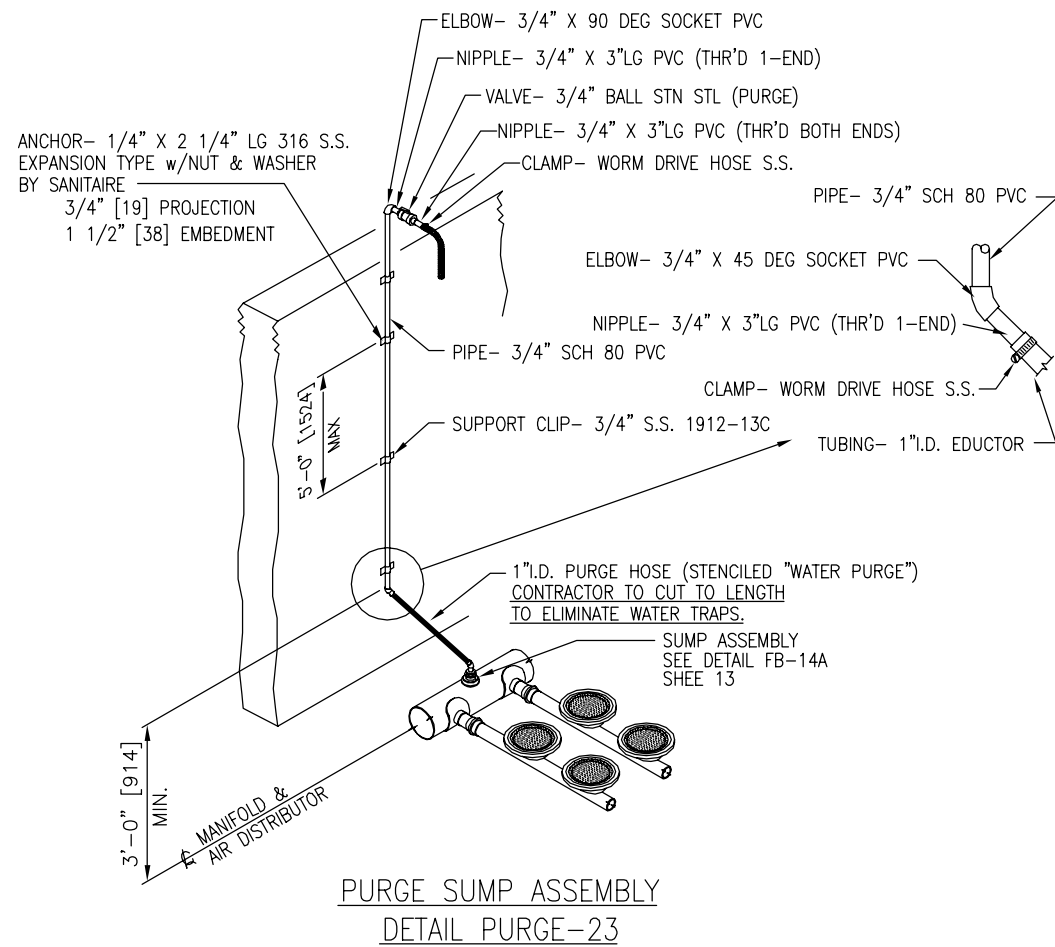

4			
3			
2			
1			
NO.	DATE	REVISION	BY
WINNIPEG, MB NORTH END WPCC			
<small>THIS DRAWING IS THE PROPERTY OF SANITAIRE AND IS SUBMITTED IN CONFIDENCE. IT IS NOT TO BE DISCLOSED, USED OR DUPLICATED WITHOUT PERMISSION OF SANITAIRE.</small>			
DETAILS			
 ITT ADVANCED WATER TREATMENT			
DRWN BY	CK	DATE 11-27-06	EQUIP. MEM
CHWD BY	RH	DATE 11-29-06	STD.
APPRD BY		DATE	SIZE D REV. A
			JOB 06-6371S
			SH. 13
			OF 13
			DWG-E-13