

PRIMARY CLARIFIER ELECTRICAL AND CONTROL ROOMS
1:30

**AIT-B696
Panel
PNL-6P**


NOTES:
1. THIS DRAWING IS BASED ON THE EXISTING LAYOUT OF THE ELECTRICAL ROOM.

CONSTRUCTION NOTES
1. REMOVE REGULATING TRANSFORMER FOR PNL-6P AND ASSOCIATED WIRING. RE-FEED PNL-6P FROM UPS-G1.

AS-BUILT DRAWING
THIS DRAWING WAS PREPARED USING UNVERIFIED INFORMATION PROVIDED BY OTHERS AND THEREFORE NO WARRANTY OR CERTIFICATION IS PROVIDED.

LAST SAVE: 2012/05/18 - 12:54pm
PATH: M:\112577\0105\4ENG\47ELE\DD - General DWG\1-0102P-E0009-001-02.dwg

DRAWING NUMBER	REFERENCE DRAWINGS
----------------	--------------------

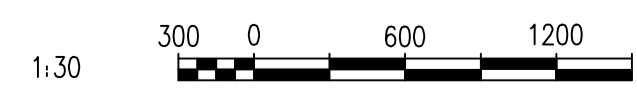

NO.	REVISIONS	DATE	DESIGN	CHECK
02	AS-BUILT, BID OPP. 209-2011	2012/05/01	TMC	
01	REMOVED XFMR-6P	2011/03/11	TMC	CJR
00	ISSUED FOR TENDER, BID OPP 837-2009	2009/12/07	NB	CJR

DESIGNED BY: EXISTING/N. BRADDO	CHECKED BY: C. REIMER
DRAWN BY: E. BOHNCKE	APPROVED BY: C. REIMER
SCALE: 1:30	RELEASED FOR CONSTRUCTION BY: J. VEILLEUX DATE: 2009/12/02
CONSULTANT NO.: 112577-0105-47DD-0301	

ENGINEER'S SEAL
ORIGINAL DRAWING
SEALED BY:
T. M. CHURCH
SNC-Lavalin
MEMBER #32682
2011/03/25
REV. 01
CHANGES ONLY

THE CITY OF WINNIPEG
WATER AND WASTE DEPARTMENT

SOUTH END WATER POLLUTION CONTROL CENTRE
ESSENTIAL SYSTEM UPGRADES
PLAN LAYOUT
PRIMARY CLARIFIER ELECTRICAL AND CONTROL ROOMS

CITY DRAWING NUMBER: 1-0102P-E0009
SHEET: 001
REV: 02
SIZE: A1