


AECOM
As of January 3, 2009, EarthTech became AECOM Canada Ltd.

AECOM AS-CONSTRUCTED
SIG..... DATE.....

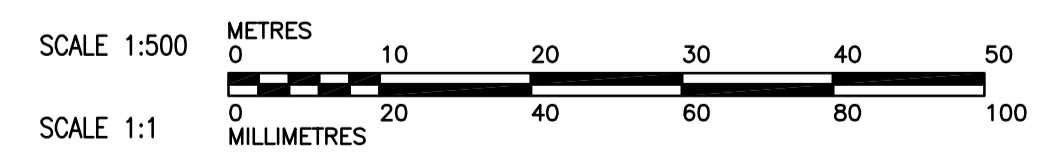

EXISTING	LEGEND - PLAN	PROPOSED	EXISTING	LEGEND - PLAN	PROPOSED	EXISTING	LEGEND - PLAN	PROPOSED
150 mm W.M.	WATERMAIN	150 mm W.M.	HYDRO	M.T.S.	LIGHT STANDARD	B.M. ELEV.		
300mm L.D.S.	LAND DRAINAGE SEWER	300mm L.D.S.	CONCRETE	ASPHALT	PROPERTY LINE			
250mm W.W.S.	WASTEWATER SEWER	250mm W.W.S.	SURVEY BAR	ELEVATION	TREE			
	MANHOLE		ANODE	CONCRETE SIDEWALK	FENCE			
	CATCH BASIN							
	CURB INLET							
	JUNCTIONS							
	CULVERT							
	GAS							

AECOM
Certificate of Authorization
AECOM Canada Ltd.
Original dated on: No. 4671 Date: 2006/03/07

NO.	REVISIONS	DATE	BY
02	AS CONSTRUCTED	08/09/11	GLG
01	ISSUED FOR CONSTRUCTION	06/06/06	JBC
00	ISSUED FOR TENDER	06/03/07	JBC

CH2M HILL
Frederickson Cooper ARCHITECTS

EarthTech

DESIGNED BY: SM
DRAWN BY: JBC
SCALE: 1:500

CHECKED BY: SRB
APPROVED BY: DJT
RELEASED FOR CONSTRUCTION BY: R. SOROKOWSKI

DATE: 2006/01/02
DATE: 06/03/07

ENGINEER'S SEAL
ORIGINAL SIGNED BY: S.R. BILEVICIUS
2006/03/07
CONSULTANT DRAWING NO. WL-C0103

THE CITY OF WINNIPEG
WATER AND WASTE DEPARTMENT
ENGINEERING DIVISION

WATER TREATMENT PLANT
CONSTRUCTION OF DEWATERING CELLS

CIVIL
CELL 3 PLAN VIEW

CITY FILE NUMBER
SHEET OF
CITY DRAWING NUMBER
1-0601L-C0009-001-02