

- CONSTRUCTION NOTES:**
1. ALL WORK AND MATERIALS TO BE IN ACCORDANCE WITH LATEST REVISION OF THE CITY OF WINNIPEG STANDARD CONSTRUCTION SPECIFICATIONS.
 2. LEGAL PLAN AND UNDERGROUND INFORMATION FROM CITY OF WINNIPEG LBIS. CONTRACTOR TO VERIFY ALL UNDERGROUNDS IN THE FIELD.
 3. CONTRACTOR TO TAKE PRECAUTIONARY STEPS TO AVOID DAMAGE FROM CONSTRUCTION ACTIVITIES TO TREES WITHIN THE LIMITS OF CONSTRUCTION.
 4. LOCATION OF EXISTING UTILITIES/SERVICES TO BE CONFIRMED IN THE FIELD BY THE CONTRACTOR.
 5. ADJUST EXISTING WATER VALVES AND WATER SERVICE CURB STOPS TO GRADE.
 6. ADJUST MANHOLE AND CATCH BASIN RIMS TO NEW GRADES.
 7. LAMP STANDARDS, HYDRO POLES AND ANCHORS THAT REQUIRE TEMPORARY SUPPORT, REMOVAL OR REPLACEMENT, TO BE DONE AT THE EXPENSE OF THE CONTRACTOR, AS NECESSARY.

ABBREVIATIONS:


CONC	CONCRETE ROADWAY
ASP	ASPHALT ROADWAY
ASP OVLY	ASPHALT OVERLAY ROADWAY
PVS	PAVING STONE/BRICK
TYP	TYPICAL
EX	EXISTING
MH	MANHOLE
WV	WATER VALVE
EL	ELEVATION
CB	CATCH BASIN
CP	CATCH PIT
CI	CURB INLET
CL	CONTROL LINE

METRIC

WHOLE NUMBERS INDICATE MILLIMETRES
DECIMALIZED NUMBERS INDICATE METRES

WARNING

- IF POWER EQUIPMENT OR EXPLOSIVES ARE TO BE USED FOR EXCAVATION ON THIS PROJECT THE CONTRACTOR MUST:
1. NOTIFY THE GAS COMPANY OF THE PROPOSED LOCATION OF EXCAVATION.
 2. TAKE PRECAUTION TO AVOID DAMAGE TO GAS COMPANY INSTALLATIONS SEE PROVINCIAL REGULATION 210/72 FOR DETAILS.
 3. OBTAIN EXCAVATION PERMITS PRIOR TO CONSTRUCTION.

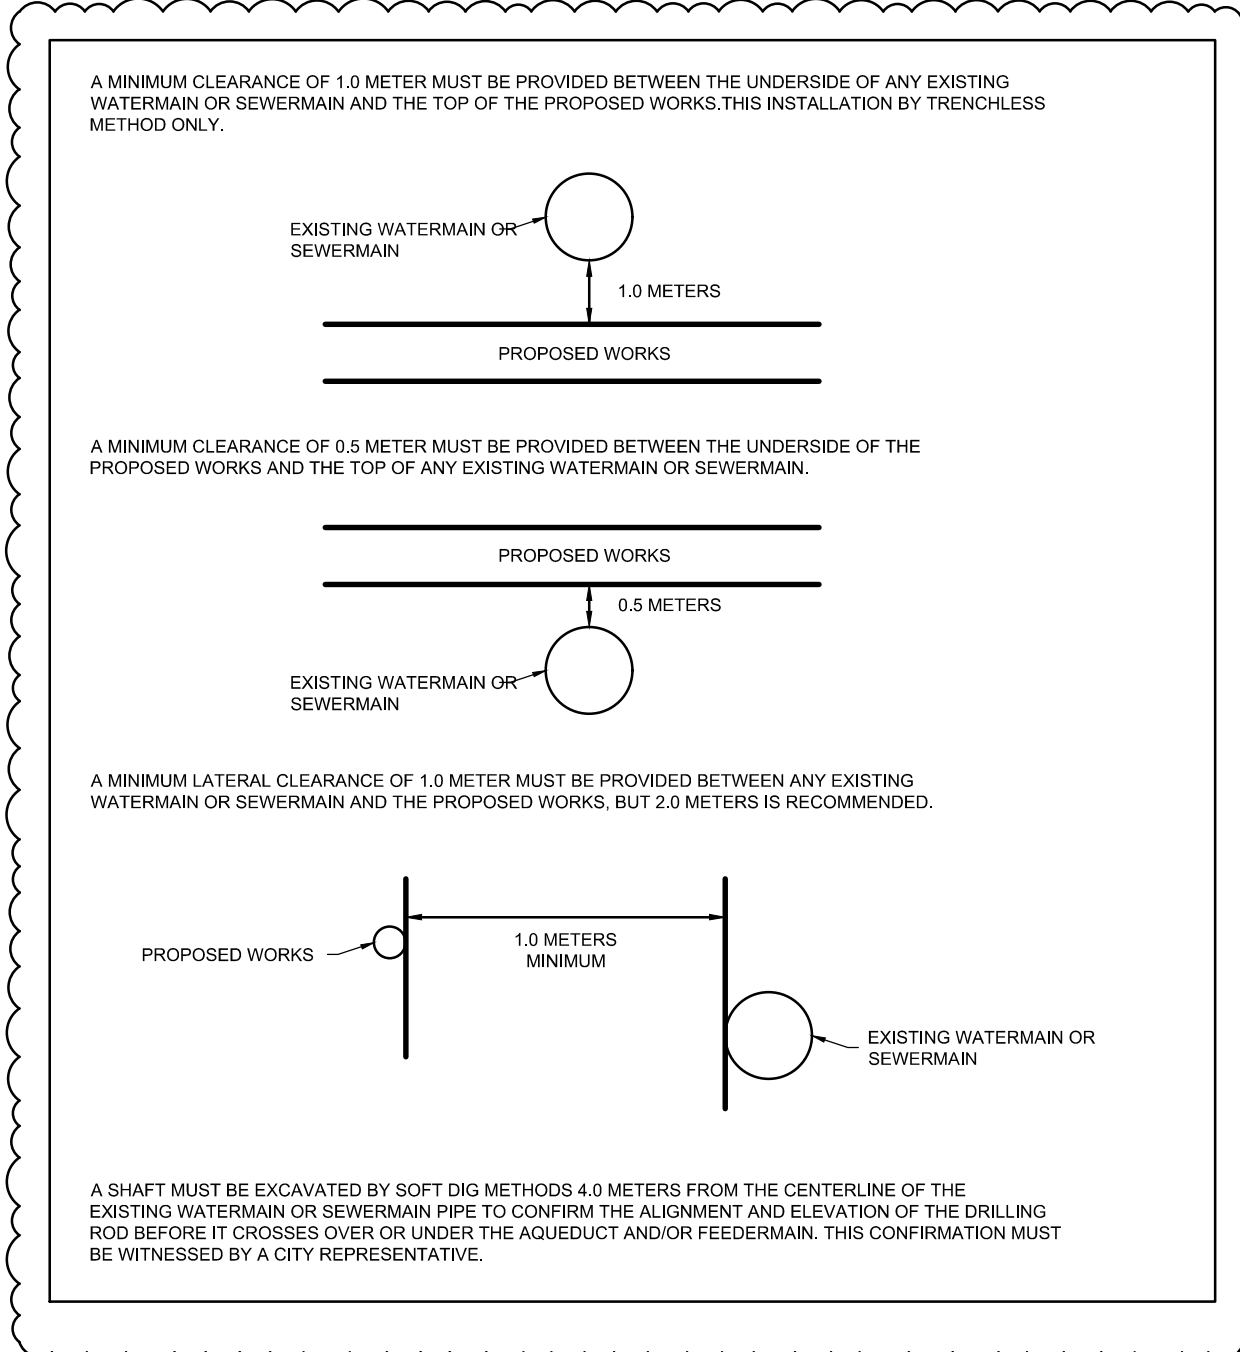

EXISTING	LEGEND-PLAN	PROPOSED	EXISTING	LEGEND-PLAN	PROPOSED	EXISTING	LEGEND-PROFILE	PROPOSED
HYDRANT			CONCRETE			CONTROL LINE		
VALVE			ASPHALT			PROPERTY LINE		
MANHOLE			ELEVATION					
CATCH BASIN			CURB RAMP					
CATCH PIT			DETECTABLE TILE					
150 WM			PROPERTY LINE					
300 LDS			SWALE					
250 WWS			TOP OF SLOPE					
HYDRO			GRASS/SOD					
MTS			PATHWAY LIGHTING					
100 GAS								

UNDERGROUND STRUCTURES	B.M. ELEV.
1	ISSUED FOR ADDENDUM 5
0	ISSUED FOR TENDER
NO.	REVISIONS

DESIGNED BY	BG	REVIEWED BY	JT
DRAWN BY	BG	APPROVED BY	JNC
SCALE:	H = 1:250	ACCEPTED BY	CAM WARD, P.ENG.
	V = 1:10	DATE	25.08.07
DATE	2025.08.07		

ORIGINAL DRAWING	REVISION "0" SEALED BY
J.N. CRANG	25.08.07
CONSULTANT DRAWING NO.	734-INF-MBI03007.01-DWG-C4257

THE CITY OF WINNIPEG	PUBLIC WORKS DEPARTMENT
LAGIMODIERE TWIN OVERPASSES	OVER CPKC KEEWATIN
REHABILITATION AND RELATED WORKS	
MULTI-USE PATH - PLAN-PROFILE	STA. 0+000 TO 0+130
REENDERS DR TO ALMEY AVE	
CITY DRAWING NUMBER	P123-25-4257
SHEET	57 OF 62
	4257