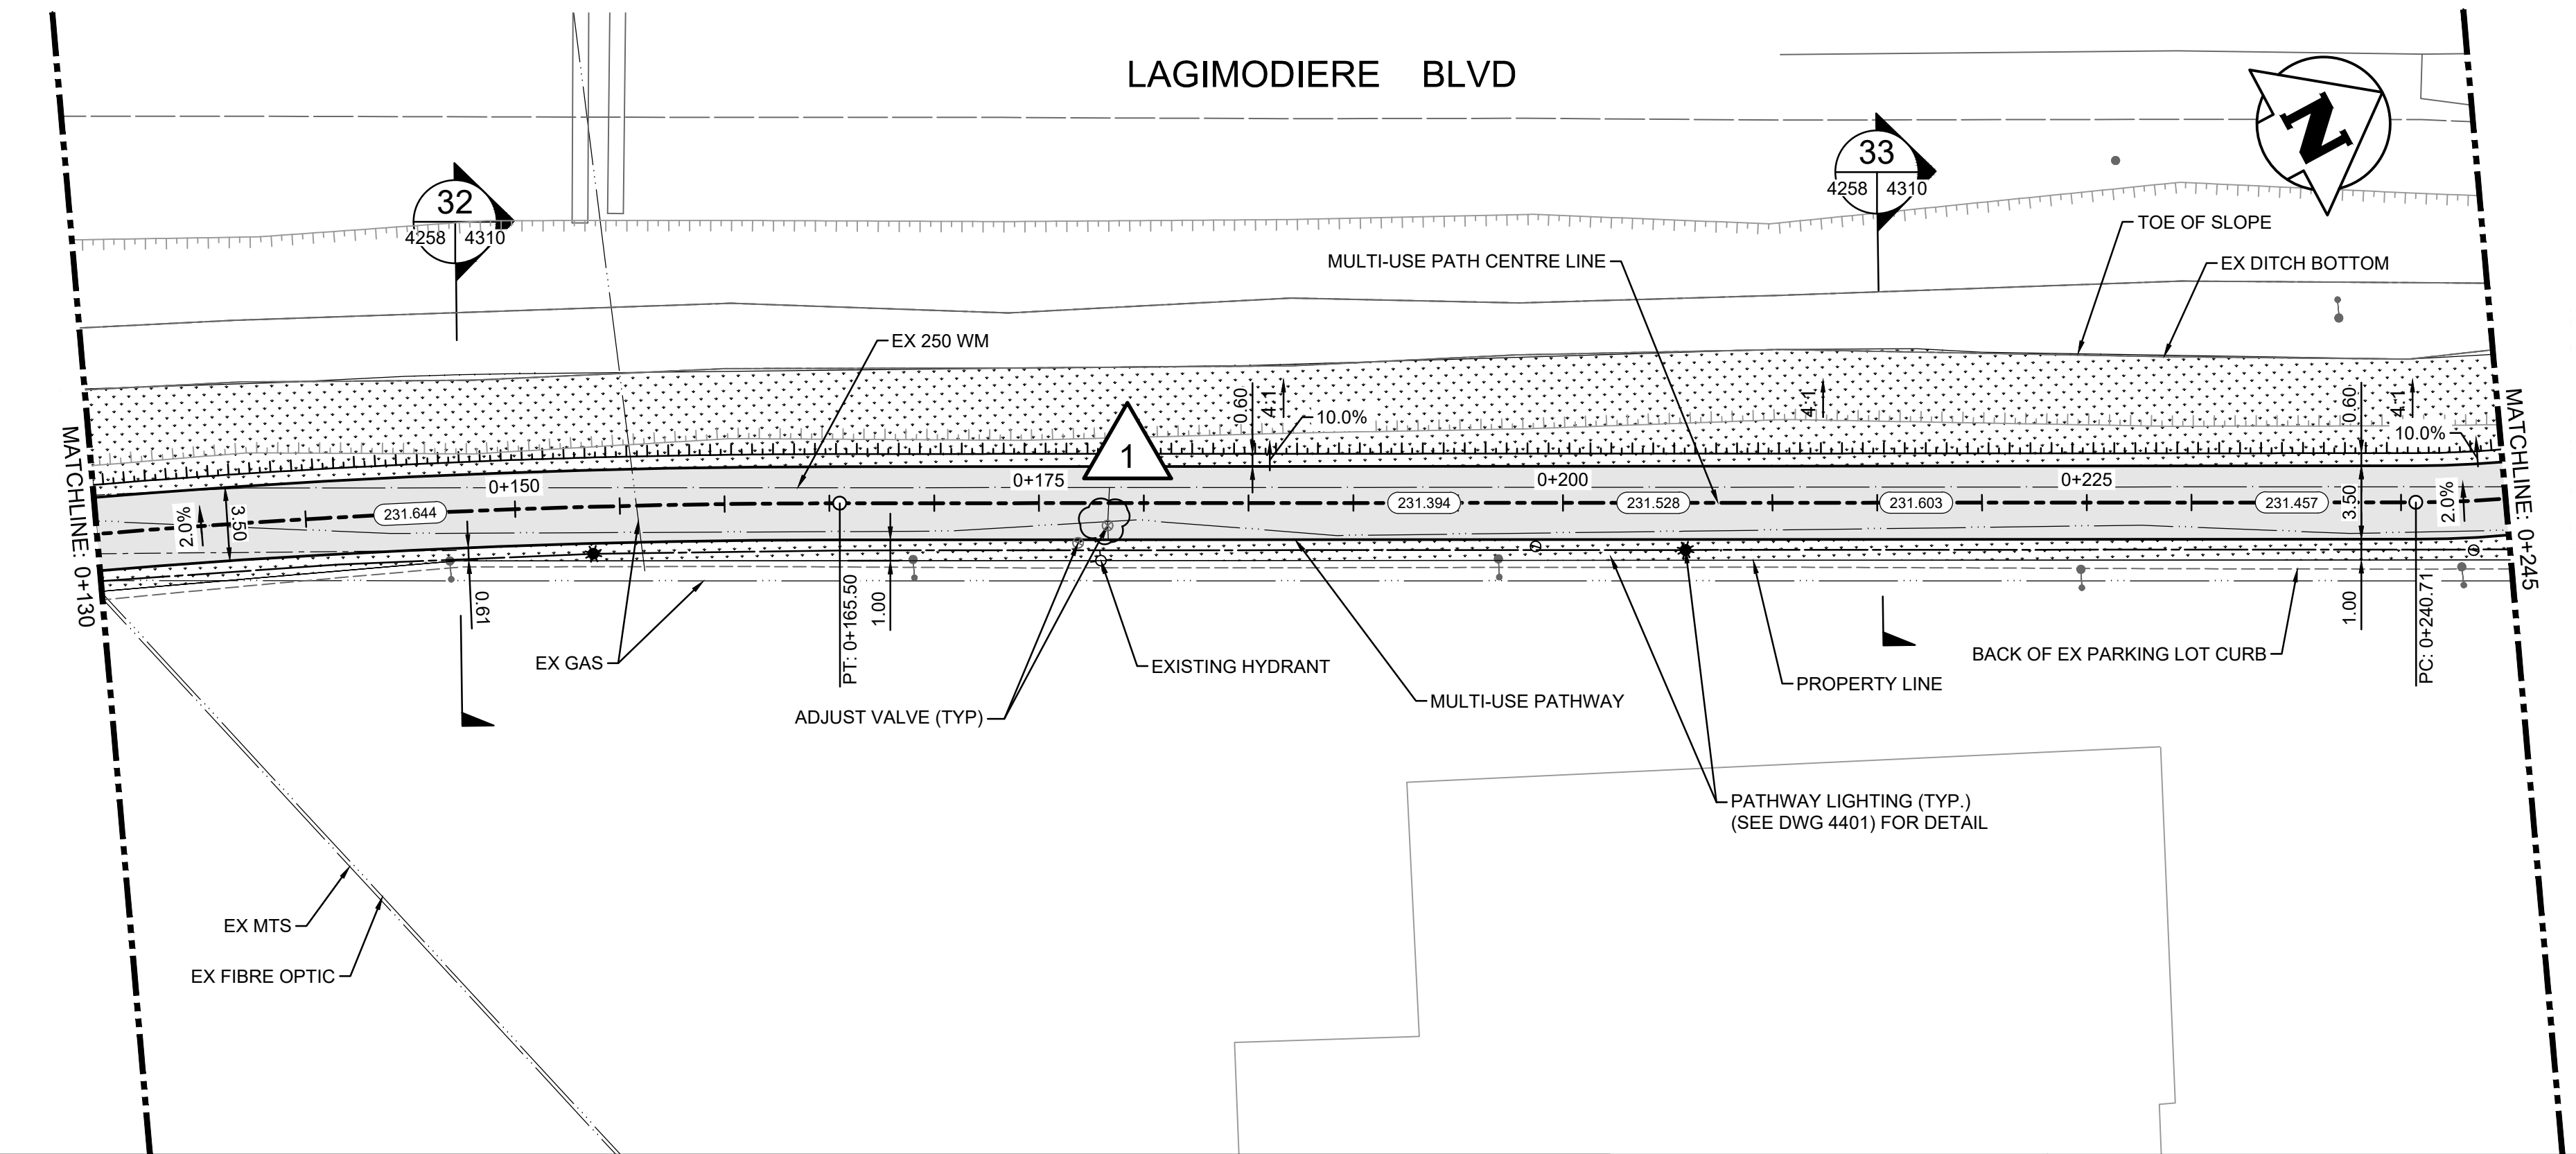




CONSTRUCTION NOTES:

1. ALL WORK AND MATERIALS TO BE IN ACCORDANCE WITH LATEST REVISION OF THE CITY OF WINNIPEG STANDARD CONSTRUCTION SPECIFICATIONS.
2. LEGAL PLAN AND UNDERGROUND INFORMATION FROM CITY OF WINNIPEG LBIS. CONTRACTOR TO VERIFY ALL UNDERGROUNDS IN THE FIELD.
3. CONTRACTOR TO TAKE PRECAUTIONARY STEPS TO AVOID DAMAGE FROM CONSTRUCTION ACTIVITIES TO TREES WITHIN THE LIMITS OF CONSTRUCTION.
4. LOCATION OF EXISTING UTILITIES/SERVICES TO BE CONFIRMED IN THE FIELD BY THE CONTRACTOR.
5. ADJUST EXISTING WATER VALVES AND WATER SERVICE CURB STOPS TO GRADE.
6. ADJUST MANHOLE AND CATCH BASIN RIMS TO NEW GRADES.
7. LAMP STANDARDS, HYDRO POLES AND ANCHORS THAT REQUIRE TEMPORARY SUPPORT, REMOVAL OR REPLACEMENT, TO BE DONE AT THE EXPENSE OF THE CONTRACTOR, AS NECESSARY.

ABBREVIATIONS:

|          |                         |
|----------|-------------------------|
| CONC     | CONCRETE ROADWAY        |
| ASP      | ASPHALT ROADWAY         |
| ASP OVLY | ASPHALT OVERLAY ROADWAY |
| PVS      | PAVING STONE/BRICK      |
| TYP      | TYPICAL                 |
| EX       | EXISTING                |
| MH       | MANHOLE                 |
| WV       | WATER VALVE             |
| EL       | ELEVATION               |
| CB       | CATCH BASIN             |
| CP       | CATCH PIT               |
| CI       | CURB INLET              |
| CL       | CONTROL LINE            |

## METRIC

WHOLE NUMBERS INDICATE MILLIMETRES  
DECIMALIZED NUMBERS INDICATE METRES

 
 
 
## WARNING

IF POWER EQUIPMENT OR EXPLOSIVES ARE TO BE USED FOR EXCAVATION ON THIS PROJECT THE CONTRACTOR MUST:

1. NOTIFY THE GAS COMPANY OF THE PROPOSED LOCATION OF EXCAVATION.
2. TAKE PRECAUTION TO AVOID DAMAGE TO GAS COMPANY INSTALLATIONS SEE PROVINCIAL REGULATION 210/72 FOR DETAILS.
3. OBTAIN EXCAVATION PERMITS PRIOR TO CONSTRUCTION.



Certificate of Authorization  
Tetra Tech Canada Inc.  
No. 6499

|                                                                                     |                     |                                                                                     |                                                                                     |                  |                                                                                     |                                                                                      |                |                                                                                       |
|-------------------------------------------------------------------------------------|---------------------|-------------------------------------------------------------------------------------|-------------------------------------------------------------------------------------|------------------|-------------------------------------------------------------------------------------|--------------------------------------------------------------------------------------|----------------|---------------------------------------------------------------------------------------|
|  | HYDRANT             |  |  | CONCRETE         |  |  | CONTROL LINE   |  |
|  | MANHOLE             |  |  | ELEVATION        |  |  | PROPERTY LINE  |                                                                                       |
|  | CATCH BASIN         |  |  | CURB RAMP        |  |                                                                                      |                |                                                                                       |
|  | CATCH PIT           |  |  | PROPERTY LINE    |  |                                                                                      |                |                                                                                       |
|  | WATERMAIN           |  |  | SEWER            |  |                                                                                      |                |                                                                                       |
|  | LAND DRAINAGE SEWER |  |  | HYDRO            |  |                                                                                      |                |                                                                                       |
|  | WASTE WATER SEWER   |  |  | TOP OF SLOPE     |  |                                                                                      |                |                                                                                       |
|  | HYDRO               |  |  | PATHWAY LIGHTING |  |                                                                                      |                |                                                                                       |
|  | M.T.S.              |  |  | M.T.S.           |  |                                                                                      |                |                                                                                       |
|  | 100 GAS             |  |  | 100 GAS          |  |                                                                                      |                |                                                                                       |
|  | EXISTING            |  |  | LEGEND-PLAN      |  |  | LEGEND-PROFILE |  |

## UNDERGROUND STRUCTURES

LOCATION OF UNDERGROUND STRUCTURES AS SHOWN ARE BASED ON THE BEST INFORMATION AVAILABLE, BUT NO GUARANTEE IS GIVEN THAT ALL EXISTING UTILITIES ARE SHOWN OR THAT THE GIVEN LOCATIONS ARE EXACT. CONFIRMATION OF EXISTENCE AND EXACT LOCATION OF ALL SERVICES MUST BE OBTAINED FROM THE INDIVIDUAL UTILITIES BEFORE PROCEEDING WITH CONSTRUCTION.

|       |                       |          |     |
|-------|-----------------------|----------|-----|
| B.M.  |                       |          |     |
| ELEV. |                       |          |     |
|       |                       |          |     |
|       |                       |          |     |
| 1     | ISSUED FOR ADDENDUM 5 | 25.09.22 | JNC |
|       | ISSUED FOR TENDER     | 25.08.07 | JNC |
| NO.   | REVISIONS             | DATE     | BY  |



# TETRA TECH

|             |                       |                           |      |
|-------------|-----------------------|---------------------------|------|
| DESIGNED BY | BG                    | REVIEWED BY               | JT   |
| DRAWN BY    | BG                    | APPROVED BY               | JNC  |
| SCALE:      | H = 1:250<br>V = 1:10 | ACCEPTED BY               | DATE |
| DATE        | 2025.08.07            | CAM WARD, P.ENG. 25.08.07 |      |

ORIGINAL DRAWING  
REVISION " 0 " SEALED BY  
J.N. CRANG  
25.08.07

CONSULTANT DRAWING NO.  
734-INF.MBI03007.01-DWG-C4258



**THE CITY OF WINNIPEG**  
**PUBLIC WORKS DEPARTMENT**

# LAGIMODIERE TWIN OVERPASSES OVER CPKC KEEWATIN REHABILITATION AND RELATED WORKS

MULTI-USE PATH - PLAN-PROFILE  
STA. 0+130 TO 0+245  
REENDERS DR TO ALMEY AVE

CITY DRAWING NUMBER

P123-25-4258

SHEET OF

|    |    |
|----|----|
| 58 | 62 |
|----|----|

4258