

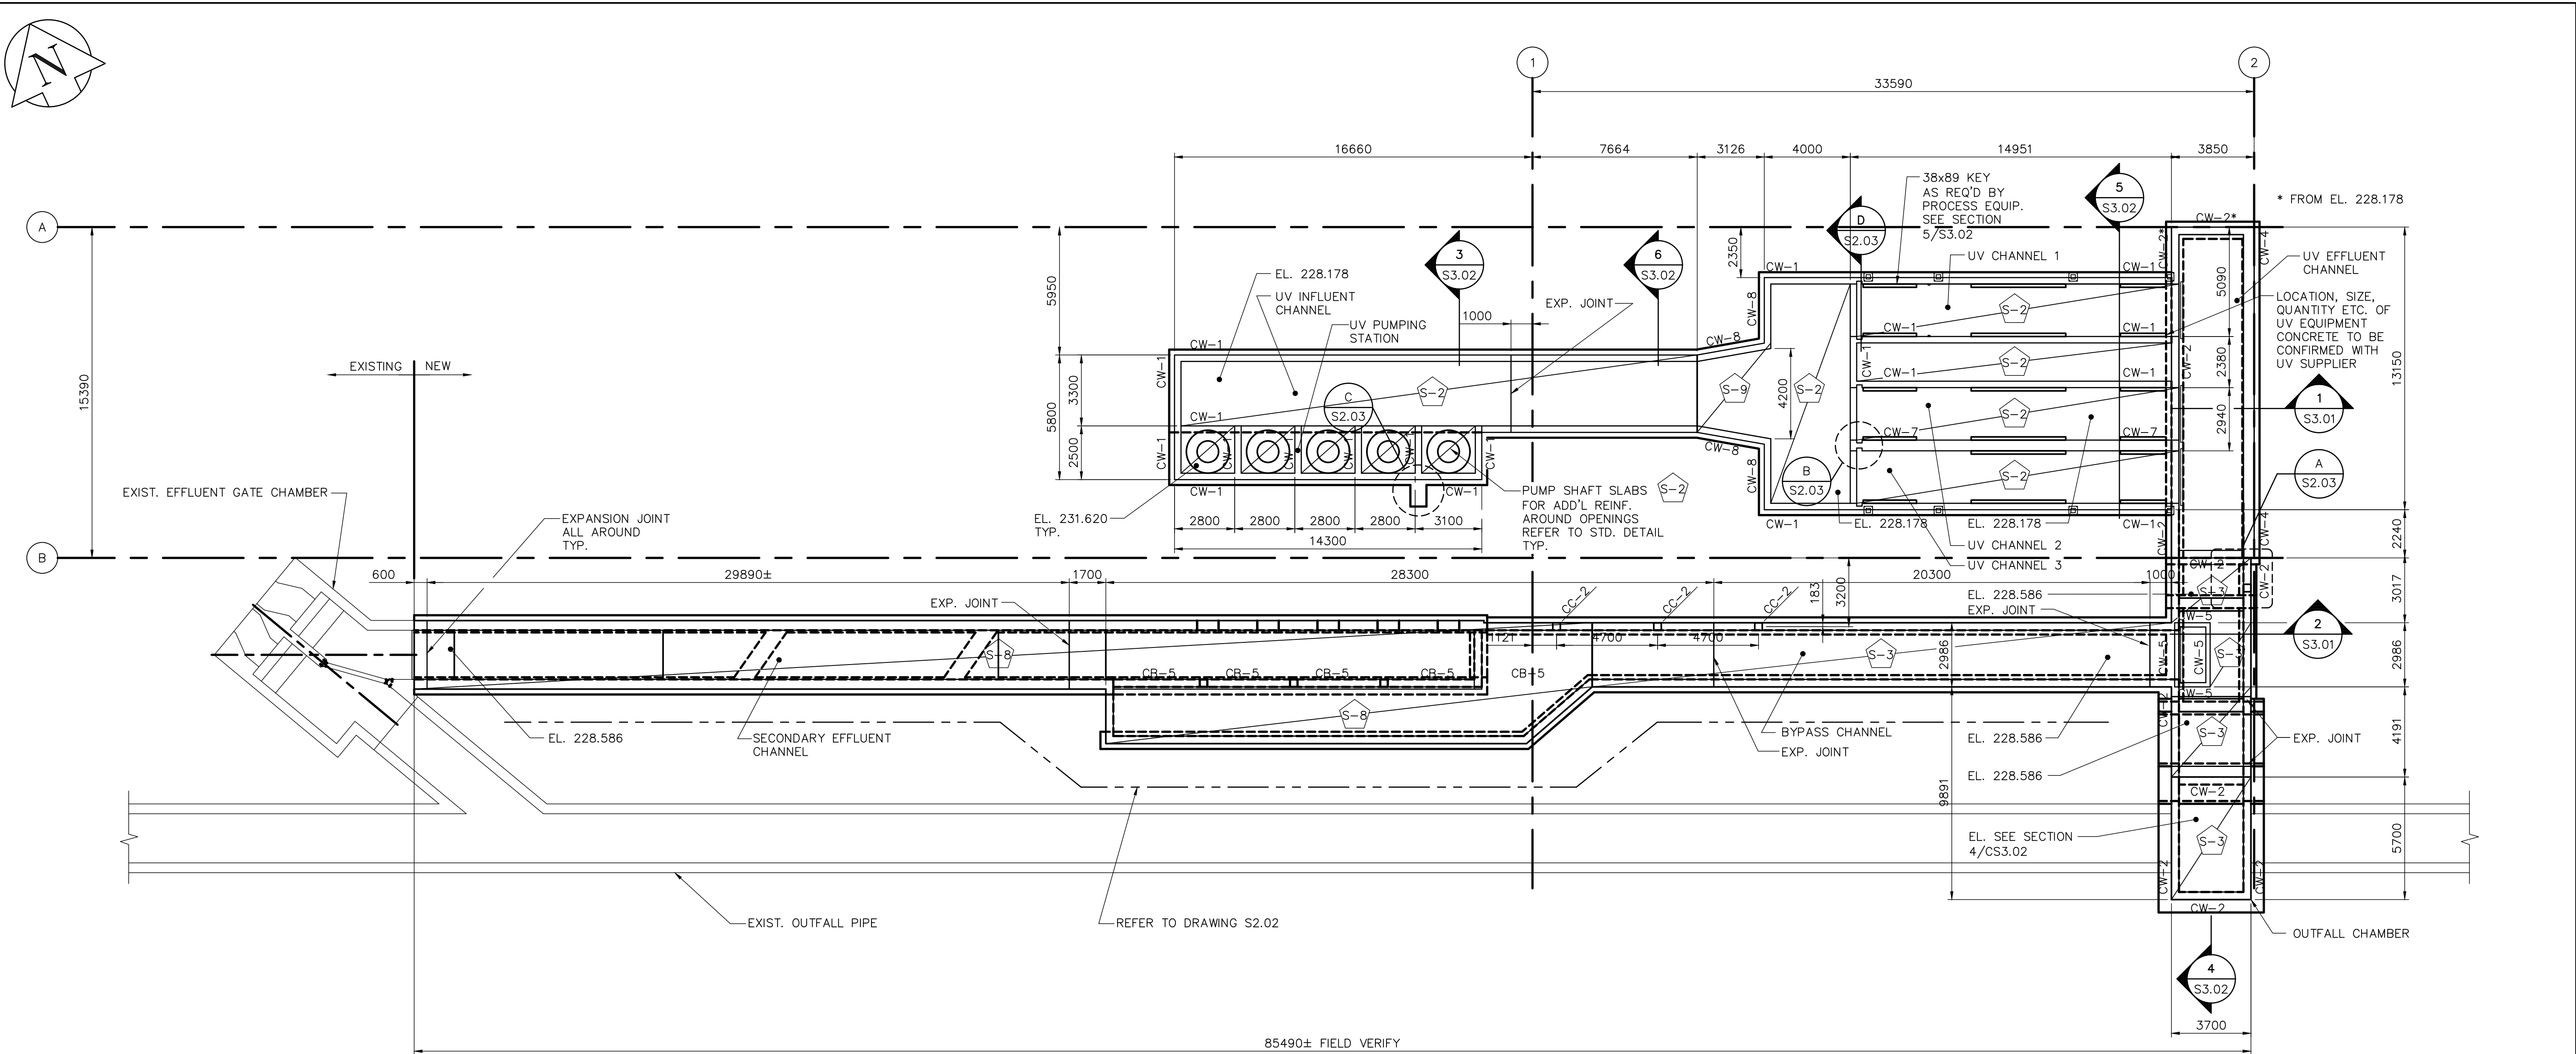




LAST SAVE: 2025/04/17 5:03 AM
PATH: C:\Bentley\Bentley\AEC\Drawings\City of Winnipeg - NEWPCC Upgrades\2025\Project Files\800 Design Collaboration\UV Upgrades\SS-Structural\CAD\1-0101U-S0004-001-300.dwg

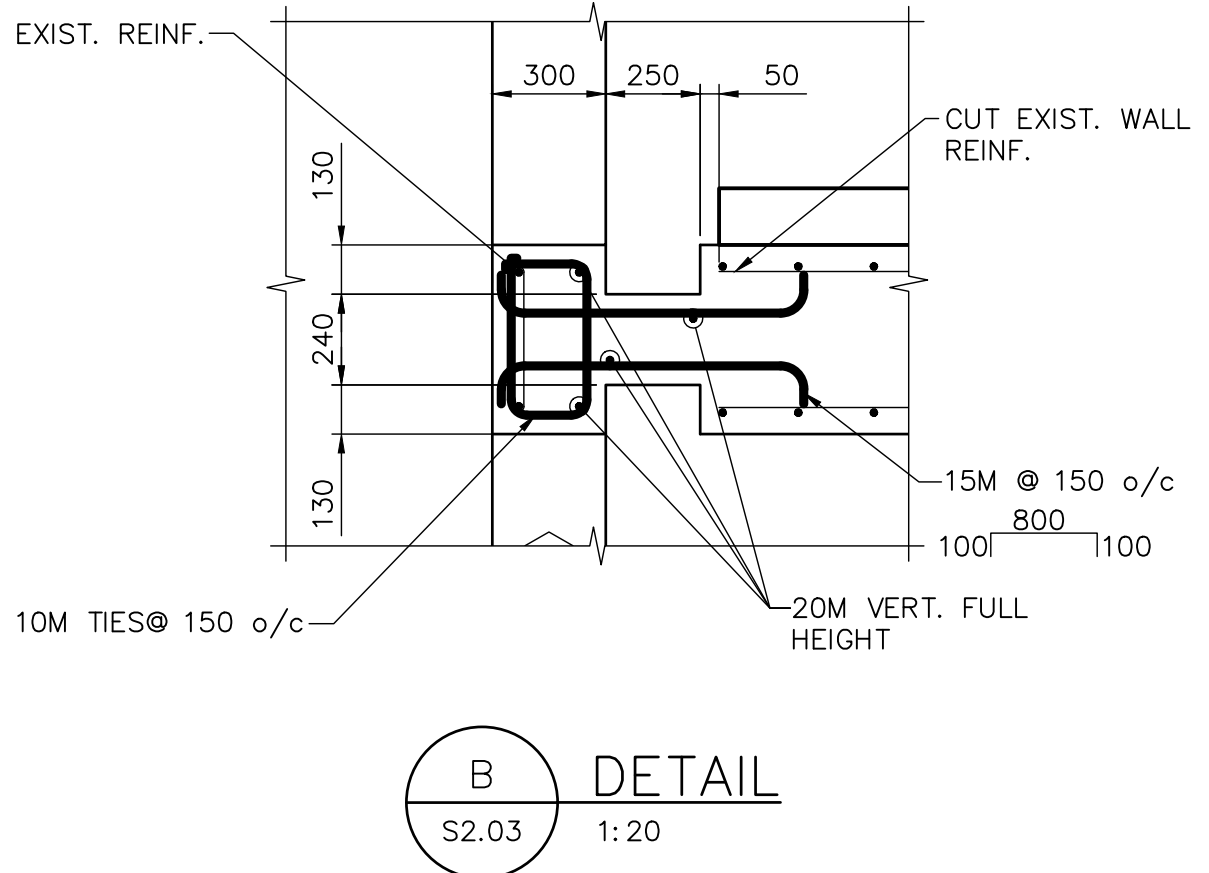

PLAN ABOVE ELEVATION 231.620
SCALE: 1:150

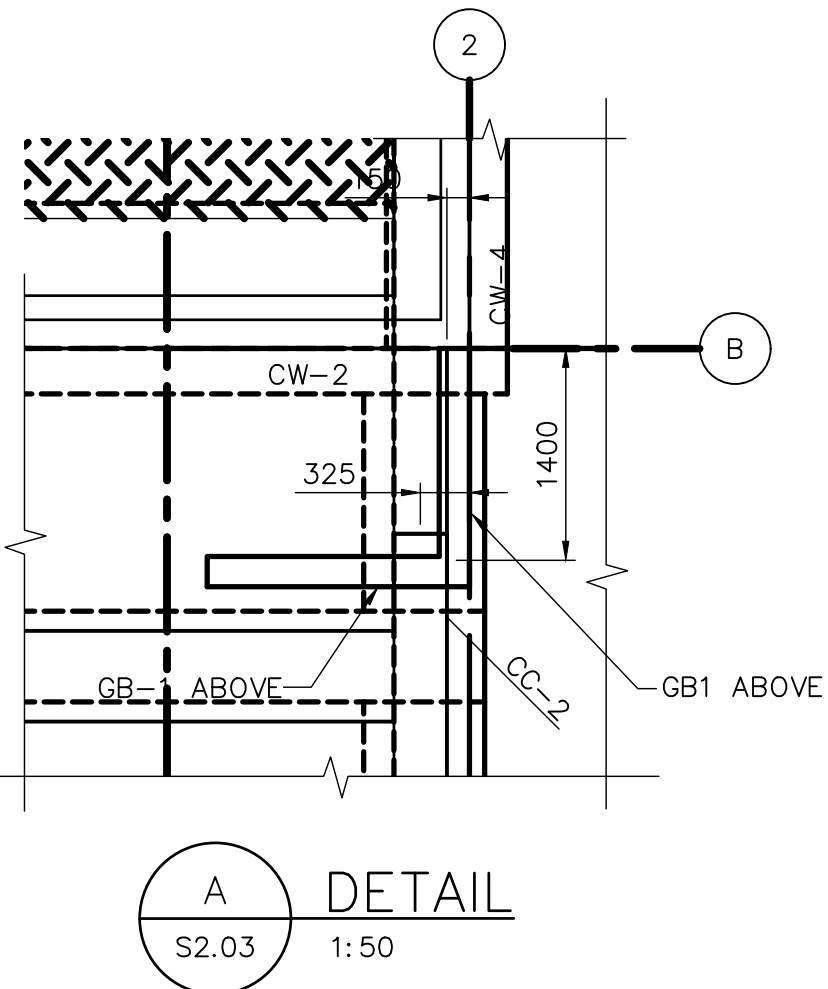

DETAIL IS FOR BOTH SINGLE AND DOUBLE BLOCK-OUTS.

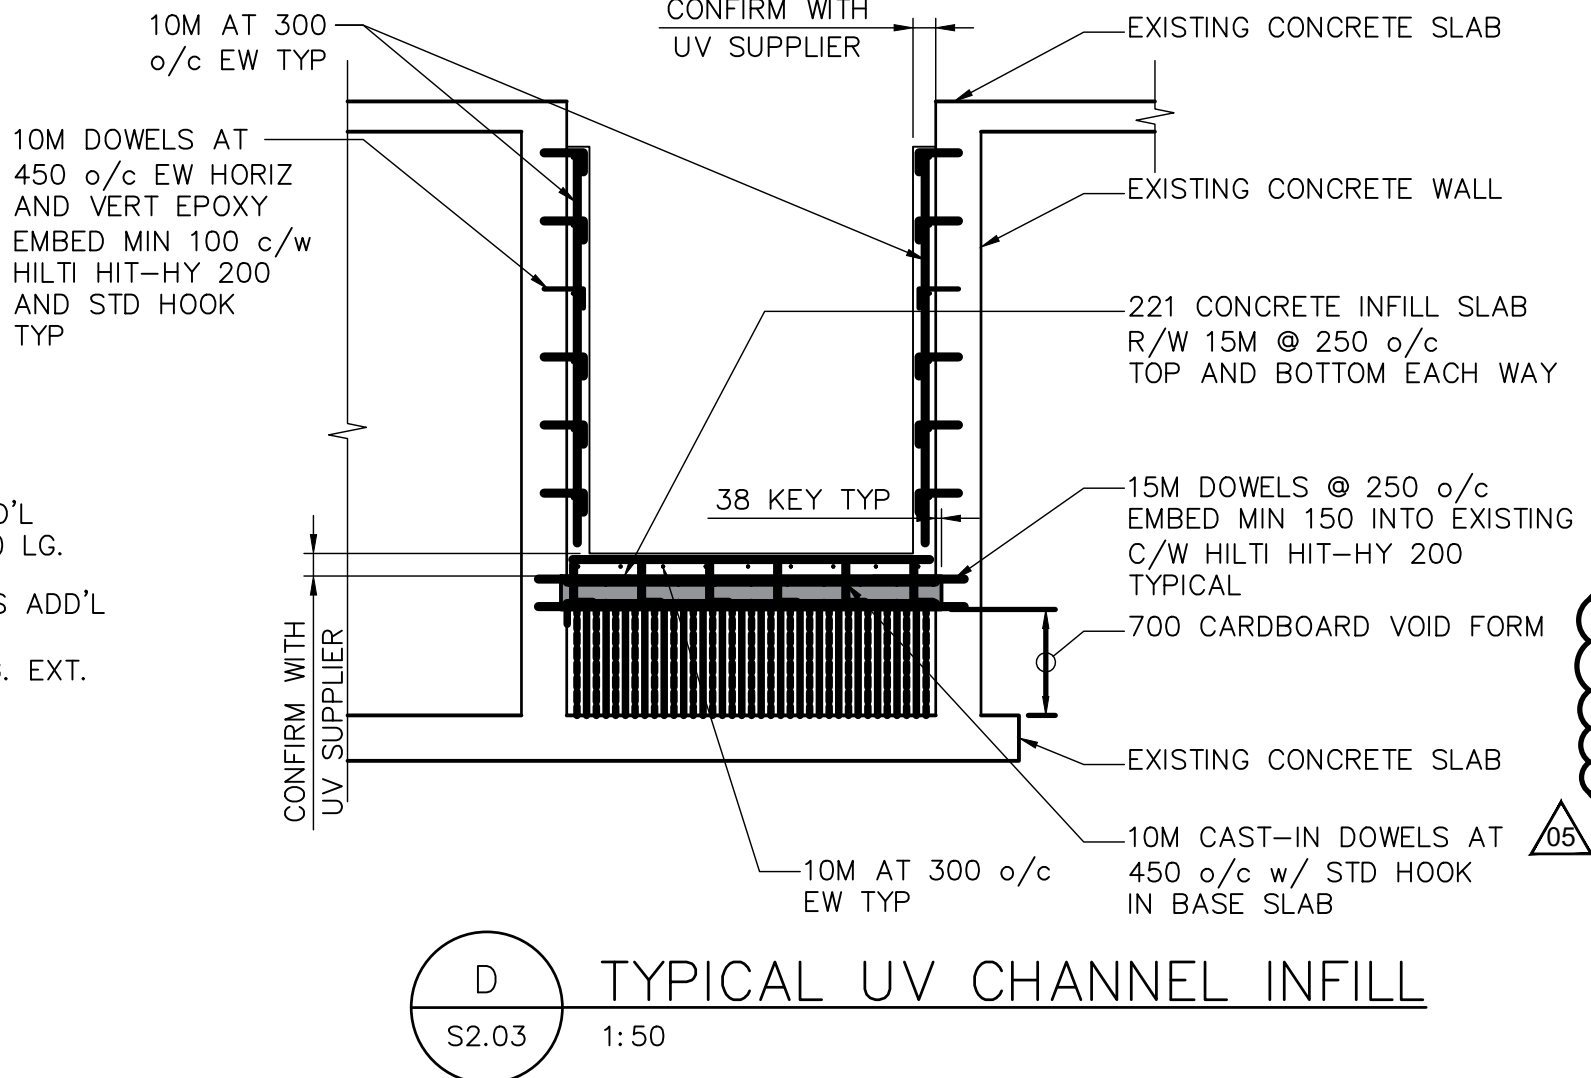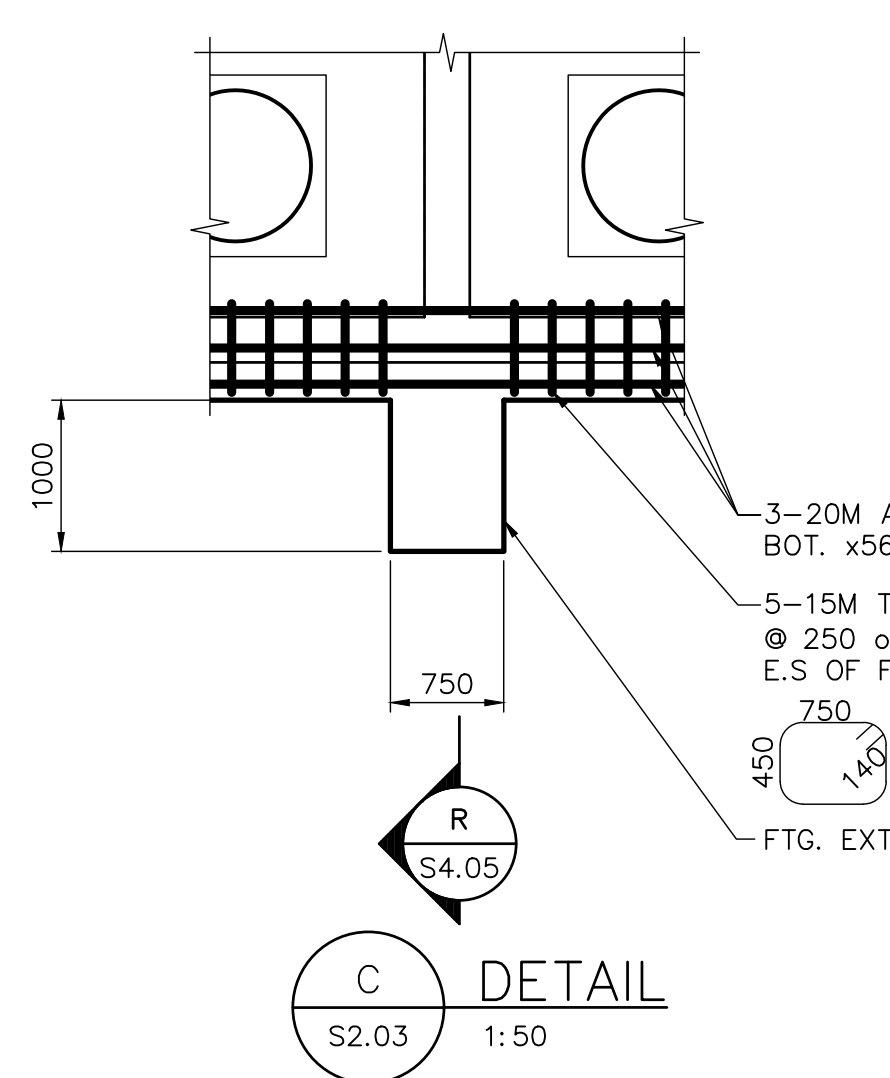

NOTES:

- CONTRACTOR TO SITE CONFIRM ALL DIMENSIONS PRIOR TO CONSTRUCTION AND/OR FABRICATION
- CONTRACTOR TO REMOVE EXISTING COATING FROM CONCRETE WITHIN CHANNEL PRIOR TO COMMENCING NEW CONCRETE WORKS

NOTES:

1. FOR GENERAL NOTES AND SCHEDULES REFER TO DRAWING S1.01.
2. FOR STANDARD DETAILS REFER TO DRAWINGS S4.01, S4.02, AND S4.03.

TENDER NO. 30-2025

NOTE: ALL NEW CONCRETE IN EXISTING CHANNELS TO BE 35 MPa STRENGTH A-1 EXPOSURE CLASS CONCRETE.

REVISION 04. CHANGES THE ENGINEER'S DESIGN RESPONSIBILITIES ARE LIMITED TO THE CHANGES INDICATED IN THE CLOUDED WORK			
DESIGNED BY:	CT	CHECKED BY:	MB
DRAWN BY:	MK	APPROVED BY:	NW
DATE:	2025-02-26	RELEASED FOR CONSTR. DATE:	



NO.	REVISIONS	DATE	DESIGN	CHECK
05	ISSUED FOR ADDENDUM 5	2025-04-17	CT	MB
04	ISSUED FOR TENDER	2025-02-26	CT	MB
03	AS CONSTRUCTED	07/03/14	GC	GGP
02	ISSUED FOR CONSTRUCTION	05/06/06	GLG	GGP
01	ISSUED FOR ADDENDUM 1	05/03/04	JEH	GGP
00	ISSUED FOR TENDER	05/02/18	JEH	GGP

DESIGNED BY: RE, MK		CHECKED BY: GGP	
DRAWN BY: C.T.		APPROVED BY: DT	
SCALE: AS NOTED		RELEASED FOR CONSTRUCTION BY:	
DATE: 2023-07-24		DATE:	
CONSULTANT NO.:		66303D-S2.03	

ENGINEER'S SEAL

AECOM

THE CITY OF WINNIPEG
WATER AND WASTE DEPARTMENT

NEWPCC - SECONDARY EFFLUENT
UV DISINFECTION FACILITY
STRUCTURAL
PLAN ABOVE ELEVATION 231.620

CITY DRAWING NUMBER
1-0101U-S0004-001-03

SHEET
4

REV.
05

SIZE
A1