


NOTE:

FOR INTERNAL WIRING,  
WIRE LABEL TO BE  
TB3 TERMINAL NUMBER  
(UNLESS SPECIFIED OTHERWISE)

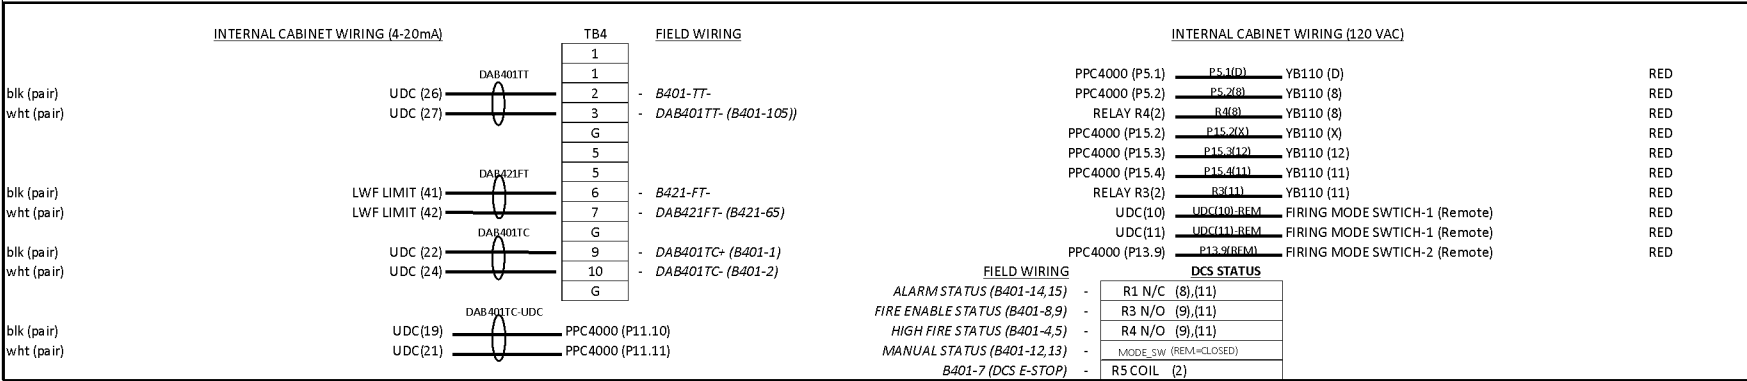

REVISION ## CHANGES	
THE ENGINEER'S DESIGN RESPONSIBILITIES ARE LIMITED TO THE CHANGES INDICATED IN THE CLOUDED WORK	
DESIGNED BY:	CHECKED BY:
DRAWN BY:	APPROVED BY:
DATE: YYYY MM DD	RELEASED FOR CONSTR. DATE: YYYY MM DD

B.M. ELEV.			ENGINEER'S SEAL	THE CITY OF WINNIPEG WATER AND WASTE DEPARTMENT ENGINEERING DIVISION	
			DESIGNED BY: EB	CHECKED BY: JWB	NORTH END WATER POLLUTION CONTROL CENTER BOILER 4 PPC/BMS WIRING
			DRAWN BY: SA	APPROVED BY:	
2	AS BUILT	2019/11/06	SCALE: HORIZONTAL 1:250	RELEASED FOR CONSTRUCTION	
1	FOR CONSTRUCTION	2019/10/18	VERTICAL 1:50		
0	FOR CUSTOMER REVIEW	2019/09/23	DATE		
NO.	REVISIONS	DATE	BY	DATE	
PLOT DATE:			CITY DRAWING NUMBER 19-01-601-4E002-4		
			SHEET 1 OF 1		