




| Issue No. | Date       | Description        |
|-----------|------------|--------------------|
| 1         | 2025/12/11 | Contract Documents |
| 2         | 2026/01/15 | Addendum 03        |

**LEGEND**

- PROPERTY LINE
- EXISTING DECIDUOUS TREE
- EXISTING VM
- EXISTING STM LINE
- EXISTING SAN LINE
- EXISTING HYDRO LINE (BELOW GRADE)
- CP CONCRETE PAVING (REFER TO CIVL)
- CP CONCRETE PAVING WITH PRECAST CONCRETE BANDING (REFER TO CIVL)
- LIGHT DUTY VEHICULAR ASPHALT (REFER TO CIVL)
- HEAVY DUTY VEHICULAR ASPHALT (REFER TO CIVL)
- ASPHALT PAVING - MULTILUSE TRAIL (REFER TO CIVL)
- ASPHALT PAVING - CHILDCARE PLAY AREA (REFER TO CIVL)
- PRECAST CONCRETE UNIT PAVING - VEHICULAR (COLOUR 01)
- PRECAST CONCRETE UNIT PAVING - VEHICULAR (COLOUR 02)
- SOD
- GRANITE MULCH SURFACING
- PLANTING BED
- LIGHT STANDARD - VEHICULAR (REFER TO ELECTRICAL)
- LIGHT STANDARD - PEDESTRIAN (REFER TO ELECTRICAL)
- EV CHARGING STATION (REFER TO ELECTRICAL)
- TAMPER-PROOF HOSE BIB (REFER TO MECHANICAL)
- CATCH BASIN (REFER TO CIVIL)
- MAINTENANCE HOLE (REFER TO CIVIL)
- FIRE HYDRANT (REFER TO CIVIL)
- CLEAN OUT MAINTENANCE HOLE (REFER TO CIVIL)
- JUNCTION BOX (REFER TO CIVIL)
- CO
- JB

**GENERAL NOTES**

- THIS DRAWING SET IS COPYRIGHTED AND MUST NOT BE USED, REPRODUCED, OR REVISED WITHOUT WRITTEN PERMISSION.
- ALL DIMENSIONS ARE IN MILLIMETERS (mm) UNLESS OTHERWISE NOTED. CONTRACTOR TO VERIFY ALL DIMENSIONS.
- DO NOT SCALE DRAWINGS.
- SITE FEATURES HAVE BEEN LOCATED FROM A SURVEY DONE BY STEVEN SURVEYS, PREPARED IN NOVEMBER 2024. THESE HAVE BEEN SHOWN FOR DIAGNOSTIC PURPOSES ONLY AND ARE APPROXIMATE IN LOCATION. EXACT LOCATIONS OF ALL UTILITIES TO BE VERIFIED AND CONFIRMED BY CONTRACTOR ON SITE PRIOR TO CONSTRUCTION. REPORT DISCREPANCIES TO CONTRACT ADMINISTRATOR PRIOR TO COMMENCEMENT OF WORK.
- CONTRACTOR SHALL ARRANGE FOR UTILITY STAKING PRIOR TO START OF CONSTRUCTION. IT IS THE CONTRACTOR'S RESPONSIBILITY TO VISIT THE SITE PRIOR TO CONSTRUCTION TO BECOME FAMILIAR WITH EXISTING CONDITIONS.
- CONTRACTOR SHALL PROVIDE THEIR OWN LAYOUT, GRADING, STAKING, AND SURVEYING REQUIRED FOR CONSTRUCTION. REFER TO EXISTING SURVEY FOR BENCH-MARKS AND OTHER EXISTING INFORMATION. CONTRACTOR SHALL FIELD VERIFY LAYOUT PRIOR TO CONSTRUCTION.
- CONTRACTOR SHALL PROTECT ALL EXISTING AND NEW CONSTRUCTION FROM DAMAGE. SHOULD ANY DAMAGE OCCUR, THE CONTRACTOR SHALL MAKE ALL NECESSARY REPAIRS AT NO COST TO THE OWNER. CONTRACTOR SHALL COORDINATE THEIR WORK WITH ALL OTHER CONTRACTORS ON SITE.
- PROVIDE BARRIERS OR OTHER PROTECTION TO KEEP VEHICULAR AND PEDESTRIAN TRAFFIC AWAY FROM CONSTRUCTION AREA AND OFF NEWLY PAVED AREAS BEFORE PAVING HAS CURED. DO NOT LEAVE ANY HOLES OPEN OVERNIGHT.
- KEEP AREA OUTSIDE CONSTRUCTION ZONE CLEAN AND USABLE BY OTHERS AT ALL TIMES.
- CONTRACTOR SHALL SUBMIT SAMPLES OF ALL PROPOSED MATERIALS FOR APPROVAL PRIOR TO PLACING ORDERS.
- ALL WORK SHALL BE SUPERVISED BY CONTRACT ADMINISTRATOR PRIOR TO PAYMENT APPROVAL.
- AT ALL EDGES OF EXISTING SIDEWALK OR CURB AGAINST WHICH NEW CONCRETE IS TO BE PLACED, SAW CUT AND REMOVE EXISTING CONCRETE BACK TO THE NEAREST CONSTRUCTION JOINT TO PROVIDE A SMOOTH TRANSITION TO THE NEW CONCRETE.
- INSTALL EXPANSION JOINTS AT ALL LOCATIONS WHERE NEW CONCRETE MEETS EXISTING CONCRETE PAVEMENT, SLABS, OR FOOTINGS.
- INSTALL EXPANSION JOINTS AT MAXIMUM 6 METER INTERVALS, OR AS NOTED ON DRAWINGS. LONGITUDINAL JOINTS LOCATED OUTSIDE OF THE PLANT TO BE AT 1500MM O.C. MAXIMUM, OR AS NOTED ON CIVIL DRAWINGS.
- CONTRACTOR TO STAKE OUT FENCE LAYOUT FOR CHILD CARE PLAY AREAS FOR REVIEW BY CONSULTANT PRIOR TO INSTALLATION. FENCE LAYOUT TO BE ADJUSTED TO ACCOMMODATE MANITOBA REGULATORY REQUIREMENTS FOR EXTERIOR PLAY AREA SIZING REQUIREMENTS.

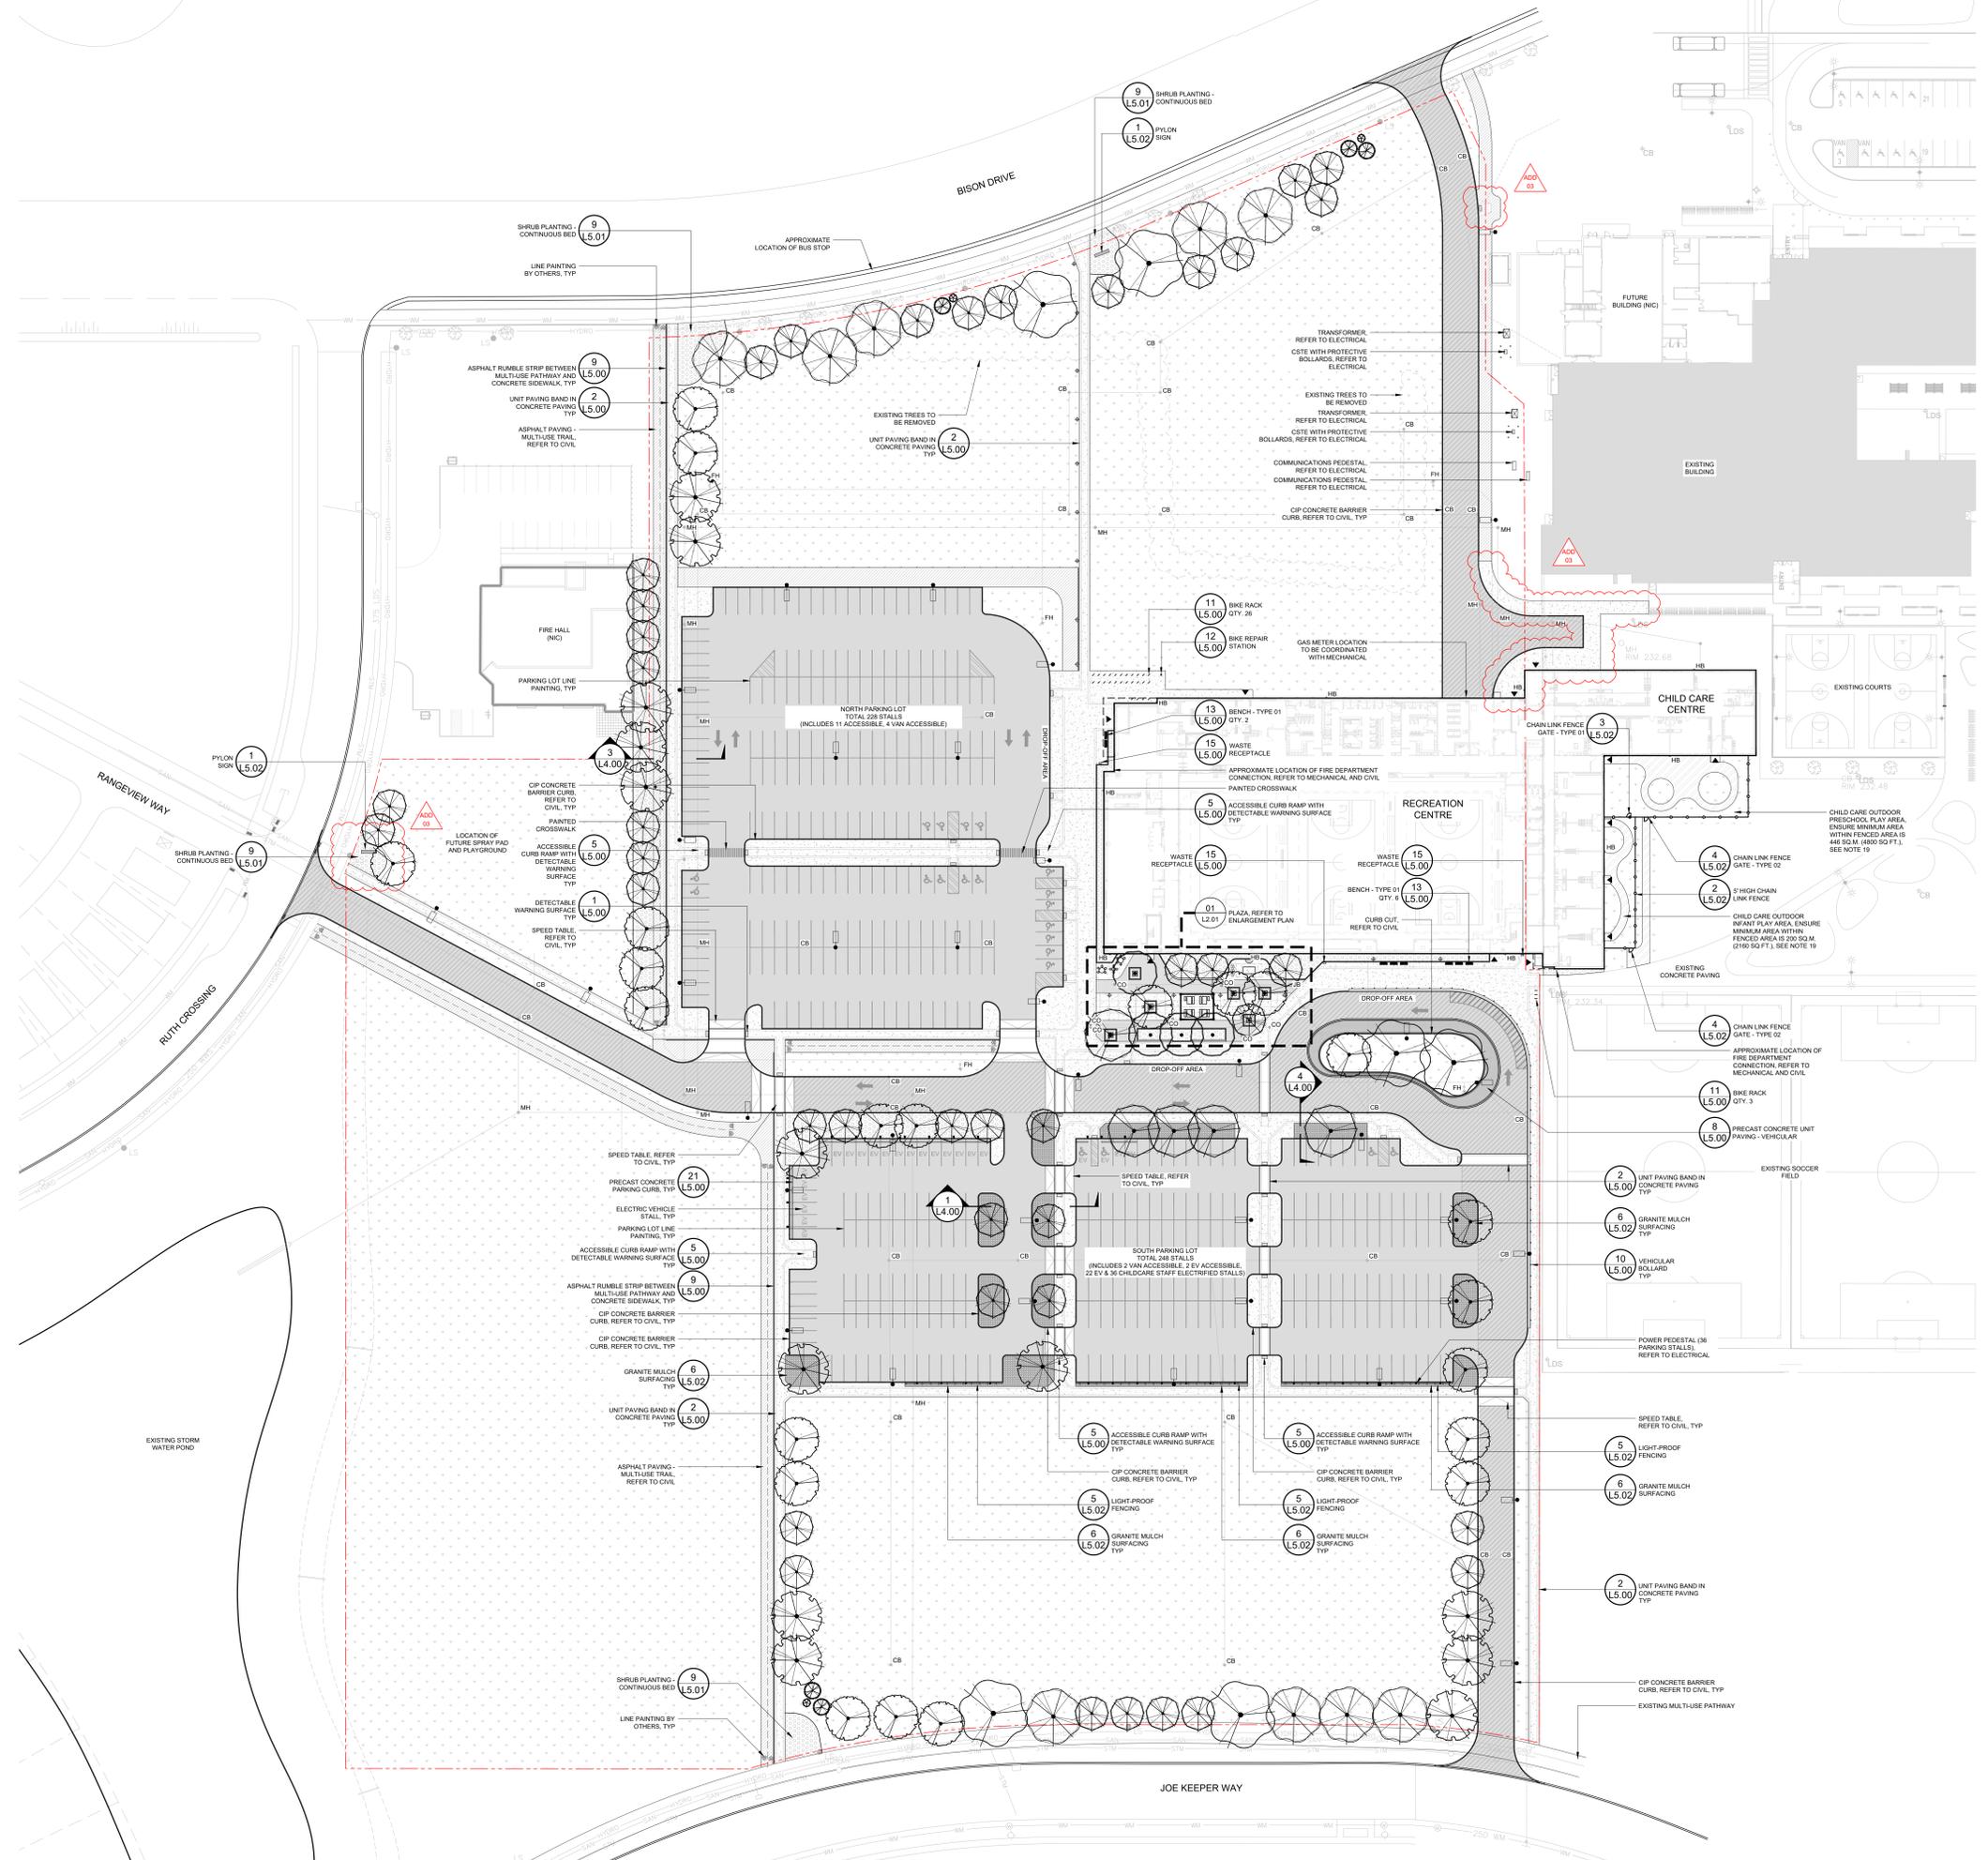

Contractor Must Check & Verify all Dimensions on the Job.

Do Not Scale Drawings.

All Drawings, Specifications and Related Documents are the Copyright Property of the Architect and Must be Returned Upon Request. Reproduction of Drawings, Specifications and Related Documents in Part or in Whole is Prohibited Without the Written Permission of the Architect.

This Drawing is Not to be Used for Construction Until Signed by the Landscape Architect.

**South Winnipeg Recreation Campus**  
Address: 15 Ruth Crossing & 25 Ruth Crossing  
Winnipeg, MB  
Consultant Project No: 220007  
City of Winnipeg Project No: 2020-127  
City of Winnipeg Tender No: 63-2025B

**MATERIALS PLAN**

Scale: 1:500

**L1.00**