


LAST SAVE: 2025/05/01 - 3:54pm
PATH: M:\694715\4ENG\48C\DD - General DWG\HURST\1-0650M-A0031-005-02.dwg

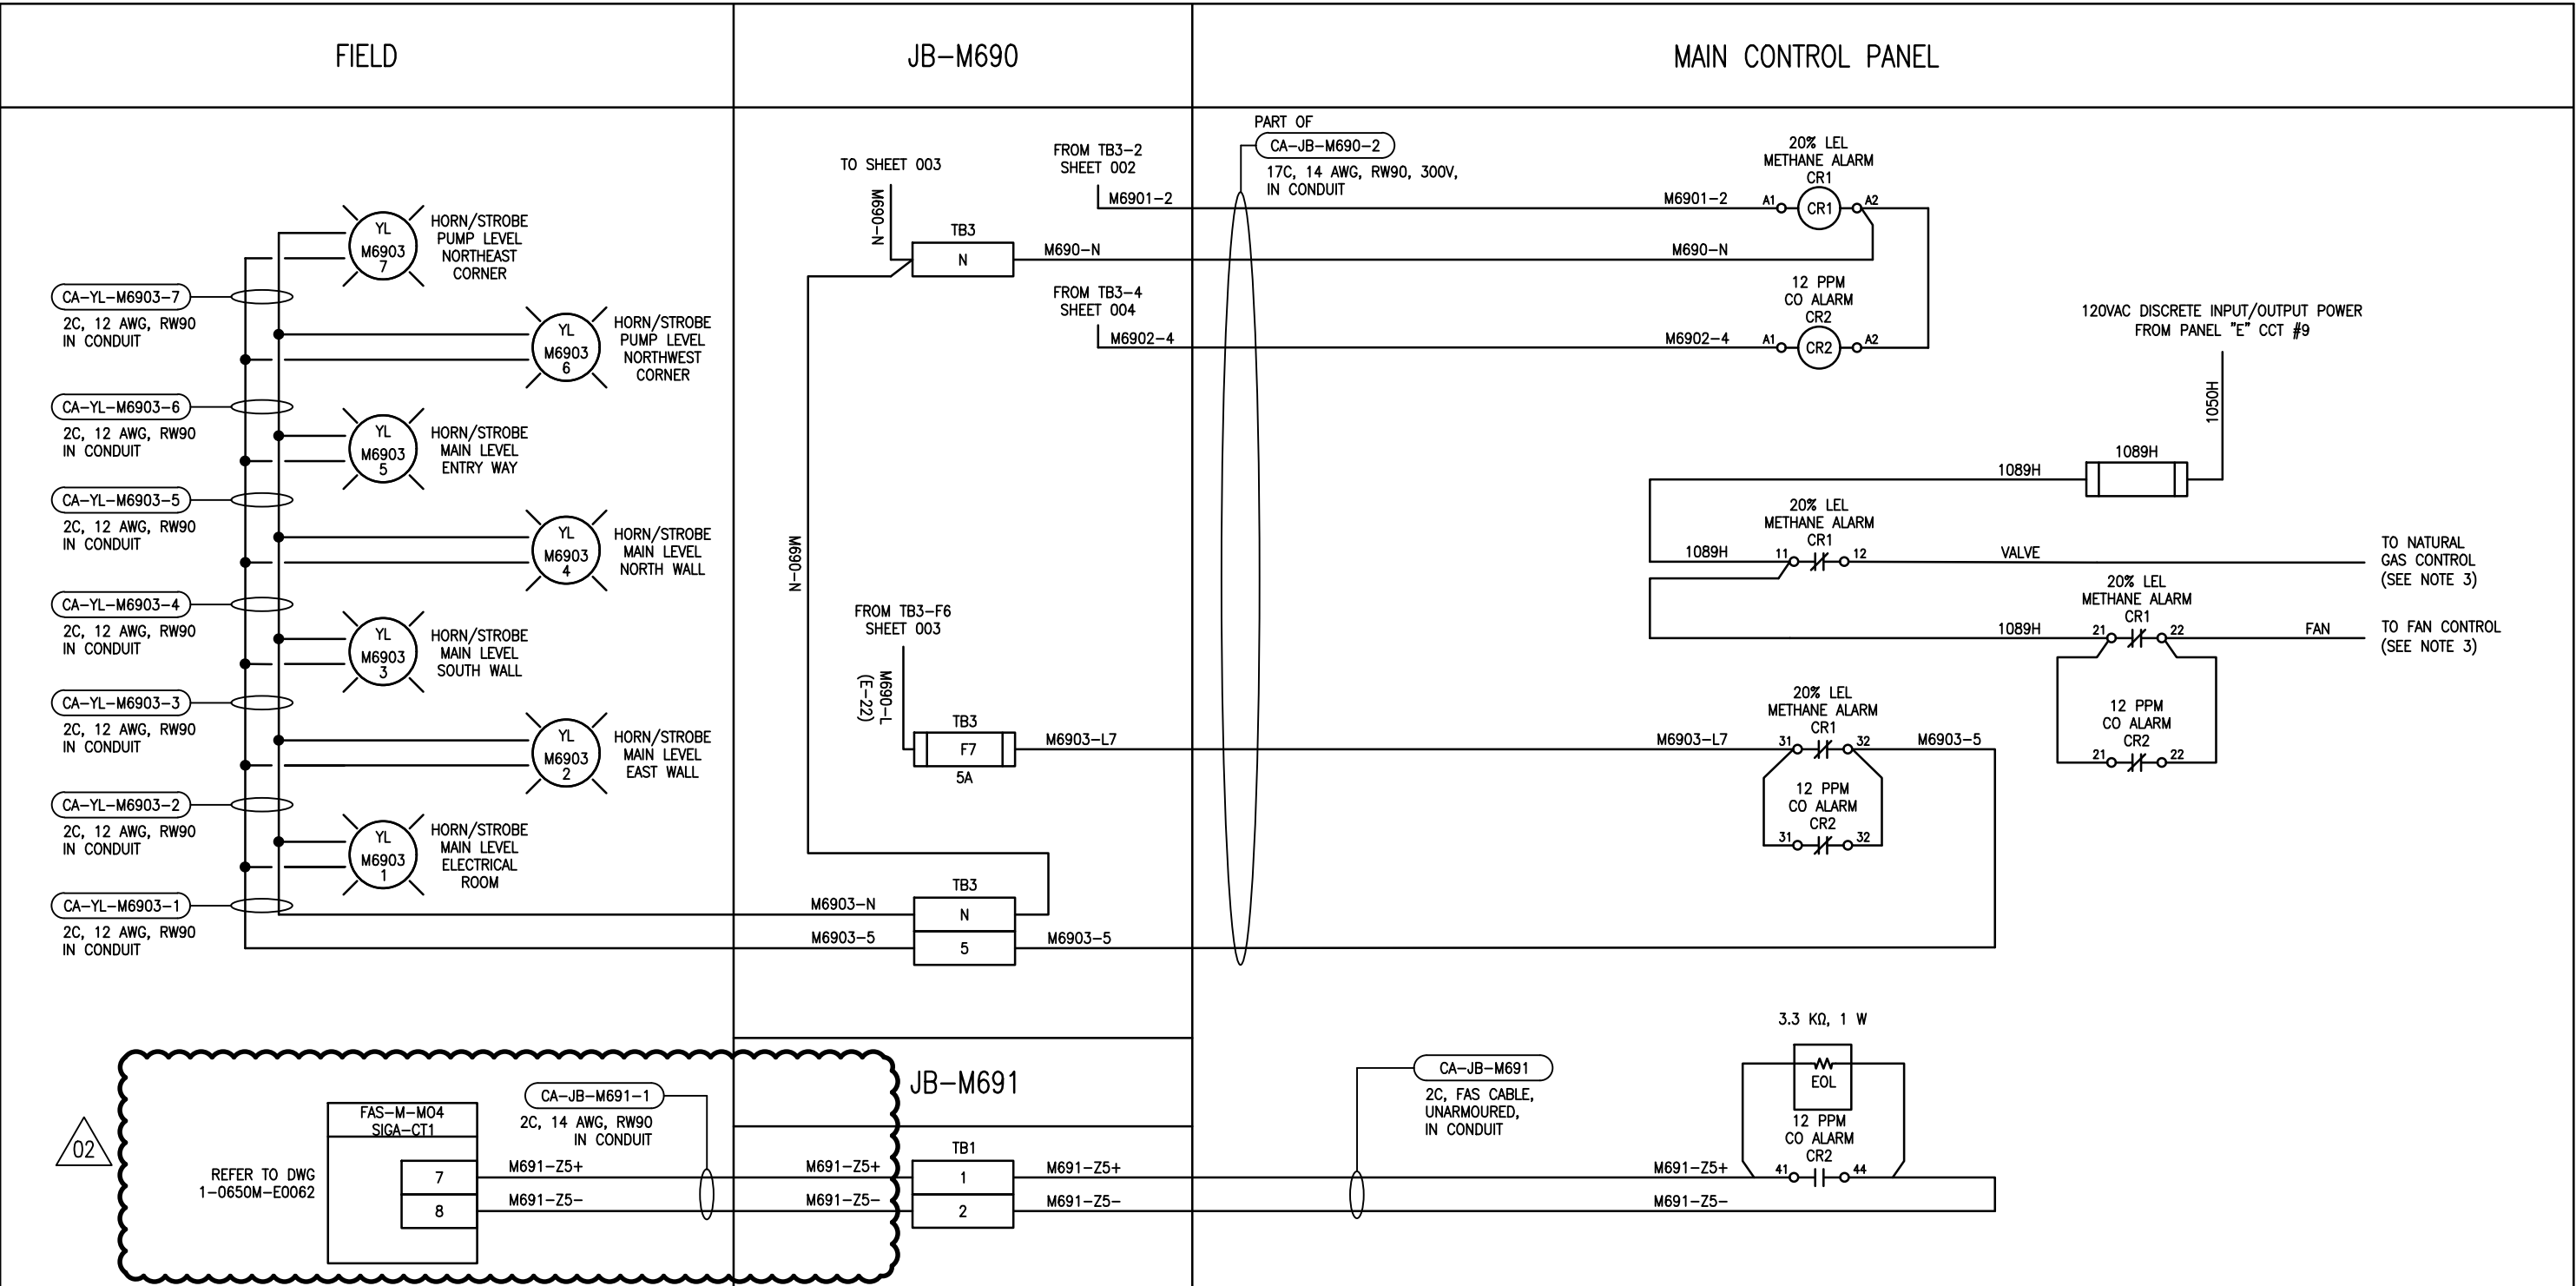

NOTES

- FOR NOTES AND REFERENCE DRAWINGS SEE SHEET 001
- TIE EXISTING CO DETECTION SIGNAL FROM JB-M691 TO NEW FIRE ALARM INPUT MODULE FAS-M-M04.
- RECONNECTED TO EXISTING WIRES LABELLED "VALVE" AND "FAN".



148 Nature Park Way
Winnipeg, Manitoba Canada R3P 0X7
204-786-8080

DESIGNED BY: M. SARIC	CHECKED BY: B. CLEVEN
DRAWN BY: M. SARIC	APPROVED BY: B. CLEVEN
SCALE: N.T.S.	DATE: 2021/06/12
ISSUED FOR CONSTRUCTION BY: A. WEISS	DATE: 2021/09/08
CONSULTANT NO.:	

ENGINEER'S SEAL



THE CITY OF WINNIPEG
WATER AND WASTE DEPARTMENT

HURST PUMPING STATION
GAS DETECTION UPGRADES
LOOP DIAGRAM
METHANE AND CO DETECTION

CITY DRAWING NUMBER	SHEET	REV.	SIZE
1-0650M-A0031	005	02	B

NO.	REVISIONS	DATE	DESIGN	CHECK
02	ISSUED FOR TENDER AND CONSTRUCTION	2025/04/30	VE	VE
01	AS-BUILT - 1070-2019 TENDER	2023/03/17	-	VE
00	ISSUED FOR CONSTRUCTION	2021/09/08	MS	BC