
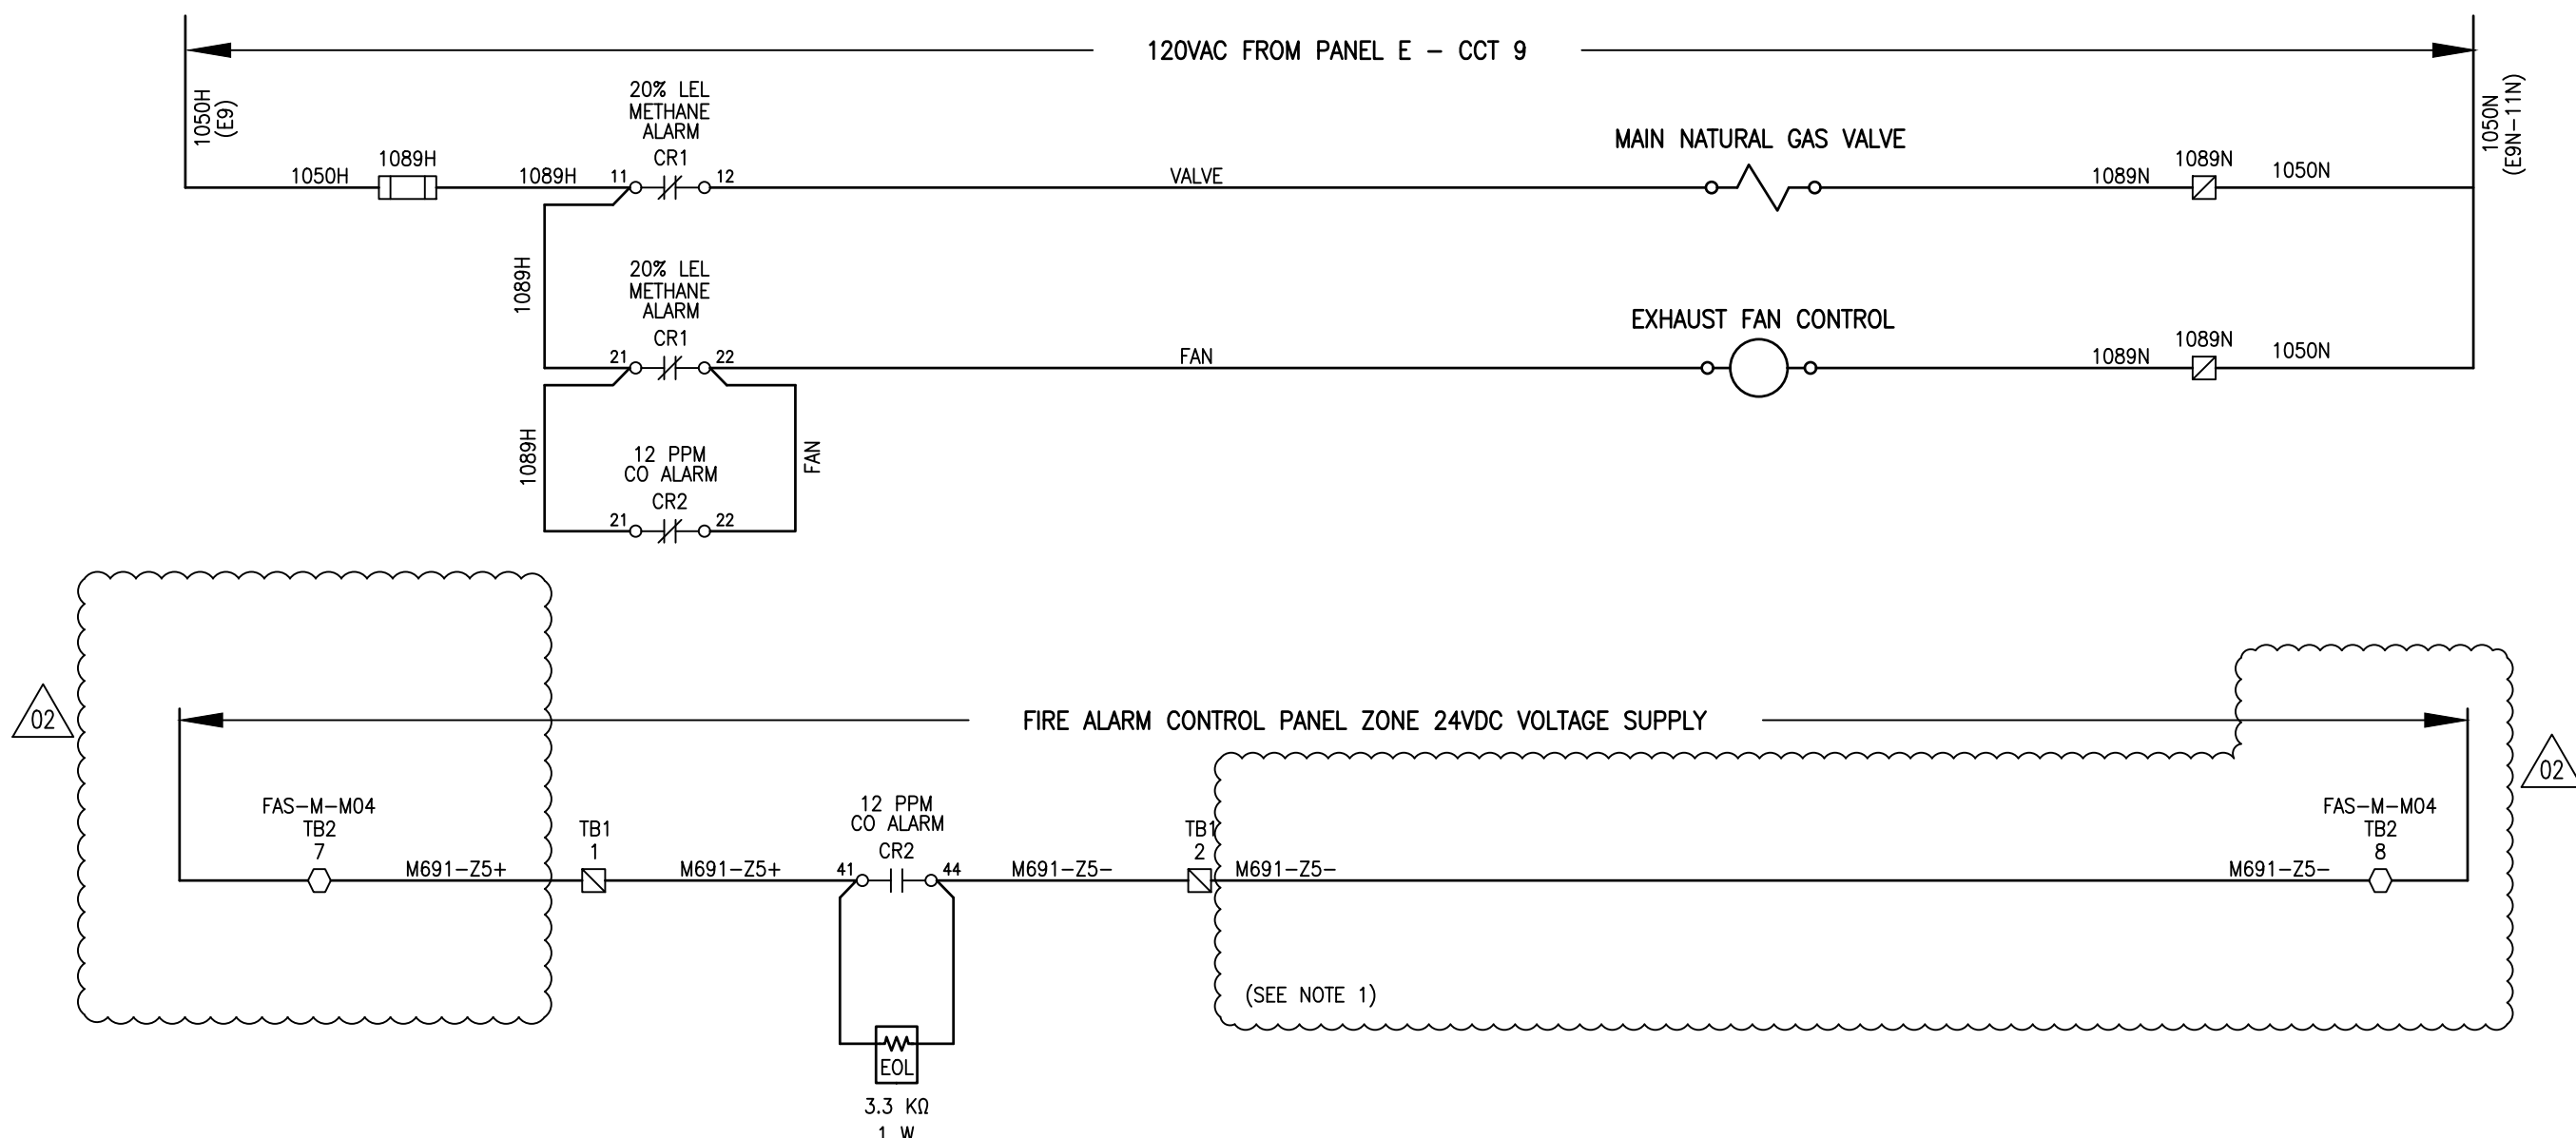
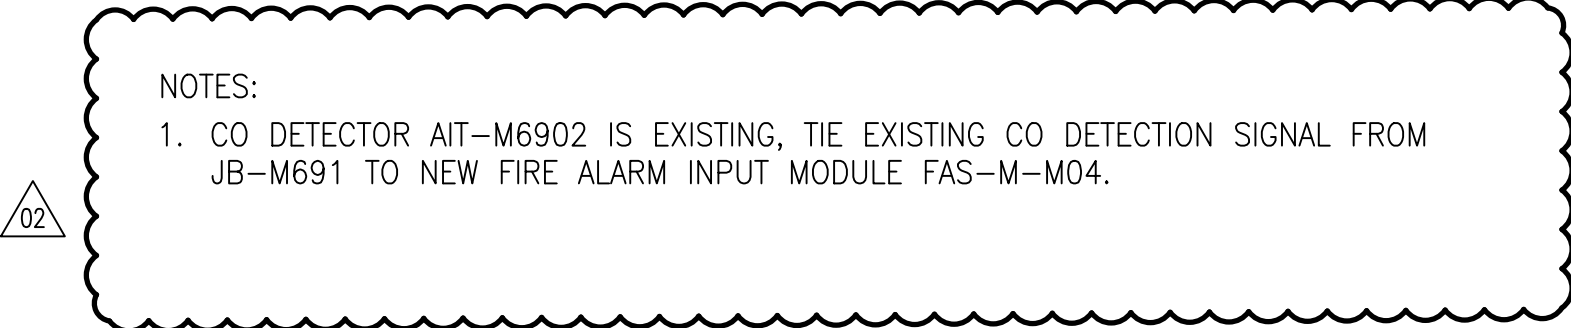
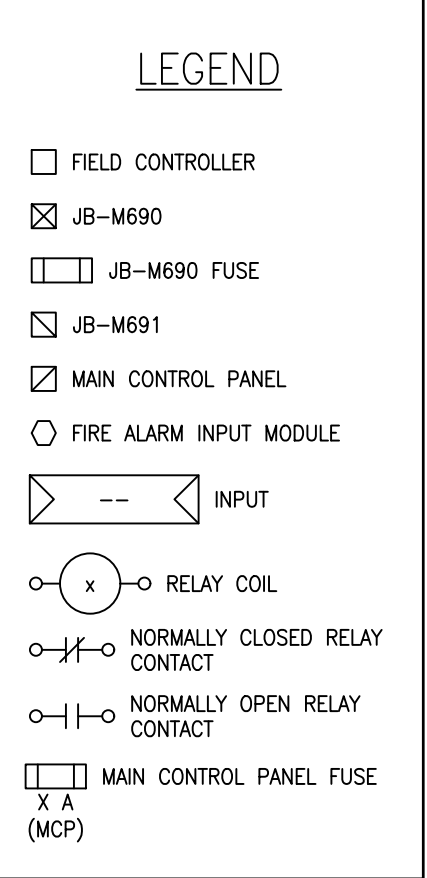


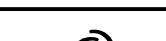

**ENGINEERS
GEOSCIENTISTS
MANITOBA**
Certificate of Authorization
AtkinsRéalis Canada Inc.
No. 4489

					 148 Nature Park Way, Winnipeg, Manitoba Canada R3P 0X7 204-786-8080		ENGINEER'S SEAL		 THE CITY OF WINNIPEG WATER AND WASTE DEPARTMENT			
					DESIGNED BY: M. SARIC	CHECKED BY: B. CLEVEN	 HURST PUMPING STATION GAS DETECTION UPGRADES SCHEMATIC METHANE AND CO DETECTION					
					DRAWN BY: M. SARIC	APPROVED BY: B. CLEVEN						
					SCALE: NTS	ISSUED FOR CONSTRUCTION BY: A. WEISS						
					DATE: 2021/06/12	DATE: 2021/09/08						
02	ISSUED FOR TENDER AND CONSTRUCTION	2025/04/30	VE	VE								
01	AS-BUILT - 1070-2019 TENDER	2023/03/17	-	VE								
00	ISSUED FOR CONSTRUCTION	2021/09/08	MS	BC								
NO. REVISIONS					DATE	DESIGN	CHECK	CITY DRAWING NUMBER				
								1-0650M-A0032				
								SHEET	REV.	SIZE		
								001	02	A1		